

Brampton Encore - 36L - 2 - 28-2 Elev.CL SIREN

ELECTRICAL

Inv.1,460	1 - 200 AMP ELECTRICAL SERVICE
Line22817	Note:
27Jun17 / 22Nov17	

Exterior Colours

Inv.1,460	1 - EXTERIOR COLOUR PACKAGE #1
Line24785	Note:
27Jun17 / 22Nov17	

MISC.

Inv.1,460	1 - REFUND-SIDE DOOR- HOME TO EXTERIOR- AS PER PLAN AND GRADE PERMITTING
Line22816	Note:
27Jun17 / 22Nov17	

Inv.1,460	1 - Purchaser has attended an appointment at the Decor Centre & has DECLINED any additional upgrades and accepts and acknowledges that there will be no further changes/additions/deletions to be made upon signing on June 27 2017.
Line22821	Note:
27Jun17 / 22Nov17	

Inv.1,460	1 - Purchasers are aware & accepts that ANY changes made to upgrades after signing this Purchasers Extra Form are subject to a minimum administration fee of \$500. PLUS a 10% holdback fee.
Line22822	Note:
27Jun17 / 22Nov17	

Inv.1,460	1 - BONUS PACKAGE: \$10,000.00 (INCLUDING TAXES) WORTH OF UPGRADES FROM GOLD PARK HOMES DÉCOR CENTRE IS BEING APPLIED TOWARD THE STRUCTURAL APPOINTMENT. PURCHASER HAS A REMAINING AMOUNT OF \$4965.85 (INCLUDING TAXES) TO BE USED TOWARD THE COLOUR APPOINTMENT.
Line22823	Note:
27Jun17 / 22Nov17	

WINDOWS - BASEMENT

Inv.1,460	2 - BASEMENT WINDOWS - UPGRADE EXISTING BASEMENT WINDOW TO 30 INCH X 24 INCH - MAY REQUIRE INSTALLATION OF WINDOW WELL
Line22819	Note:
27Jun17 / 22Nov17	

Inv.1,460	1 - BASEMENT WINDOWS - UPGRADE EXISTING BASEMENT WINDOW TO 30 INCH X 16 INCH
Line22820	Note:
27Jun17 / 22Nov17	

BE2-36L
JUNE 27 2017


The Siren

SEMI SERIES

Elevation A • 1,688 sq.ft.

Elevation B • 1,677 sq.ft.

→ Elevation C • 1,687 sq.ft.

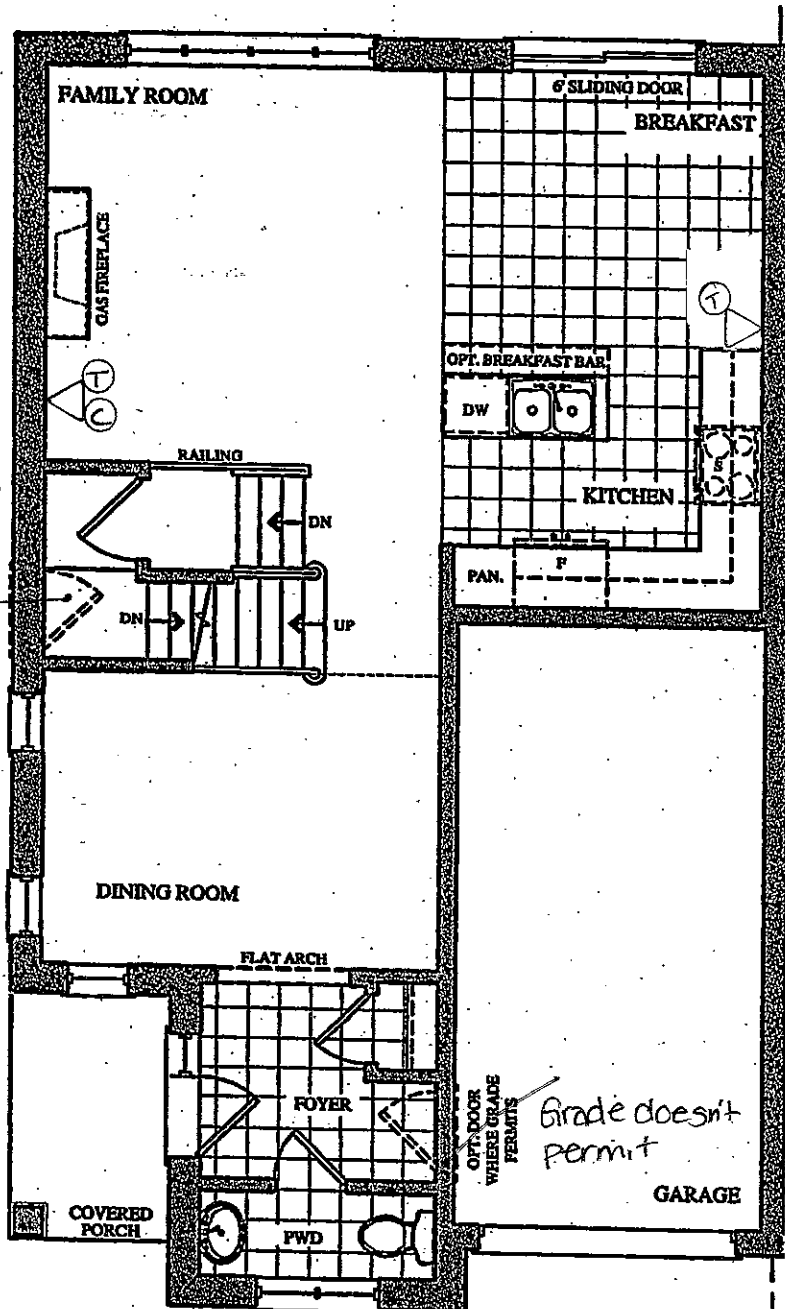


GROUND FLOOR PLAN
ELEV. 'A' & 'B'

LEGEND

△ ⊕ PHONE

△ ⊙ CABLE

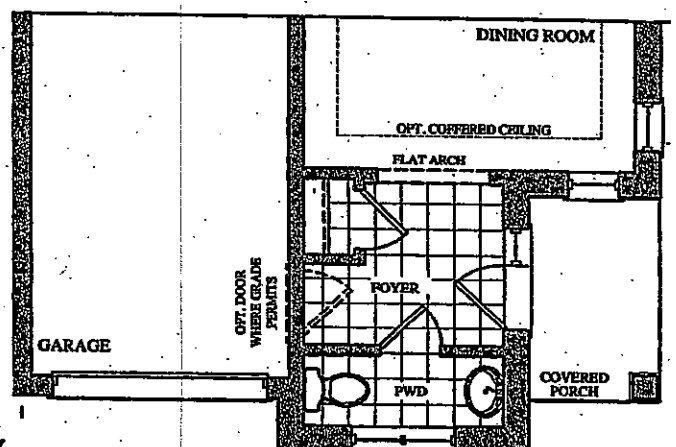


PART. GROUND FLOOR PLAN
ELEV. 'C'


BEZ-36L
JUNE 27 2017

The Siren SEMI SERIES


Elevation A • 1,688 sq.ft.
Elevation B • 1,677 sq.ft.
Elevation C • 1,687 sq.ft.

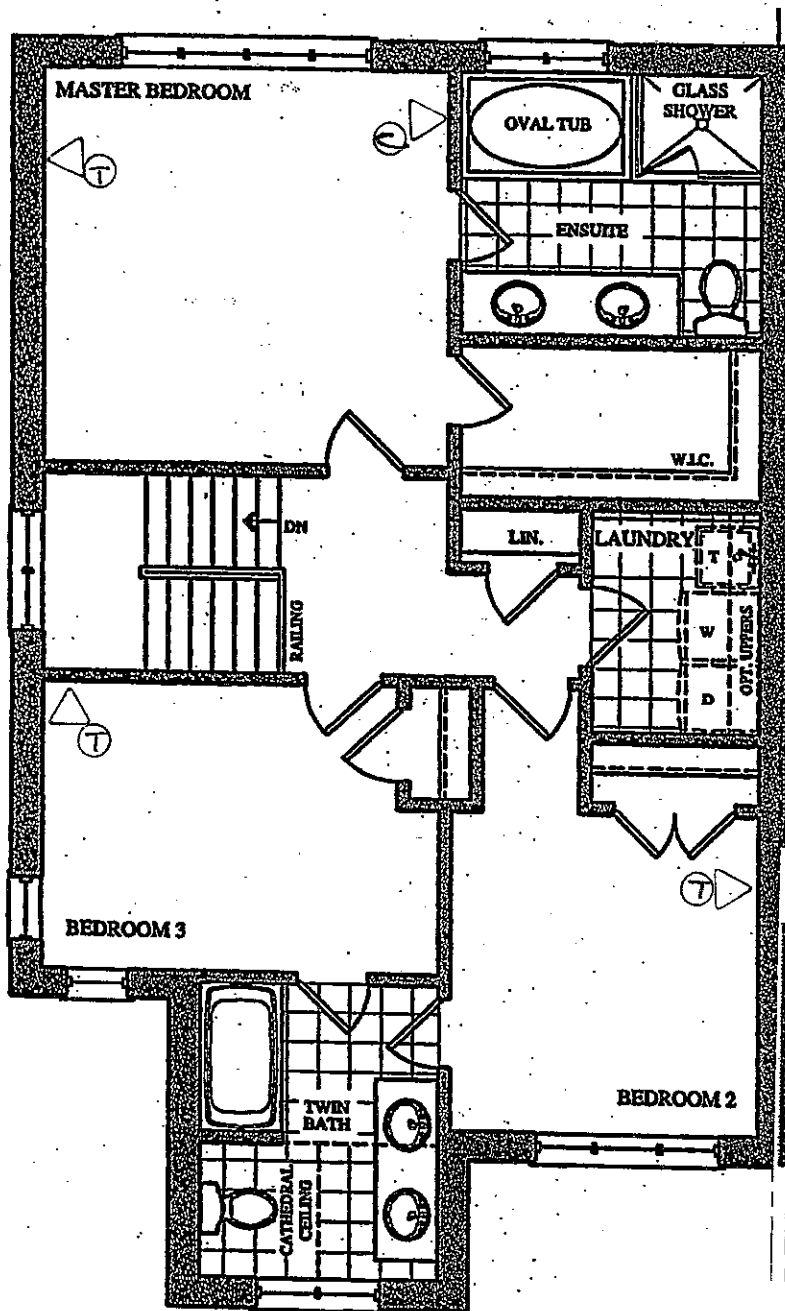

SECOND FLOOR PLAN
ELEV. 'A'

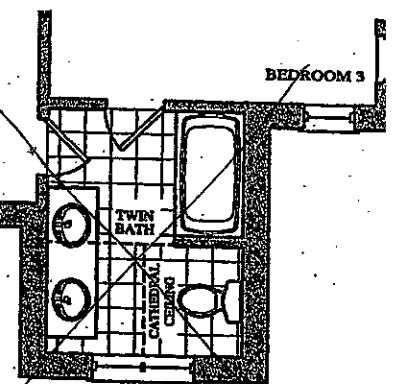

PART. SECOND FLOOR PLAN
ELEV. 'B'

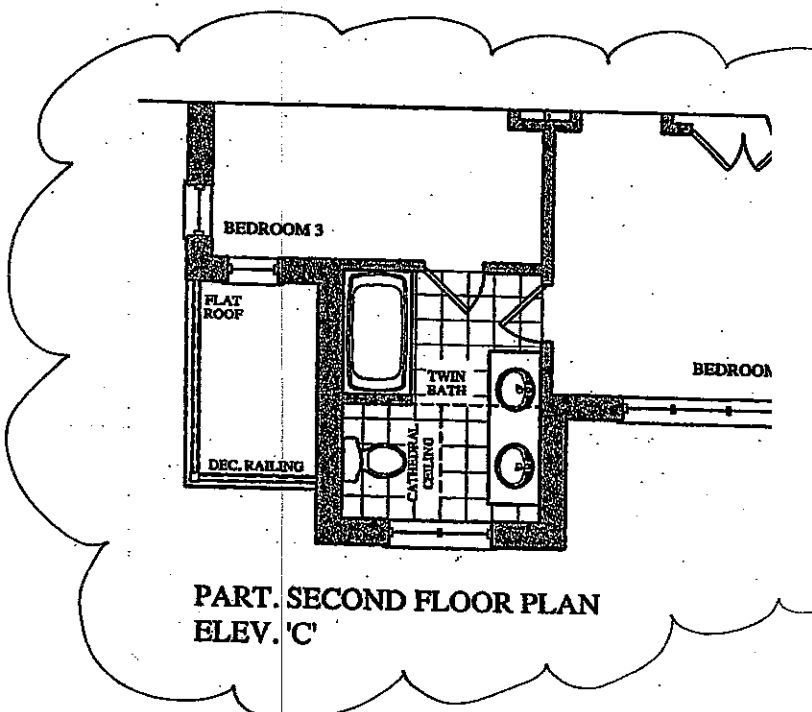

PART. SECOND FLOOR PLAN
ELEV. 'C'

BE2-36L 
JUNE 27 2017

The Siren

SEMI SERIES

Elevation A • 1,688 sq.ft.
Elevation B • 1,677 sq.ft.
→ Elevation C • 1,687 sq.ft.

