

Brampton Encore - 1 - 2 - 38-8 Elev.B CORELLI OPT - OPTG AND OPT5  
CENTRAL VAC AND WIRING

Inv.1,540	1 - CAT 6 WIRING - UPGRADE AN OUTLET TO CAT 6- MUST SPECIFY LOCATION
Line23714	Note:
2Aug17 / 2Aug17	
Inv.1,541	1 - CONDUIT PIPE- FOR TELEVISION- MUST SPECIFY LOCATION AND TERMINATION POINT- SEE FLOORPLAN ABOVE MAIN FLOOR FIREPLACE
Line23716	Note:
3Aug17 / 3Aug17	

CONCRETE AND DRAIN

Inv.1,540	1 - COLD CELLAR
Line23710	Note:
2Aug17 / 2Aug17	
Inv.1,540	1 - ROUGH-IN - 3PC BASEMENT ROUGH-IN
Line23711	Note:
2Aug17 / 2Aug17	

DRYWALL

Inv.1,540	1 - SMOOTH CEILINGS SECOND FLOOR
Line23697	Note:
2Aug17 / 2Aug17	
Inv.1,540	1 - SMOOTH CEILINGS MAIN FLOOR
Line23701	Note:
2Aug17 / 2Aug17	

ELECTRICAL

Inv.1,540	1 - 110V RECEPTACLE FOR FUTURE GAS STOVE IN KITCHEN
Line23699	Note:
2Aug17 / 2Aug17	
Inv.1,540	1 - CENTER STD LIGHT FIXTURE AS BEST AS POSSIBLE IN DINING ROOM
Line23704	Note:
2Aug17 / 2Aug17	
Inv.1,540	1 - ADD CAPPED LIGHT FIXTURE IN LIVING ROOM- CENTER TO CEILING AS BEST AS POSSIBLE ON SEPERATE SWITCH
Line23705	Note:
2Aug17 / 2Aug17	
Inv.1,540	1 - 220V WALL RECEPTICAL ON DEDICATED CIRCUIT- FOR 4 WIRE BUILT-IN WALL OVEN - MUST SPECIFY LOCATION
Line23707	Note:
2Aug17 / 2Aug17	
Inv.1,541	1 - 110V WALL RECEPTACLE ON NORMAL CIRCUIT-MUST SPECIFY LOCATION
Line23717	Note:
3Aug17 / 3Aug17	

Exterior Colours

Inv.1,540	1 - EXTERIOR COLOUR PACKAGE #10
Line23706	Note:
2Aug17 / 2Aug17	

**Brampton Encore - 1 - 2 - 38-8 Elev.B CORELLI OPT - OPTG AND OPT5**

**FORMING**

Inv.1,540	1 - COLD CELLAR
Line23712	Note:
2Aug17 / 2Aug17	

**FRAMING**

Inv.1,540	1 - MAN DOOR- GARAGE TO HOUSE- GRADE PERMITTING
Line23709	Note:
2Aug17 / 2Aug17	
Inv.1,541	4 - MAIN FLOOR TALLER DOORS
Line23715	Note:
3Aug17 / 3Aug17	

**HVAC**

Inv.1,540	1 - GAS LINE - FOR FUTURE GAS STOVE IN KITCHEN
Line23698	Note:
2Aug17 / 2Aug17	
Inv.1,540	1 - 8" STOVE VENT IN KITCHEN ON EXTERIOR WALL
Line23703	Note:
2Aug17 / 2Aug17	

**KITCHEN AND BATH CABINETRY**

Inv.1,667	1 - KITCHEN: INSTALL Oak PVC 112 Built in wall oven and microwave and cooktop with countertop by others 242cm
Line24980	Note:
5Dec17 / 7Feb18	
Inv.1,667	1 - KITCHEN: INSTALL Oak PVC 158 Overlay Gable Pantry 61x220 61x242, TO GO BESIDE WALL OVEN UNIT
Line24982	Note:
5Dec17 / 7Feb18	

**MISC.**

Inv.1,667	1 - Purchaser has attended a Colour appointment at the Decor Centre & has DECLINED any additional upgrades and accepts and acknowledges that there will be no further structural changes/additions/deletions to be made upon signing on December 5, 2017
Line24983	Note:
5Dec17 / 7Feb18	
Inv.1,667	1 - Purchasers are aware & accepts that ANY changes made to upgrades after signing this Purchasers Extra Form are subject to a minimum administration fee of \$500. PLUS a 10% holdback fee.
Line24984	Note:
5Dec17 / 7Feb18	

**PLUMBING**

Inv.1,540	1 - ROUGH-IN - 3PC BASEMENT ROUGH-IN
Line23713	Note:
2Aug17 / 2Aug17	

**WINDOWS - BASEMENT**



CONSTRUCTION SUMMARY

Brampton Encore - 1 - 2 - 38-8 Elev.B CORELLI OPT - OPTG AND OPT5

Inv.1,540	3 - UPGRADE 3 REAR BASEMENT WINDOWS- 30" x 16"
Line23700	Note:
2Aug17 / 2Aug17	

WINDOWS AND DOORS

Inv.1,540	1 - MAN DOOR- GARAGE TO HOUSE- GRADE PERMITTING
Line23708	Note:
2Aug17 / 2Aug17	

Purchaser: Harjit Kaur Bhandal

Property: 1

Telephone Res. / Bus: (647) 708-3637

Project: Brampton Encore - Phase 2

Decor Advisor: Terri Parisani

Model and Elevation: 38-8 Elev.B CORELLI OPT - OPTG AND C

Layout Changes: ☒ Yes ☐ No      Sketch Attached: ☒ Yes ☐ No      Exterior Colour Scheme:

### 1. Cabinetry

	Style and Colour	Counter	Hardware
Kitchen / Breakfast	Toscana (pvc) Antique White	Crema Caramel Granite Standard EdgeFE 20	CS1-25
Laundry Room			
Powder Room			
TWIN BATH	Toscana(pvc)ChocolateMaple	6696-46 Carrara Bianco Laminate	CS1-25
Master Ensuite Bathroom	Toscana(pvc)ChocolateMaple	6696-46 Carrara Bianco Laminate	CS1-25
Second Ensuite Bathroom (If Applicable)	Toscana(pvc)ChocolateMaple	6696-46 Carrara Bianco Laminate	CS1-25
GROUND FL ENSUITE	Toscana(pvc)ChocolateMaple	6696-46 Carrara Bianco Laminate	CS1-25

Comment

### 2. Floor Tile

	Selection
Entrance Vestibule	Carrara Series 13 x 13 White/Grey upg 1
Main Hall	
Kitchen / Breakfast	Carrara Series 13 x 13 White/Grey
Laundry Room	Carrara Series 13 x 13 White/Grey
Powder Room	Carrara Series 13 x 13 White/Grey
TWIN BATH	Carrara Series 13 x 13 White/Grey
Master Ensuite Bathroom	Carrara Series 13 x 13 White/Grey
Second Ensuite Bathroom (If Applicable)	Carrara Series 13 x 13 White/Grey
Lower Landing (If Applicable)	Carrara Series 13 x 13 White/Grey (ground floor)
GROUND FL ENSUITE	Carrara Series 13 x 13 White/Grey

Comment

### 3. Wall Tile

	Selection	Listello/Inserts	Describe
TWIN BATH	Weave White 8 x 10 std	<input type="radio"/> Yes <input checked="" type="radio"/> No	
Master Ensuite Bathroom			
Tub Deck	Weave White 8 x 10	<input type="radio"/> Yes <input checked="" type="radio"/> No	
Shower Stall	Weave White 8 x 10	<input type="radio"/> Yes <input checked="" type="radio"/> No	
Bathroom Walls	Weave White 8 x 10	<input type="radio"/> Yes <input checked="" type="radio"/> No	
Second Ensuite Bathroom (If Applicable)	Weave White 8 x 10	<input type="radio"/> Yes <input checked="" type="radio"/> No	
GROUND FL ENSUITE	Weave White 8 x 10	<input type="radio"/> Yes <input checked="" type="radio"/> No	
Kitchen Backsplash	<input type="radio"/> Yes <input checked="" type="radio"/> No	Backsplash Behind Fridge	

Comment

Scheduled Closing Date: March-20-18

Purchaser: Harjit Kaur Bhandal  
Telephone Res. / Bus: (647) 708-3637  
Decor Advisor: Terri Parisani

Property: 1  
Project: Brampton Encore - Phase 2  
Model and Elevation: 38-8 Elev.B CORELLI OPT - OPTG AND C

4. Plumbing Fixtures

<input type="text"/>	Second Ensuite	<input type="text"/>	Powder Room	<input type="text"/>	
Master Ensuite Bathroom	<input type="text"/>	Other Room - Specify	<input type="text"/>	Other Washroom	<input type="text"/>
Comment					
STANDARD PLUMBING THROUGHOUT					

5. Hardwood Flooring

Main Hall	Type and Stain	Std.Vintage RedOak 4 3/8 Natural	Upper Landing	Type and Stain	Std.Vintage RedOak 4 3/8 Natural
Kitchen / Breakfast			Upper Hall		
Living Room		Std.Vintage RedOak 4 3/8 Natural	Master Bedroom		
Dining Room		Std.Vintage RedOak 4 3/8 Natural	Bedroom #2		
Family Room		Std.Vintage RedOak 4 3/8 Natural	Bedroom #3		
Den/Library			Bedroom #4		
Entrance Vestibule			Bedroom #5		
Lower Landing (If Applicable)		Std.Vintage RedOak 4 3/8 Natural	Other Room - Specify		
			BREAKFAST AREA		Std.Vintage RedOak 4 3/8 Natural
Comment					

6. Carpeting

Ground Floor	Upgrade	✓	Description	11077 TEMPLAR
Second Floor	Upgrade	✓	Description	11077 TEMPLAR
	Upgrade		Description	
Upgrade Underpad	Type	STANDARD	Area	
Carpet on Stairs	Capped	STANDARD Ground Fl to Bsmnt	Runner - *Upgrade	
Comment				

7. Fireplace

	Living Room			Family Room			Other Room - Specify		
	Purchased	As Per Plan	N/A	Purchased	As Per Plan	N/A	Purchased	As Per Plan	N/A
	<input type="radio"/>	<input type="radio"/>	<input checked="" type="radio"/>	<input type="radio"/>	<input checked="" type="radio"/>	<input type="radio"/>	<input type="radio"/>	<input type="radio"/>	<input checked="" type="radio"/>
Fireplace Type				STANDARD					
Mantle Type				NF 24					
Colour / Stain				WHITE PAINT GRADE					
Surround				NERO MARQUINA					
Hearth				NONE					
Comment									

Purchaser:Harjit Kaur Bhandal

Telephone Res. / Bus: (647) 708-3637

Decor Advisor:Terri Parisani

Property: 1

Project: Brampton Encore - Phase 2

Model and Elevation: 38-8 Elev.B CORELLI OPT - OPTG AND C

8. Trim Carpentry

Interior Doors

STANDARD

Front Door Glass Inserts

STANDARD

Door Handles

STANDARD

Interior Trim

STANDARD

Comment

9. Plaster Mouldings and Medallions

Standard Throughout

☐ Yes

☒ No

☐ N/A

Entrance Vestibule

Main Hall

Living Room

Dining Room

Family Room

Kitchen/Breakfast

Den/Library

Lower Landing

Other Room - Specify

Comment

10. Railings and Spindles

Railing Package

STANDARD

Railing Colour

NATURAL

Stringer / Riser

NATURAL

Spindle Colour

NATURAL

Treads

NATURAL

Oak Stairs

☒ Yes

☐ No

☐ N/A

Comment

STAIRS FROM GROUND FLOOR TO BASEMENT ARE CARPETED

11. Wall Paint / Ceilings

Throughout Finished Areas

COOL WHITE

Trim Paint

White

Smooth Ceilings

Ground Floor

☒

Second Floor

☒

Note

Comment

Scheduled Closing Date: March-20-18

Purchaser: Harjit Kaur Bhandal  
Telephone Res. / Bus: (647) 708-3637  
Decor Advisor: Terri Parisani

Property: 1  
Project: Brampton Encore - Phase 2  
Model and Elevation: 38-8 Elev.B CORELLI OPT - OPTG AND C

12. Electrical

Hood Fan ☐ White ☒ Stainless ☐ N/A

Above Kitchen Cabinet Light ☐ Yes ☒ No

Below Kitchen Cabinet Light ☐ Yes ☒ No

Standard Appliances ☐

Over The Range Microwave ☐

Chimney Style Fan ☐

Comment

MICROWAVE/WALL OVEN UNIT WITH GAS COOKTOP

13. Heating and Air Conditioning

Air Conditioning

Gas Provisions Stove

Gas Provisions Dryer

Gas Provisions Barbecue

Comment

14. Additional Comments

15. Disclaimers and Notes

- 1) Colours of all materials are as close as possible to builder's selection, but not necessarily identical due to variances in manufacturing.
- 2) Any extras listed above are null and void unless accompanied by a separate invoice/amendment. Said invoice must be paid in full.
- 3) The Purchaser acknowledges that after Interior Colour Selection form is signed and dated, no further changes will be permitted other than re-selection due to unavailability. \_\_\_\_\_ Purchaser's Initials
- 4) The Purchaser acknowledges reading and accepting the "Gold Park Homes Decor Centre Disclaimers" form. This document contains other miscellaneous disclaimers.

This Interior Colour Selection is final and approved by:

Signature: Harjit Kaur Bhandal Date: 5/Dec/2017



**encore**  
BRAMPTON

Telephone — ① - cat 6  
Cable — ②  
Electrical — ③

# The Corelli

## 38' SERIES

Elevation A • 3,878 sq.ft. | Elevation B • 3,878 sq.ft.

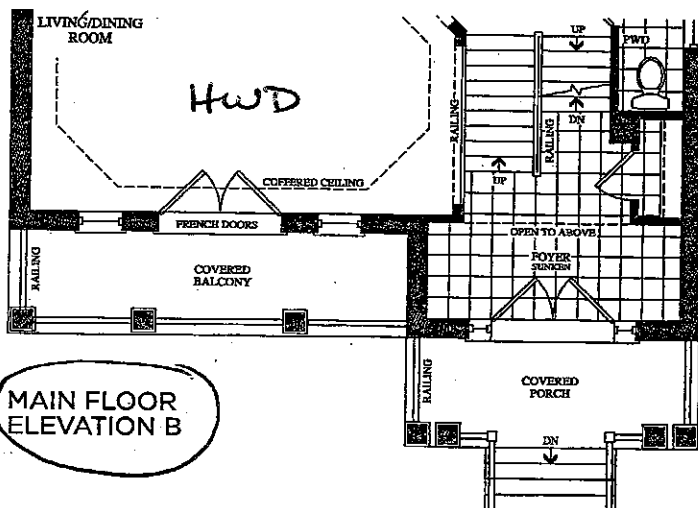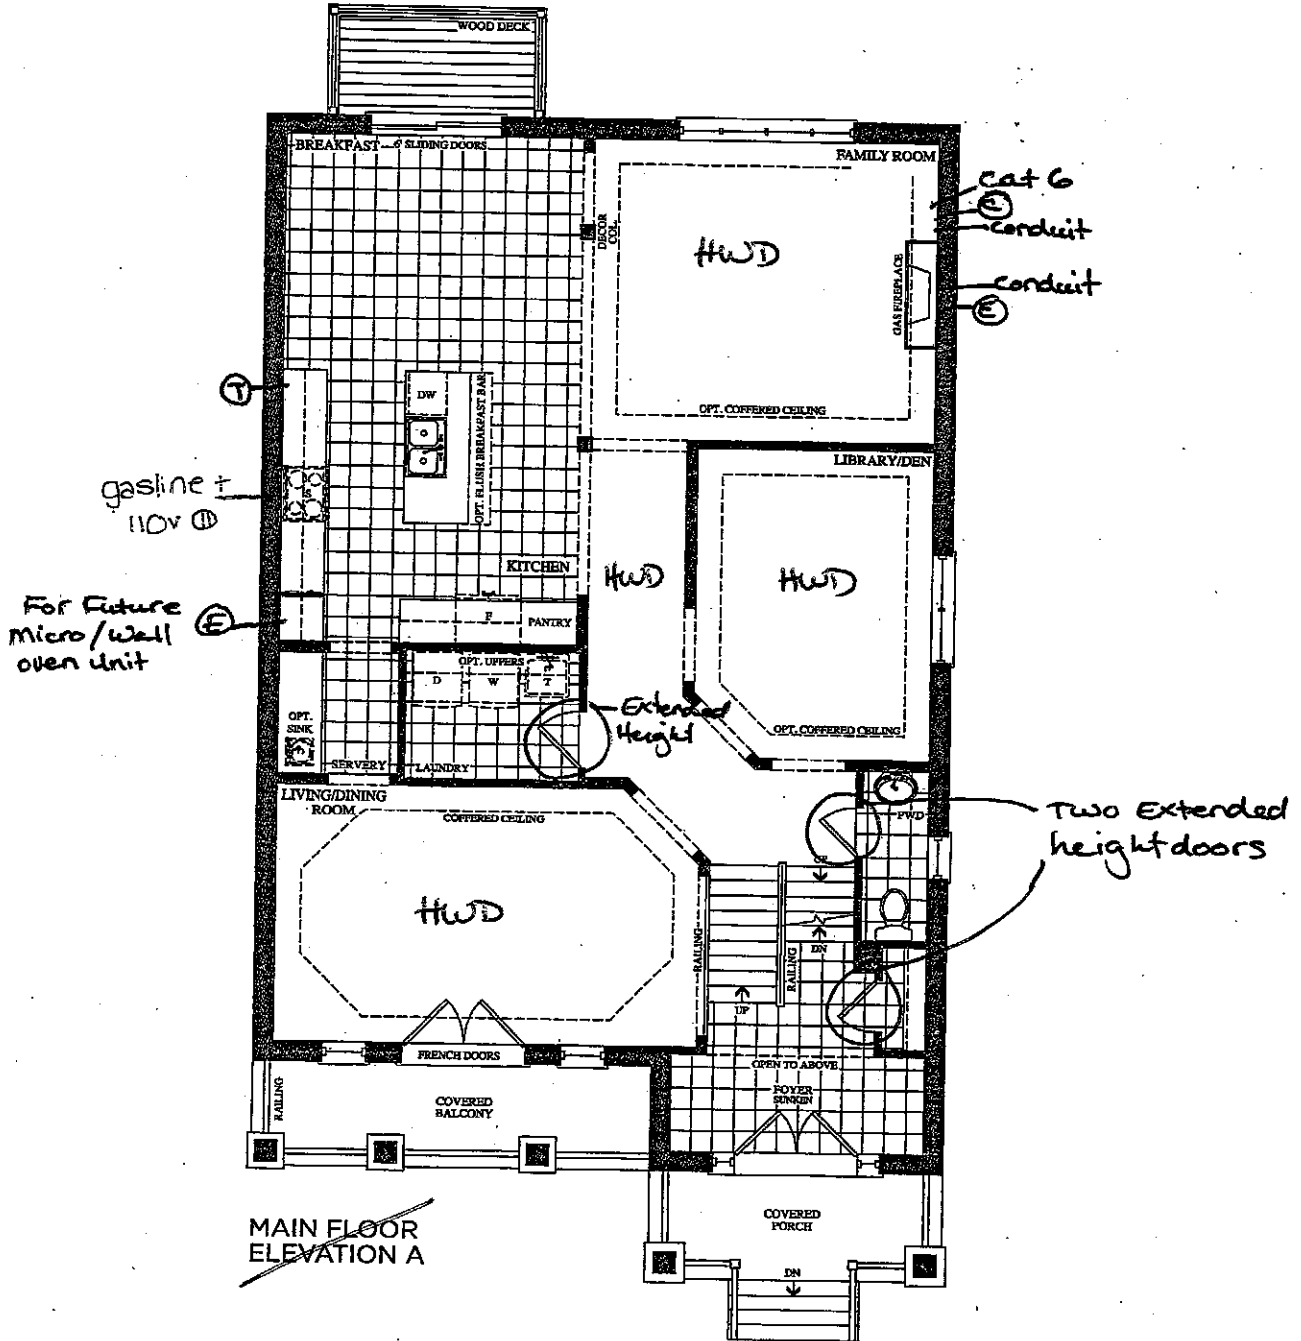

Lot 1  
May 30, 17  
②  
fn

Lot 1  
Dec. 5, 17  
②

Prices, figures, illustrations, sizes, features and finishes are subject to change without notice. E&O.E. Areas and dimensions are approximate and actual usable floor space may vary from the stated area. Layout may be reverse of the unit purchased. E. & O.E.

**GOLDPARK**  
HOMES


Telephone — (T) cat 6  
 Cable — (C)

**encore**  
 BRAMPTON


**The  
 Corelli**  
 38' SERIES

Elevation A • 3,878 sq.ft. | Elevation B • 3,878 sq.ft.

\*smooth ceilings

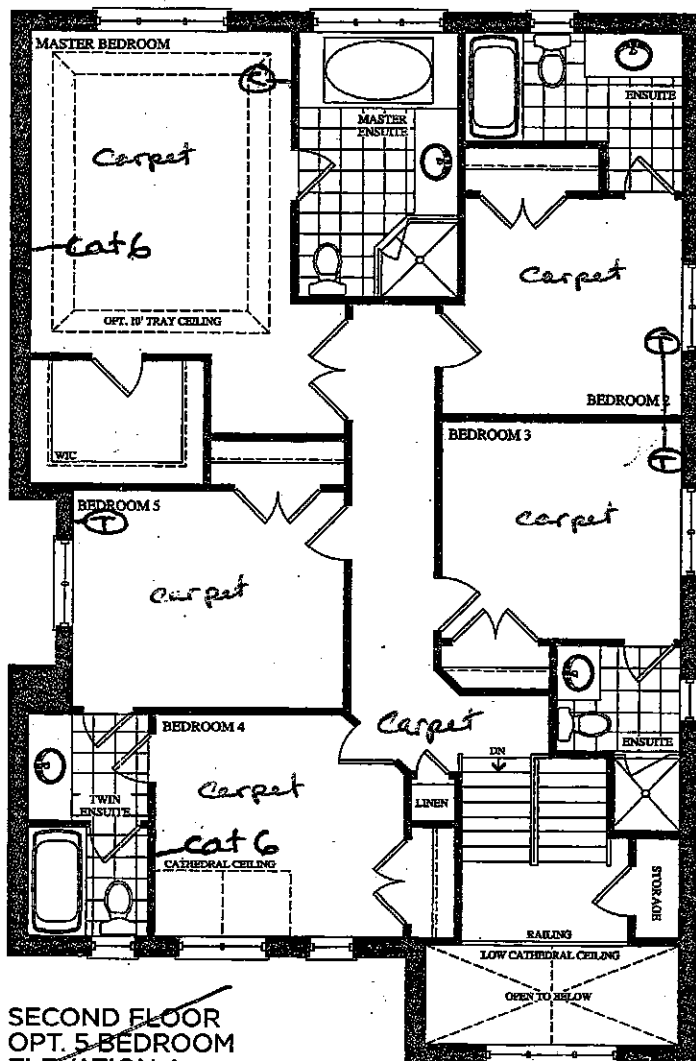

SECOND FLOOR  
 OPT. 5 BEDROOM  
 ELEVATION A

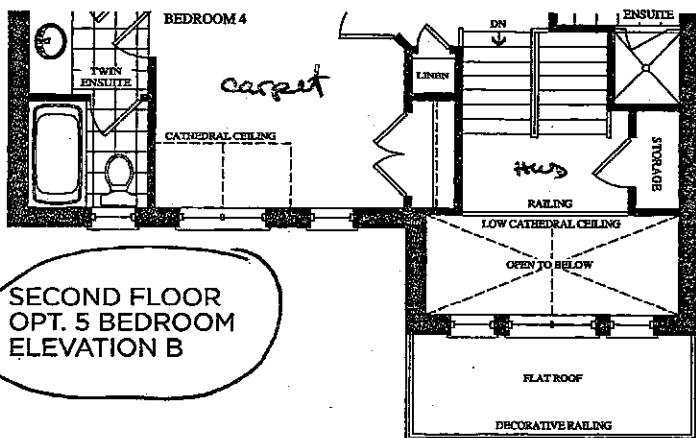

SECOND FLOOR  
 OPT. 5 BEDROOM  
 ELEVATION B

Lot 1  
 May 30, 17

Lot 1  
 Dec. 5, 17

(2)

(2)

M


Telephone — ①

encore  
BRAMPTON

# The Corelli 38' SERIES

Elevation A • 3,878 sq.ft. | Elevation B • 3,878 sq.ft.

\*smooth ceilings

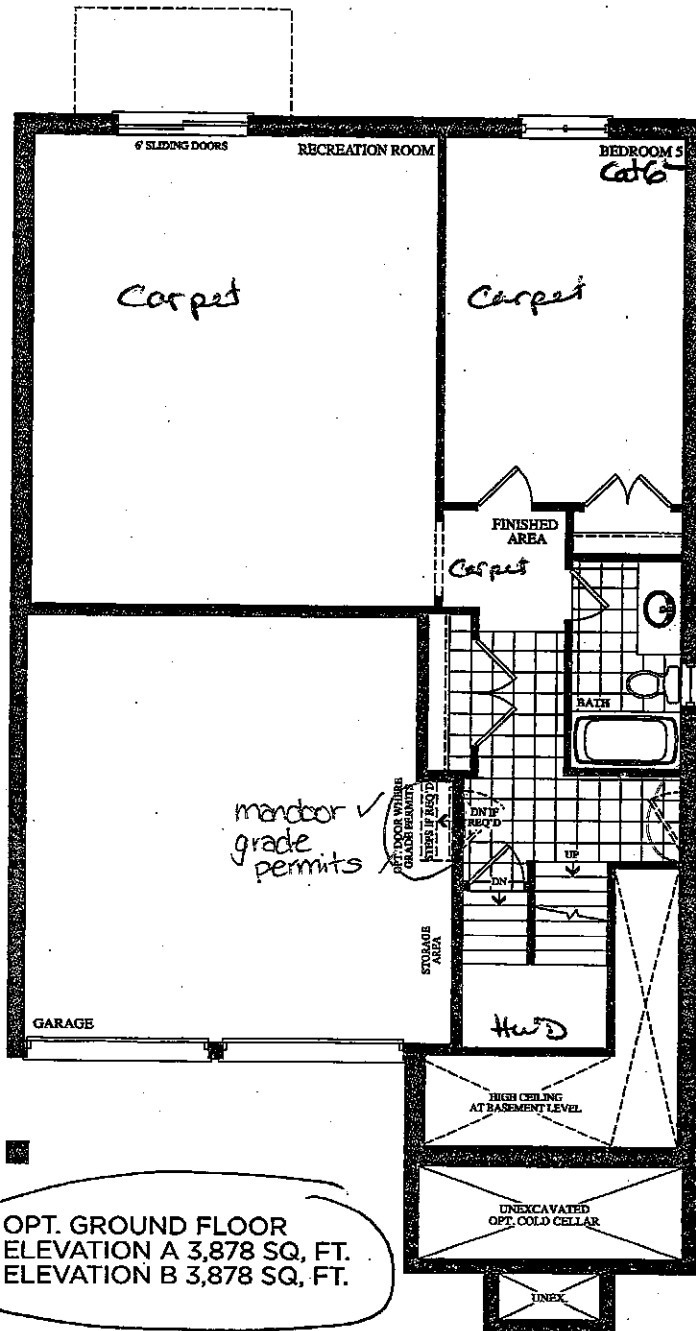

OPT. GROUND FLOOR  
ELEVATION A 3,878 SQ. FT.  
ELEVATION B 3,878 SQ. FT.

Lot 1  
Dec. 5, 17

②

Lot 1  
May 30, 17


③  
M

Prices, figures, illustrations, sizes, features and finishes are subject to change without notice. E.&O.E. Areas and dimensions are approximate and actual usable floor space may vary from the stated area. Layout may be reverse of the unit purchased. E. & O.E.

GOLDPARK  
HOMES

BSMNT WINDOWS  
2 x 30"x24"

Elevation A • 3,878 sq.ft. | Elevation B • 3,878 sq.ft.

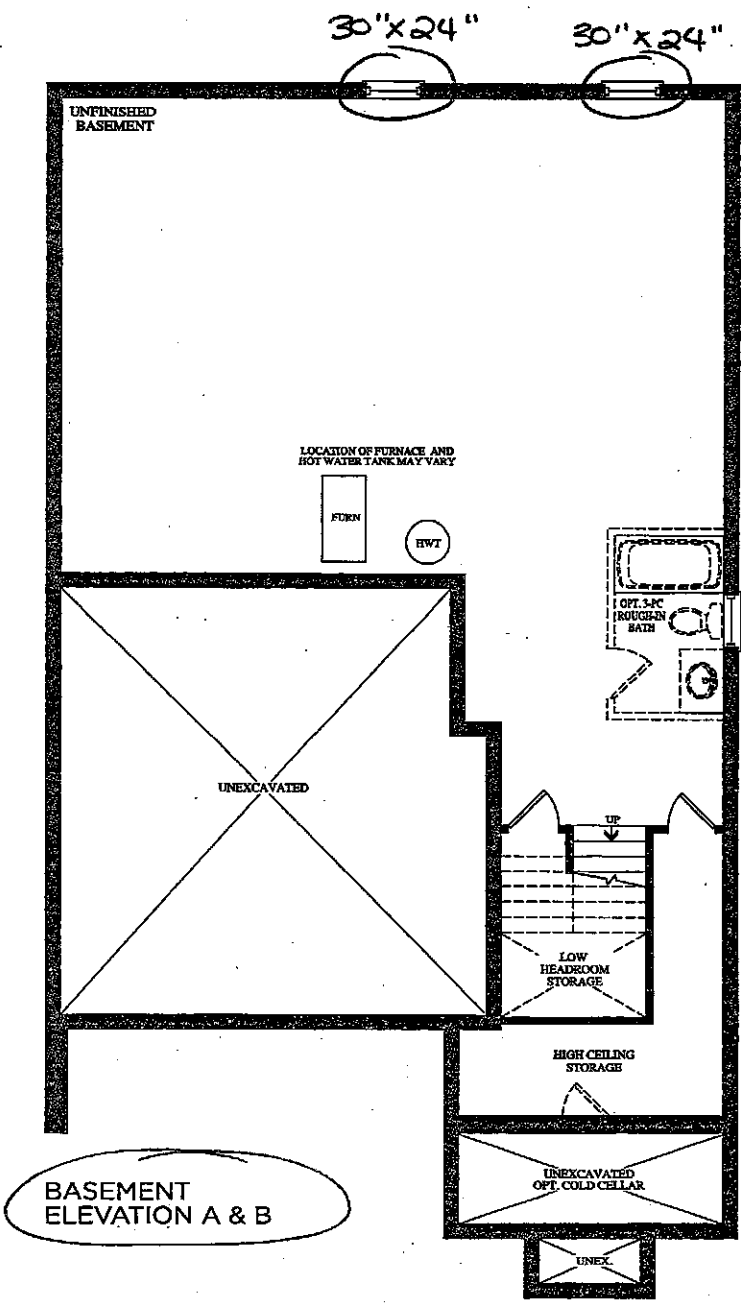

Lot 1  
Dec 5, 17  
(9)

Lot 1  
May 30, 17  
(9)  
M

Prices, figures, illustrations, sizes, features and finishes are subject to change without notice. E.&O.E. Areas and dimensions are approximate and actual usable floor space may vary from the stated area. Layout may be reverse of the unit purchased. E. & O.E.



Trade Name: Gold Park Homes

Site location: Brampton


Model: 38-8

Address:

Project: Encore

Phase:

This layout has been explained to the purchaser by Cortina Kitchens Inc. and is understood by the purchaser.

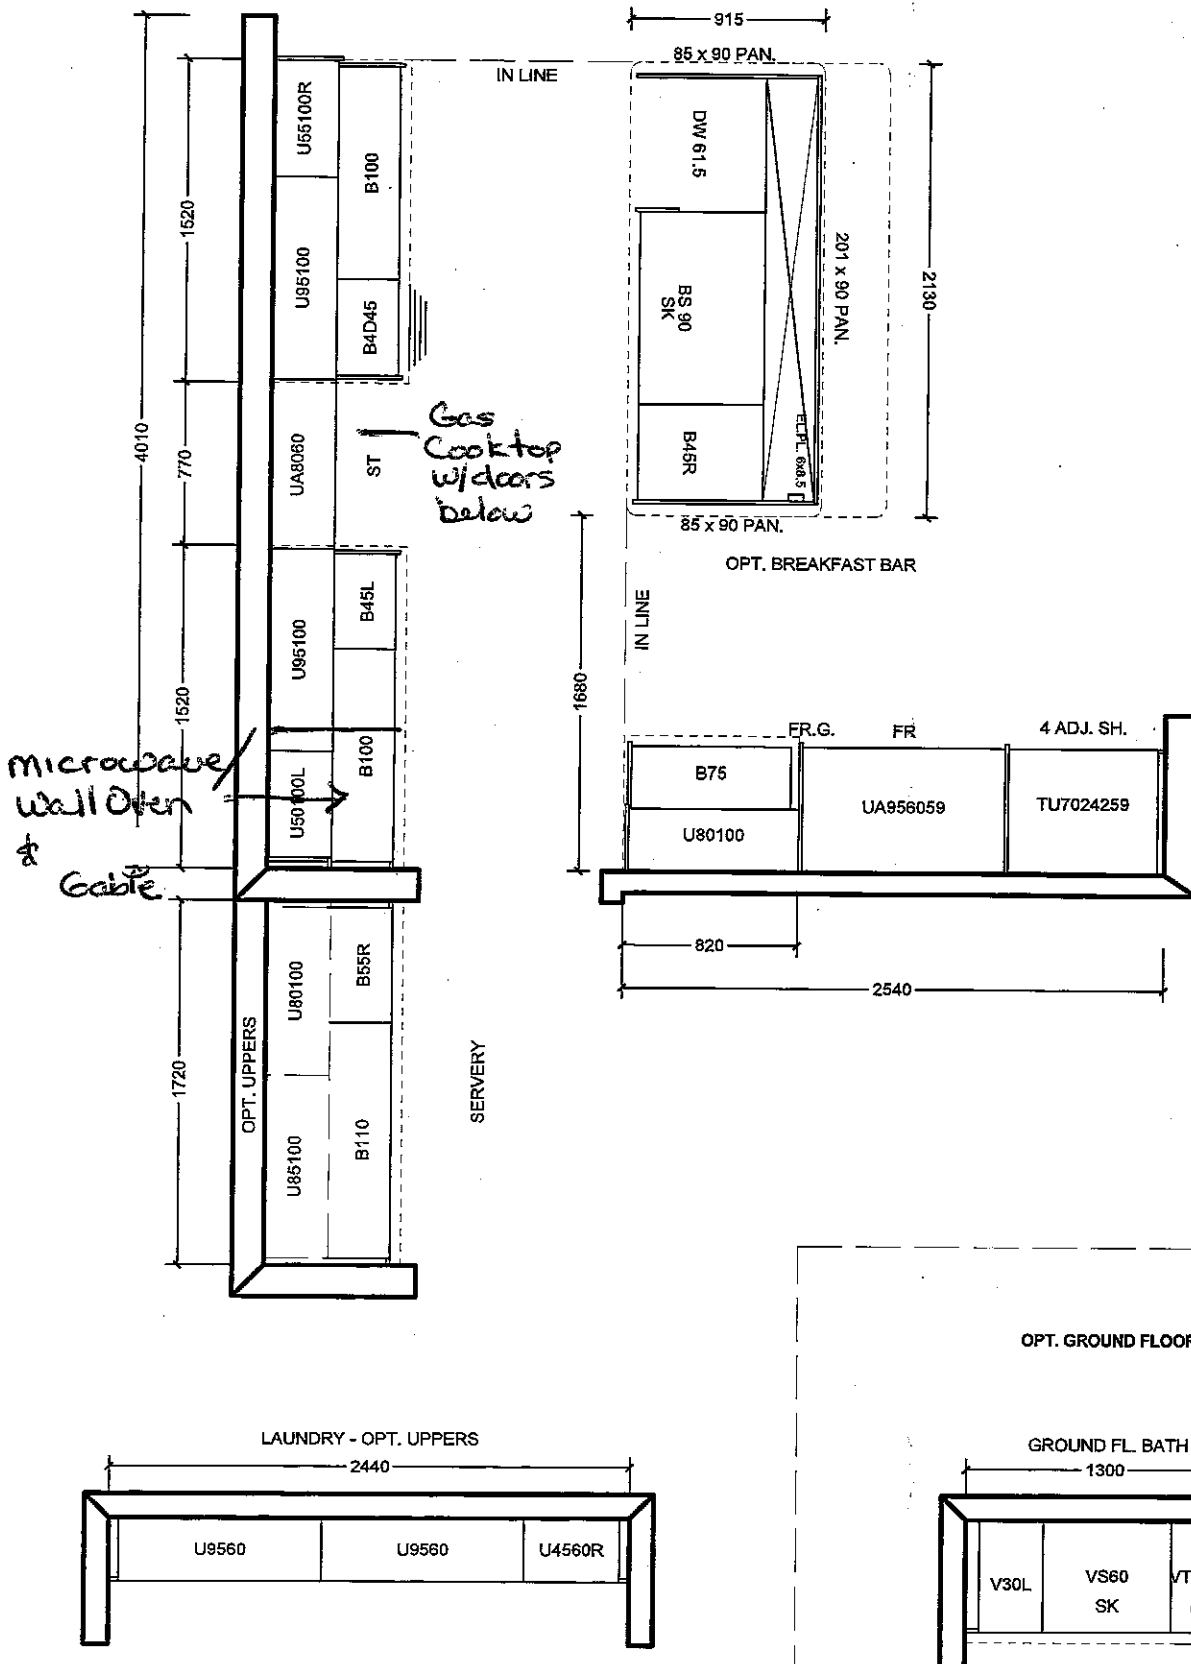

All prices subject to confirmation from head office.  
This quotation is subject to the terms & conditions set out in Cortina's Agreement of Purchase and Sale

All agreements are contingent upon strikes, accidents, and delay beyond our control.  
Please provide our installer with template for sinkholes or \$150.00 will be charged for callback.

ACCEPTED DATE: \_\_\_\_\_

CUSTOMER SIGNATURE

SALESPERSON SIGNATURE

CORTINA HEAD OFFICE APPROVAL

ITEM A. Wood grain and colour are characteristics of the product, we cannot guarantee that such grain and colour will always match  
ITEM B. Cortina Kitchens reserves the right to alter dimensions and make technical changes without notice.

# CORTINA

KITCHENS INC.

70 Regina Road Woodbridge ON L4L 8L6  
905-264-6464

## INFORMATION - PVC DOORS

Builder: Gold Park Homes Project: Encore 2 Lot #: 1

All cabinets with PVC (Thermofoil) Doors come with melamine gables, panels and kick. The doors, crown moulding and light valance are PVC wrapped. Open shelves incorporated in design will only be available with melamine interiors. There will be variations in colour shades between the PVC parts (doors, crown and Light valance) and the melamine parts (open shelves, Gables, Panels and Kick) due to the difference in material.

Furring Panel with crown moulding to the ceiling is not available on all PVC door styles due to subtle variations in colour shades between the PVC parts (moulding) and the melamine parts (furring panel) due to the difference in material. Grain directions in wood grain pattern melamine, vary between the furring panel, crown moulding (horizontal) and the PVC doors (vertical).

Thank you for your understanding.

---

I am well informed of this information, and agree to the purchase of the above.

Purchaser: Harjit Kaur Bhandal Date: Dec. 5, 17

Lot 1  
Dec. 5, 17  
④


**GOLDPARK**  
WORTH MORE




Granite, Marble,  
Engineered Surfaces

- Standard 2CM & 3CM
- ⊖ Upgrade 1 2CM & 3CM
- ⊗ Upgrade 1 4 CM
- Upgrade 2


**20 mm (3/4") Profiles**

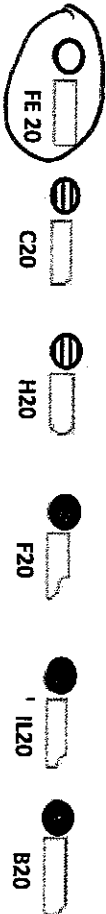

**30mm (1 1/4") Profiles**

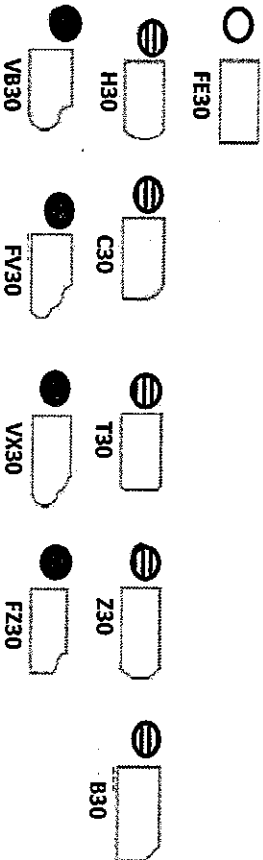

**40mm (1 1/2") Profiles**

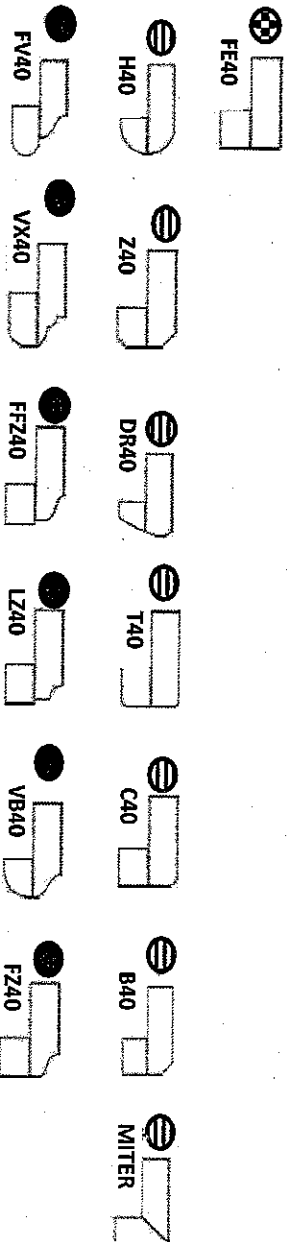

Note: All colours may not be available in 30mm at time ordered. Vendor reserves the right to use 40 mm edges (by lamination process).

\*Mitre edge is available in Upgrade 1 for an overall thickness of 2". All other Mitre edge options will be an Upgrade 2 Edge.


Lot 1

Dec. 5, 17

2




CSI-6

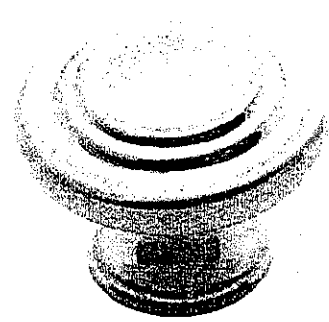


CSI-10




CSI-14

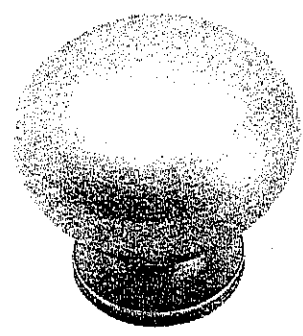


CSI-16

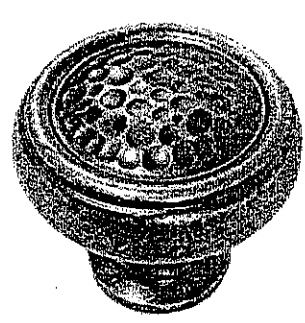


CSI-18

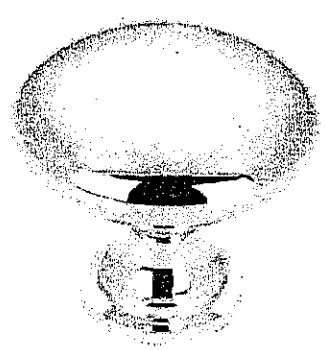


CSI-19

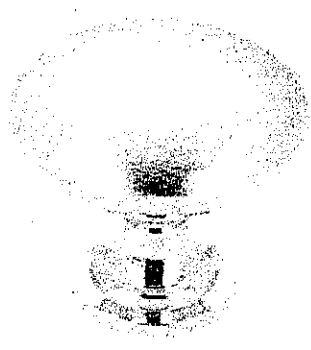


CSI-20

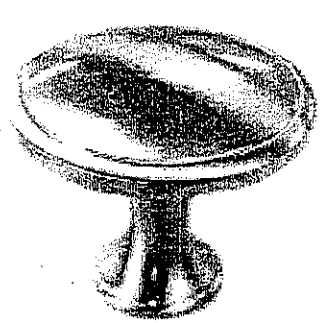


CSI-21

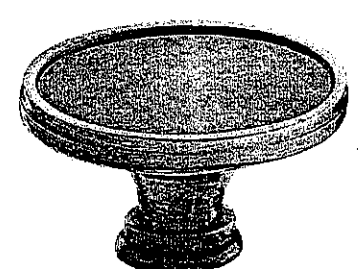


CSI-22

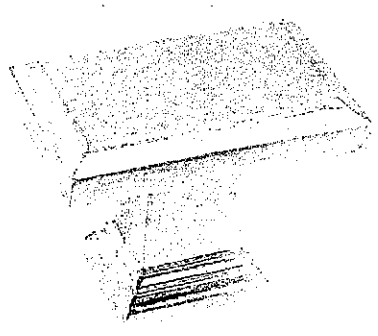

CSI-23

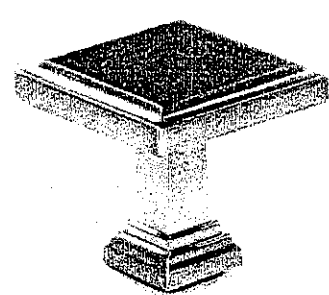

CSI-24

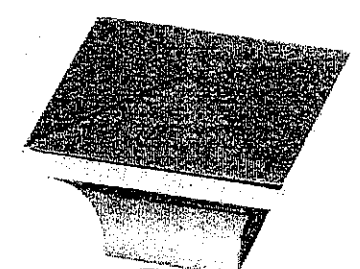

CSI-25

Kitchen  
Twin  
Master  
Brs. 2  
Ground Floor

**\*NOTES:**  
- IMAGES ARE FOR QUICK REFERENCE PURPOSES ONLY  
- ACTUAL SIZES AND FINISHES AS PER HARDWARE  
SAMPLE BOARD PROVIDED TO DECOR CENTRE

*Gold Park Homes Décor*

**GOLDPARK**  
WORTH MORE™

## *Centre Disclaimers*

*Through years of doing business, we at Gold Park Homes have encountered issues beyond our control. The following disclaimers apply to all instances of Purchaser's Extras forms and all Interior Colour Scheme forms.*

### **FIREPLACES**

Fireplace Marble: Due to the many variables that can affect the pattern and/or design, frequently the marble installed on the fireplace will not be identical to the samples. We will make every attempt to come as close to the samples as possible, but cannot be responsible for results which differ from the samples.

### **CERAMIC FLOOR TILE**

Many variables including variegation can affect tile colour, pattern and/or design which mean installed tiles may not be identical to the samples. We will make every attempt to come as close as possible, but cannot be responsible for results which differ from the samples.

### **HARDWOOD FLOORING**

The purchaser is advised that cupping and shrinkage are characteristics of hardwood flooring normally appearing after installation, especially when humidity levels are not regulated, and no warranty is provided by the flooring supplier with respect to such cupping and shrinkage. Furthermore, hardwood floors may also heave and warp when located at or close to entrance points of the home, where rain could make its way to the flooring. The vendor agrees to install any hardwood flooring ordered by the purchaser in a good and workmanlike manner, but shall not be responsible for, and is hereby released by the purchaser from responsibility and liability for cupping, shrinkage, heaving and warping of hardwood flooring in the above mentioned circumstances.

### **STAIRCASE VS FLOORING WOOD SPECIES DIFFERENCE**

The purchaser is aware and therefore accepts and acknowledges that the wood species of the staircase and flooring chosen do not match. This difference might result in an undesirable colour variance.

The purchaser is aware and therefore accepts and acknowledges that though the flooring is of the same species as the staircase the difference in product finishing may result in a stain colour variance.

The purchaser agrees that the vendor is to be exempt from any and all claims by the purchaser regarding this colour variance.

### **RAILINGS**

All railings, pickets, posts, nosing's and stairs come from solid wood and veneered wood materials sourced from multiple locations and sources. As such there will be variations in grains and shades between the various natural components beyond our control. Due to this variance in material, all components will stain with colour or natural finish differently.

Iron pickets are wrought in nature and depending on the manufacturing process will have differences from picket to picket which is normal. Also the finish of the iron pickets is of a powder coated nature. This process can produce minor colour variations or tones. Furthermore, the assembly of the metal pickets can develop a natural rattle over time from vibration in the railing. Minor rattling is normal and is a part of the wrought iron picket assembly.

### **HOUSE EXTERIORS**

Variations in subcontractors across different sites and varying site conditions may result in house exteriors that differ from the artist renderings. We cannot be responsible for results which differ from the artists renderings of elevations.

### **PLASTER MOULDINGS AND MEDALLIONS**

Plaster mouldings will not be installed in open to above areas or areas with 2 storey elements.

### **STAIN COLOURS**

Due to the many variables that can affect the outcome of a stain colour on wood, staircases, railings, and fireplaces, the colour may not be identical to samples. Factors such as density, age, humidity, air temperature, and the uniqueness of each piece of wood can result in wide variations in darkness or lightness. We will make every attempt to come as close to the sample as possible, but cannot be responsible for results which differ from the samples.

Stain on pre-finished hardwood floors will not be an exact match to the stain colours available on stairs, pickets and rails. The purchaser is responsible for choosing the stain on these areas to their satisfaction.

### **IN-WALL CONDUIT FOR AUDIO/VIDEO CABLES**

It is important to note that due to the variation in framing requirements in different parts of your home, conduit lengths and routing can vary. In virtually all instances of ground floor installation (I.e. above a fireplace), conduit will first travel down into the basement below the floor joists, over to the termination point and back up into the main floor. As a result, it is best to measure the length of the conduit after occupancy with a "pull wire" before

purchasing your cables. For above-fireplace installations, the conduit wall plate will be installed approximately 10" above the Fireplace Mantle, unless otherwise specified in the Construction Summary.

#### **APPLIANCE SPECIFICATIONS**

All appliance openings are set to builder's standard openings. Please advise Décor Centre at time of your structural appointment if custom sizing of cabinets is required for any built - in appliances. The purchaser is responsible for costs and fees associated with changes to pre-manufactured kitchens made subsequent to colour appointments.

Purchaser accepts & acknowledges that in order to accommodate upgraded appliances, all appliance specifications should be provided at the time of their structural appointment, should this not occur they must be provided to the Décor Center within one (1) week of completion of structural chart. Failure to do so may result in the need to revert to the standard appliance openings or in a delay in construction of your dwelling, as well as a cost of \$500 to re-open your structural file should changes be required. As a result we may be forced to extend the closing of your transaction. Due to failure to complete the above-mentioned selections and at no fault of our own, we reserve our right to hold you responsible for this delayed closing, including charging extra administration cost and interest on the balance due on closing.

Purchasers Accept Standard Appliance Openings (unless otherwise specified):

Fridge - 37-1/2"W x 73-1/2" High Approx.

Range - 30-1/2"D x 31-1/2"W Approx.

Dishwasher - 24" W Approx.

#### **DELETION OF HOODFAN & CABINETS ABOVE STOVE:**

The purchasers are aware that in requesting NOT TO INSTALL builder's standard hood fan and standard cabinets above stove they will receive NO STANDARD HOOD FAN and NO CREDIT. Purchasers are installing their own hood fan after closing and accept that it may waive any warranty associated with such a change.

Purchasers accept and acknowledge that the exhaust fan duct hole may be off-centered with the stove in the kitchen due to purchasers installing their own hood fan after closing. The vendor is exempt from adjusting such openings for the purchasers range hood.

#### **ELECTRICAL FOR APPLIANCES**

Pricing is subject to change based on the appliance specifications provided. Purchasers should provide proper appliance specifications and cut-out sheets in order for Gold Park to price extras accordingly.

#### **KITCHEN CABINETS**

The kitchen you order/purchase will undoubtedly contain slight colour variations. The degree of these variations is virtually impossible to determine before the kitchen is installed in its intended location. The amount of and type of lighting will also affect various highlights in the finish. Note: No two pieces of wood are identical. Variations in colour tone and grain patterns make a perfect colour match virtually impossible. It is generally agreed that these variations add to the natural beauty of a wood kitchen.

#### **STAIN**

Charcoal is a spray stain applied to Oak and Maple products with several characteristics that are important to be aware of when purchasing this product.

1. Shadow lines may be visible at the interior profile edges of a door or drawer front. If movement occurs shadow lines may increase or decrease, depending on the style and/or size of a door or drawer front.
2. Variation and unevenness may be visible in the finish.
3. Hairline cracks at the joints are created over time due to the nature of natural wood, caused by usage, humidity\*\*, or dryness. They tend to be more visible to darker stains, than lighter wood stains.

\*\* Relative humidity is recommended to be between 45% and 55%. Please refer to Cortina Kitchens "Cleaning, Care, Maintenance, & Warranty Information" guide.

Please be advised that Cortina Kitchens will not replace doors and/or parts that exhibit the above characteristics associated with this finish. These characteristics are not avoidable and are a result of the natural characteristics of wood and wood veneer, and the characteristics of darker stains on wood. The Charcoal stain is not available on doors in Group IV, Group IVA, Group V and Group VA.

Cortina Kitchens offers a wide variety of finishes, applied to oak and maple products. The subject finishes include the spray stains Cocoa, Espresso, Graphite as well as wiping stain Ebony.

Due to the very dark stains applied on natural maple and oak doors and joints, several characteristics are important to be noted when purchasing these products.

1. Shadow lines may be visible at the interior profile edges of a door or drawer front. If movement occurs shadow lines may increase or decrease, depending on the style and/or size of a door or drawer front.
2. Variation and unevenness may be visible in the finish.
3. Hairline cracks at the joints are created over time due to the nature of natural wood, caused by usage, humidity, or dryness. They tend to be more visible to darker stains, than lighter wood stains.

Please be advised that Cortina Kitchens will not replace doors nor parts that exhibit the above characteristics associated with this finish. These characteristics are not avoidable and are a result of the natural characteristics of wood and wood veneer, and the characteristics of darker stains on wood.

### **CABINETRY DOOR HARDWARE**

Cortina Kitchens' cabinetry doors and drawer fronts will be drilled to accept a standard knob or handle selected from Cortina's hardware boards. This drilling comes standard with the order, and is done ONLY in our shop, not on the job site.

For those not wanting Cortina's hardware drilling, the following applies:

No holes to be drilled on the doors and drawer fronts should be specified in writing on the colour chart and the P.O. If while in production, Cortina Kitchens misses this request, Cortina Kitchens and the Builder will not be held responsible to replace any or all doors and drawer fronts affected, and the customer agrees to accept the product as is. No hardware will be supplied or credited by Cortina Kitchens with this request. No charge will apply for this request.

### **PVC DOORS**

All cabinets with PVC (Thermofoil) Doors come with melamine gables, panels and kick.

The doors, crown moulding and light valance are PVC wrapped. Open shelves incorporated in design will only be available with melamine interiors. There will be variations in colour shades between the PVC parts (doors, crown and Light valance) and the melamine parts (open shelves, Gables, Panels and Kick) due to the difference in material.

Furring Panel with crown moulding to the ceiling is not available on all PVC door styles due to subtle variations in colour shades between the PVC parts (moulding) and the melamine parts (furring panel) due to the difference in material. Grain directions in wood grain pattern melamine, vary between the furring panel, crown moulding (horizontal) and the PVC doors (vertical).

### **GRANITE, MARBLE ENGINEERED SURFACES WAIVER**

Granite and marble are naturally occurring products, and due to the many variables that can affect the pattern, colour and/or design and "pitting" of natural products slabs installed will not be identical to the samples displayed. We will make every attempt to come as close to the samples as possible, but cannot be responsible for results which differ from the samples. Every effort is made to provide granite counter tops as close as possible but the vendor is not responsible for results which differ from the sample displayed. All countertop surfaces may have seams & product pattern & shade can change in areas containing seams.

### **RESELECTIONS**

It is not uncommon for flooring, such as tile, to become discontinued prior to its installation. Therefore it may be necessary to make a reselection of certain materials sometime during the build process. We cannot assure you that another choice approximating your selection will be available.

### **PLANS**

Plans are subject to change without notice. Actual usable floor space may vary from the stated floor area. Layout for kitchen, furnace, HWT and laundry tub may vary from plan. Vertical and horizontal bulkhead, which are not shown on plan, may be required for plumbing and heating runs. E.& O.E.

### **PLEASE NOTE:**

In the event the work on the house has progressed beyond the point where the items covered by these invoices cannot be installed without entailing any unusual expense, then this order is to be cancelled and any deposit paid in connection with the same is to be refunded to the purchaser.

The vendor will undertake to incorporate the work covered by the sales extra in the construction of the house but will not be liable to the purchaser in any way, if for any reason the work covered by the extra is not carried out. In that event, any monies paid in connection with the same shall be returned to the purchaser.

It is understood and agreed that if for any reason whatsoever the transaction of Purchase and Sale is not completed, the total cost of extras ordered are not refundable to the Purchaser(s).

Extras or changes will not be processed unless signed by the Vendor.

These extras may not be amended without the written consent of Gold Park Homes.

The purchaser(s) and the builder acknowledge and agree that this "Purchaser's Extra" form shall not be deemed to be part of the agreement of purchase and sale entered into between them, nor an addendum thereto.

No postdated cheques will be accepted.

No estimates or orders will be accepted once construction has commenced.

Should a refund be requested on any extras purchased, an 80% reimbursement of the purchase price will be given. (a \$50.00 minimum charge and a maximum \$250.00 charge will apply)

Estimates will only be considered when resubmitted on a signed Purchaser Extras form, accompanied by payment in full.

All prices are estimates only and may be subject to change. Should a change in price occur Gold Park Homes reserves the right to request from the purchaser an adjustment of the price or a refund limited to that item.

Purchasers are aware & accept that ANY changes made to upgrades after signing the Purchasers Extra Form are subject to a minimum administration fee of \$500. PLUS a 10% holdback fee.

Purchasers are aware that any request to add a percentage of upgrades from the purchaser's extras form will be processed only after the builder receives approval letter from the bank.

Please be advised that your failure to finalize your structural or colour selections may result in a delay in construction of your dwelling and we may have to extend closing of your transaction. Due to failure to complete the above-mentioned selections and at no fault of us, we reserve our right to hold you responsible for a delayed closing, including charging extra administration cost and interest on the balance due on closing.

Purchaser has attended a Colour appointment at the Decor Centre & has DECLINED any additional upgrades and accepts and acknowledges that there will be no further structural changes/additions/deletions to be made upon signing.

I hereby acknowledge reading and understanding the above copy and will not hold Gold Park Homes responsible for any issues in relation to above.

Purchasers Signatures

Harjit Kaur Bhandal

Date

Dec-5, 17

\_\_\_\_\_