

Brampton Encore - 64R - 2 - 28-7 Elev.D Wagner

CENTRAL VAC AND WIRING

Inv.1,537	1 - TELEPHONE AND CABLE ROUGH-IN LOCATIONS
Line23659	Note:
31Jul17 / 23Nov17	
Inv.1,537	1 - FAMILY ROOM: INSTALL CONDUIT PIPE- FOR TELEVISION- MUST SPECIFY LOCATION AND TERMINATION POINT
Line23688	Note:
31Jul17 / 23Nov17	

CERAMIC

Inv.1,778	1 - FOYER: INSTALL 5TH UPGRADE FLOOR TILE THROUGHOUT FOYER
Line26123	Note:
1Mar18 / 16May18	
Inv.1,778	1 - KITCHEN: INSTALL 4TH UPGRADE FLOOR TILE THROUGHOUT KITCHEN
Line26125	Note:
1Mar18 / 16May18	
Inv.1,778	1 - POWDER ROOM: INSTALL 5TH UPGRADE FLOOR TILE THROUGHOUT POWDER ROOM
Line26124	Note:
1Mar18 / 16May18	
Inv.1,778	1 - MASTER ENSUITE: INSTALL 1ST UPGRADE FLOOR TILE THROUGHOUT MASTER ENSUITE FLOOR, TUB TOP, FACE, SURROUND (ROWS). SHOWER WALL AND SHOWER CEILING
Line26126	Note:
1Mar18 / 16May18	

ELECTRICAL

Inv.1,537	1 - FAMILY ROOM: INSTALL 110V WALL RECEPTACLE ON DEDICATED CIRCUIT - ABOVE FIREPLACE FOR FUTURE TV
Line23689	Note:
31Jul17 / 23Nov17	
Inv.1,537	1 - LIVING ROOM: INSTALL ROUGH - IN CEILING OUTLET & SWITCH (WITH COVER PLATE) - DOES NOT INCLUDE FIXTURE - MUST SPECIFY LOCATION
Line23684	Note:
31Jul17 / 23Nov17	
Inv.1,537	1 - KITCHEN: INSTALL GAS LINE ROUGH - GROUND FLOOR- (2-STOREY MODELS) FOR STOVE, INCLUDES 110V PLUG
Line24812	Note:
31Jul17 / 23Nov17	

Exterior Colours

Inv.1,537	1 - EXTERIOR COLOUR PACKAGE #8
Line24813	Note:
31Jul17 / 23Nov17	

GRANITE MARBLE QUARTZ

Inv.1,778	1 - KITCHEN: INSTALL 3RD CEASARSTONE GRANITE THROUGHOUT KITCHEN (STD. EDGE)
Line26127	Note:
1Mar18 / 16May18	

Brampton Encore - 64R - 2 - 28-7 Elev.D Wagner

Inv.1,778	1 - KITCHEN: INSTALL FLUSH BREAKFAST BAR ON KITCHEN ISLAND (3RD UPGRADE GRANITE, STD. EDGE)
Line26128	Note:
1Mar18 / 16May18	
Inv.1,778	1 - MAIN BATH: INSTALL 2ND UPGRADE CEASARSTONE ON MAIN BATH VANITY (STD. EDGE)
Line26129	Note:
1Mar18 / 16May18	
Inv.1,778	1 - MASTER ENSUITE: INSTALL 2ND UPGRADE GRANITE ON MASTER ENSUITE BATH VANITY (STD. EDGE)
Line26130	Note:
1Mar18 / 16May18	

HARDWOOD

Inv.1,778	1 - MAIN FLOOR: INSTALL 2ND UPGRADE HARDWOOD THROUGHOUT MAIN FLOOR AND LANDINGS- FAMILY ROOM, FORMAL ROOM AND LANDINGS
Line26121	Note:
1Mar18 / 16May18	

HVAC

Inv.1,537	1 - INSTALL 2.5 TON AIR CONDITIONER
Line23685	Note:
31Jul17 / 23Nov17	
Inv.1,537	1 - KITCHEN: INSTALL GAS LINE ROUGH - GROUND FLOOR- (2-STOREY MODELS) FOR STOVE, INCLUDES 110V PLUG
Line23663	Note:
31Jul17 / 23Nov17	

KITCHEN AND BATH CABINETRY

Inv.1,778	1 - MAIN BATH: INSTALL UPGRADE STAIN ON MAIN BATH CABINETS
Line26133	Note:
1Mar18 / 16May18	
Inv.1,778	1 - KITCHEN: INSTALL TWO-TONE CABINETS IN KITCHEN. ISLAND IS A DIFFERENT COLOUR FROM THE REST OF THE CABINETRY
Line26134	Note:
1Mar18 / 16May18	

MISC.

Inv.1,537	1 - BONUS PACKAGE: \$5000.00 (INCLUDING TAXES) WORTH OF UPGRADES FROM GOLD PARK HOMES DÉCOR CENTRE IS BEING APPLIED TOWARD THE STRUCTURAL APPOINTMENT. PURCHASER HAS A REMAINING AMOUNT OF \$0.00 (INCLUDING TAXES) TO BE USED TOWARD THE COLOUR APPOINTMENT
Line23665	Note:
31Jul17 / 23Nov17	
Inv.1,537	1 - Purchaser has attended a Structural appointment at the Decor Centre & has DECLINED any additional upgrades and accepts and acknowledges that there will be no further structural changes/additions/deletions to be made upon signing on July 31, 2017
Line23666	Note:
31Jul17 / 23Nov17	
Inv.1,537	1 - Purchasers are aware & accepts that ANY changes made to upgrades after signing this Purchasers Extra Form are subject to a minimum administration fee of \$500. PLUS a 10% holdback fee.
Line23667	Note:
31Jul17 / 23Nov17	

Brampton Encore - 64R - 2 - 28-7 Elev.D Wagner

Inv.1,778	1 - Purchaser has attended a Colour appointment at the Decor Centre & has DECLINED any additional upgrades and accepts and acknowledges that there will be no further structural changes/additions/deletions to be made upon signing on March 1, 2018.
Line26135	Note:
1Mar18 / 16May18	
Inv.1,778	1 - Purchasers are aware & accepts that ANY changes made to upgrades after signing this Purchasers Extra Form are subject to a minimum administration fee of \$500. PLUS a 10% holdback fee
Line26136	Note:
1Mar18 / 16May18	

PAINTING

Inv.1,778	1 - STAIRCASE: STAIN STAIRS TO UPGRADE 2 GOTHAM RED OAK
Line26122	Note: PRICE INCLUDES UPGRADE 2 STAIN
1Mar18 / 16May18	

PLUMBING

Inv.1,537	1 - KITCHEN: INSTALL ROUGH-IN - WATERLINE FOR FRIDGE
Line23664	Note:
31Jul17 / 23Nov17	
Inv.1,778	2 - MASTER ENSUITE: INSTALL TWO (X2) UNDERMOUNT SINKS
	CALVIN 19 1/4"
	#4220CFY
Line26131	Note:
1Mar18 / 16May18	
Inv.1,778	1 - MAIN BATH: INSTALL ONE (X1) UNDERMOUNT SINK
	CALVIN 19 1/4"
	#4220CFY
Line26132	Note:
1Mar18 / 16May18	

Scheduled Closing Date: October-05-18

Purchaser: Saqib Kamran
Telephone Res. / Bus: (905) 669-8116
Decor Advisor: Terri Parisani

Property: 64R
Project: Brampton Encore - Phase 2
Model and Elevation: 28-7 Elev.D Wagner

Layout Changes: Yes No Sketch Attached: Yes No Exterior Colour Scheme:

1. Cabinetry

Table with 4 columns: Room, Style and Colour, Counter, Hardware. Rows include Kitchen / Breakfast, Laundry Room, Powder Room, MAIN BATH, Master Ensuite Bathroom, Second Ensuite Bathroom (If Applicable).

Comment
KITCHEN ISLAND TO BE DIFFERENT COLOUR CABINET
**KITCHEN CABINETS: Venice (pvc) White Crystal
**KITCHEN ISLAND: Venice (pvc) MYSTIC

2. Floor Tile

Table with 2 columns: Room, Selection. Rows include Entrance Vestibule, Main Hall, Kitchen / Breakfast, Laundry Room, Powder Room, MAIN BATH, Master Ensuite Bathroom, Second Ensuite Bathroom (If Applicable), Lower Landing (If Applicable).

Comment

3. Wall Tile

Table with 3 columns: Room, Selection, Listello/Inserts, Describe. Rows include MAIN BATH, Master Ensuite Bathroom (Tub Deck, Shower Stall, Bathroom Walls), Second Ensuite Bathroom (If Applicable), Kitchen Backsplash.

Comment
MASTER ENSUITE FLOOR TILE: *UPG.1 NEW BYZANTINE PENTELIC GREY 13 X 13 - TO GO ON TUB DECK, WALL, SKIRT, SHOWER WALL AND CEILING

Purchaser: Saqib Kamran
Telephone Res. / Bus: (905) 669-8116
Decor Advisor: Terri Parisani

Property: 64R
Project: Brampton Encore - Phase 2
Model and Elevation: 28-7 Elev.D Wagner

4. Plumbing Fixtures

<input type="checkbox"/>	Second Ensuite	<input type="checkbox"/>	Powder Room	<input type="checkbox"/>
Master Ensuite Bathroom	<input type="checkbox"/>	Other Room - Specify	<input type="checkbox"/>	Other Washroom
<input type="text"/>				

Comment
ALL FIXTURES TO REMAIN AS STANDARD
TOTAL OF THREE (X3) CALVIN UNDERMOUNT SINKS. SEE INVOICE

5. Hardwood Flooring

	Type and Stain		Type and Stain
Main Hall	<input type="text"/>	Upper Landing	*UPG.2, 5" WHITE OAK GOTHAM
Kitchen / Breakfast	<input type="text"/>	Upper Hall	<input type="text"/>
Living Room	*UPG.2, 5" WHITE OAK GOTHAM	Master Bedroom	<input type="text"/>
Dining Room	<input type="text"/>	Bedroom #2	<input type="text"/>
Family Room	*UPG.2, 5" WHITE OAK GOTHAM	Bedroom #3	<input type="text"/>
Den/Library	<input type="text"/>	Bedroom #4	<input type="text"/>
Entrance Vestibule	<input type="text"/>	Bedroom #5	<input type="text"/>
Lower Landing (If Applicable)	*UPG.2, 5" WHITE OAK GOTHAM	Other Room - Specify	<input type="text"/>

Comment
*UPGRADE 2 NORTHERN SOLID SAWN, CHARACTER PEARL, WHITE OAK 5" IN GOTHAM

6. Carpeting

	Upgrade	Description
Ground Floor	<input type="checkbox"/>	<input type="text"/>
Second Floor	<input type="checkbox"/>	11077 TEMPLAR
<input type="text"/>	<input type="checkbox"/>	<input type="text"/>

Upgrade Underpad	Type	Area
	STANDARD	<input type="text"/>
Carpet on Stairs	Capped	Runner - *Upgrade
	<input type="text"/>	<input type="text"/>

Comment

7. Fireplace

	Living Room			Family Room			Other Room - Specify		
	Purchased	As Per Plan	N/A	Purchased	As Per Plan	N/A	Purchased	As Per Plan	N/A
Fireplace Type	<input type="radio"/>	<input type="radio"/>	<input checked="" type="radio"/>	<input type="radio"/>	<input checked="" type="radio"/>	<input type="radio"/>	<input type="radio"/>	<input type="radio"/>	<input checked="" type="radio"/>
Mantle Type	<input type="text"/>			STANDARD			<input type="text"/>		
Colour / Stain	<input type="text"/>			NF-20			<input type="text"/>		
Surround	<input type="text"/>			WHITE PAINT GRADE			<input type="text"/>		
Hearth	<input type="text"/>			NERO MARQUINA			<input type="text"/>		
	<input type="text"/>			NONE			<input type="text"/>		

Comment
X S.K

Scheduled Closing Date: October-05-18

Purchaser: Saqib Kamran
Telephone Res. / Bus: (905) 669-8116
Decor Advisor: Terri Parisani

Property: 64R
Project: Brampton Encore - Phase 2
Model and Elevation: 28-7 Elev.D Wagner

8. Trim Carpentry

Interior Doors STANDARD Front Door Glass Inserts STANDARD Door Handles STANDARD
Interior Trim STANDARD
Comment

9. Plaster Mouldings and Medallions

Standard Throughout Yes No N/A
Entrance Vestibule Kitchen/Breakfast
Main Hall Den/Library
Living Room Lower Landing
Dining Room Other Room - Specify
Family Room
Comment

10. Railings and Spindles

Railing Package STANDARD
Railing Colour *UPG. 2 GOTHAM RED OAK
Stringer / Riser *UPG. 2 GOTHAM RED OAK
Spindle Colour *UPG. 2 GOTHAM RED OAK
Treads *UPG. 2 GOTHAM RED OAK
Oak Stairs Yes No N/A
Comment
SEE ATTACHED DISCLAIMER

11. Wall Paint / Ceilings

Throughout Finished Areas WARM GREY
Trim Paint White
Smooth Ceilings
Ground Floor
Second Floor
Note
Comment
X S.K

*** NOTE: This is not an approved document. Document must be locked ***

Scheduled Closing Date: October-05-18

Purchaser: Saqib Kamran
Telephone Res. / Bus: (905) 669-8116
Decor Advisor: Terri Parisani

Property: 64R
Project: Brampton Encore - Phase 2
Model and Elevation: 28-7 Elev.D Wagner

12. Electrical

Hood Fan ☐ White ☒ Stainless ☐ N/A

Above Kitchen Cabinet Light ☐ Yes ☒ No

Below Kitchen Cabinet Light ☐ Yes ☒ No

Standard Appliances ☒

Over The Range Microwave ☐

Chimney Style Fan ☐

Comment

13. Heating and Air Conditioning

Air Conditioning

Gas Provisions Stove

Gas Provisions Dryer

Gas Provisions Barbecue


Comment

14. Additional Comments

15. Disclaimers and Notes

- 1) Colours of all materials are as close as possible to builder's selection, but not necessarily identical due to variances in manufacturing.
- 2) Any extras listed above are null and void unless accompanied by a separate invoice/amendment. Said invoice must be paid in full.
- 3) The Purchaser acknowledges that after Interior Colour Selection form is signed and dated, no further changes will be permitted other than re-selection due to unavailability. Purchaser's Initials
- 4) The Purchaser acknowledges reading and accepting the "Gold Park Homes Decor Centre Disclaimers" form. This document contains other miscellaneous disclaimers.

This Interior Colour Selection is final and approved by:

Signature:  Date: 01-03-18

Scheduled Closing Date: October-05-18

Purchaser: Saqib Kamran
Telephone Res. / Bus: (905) 669-8116
Decor Advisor: Terri Parisani

Property: 64R
Project: Brampton Encore - Phase 2
Model and Elevation: 28-7 Elev.D Wagner

Layout Changes: ☐ Yes ☒ No Sketch Attached: ☒ Yes ☐ No Exterior Colour Scheme:

1. Cabinetry

	Style and Colour	Counter	Hardware
Kitchen / Breakfast	**SEE NOTES BELOW	*UPG.3, #6270 STD. EDGE: FE-20	CS1-21
Laundry Room			
Powder Room			
MAIN BATH	SIENA (OAK) *GRAPHITE*	*UPG.2, #6141 STD. EDGE	CS1-24
Master Ensuite Bathroom	SIENA (OAK) SLATE	*UPG.2, ANDINO WHITE STD. EDGE	CS1-24
Second Ensuite Bathroom (If Applicable)			

Comment

KITCHEN ISLAND TO BE DIFFERENT COLOUR CABINET
**KITCHEN CABINETS: Venice (pvc) White Crystal
**KITCHEN ISLAND: Venice (pvc) MYSTIC

2. Floor Tile

	Selection
Entrance Vestibule	*UPG.5, IMPERIAL GREY POLISHED 24 X 24
Main Hall	
Kitchen / Breakfast	*UPG.4, IMPERIAL GREY POLISHED 12 X 24
Laundry Room	COSTA WHITE MATTE 13 X 13
Powder Room	*UPG.5, IMPERIAL GREY POLISHED 24 X 24
MAIN BATH	SERPENTINE BEYAZ 13 X 13
Master Ensuite Bathroom	*UPG.1 NEW BYZANTINE PENTELIC GREY 13 X 13
Second Ensuite Bathroom (If Applicable)	
Lower Landing (If Applicable)	

Comment

3. Wall Tile

	Selection	Listello/Inserts	Describe
MAIN BATH	SERPENTINE BEYAZ 8 X 10	<input type="radio"/> Yes <input checked="" type="radio"/> No	
Master Ensuite Bathroom			
Tub Deck	*UPG. 1, SEE NOTES BELOW	<input type="radio"/> Yes <input checked="" type="radio"/> No	
Shower Stall	*UPG. 1, SEE NOTES BELOW	<input type="radio"/> Yes <input checked="" type="radio"/> No	
Bathroom Walls	*UPG. 1, SEE NOTES BELOW	<input type="radio"/> Yes <input checked="" type="radio"/> No	
Second Ensuite Bathroom (If Applicable)		<input type="radio"/> Yes <input type="radio"/> No	
		<input type="radio"/> Yes <input type="radio"/> No	
Kitchen Backsplash	<input type="radio"/> Yes <input checked="" type="radio"/> No	Backsplash Behind Fridge	

Comment

MASTER ENSUITE FLOOR TILE: *UPG.1 NEW BYZANTINE PENTELIC GREY 13 X 13 - TO GO ON TUB DECK, WALL, SKIRT, SHOWER WALL AND CEILING

X S.K

Scheduled Closing Date: October-05-18

Purchaser: Saqib Kamran
Telephone Res. / Bus: (905) 669-8116
Decor Advisor: Terri Parisani

Property: 64R
Project: Brampton Encore - Phase 2
Model and Elevation: 28-7 Elev.D Wagner

4. Plumbing Fixtures

<input type="checkbox"/>	Second Ensuite	<input type="checkbox"/>	Powder Room	<input type="checkbox"/>
Master Ensuite Bathroom <input type="checkbox"/>	Other Room - Specify <input type="checkbox"/>	<input type="checkbox"/>	Other Washroom	<input type="checkbox"/>

Comment

ALL FIXTURES TO REMAIN AS STANDARD

TOTAL OF THREE (X3) CALVIN UNDERMOUNT SINKS. SEE INVOICE

5. Hardwood Flooring

	Type and Stain		Type and Stain
Main Hall	<input type="text"/>	Upper Landing	*UPG.2, 5" WHITE OAK GOTHAM
Kitchen / Breakfast	<input type="text"/>	Upper Hall	<input type="text"/>
Living Room	*UPG.2, 5" WHITE OAK GOTHAM	Master Bedroom	<input type="text"/>
Dining Room	<input type="text"/>	Bedroom #2	<input type="text"/>
Family Room	*UPG.2, 5" WHITE OAK GOTHAM	Bedroom #3	<input type="text"/>
Den/Library	<input type="text"/>	Bedroom #4	<input type="text"/>
Entrance Vestibule	<input type="text"/>	Bedroom #5	<input type="text"/>
Lower Landing (If Applicable)	*UPG.2, 5" WHITE OAK GOTHAM	Other Room - Specify	<input type="text"/>

Comment

*UPGRADE 2 NORTHERN SOLID SAWN, CHARACTER PEARL, WHITE OAK 5" IN GOTHAM

6. Carpeting

	Upgrade	Description
Ground Floor	<input type="checkbox"/>	<input type="text"/>
Second Floor	<input type="checkbox"/>	11077 TEMPLAR
<input type="text"/>	<input type="checkbox"/>	<input type="text"/>

Upgrade Underpad	Type	Area
	STANDARD	<input type="text"/>
Carpet on Stairs	Capped	Runner - *Upgrade
	<input type="text"/>	<input type="text"/>

Comment

7. Fireplace

	Living Room			Family Room			Other Room - Specify		
	Purchased	As Per Plan	N/A	Purchased	As Per Plan	N/A	Purchased	As Per Plan	N/A
	<input type="radio"/>	<input type="radio"/>	<input checked="" type="radio"/>	<input type="radio"/>	<input checked="" type="radio"/>	<input type="radio"/>	<input type="radio"/>	<input type="radio"/>	<input checked="" type="radio"/>
Fireplace Type	<input type="text"/>			STANDARD			<input type="text"/>		
Mantle Type	<input type="text"/>			NF-20			<input type="text"/>		
Colour / Stain	<input type="text"/>			WHITE PAINT GRADE			<input type="text"/>		
Surround	<input type="text"/>			NERO MARQUINA			<input type="text"/>		
Hearth	<input type="text"/>			NONE			<input type="text"/>		

Comment

X S.K

Scheduled Closing Date: October-05-18

Purchaser: Saqib Kamran

Property: 64R

Telephone Res. / Bus: (905) 669-8116

Project: Brampton Encore - Phase 2

Decor Advisor: Terri Parisani

Model and Elevation: 28-7 Elev.D Wagner

8. Trim Carpentry

Interior Doors Front Door Glass Inserts Door Handles

Interior Trim

Comment

9. Plaster Mouldings and Medallions

Standard Throughout ☐ Yes ☐ No ☒ N/A

Entrance Vestibule Kitchen/Breakfast

Main Hall Den/Library

Living Room Lower Landing

Dining Room Other Room - Specify

Family Room

Comment

10. Railings and Spindles

Railing Package

Railing Colour Spindle Colour

Stringer / Riser Treads

Comment

Oak Stairs ☒ Yes ☐ No ☐ N/A

SEE ATTACHED DISCLAIMER

11. Wall Paint / Ceilings

Throughout Finished Areas

Trim Paint

Smooth Ceilings

Ground Floor ☐

Second Floor ☐

Note

Comment

X S.K

Scheduled Closing Date: October-05-18

Purchaser: Saqib Kamran

Property: 64R

Telephone Res. / Bus: (905) 669-8116

Project: Brampton Encore - Phase 2

Decor Advisor: Terri Parisani

Model and Elevation: 28-7 Elev.D Wagner

12. Electrical

Hood Fan ☐ White ☒ Stainless ☐ N/A

Above Kitchen Cabinet Light ☐ Yes ☒ No

Below Kitchen Cabinet Light ☐ Yes ☒ No

Standard Appliances ☒

Over The Range Microwave ☐

Chimney Style Fan ☐

Comment

13. Heating and Air Conditioning

Air Conditioning

Gas Provisions Stove

Gas Provisions Dryer

Gas Provisions Barbecue

Comment

14. Additional Comments

15. Disclaimers and Notes

- 1) Colours of all materials are as close as possible to builder's selection, but not necessarily identical due to variances in manufacturing.
- 2) Any extras listed above are null and void unless accompanied by a separate invoice/amendment. Said invoice must be paid in full.
- 3) The Purchaser acknowledges that after Interior Colour Selection form is signed and dated, no further changes will be permitted other than re-selection due to unavailability. J.S.K. Purchaser's Initials
- 4) The Purchaser acknowledges reading and accepting the "Gold Park Homes Decor Centre Disclaimers" form. This document contains other miscellaneous disclaimers.

This Interior Colour Selection is final and approved by:


Signature: 

Date: 01-03-18


Telephone — (T)
 Cable — (C)
 Electrical — (E)

The Wagner SEMI SERIES

Elevation A • 2,127 sq.ft.
 Elevation B • 2,117 sq.ft.
 Elevation C • 2,127 sq.ft.
 Elevation D • 2,127 sq.ft.

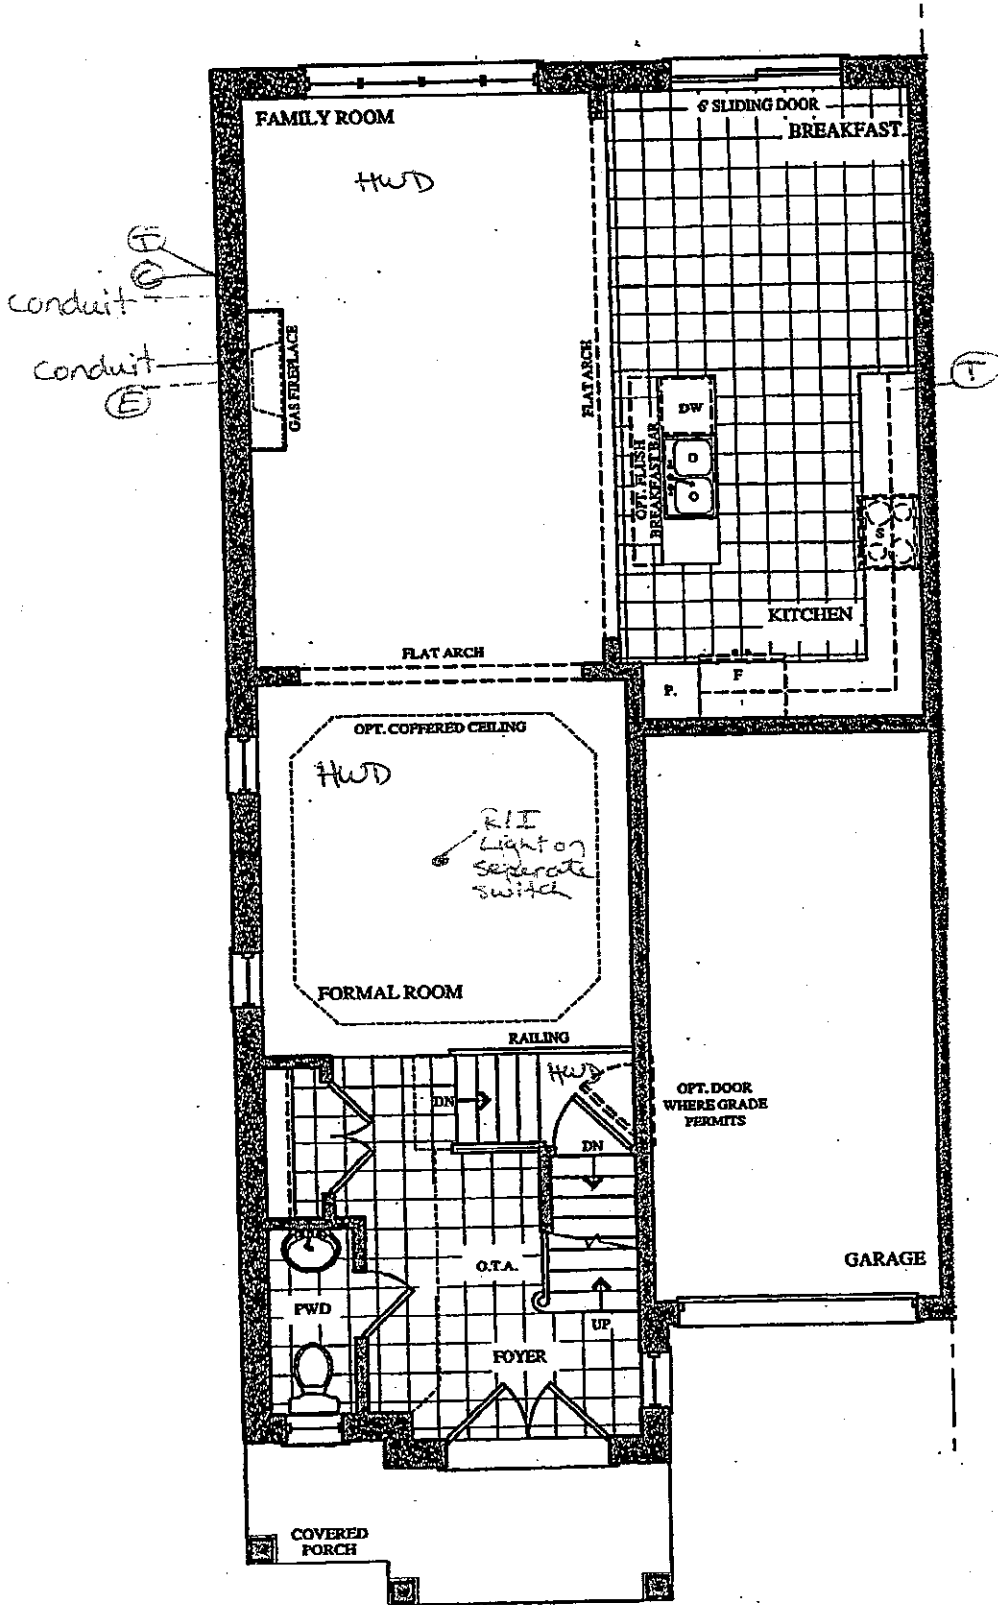

GROUND FLOOR PLAN
ELEV. 'A' & 'B'

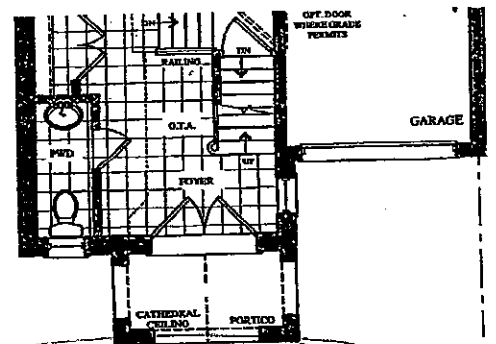

PART. GROUND FLOOR PLAN
ELEV. 'C' & 'D'

Lot 64R
July 31, 17

Lot 64R
Mar 1, 18

(SK)


(SV)

Telephone — (T)
Cable — (C)


The Wagner

SEMI SERIES


Elevation A • 2,127 sq.ft.
Elevation B • 2,117 sq.ft.
Elevation C • 2,127 sq.ft.
Elevation D • 2,127 sq.ft.

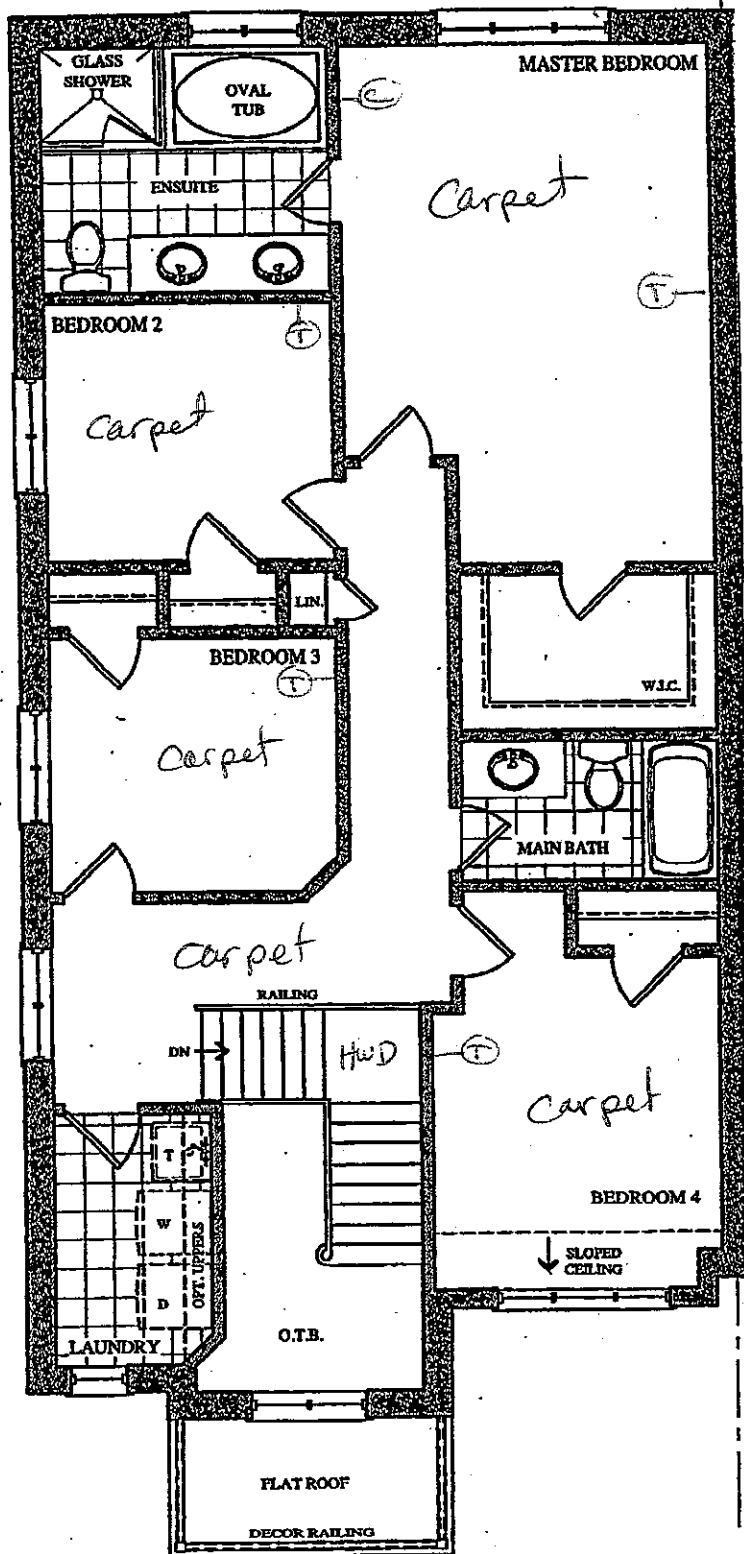


SECOND FLOOR PLAN
ELEV. 'A'

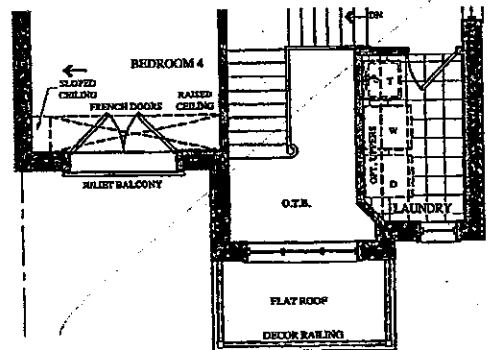

PART. SECOND FLOOR PLAN
ELEV. 'B'

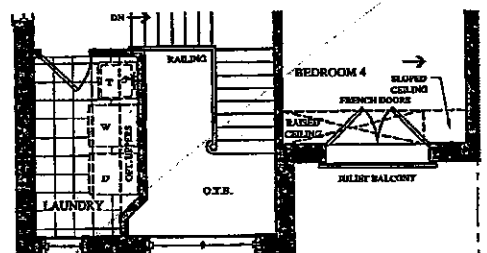

PART. SECOND FLOOR PLAN
ELEV. 'C'

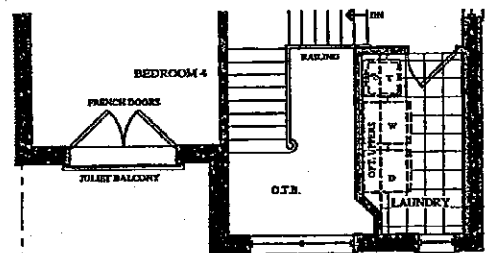

PART. SECOND FLOOR PLAN
ELEV. 'D'

Lot 64R
July 31, 17

(S/K)


Lot 64R
Mar. 1, 18

(S/V)

The Wagner

SEMI SERIES

Elevation A • 2,127 sq.ft.
 Elevation B • 2,117 sq.ft.
 Elevation C • 2,127 sq.ft.
 Elevation D • 2,127 sq.ft.

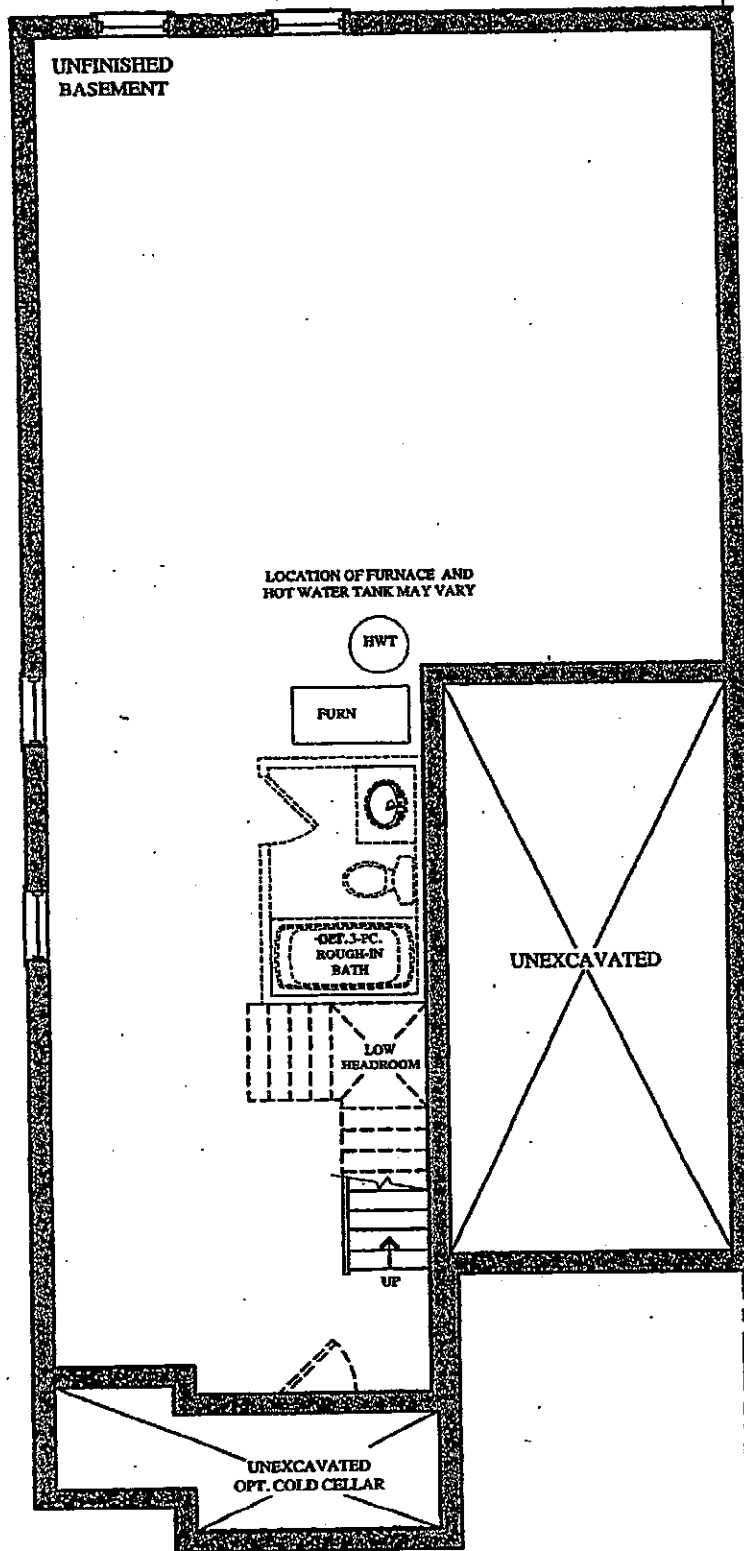


**BASEMENT FLOOR PLAN
 ELEV. 'A' & 'B'**

Lot 64R
 July 31, 17

(S-K)

Lot 64R
 Apr. 1, 18

(S-V)

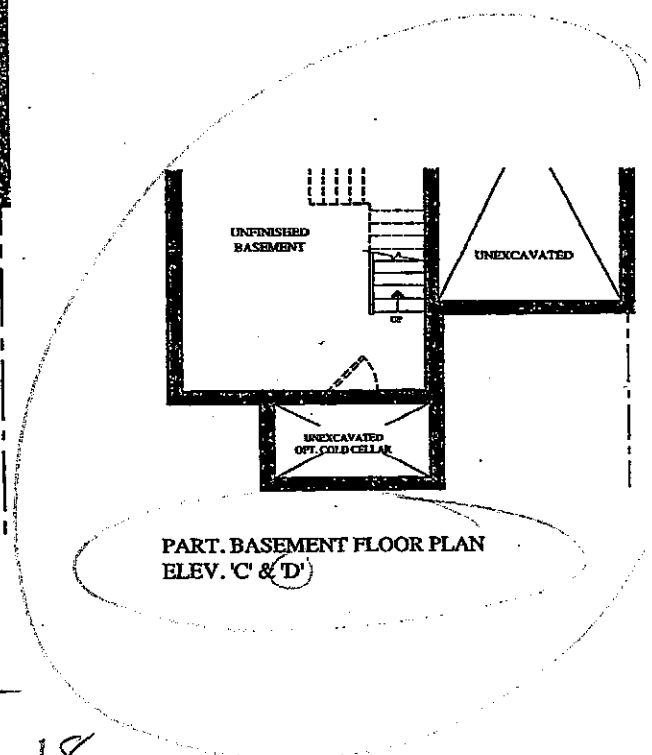

**PART. BASEMENT FLOOR PLAN
 ELEV. 'C' & 'D'**

ITEM A. Wood grain and colour are characteristics of the product, we cannot guarantee that such grain and colour will always match
ITEM B. Cortina Kitchens reserves the right to alter dimensions and make technical changes without notice.

CORTINA

KITCHENS INC.

70 Regina Road Woodbridge ON L4L 8L6
905-264-6464

INFORMATION - PVC DOORS

Builder: Gold Park Homes Project: Encore 2 Lot #: 64R

All cabinets with PVC (Thermofoil) Doors come with melamine gables, panels and kick. The doors, crown moulding and light valance are PVC wrapped. Open shelves incorporated in design will only be available with melamine interiors. There will be variations in colour shades between the PVC parts (doors, crown and Light valance) and the melamine parts (open shelves, Gables, Panels and Kick) due to the difference in material.

Furring Panel with crown moulding to the ceiling is not available on all PVC door styles due to subtle variations in colour shades between the PVC parts (moulding) and the melamine parts (furring panel) due to the difference in material. Grain directions in wood grain pattern melamine, vary between the furring panel, crown moulding (horizontal) and the PVC doors (vertical).

Thank you for your understanding.

I am well informed of this information, and agree to the purchase of the above.

Purchaser: 

Date: 01-03-18

CORTINA

30 Regina Road Woodbridge ON L4L 8L6
905-264-6464

DARK STAIN INFORMATION

Builder Gold Park Homes... Project Encore 2... Lot # 64R...

Cortina Kitchens offers a wide variety of finishes, applied to oak and maple products. The subject finishes include the spray stains **Cocoa**, **Espresso**, **Graphite** as well as wiping stain **Ebony**.

Due to the very dark stains applied on natural maple and oak doors and joints, several characteristics are important to be noted when purchasing these products.

1. Shadow lines may be visible at the interior profile edges of a door or drawer front. If movement occurs shadow lines may increase or decrease, depending on the style and/or size of a door or drawer front.
2. Variation and unevenness may be visible in the finish.
3. Hairline cracks at the joints are created over time due to the nature of natural wood, caused by usage, humidity, or dryness. They tend to be more visible to darker stains, than lighter wood stains.

Please be advised that Cortina Kitchens will not replace doors nor parts that exhibit the above characteristics associated with this finish. These characteristics are not avoidable and are a result of the natural characteristics of wood and wood veneer, and the characteristics of darker stains on wood.

Thank you for your understanding.

I am well informed of this information, and agree to the purchase of any of the subject finishes listed above.

Purchaser: 

Date: 01-03-18

Sk

STANDARD HARDWARE




CSI-6



CSI-10




CSI-14

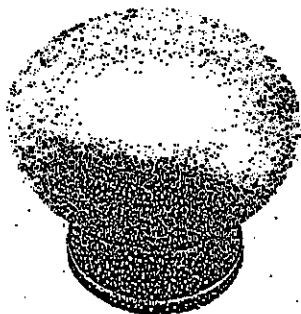

CSI-16



CSI-18

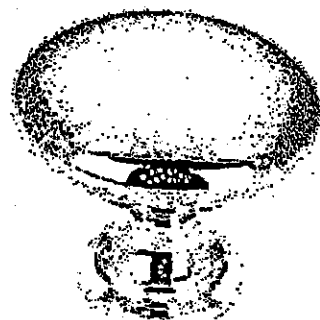

CSI-19



CSI-20




CSI-21


Kitchen



CSI-22

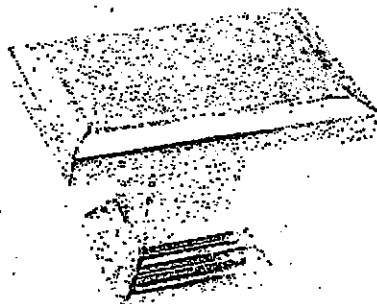


CSI-23

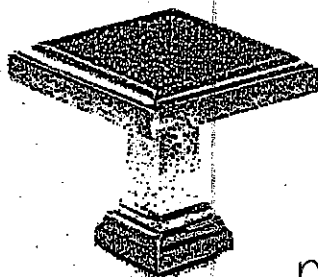

CSI-24

main master

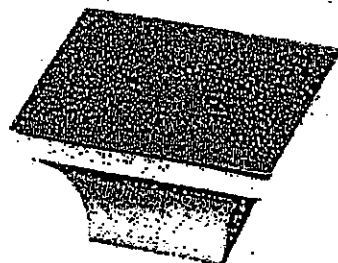

CSI-25

*NOTES:

- IMAGES ARE FOR QUICK REFERENCE PURPOSES ONLY
- ACTUAL SIZES AND FINISHES AS PER HARDWARE SAMPLE BOARD PROVIDED TO DECOR CENTRE


Calvin

Main Bath x1
Master Ensuite x2

Total = 3

S-K
4220CFY

19 1/4" Oval
Undermount Sink

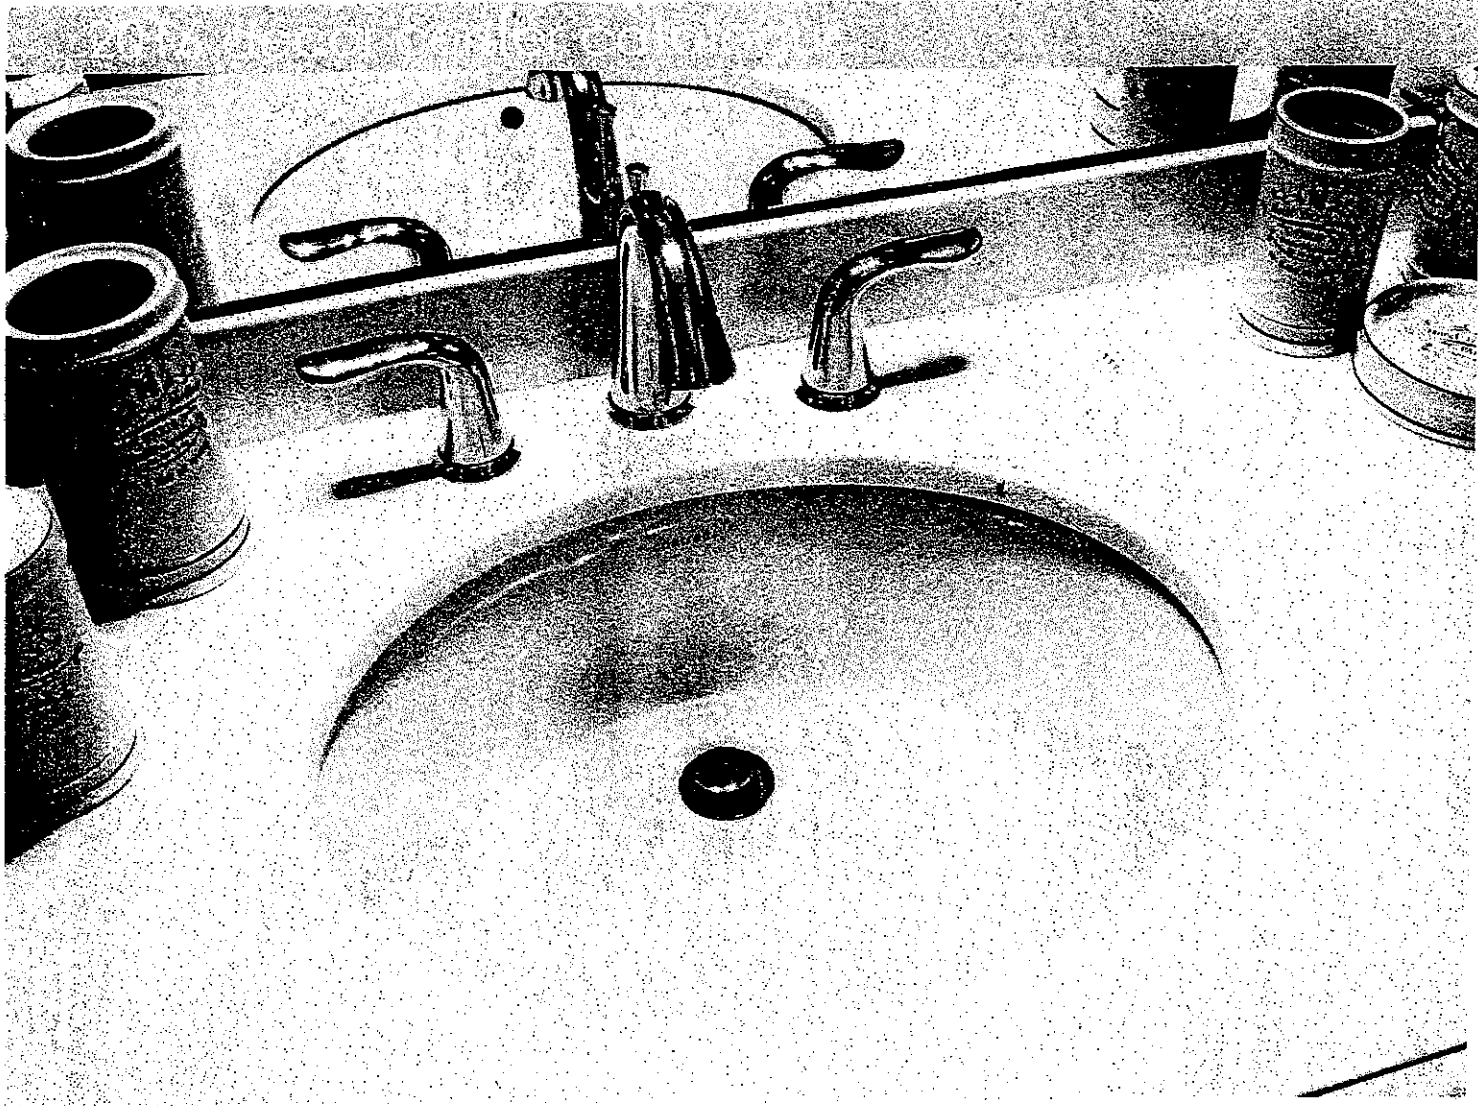

FEATURES

Vitreous china
Front overflow hole
Template and mounting hardware supplied
Overall dimensions (W x D x H):
(OD): 19 1/4" x 16 1/8" x 7 5/8"
(ID): 17" x 13 3/4" x 5 3/4"

CERTIFICATIONS

IAPMO cUPC
ASME A112.19.2 / CSA B45.1-2008

COLOUR

Soft white

Lot 64R
Mar. 1, 18

All Vanities to be
std. edges

SK

GOLDPARK

WORTH MORE




encore
BRAMPTON


Granite, Marble,
Engineered Surfaces

- Standard 2CM & 3CM
- Upgrade 1 2CM & 3CM
- Upgrade 1 4 CM
- Upgrade 2


20mm (3/4") Profiles

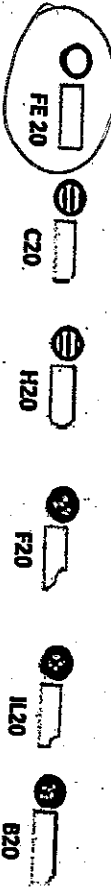

30mm (1 1/4") Profiles

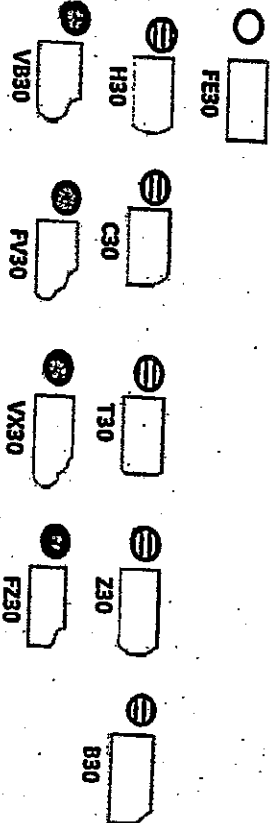

40mm (1 1/2") Profiles

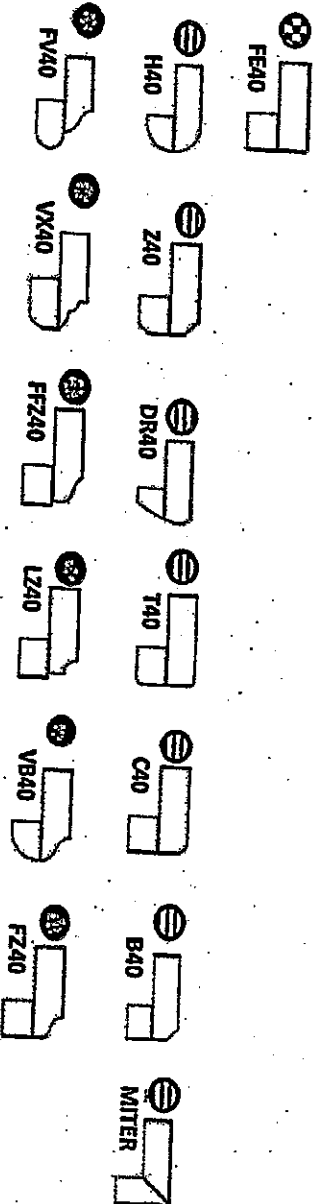

Note: All colours may not be available in 30mm at time ordered. Vendor reserves the right to use 40 mm edges (by lamination process).

*Mitre edge is available in Upgrade 1 for an overall thickness of 2". All other Mitre edge options will be an Upgrade 2 Edge.

Kitchen

Jaspa Painting & Decorating Inc.

75002 Martin Grove Road, Woodbridge, ON L3L 8C6
T/ 905-850-4096 F/ 905-851-1622

INFORMATION – STAINED OAK RAILING, PICKETS, STAIRS & NOSINGS

Builder: Gold Park Homes Project: Encore 2 Lot #: 64R

All oak railings, pickets, stairs and nosings are stained after installation, on-site, with an alkyd based wiping stain. In addition to staining, 2 coats of clear satin varnish are applied. **PLEASE NOTE** that the stain colour samples provided to the décor centre are not hardwood flooring colour matches and are formulated to coordinate with and/or compliment the factory finished hardwood floors offered by the builder. Oak railings, pickets, stairs and nosings will vary from our stain samples as a result of the many variables that can affect the outcome of a stain colour. Factors such as density, age, red or white oak colour, grain pattern and the uniqueness of each piece of wood, as well as the on-site temperature and humidity levels during application, can result in a wide variation of stain colour and tone on the finished product.

I am well informed of this information, and agree to purchase the above.

Purchaser: 

Date: 01-03-17

Jaspa Painting & Decorating Inc. must receive a signed copy of this form prior to the application of any stain.

Gold Park Homes Décor

GOLDPARK
WORTH MORE™

Centre Disclaimers

Through years of doing business, we at Gold Park Homes have encountered issues beyond our control. The following disclaimers apply to all instances of Purchaser's Extras forms and all Interior Colour Scheme forms.

FIREPLACES

Fireplace Marble: Due to the many variables that can affect the pattern and/or design, frequently the marble installed on the fireplace will not be identical to the samples. We will make every attempt to come as close to the samples as possible, but cannot be responsible for results which differ from the samples.

CERAMIC FLOOR TILE

Many variables including variegation can affect tile colour, pattern and/or design which mean installed tiles may not be identical to the samples. We will make every attempt to come as close as possible, but cannot be responsible for results which differ from the samples.

HARDWOOD FLOORING

The purchaser is advised that cupping and shrinkage are characteristics of hardwood flooring normally appearing after installation, especially when humidity levels are not regulated, and no warranty is provided by the flooring supplier with respect to such cupping and shrinkage. Furthermore, hardwood floors may also heave and warp when located at or close to entrance points of the home, where rain could make its way to the flooring. The vendor agrees to install any hardwood flooring ordered by the purchaser in a good and workmanlike manner, but shall not be responsible for, and is hereby released by the purchaser from responsibility and liability for cupping, shrinkage, heaving and warping of hardwood flooring in the above mentioned circumstances.

STAIRCASE VS FLOORING

WOOD SPECIES DIFFERENCE

The purchaser is aware and therefore accepts and acknowledges that the wood species of the staircase and flooring chosen do not match. This difference might result in an undesirable colour variance

The purchaser is aware and therefore accepts and acknowledges that though the flooring is of the same species as the staircase the difference in product finishing may result in a stain colour variance.

The purchaser agrees that the vendor is to be exempt from any and all claims by the purchaser regarding this colour variance.

RAILINGS

All railings, pickets, posts, nosing's and stairs come from solid wood and veneered wood materials sourced from multiple locations and sources. As such there will be variations in grains and shades between the various natural components beyond our control. Due to this variance in material, all components will stain with colour or natural finish differently.

Iron pickets are wrought in nature and depending on the manufacturing process will have differences from picket to picket which is normal. Also the finish of the iron pickets is of a powder coated nature. This process can produce minor colour variations or tones. Furthermore, the assembly of the metal pickets can develop a natural rattle over time from vibration in the railing. Minor rattling is normal and is a part of the wrought iron picket assembly.

HOUSE EXTERIORS

Variations in subcontractors across different sites and varying site conditions may result in house exteriors that differ from the artist renderings. We cannot be responsible for results which differ from the artists renderings of elevations.

PLASTER MOULDINGS AND MEDALLIONS

Plaster mouldings will not be installed in open to above areas or areas with 2 storey elements.

STAIN COLOURS

Due to the many variables that can affect the outcome of a stain colour on wood, staircases, railings, and fireplaces, the colour may not be identical to samples. Factors such as density, age, humidity, air temperature, and the uniqueness of each piece of wood can result in wide variations in darkness or lightness. We will make every attempt to come as close to the sample as possible, but cannot be responsible for results which differ from the samples.

Stain on pre-finished hardwood floors will not be an exact match to the stain colours available on stairs, pickets and rails. The purchaser is responsible for choosing the stain on these areas to their satisfaction.

IN-WALL CONDUIT FOR AUDIO/VIDEO CABLES

It is important to note that due to the variation in framing requirements in different parts of your home, conduit lengths and routing can vary. In virtually all instances of ground floor installation (I.e. above a fireplace), conduit will first travel down into the basement below the floor joists, over to the termination point and back up into the main floor. As a result, it is best to measure the length of the conduit after occupancy with a "pull wire" before

X S.K

purchasing your cables. For above-fireplace installations, the conduit wall plate will be installed approximately 10" above the Fireplace Mantle, unless otherwise specified in the Construction Summary.

APPLIANCE SPECIFICATIONS

All appliance openings are set to builder's standard openings. Please advise Décor Centre at time of your structural appointment if custom sizing of cabinets is required for any built-in appliances. The purchaser is responsible for costs and fees associated with changes to pre-manufactured kitchens made subsequent to colour appointments.

Purchaser accepts & acknowledges that in order to accommodate upgraded appliances, all appliance specifications should be provided at the time of their structural appointment, should this not occur they must be provided to the Décor Center within one (1) week of completion of structural chart. Failure to do so may result in the need to revert to the standard appliance openings or in a delay in construction of your dwelling, as well as a cost of \$500 to re-open your structural file should changes be required. As a result we may be forced to extend the closing of your transaction. Due to failure to complete the above-mentioned selections and at no fault of our own, we reserve our right to hold you responsible for this delayed closing, including charging extra administration cost and interest on the balance due on closing.

Purchasers Accept Standard Appliance Openings (unless otherwise specified):

Fridge - 37-1/2"W x 73-1/2" High Approx.

Range - 30-1/2"D x 31-1/2"W Approx.

Dishwasher - 24" W Approx.

DELETION OF HOODFAN & CABINETS ABOVE STOVE:

The purchasers are aware that in requesting NOT TO INSTALL builder's standard hood fan and standard cabinets above stove they will receive NO STANDARD HOOD FAN and NO CREDIT. Purchasers are installing their own hood fan after closing and accept that it may waive any warranty associated with such a change.

Purchasers accept and acknowledge that the exhaust fan duct hole may be off-centered with the stove in the kitchen due to purchasers installing their own hood fan after closing. The vendor is exempt from adjusting such openings for the purchasers range hood.

ELECTRICAL FOR APPLIANCES

Pricing is subject to change based on the appliance specifications provided. Purchasers should provide proper appliance specifications and cut-out sheets in order for Gold Park to price extras accordingly.

KITCHEN CABINETS

The kitchen you order/purchase will undoubtedly contain slight colour variations. The degree of these variations is virtually impossible to determine before the kitchen is installed in its intended location. The amount of and type of lighting will also affect various highlights in the finish. Note: No two pieces of wood are identical. Variations in colour tone and grain patterns make a perfect colour match virtually impossible. It is generally agreed that these variations add to the natural beauty of a wood kitchen.

STAIN

Charcoal is a spray stain applied to Oak and Maple products with several characteristics that are important to be aware of when purchasing this product.

1. Shadow lines may be visible at the interior profile edges of a door or drawer front. If movement occurs shadow lines may increase or decrease, depending on the style and/or size of a door or drawer front.
2. Variation and unevenness may be visible in the finish.
3. Hairline cracks at the joints are created over time due to the nature of natural wood, caused by usage, humidity**, or dryness. They tend to be more visible to darker stains, than lighter wood stains.

** Relative humidity is recommended to be between 45% and 55%. Please refer to Cortina Kitchens "Cleaning, Care, Maintenance, & Warranty Information" guide.

Please be advised that Cortina Kitchens will not replace doors and/or parts that exhibit the above characteristics associated with this finish. These characteristics are not avoidable and are a result of the natural characteristics of wood and wood veneer, and the characteristics of darker stains on wood. The Charcoal stain is not available on doors in Group IV, Group IVA, Group V and Group VA.

Cortina Kitchens offers a wide variety of finishes, applied to oak and maple products. The subject finishes include the spray stains Cocoa, Espresso, Graphite as well as wiping stain Ebony.

Due to the very dark stains applied on natural maple and oak doors and joints, several characteristics are important to be noted when purchasing these products.

1. Shadow lines may be visible at the interior profile edges of a door or drawer front. If movement occurs shadow lines may increase or decrease, depending on the style and/or size of a door or drawer front.
2. Variation and unevenness may be visible in the finish.
3. Hairline cracks at the joints are created over time due to the nature of natural wood, caused by usage, humidity, or dryness. They tend to be more visible to darker stains, than lighter wood stains.

Please be advised that Cortina Kitchens will not replace doors nor parts that exhibit the above characteristics associated with this finish. These characteristics are not avoidable and are a result of the natural characteristics of wood and wood veneer, and the characteristics of darker stains on wood.

X S.K

CABINETRY DOOR HARDWARE

Cortina Kitchens' cabinetry doors and drawer fronts will be drilled to accept a standard knob or handle selected from Cortina's hardware boards. This drilling comes standard with the order, and is done ONLY in our shop, not on the job site.

For those not wanting Cortina's hardware drilling, the following applies:

No holes to be drilled on the doors and drawer fronts should be specified in writing on the colour chart and the P.O. If while in production, Cortina Kitchens misses this request, Cortina Kitchens and the Builder will not be held responsible to replace any or all doors and drawer fronts affected, and the customer agrees to accept the product as is. No hardware will be supplied or credited by Cortina Kitchens with this request. No charge will apply for this request.

PVC DOORS

All cabinets with PVC (Thermofoil) Doors come with melamine gables, panels and kick.

The doors, crown moulding and light valance are PVC wrapped. Open shelves incorporated in design will only be available with melamine interiors. There will be variations in colour shades between the PVC parts (doors, crown and Light valance) and the melamine parts (open shelves, Gables, Panels and Kick) due to the difference in material.

Furring Panel with crown moulding to the ceiling is not available on all PVC door styles due to subtle variations in colour shades between the PVC parts (moulding) and the melamine parts (furring panel) due to the difference in material. Grain directions in wood grain pattern melamine, vary between the furring panel, crown moulding (horizontal) and the PVC doors (vertical).

GRANITE, MARBLE ENGINEERED SURFACES WAIVER

Granite and marble are naturally occurring products, and due to the many variables that can affect the pattern, colour and/or design and "pitting" of natural products slabs installed will not be identical to the samples displayed. We will make every attempt to come as close to the samples as possible, but cannot be responsible for results which differ from the samples. Every effort is made to provide granite counter tops as close as possible but the vendor is not responsible for results which differ from the sample displayed. All countertop surfaces may have seams & product pattern & shade can change in areas containing seams.

RESELECTIONS

It is not uncommon for flooring, such as tile, to become discontinued prior to its installation. Therefore it may be necessary to make a reselection of certain materials sometime during the build process. We cannot assure you that another choice approximating your selection will be available.

PLANS

Plans are subject to change without notice. Actual usable floor space may vary from the stated floor area. Layout for kitchen, furnace, HWT and laundry tub may vary from plan. Vertical and horizontal bulkhead, which are not shown on plan, may be required for plumbing and heating runs. E.& O.E.

PLEASE NOTE:

In the event the work on the house has progressed beyond the point where the items covered by these invoices cannot be installed without entailing any unusual expense, then this order is to be cancelled and any deposit paid in connection with the same is to be refunded to the purchaser.

The vendor will undertake to incorporate the work covered by the sales extra in the construction of the house but will not be liable to the purchaser in any way, if for any reason the work covered by the extra is not carried out. In that event, any monies paid in connection with the same shall be returned to the purchaser.

It is understood and agreed that if for any reason whatsoever the transaction of Purchase and Sale is not completed, the total cost of extras ordered are not refundable to the Purchaser(s).

Extras or changes will not be processed unless signed by the Vendor.

These extras may not be amended without the written consent of Gold Park Homes.

The purchaser(s) and the builder acknowledge and agree that this "Purchaser's Extra" form shall not be deemed to be part of the agreement of purchase and sale entered into between them, nor an addendum thereto.

No postdated cheques will be accepted.

No estimates or orders will be accepted once construction has commenced.

Should a refund be requested on any extras purchased, an 80% reimbursement of the purchase price will be given. (a \$50.00 minimum charge and a maximum \$250.00 charge will apply)

Estimates will only be considered when resubmitted on a signed Purchaser Extras form, accompanied by payment in full.

All prices are estimates only and may be subject to change. Should a change in price occur Gold Park Homes reserves the right to request from the purchaser an adjustment of the price or a refund limited to that item.

Purchasers are aware & accept that ANY changes made to upgrades after signing the Purchasers Extra Form are subject to a minimum administration fee of \$500. PLUS a 10% holdback fee.

Purchasers are aware that any request to add a percentage of upgrades from the purchaser's extras form will be processed only after the builder receives approval letter from the bank.

X S.K

Please be advised that your failure to finalize your structural or colour selections may result in a delay in construction of your dwelling and we may have to extend closing of your transaction. Due to failure to complete the above-mentioned selections and at no fault of us, we reserve our right to hold you responsible for a delayed closing, including charging extra administration cost and interest on the balance due on closing.

Purchaser has attended a Colour appointment at the Decor Centre & has DECLINED any additional upgrades and accepts and acknowledges that there will be no further structural changes/additions/deletions to be made upon signing.

I hereby acknowledge reading and understanding the above copy and will not hold Gold Park Homes responsible for any issues in relation to above.

Purchasers Signatures



Date 01-03-18
