

Brampton Encore - 64L - 2 - 28-7 Elev.C Wagner

CENTRAL VAC AND WIRING

Inv.1,536	1 - TELEPHONE AND CABLE LOCATION SKETCH
Line23646	Note:
31Jul17 / 23Nov17	
Inv.1,536	1 - FAMILY ROOM: INSTALL CONDUIT PIPE- FOR TELEVISION- MUST SPECIFY LOCATION AND TERMINATION POINT
Line23647	Note:
31Jul17 / 23Nov17	

CERAMIC

Inv.1,763	1 - KITCHEN: INSTALL 4TH UPGRADE TILE THROUGHOUT KITCHEN FLOOR
Line25981	Note:
20Feb18 / 16May18	
Inv.1,763	1 - FOYER: INSTALL 5TH UPGRADE TILE THROUGHOUT FOYER FLOOR
Line25982	Note:
20Feb18 / 16May18	
Inv.1,763	1 - POWDER ROOM: INSTALL 5TH UPGRADE TILE THROUGHOUT POWDER ROOM FLOOR
Line25983	Note:
20Feb18 / 16May18	
Inv.1,763	1 - KITCHEN BACKSPLASH: INSTALL 2ND UPGRADE BACKSPLASH IN KITCHEN- ABOVE COUNTER AND BEHIND STOVE
Line25984	Note:
20Feb18 / 16May18	
Inv.1,763	1 - MASTER ENSUITE: INSTALL 1ST UPGRADE FLOOR TILE IN MASTER ENSUITE FLOOR
Line25985	Note:
20Feb18 / 16May18	

CONCRETE AND DRAIN

Inv.1,536	1 - BASEMENT: INSTALL ROUGH-IN - 3PC BASEMENT ROUGH-IN
Line23650	Note:
31Jul17 / 23Nov17	

ELECTRICAL

Inv.1,536	1 - FAMILY ROOM: INSTALL 110V WALL RECEPTACLE ON DEDICATED CIRCUIT - ABOVE FIREPLACE FOR TV
Line23648	Note:
31Jul17 / 23Nov17	
Inv.1,536	1 - FORMAL ROOM: INSTALL ROUGH - IN CEILING OUTLET & SWITCH (WITH COVER PLATE) - DOES NOT INCLUDE FIXTURE - MUST SPECIFY LOCATION
Line23649	Note:
31Jul17 / 23Nov17	
Inv.1,536	1 - KITCHEN: INSTALL GAS LINE ROUGH - 2ND FLOOR- (2-STOREY MODELS) FOR STOVE. INCLUDES 110 PLUG FOR STOVE
Line24814	Note:
31Jul17 / 23Nov17	

Exterior Colours

Inv.1,536	1 - EXTERIOR COLOUR PACKAGE #8
Line24815	Note:
31Jul17 / 23Nov17	

Brampton Encore - 64L - 2 - 28-7 Elev.C Wagner

GRANITE MARBLE QUARTZ

Inv.1,763	1 - KITCHEN: INSTALL 3RD UPGRADE CEASARSTONE COUNTER THROUGHOUT KITCHEN (STANDARD EDGE)
Line25975	Note:
20Feb18 / 16May18	
Inv.1,763	1 - KITCHEN: INSTALL FLUSH BREAKFAST BAR (3RD UPGRADE CEASARSTONE COUNTER-STANDARD EDGE)
Line25976	Note:
20Feb18 / 16May18	
Inv.1,763	1 - MAIN BATH: INSTALL 4TH UPGRADE CEASARSTONE ON MAIN BATH VANITY
Line25986	Note:
20Feb18 / 16May18	
Inv.1,763	1 - MASTER ENSUITE: INSTALL 2ND UPGRADE CEASARSTONE ON MASTER ENSUITE VANITY
Line25987	Note:
20Feb18 / 16May18	

HARDWOOD

Inv.1,763	1 - MAIN FLOOR: INSTALL 2ND UPGRADE HARDWOOD THROUGHOUT MAIN FLOOR-FAMILY ROOM, LIVING ROOM AND LANDINGS
Line25977	Note:
20Feb18 / 16May18	
Inv.1,763	1 - UPPER HALL: INSTALL 2ND UPGRADE HARDWOOD THROUGHOUT UPPER HALL, IN LIEU OF STANDARD CARPET
Line25978	Note:
20Feb18 / 16May18	

HVAC

Inv.1,536	1 - KITCHEN: INSTALL GAS LINE ROUGH - 2ND FLOOR- (2-STOREY MODELS) FOR STOVE. INCLUDES 110 PLUG FOR STOVE
Line23652	Note:
31Jul17 / 23Nov17	
Inv.1,536	1 - BASEMENT: INSTALL 2.5 TON AIR CONDITIONER
Line23653	Note:
31Jul17 / 23Nov17	

KITCHEN AND BATH CABINETRY

Inv.1,763	1 - KITCHEN: SPRAY STAIN KITCHEN CABINETS THROUGHOUT KITCHEN
Line25974	Note:
20Feb18 / 16May18	

MISC.

Inv.1,536	1 - BONUS PACKAGE: \$5,000.00 (INCLUDING TAXES) WORTH OF UPGRADES FROM GOLD PARK HOMES DÉCOR CENTRE IS BEING APPLIED TOWARD THE STRUCTURAL APPOINTMENT. PURCHASER HAS A REMAINING AMOUNT OF \$00 (INCLUDING TAXES) TO BE USED TOWARD THE COLOUR APPOINTMENT
Line23656	Note:
31Jul17 / 23Nov17	

Brampton Encore - 64L - 2 - 28-7 Elev.C Wagner

Inv.1,536	1 - Purchaser has attended a Structural appointment at the Decor Centre & has DECLINED any additional upgrades and accepts and acknowledges that there will be no further structural changes/additions/deletions to be made upon signing on July 31, 2017
Line23657	Note:
31Jul17 / 23Nov17	
Inv.1,536	1 - Purchasers are aware & accepts that ANY changes made to upgrades after signing this Purchasers Extra Form are subject to a minimum administration fee of \$500. PLUS a 10% holdback fee
Line23658	Note:
31Jul17 / 23Nov17	
Inv.1,763	1 - Purchaser has attended a Colour appointment at the Decor Centre & has DECLINED any additional upgrades and accepts and acknowledges that there will be no further structural changes/additions/deletions to be made upon signing on February 20, 2018
Line25990	Note:
20Feb18 / 16May18	
Inv.1,763	1 - Purchasers are aware & accepts that ANY changes made to upgrades after signing this Purchasers Extra Form are subject to a minimum administration fee of \$500. PLUS a 10% holdback fee
Line25991	Note:
20Feb18 / 16May18	

PAINTING

Inv.1,763	1 - STAIRCASE: STAIN STAIRCASE TO GOTHIC STAIN. SEE ATTACHED DISCLAIMER
Line25979	Note: **THE HARDWOOD SELECTED IS A WHITE OAK, THE STAIRS ARE RED OAK. PLEASE SEE ATTACHED DISCLAIMER
20Feb18 / 16May18	
Inv.1,763	1 - STAIRCASE: UPGRADED STAIN TO GO ON STAIRCASE
Line25980	Note: **THE HARDWOOD SELECTED IS A WHITE OAK, THE STAIRS ARE RED OAK. PLEASE SEE ATTACHED DISCLAIMER
20Feb18 / 16May18	

PLUMBING

Inv.1,536	1 - KITCHEN: INSTALL ROUGH-IN - WATERLINE FOR FRIDGE
Line23654	Note:
31Jul17 / 23Nov17	
Inv.1,536	1 - GARAGE: INSTALL HOSE BIB - STANDARD TO UPGRADED WITH HOT AND COLD WATER VALVE
Line23655	Note: IN GARAGE ONLY
31Jul17 / 23Nov17	
Inv.1,763	1 - MAIN BATH: INSTALL ONE (X1) UNDER MOUNT SINK IN MAIN BATH VANITY
	CALVIN 19 1/4" OVAL UNDERMOUNT SINK #4220CFY
Line25988	Note:
20Feb18 / 16May18	
Inv.1,763	2 - MASTER ENSUTTE: INSTALL TWO (X2) UNDER MOUNT SINK IN MASTER ENSUITE VANITY
	CALVIN 19 1/4" OVAL UNDERMOUNT SINK #4220CFY
Line25989	Note:
20Feb18 / 16May18	

WINDOWS - BASEMENT

Brampton Encore - 64L - 2 - 28-7 Elev.C Wagner

Inv.1,536	4 - BASEMENT: INSTALL FOUR (X4) BASEMENT WINDOWS - UPGRADE EXISTING BASEMENT WINDOW TO 30 INCH X 24 INCH - MAY REQUIRE INSTALLATION OF WINDOW WELL
Line23651	Note: PURCHASER IS AWARE THAT THEY WILL GET WINDOW WELLS ON THE SIDE OF THE HOUSE
31Jul17 / 23Nov17	

Purchaser: Atif Ishaq Property: 64L
Telephone Res. / Bus: (416) 827-3428 Project: Brampton Encore - Phase 2
Decor Advisor: Terri Parisani Model and Elevation: 28-7 Elev.C Wagner

Layout Changes: Yes No Sketch Attached: Yes No Exterior Colour Scheme:

1. Cabinetry

	Style and Colour	Counter	Hardware
Kitchen / Breakfast	Siena (oak) *GRAPHITE	*UPG.3 #6600 NOUGAT STD.EDGE: FE-20	CS1-21
Laundry Room			
Powder Room			
MAIN BATH	Toscana (pvc) Mystic	*UPG.4, #7141 CEASARSTONE	CS1-24
Master Ensuite Bathroom	Toscana (pvc) Mystic	*UPG.2, WHITE SPRING CEASARSTONE	CS1-24
Second Ensuite Bathroom (If Applicable)			

Comment

2. Floor Tile

	Selection
Entrance Vestibule	*UPG.5, ETERNA CARRARA WHITE POLISHED 24 X 24
Main Hall	
Kitchen / Breakfast	*UPG.4, ETERNA CARRARA WHITE POLISHED 12 X 24
Laundry Room	SERPENTINE BEYAZ 13 X 13
Powder Room	*UPG.5, ETERNA CARRARA WHITE POLISHED 24 X 24
MAIN BATH	SERPENTINE BEYAZ 13 X 13
Master Ensuite Bathroom	*UPG.1 CARRARA MATTE WHITE/GREY 13 X 13
Second Ensuite Bathroom (If Applicable)	
Lower Landing (If Applicable)	

Comment

3. Wall Tile

	Selection	Listello/Inserts	Describe
MAIN BATH	SERPENTINE BEYAZ 8 X 10	Yes No	
Master Ensuite Bathroom			
Tub Deck	WEAVE WHITE 8 X 10	Yes No	
Shower Stall	WEAVE WHITE 8 X 10	Yes No	
Bathroom Walls	WEAVE WHITE 8 X 10	Yes No	
Second Ensuite Bathroom (If Applicable)		Yes No	
		Yes No	
Kitchen Backsplash	Yes No	Backsplash Behind Fridge	

Comment

*KITCHEN BACKSPLASH- UPGRADE 2: QUEEN MOSAICS SNOW WHITE GLOSSY SHEET

Scheduled Closing Date: October-05-18

Purchaser: Atif Ishaq
Telephone Res. / Bus: (416) 827-3428
Decor Advisor: Terri Parisani

Property: 64L
Project: Brampton Encore - Phase 2
Model and Elevation: 28-7 Elev.C Wagner

4. Plumbing Fixtures

Form for Plumbing Fixtures including checkboxes for Master Ensuite Bathroom, Second Ensuite, Powder Room, Other Room - Specify, and Other Washroom. Includes a comment field with the text 'ALL FIXTURES TO REMAIN AS STANDARD'.

5. Hardwood Flooring

Form for Hardwood Flooring with columns for room names and Type and Stain. Includes a comment field with the text '* UPGRADE 2 HARDWOOD: WHITE OAK 5" IN GOTHAM'.

6. Carpeting

Form for Carpeting with checkboxes for Ground Floor and Second Floor, and fields for Upgrade Underpad, Carpet on Stairs, and a comment field.

7. Fireplace

Form for Fireplace with radio buttons for Living Room, Family Room, and Other Room - Specify, and fields for Fireplace Type, Mantle Type, Colour / Stain, Surround, and Hearth. Includes a comment field with a signature.

Scheduled Closing Date: October-05-18

Purchaser: Atif Ishaq
Telephone Res. / Bus: (416) 827-3428
Decor Advisor: Terri Parisani

Property: 64L
Project: Brampton Encore - Phase 2
Model and Elevation: 28-7 Elev.C Wagner

8. Trim Carpentry

Interior Doors Front Door Glass Inserts Door Handles
Interior Trim
Comment

9. Plaster Mouldings and Medallions

Standard Throughout ☐ Yes ☐ No ☒ N/A

Entrance Vestibule	<input type="text"/>	<input type="text"/>	Kitchen/Breakfast	<input type="text"/>	<input type="text"/>
Main Hall	<input type="text"/>	<input type="text"/>	Den/Library	<input type="text"/>	<input type="text"/>
Living Room	<input type="text"/>	<input type="text"/>	Lower Landing	<input type="text"/>	<input type="text"/>
Dining Room	<input type="text"/>	<input type="text"/>	Other Room - Specify	<input type="text"/>	<input type="text"/>
Family Room	<input type="text"/>	<input type="text"/>			

Comment

10. Railings and Spindles

Railing Package
Railing Colour Spindle Colour
Stringer / Riser Treads
Oak Stairs ☒ Yes ☐ No ☐ N/A
Comment

11. Wall Paint / Ceilings

Throughout Finished Areas

Trim Paint
Smooth Ceilings
Ground Floor ☐
Second Floor ☐
Note
Comment

Scheduled Closing Date: October-05-18

Purchaser: Atif Ishaq
Telephone Res. / Bus: (416) 827-3428
Decor Advisor: Terri Parisani

Property: 64L
Project: Brampton Encore - Phase 2
Model and Elevation: 28-7 Elev.C Wagner

12. Electrical

Hood Fan ☐ White ☒ Stainless ☐ N/A

Above Kitchen Cabinet Light ☐ Yes ☒ No

Below Kitchen Cabinet Light ☐ Yes ☒ No

Standard Appliances ☒

Over The Range Microwave ☐

Chimney Style Fan ☐

Comment

13. Heating and Air Conditioning

Air Conditioning

Gas Provisions Stove

Gas Provisions Dryer

Gas Provisions Barbecue

Comment

14. Additional Comments

15. Disclaimers and Notes

- 1) Colours of all materials are as close as possible to builder's selection, but not necessarily identical due to variances in manufacturing.
- 2) Any extras listed above are null and void unless accompanied by a separate invoice/amendment. Said invoice must be paid in full.
- 3) The Purchaser acknowledges that after Interior Colour Selection form is signed and dated, no further changes will be permitted other than re-selection due to unavailability. Terri Purchaser's Initials
- 4) The Purchaser acknowledges reading and accepting the "Gold Park Homes Decor Centre Disclaimers" form. This document contains other miscellaneous disclaimers.

This Interior Colour Selection is final and approved by:

Signature: [Signature] Date: Feb. 20. 18

Scheduled Closing Date: October-05-18

Purchaser: Atif Ishaq

Property: 64L

Telephone Res. / Bus: (416) 827-3428

Project: Brampton Encore - Phase 2

Decor Advisor: Terri Parisani

Model and Elevation: 28-7 Elev.C Wagner

Layout Changes: ☐ Yes ☒ No

Sketch Attached: ☒ Yes ☐ No

Exterior Colour Scheme:

1. Cabinetry

	Style and Colour	Counter	Hardware
Kitchen / Breakfast	Siena (oak) *GRAPHITE	*UPG.3 #6600 NOUGAT STD.EDGE: FE-20	CS1-21
Laundry Room	-		
Powder Room	-		
MAIN BATH	Toscana (pvc) Mystic	*UPG.4, #7141 CEASARSTONE	CS1-24
Master Ensuite Bathroom	Toscana (pvc) Mystic	*UPG.2, WHITE SPRING CEASARSTONE	CS1-24
Second Ensuite Bathroom (If Applicable)	-		

Comment

2. Floor Tile

	Selection
Entrance Vestibule	*UPG.5, ETERNA CARRARA WHITE POLISHED 24 X 24
Main Hall	-
Kitchen / Breakfast	*UPG.4, ETERNA CARRARA WHITE POLISHED 12 X 24
Laundry Room	SERPENTINE BEYAZ 13 X 13
Powder Room	*UPG.5, ETERNA CARRARA WHITE POLISHED 24 X 24
MAIN BATH	SERPENTINE BEYAZ 13 X 13
Master Ensuite Bathroom	*UPG.1 CARRARA MATTE WHITE/GREY 13 X 13
Second Ensuite Bathroom (If Applicable)	-
Lower Landing (If Applicable)	

Comment

3. Wall Tile

	Selection	Listello/Inserts	Describe
MAIN BATH	SERPENTINE BEYAZ 8 X 10	<input type="radio"/> Yes <input checked="" type="radio"/> No	
Master Ensuite Bathroom			
Tub Deck	WEAVE WHITE 8 X 10	<input type="radio"/> Yes <input checked="" type="radio"/> No	
Shower Stall	WEAVE WHITE 8 X 10	<input type="radio"/> Yes <input checked="" type="radio"/> No	
Bathroom Walls	WEAVE WHITE 8 X 10	<input type="radio"/> Yes <input checked="" type="radio"/> No	
Second Ensuite Bathroom (If Applicable)	-	<input type="radio"/> Yes <input type="radio"/> No	
		<input type="radio"/> Yes <input type="radio"/> No	

Kitchen Backsplash ☒ Yes ☐ No

Backsplash Behind Fridge

Comment

*KITCHEN BACKSPLASH- UPGRADE 2: QUEEN MOSAICS SNOW WHITE GLOSSY SHEET



Purchaser: Atif Ishaq
Telephone Res. / Bus: (416) 827-3428
Decor Advisor: Terri Parisani

Property: 64L
Project: Brampton Encore - Phase 2
Model and Elevation: 28-7 Elev.C Wagner

4. Plumbing Fixtures

<input type="checkbox"/>	Second Ensuite	<input type="checkbox"/>	Powder Room	<input type="checkbox"/>
Master Ensuite Bathroom	<input type="checkbox"/>	Other Room - Specify	<input type="checkbox"/>	Other Washroom
Comment		<input type="text"/>		

ALL FIXTIRES TO REMAIN AS STANDARD

5. Hardwood Flooring

	Type and Stain		Type and Stain
Main Hall	<input type="text"/>	Upper Landing	*UPG.2, 5" GOTHAM
Kitchen / Breakfast	<input type="text"/>	Upper Hall	**UPG.2, 5" GOTHAM
Living Room	*UPG.2, 5" GOTHAM	Master Bedroom	<input type="text"/>
Dining Room	<input type="text"/>	Bedroom #2	<input type="text"/>
Family Room	*UPG.2, 5" GOTHAM	Bedroom #3	<input type="text"/>
Den/Library	<input type="text"/>	Bedroom #4	<input type="text"/>
Entrance Vestibule	<input type="text"/>	Bedroom #5	<input type="text"/>
Lower Landing (If Applicable)	*UPG.2, 5" GOTHAM	Other Room - Specify	<input type="text"/>

Comment
* UPGRADE 2 HARDWOOD: WHITE OAK 5" IN GOTHAM

6. Carpeting

	Upgrade	Description
Ground Floor	<input type="checkbox"/>	<input type="text"/>
Second Floor	<input type="checkbox"/>	14234 BEIGE MARBLE
<input type="text"/>	<input type="checkbox"/>	<input type="text"/>

Upgrade Underpad	Type STANDARD	Area <input type="text"/>
Carpet on Stairs	Capped <input type="text"/>	Runner - *Upgrade <input type="text"/>

Comment

7. Fireplace

	Living Room			Family Room			Other Room - Specify		
	Purchased	As Per Plan	N/A	Purchased	As Per Plan	N/A	Purchased	As Per Plan	N/A
	<input type="radio"/>	<input type="radio"/>	<input checked="" type="radio"/>	<input type="radio"/>	<input checked="" type="radio"/>	<input type="radio"/>	<input type="radio"/>	<input type="radio"/>	<input checked="" type="radio"/>
Fireplace Type	<input type="text"/>			STANDARD			<input type="text"/>		
Mantle Type	<input type="text"/>			NF-20			<input type="text"/>		
Colour / Stain	<input type="text"/>			WHITE PAINT GRADE			<input type="text"/>		
Surround	<input type="text"/>			NERO MARQUINA			<input type="text"/>		
Hearth	<input type="text"/>			NONE			<input type="text"/>		

Comment

fin

Scheduled Closing Date: October-05-18

Purchaser: Atif Ishaq
Telephone Res. / Bus: (416) 827-3428
Decor Advisor: Terri Parisani

Property: 64L
Project: Brampton Encore - Phase 2
Model and Elevation: 28-7 Elev.C Wagner

8. Trim Carpentry

Interior Doors STANDARD Front Door Glass Inserts STANDARD Door Handles STANDARD
Interior Trim STANDARD

Comment

9. Plaster Mouldings and Medallions

Standard Throughout ☐ Yes ☐ No ☒ N/A

Entrance Vestibule			Kitchen/Breakfast		
Main Hall			Den/Library		
Living Room			Lower Landing		
Dining Room			Other Room - Specify		
Family Room					

Comment

10. Railings and Spindles

Railing Package *1 3/4" COLONIAL WITH V-GROOVE HANDRAIL
Railing Colour *GOTHAM (WHITE OAK) Spindle Colour *GOTHAM (WHITE OAK)
Stringer / Riser *GOTHAM (WHITE OAK) Treads *GOTHAM (WHITE OAK)
Oak Stairs ☒ Yes ☐ No ☐ N/A

Comment

**SEE ATTACHED STAIN DISCLAIMER

11. Wall Paint / Ceilings

Throughout Finished Areas COOL WHITE

Trim Paint White

Smooth Ceilings

Ground Floor ☐

Second Floor ☐

Note

Comment

Scheduled Closing Date: October-05-18

Purchaser: Atif Ishaq
Telephone Res. / Bus: (416) 827-3428
Decor Advisor: Terri Parisani

Property: 64L
Project: Brampton Encore - Phase 2
Model and Elevation: 28-7 Elev.C Wagner

12. Electrical

Hood Fan ☐ White ☒ Stainless ☐ N/A

Above Kitchen Cabinet Light ☐ Yes ☒ No

Below Kitchen Cabinet Light ☐ Yes ☒ No

Standard Appliances ☒

Over The Range Microwave ☐

Chimney Style Fan ☐

Comment

13. Heating and Air Conditioning

Air Conditioning

Gas Provisions Stove

Gas Provisions Dryer

Gas Provisions Barbecue

Comment

14. Additional Comments

15. Disclaimers and Notes

- 1) Colours of all materials are as close as possible to builder's selection, but not necessarily identical due to variances in manufacturing.
- 2) Any extras listed above are null and void unless accompanied by a separate invoice/amendment. Said invoice must be paid in full.
- 3) The Purchaser acknowledges that after Interior Colour Selection form is signed and dated, no further changes will be permitted other than re-selection due to unavailability. Atif Ishaq Purchaser's Initials
- 4) The Purchaser acknowledges reading and accepting the "Gold Park Homes Decor Centre Disclaimers" form. This document contains other miscellaneous disclaimers.

This Interior Colour Selection is final and approved by:

Signature: Atif Ishaq


Date: Oct 20 2018

Telephone — (T)
 Cable — (C)
 Electrical — (E)


The Wagner SEMI SERIES

Elevation A • 2,127 sq.ft.
 Elevation B • 2,117 sq.ft.
 Elevation C • 2,127 sq.ft.
 Elevation D • 2,127 sq.ft.

Lot 64L
 Feb. 20, 18

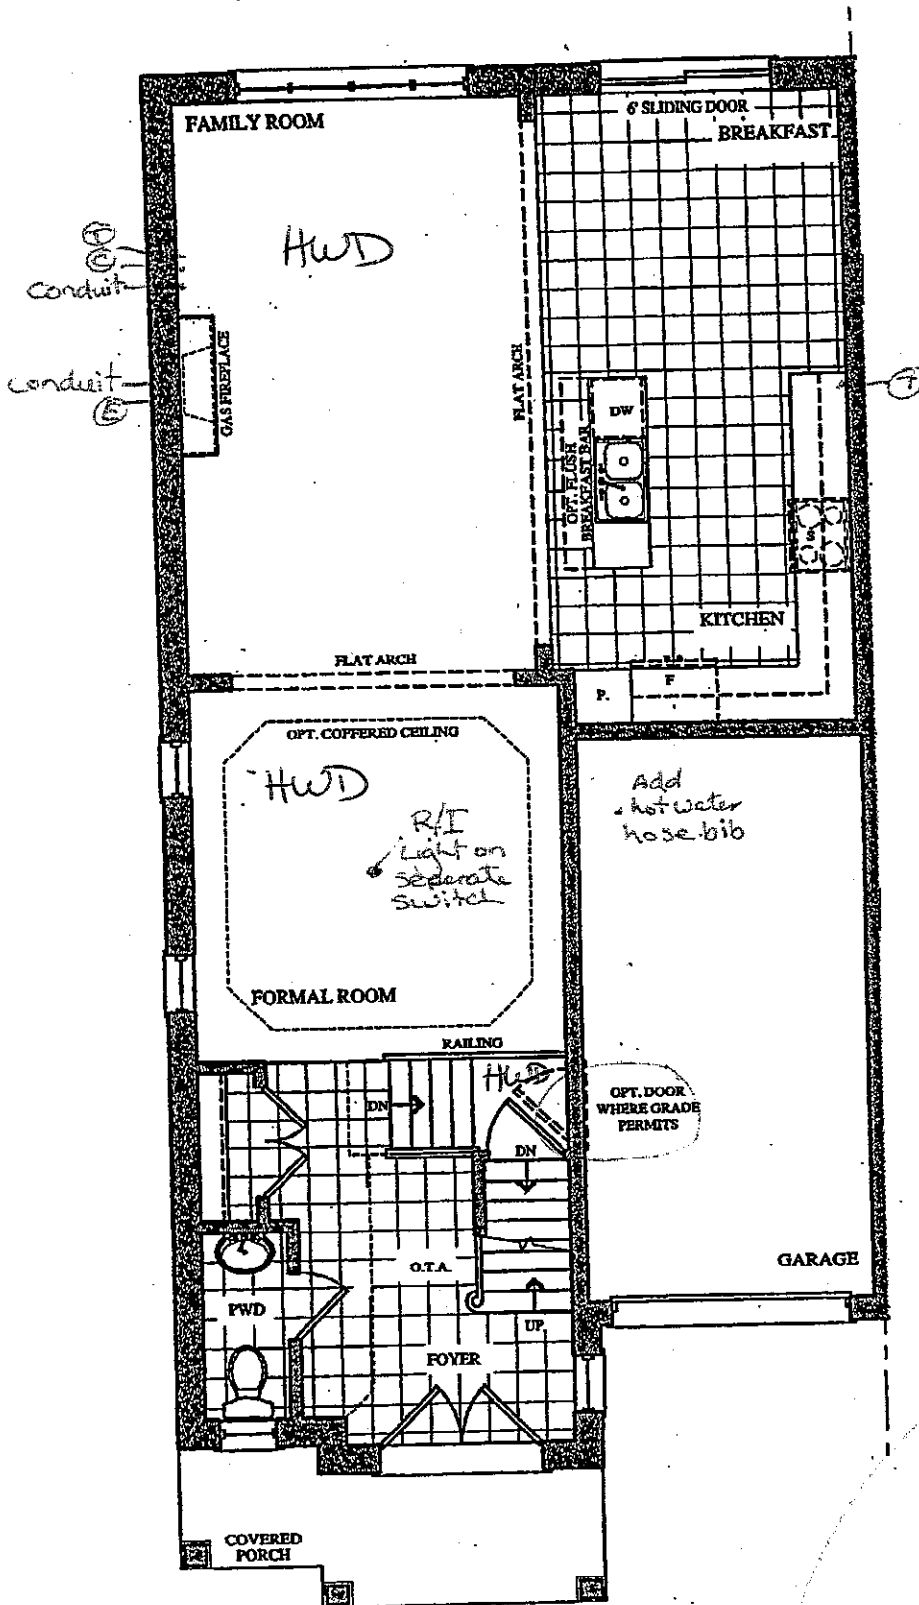

GROUND FLOOR PLAN
 ELEV. 'A' & 'B'

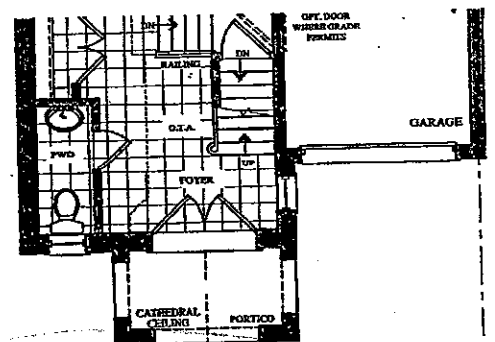

PART. GROUND FLOOR PLAN
 ELEV. 'C' & 'D'


Lot 64L
 July 31, 17




Telephone — (T)
 Cable — (C)

The Wagner SEMI SERIES


Elevation A • 2,127 sq.ft.
 Elevation B • 2,117 sq.ft.
 Elevation C • 2,127 sq.ft.
 Elevation D • 2,127 sq.ft.

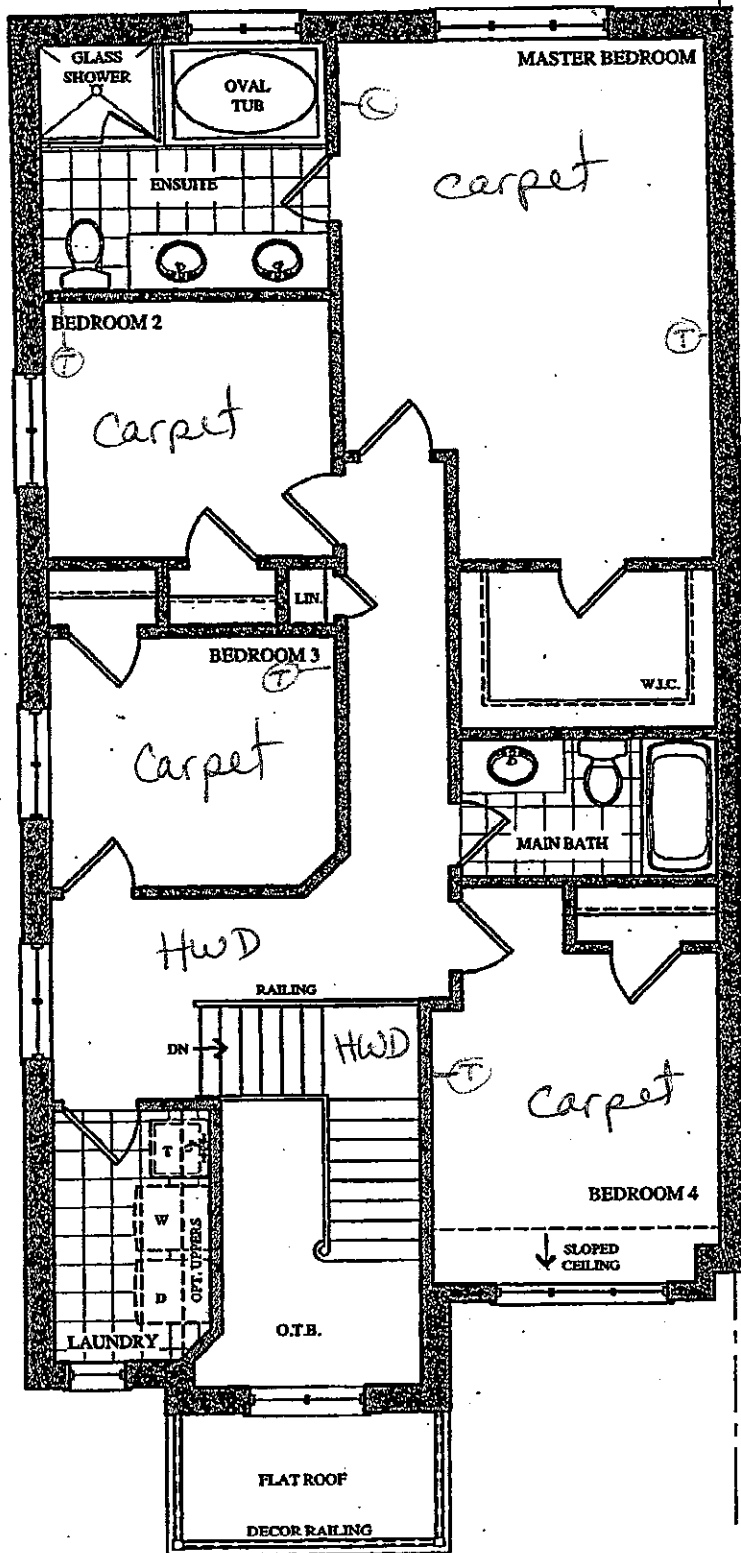


SECOND FLOOR PLAN
ELEV. 'A'

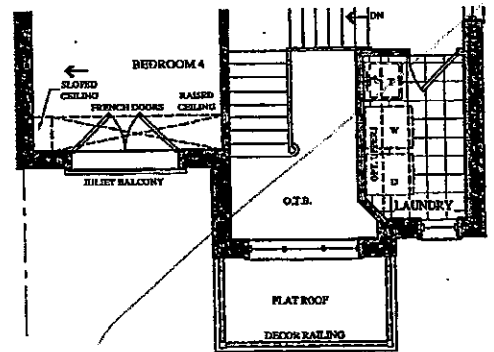

PART. SECOND FLOOR PLAN
ELEV. 'B'

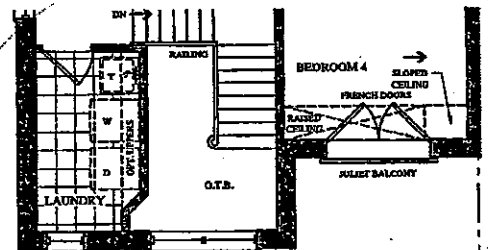

PART. SECOND FLOOR PLAN
ELEV. 'C'

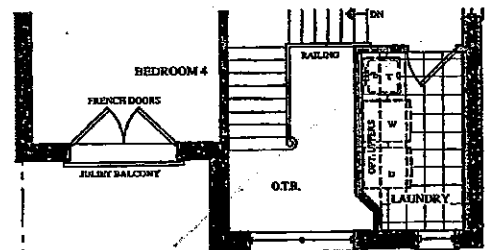

PART. SECOND FLOOR PLAN
ELEV. 'D'

Lot 64L
 July 31, 17

(Signature)


Lot 64L
 Feb. 20, 18

(Signature)


BSMNT WINDOWS
4x 30"x24"

The Wagner SEMI SERIES

Elevation A • 2,127 sq.ft.
Elevation B • 2,117 sq.ft.
Elevation C • 2,127 sq.ft.
Elevation D • 2,127 sq.ft.

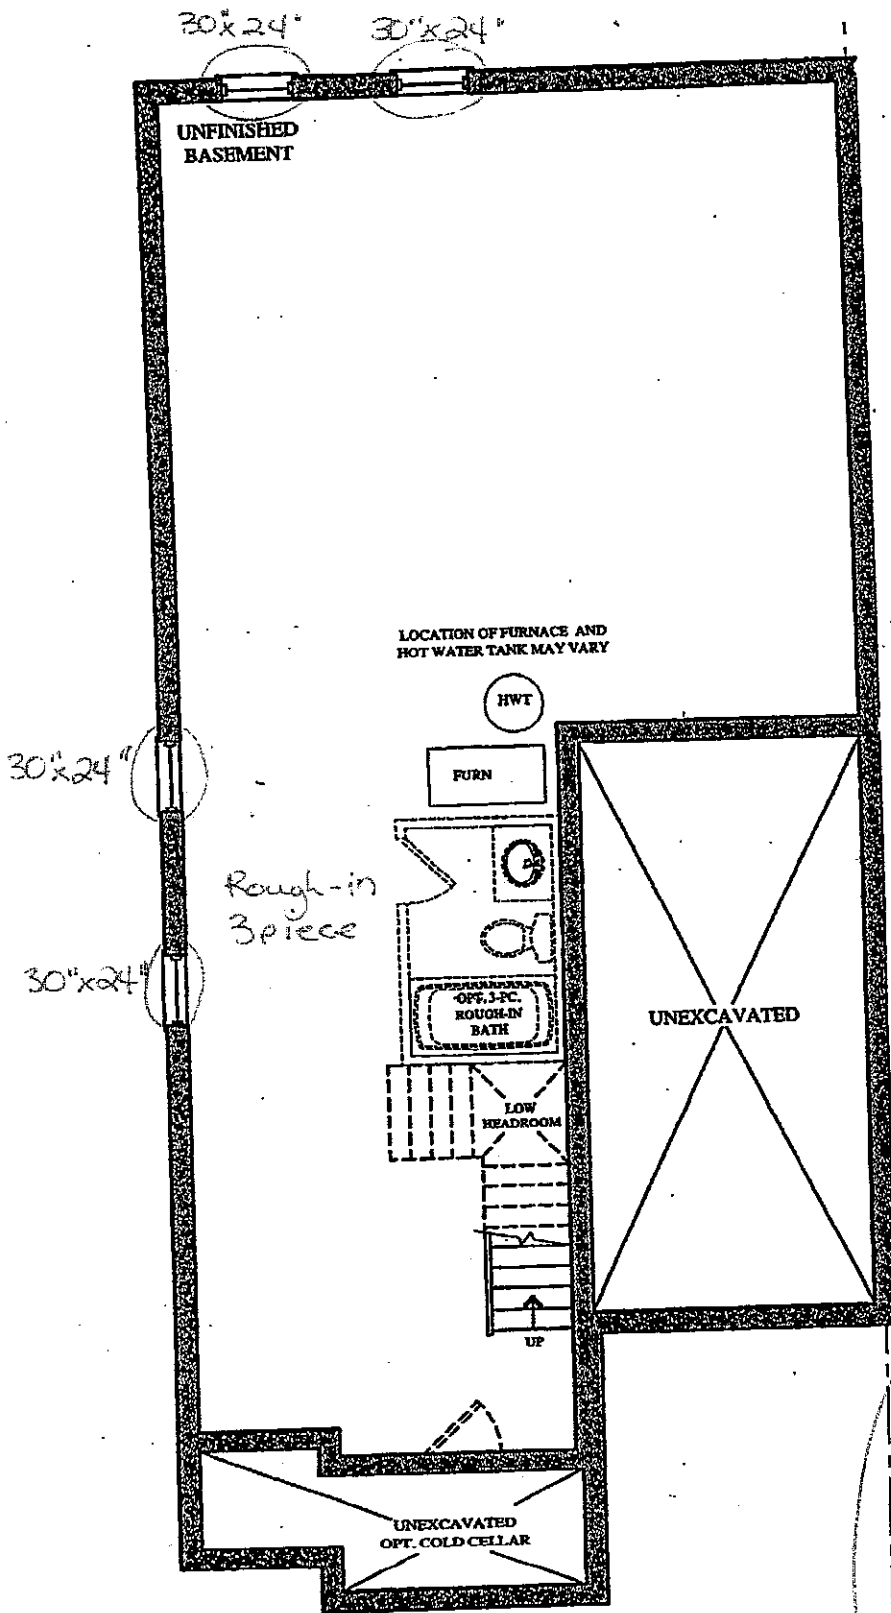

**BASEMENT FLOOR PLAN
ELEV. 'A' & 'B'**

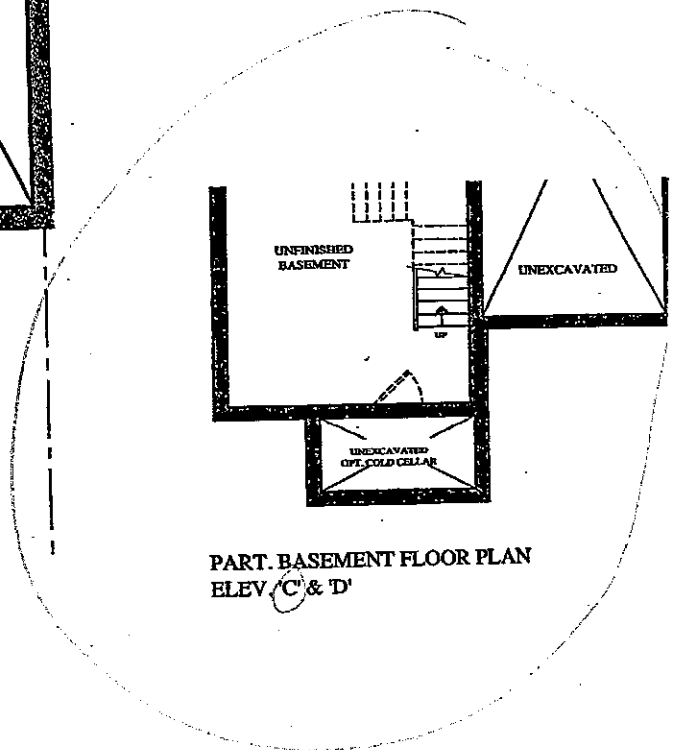

**PART. BASEMENT FLOOR PLAN
ELEV. 'C' & 'D'**

Lot 64L
July 31, 17

[Signature]

Lot 64L
Feb. 20, 18

[Signature]

CORTINA

KITCHENS INC.
70 Regina Road, Woodbridge, Ontario L4L 8L8
Tel: 905-294-6454 Fax: 905-294-0684
www.CortinaKitchens.com

QUOTATION

Date: 06/23/16

Trade Name: Gold Park Homes

Site location: Brampton





Model: SD-7

Address:

Project: Encore

Phase:

This layout has been explained to the purchaser by Cortina Kitchens Inc. and is understood by the purchaser.

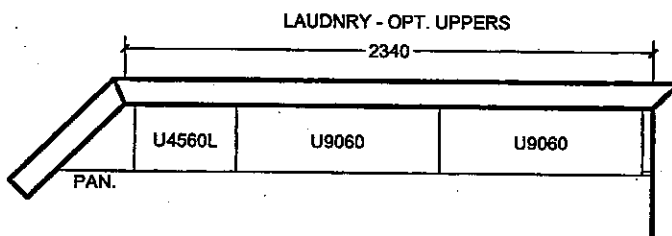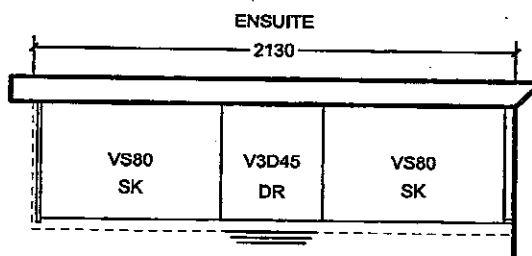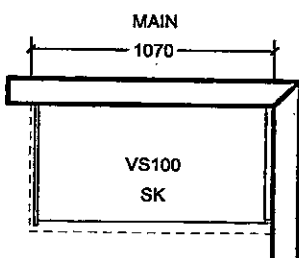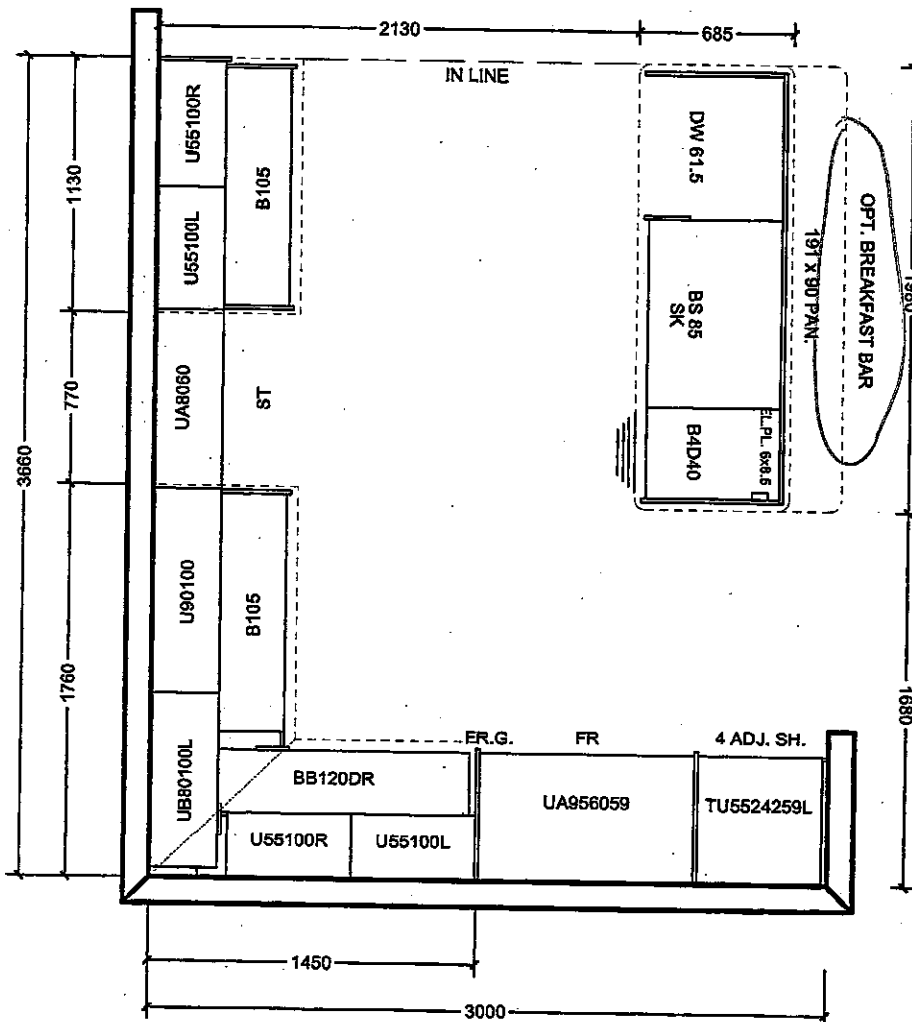

All prices subject to confirmation from head office.
This quotation is subject to the terms & conditions set out
in Cortina's Agreement of Purchase and Sale

All agreements are contingent upon strikes, accidents, and delay beyond our control.
Please provide our installer with template for sinkholes or \$150.00 will be charged for callback.

ACCEPTED DATE: _____

CUSTOMER SIGNATURE

SALESPERSON SIGNATURE

CORTINA HEAD OFFICE APPROVAL


ITEM A. Wood grain and colour are characteristics of the product, we cannot guarantee that such grain and colour will always match
ITEM B. Cortina Kitchens reserves the right to alter dimensions and make technical changes without notice.

STANDARD HARDWARE

STANDARD HARDWARE




CSI-6

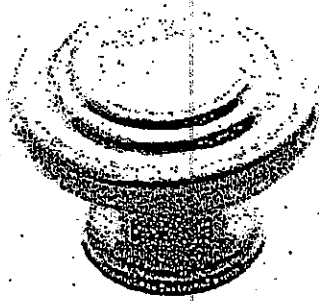

CSI-10




CSI-14

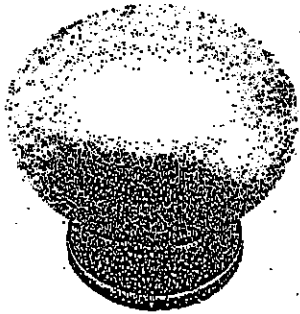


CSI-16




CSI-18

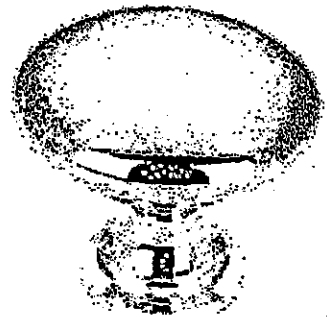

CSI-19

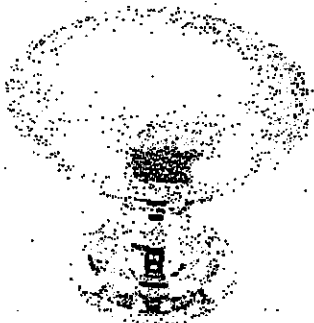

CSI-20

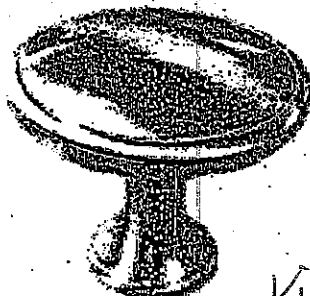


CSI-21

kitchen




CSI-22

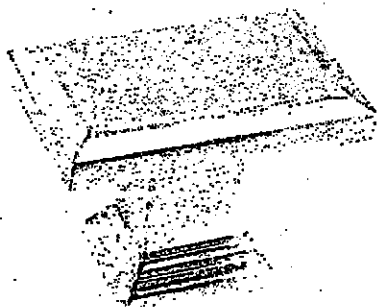

CSI-23



CSI-24

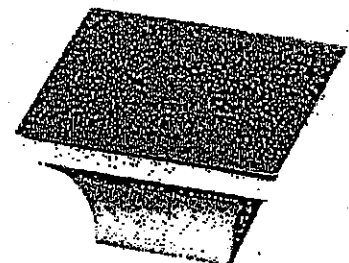main
master

CSI-25

*NOTES:

- IMAGES ARE FOR QUICK REFERENCE PURPOSES ONLY
- ACTUAL SIZES AND FINISHES AS PER HARDWARE SAMPLE BOARD PROVIDED TO DECOR CENTRE

CORTINA

KITCHENS & BATHS

80 Regina Road Woodbridge ON L4L 8L6
905-264-6464

DARK STAIN INFORMATION

Builder Gold Park Homes... Project Encore 2... Lot # 64L

Cortina Kitchens offers a wide variety of finishes, applied to oak and maple products. The subject finishes include the spray stains **Cocoa**, **Espresso**, **Graphite** as well as wiping stain **Ebony**.

Due to the very dark stains applied on natural maple and oak doors and joints, several characteristics are important to be noted when purchasing these products.


1. Shadow lines may be visible at the interior profile edges of a door or drawer front. If movement occurs shadow lines may increase or decrease, depending on the style and/or size of a door or drawer front.
2. Variation and unevenness may be visible in the finish.
3. Hairline cracks at the joints are created over time due to the nature of natural wood, caused by usage, humidity, or dryness. They tend to be more visible to darker stains, than lighter wood stains.

Please be advised that Cortina Kitchens will not replace doors nor parts that exhibit the above characteristics associated with this finish. These characteristics are not avoidable and are a result of the natural characteristics of wood and wood veneer, and the characteristics of darker stains on wood.

Thank you for your understanding.

I am well informed of this information, and agree to the purchase of any of the subject finishes listed above.

Purchaser: _____

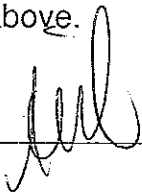

Date: _____

Feb 20 2018

Lot 64L
Feb. 20, 18
(11)




GOLDPARK

WORTH MORE



Granite, Marble,
Engineered Surfaces

- Standard 2CM & 3CM
- ⊖ Upgrade 1 2CM & 3CM
- ⊗ Upgrade 1 4 CM
- ⊕ Upgrade 2

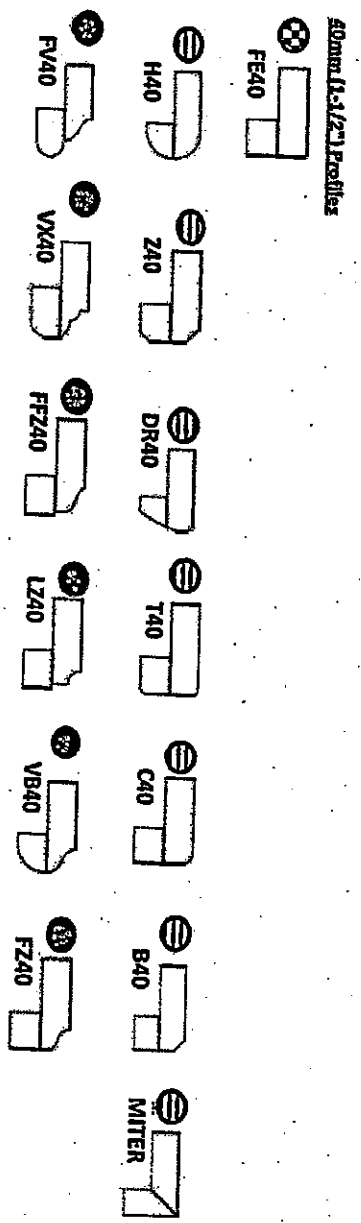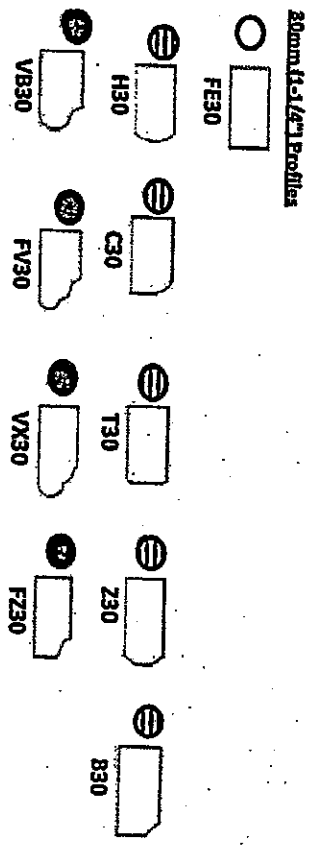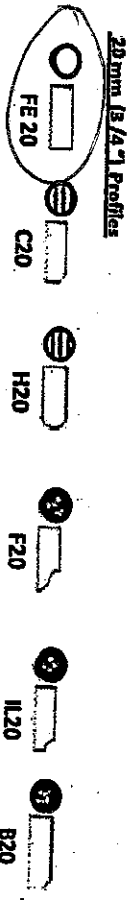

Note: All colours may not be available in 30mm at time ordered. Vendor reserves the right to use 40 mm edges (by lamination process).

*Mitre edge is available in Upgrade 1 for an overall thickness of 2". All other Mitre edge options will be an Upgrade 2 Edge.

Kitchen - Std. Kitchen Edge
Main Std. Vanity Edge
Master Std. Vanity Edge


Main Bath x1
Master Ensuite x2

Lot 64C
Feb. 20, 18



Calvin Total = 3

19 1/4" Oval
4220CFY Undermount Sink

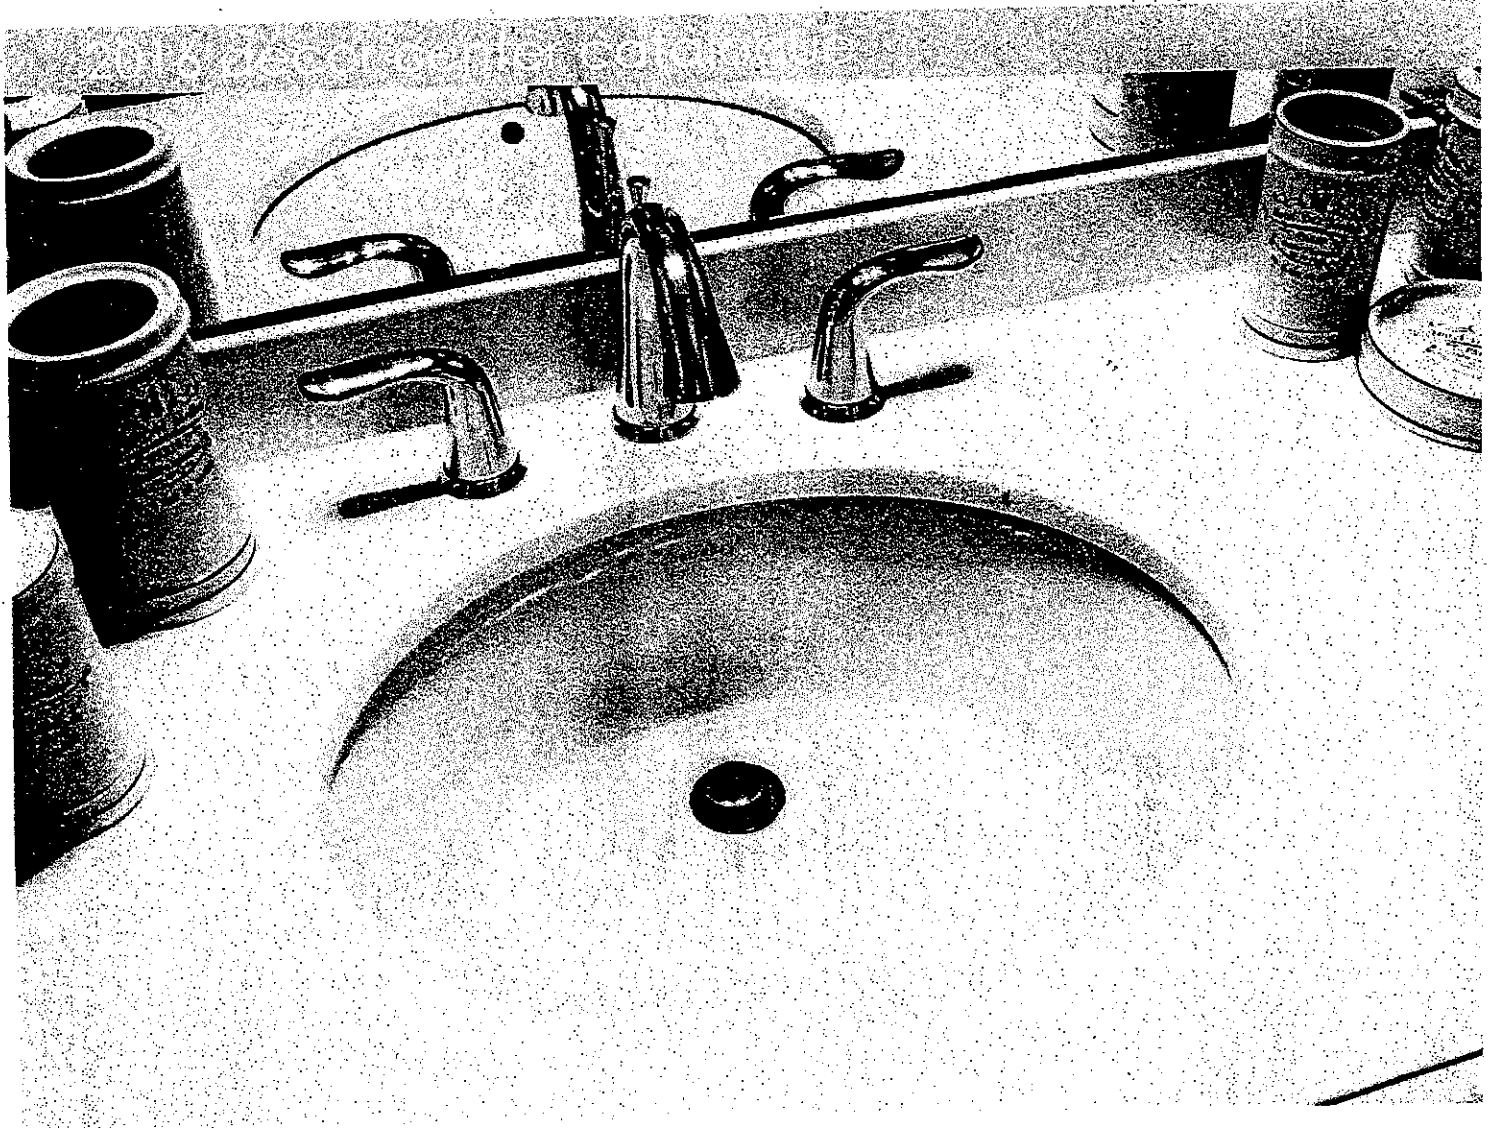

FEATURES

Vitreous china
Front overflow hole
Template and mounting hardware supplied
Overall dimensions (W x D x H):
(OD): 19 1/4" x 16 1/8" x 7 7/8"
(ID): 17" x 13 3/4" x 5 3/4"

CERTIFICATIONS

IAPMO cUPC
ASME A112.19.2 / CSA B45.1-2008

COLOUR

Soft white

contrac.
www.contrac.ca

The images shown are a representation of the finish and color, and may not reflect every characteristic possible.

Issued: Feb. 2016

Jaspa Painting & Decorating Inc.

7500-2 Martin Grove Road, Woodbridge, ON L3L 8C9
T/ 905-850-4096 F/ 905-851-1622

INFORMATION – STAINED OAK RAILING, PICKETS, STAIRS & NOSINGS

Builder: Gold Park Project: Encore 2 Lot #: 64L

All oak railings, pickets, stairs and nosings are stained after installation, on-site, with an alkyd based wiping stain. In addition to staining, 2 coats of clear satin varnish are applied. **PLEASE NOTE** that the stain colour samples provided to the décor centre are not hardwood flooring colour matches and are formulated to coordinate with and/or compliment the factory finished hardwood floors offered by the builder. Oak railings, pickets, stairs and nosings will vary from our stain samples as a result of the many variables that can affect the outcome of a stain colour. Factors such as density, age, red or white oak colour, grain pattern and the uniqueness of each piece of wood, as well as the on-site temperature and humidity levels during application, can result in a wide variation of stain colour and tone on the finished product.

I am well informed of this information, and agree to purchase the above.

Purchaser:  Date: _____

Jaspa Painting & Decorating Inc. must receive a signed copy of this form prior to the application of any stain.

Gold Park Homes Décor

GOLDPARK
WORTH MORE™

Centre Disclaimers

Through years of doing business, we at Gold Park Homes have encountered issues beyond our control. The following disclaimers apply to all instances of Purchaser's Extras forms and all Interior Colour Scheme forms.

FIREPLACES

Fireplace Marble: Due to the many variables that can affect the pattern and/or design, frequently the marble installed on the fireplace will not be identical to the samples. We will make every attempt to come as close to the samples as possible, but cannot be responsible for results which differ from the samples.

CERAMIC FLOOR TILE

Many variables including variegation can affect tile colour, pattern and/or design which mean installed tiles may not be identical to the samples. We will make every attempt to come as close as possible, but cannot be responsible for results which differ from the samples.

HARDWOOD FLOORING

The purchaser is advised that cupping and shrinkage are characteristics of hardwood flooring normally appearing after installation, especially when humidity levels are not regulated, and no warranty is provided by the flooring supplier with respect to such cupping and shrinkage. Furthermore, hardwood floors may also heave and warp when located at or close to entrance points of the home, where rain could make its way to the flooring. The vendor agrees to install any hardwood flooring ordered by the purchaser in a good and workmanlike manner, but shall not be responsible for, and is hereby released by the purchaser from responsibility and liability for cupping, shrinkage, heaving and warping of hardwood flooring in the above mentioned circumstances.

STAIRCASE VS FLOORING

WOOD SPECIES DIFFERENCE

The purchaser is aware and therefore accepts and acknowledges that the wood species of the staircase and flooring chosen do not match. This difference might result in an undesirable colour variance

The purchaser is aware and therefore accepts and acknowledges that though the flooring is of the same species as the staircase the difference in product finishing may result in a stain colour variance.

The purchaser agrees that the vendor is to be exempt from any and all claims by the purchaser regarding this colour variance.

RAILINGS

All railings, pickets, posts, nosing's and stairs come from solid wood and veneered wood materials sourced from multiple locations and sources. As such there will be variations in grains and shades between the various natural components beyond our control. Due to this variance in material, all components will stain with colour or natural finish differently.

Iron pickets are wrought in nature and depending on the manufacturing process will have differences from picket to picket which is normal. Also the finish of the iron pickets is of a powder coated nature. This process can produce minor colour variations or tones. Furthermore, the assembly of the metal pickets can develop a natural rattle over time from vibration in the railing. Minor rattling is normal and is a part of the wrought iron picket assembly.

HOUSE EXTERIORS

Variations in subcontractors across different sites and varying site conditions may result in house exteriors that differ from the artist renderings. We cannot be responsible for results which differ from the artists renderings of elevations.

PLASTER MOULDINGS AND MEDALLIONS

Plaster mouldings will not be installed in open to above areas or areas with 2 storey elements.

STAIN COLOURS

Due to the many variables that can affect the outcome of a stain colour on wood, staircases, railings, and fireplaces, the colour may not be identical to samples. Factors such as density, age, humidity, air temperature, and the uniqueness of each piece of wood can result in wide variations in darkness or lightness. We will make every attempt to come as close to the sample as possible, but cannot be responsible for results which differ from the samples.

Stain on pre-finished hardwood floors will not be an exact match to the stain colours available on stairs, pickets and rails. The purchaser is responsible for choosing the stain on these areas to their satisfaction.

IN-WALL CONDUIT FOR AUDIO/VIDEO CABLES

It is important to note that due to the variation in framing requirements in different parts of your home, conduit lengths and routing can vary. In virtually all instances of ground floor installation (I.e. above a fireplace), conduit will first travel down into the basement below the floor joists, over to the termination point and back up into the main floor. As a result, it is best to measure the length of the conduit after occupancy with a "pull wire" before

X 

purchasing your cables. For above-fireplace installations, the conduit wall plate will be installed approximately 10" above the Fireplace Mantle, unless otherwise specified in the Construction Summary.

APPLIANCE SPECIFICATIONS

All appliance openings are set to builder's standard openings. Please advise Décor Centre at time of your structural appointment if custom sizing of cabinets is required for any built - in appliances. The purchaser is responsible for costs and fees associated with changes to pre-manufactured kitchens made subsequent to colour appointments.

Purchaser accepts & acknowledges that in order to accommodate upgraded appliances, all appliance specifications should be provided at the time of their structural appointment, should this not occur they must be provided to the Décor Center within one (1) week of completion of structural chart. Failure to do so may result in the need to revert to the standard appliance openings or in a delay in construction of your dwelling, as well as a cost of \$500 to re-open your structural file should changes be required. As a result we may be forced to extend the closing of your transaction. Due to failure to complete the above-mentioned selections and at no fault of our own, we reserve our right to hold you responsible for this delayed closing, including charging extra administration cost and interest on the balance due on closing.

Purchasers Accept Standard Appliance Openings (unless otherwise specified):

Fridge - 37-1/2"W x 73-1/2" High Approx.

Range - 30-1/2"D x 31-1/2"W Approx.

Dishwasher - 24" W Approx.

DELETION OF HOODFAN & CABINETS ABOVE STOVE:

The purchasers are aware that in requesting NOT TO INSTALL builder's standard hood fan and standard cabinets above stove they will receive NO STANDARD HOOD FAN and NO CREDIT. Purchasers are installing their own hood fan after closing and accept that it may waive any warranty associated with such a change.

Purchasers accept and acknowledge that the exhaust fan duct hole may be off-centered with the stove in the kitchen due to purchasers installing their own hood fan after closing. The vendor is exempt from adjusting such openings for the purchasers range hood.

ELECTRICAL FOR APPLIANCES

Pricing is subject to change based on the appliance specifications provided. Purchasers should provide proper appliance specifications and cut-out sheets in order for Gold Park to price extras accordingly.

KITCHEN CABINETS

The kitchen you order/purchase will undoubtedly contain slight colour variations. The degree of these variations is virtually impossible to determine before the kitchen is installed in its intended location. The amount of and type of lighting will also affect various highlights in the finish. Note: No two pieces of wood are identical. Variations in colour tone and grain patterns make a perfect colour match virtually impossible. It is generally agreed that these variations add to the natural beauty of a wood kitchen.

STAIN

Charcoal is a spray stain applied to Oak and Maple products with several characteristics that are important to be aware of when purchasing this product.

1. Shadow lines may be visible at the interior profile edges of a door or drawer front. If movement occurs shadow lines may increase or decrease, depending on the style and/or size of a door or drawer front.
2. Variation and unevenness may be visible in the finish.
3. Hairline cracks at the joints are created over time due to the nature of natural wood, caused by usage, humidity**, or dryness. They tend to be more visible to darker stains, than lighter wood stains.

** Relative humidity is recommended to be between 45% and 55%. Please refer to Cortina Kitchens "Cleaning, Care, Maintenance, & Warranty Information" guide.

Please be advised that Cortina Kitchens will not replace doors and/or parts that exhibit the above characteristics associated with this finish. These characteristics are not avoidable and are a result of the natural characteristics of wood and wood veneer, and the characteristics of darker stains on wood. The Charcoal stain is not available on doors in Group IV, Group IVA, Group V and Group VA.

Cortina Kitchens offers a wide variety of finishes, applied to oak and maple products. The subject finishes include the spray stains Cocoa, Espresso, Graphite as well as wiping stain Ebony.

Due to the very dark stains applied on natural maple and oak doors and joints, several characteristics are important to be noted when purchasing these products.

1. Shadow lines may be visible at the interior profile edges of a door or drawer front. If movement occurs shadow lines may increase or decrease, depending on the style and/or size of a door or drawer front.
2. Variation and unevenness may be visible in the finish.
3. Hairline cracks at the joints are created over time due to the nature of natural wood, caused by usage, humidity, or dryness. They tend to be more visible to darker stains, than lighter wood stains.

Please be advised that Cortina Kitchens will not replace doors nor parts that exhibit the above characteristics associated with this finish. These characteristics are not avoidable and are a result of the natural characteristics of wood and wood veneer, and the characteristics of darker stains on wood.

CABINETRY DOOR HARDWARE

Cortina Kitchens' cabinetry doors and drawer fronts will be drilled to accept a standard knob or handle selected from Cortina's hardware boards. This drilling comes standard with the order, and is done ONLY in our shop, not on the job site.

For those not wanting Cortina's hardware drilling, the following applies:

No holes to be drilled on the doors and drawer fronts should be specified in writing on the colour chart and the P.O. If while in production, Cortina Kitchens misses this request, Cortina Kitchens and the Builder will not be held responsible to replace any or all doors and drawer fronts affected, and the customer agrees to accept the product as is. No hardware will be supplied or credited by Cortina Kitchens with this request. No charge will apply for this request.

PVC DOORS

All cabinets with PVC (Thermofoil) Doors come with melamine gables, panels and kick.

The doors, crown moulding and light valance are PVC wrapped. Open shelves incorporated in design will only be available with melamine interiors. There will be variations in colour shades between the PVC parts (doors, crown and Light valance) and the melamine parts (open shelves, Gables, Panels and Kick) due to the difference in material.

Furring Panel with crown moulding to the ceiling is not available on all PVC door styles due to subtle variations in colour shades between the PVC parts (moulding) and the melamine parts (furring panel) due to the difference in material. Grain directions in wood grain pattern melamine, vary between the furring panel, crown moulding (horizontal) and the PVC doors (vertical).

GRANITE, MARBLE ENGINEERED SURFACES WAIVER

Granite and marble are naturally occurring products, and due to the many variables that can affect the pattern, colour and/or design and "pitting" of natural products slabs installed will not be identical to the samples displayed. We will make every attempt to come as close to the samples as possible, but cannot be responsible for results which differ from the samples. Every effort is made to provide granite counter tops as close as possible but the vendor is not responsible for results which differ from the sample displayed. All countertop surfaces may have seems & product pattern & shade can change in areas containing seems.

RESELECTIONS

It is not uncommon for flooring, such as tile, to become discontinued prior to its installation. Therefore it may be necessary to make a reselection of certain materials sometime during the build process. We cannot assure you that another choice approximating your selection will be available.

PLANS

Plans are subject to change without notice. Actual usable floor space may vary from the stated floor area. Layout for kitchen, furnace, HWT and laundry tub may vary from plan. Vertical and horizontal bulkhead, which are not shown on plan, may be required for plumbing and heating runs. E.& O.E.

PLEASE NOTE:

In the event the work on the house has progressed beyond the point where the items covered by these invoices cannot be installed without entailing any unusual expense, then this order is to be cancelled and any deposit paid in connection with the same is to be refunded to the purchaser.

The vendor will undertake to incorporate the work covered by the sales extra in the construction of the house but will not be liable to the purchaser in any way, if for any reason the work covered by the extra is not carried out. In that event, any monies paid in connection with the same shall be returned to the purchaser.

It is understood and agreed that if for any reason whatsoever the transaction of Purchase and Sale is not completed, the total cost of extras ordered are not refundable to the Purchaser(s).

Extras or changes will not be processed unless signed by the Vendor.

These extras may not be amended without the written consent of Gold Park Homes.

The purchaser(s) and the builder acknowledge and agree that this "Purchaser's Extra" form shall not be deemed to be part of the agreement of purchase and sale entered into between them, nor an addendum thereto.

No postdated cheques will be accepted.

No estimates or orders will be accepted once construction has commenced.


Should a refund be requested on any extras purchased, an 80% reimbursement of the purchase price will be given. (a \$50.00 minimum charge and a maximum \$250.00 charge will apply)

Estimates will only be considered when resubmitted on a signed Purchaser Extras form, accompanied by payment in full.

All prices are estimates only and may be subject to change. Should a change in price occur Gold Park Homes reserves the right to request from the purchaser an adjustment of the price or a refund limited to that item.

Purchasers are aware & accept that ANY changes made to upgrades after signing the Purchasers Extra Form are subject to a minimum administration fee of \$500. PLUS a 10% holdback fee.

Purchasers are aware that any request to add a percentage of upgrades from the purchaser's extras form will be processed only after the builder receives approval letter from the bank.

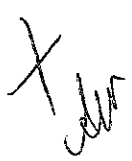


Please be advised that your failure to finalize your structural or colour selections may result in a delay in construction of your dwelling and we may have to extend closing of your transaction. Due to failure to complete the above-mentioned selections and at no fault of us, we reserve our right to hold you responsible for a delayed closing, including charging extra administration cost and interest on the balance due on closing.

Purchaser has attended a Colour appointment at the Decor Centre & has DECLINED any additional upgrades and accepts and acknowledges that there will be no further structural changes/additions/deletions to be made upon signing.

I hereby acknowledge reading and understanding the above copy and will not hold Gold Park Homes responsible for any issues in relation to above.

Purchasers Signatures

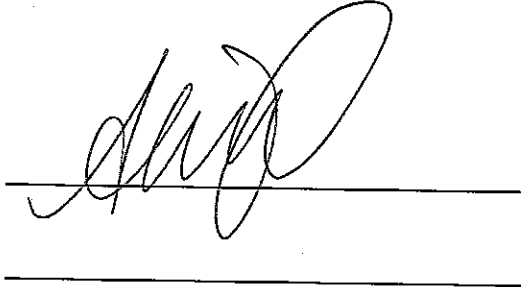A handwritten signature in black ink, appearing to be 'MJP', is written over a horizontal line. Below this line is another horizontal line.

Date

Feb. 20. 2018