Kleinburg GLEN

KG 28
April 7 2018

the Carlton

Elevation A • 3,354 sq.ft.
Elevation B • 3,361 sq.ft.

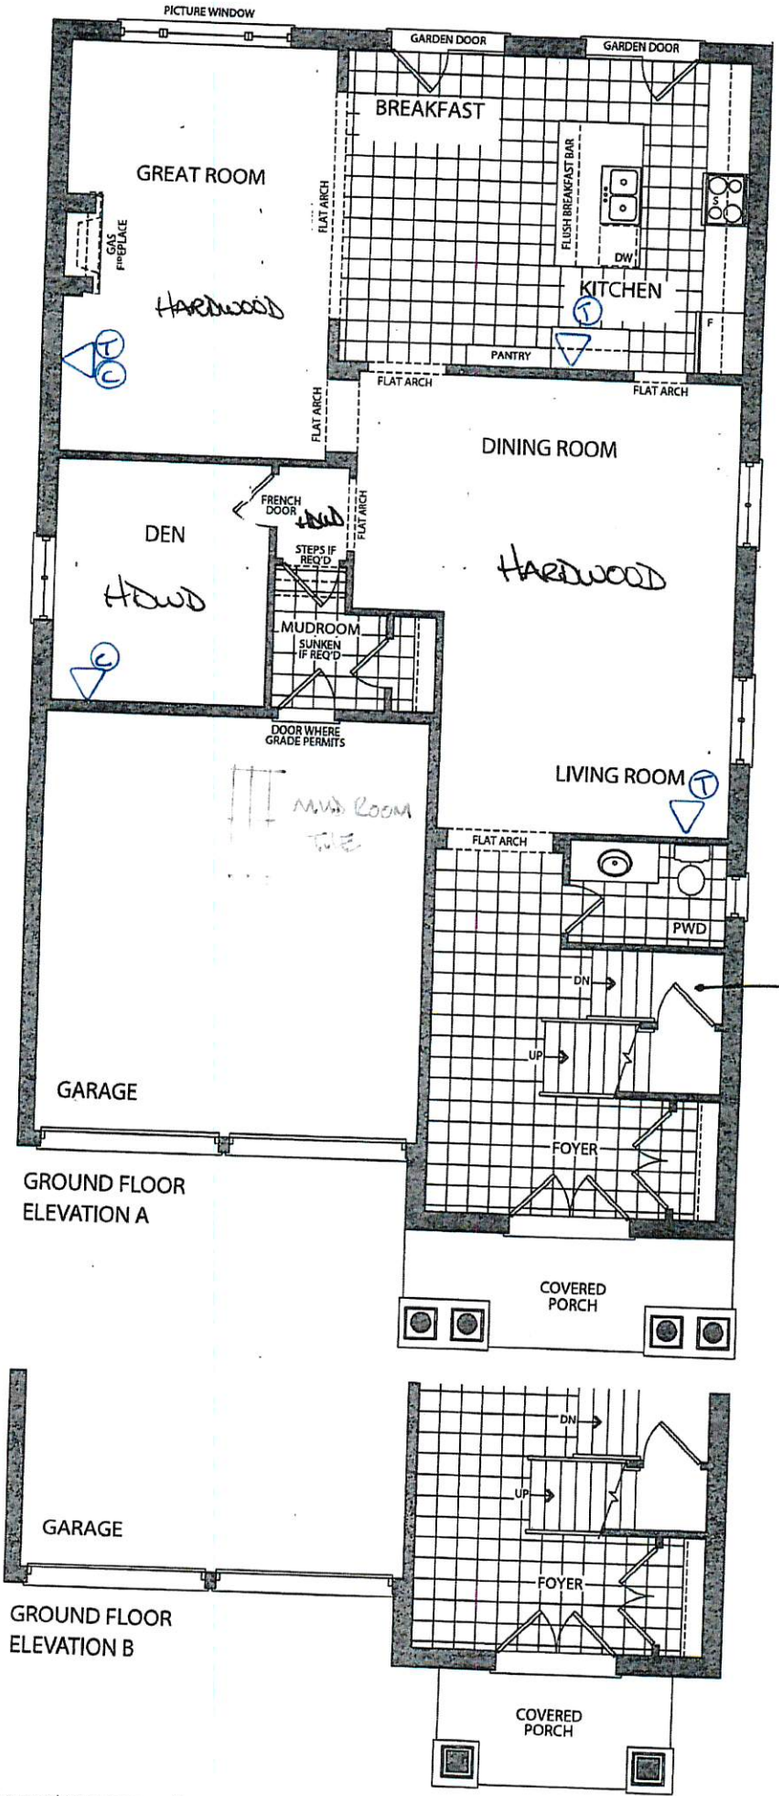

LEGEND

T PHONE

C CABLE

Prices, figures, illustrations, sizes, features and finishes are subject to change without notice. E.&O.E. Areas and dimensions are approximate and actual usable floor space may vary from the stated area. Layout may be reverse of the unit purchased. E. & O.E.

GOLDPARK HOMES

Kleinburg GLEN

KG 28
April 16 2018

the Carlton

Elevation A • 3,354 sq.ft.
→ Elevation B • 3,361 sq.ft.

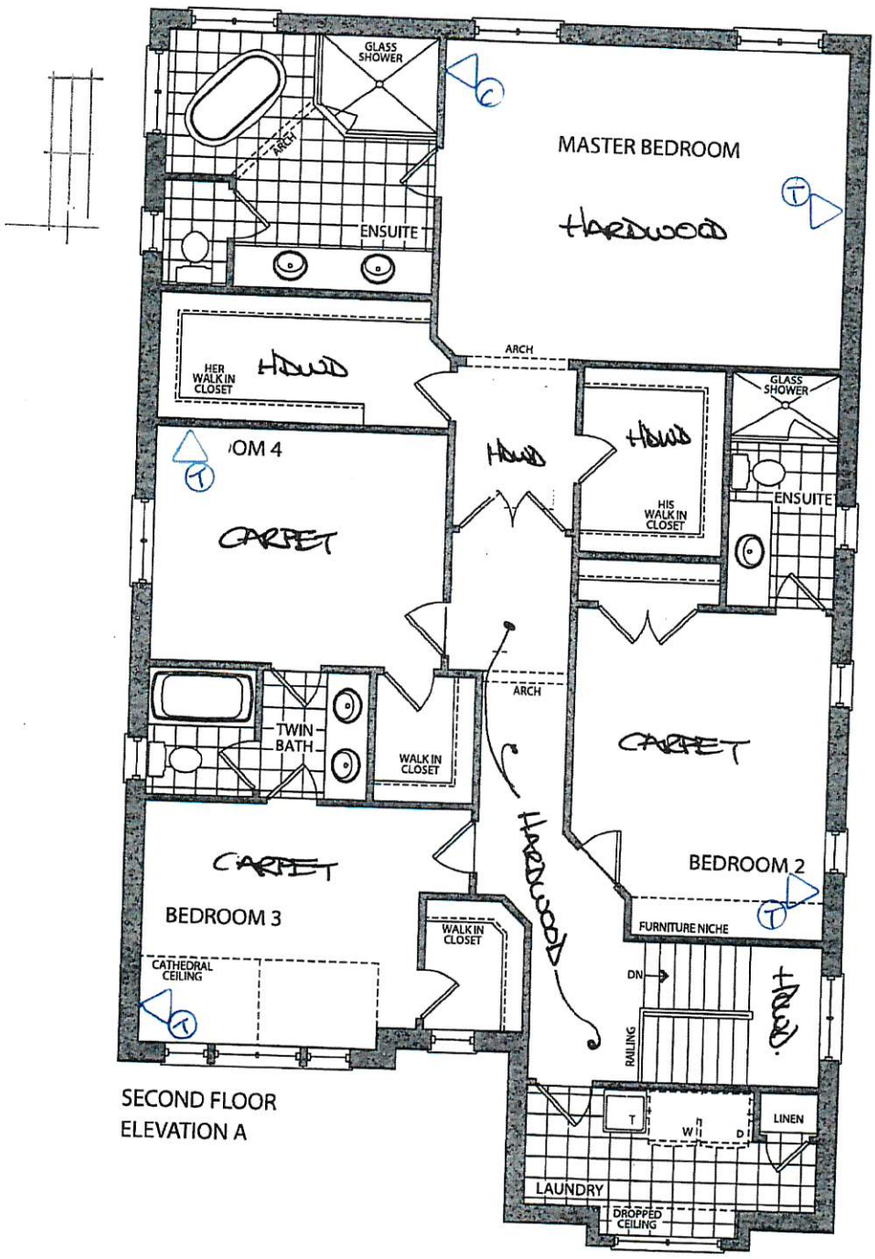

SECOND FLOOR
ELEVATION A

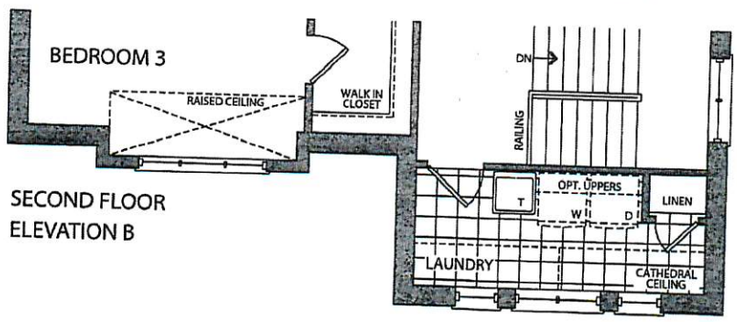

SECOND FLOOR
→ ELEVATION B

Prices, figures, illustrations, sizes, features and finishes are subject to change without notice. E.&O.E. Areas and dimensions are approximate and actual usable floor space may vary from the stated area. Layout may be reverse of the unit purchased. E. & O.E.

GOLDPARK HOMES

Kleinburg GLEN

KG-28
April 10 2018

the Carlton

Elevation A • **3,354** sq.ft.
Elevation B • **3,361** sq.ft.

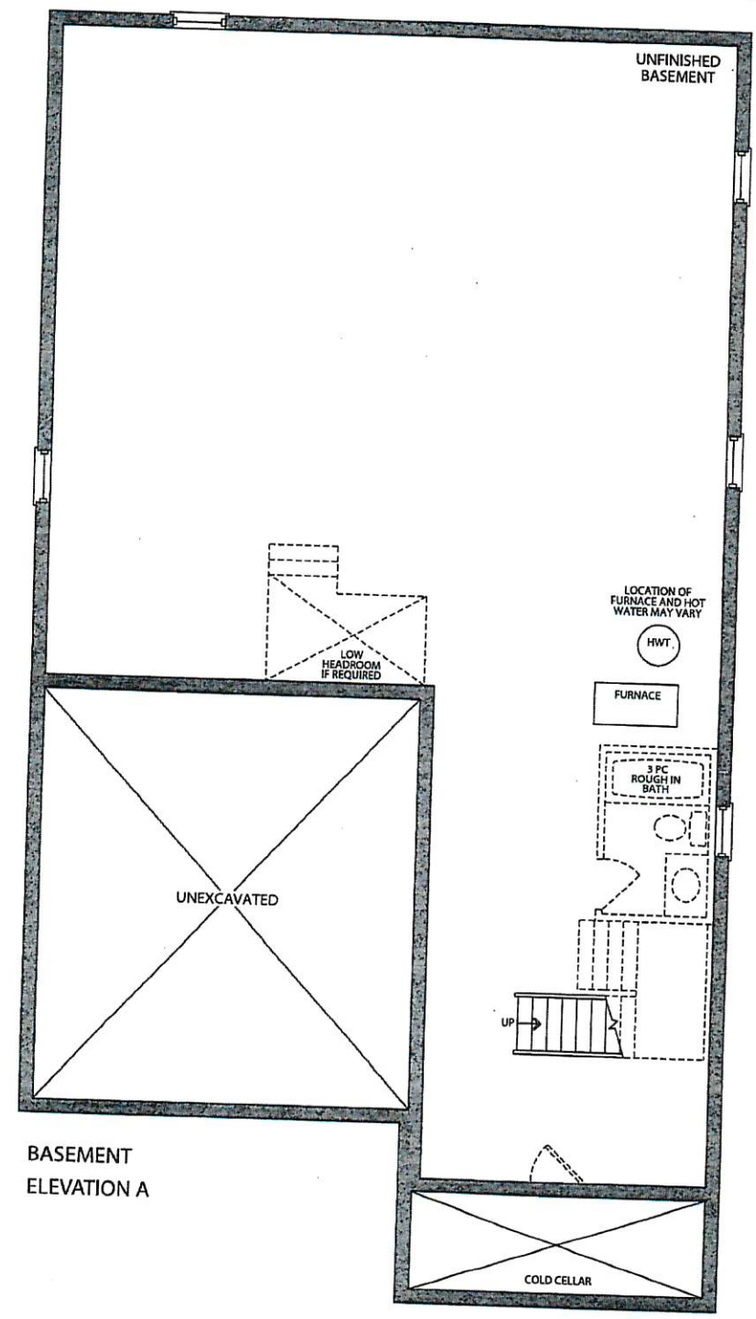

BASEMENT
ELEVATION A

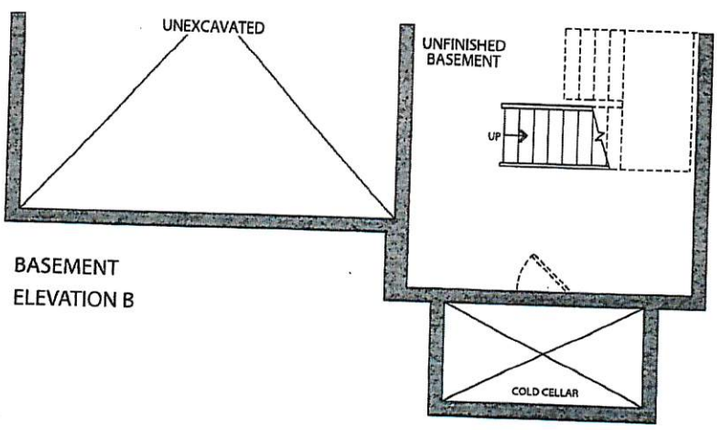

BASEMENT
ELEVATION B

Prices, figures, illustrations, sizes, features and finishes are subject to change without notice. E.&O.E. Areas and dimensions are approximate and actual usable floor space may vary from the stated area. Layout may be reverse of the unit purchased. E. & O.E.

GOLDPARK HOMES