


- (RC) COMPLETE ROOF (INCLUDING REAR) CONNECTED TO FRONT.
(RF) HALF ROOF CONNECTED TO FRONT DOWNSPOUT AND CONNECTED TO RDC SERVICE CONNECTION.
(RR) HALF ROOF CONNECTED TO REAR DOWNSPOUT AND CONNECTED TO INFILTRATION TRENCH.
- 1.1 - ROOF DRAINS TO BE CONNECTED AT THE FRONT TO RDC SERVICE CONNECTION FOR ROOF CONFIGURATIONS RC, RF, & RR (REFER TO SCS DWG. 906 DETAIL B)
1.2 - IF ROOF CONFIGURATION IS RF OR RC, FRONT ROOF DRAINS TO BE CONNECTED TO FRONT DOWNSPOUT & CONNECTED TO RDC SERVICE CONNECTION. (REFER TO SCS DWG. 906 DETAIL B)
1.3 - IF ROOF CONFIGURATION IS RR, REAR ROOF DRAINS TO BE CONNECTED TO REAR ROOF DOWNSPOUT AND CONNECTED TO INFILTRATION TRENCH (REFER TO SCS DWG. 906 DETAIL A)
1.4 - THE CONTRACTOR SHALL CHECK AND VERIFY ALL GIVEN GRADE ELEVATIONS PRIOR TO COMMENCEMENT OF CONSTRUCTION. FOOTINGS TO BEAR ON NATURAL UNDISTURBED SOIL OR ROCK AND TO BE A MINIMUM OF 1.22m BELOW FINISHED GRADE.
1.5 - ALL FRONT AND REAR YARDS SHALL BE GRADED AT A 2%-5% GRADE WITHIN 6.0m OF THE DWELLING UNIT.
1.6 - MAXIMUM DRIVEWAY SLOPE SHALL BE 8%.
1.7 - THE MAXIMUM ALLOWABLE SLOPE IS 3:1 (HORIZONTAL AND VERTICAL) WITH A MAXIMUM ELEVATION DIFFERENCE OD 500mm.
1.8 - DRIVEWAYS TO BE SET BACK A MINIMUM OF 1.0m, FROM ABOVE GROUND SERVICES OR OTHER OBSTRUCTION.
1.9 - LOT HIGH POINT (HP) TO BE 2.0m UPSTREAM OF DOWNSPOUTS
1.10 - ROOF LEADER EMERGENCY OVERFLOW TO DISCHARGE VIA SPLASH PAD. (REFER TO SCS DWG. 906 DETAIL A FOR ROOF CONFIGURATION RR AND DETAIL B FOR ROOF CONFIGURATION RC & RF)
1.11 - INFILTRATION TRENCHES NOT TO CROSS BETWEEN LOT LINES. (REFER TO SCS DWG. 906 DETAIL A)
1.12 - IF ROOF CONFIGURATION IS RR, REAR ROOF DOWNSPOUTS CONNECTED TO 100mmØ CAP. REMOVE CAP AND CONNECT TO REAR LOT INFILTRATION TRENCH. BUILDER IS RESPONSIBLE TO BUILD THE REAR YARD ROOF LEADER CONNECTION TO THE CAP AT THE TRENCHES (TYP.) REFER TO SCS DWG. 906 DETAIL A.
1.13 - BUILDER TO REFER TO SCS DWG. 906 DETAILS A & B FOR DETAILS ON THE INFILTRATION TRENCH.

- LOT _____
- WE HAVE REVIEWED THE SITE AND GRADING PLAN FOR THE PROPOSED BUILDING TO BE CONSTRUCTED, AND HEREBY CERTIFY THAT:
1. The proposed grading and appurtenant drainage works comply with sound engineering principles.
 2. The proposed grading is in conformity with the grading plan approval for this subdivision and will not adversely affect adjacent lands.
 3. The proposed building is compatible with the proposed grading.
 4. The proposed water service curb stop is to be located in the grassed portion of the front yard.
 5. The driveway conforms with the City of Vaughan By-Law 1-88 as amended and is a minimum 1.0 metre clear of all street landscape catch basins.
 6. The proposed building is a minimum of 0.6 m side yard setback from a drainage swale.

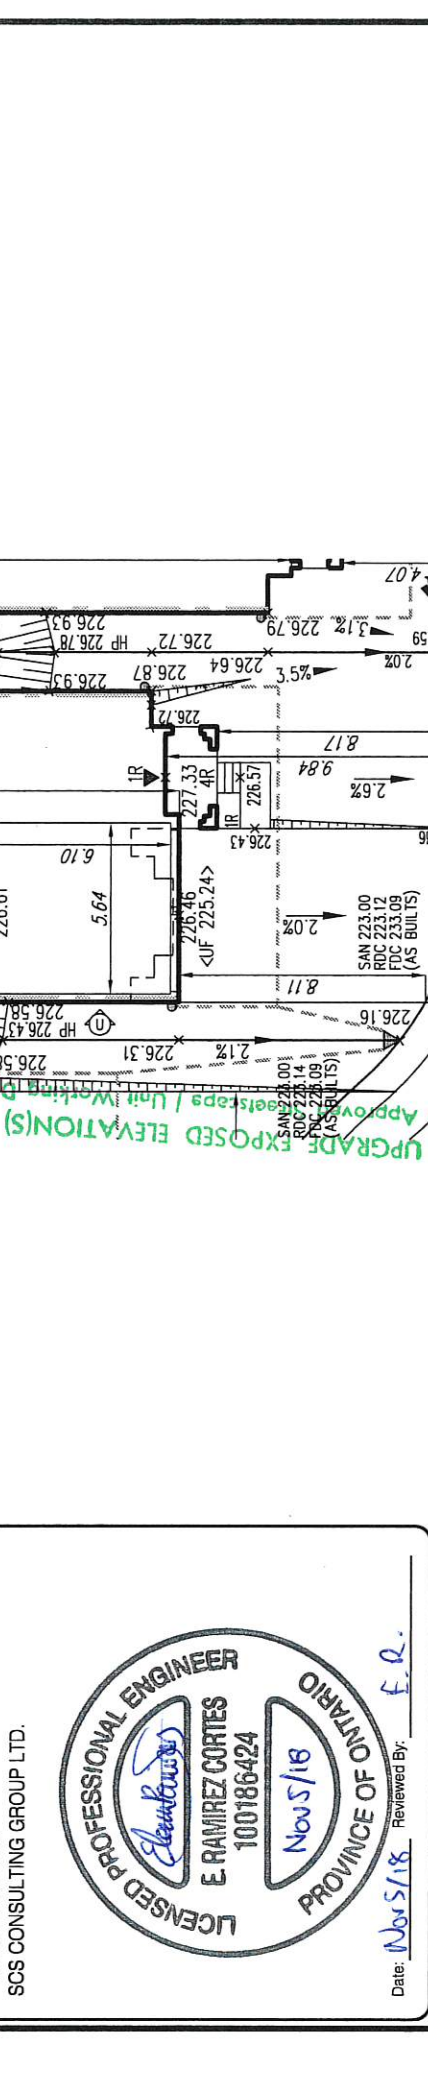

COVERAGE CALCULATION	
LOT NO. :	90
LOT AREA :	510.49 m2
BLDG. AREA : (NET FLOOR)	201.32 m2
LOT COVERAGE :	39.44 %
LANDSCAPE AREA:	242.93 m2
LANDSCAPE COV. :	47.59 %

BUILDING HEIGHT	
MAX BUILDING HEIGHT:	11.00 m
FROM AVERAGE FIN. GRADE @ FRONT OF BUILDING TO MEAN	
ESTABLISHED GRADE:	226.67
F.F. TO TOP OF ROOF:	10.98 m
F.F. TO MEAN OF ROOF:	8.58 m
PROPOSED BLDG. HGT:	9.19 m
FRONT YARD LANDSCAPE AREA	
FRONT YARD AREA :	100.43 m ²
LANDSCAPE AREA :	55.57 m ²
COVERAGE (60% MIN.) :	55.33 %
SOFT LANDSCAPE AREA:	52.90 m ²
SOFT COVERAGE (60% MIN.):	95.20 %
REAR YARD LANDSCAPE AREA	
REAR YARD AREA :	129.16 m ²
SOFT LANDSCAPE AREA :	127.41 m ²
COVERAGE (60% MIN.):	98.65 %

It is the builder's complete responsibility to ensure that all plans submitted for approval fully comply with the Architectural Guidelines and all applicable regulations and requirements including zoning provisions and any provisions in the subdivision agreement. The Control Authority reserves the right to review, examine or approve site (lotting) plans or working drawings with respect to any zoning or building code or permit matter or that any house can be properly built or located on its lot.

This is to certify that these plans comply with the applicable Architectural Design Guidelines approved by the City of VAUGHAN.

ARCHITECTURAL REVIEW & APPROVAL

NOV 06 2018

John G. Williams Limited, Architect

GENERAL NOTES: 1. BUILDER TO VERIFY LOCATION OF UTILITIES AND OTHER SERVICES. IF MIN. DIMENSIONS ARE NOT MAINTAINED, BUILDER IS TO RELOCATE AT BUILDER'S EXPENSE. 2. BUILDER TO VERIFY ELEV. OF STM. AND SAN. LATERALS IN RELATION TO BASEMENT US OF FOOTING ELEVATIONS FOR COMPLIANCE WITH MUNICIPAL STANDARDS PRIOR TO EXCAVATION. 3. APPROVED PERMIT DRAWINGS & CONSTRUCTION NOTES MUST BE REVIEWED AND FOLLOWED IN CONJUNCTION WITH THE SITING AND GRADING PLAN. BUILDER TO VERIFY BUILDING ENVELOPE ON SITE PLAN MATCHES APPROVED PERMIT DRAWINGS & CONSTRUCTION NOTES PRIOR TO POURING CONCRETE. IF THERE ARE ANY DISCREPANCIES, THEY ARE TO BE BROUGHT TO THE ATTENTION OF HUNT DESIGN ASSOCIATES INC. 4. UNLESS NOTED ON BUILDING ENVELOPE OR APPROVED PERMIT DRAWINGS & CONSTRUCTION NOTES, ALL TOP OF FOUNDATION WALLS INCLUDING GARAGE WALLS TO BE CONSISTENT WITH THE ELEVATION PROVIDED FOR TRM ON SITING AND GRADING PLAN. THE EXTERIOR OF THE FOUNDATION WALL TO BE PROVIDED WITH A REDUCTION OF THICKNESS FOR MASONRY VENEER AS REQUIRED.	
-	-
-	-
-	-
-	-
REVISED AS PER ENGINEER & REISSUED FOR FINAL	OF 2018/11/01
ISSUED FOR FINAL APPROVAL	OF 2018/10/25
ISSUED FOR PRELIMINARY APPROVAL	OF 2018/10/15

GENERAL NOTES:

1. BUILDER TO VERIFY LOCATION OF UTILITIES AND OTHER SERVICES. IF MIN. DIMENSIONS ARE NOT MAINTAINED, BUILDER IS TO RELOCATE AT BUILDER'S EXPENSE.
2. BUILDER TO VERIFY ELEV. OF STM. AND SAN. LATERALS IN RELATION TO BASEMENT USE OF FOOTING ELEVATIONS FOR COMPLIANCE WITH MUNICIPAL STANDARDS PRIOR TO EXCAVATION.
3. APPROVED PERMIT DRAWINGS & CONSTRUCTION NOTES MUST BE REVIEWED AND FOLLOWED IN CONJUNCTION WITH THE SITING AND GRADING PLAN. BUILDER TO VERIFY BUILDING ENVELOPE ON SITE

4. UNLESS NOTED ON BUILDING ENVELOPE OR APPROVED PERMIT DRAWINGS & CONSTRUCTION NOTES, ALL TOP OF FOUNDATION WALLS INCLUDING GARAGE WALLS TO BE CONSISTENT WITH THE ELEVATION


ISSUED FOR FINAL APPROVAL	OF	2018/10/25

DOWNPOUTS	SLUMP PUMP AND SURFACE DISCHARGE LOCATION	FF	FINISHED FLOOR
WINDOWS PERMITTED	DISCHARGE LOCATION	FW	TOP OF FOUNDATION WALL
SUBGRADE DISTANCE IS LESS THAN 4 FEET (NO WINDOWS PERMITTED)	CHAIN LINK FENCE	WOD	WALKOUT DECK
EXTERIOR DOOR LOCATION	FENCE AND GATE	WOB	WALKOUT BASEMENT
EXTERIOR DOOR LOCATION	PRIVACY FENCE	WOD	WALKOUT DECK
IF GRADE PERMITS	ACQUSTIC FENCE	REV	REVERSED
	NO DOOR	ND	NO DOOR
	HIGHLIGHTED GRADE	XXX	HIGHLIGHTED GRADE

Name

PHILOSOPHIES COURT

MES - 217020

File Number	Lot / Page Number
217020W/SP01	90

L3R 0J7 T 905.737.5133 F 905.737.7326


All readers should view related documents and design as the complete property of Hines Design Associates (HDA). Reproduction of this property in whole or in part is strictly prohibited without HDA's written permission. HDA assumes no responsibility or liability for this property unless it bears the appropriate B24 number and original signature.