
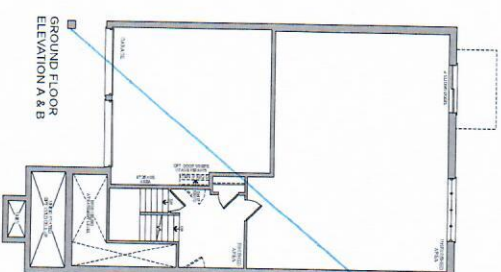
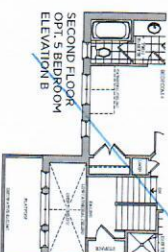
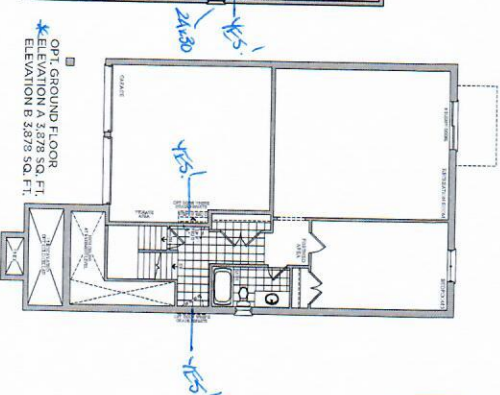
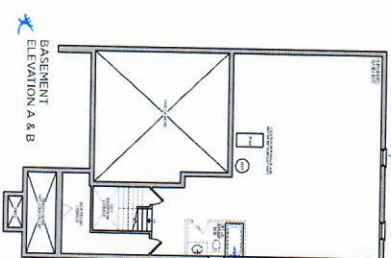
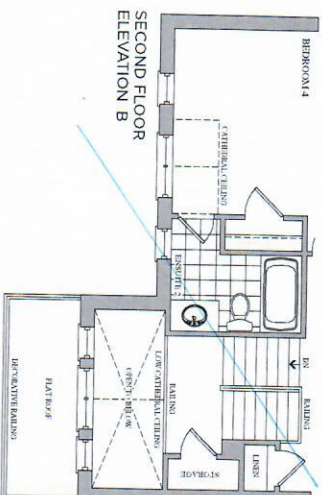
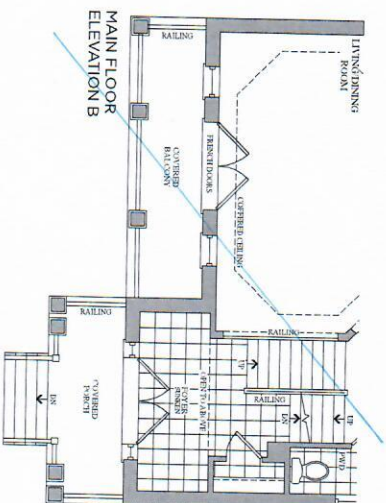
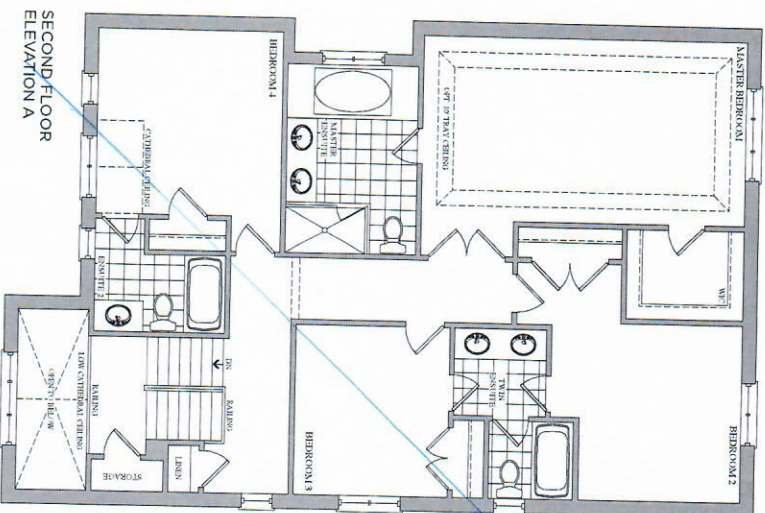


BE-2-26 *REVISED* - 5 EDM

The Corelli 38' SERIES

Elevation A • 3,878 sq.ft.
Elevation B • 3,878 sq.ft.

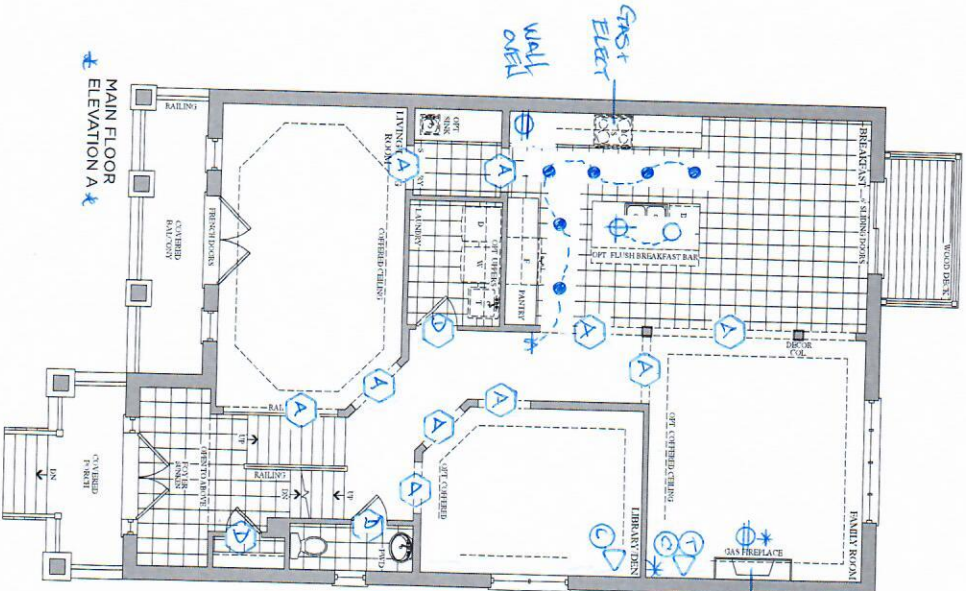

SCHEDULE 'F'

VENDOR
PURCHASER
PURCHASER

GOLD PARK
WORTH MORE™

Prices, figures, illustrations, sizes, features and finishes are subject to change without notice. Areas and dimensions are approximate and actual usable floor space may vary from the stated area. Layout may be reverse of the unit purchased. E. & O.E.