

Brampton Encore - 70L - 2 - 28-7 Elev.A Wagner
CONCRETE AND DRAIN

Inv.2,093	1 - 3PC Basement Rough-In
Line29779	Note:
15Oct19 / 19Nov19	

Exterior Colours

Inv.2,093	1 - Exterior Colour Package #9
Line29798	Note:
15Oct19 / 19Nov19	

FORMING

Inv.2,093	1 - Garage ManDoor
Line29780	Note:
15Oct19 / 19Nov19	

FRAMING

Inv.2,093	1 - MANDOOR - GARAGE TO HOUSE- AS PER PLAN AND GRADE PERMITING
Line29341	Note:
15Oct19 / 19Nov19	

PLUMBING

Inv.2,093	1 - ROUGH-IN - 3PC BASEMENT ROUGH-IN
Line29339	Note:
15Oct19 / 19Nov19	

WINDOWS - BASEMENT

Inv.2,093	4 - BASEMENT WINDOWS - UPGRADE EXISTING BASEMENT WINDOW TO 30 INCH X 24 INCH - MAY REQUIRE INSTALLATION OF WINDOW WELL
Line29340	Note:
15Oct19 / 19Nov19	


WINDOWS AND DOORS

Inv.2,093	1 - Garage Mandoor
Line29793	Note:
15Oct19 / 19Nov19	


BE2-70L
OCT 16 2019.

The
Wagner
SEMI SERIES

- Elevation A • 2,127 sq.ft.
- Elevation B • 2,117 sq.ft.
- Elevation C • 2,127 sq.ft.
- Elevation D • 2,127 sq.ft.

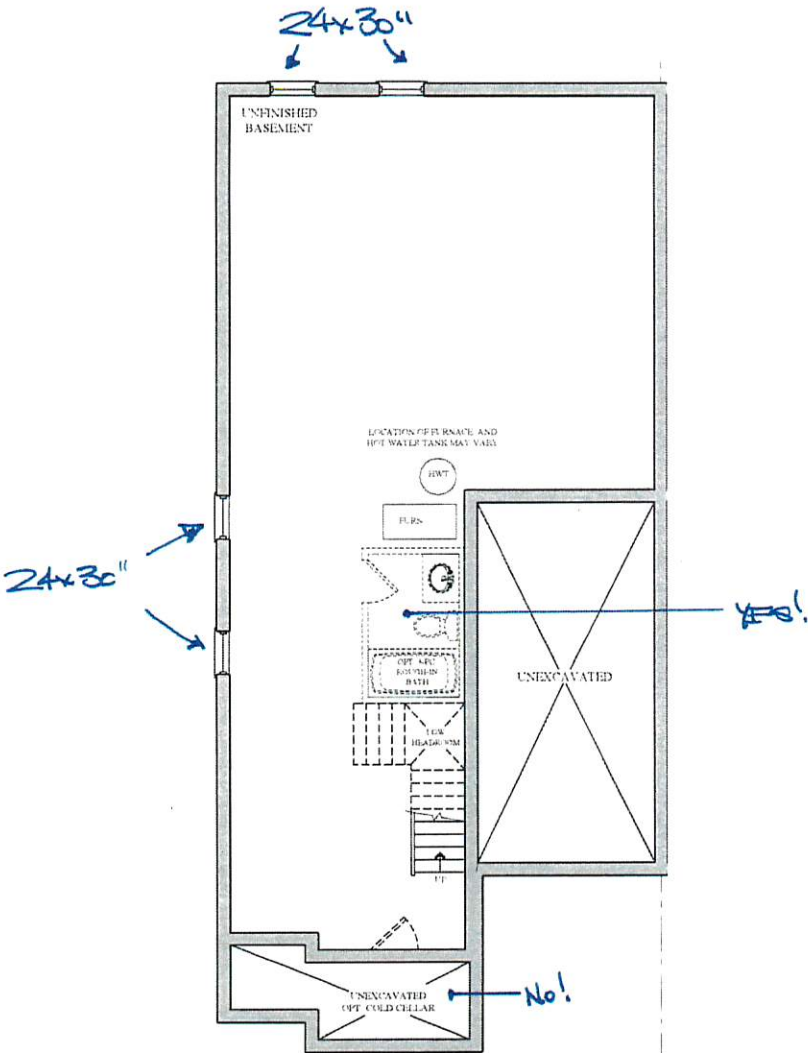

BASEMENT FLOOR PLAN
ELEV. 'A' & 'B'

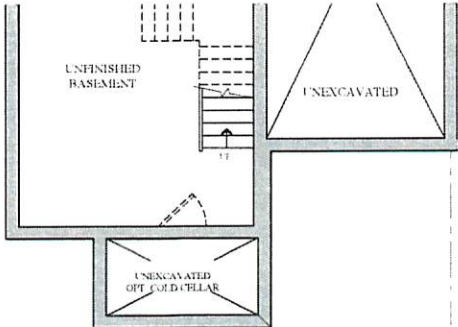

PART. BASEMENT FLOOR PLAN
ELEV. 'C' & 'D'


Prices, figures, illustrations, sizes, features and finishes are subject to change without notice. Areas and dimensions are approximate and actual usable floor space may vary from the stated area. Layout may be reverse of the unit purchased. E. & O.E.




BEZ-7d
OCT 16 2019

The Wagner SEMI SERIES

- Elevation A • 2,127 sq.ft.
- Elevation B • 2,117 sq.ft.
- Elevation C • 2,127 sq.ft.
- Elevation D • 2,127 sq.ft.

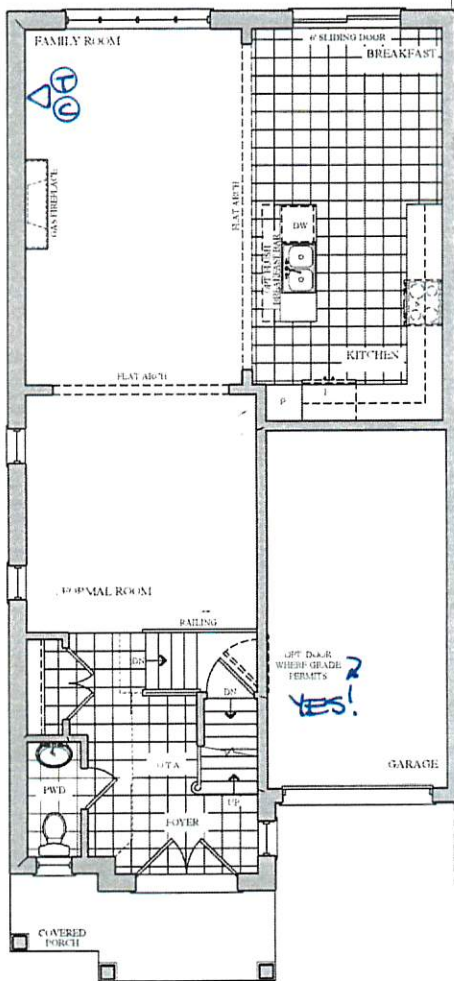

GROUND FLOOR PLAN
ELEV. 'A' & 'B'

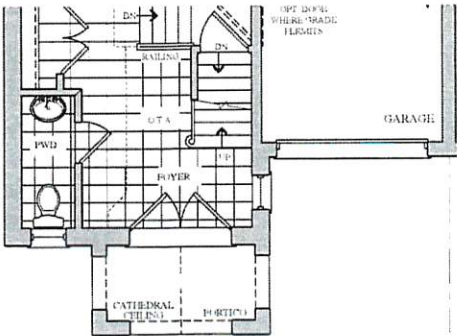

PART. GROUND FLOOR PLAN
ELEV. 'C' & 'D'


Prices, figures, illustrations, sizes, features and finishes are subject to change without notice. Areas and dimensions are approximate and actual usable floor space may vary from the stated area. Layout may be reverse of the unit purchased. E. & O.E.

GOLDPARK
WORTH MORE™


BEZ-70L
OCT. 16 2019

The
Wagner
SEMI SERIES


- Elevation A • 2,127 sq.ft.
- Elevation B • 2,117 sq.ft.
- Elevation C • 2,127 sq.ft.
- Elevation D • 2,127 sq.ft.

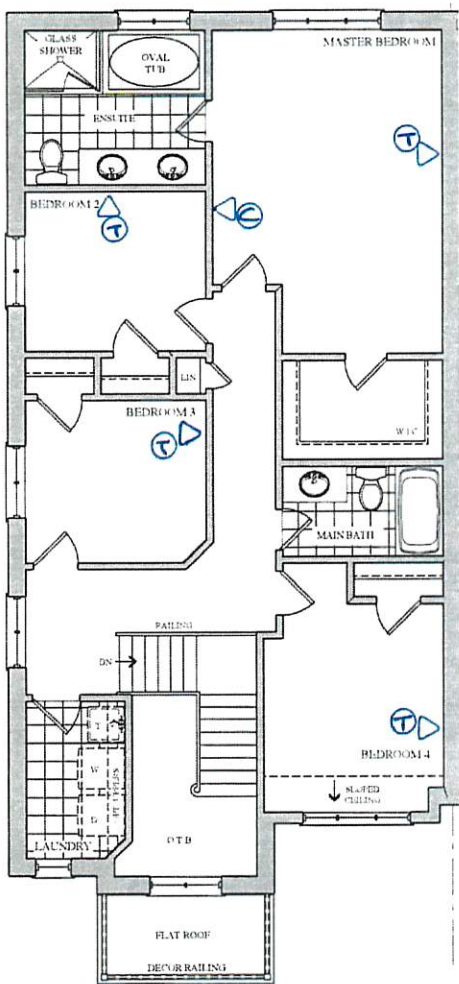


SECOND FLOOR PLAN
ELEV. 'A'

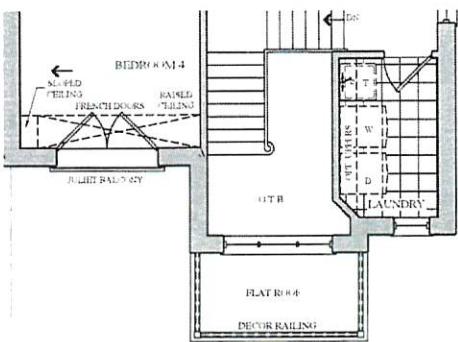

PART. SECOND FLOOR PLAN
ELEV. 'B'

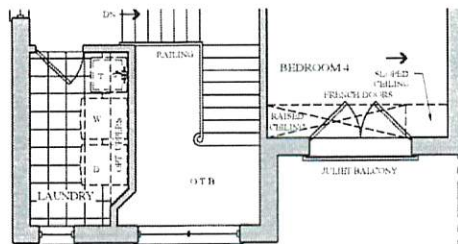

PART. SECOND FLOOR PLAN
ELEV. 'C'

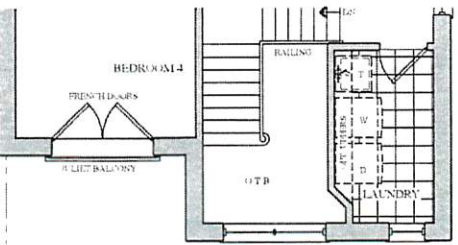

PART. SECOND FLOOR PLAN
ELEV. 'D'

Prices, figures, illustrations, sizes, features and finishes are subject to change without notice. Areas and dimensions are approximate and actual usable floor space may vary from the stated area. Layout may be reverse of the unit purchased. E. & O.E.