

Brampton Encore - 68L - 2 - 28-5 Elev.C Debussy

CONCRETE AND DRAIN

Inv.2,086	1 - 3PC Basement Rough-In
Line29804	Note:
3Oct19 / 20Nov19	

Exterior Colours

Inv.2,086	1 - Exterior Colour Package # 6
Line29805	Note:
3Oct19 / 20Nov19	

FRAMING

Inv.2,086	1 - MANDOOR - GARAGE TO HOUSE- AS PER PLAN AND GRADE PERMITING
Line29225	Note:
3Oct19 / 20Nov19	

PLUMBING

Inv.2,086	1 - ROUGH-IN - 3PC BASEMENT ROUGH-IN
Line29226	Note:
3Oct19 / 20Nov19	

WINDOWS - BASEMENT

Inv.2,086	1 - *NOTE* BASEMENT WINDOWS ARE LARGER DUE TO LOOK-OUT CONDITION
Line29232	Note:
3Oct19 / 20Nov19	

WINDOWS AND DOORS

Inv.2,086	1 - Garage Mandoor - Grade Permitting, As Per Plan
Line29803	Note:
3Oct19 / 20Nov19	


BE2-68L
OCT 7 2019

encore
BRAMPTON

The Debussy SEMI SERIES

Elevation A • 2,283 sq.ft.
Elevation B • 2,283 sq.ft.
Elevation C • 2,283 sq.ft.
Elevation D • 2,283 sq.ft.

* LARGER BASEMENT
WINDOWS → LOOK OUT.
CONDITION.

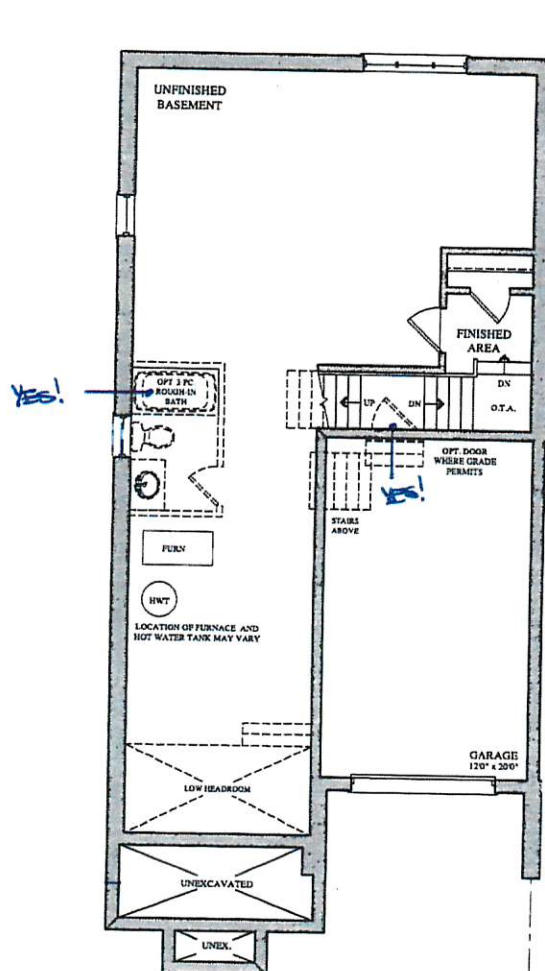

BASEMENT FLOOR PLAN
ELEV. 'A', 'B', 'C' & 'D'

BEZ-68L
Oct 7 2009.

encore
BRAMPTON


The Debussy SEMI SERIES

Elevation A • 2,283 sq.ft.


Elevation B • 2,283 sq.ft.

→ Elevation C • 2,283 sq.ft.

Elevation D • 2,283 sq.ft.

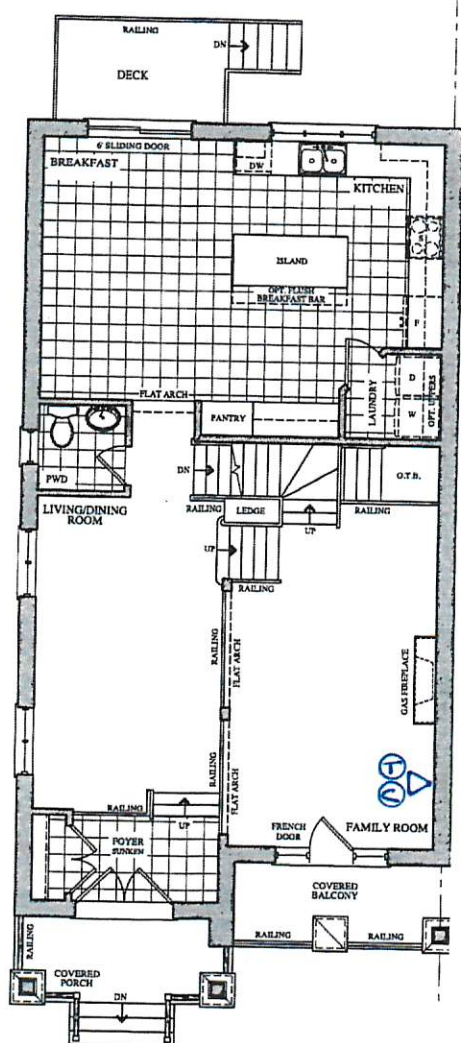

GROUND FLOOR PLAN
ELEV. 'A' & 'B'

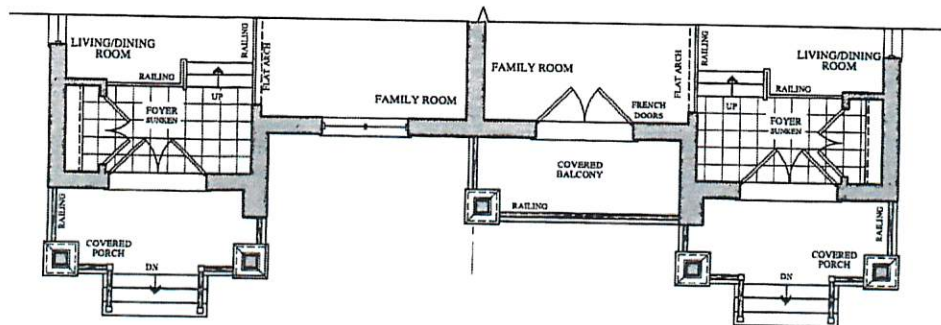

PART. GROUND FLOOR PLAN
ELEV. 'C'

PART. GROUND FLOOR PLAN
ELEV. 'D'

Prices, figures, illustrations, sizes, features and finishes are subject to change without notice. Areas and dimensions are approximate and actual usable floor space may vary from the stated area. Layout may be reverse of the unit purchased. E. & O.E.


GOLD PARK
WORTH MORE™

BEZ 681
OCT 7 200


encore
BRAMPTON

The Debussy SEMI SERIES

- Elevation A • 2,283 sq.ft.
- Elevation B • 2,283 sq.ft.
- Elevation C • 2,283 sq.ft.
- Elevation D • 2,283 sq.ft.

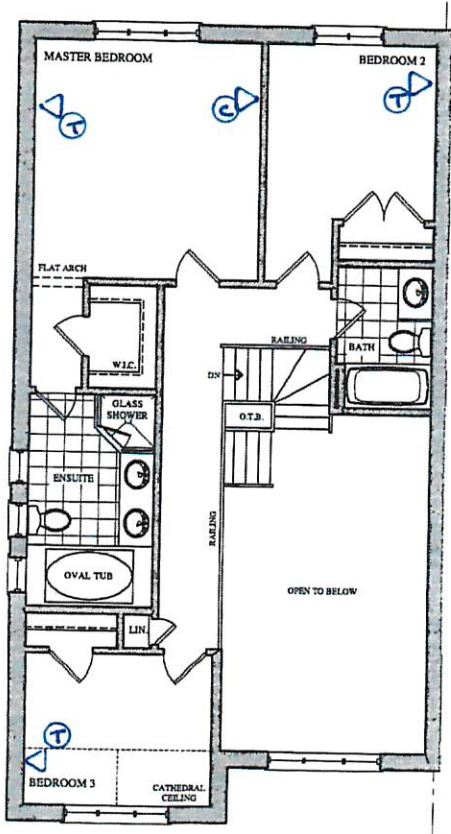

SECOND FLOOR PLAN
ELEV. 'A' & 'B'

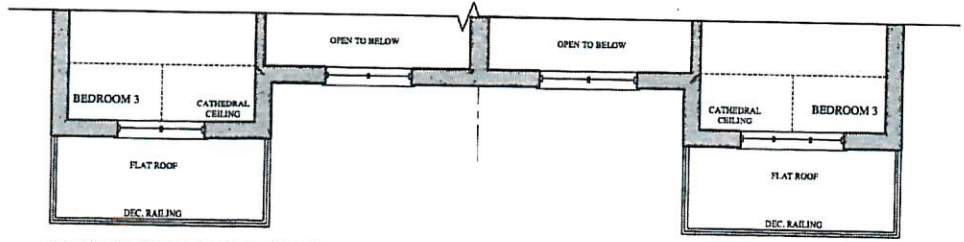

→ PART. SECOND FLOOR PLAN
ELEV. 'C'

PART. SECOND FLOOR PLAN
ELEV. 'D'

Prices, figures, illustrations, sizes, features and finishes are subject to change without notice. Areas and dimensions are approximate and actual usable floor space may vary from the stated area. Layout may be reverse of the unit purchased. E. & O.E.