

Brampton Encore - 69R - 2 - 28-10 Elev B Stravinsky

CONCRETE AND DRAIN

Inv.2,087	1 - 3PC Basement Rough-In
Line30410	Note:
3Oct19 / 13Jan20	

Exterior Colours

Inv.2,087	1 - Exterior Colour Package # 3
Line30412	Note:
3Oct19 / 13Jan20	

FORMING

Inv.2,087	1 - SIDE DOOR- HOME TO EXTERIOR- AS PER PLAN AND GRADE PERMITTING
Line29228	Note:
3Oct19 / 13Jan20	
Inv.2,087	1 - Garage Mandoor - Garage To House - As Per Plan And Grade Permitting
Line30415	Note:
3Oct19 / 13Jan20	

FRAMING

Inv.2,087	1 - MANDOOR - GARAGE TO HOUSE- AS PER PLAN AND GRADE PERMITING
Line29229	Note:
3Oct19 / 13Jan20	
Inv.2,087	1 - Side Door - Home To Exterior - As Per Plan And Grade Permitting
Line30414	Note:
3Oct19 / 13Jan20	

INTERIOR TRIM AND DOORS

Inv.2,087	1 - Side Door & Mandoor - As Per Plan And Grade Permitting
Line30411	Note:
3Oct19 / 13Jan20	

PLUMBING

Inv.2,087	1 - ROUGH-IN - 3PC BASEMENT ROUGH-IN
Line29231	Note:
3Oct19 / 13Jan20	

WINDOWS - BASEMENT


Inv.2,087	3 - BASEMENT WINDOWS - UPGRADE EXISTING BASEMENT WINDOW TO 30 INCH X 24 INCH - MAY REQUIRE INSTALLATION OF WINDOW WELL
Line29230	Note:
3Oct19 / 13Jan20	

WINDOWS AND DOORS

Inv.2,087	1 - Side Door & Mandoor
Line30409	Note:
3Oct19 / 13Jan20	


The
Stravinsky
SEMI SERIES

- Elevation A • 2,090 sq.ft.
→ Elevation B • 2,105 sq.ft.
Elevation C • 2,160 sq.ft.
Elevation D • 2,105 sq.ft.

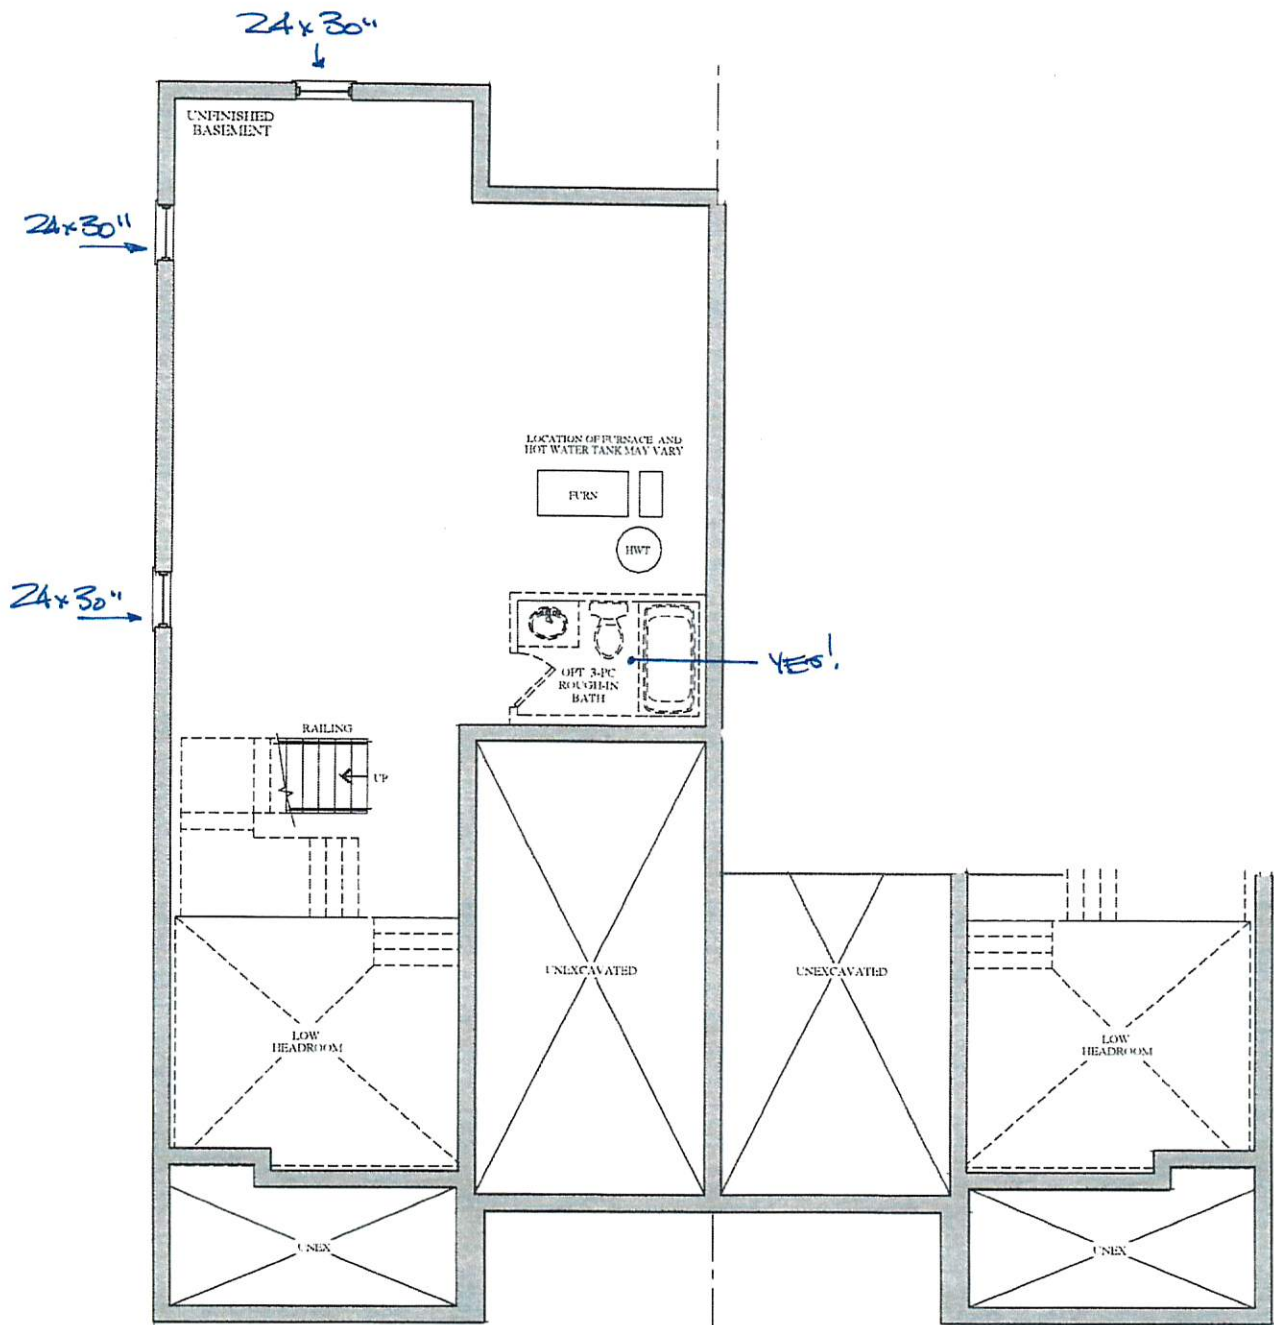

BASEMENT
ELEVATION A

BASEMENT
ELEVATION B

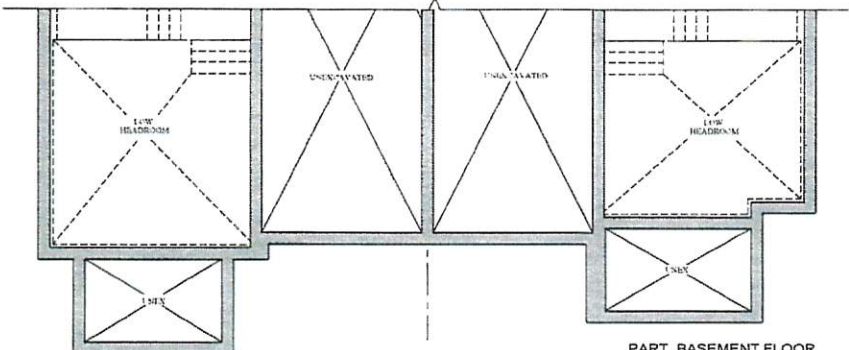

PART. BASEMENT FLOOR
ELEVATION C

PART. BASEMENT FLOOR
ELEVATION D

VENDOR

PURCHASER

PURCHASER

GOLD PARK
WORTH MORE™

Prices figures, illustrations, sizes, features and finishes are subject to change without notice. Areas and dimensions are approximate and actual usable floor space may vary from the stated area. Layout may be reverse of the unit purchased. E. & O.E.

BE2-60R
DEC 11 2009


The Stravinsky SEMI SERIES

Elevation A • 2,090 sq.ft.


→ Elevation B • 2,105 sq.ft.

Elevation C • 2,160 sq.ft.


Elevation D • 2,105 sq.ft.

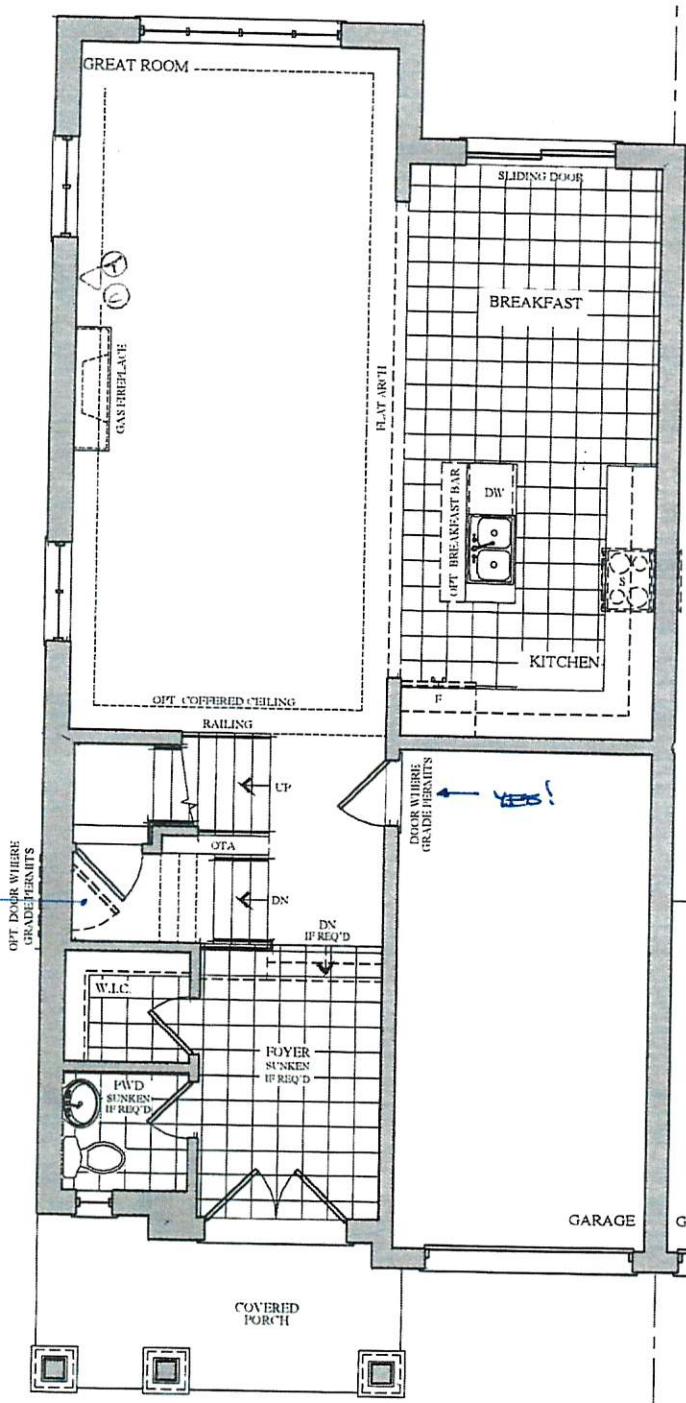

GROUND FLOOR
ELEVATION A

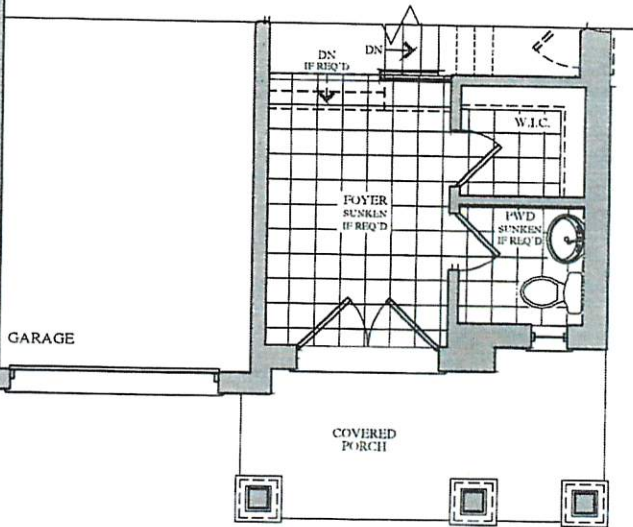

GROUND FLOOR
ELEVATION B

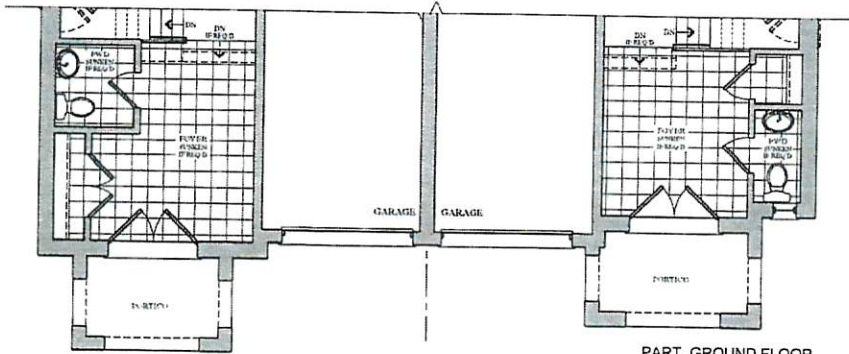

PART. GROUND FLOOR
ELEVATION C

PART. GROUND FLOOR
ELEVATION D

VENDOR

PURCHASER

PURCHASER



GOLDPARK
WORTH MORE™

Prices figures, illustrations, sizes, features and finishes are subject to change without notice. Areas and dimensions are approximate and actual usable floor space may vary from the stated area. Layout may be reverse of the unit purchased. E. & O.E.

BEZ-69R
DEC 11 2019

The Stravinsky SEMI SERIES

Elevation A • 2,090 sq.ft.
→ Elevation B • 2,105 sq.ft.
Elevation C • 2,160 sq.ft.
Elevation D • 2,105 sq.ft.

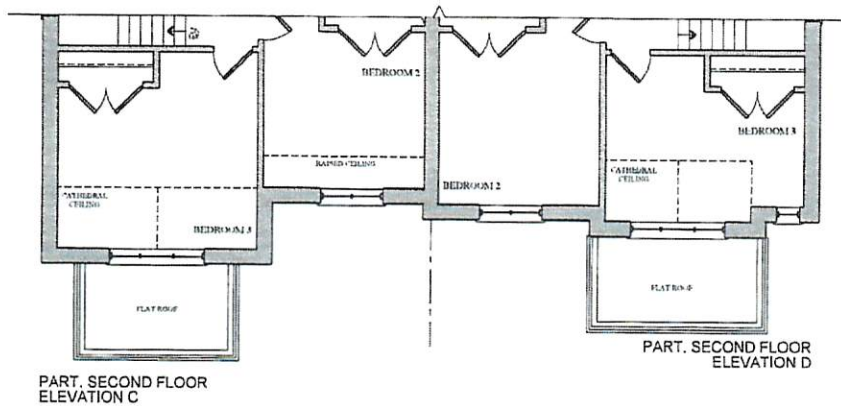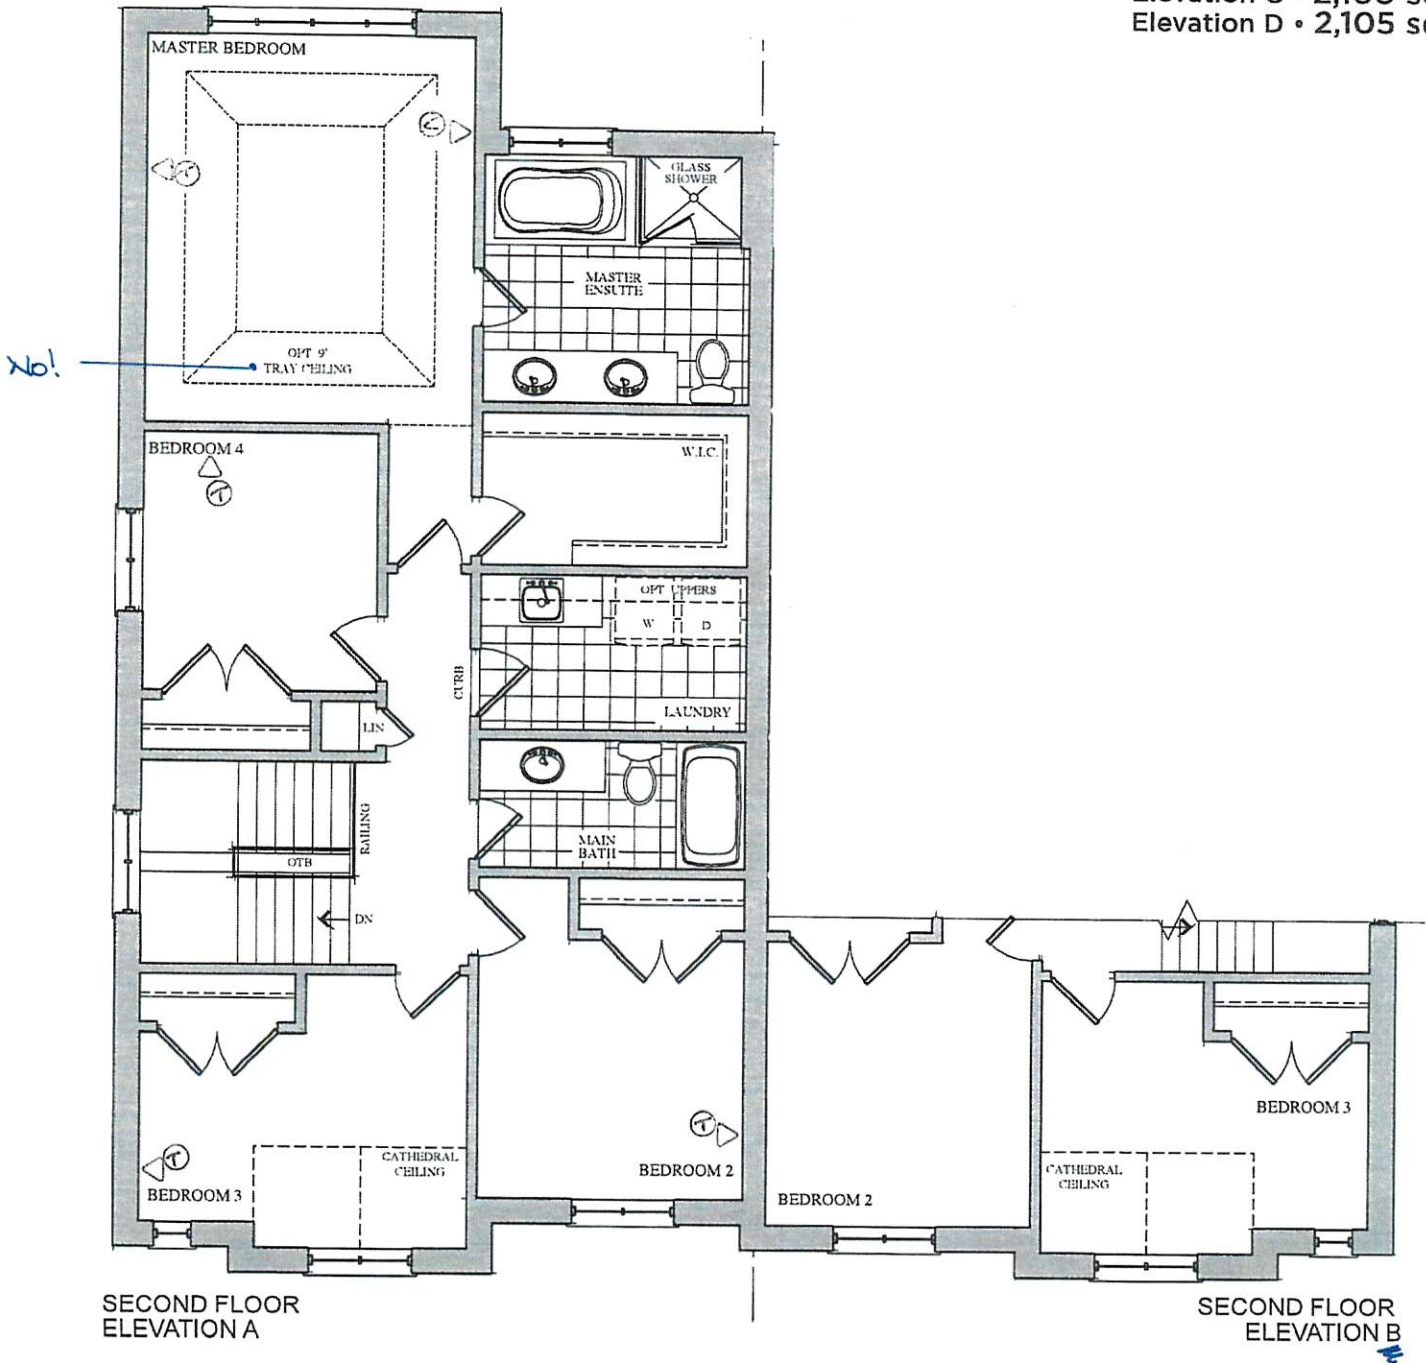

VENDOR
PURCHASER
PURCHASER

GOLD PARK
WORTH MORE™

Prices, figures, illustrations, sizes, features and finishes are subject to change without notice. Areas and dimensions are approximate and actual usable floor space may vary from the stated area. Layout may be reverse of the unit purchased. E. & O.E.