

Brampton Encore - 103 - 2 - 38-10 Elev B Copland

CENTRAL VAC AND WIRING

Inv.2,150	1 - FAMILY ROOM: CONDUIT PIPE- FOR TELEVISION- LOCATE APPROX 66" AFF. ABOVE FIREPLACE, TERMINATING AT CABLE LOCATION
Line30254	Note:
7Jan20 / 14Jan20	

ELECTRICAL

Inv.2,150	1 - KITCHEN: SINGLE POLE SWITCH FOR CAPPED OUTLETS ABOVE ISLAND
Line30257	Note:
7Jan20 / 14Jan20	
Inv.2,150	2 - KITCHEN: CAPPED CEILING ROUGH-IN ABOVE ISLAND
Line30256	Note:
7Jan20 / 14Jan20	
Inv.2,150	1 - FAMILY ROOM: 110V WALL RECEPTACLE ON DEDICATED CIRCUIT- LOCATE APPROX. 66" A.F.F. ABOVE FIREPLACE
Line30253	Note:
7Jan20 / 14Jan20	
Inv.2,150	1 - KITCHEN: 220V WALL RECEPTICAL ON DEDICATED CIRCUIT- FOR 4 WIRE BUILT-IN WALL OVEN - SEE PLAN
Line30259	Note:
7Jan20 / 14Jan20	
Inv.2,150	1 - LIVING / DINING ROOM: RELOCATE STANDARD FIXTURE - APPROX. CENTER OF CEILING -LIVING/DINING
Line30260	Note:
7Jan20 / 14Jan20	
Inv.2,150	1 - 200 AMP ELECTRICAL SERVICE
Line30262	Note:
7Jan20 / 14Jan20	

Exterior Colours

Inv.2,150	1 - Exterior Colour Package # 7
Line30488	Note:
7Jan20 / 14Jan20	

FORMING

Inv.2,150	1 - SIDE DOOR- HOME TO EXTERIOR- AS PER PLAN AND GRADE PERMITTING
Line30248	Note: Included in aps
7Jan20 / 14Jan20	
Inv.2,150	1 - Garage Mandoor - Garage To House - As Per Plan And Grade Permitting
Line30484	Note:
7Jan20 / 14Jan20	

FRAMING

Inv.2,150	1 - MANDOOR - GARAGE TO HOUSE- AS PER PLAN AND GRADE PERMITING
Line30246	Note: Included in aps
7Jan20 / 14Jan20	
Inv.2,150	1 - MASTER WALK-IN CLOSET: RELOCATE DOOR TO CLOSET TO BE ACCESSIBLE FROM INSIDE BEDROOM, NOT HALL WAY. SEE PLAN FOR LOCATION
Line30265	Note:
7Jan20 / 14Jan20	

Brampton Encore - 103 - 2 - 38-10 Elev B Copland

Inv.2,150	1 - MASTER BEDROOM: RELOCATE DOUBLE DOORS TO APPROX. 36" *BEFORE* BEDROOM - SO WHEN DOORS ARE FULLY OPEN THEY ARE *BEFORE* FLAT ARCH - SEE PLAN FOR LOCATION
Line30264	Note:
7Jan20 / 14Jan20	
Inv.2,150	1 - UPPER HALL: ADD 2X4' FIXED SKYLIGHT IN UPPER HALL LOCATE CLOSE TO LAUNDRY ROOM DOORS *IF POSSIBLE* - EXACT LOCATION TO BE DETERMINED BY VENDOR.
Line30266	Note:
7Jan20 / 14Jan20	
Inv.2,150	1 - Side Door - Home To Exterior - As Per Plan And Grade Permitting
Line30485	Note:
7Jan20 / 14Jan20	

INTERIOR TRIM AND DOORS

Inv.2,150	5 - MAIN FLOOR: EXTENDED HEIGHT ARCHWAY (PRICE PER DOORWAY) - 96"
Line30269	Note: DOORS TO REMAIN STD 80"
7Jan20 / 14Jan20	
Inv.2,150	1 - Side Door & Mandoor - As Per Plan And Grade Permitting
Line30486	Note:
7Jan20 / 14Jan20	
Inv.2,150	1 - Relocate Doors on Second Floor as Per Plan and Notes
Line30487	Note:
7Jan20 / 14Jan20	

MISC.

Inv.2,150	1 - Purchaser has attended an appointment at the Decor Centre & has DECLINED any additional upgrades and accepts and acknowledges that there will be no further changes/additions/deletions to be made upon signing on January 7, 2020.
Line30271	Note: A minimum \$500 fee to re-open file will apply for any changes.
7Jan20 / 14Jan20	
Inv.2,150	1 - BONUS PACKAGE: \$10,000.00 (INCLUDING TAXES) WORTH OF UPGRADES FROM GOLD PARK HOMES DÉCOR CENTRE IS BEING APPLIED TOWARD THIS ORDER. PURCHASER HAS A REMAINING AMOUNT OF \$903.50 (INCLUDING TAXES).
Line30272	Note:
7Jan20 / 14Jan20	
Inv.2,150	1 - KITCHEN - Purchaser accepts & acknowledges that in order to accommodate for built-in appliances for cook-top and wall ovens, all appliance specifications must be provided to the Décor Center within one (1) week of completion of structural app
Line30273	Note:
7Jan20 / 14Jan20	

WINDOWS - BASEMENT

Inv.2,150	2 - BASEMENT WINDOWS *REAR ONLY*- UPGRADE EXISTING BASEMENT WINDOW TO 30 INCH X 24 INCH - MAY REQUIRE INSTALLATION OF WINDOW WELL
Line30268	Note:
7Jan20 / 14Jan20	

WINDOWS AND DOORS

Inv.2,150	1 - Side Door & Mandoor - As Per Plan And Grade Permitting
Line30489	Note:
7Jan20 / 14Jan20	




CONSTRUCTION SUMMARY

Brampton Encore - 103 - 2 - 38-10 Elev B Copland

Inv.2,150	1 - Skylight Location and Size As Per Plan and Notes
Line30490	Note:
7Jan20 / 14Jan20	

BE2-103
DEC 7 20

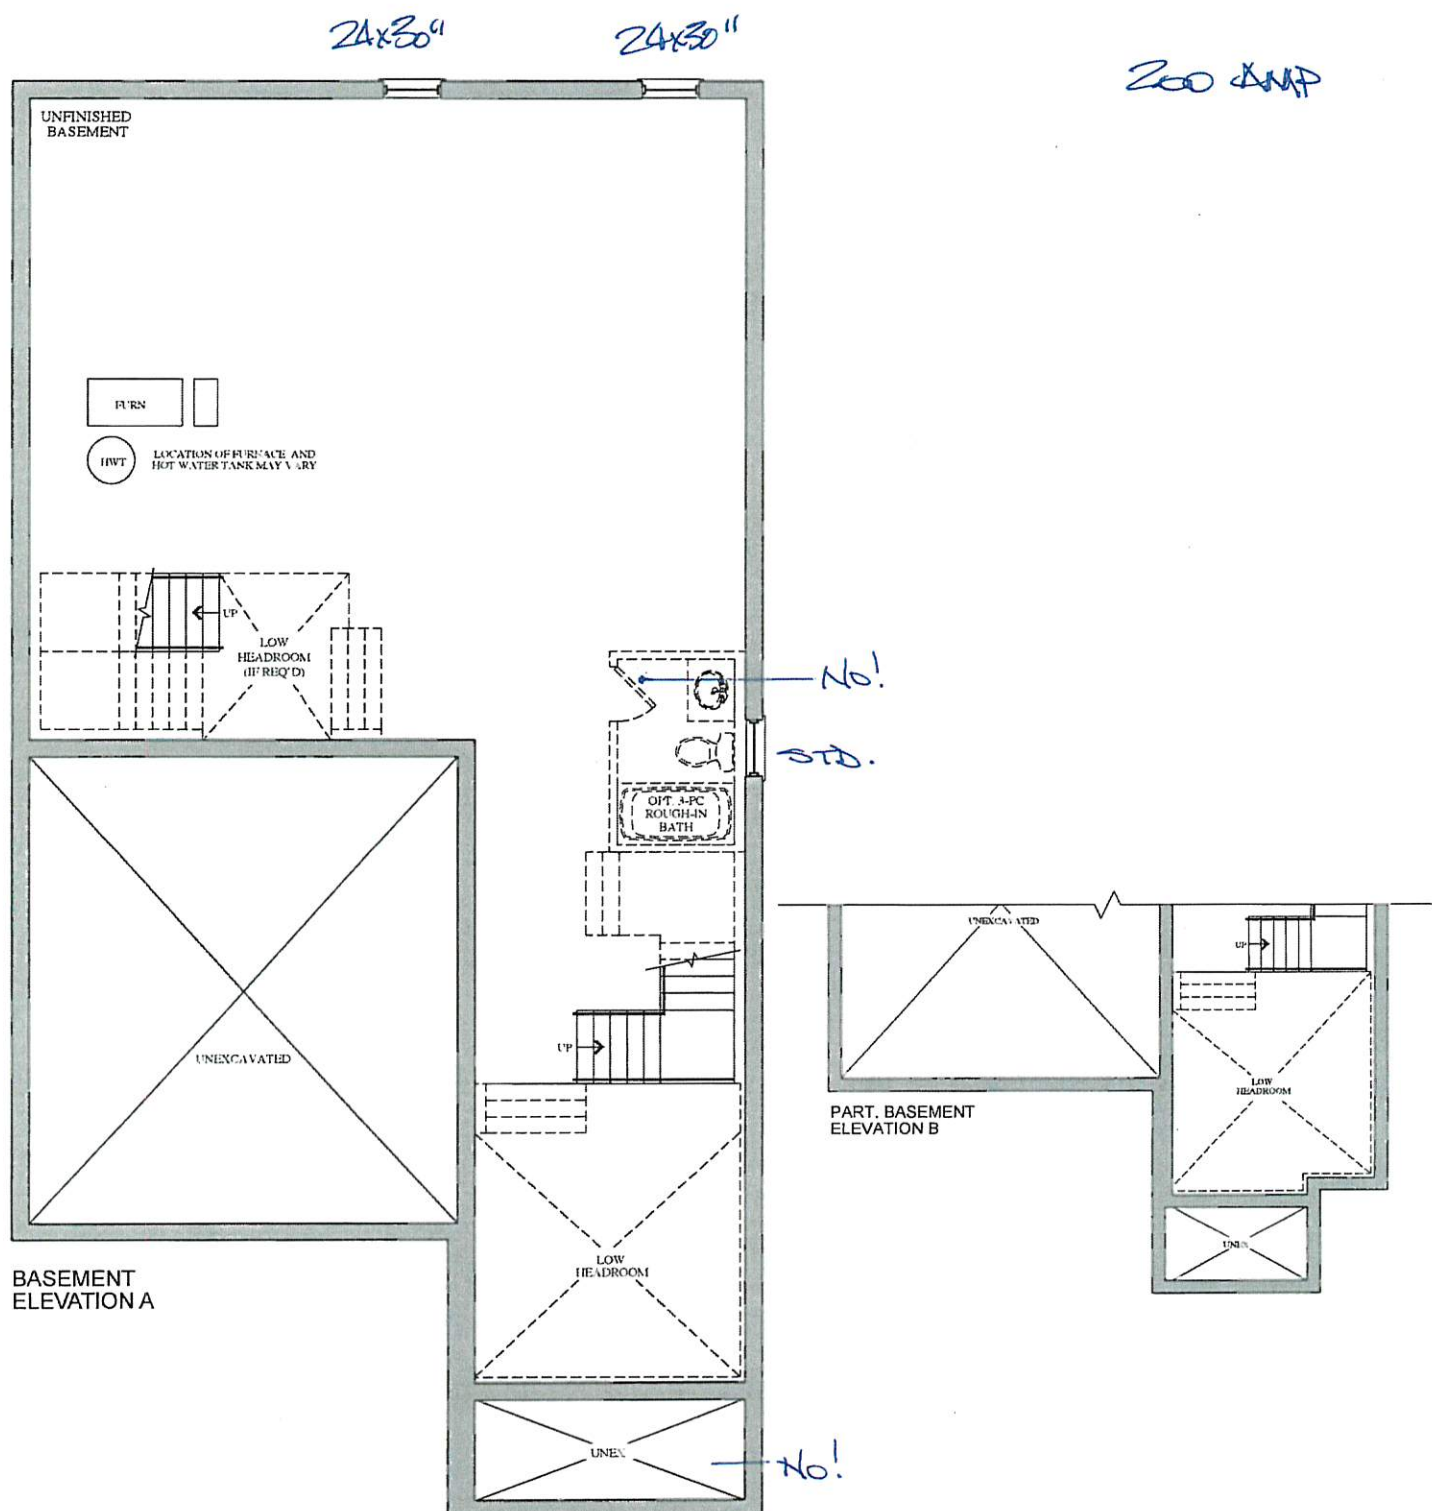

VENDOR

PURCHASER

PURCHASER

Germinde Sanglerz

[illegible]

GOLD PARK
WORTH MORE™

Prices, figures, illustrations, sizes, features and finishes are subject to change without notice. Areas and dimensions are approximate and actual usable floor space may vary from the stated area. Layout may be reverse of the unit purchased. E. & O.E.

SCHEDULE 'F'


encore
BRAMPTON

BEZ-103
Jan 7 2020 GS GS

The
Copland
38' SERIES

Elevation A • 2,940 sq.ft.
→ Elevation B • 2,920 sq.ft.

smooth ceiling

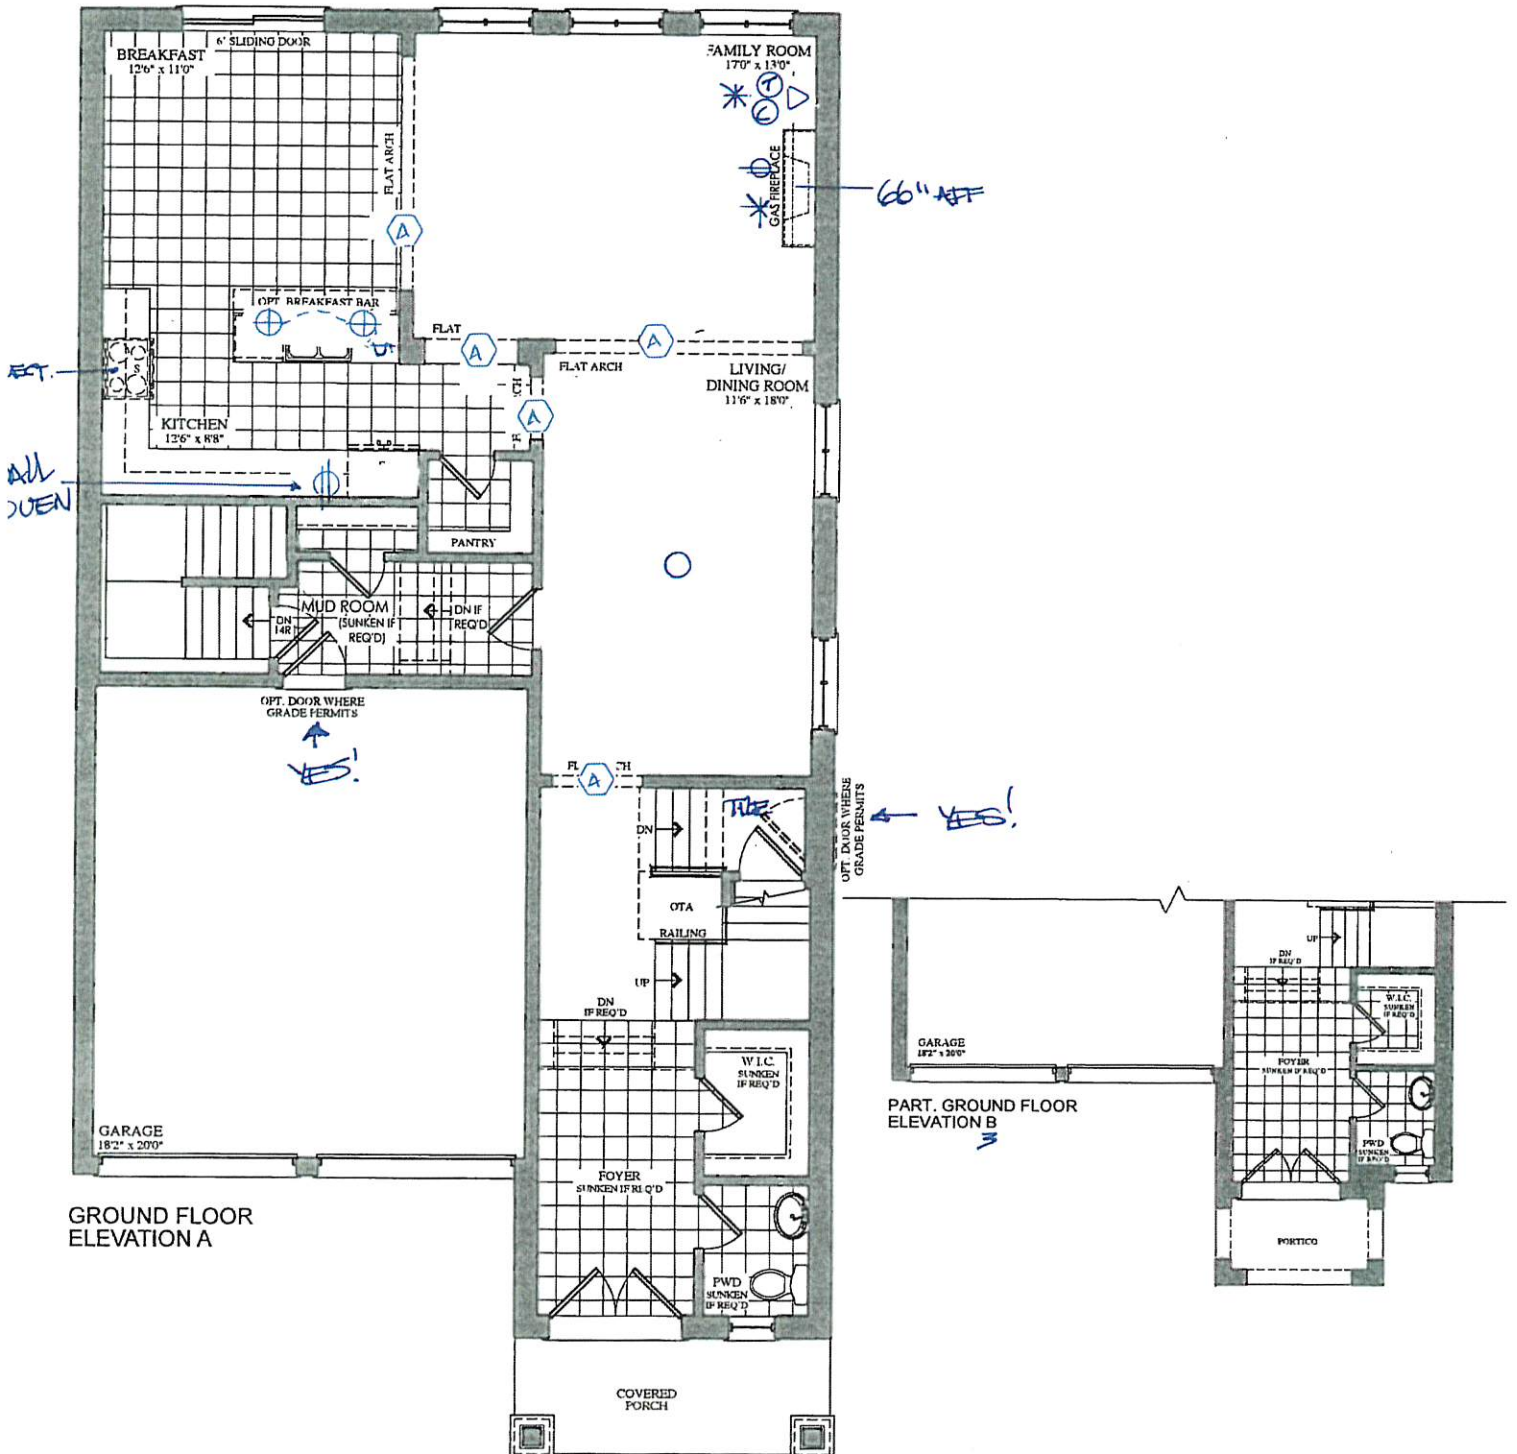

VENDOR
PURCHASER
PURCHASER


GS

GOLDPARK
WORTH MORE™

Prices, figures, illustrations, sizes, features and finishes are subject to change without notice. Areas and dimensions are approximate and actual usable floor space may vary from the stated area. Layout may be reverse of the unit purchased. E. & O.E.

Elevation A • 2,940 sq.ft.
→ Elevation B • 2,920 sq.ft.

DE2-103
Jan 7 2020

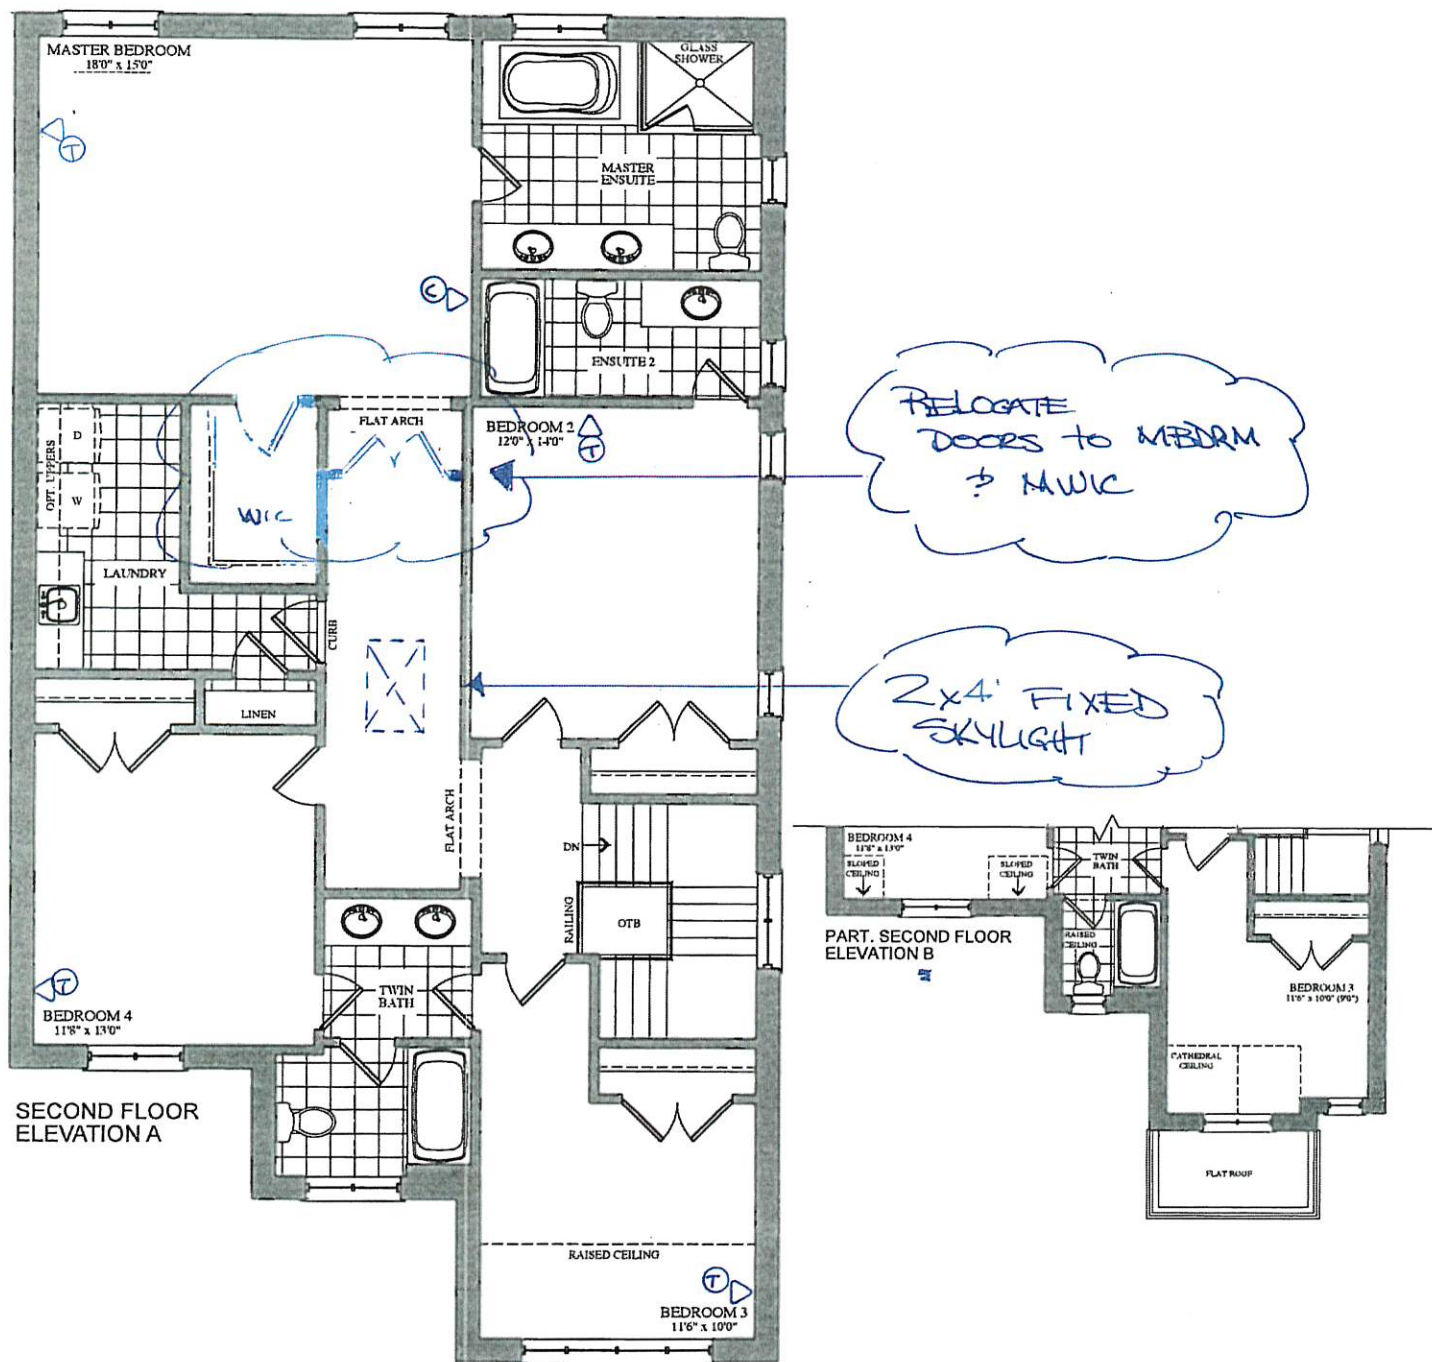

VENDOR
PURCHASER
PURCHASER

CS


GOLD PARK
WORTH MORE™

Prices, figures, illustrations, sizes, features and finishes are subject to change without notice. Areas and dimensions are approximate and actual usable floor space may vary from the stated area. Layout may be reverse of the unit purchased. E. & O.E.

Features	
Controls	PrecisionPro™
Surface Type	Black Ceramic Glass
Right Element (Watts)	9"/12" - 1,800 / 3,000
Left Front Element (Watts)	7" - 1,800
Left Rear Element (Watts)	7" - 1,800
Left Bridge Element (Watts)	SpacePro™ Bridge - 1,350
Centre Front Element (Watts)	Keep Warm Zone - 100
Centre Rear Element (Watts)	6" - 1,200
Hot Surface Indicators	Yes
Control Location	Centre Front
Knob Colour	Stainless
Knob Type	Cast Metal
Optional Accessories	
Griddle	PN # 316432200
Specifications	
Power Supply Connection Location	Right Front
Voltage Rating	240V/208V / 60Hz
Connected Load (kW Rating) @ 240 / 208 Volts¹	10.6 / 8.0
Amps @ 240 / 208 Volts	44.2 / 38.5
Minimum Circuit Required (Amps)	40
Approved for Electric Single Wall Oven Combination Installation²	Yes
Shipping Weight (Approx.)	45 Lbs.

¹Single phase 3- or 4-wire cable, 120/240 or 120/208 Volt, 60 Hertz AC only electrical supply with ground required on separate circuit fused on both sides of line.

²Cooktops are approved for installation above any of our Electric Single Wall Ovens.

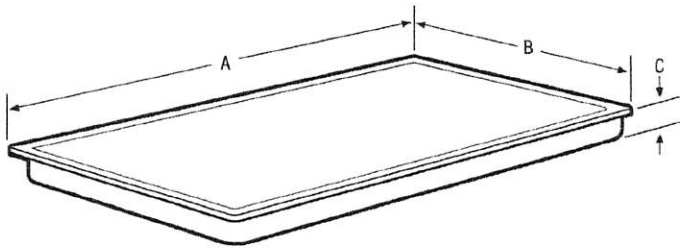

NOTE: For planning purposes only. Always consult local and national electric codes. Refer to Product Installation Guide for detailed installation instructions on the web at frigidaire.ca.




Product Dimensions		Cutout Dimensions	
A-Width	36-3/4"	Width (Min.)/(Max.)	35-5/8"/36-1/8"
B-Depth	21-3/8"	Depth (Min.)/(Max.)	20-1/4"/20-1/2"
C-Height	2-5/8"	Height	5"

Granite Countertop
Installation Kit available.

Gurminder Sanghera
Gurkeerat Sghar
Jan. 11/2020

Accessories information available
on the web at frigidaire.ca

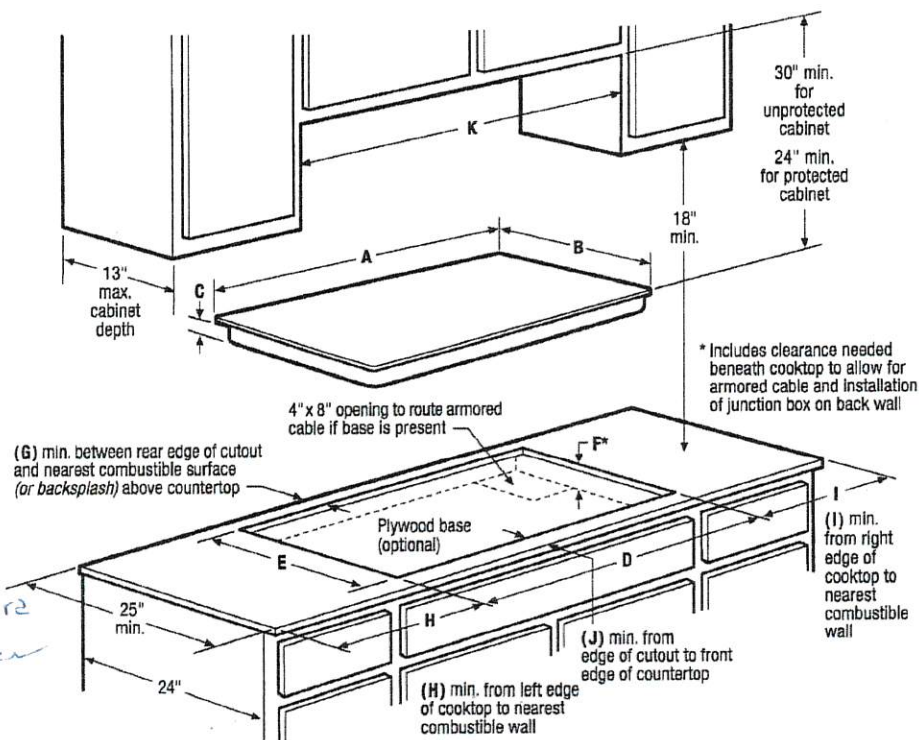

Gurinder Singh
Gurkeet Singh
Jan 11/2020

Product Dimensions			Required Clearances			
A - Width	B - Depth	C - Height	G (min.)	H (min.)	I (min.)	J (min.)
36-3/4"	21-3/8"	2-5/8"	2"	7-1/2"	7-1/2"	2-1/2"
Product Cutout Dimensions			K - Cabinet Opening Width (min.)		Utility Connection Locations	
D - Width (min. - max.)	E - Depth (min. - max.)	F - Height (min.)*			Power Supply	
35-5/8" - 36-1/8"	20-1/4" - 20-1/2"	5"	36-3/4"		Right Front	

Built-In Cooktop Specifications

- Product Shipping Weight (approx.) - 45 Lbs.
- Single phase 3- or 4-wire cable, 120/240 or 120/208 Volt, 60 Hertz AC only electrical supply with ground required on separate circuit fused on both sides of line
- Connected Load (kW Rating) @ 240/208 Volts = 10.6/8.0 kW
- Amps @ 240/208 Volts = 44.2/38.5 Amps
- Recommended Circuit Breaker - 40 Amps
- Always consult local and national electric codes.
- Cooktop cutout height includes clearance needed beneath cooktop to allow for armored cable and installation of junction box on back wall. Position center of junction box 10" inward from right side of cooktop cutout, and 12" down from underside of countertop.
- Overhead cabinetry should not exceed a 13" maximum depth.
- Absolute minimum horizontal distance between overhead cabinets installed to either side of appliance must be no less than 36-3/4".
- Allow 30" minimum clearance between top of cooktop platform and bottom of unprotected wood or metal overhead cabinet, or 24" minimum clearance when bottom of wood or metal overhead cabinet is protected by not less than 1/8" flame-retardant millboard covered with not less than No. 28 MG5 sheet steel, 0.015" stainless steel, 0.024" aluminum or 0.020" copper.
- Allow 2" minimum clearance between rear edge of cutout and nearest combustible surface (or backsplash) above countertop.

- Allow 7-1/2" minimum required clearance from left edge of cooktop to nearest combustible wall and 7-1/2" minimum from right edge of cooktop to nearest combustible wall.
- Installation of drawer beneath cooktop requires 4" minimum clearance beneath countertop surface, and assured clearance for electrical installation.
- To reduce risk of fire when using overhead cabinetry, install range hood that projects horizontally a recommended minimum of 5" beyond bottom of cabinets.
- Electric Built-In Cooktop model FPEC3677R is approved to be used over any Frigidaire® Electric Single Wall Oven. (Refer to *Electric Cooktop Installation Over 30"/27" Electric Single Wall Oven Specifications* page on web.)

Note: For planning purposes only. Refer to Product Installation Guide on the web at frigidaire.com for detailed instructions.

Optional Accessories

- Granite Countertop Installation Kit - (PN # 903061-9010)
- Giddle - (PN # 316432200).

FRIGIDAIRE

USA • 10200 David Taylor Drive • Charlotte, NC 28262 • 1-800-FRIGIDAIRE • frigidaire.com
CANADA • 5855 Terry Fox Way • Mississauga, ON L5V 3E4 • 1-800-265-8352 • frigidaire.ca

FPEC3677R Q7/15

© 2015 Electrolux Home Products, Inc.

Accessories information available on the web at frigidaire.com




Specifications subject to change.

Features	
Control Design	Fully-Integrated Express-Select®
Digital Display	Yes
Door Latch/Stay-Put Door Hinge Design	Yes/Yes
Low Rinse-Aid Indicator Light	Yes
Interior Colour/Interior Design	GraniteGrey™/Tall Tub
Wash System	Direct Feed
Wash Arm	OrbitClean®
Wash Levels/Wash Speeds	5/3
DishSense™ Technology	Yes
AquaSurge™ Technology	Yes
Sound Package	SilentDesign™ 1
Filter/Filter Trap	S. Steel/Removable
Soft Food Disposer	Yes
dB Level	52
Drying System	SaharaDry™
Cycles	
Number of Cycles	8
PowerPlus® (Heavy)	Yes
Normal	Yes
Light	
Quick Wash (34-Min.)	Yes
Favourite	Yes
China Crystal	Yes
Rinse Only	Yes
Energy Saver Plus	Yes
Upper Rack Wash Only	Yes
Cycle Indicator Light/Control Lock	No/Yes
Cycle Complete Floor Beam Indicator	
Options	
Heat/No Heat Dry	Yes/Yes
Hi-Temp Wash	Yes
NSF® Certified Sanitize Rinse	Yes
Delay Start	1-24 Hour
Rack System	
Rack Design	Supreme
Rack Coating	Nylon TufRacks™
Upper Rack -	
Rack Handles	Yes
Stemware/Champagne Glass Holders	Yes
Fold-Down Tines	Yes
Cup Shelves/Stemware Grips	2/No
Versa-Tray™	
Adjustable Rack	Yes
Lower Rack -	
SpaceWise® Silverware Basket	3-Piece Split
Fold-Down Tines	2 Full Rows
Small Items Cover	2
Certifications	
ENERGY STAR®	Yes
NSF® International Certification	Yes
Specifications	
Water Inlet Location	Left Bottom Front
Water Usage (Gallons)	4.9 - 8.5
Water Pressure (PSI)	20 - 120
Integral Air Gap on Supply	Yes
Leveling Legs	4
Power Supply Connection Location	Right Bottom Front
Voltage Rating	120V/60 Hz
Connected Load (kW Rating) @ 120 Volts¹	1.20
Amps @ 120 Volts	10
Shipping Weight (Approx.)	83 Lbs.

¹For use on adequately wired 120V, dedicated circuit having 2-wire service with a separate ground wire. Appliance must be grounded for safe operation.

Gurminder Sanghera
Gurkeerat Sanghera
Jan 11/2020

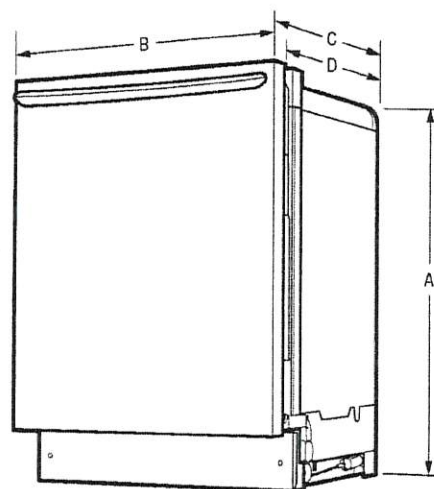

NOTE: For planning purposes only. Always consult local and national electric and plumbing codes. Refer to Product Installation Guide for detailed installation instructions on the web at frigidaire.ca



Product Dimensions		Cutout Dimensions	
A - Height (Adjustable)	33-1/2" - 35"	Height (Min.)	34-1/4"
B - Width	24"	Height (Max.)	35-3/4"
C - Depth (Including Door)	25"	Width (Min.)	24"
D - Depth (To Tub Flange)	22-1/2"	Depth (Min.)	24"
Depth with Door Open 90°	49-1/4"		

Accessories information available on the web at frigidaire.ca

FRIGIDAIRE

CANADA • 5855 Terry Fox Way • Mississauga, ON L5V 3E4 • 1-800-265-8352 • frigidaire.ca

FGID2466Q 03/17

© 2017 Electrolux Major Appliances, NA

Specifications subject to change.
Printed in Canada

CGMO226NUF MICROWAVE

24" BUILT-IN

FRIGIDAIRE
GALLERY.

FEATURES

Control/Timing System	Ready-Select®
Exterior Door Finish	Smudge-Proof™ Stainless
Handle Design	Push Button
Microwave Capacity (Cu.Ft.)	2.2
Watts (IEC-705 Test Procedure)	1100
Interior Light	Yes
Interior Colour	White
Turntable Diameter	16-1/2"
Control Lock	Yes
Clock	Yes
Touch Pad Buttons	25
Power Levels	High (1-9)

MICROWAVE CONTROL OPTIONS

Popcorn Button	Yes
Baked Potato Button	Yes
Snack Button	Yes
Melt & Soften Options	2/2
Auto Reheat Options	4
Snack Menu Options	4
Auto Cook Options	4
Auto Defrost Options	3
Add-30-Seconds	Yes
Sensor Cooking Options	4
Vegetable Cook Sensor	Yes
User Preferences	Yes

POWER RATINGS

Frequency (MHz)	2,450
Watts @ 120 Volts	1100
Amps @ 120 Volts	14.2

OPTIONAL ACCESSORIES

30" Stainless Steel Trim Kit	PN# MWTK30FGUF
27" Stainless Steel Trim Kit	PN# MWTK27FGUF

SPECIFICATIONS

Oven Interior (HxWxD)	11-1/4" x 17-7/8" x 19-1/8"
Power Supply Connection Location	Right Rear Top
Voltage Rating	120V/60Hz/15A
Connected Load (kW Rating) @ 120 Volts¹	1.7
Minimum Circuit Required (Amps)	15
Plug Type (NEMA)	LCDI (5-15P)
Shipping Weight (Approx.)	49 Lbs


For use on adequately wired 120V dedicated circuit having 2-wire service with a separate ground wire. Appliance must be grounded for safe operation.

PRODUCT DIMENSIONS

A - Height	13-5/8"
B - Width	24-7/16"
C - Depth	19-5/8"
Depth with Door Open 90°	39"

CUTOUT DIMENSIONS

Height (Min.)	16-3/4"
Height (Max.)	17"
Width (Min.)	24-3/4"
Width (Max.)	25"
Depth (Min.)	20"

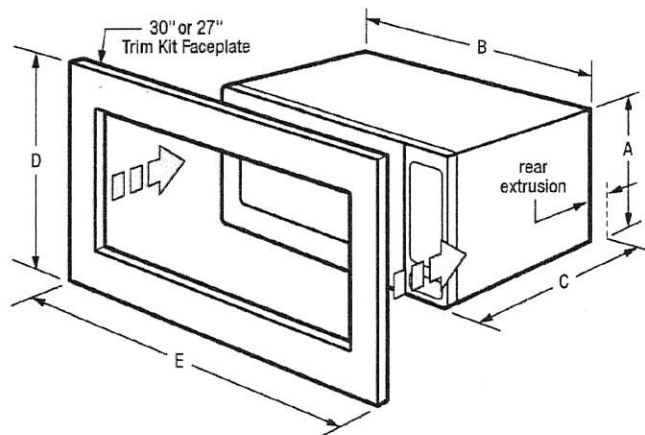

Gurmininder Singhania
Gurkeerat Singhania
Jan. 11/2020



Note: For planning purposes only. Always consult local and national electric, gas and plumbing codes. Refer to Product Installation Guide for detailed installation instructions on the web at frigidaire.ca. Specifications subject to change. Accessories information available on the web at frigidaire.ca.


FRIGIDAIRE

CANADA • 5855 Terry Fox Way • Mississauga, ON L5V 3E4 • 1-800-265-8352 • frigidaire.ca

CGMO226NU 09/18

© 2018 Electrolux Major Appliances, NA

***Note:** When used in combination with another Frigidaire® built-in product, a minimum clearance of 3" required from bottom of Built-In Microwave cutout to top edge of companion product's faceplate, leaving a 2 1/8" visible gap between both product faceplates

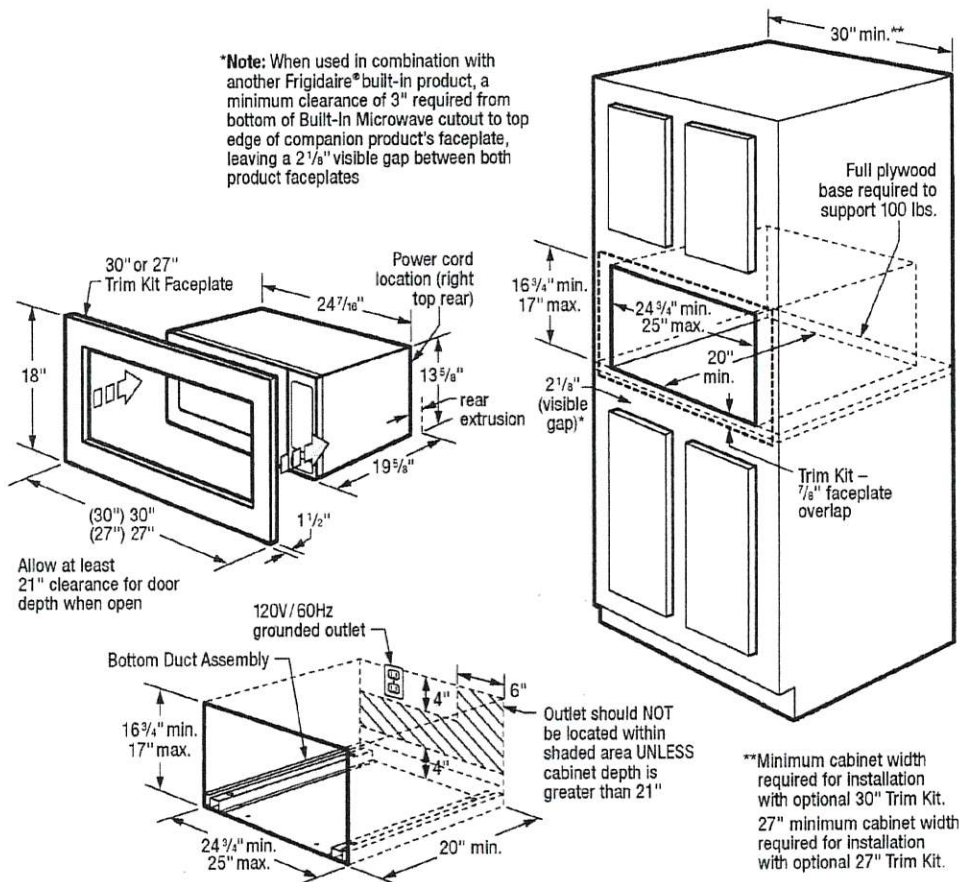

Gurmincker Sanghera
Gurkeerat Sd
Jan. 11/2020

INSTALLATION SPECIFICATIONS

- Product Shipping Weight (Approx.) - 49 Lbs. (not incl. Trim Kit)
- Voltage Rating - 120V/60 Hz/15 Amps
- Connected Load (kW Rating) @ 120 Volts = 1.7 kW
(For use on adequately wired 120V, dedicated circuit having 2-wire service with a separate ground wire. Appliance must be grounded for safe operation.)
- Amps @ 120 Volts = 14.2 Amps
- Always consult local and national electric codes.
- Microwave can stand alone on countertop or be built in with optional 30" or 27" Trim Kit (ordered by individual part number) which includes Bottom Duct Assembly - shipped in separate box.
- Allow 21" minimum clearance for 90° door swing.
- Minimum 20" deep oven cutout dimension is critical for proper installation for oven and faceplate to fit flush against cabinet front.
- Consult local building code, in the event that cutout opening may be required to be enclosed with sides, ceiling and rear partition.
- Full oven base of solid plywood or similar material required, capable of supporting 100 Lbs.

- Base must be level and front of cabinet square for proper operation.
- Grounded outlet should NOT be located in shaded area, as indicated, UNLESS cabinet depth is greater than 21".
- Can NOT be installed above any gas wall oven.
- Built-In Microwave is approved to be used in combination with any Frigidaire® Electric Single Wall Oven and/or Warmer Drawer. (Refer to model-specific Combination Installation Specification pages on web.)
- When used in combination with another Frigidaire® built-in product, a minimum clearance of 3" required from bottom of Built-In Microwave cutout to top edge of companion product's faceplate, leaving a 2-1/8" visible gap between both product faceplates.

OPTIONAL ACCESSORIES

- 30" Stainless Steel Trim Kit - (PN# MWTK30FGUF).
- 27" Stainless Steel Trim Kit - (PN# MWTK27FGUF).



FGEW3066U D/F

FOUR MURAL SIMPLE

ÉLECTRIQUE - 30 PO

FRIGIDAIRE
GALLERY

CARACTÉRISTIQUES

Système de commande/Système de chronométrage	Commandes Express-Select™
Fenêtre	Extra large
Finition extérieure des portes	Smudge-Proof™ en acier inoxydable Acier (F), Inox noir (D)
Conception des poignées	Acier inoxydable (F), Inox noir (D)
Système de nettoyage du four	Autonettoyage avec option de nettoyage à la vapeur

COMMANDES DU FOUR

Cuisson/gril	Oui/Variable (400-550 °F)
Fonction convection Effortless™	Oui
Cuisson/gril/rôtissage à convection	Oui/Oui/Oui
Four préchauffé	Rapide
Mes favoris	
Cuisson lente	
Sonde thermique Effortless™	Oui
Maintien au chaud	Oui
Ajouter une minute	Oui
Démarrage différé	Oui
Options d'autonettoyage/nettoyage	Oui/2, 3, 4 heures
Nettoyage à la vapeur	Oui
Nettoyage différé	Oui
Minuterie de cuisine	Oui
Options de cuisson minutée	Oui
Dispositif de verrouillage	Oui
Arrêt automatique du four	Oui
Verrouillage du four	Oui

CARACTÉRISTIQUES DU FOUR

Capacité (pi³)	5,1
Système de convection	Convection véritable
Éclairage du four	2 lampes halogènes
Élément de cuisson dissimulé	Oui
Configuration des grilles	1 Usage intensif, 1 Décaler la grille
Système de cuisson	Technologie de cuisson homogène
Système de grillage	Puissance d'ébullition
Élément de cuisson/gril (watts)	2 200/4 000

ACCESSOIRES OPTIONNELS

Garniture inférieure d'une hauteur de 3 po - Noire	(D) PN# à déterminer
Acier inoxydable (D)/Acier inoxydable (F)	(F) PN# à déterminer
Long câble d'alimentation armé de 10 pi	PN# 903056-9010

CERTIFICATIONS

Conforme à la norme ADA¹	Oui
Certifié par Star-K™ (mode Sabbath)	Oui

SPÉCIFICATIONS


Intérieur du four (H x L x P)	18 5/8 po x 24 1/8 po x 19 1/2 po
Emplacement du raccordement électrique	Arrière inférieur gauche
Tension nominale	240 V/208 V/60Hz
Charge connectée (puissance nominale kW) à 240/208 volts²	4,5/3,4
Ampères à 240/208 volts	18,8/16,3
Circuit minimum requis (ampères)	20
Approuvé pour installation sous le comptoir	Oui
Poids d'expédition (approx.)	145 lb

DIMENSIONS DU PRODUIT

A - Hauteur (max.)	29 po
B - Largeur	30 po
C - Profondeur (incl. la poignée)	27 1/8 po (41,91 cm)
D - Hauteur (emballage)	27 3/16 po (41,91 cm)
E - Largeur (emballage)	24 5/8 po
Profondeur avec porte ouverte à 90°	45 3/4 po (41,91 cm)

DIMENSIONS DES DÉCOUPES DU MEUBLE

Hauteur (min.)/(max.)	27 1/4 po/28 5/8 po
Largeur (min.)/(max.)	28 1/8 po/29 po
Profondeur (min.)	24 po

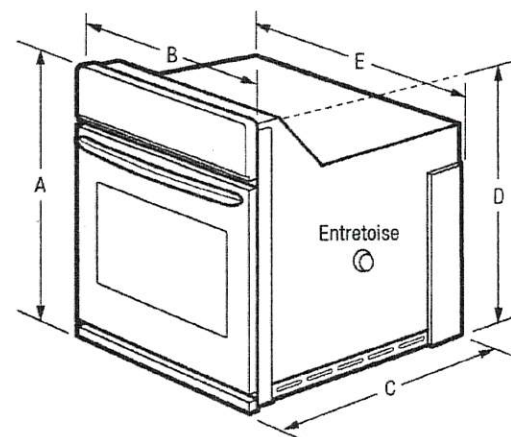

Gunnahler Songhe 12
Gurkeent Sph
Jan 11/2020



¹ Lorsqu'il est correctement installé, ce modèle est qualifié ADA selon les directives sur l'accessibilité DA/ABA Accessibility Guidelines du United States Access Board et les normes de conception sans obstacles 2010 ADA Standards for Accessible Design du ministère de la Justice.

² Câble monophasé à 3 ou 4 fils, alimentation 120/240 ou 120/208 volts, 60 hertz CA uniquement avec mise à la terre requise sur un circuit séparé et des fusibles des deux côtés de la conduite.

Remarque : Aux fins de planification seulement. Consultez systématiquement les codes locaux et nationaux d'électricité, de gaz et de plomberie. Reportez-vous au guide d'installation du produit pour des instructions d'installation détaillées sur le web à frigidaire.com/frigidaire.ca.


Spécifications sujettes à modification. Informations sur les accessoires offerts sur le web à frigidaire.com/frigidaire.ca.

FRIGIDAIRE

É.-U. • 10200 David Taylor Drive • Charlotte, NC 28262 • 1-800-FRIGIDAIRE • frigidaire.com
CANADA • 5655 Terry Fox Way • Mississauga, ON L5V 3E4 • 1-800-265-8352 • frigidaire.ca

FGEW3066 12/18

© 2018 Electrolux Home Products, Inc.

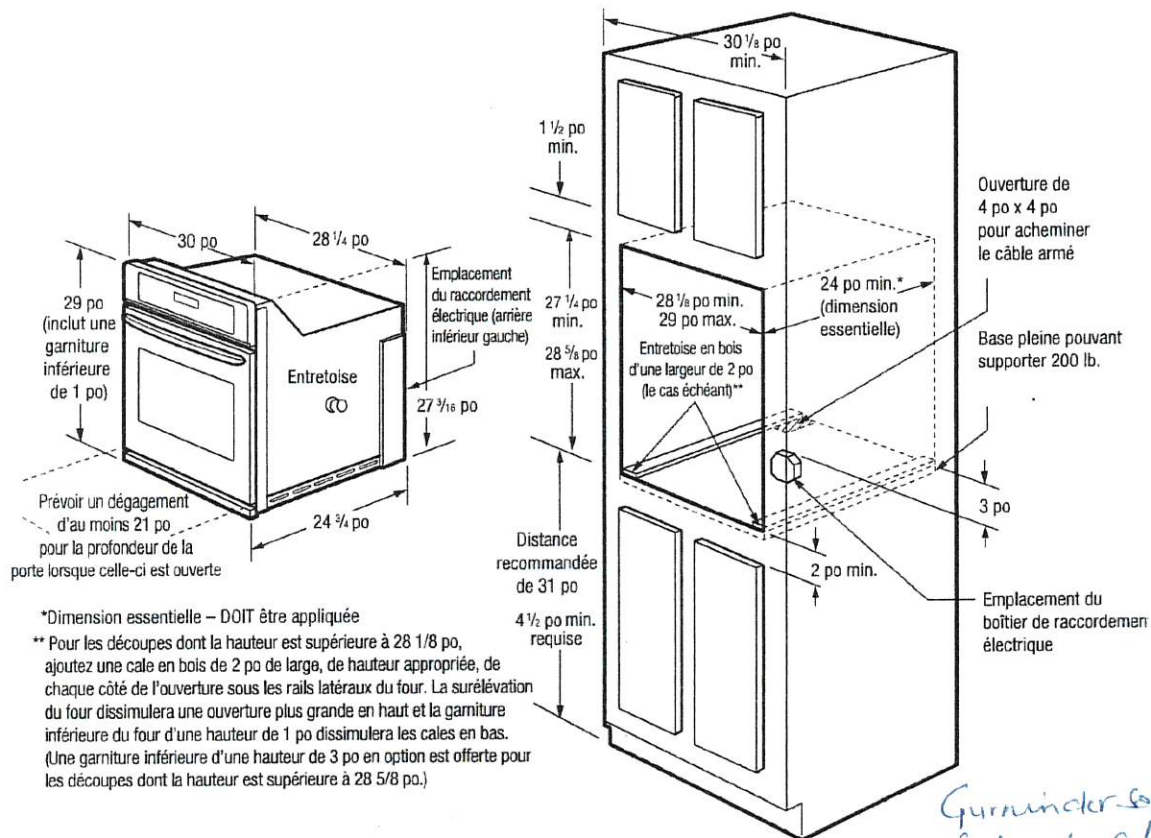

Gurminder Singh
 Gubeant Sph
 Jan 11/2020

SPÉCIFICATIONS D'INSTALLATION

- Poids d'expédition du produit (approx.) - 145 lb
- Câble monophasé à 3 ou 4 fils, alimentation 120/240 ou 120/208 volts, 60 hertz CA uniquement; avec mise à la terre requise sur un circuit séparé et des fusibles des deux côtés de la conduite.
- Charge connectée (puissance nominale en kilowatt) à 240/208 V = 4,5/3,4 kW
- Ampères à 240/208 volts = 18,8/16,3 A
- Disjoncteur recommandé - 20 A
- Consultez systématiquement les codes locaux et nationaux d'électricité.
- Un dégagement minimal de 21 po (53,34 cm) pour la profondeur de la porte du four lorsque celle-ci est ouverte.
- Distance par rapport au plancher recommandée est de 31 po. Distance minimale requise de 4-1/2 po.
- Une découpe d'au moins 24 po (60,96 cm) est essentielle pour installer correctement le four et pour s'assurer que le plateau du four tournera sans heurter la porte.
- Pour que le four tienne dans une découpe dont la hauteur est supérieure à 28-1/8 po, ajoutez une cale en bois de 2 po de large, de hauteur appropriée, de chaque côté de l'ouverture sous les rails latéraux du four. La surélévation du four dissimulera une ouverture plus grande en haut et la garniture inférieure du four d'une hauteur de 1 po dissimulera les cales en bas. (Garniture inférieure standard d'une hauteur de 1 po incluse)
- Pour que le four tienne dans une découpe dont la hauteur est supérieure à 28-5/8 po, on a prévu une garniture inférieure d'une hauteur de 3 po.

- Base complète pour four en contre-plaqué plein ou matériau similaire au besoin et pouvant supporter 200 lb.
- La base doit être à niveau et les côtés doivent être égaux.
- Les fours muraux simples NE sont PAS approuvés pour être utilisés dans une installation empilable ou côte à côte.
- Les fours muraux simples sont approuvés pour être utilisés seuls dans une installation sous le comptoir ou sous n'importe quelle table de cuisson à gaz ou électrique approuvée de la marque Frigidaire®. (Consultez les pages Internet fournissant les spécifications relatives à l'installation d'une table de cuisson à gaz ou électrique au dessus d'un four mural électrique simple de 30 po/ 27 po.)
- Les fours muraux simples sont approuvés pour être utilisés en association avec tout tiroir chauffant de la marque Frigidaire®. (Reportez-vous à la page produit du tiroir chauffant spécifique au modèle pour les spécifications d'installation et d'association.)
- Les fours muraux simples sont approuvés pour être utilisés en association avec tout four à micro-ondes de la marque Frigidaire®.

ACCESSOIRES OPTIONNELS


- Garniture inférieure en acier inoxydable noir d'une hauteur de 3 po - (PN: à déterminer).
- Garniture inférieure en acier inoxydable d'une hauteur de 3 po - (PN: à déterminer)
- Long câble d'alimentation armé de 10 pi - (PN° 903056-9010).



Remarque : Aux fins de planification seulement. Consultez systématiquement les codes locaux et nationaux d'électricité, de gaz et de plomberie. Reportez-vous au guide d'installation du produit pour des instructions d'installation détaillées sur le web à frigidaire.com/frigidaire.ca.
 Spécifications sujettes à modification. Informations sur les accessoires offerts sur le web à frigidaire.com/frigidaire.ca

FG4H2272UF
FRENCH DOOR REFRIGERATOR
 21.8 CU. FT. COUNTER-DEPTH

FRIGIDAIRE
 GALLERY

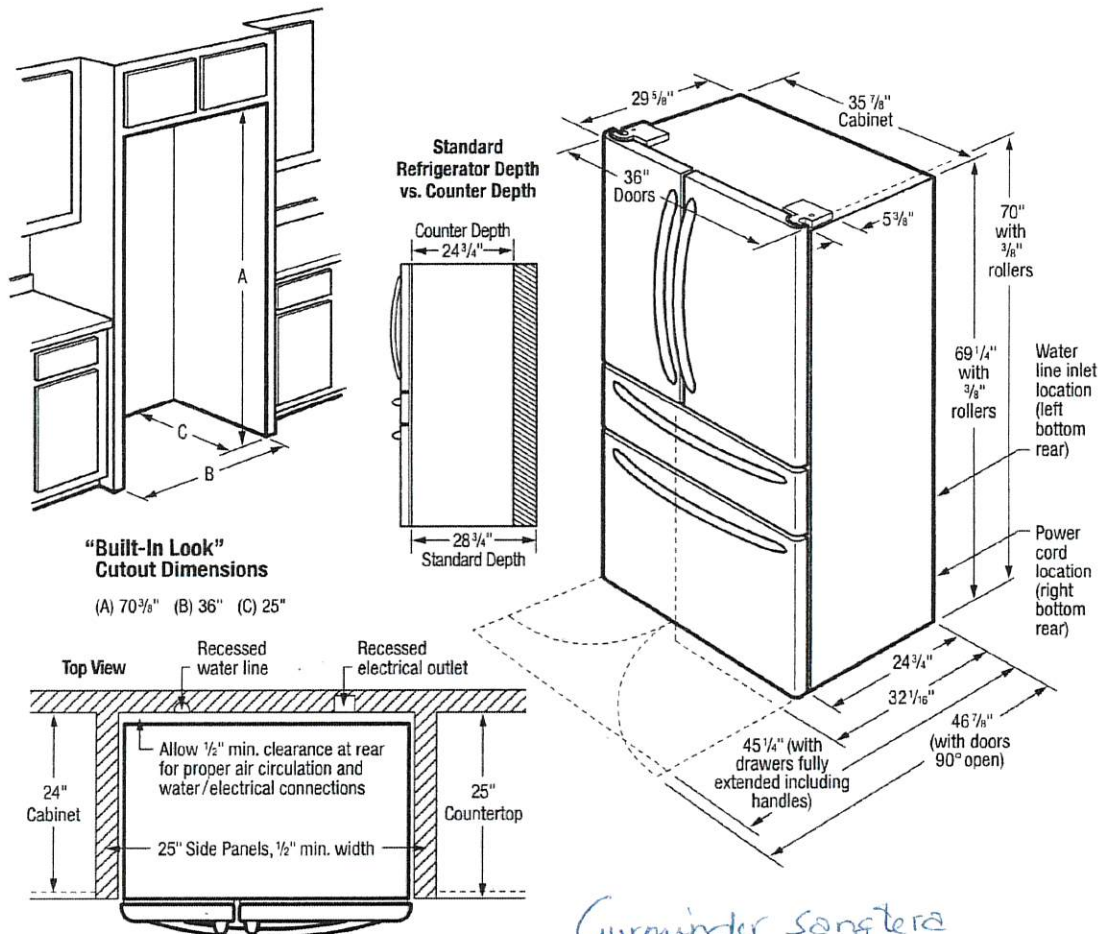

Gurminder Songtera
Gurkeet Sg
Jan. 11/2020

INSTALLATION SPECIFICATIONS

- Product Shipping Weight (approx.) - 340 Lbs.
- Voltage Rating - 120V/60 Hz/15 Amps
- Connected Load (kW Rating) @ 120 Volts = 1.14 kW
 (For use on adequately wired 120V, dedicated circuit having 2-wire service with a separate ground wire. Appliance must be grounded for safe operation.)
- Amps @ 120 Volts = 9.5 Amps
- Always consult local and national electric & plumbing codes.
- Floor should be level surface of hard material, capable of supporting fully loaded refrigerator.
- When installing refrigerator adjacent to wall, cabinet or other appliance that extends beyond front edge of unit, 20" minimum clearance recommended to allow for optimum 120° door swing, providing complete drawer/crisper access and removal. (Absolute 4-1/2" minimum clearance will ONLY allow for 90° door swing which will provide drawer/crisper access with restricted removal.)
- To ensure optimum performance, avoid installing in direct sunlight or close proximity to range, dishwasher or other heat source.

- Recess electrical outlet when possible.
- Water recess on rear wall recommended to prevent water line damage.
- Water Pressure - Cold water line must provide between 30 and 100 pounds per square inch (psi).
- Copper tubing with 1/4" O.D. recommended for water supply line with length equal to distance from rear of unit to household water supply line plus 7 additional feet. Optional Water Supply Installation Kits available.
- Adjustable front rollers to assist with door alignment.

"BUILT-IN LOOK" SPECIFICATIONS

- Minimum opening of 70-3/8"H x 36"W x 25"D required to allow for ease of installation, proper air circulation, and plumbing/electrical connections.
- Remove all wall/floor molding prior to installation.



FRIGIDAIRE

USA • 10200 David Taylor Drive • Charlotte, NC 28262 • 1-800-FRIGIDAIRE • frigidaire.com
 CANADA • 5855 Terry Fox Way • Mississauga, ON L5V 3E4 • 1-800-265-8352 • frigidaire.ca

Note: For planning purposes only. Always consult local and national electric, gas and plumbing codes. Refer to Product Installation Guide for detailed installation instructions on the web at frigidaire.com / frigidaire.ca.

Specifications subject to change. Accessories information available on the web at frigidaire.com / frigidaire.ca

FG4H2272U 10/18

© 2018 Electrolux Home Products, Inc.