

## Schedule 1: Designer Information

Use one form for each individual who reviews and takes responsibility for design activities with respect to the project.

|   |                                     |   |                                    |
|---|-------------------------------------|---|------------------------------------|
| <b>A. Project Information</b>   |                                     |   |                                    |
| Building number, street name   |                                     | Unit no.   | Lot/con.                           |
| Municipality<br>VAUGHAN (WOODBIDGE)   | Postal code                         | Plan number/ other description<br><b>M4647</b>                                                                |                                    |
| <b>B. Individual who reviews and takes responsibility for design activities</b>   |                                     |   |                                    |
| Name<br><b>MICHAEL O'ROURKE</b>   |                                     | Firm<br><b>HVAC DESIGNS LTD.</b>                                                                              |                                    |
| Street address<br><b>375 FINLEY AVE</b>   |                                     | Unit no.<br><b>202</b>                                                                                        | Lot/con.<br><b>N/A</b>             |
| Municipality<br><b>AJAX</b>   | Postal code<br><b>L1S 2E2</b>       | Province<br><b>ONTARIO</b>                                                                                    | E-mail<br><b>info@hvacdsgns.ca</b> |
| Telephone number<br><b>(905) 619-2300</b>   | Fax number<br><b>(905) 619-2375</b> | Cell number<br>( )                                                                                            |                                    |
| <b>C. Design activities undertaken by individual identified in Section B. [Building Code Table 3.5.2.1 OF Division C]</b>   |                                     |   |                                    |
| <input type="checkbox"/> House<br><input type="checkbox"/> Small Buildings<br><input type="checkbox"/> Large Buildings<br><input type="checkbox"/> Complex Buildings                                                                                         |                                     |   |                                    |
| <input checked="" type="checkbox"/> HVAC – House<br><input type="checkbox"/> Building Services<br><input type="checkbox"/> Detection, Lighting and Power<br><input type="checkbox"/> Fire Protection                                                         |                                     |   |                                    |
| <input type="checkbox"/> Building Structural<br><input type="checkbox"/> Plumbing – House<br><input type="checkbox"/> Plumbing – All Buildings<br><input type="checkbox"/> On-site Sewage Systems                                                            |                                     |   |                                    |
| Description of designer's work<br><b>HEAT LOSS / GAIN CALCULATIONS<br/>DUCT SIZING<br/>RESIDENTIAL MECHANICAL VENTILATION DESIGN SUMMARY<br/>RESIDENTIAL SYSTEM DESIGN per CSA-F280-12</b>                                                                   |                                     | <b>Model: 4201- THE MAPLEWOOD</b><br><b>Project: PINE VALLEY &amp; TESTON</b>                                 |                                    |
| <b>D. Declaration of Designer</b>   |                                     |   |                                    |
| I, <b>MICHAEL O'ROURKE</b><br>(print name)   |                                     | declare that (choose one as appropriate):                                                                     |                                    |
| <input type="checkbox"/> I review and take responsibility for the design work on behalf of a firm registered under subsection 3.2.4. of Division C, of the Building Code. I am qualified, and the firm is registered, in the appropriate classes/categories. |                                     | DATE REVIEWED<br><b>Mar 02/20</b>                                                                             |                                    |
| Individual BCIN: _____<br>Firm BCIN: _____   |                                     | INITIAL<br><b>RJ</b>                                                                                          |                                    |
| <input checked="" type="checkbox"/> I review and take responsibility for the design and am qualified in the appropriate category as an "other designer" under subsection 3.2.5. of Division C, of the Building Code.                                         |                                     |   |                                    |
| Individual BCIN: <b>19669</b><br>Basis for exemption from registration and qualification: <b>O.B.C SENTENCE 3.2.4.1 (4)</b>   |                                     |   |                                    |
| <input type="checkbox"/> The design work is exempt from the registration and qualification requirements of the Building Code.<br>Basis for exemption from registration and qualification: _____                                                              |                                     |   |                                    |
| I certify that:   |                                     |   |                                    |
| 1. The information contained in this schedule is true to the best of my knowledge.   |                                     |   |                                    |
| 2. I have submitted this application with the knowledge and consent of the firm.   |                                     |   |                                    |
| Date<br><b>October 5, 2018</b>   |                                     | Signature of Designer<br> |                                    |

### NOTE:

- For the purposes of this form, "individual" means the "person" referred to in Clause 3.2.4.7(1) d). of Division C, Article 3.2.5.1. of Division C, and all other persons who are exempt from qualification under Subsections 3.2.4. and 3.2.5. of Division C.
- Schedule 1 is not required to be completed by a holder of a license, temporary license, or a certificate of authorization, issued by the Ontario Association of Architects. Schedule 1 is also not required to be completed by a holder of a license to practise, a limited license to practise, or a certificate of authorization, issued by the Association of Professional Engineers of Ontario.

Application for a Permit Construct or Demolish – Effective January 1, 2015

20-120004 - GLD - 00 - CM

| ROOM USE                      | FACTORS  | GRS. WALL AREA | GLAZING | LOSS | GAIN | PWD  | FOY  | MUD  | LOD  | BAS   |
|-------------------------------|----------|----------------|---------|------|------|------|------|------|------|-------|
| EXP. WALL                     | CLG. HT. |                |         |      |      |      |      |      |      |       |
| 20                            | 20       | 1240           | 0       | 0    | 0    | 110  | 473  | 77   | 430  | 1773  |
| 62                            | 20       | 0              | 0       | 0    | 0    | 0    | 0    | 0    | 0    | 0     |
| 21.3                          | 16.8     | 0              | 0       | 0    | 0    | 0    | 0    | 0    | 0    | 0     |
| 21.3                          | 42.4     | 92             | 1968    | 3900 | 0    | 7    | 149  | 297  | 0    | 0     |
| 21.3                          | 26.7     | 70             | 1480    | 1882 | 0    | 0    | 0    | 0    | 0    | 0     |
| 21.3                          | 42.4     | 0              | 0       | 0    | 0    | 0    | 0    | 0    | 0    | 0     |
| 21.3                          | 103.0    | 0              | 0       | 0    | 0    | 0    | 0    | 0    | 0    | 0     |
| DOORS                         | 25.2     | 20             | 505     | 106  | 0    | 0    | 0    | 0    | 0    | 0     |
| NET EXPOSED WALL              | 4.5      | 1058           | 4722    | 582  | 103  | 460  | 96   | 416  | 1856 | 385   |
| NET EXPOSED BSM WALL ABOVE GR | 3.8      | 0              | 0       | 0    | 0    | 0    | 0    | 0    | 0    | 0     |
| EXPOSED CLG                   | 0.7      | 421            | 540     | 269  | 0    | 0    | 0    | 0    | 0    | 0     |
| NO A T T I C EXPOSED CLG      | 2.7      | 0              | 0       | 0    | 0    | 0    | 0    | 0    | 0    | 0     |
| EXPOSED FLOOR                 | 2.8      | 0              | 0       | 0    | 0    | 0    | 0    | 0    | 0    | 0     |
| BASEMENT/CRAWL HEAT LOSS      |          | 20             | 585     | 385  | 0    | 0    | 0    | 0    | 0    | 0     |
| SLAB ON GRADE HEAT LOSS       |          | 0              | 0       | 0    | 0    | 0    | 0    | 0    | 0    | 0     |
| SUBTOTAL HT LOSS              |          | 3866           | 7392    | 392  | 609  | 392  | 3566 | 819  | 1724 | 7979  |
| SUB TOTAL HT GAIN             |          | 0              | 0       | 0    | 0    | 0    | 0    | 0    | 0    | 0     |
| LEVEL FACTOR / MULTIPLIER     |          | 0.40           | 0.38    | 0.36 | 0.30 | 0.30 | 0.30 | 0.36 | 0.30 | 0.60  |
| AIR CHANGE HEAT LOSS          |          | 3448           | 1064    | 57   | 213  | 213  | 1246 | 265  | 1318 | 11823 |
| AIR CHANGE HEAT GAIN          |          | 0              | 0       | 0    | 0    | 0    | 0    | 0    | 0    | 0     |
| DUCT LOSS                     |          | 0              | 0       | 0    | 0    | 0    | 0    | 0    | 0    | 0     |
| DUCT GAIN                     |          | 0              | 0       | 0    | 0    | 0    | 0    | 0    | 0    | 0     |
| HEAT GAIN PEOPLE              | 240      | 0              | 0       | 0    | 0    | 0    | 0    | 0    | 0    | 0     |
| HEAT GAIN APPLIANCES/LIGHTS   |          | 0              | 0       | 0    | 0    | 0    | 0    | 0    | 0    | 0     |
| TOTAL HT LOSS BTU/H           |          | 13316          | 938     | 821  | 821  | 821  | 4811 | 1025 | 1724 | 18802 |
| TOTAL HT GAIN x 1.3 BTU/H     |          | 12200          | 0       | 0    | 0    | 0    | 1218 | 1454 | 1713 | 2402  |

TOTAL COMBINED HEAT LOSS BTU/H. 63066

.....

SITE NAME: PINE VALLEY & TESTON  
BUILDER: GOLD PARK HOMES

TYPE: 4201- THE MAPLEWOOD DATE: Oct-18

GFA: 2640 LO# 77464

HEATING CFM 1100 COOLING CFM 1100  
TOTAL HEAT LOSS 59,885  
AIR FLOW RATE CFM 18.37

EL206UH070XE36B  
FAN SPEED  
LOW 0  
MEDIUM 995  
HIGH 1100

AFUE = 96 %  
INPUT (BTU/H) = 66,000  
OUTPUT (BTU/H) = 64,000

| RUN COUNT | 4th | 3rd | 2nd | 1st | Bas |
|-----------|-----|-----|-----|-----|-----|
| S/A       | 0   | 0   | 4   | 12  | 5   |
| R/A       | 0   | 0   | 2   | 3   | 1   |

All S/A diffusers 4"x10" unless noted otherwise on layout.

All S/A runs 5'x10" unless noted otherwise on layout.

| ROOM NAME                 | 1    | 2    | 3    | 4     | 5     | 6     | 7      | 8     | 10   | 14    | 15    | 16    | 17    | 18   | 19   | 20   | 21   | 22   | 23   | 24   |
|---------------------------|------|------|------|-------|-------|-------|--------|-------|------|-------|-------|-------|-------|------|------|------|------|------|------|------|
| ROOM NAME                 | MBR  | ENS  | ENS  | BED-2 | BED-3 | BED-4 | L-BATH | BED-4 | MBR  | K/G/D | K/G/D | K/G/D | K/G/D | PWD  | FOY  | MUD  | BAS  | BAS  | BAS  | BAS  |
| RM LOSS MBH               | 1.72 | 0.97 | 0.97 | 2.04  | 3.19  | 3.26  | 1.26   | 3.26  | 1.72 | 3.33  | 3.33  | 3.33  | 3.33  | 0.82 | 4.81 | 1.02 | 4.31 | 4.31 | 4.31 | 4.31 |
| CFM PER RUN HEAT          | 32   | 18   | 18   | 38    | 59    | 60    | 23     | 60    | 32   | 61    | 61    | 61    | 61    | 15   | 88   | 19   | 79   | 79   | 79   | 79   |
| RM GAIN MBH               | 1.90 | 0.98 | 0.98 | 3.13  | 3.25  | 1.90  | 0.25   | 1.90  | 1.90 | 3.05  | 3.05  | 3.05  | 3.05  | 0.58 | 1.22 | 1.45 | 0.82 | 0.82 | 0.82 | 0.82 |
| CFM PER RUN COOLING       | 59   | 30   | 30   | 96    | 100   | 58    | 8      | 58    | 59   | 94    | 94    | 94    | 94    | 18   | 37   | 45   | 25   | 25   | 25   | 25   |
| ADJUSTED PRESSURE         | 0.17 | 0.17 | 0.17 | 0.16  | 0.16  | 0.17  | 0.17   | 0.17  | 0.17 | 0.16  | 0.16  | 0.16  | 0.16  | 0.16 | 0.16 | 0.17 | 0.17 | 0.17 | 0.17 | 0.17 |
| ACTUAL DUCT LGH           | 56   | 19   | 18   | 10    | 50    | 46    | 21     | 49    | 51   | 62    | 55    | 60    | 60    | 26   | 33   | 12   | 49   | 50   | 12   | 47   |
| EQUIVALENT LENGTH         | 120  | 120  | 130  | 180   | 160   | 140   | 140    | 150   | 110  | 170   | 150   | 120   | 120   | 130  | 90   | 140  | 120  | 110  | 130  | 130  |
| TOTAL EFFECTIVE LENGTH    | 176  | 139  | 148  | 190   | 210   | 186   | 161    | 199   | 161  | 232   | 205   | 180   | 180   | 166  | 158  | 152  | 169  | 160  | 142  | 177  |
| ADJUSTED PRESSURE         | 0.1  | 0.12 | 0.12 | 0.09  | 0.08  | 0.09  | 0.11   | 0.09  | 0.11 | 0.07  | 0.08  | 0.09  | 0.09  | 0.11 | 0.11 | 0.11 | 0.11 | 0.11 | 0.12 | 0.1  |
| ROUND DUCT SIZE           | 5    | 4    | 4    | 6     | 6     | 5     | 4      | 5     | 4    | 6     | 6     | 6     | 6     | 5    | 4    | 5    | 5    | 5    | 5    | 5    |
| HEATING VELOCITY (ft/min) | 235  | 207  | 207  | 194   | 301   | 441   | 264    | 441   | 367  | 311   | 311   | 311   | 311   | 448  | 172  | 646  | 580  | 580  | 580  | 580  |
| COOLING VELOCITY (ft/min) | 433  | 344  | 344  | 489   | 510   | 426   | 92     | 426   | 877  | 479   | 479   | 479   | 479   | 690  | 272  | 516  | 184  | 184  | 184  | 184  |
| OUTLET GRILL SIZE         | 3X10 | 3X10 | 3X10 | 4X10  | 4X10  | 3X10  | 3X10   | 3X10  | 3X10 | 4X10  | 4X10  | 4X10  | 4X10  | 3X10 | 3X10 | 3X10 | 3X10 | 3X10 | 3X10 | 3X10 |
| TRUNK                     | A    | B    | E    | E     | C     | C     | D      | C     | A    | A     | A     | A     | A     | D    | C    | D    | A    | B    | D    | C    |

**VAUGHAN**  
CITY OF VAUGHAN  
BUILDING PERMIT DRAWINGS  
ALL CONSTRUCTION SHALL  
COMPLY WITH THE APPLICABLE  
REQUIREMENTS OF ONTARIO  
REGULATION 332/12, (AS AMENDED),  
THE 2012 BUILDING CODE, MADE  
UNDER THE BUILDING CODE ACT

| SUPPLY AIR TRUNK SIZE  | TRUNK | STATIC PRESS. | ROUND DUCT | RECT DUCT | VELOCITY (ft/min) | TRUNK CFM | STATIC PRESS. | ROUND DUCT | RECT DUCT | VELOCITY (ft/min) | RETURN AIR TRUNK SIZE | TRUNK CFM | STATIC PRESS. | ROUND DUCT | RECT DUCT | VELOCITY (ft/min) |
|------------------------|-------|---------------|------------|-----------|-------------------|-----------|---------------|------------|-----------|-------------------|-----------------------|-----------|---------------|------------|-----------|-------------------|
| TRUNK A                | 265   | 0.07          | 8.8        | 10        | 477               | 0         | 0.00          | 0          | 0         | 8                 | TRUNK O               | 0         | 0.05          | 0          | 0         | 8                 |
| TRUNK B                | 502   | 0.07          | 11.2       | 14        | 645               | 0         | 0.00          | 0          | 0         | 8                 | TRUNK P               | 0         | 0.05          | 0          | 0         | 8                 |
| TRUNK C                | 361   | 0.08          | 9.6        | 10        | 650               | 0         | 0.00          | 0          | 0         | 8                 | TRUNK Q               | 0         | 0.05          | 0          | 0         | 8                 |
| TRUNK D                | 543   | 0.08          | 11.2       | 14        | 698               | 0         | 0.00          | 0          | 0         | 8                 | TRUNK R               | 0         | 0.05          | 0          | 0         | 8                 |
| TRUNK E                | 1101  | 0.07          | 15         | 26        | 762               | 0         | 0.00          | 0          | 0         | 8                 | TRUNK S               | 0         | 0.05          | 0          | 0         | 8                 |
| TRUNK F                | 0     | 0.00          | 0          | 0         | 0                 | 0         | 0.00          | 0          | 0         | 8                 | TRUNK T               | 0         | 0.05          | 0          | 0         | 8                 |
| RETURN AIR #           | 1     | 2             | 3          | 4         | 5                 | 0         | 0             | 0          | 0         | 0                 | TRUNK U               | 0         | 0.05          | 0          | 0         | 8                 |
| AIR VOLUME             | 115   | 130           | 165        | 155       | 360               | 0         | 0             | 0          | 0         | 0                 | TRUNK V               | 0         | 0.05          | 0          | 0         | 8                 |
| PLENUM PRESSURE        | 0.15  | 0.15          | 0.15       | 0.15      | 0.15              | 0.15      | 0.15          | 0.15       | 0.15      | 0.15              | TRUNK W               | 1100      | 0.05          | 16.3       | 30        | 8                 |
| ACTUAL DUCT LGH        | 46    | 45            | 43         | 17        | 57                | 1         | 1             | 1          | 1         | 1                 | TRUNK X               | 525       | 0.05          | 12.4       | 18        | 8                 |
| EQUIVALENT LENGTH      | 225   | 210           | 145        | 185       | 150               | 0         | 0             | 0          | 0         | 0                 | TRUNK Y               | 400       | 0.05          | 11.2       | 14        | 8                 |
| TOTAL EFFECTIVE LENGTH | 271   | 255           | 188        | 202       | 207               | 1         | 1             | 1          | 1         | 1                 | TRUNK Z               | 1100      | 0.05          | 16.3       | 24        | 10                |
| ADJUSTED PRESSURE      | 0.05  | 0.06          | 0.08       | 0.07      | 0.07              | 0.07      | 0.07          | 0.07       | 0.07      | 0.09              | DROP                  |           |               |            |           |                   |
| ROUND DUCT SIZE        | 7     | 7             | 7.1        | 7.2       | 9.9               | 0         | 0             | 0          | 0         | 0                 |                       |           |               |            |           |                   |
| INLET GRILL SIZE       | 8     | 8             | 8          | 8         | 8                 | 0         | 0             | 0          | 0         | 8                 |                       |           |               |            |           |                   |
| INLET GRILL SIZE       | 14    | 14            | 14         | 14        | 30                | 0         | 0             | 0          | 0         | 14                |                       |           |               |            |           |                   |

TYPE: 4201- THE MAPLEWOOD  
SITE NAME: PINE VALLEY & TESTON

LO # 77464

**RESIDENTIAL MECHANICAL VENTILATION DESIGN SUMMARY**

| COMBUSTION APPLIANCES |                                                                               | 9.32.3.1(1) |
|-----------------------|-------------------------------------------------------------------------------|-------------|
| a)                    | <input checked="" type="checkbox"/> Direct vent (sealed combustion) only      |             |
| b)                    | <input type="checkbox"/> Positive venting induced draft (except fireplaces)   |             |
| c)                    | <input type="checkbox"/> Natural draft, B-vent or induced draft gas fireplace |             |
| d)                    | <input type="checkbox"/> Solid Fuel (Including fireplaces)                    |             |
| e)                    | <input type="checkbox"/> No Combustion Appliances                             |             |

| HEATING SYSTEM                                 |                                         |
|------------------------------------------------|-----------------------------------------|
| <input checked="" type="checkbox"/> Forced Air | <input type="checkbox"/> Non Forced Air |
| <input type="checkbox"/> Electric Space Heat   |                                         |

| HOUSE TYPE                            |                                                      | 9.32.1(2) |
|---------------------------------------|------------------------------------------------------|-----------|
| <input checked="" type="checkbox"/> I | Type a) or b) appliance only, no solid fuel          |           |
| <input type="checkbox"/> II           | Type I except with solid fuel (including fireplaces) |           |
| <input type="checkbox"/> III          | Any Type c) appliance                                |           |
| <input type="checkbox"/> IV           | Type I, or II with electric space heat               |           |
| <input type="checkbox"/>              | Other: Type I, II or IV no forced air                |           |

| SYSTEM DESIGN OPTIONS                 |                                               | O.N.H.W.P. |
|---------------------------------------|-----------------------------------------------|------------|
| <input type="checkbox"/> 1            | Exhaust only/Forced Air System                |            |
| <input type="checkbox"/> 2            | HRV with Ducting/Forced Air System            |            |
| <input checked="" type="checkbox"/> 3 | HRV Simplified/connected to forced air system |            |
| <input type="checkbox"/> 4            | HRV with Ducting/non forced air system        |            |
| <input type="checkbox"/>              | Part 6 Design                                 |            |

| TOTAL VENTILATION CAPACITY |              | 9.32.3.3(1) |
|----------------------------|--------------|-------------|
| Basement + Master Bedroom  | 2 @ 21.2 cfm | 42.4 cfm    |
| Other Bedrooms             | 3 @ 10.6 cfm | 31.8 cfm    |
| Kitchen & Bathrooms        | 5 @ 10.6 cfm | 53 cfm      |
| Other Rooms                | 3 @ 10.6 cfm | 31.8 cfm    |
| Table 9.32.3.A.            | TOTAL        | 159.0 cfm   |

| PRINCIPAL VENTILATION CAPACITY REQUIRED |      | 9.32.3.4.(1) |
|-----------------------------------------|------|--------------|
| 1 Bedroom                               | 31.8 | cfm          |
| 2 Bedroom                               | 47.7 | cfm          |
| 3 Bedroom                               | 63.6 | cfm          |
| 4 Bedroom                               | 79.5 | cfm          |
| 5 Bedroom                               | 95.4 | cfm          |
| TOTAL                                   |      | 79.5 cfm     |

| SUPPLEMENTAL VENTILATION CAPACITY |     | 9.32.3.5. |
|-----------------------------------|-----|-----------|
| Total Ventilation Capacity        | 159 | cfm       |
| Less Principal Ventil. Capacity   | 155 | cfm       |
| Required Supplemental Capacity    | 4.0 | cfm       |

| PRINCIPAL EXHAUST FAN CAPACITY                   |                |
|--------------------------------------------------|----------------|
| Model: VANEE 65H                                 | Location: BSMT |
| 155.0 cfm                                        | 3.0 sones      |
| <input checked="" type="checkbox"/> HVI Approved |                |

| PRINCIPAL EXHAUST HEAT LOSS CALCULATION |        |        |        |      |
|-----------------------------------------|--------|--------|--------|------|
| CFM                                     | ΔT °F  | FACTOR | % LOSS |      |
| 155.0 CFM                               | X 76 F | X 1.08 | X      | 0.25 |

| SUPPLEMENTAL FANS |           | NUTONE |     |       |
|-------------------|-----------|--------|-----|-------|
| Location          | Model     | cfm    | HVI | Sones |
| ENS               | QTXEN050C | 50     | ✓   | 0.3   |
| L-BATH            | QTXEN050C | 50     | ✓   | 0.3   |
| LAUN              | QTXEN050C | 50     | ✓   | 0.3   |
| PWD               | QTXEN050C | 50     | ✓   | 0.3   |

| HEAT RECOVERY VENTILATOR |                       | 9.32.3.11.                                       |
|--------------------------|-----------------------|--------------------------------------------------|
| Model: VANEE 65H         |                       |                                                  |
| 155                      | cfm high              | 64 cfm low                                       |
| 75                       | % Sensible Efficiency | <input checked="" type="checkbox"/> HVI Approved |
|                          |                       | @ 32 deg F ( 0 deg C)                            |

| LOCATION OF INSTALLATION |                   |
|--------------------------|-------------------|
| Lot:                     | Concession        |
| Township                 | Plan:             |
| Address                  |                   |
| Roll #                   | Building Permit # |
| BUILDER:                 | GOLD PARK HOMES   |
| Name:                    |                   |
| Address:                 |                   |
| City:                    |                   |
| Telephone #:             | Fax #:            |

| INSTALLING CONTRACTOR |        |
|-----------------------|--------|
| Name:                 |        |
| Address:              |        |
| City:                 |        |
| Telephone #:          | Fax #: |

| DESIGNER CERTIFICATION                                                                                        |                         |
|---|-------------------------|
| I hereby certify that this ventilation system has been designed in accordance with the Ontario Building Code. |                         |
| Name:   | HVAC Designs Ltd.       |
| Signature:   | <i>Michael O'Rourke</i> |
| HRAI #   | 001820                  |
| Date:   | October-18              |

| <b>CSA F280-12 Residential Heat Loss and Heat Gain Calculations</b>   | |
|---|
| <b>Formula Sheet (For Air Leakage / Ventilation Calculation)</b>   | |
| LO#: 77464   | Model: 4201- THE MAPLEWOOD | Builder: GOLD PARK HOMES                            | Date: 10/5/2018                       | |
| <b>Volume Calculation</b>   |                            | <b>Air Change &amp; Delta T Data</b>                | |
| <table border="1" style="width:100%; border-collapse: collapse;"> <tr> <th>Level</th> <th>Floor Area (ft²)</th> <th>Floor Height (ft)</th> <th>Volume (ft³)</th> </tr> <tr> <td>Bsmt</td> <td>1791</td> <td>10</td> <td>17910</td> </tr> <tr> <td>First</td> <td>1791</td> <td>11</td> <td>19701</td> </tr> <tr> <td>Second</td> <td>1589</td> <td>9</td> <td>14301</td> </tr> <tr> <td>Third</td> <td>0</td> <td>9</td> <td>0</td> </tr> <tr> <td>Fourth</td> <td>0</td> <td>9</td> <td>0</td> </tr> <tr> <td colspan="2" style="text-align: right;">Total:</td> <td></td> <td>51,912.0 ft³</td> </tr> <tr> <td colspan="2" style="text-align: right;">Total:</td> <td></td> <td>1470.0 m³</td> </tr> </table>                                                                         |                            | Level                                               | Floor Area (ft²)                      | Floor Height (ft)   | Volume (ft³)      | Bsmt                                                | 1791                                  | 10                                     | 17910 | First | 1791   | 11    | 19701 | Second | 1589 | 9      | 14301 | Third | 0   | 9     | 0         | Fourth | 0 | 9 | 0   | Total: |   |   | 51,912.0 ft³ | Total: |  |  | 1470.0 m³ | <table border="1" style="width:100%; border-collapse: collapse;"> <tr> <th colspan="4">WINTER NATURAL AIR CHANGE RATE</th> </tr> <tr> <td></td> <td></td> <td></td> <td>0.335</td> </tr> <tr> <th colspan="4">SUMMER NATURAL AIR CHANGE RATE</th> </tr> <tr> <td></td> <td></td> <td></td> <td>0.122</td> </tr> </table><br><table border="1" style="width:100%; border-collapse: collapse;"> <tr> <th colspan="4">Design Temperature Difference</th> </tr> <tr> <th></th> <th>Tin °C</th> <th>Tout °C</th> <th>ΔT °C</th> </tr> <tr> <td>Winter DTDh</td> <td>22</td> <td>-20</td> <td>42</td> </tr> <tr> <td>Summer DTDc</td> <td>22</td> <td>31</td> <td>9</td> </tr> <tr> <td></td> <td></td> <td></td> <td>16</td> </tr> </table> |  | WINTER NATURAL AIR CHANGE RATE |  |  |  |  |  |  | 0.335 | SUMMER NATURAL AIR CHANGE RATE |  |  |  |  |  |  | 0.122 | Design Temperature Difference |  |  |  |  | Tin °C | Tout °C | ΔT °C | Winter DTDh | 22 | -20 | 42 | Summer DTDc | 22 | 31 | 9 |  |  |  | 16 |
| Level   | Floor Area (ft²)           | Floor Height (ft)                                   | Volume (ft³)                          | |
| Bsmt   | 1791                       | 10                                                  | 17910                                 | |
| First   | 1791                       | 11                                                  | 19701                                 | |
| Second   | 1589                       | 9                                                   | 14301                                 | |
| Third   | 0                          | 9                                                   | 0                                     | |
| Fourth   | 0                          | 9                                                   | 0                                     | |
| Total:   |                            |                                                     | 51,912.0 ft³                          | |
| Total:   |                            |                                                     | 1470.0 m³                             | |
| WINTER NATURAL AIR CHANGE RATE   | |
|   |                            |                                                     | 0.335                                 | |
| SUMMER NATURAL AIR CHANGE RATE   | |
|   |                            |                                                     | 0.122                                 | |
| Design Temperature Difference   | |
|   | Tin °C                     | Tout °C                                             | ΔT °C                                 | |
| Winter DTDh   | 22                         | -20                                                 | 42                                    | |
| Summer DTDc   | 22                         | 31                                                  | 9                                     | |
|   |                            |                                                     | 16                                    | |
| <b>5.2.3.1 Heat Loss due to Air Leakage</b>   | |
| $HL_{airb} = LR_{airb} \times \frac{V_b}{3.6} \times DTD_h \times 1.2$   | |
| 0.335   | x                          | 408.33                                              | x                                     | |
|   |                            | 42 °C                                               | x                                     | |
|   |                            | 1.2                                                 | x                                     | |
|   |                            |                                                     | =                                     | |
|   |                            |                                                     | 6930 W                                | |
|   |                            |                                                     | =                                     | |
|   |                            |                                                     | 23646 Btu/h                           | |
| <b>5.2.3.2 Heat Loss due to Mechanical Ventilation</b>   | |
| $HL_{vairb} = PVC \times DTD_h \times 1.08 \times (1 - E)$   | |
| 155 CFM   | x                          | 76 °F                                               | x                                     | |
|   |                            | 1.08                                                | x                                     | |
|   |                            | 0.25                                                | x                                     | |
|   |                            |                                                     | =                                     | |
|   |                            |                                                     | 3181 Btu/h                            | |
| <b>5.2.3.3 Calculation of Air Change Heat Loss for Each Room (Floor Multiplier Section)</b>   | |
| $HL_{airr} = Level Factor \times HL_{airbv} \times \{(HL_{ugcr} + HL_{bgcr}) \div (HL_{agelevel} + HL_{bglevel})\}$   | |
| <table border="1" style="width:100%; border-collapse: collapse;"> <tr> <th>Level</th> <th>Level Factor (LF)</th> <th>HLairbv Air Leakage + Ventilation Heat Loss (Btu/h)</th> <th>Level Conductive Heat Loss: (HLlevel)</th> <th>Air Leakage Heat Loss Multiplier (LF8)</th> </tr> <tr> <td>1</td> <td>0.5</td> <td rowspan="4">23,646</td> <td>9,704</td> <td>1.218</td> </tr> <tr> <td>2</td> <td>0.3</td> <td>20,302</td> <td>0.349</td> </tr> <tr> <td>3</td> <td>0.2</td> <td>5,642</td> <td>ALL 0.349</td> </tr> <tr> <td>4</td> <td>0</td> <td>0</td> <td>CONSTRUCTION SHALL COMPLY WITH THE APPLICABLE REQUIREMENTS OF THE 2012 BUILDING CODE, MAINTAINED UNDER THE BUILDING CODE ACT</td> </tr> <tr> <td>5</td> <td>0</td> <td>0</td> <td>0</td> <td>0.000</td> </tr>
| $HL_{vairb} = PVC \times DTD_h \times 1.08 \times (1 - E)$   | |
| 155 CFM   | x                          | 76 °F                                               | x                                     | |
|   |                            | 1.08                                                | x                                     | |
|   |                            | 0.25                                                | x                                     | |
|   |                            |                                                     | =                                     | |
|   |                            |                                                     | 661 Btu/h                             | |

### HEAT LOSS AND GAIN SUMMARY SHEET

|                                   |                                   |
|-----------------------------------|-----------------------------------|
| <b>MODEL:</b> 4201- THE MAPLEWOOD | <b>BUILDER:</b> GOLD PARK HOMES   |
| <b>SFQT:</b> 2640                 | <b>SITE:</b> PINE VALLEY & TESTON |
| <b>LO#</b> 77464                  |                                   |

#### DESIGN ASSUMPTIONS

|                      |    |                                |    |
|----------------------|----|--------------------------------|----|
| HEATING              | °F | COOLING                        | °F |
| OUTDOOR DESIGN TEMP. | -4 | OUTDOOR DESIGN TEMP.           | 88 |
| INDOOR DESIGN TEMP.  | 72 | INDOOR DESIGN TEMP. (MAX 75°F) | 72 |

#### BUILDING DATA

|                                     |                 |                           |          |
|-------------------------------------|-----------------|---------------------------|----------|
| ATTACHMENT:                         | DETACHED        | # OF STORIES (+BASEMENT): | 3        |
| FRONT FACES:                        | NORTH           | ASSUMED (Y/N):            | Y        |
| AIR CHANGES PER HOUR:               | 3.57            | ASSUMED (Y/N):            | Y        |
| AIR TIGHTNESS CATEGORY:             | AVERAGE         | ASSUMED (Y/N):            | Y        |
| WIND EXPOSURE:                      | SHELTERED       | ASSUMED (Y/N):            | Y        |
| HOUSE VOLUME (ft³):                 | 51912.0         | ASSUMED (Y/N):            | Y        |
| INTERNAL SHADING:                   | BLINDS/CURTAINS | ASSUMED OCCUPANTS:        | 5        |
| INTERIOR LIGHTING LOAD (Btu/h/ft²): | 1.27            | DC BRUSHLESS MOTOR (Y/N): | Y        |
| FOUNDATION CONFIGURATION            | BCIN_1          | DEPTH BELOW GRADE:        | 7.5 ft   |
| LENGTH: 68.0 ft                     | WIDTH: 33.0 ft  | EXPOSED PERIMETER:        | 202.0 ft |

| 2012 OBC - COMPLIANCE PACKAGE                                              |  | Compliance Package A1 |           |
|----------------------------------------------------------------------------|--|-----------------------|-----------|
| Component                                                                  |  | Nominal               | Min. Eff. |
| Ceiling with Attic Space Minimum RSI (R)-Value                             |  | 60                    | 59.22     |
| Ceiling Without Attic Space Minimum RSI (R)-Value                          |  | 31                    | 27.65     |
| Exposed Floor Minimum RSI (R)-Value                                        |  | 31                    | 29.80     |
| Walls Above Grade Minimum RSI (R)-Value                                    |  | 22                    | 17.03     |
| Basement Walls Minimum RSI (R)-Value                                       |  | 20 ci                 | 21.12     |
| Below Grade Slab Entire surface > 600 mm below grade Minimum RSI (R)-Value |  | -                     | -         |
| Edge of Below Grade Slab ≤ 600 mm Below Grade Minimum RSI (R)-Value        |  | 10                    | 10        |
| Heated Slab or Slab ≤ 600 mm below grade Minimum RSI (R)-Value             |  | 10                    | 11.13     |
| Windows and Sliding Glass Doors Maximum U-Value                            |  | 0.28                  | -         |
| Skylights Maximum U-Value                                                  |  | 0.49                  | -         |
| Space Heating Equipment Minimum AFUE                                       |  | 0.96                  | -         |
| HRV Minimum Efficiency                                                     |  | 75%                   | -         |
| Domestic Hot Water Heater Minimum EF                                       |  | 0.8                   | -         |



INDIVIDUAL BCIN: 19669

MICHAEL O'ROURKE



## Residential Foundation Thermal Load Calculator

Supplemental tool for CAN/CSA-F280
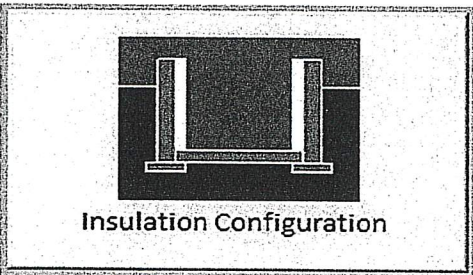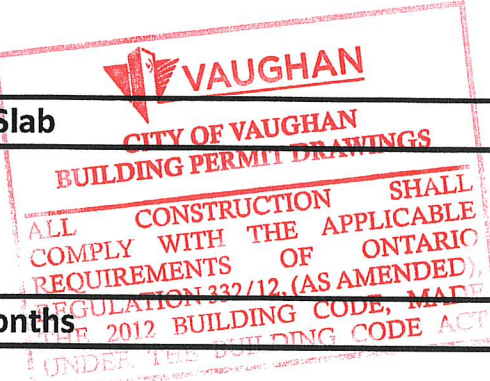
| Weather Station Description    |                                           |   |
|--------------------------------|-------------------------------------------|---|
| Province:                      | Ontario                                   |   |
| Region:                        | Vaughan (Woodbridge)                      |   |
| Site Description               |                                           |   |
| Soil Conductivity:             | Normal conductivity: dry sand, loam, clay |   |
| Water Table:                   | Normal (7-10 m, 23-33 ft)                 |   |
| Foundation Dimensions          |                                           |   |
| Floor Length (m):              | 20.7                                      | <br>Insulation Configuration |
| Floor Width (m):               | 10.1                                      |   |
| Exposed Perimeter (m):         | 0.0                                       |   |
| Wall Height (m):               | 3.0                                       |   |
| Depth Below Grade (m):         | 2.29                                      |   |
| Window Area (m <sup>2</sup> ): | 4.9                                       |   |
| Door Area (m <sup>2</sup> ):   | 1.9                                       |   |
| Radiant Slab                   |                                           |   |
| Heated Fraction of the Slab:   | 0                                         |                             |
| Fluid Temperature (°C):        | 33                                        |   |
| Design Months                  |                                           |   |
| Heating Month                  | 1                                         |   |
| Foundation Loads               |                                           |   |
| Heating Load (Watts):          | 1880                                      |   |

TYPE: 4201- THE MAPLEWOOD  
LO# 77464

## Air Infiltration Residential Load Calculator

Supplemental tool for CAN/CSA-F280


| Weather Station Description       |                            |                                       |
|-----------------------------------|----------------------------|---------------------------------------|
| Province:                         | Ontario                    |                                       |
| Region:                           | Vaughan (Woodbridge)       |                                       |
| Weather Station Location:         | Open flat terrain, grass   |                                       |
| Anemometer height (m):            | 10                         |                                       |
| Local Shielding                   |                            |                                       |
| Building Site:                    | Suburban, forest           |                                       |
| Walls:                            | Heavy                      |                                       |
| Flue:                             | Heavy                      |                                       |
| Highest Ceiling Height (m):       | 6.86                       |                                       |
| Building Configuration            |                            |                                       |
| Type:                             | Detached                   |                                       |
| Number of Stories:                | Two                        |                                       |
| Foundation:                       | Full                       |                                       |
| House Volume (m <sup>3</sup> ):   | 1470.0                     |                                       |
| Air Leakage/Ventilation           |                            |                                       |
| Air Tightness Type:               | Present (1961-) (3.57 ACH) |                                       |
| Custom BDT Data:                  | ELA @ 10 Pa.<br>3.57       | 1959.5 cm <sup>2</sup><br>ACH @ 50 Pa |
| Mechanical Ventilation (L/s):     | Total Supply<br>73.2       | Total Exhaust<br>73.2                 |
| Flue Size                         |                            |                                       |
| Flue #:                           | #1                         | #2                                    |
| Diameter (mm):                    | 0                          | 0                                     |
| #3                                | #4                         |                                       |
| 0                                 | 0                          |                                       |
| Natural Infiltration Rates        |                            |                                       |
| Heating Air Leakage Rate (ACH/H): | 0.335                      |                                       |
| Cooling Air Leakage Rate (ACH/H): | 0.122                      |                                       |

TYPE: 4201- THE MAPLEWOOD  
LO# 77464


CSA-F280-12 WOD  
PACKAGE A1 LOD


PART. BASEMENT PLAN ELEV. 'A', & 'B' - W.O.D. COND.

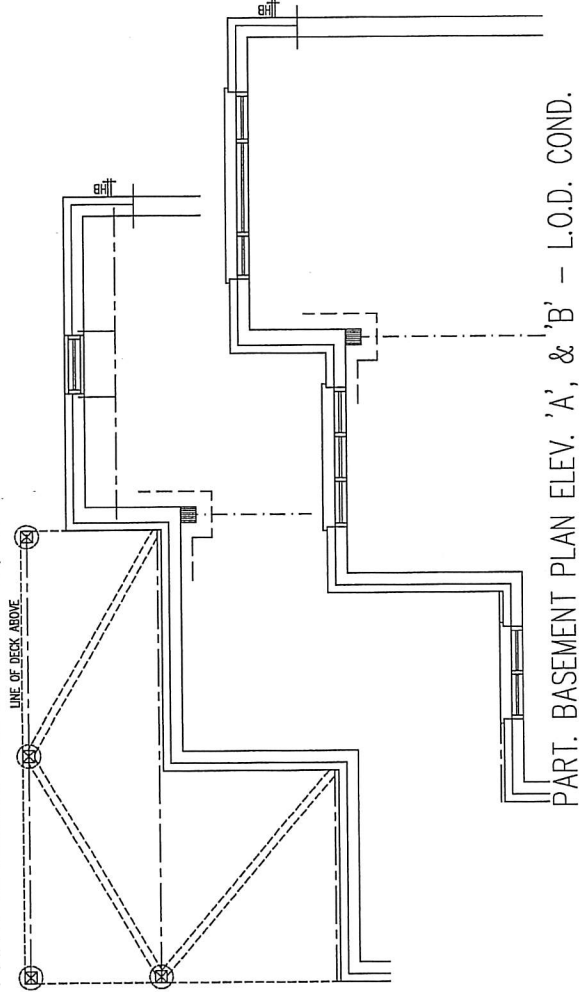

PART. BASEMENT PLAN ELEV. 'A', & 'B' - L.O.D. COND.

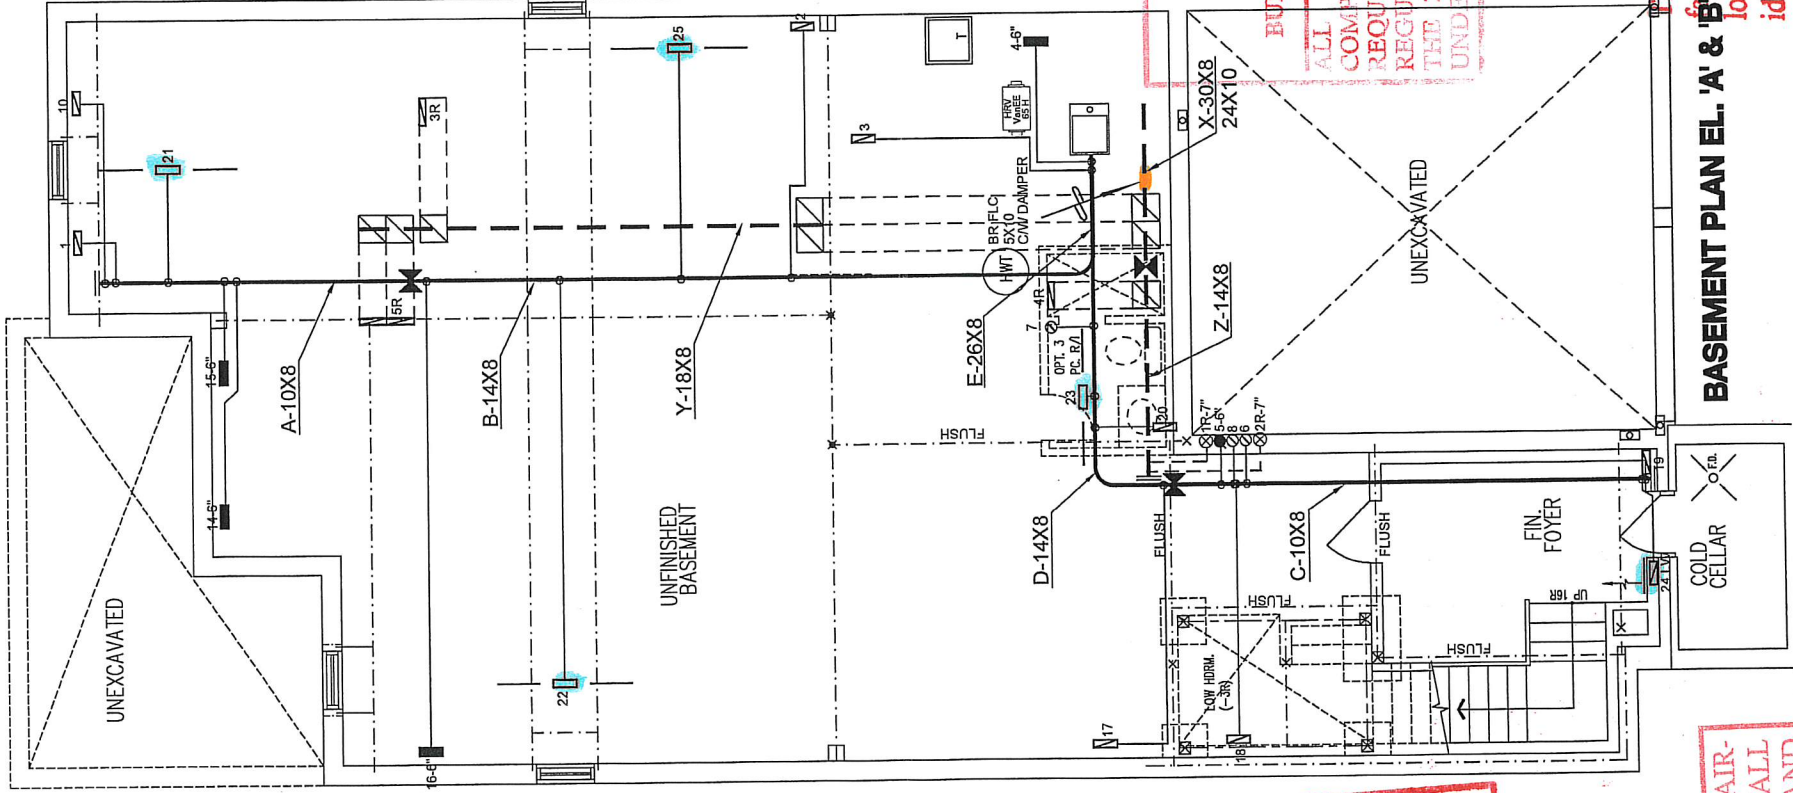

DWELLING  
☒ TYPE I  
☐ TYPE II  
☐ TYPE III  
☐ TYPE IV  
☐ COUPLED  
☐ FORCED AIR

HEATING, VENTILATING AND AIR-CONDITIONING SYSTEMS SHALL BE DESIGNED, CONSTRUCTED AND INSTALLED IN ACCORDANCE WITH THE PROVISIONS OF DIVISION B - SECTION 6.2. OF THE 2012 BUILDING CODE COMPENDIUM

**VAUGHAN**  
CITY OF VAUGHAN  
BUILDING PERMIT DRAWINGS  
ALL CONSTRUCTION SHALL COMPLY WITH THE APPLICABLE REQUIREMENTS OF ONTARIO REGULATION 332/12, (AS AMENDED), THE 2012 BUILDING CODE, MADE UNDER THE BUILDING CODE ACT

The forced air heating system circulation fan shall be controlled by a manual switch located adjacent to the ventilation fan switch and identified by the words "Circulation Fan."

PLEASE SEE BACKSIDE FOR NOTES

BASEMENT PLAN EL. 'A' & 'B'


| HVAC LEGEND |                           |  |                                 |  |                              |  |
|-------------|---------------------------|--|---------------------------------|--|------------------------------|--|
|             | SUPPLY AIR GRILLE         |  | 6" SUPPLY AIR BOOT ABOVE        |  | 14"x8" RETURN AIR GRILLE     |  |
|             | SUPPLY AIR GRILLE 6" BOOT |  | SUPPLY AIR STACK FROM 2nd FLOOR |  | 30"x8" RETURN AIR GRILLE     |  |
|             | SUPPLY AIR BOOT ABOVE     |  | 6" SUPPLY AIR STACK 2nd FLOOR   |  | FRA- FLOOR RETURN AIR GRILLE |  |

| REVISIONS |  | Description           |  | Date     |  |
|-----------|--|-----------------------|--|----------|--|
| No.       |  |                       |  |          |  |
| 1.        |  | DECK CONDITIONS ADDED |  | OCT/2018 |  |
| 2.        |  |                       |  |          |  |
| 3.        |  |                       |  |          |  |

ALL DRAWINGS, CALCULATIONS AND SPECIFICATIONS ARE THE PROPERTY OF HVAC DESIGNS LTD. © AND MAY NOT BE REPRODUCED, MODIFIED OR ALTERED WITHOUT EXPRESSED WRITTEN CONSENT. THE DRAWINGS ARE DATED AND USE OF THESE DRAWINGS AFTER ONE YEAR FROM THE DATED NOTED IS NOT AUTHORIZED. CONTRACTOR SHALL CHECK ALL CONDITIONS BEFORE PROCEEDING WITH WORK. LATEST MUNICIPAL APPROVED DRAWINGS ONLY TO BE USED DURING INSTALLATION OF HEATING SYSTEM. HVAC DESIGNS LTD. IS NOT LIABLE FOR ANY CLAIMS ARISING FROM UNAUTHORIZED USE OF THE DRAWINGS OR FROM ANY CHANGES TO ACCEPTED STANDARDS AND/OR THE ONTARIO BUILDING CODE.

| Client   |  | Project Name   |  | Client                                                 |  |
|---|--|---|--|--------------------------------------------------------|--|
| GOLD PARK HOMES   |  | PINE VALLEY & TESTON VAUGHAN, ONTARIO   |  | THE MAPLEWOOD 4201                                     |  |
| 2640 sqft   |  |   |  |                                                        |  |
| HVA DESIGNS LTD.   |  | 375 Finley Ave. Suite 202 - Ajax, Ontario L1S 2E2 Tel. 905.619.2300 - 905.420.5300 Fax 905.619.2375 Email: info@hvadesigns.ca Web: www.hvadesigns.ca |  | Specializing in Residential Mechanical Design Services |  |
| Installation to comply with the latest Ontario Building Code. All supply branch outlets shall be equipped with a manual balancing damper. Ductwork which passes through the garage or unheated spaces shall be adequately insulated and be gas-proofed. |  |   |  |                                                        |  |
| HEAT LOSS 63086 BTU/H   |  | UNIT DATA   |  | # OF RUNS S/A R/A FANS                                 |  |
| MAKE LENNOX   |  | 3RD FLOOR   |  | 3RD FLOOR                                              |  |
| MODEL EL296UH070XE36B   |  | 2ND FLOOR   |  | 2ND FLOOR                                              |  |
| INPUT 66 MBTU/H   |  | 1ST FLOOR   |  | 1ST FLOOR                                              |  |
| OUTPUT 64 MBTU/H   |  | BASEMENT   |  | BASEMENT                                               |  |
| COOLING 3.0 TONS   |  | ALL S/A DIFFUSERS 4 "x10" UNLESS NOTED OTHERWISE ON LAYOUT. ALL S/A RUNS 5/8" UNLESS NOTED OTHERWISE ON LAYOUT. UNDERCUT DOORS 1" min. FOR R/A       |  | Date JAN/2018                                          |  |
| FAN SPEED 1100 cfm @ 0.5" w.c.   |  |   |  | Scale 1/8" = 1'-0"                                     |  |
|   |  |   |  | BCIN# 19869                                            |  |
|   |  |   |  | LO# 77464                                              |  |

| HVAC LEGEND                                                                         |                           |                                                                                       |                                 |                                                                                       |                              |                                                                                       |                            |
|-------------------------------------------------------------------------------------|---------------------------|---------------------------------------------------------------------------------------|---------------------------------|---------------------------------------------------------------------------------------|------------------------------|---------------------------------------------------------------------------------------|----------------------------|
| SYMBOL                                                                              | DESCRIPTION               | SYMBOL                                                                                | DESCRIPTION                     | SYMBOL                                                                                | DESCRIPTION                  | SYMBOL                                                                                | DESCRIPTION                |
|  | SUPPLY AIR GRILLE         |  | 6" SUPPLY AIR BOOT ABOVE        |  | 14"x8" RETURN AIR GRILLE     |  | RETURN AIR STACK ABOVE     |
|  | SUPPLY AIR GRILLE 6" BOOT |  | SUPPLY AIR STACK FROM 2nd FLOOR |  | 30"x8" RETURN AIR GRILLE     |  | RETURN AIR STACK 2nd FLOOR |
|  | SUPPLY AIR BOOT ABOVE     |  | 6" SUPPLY AIR STACK 2nd FLOOR   |  | FRA- FLOOR RETURN AIR GRILLE |  | REDUCER                    |

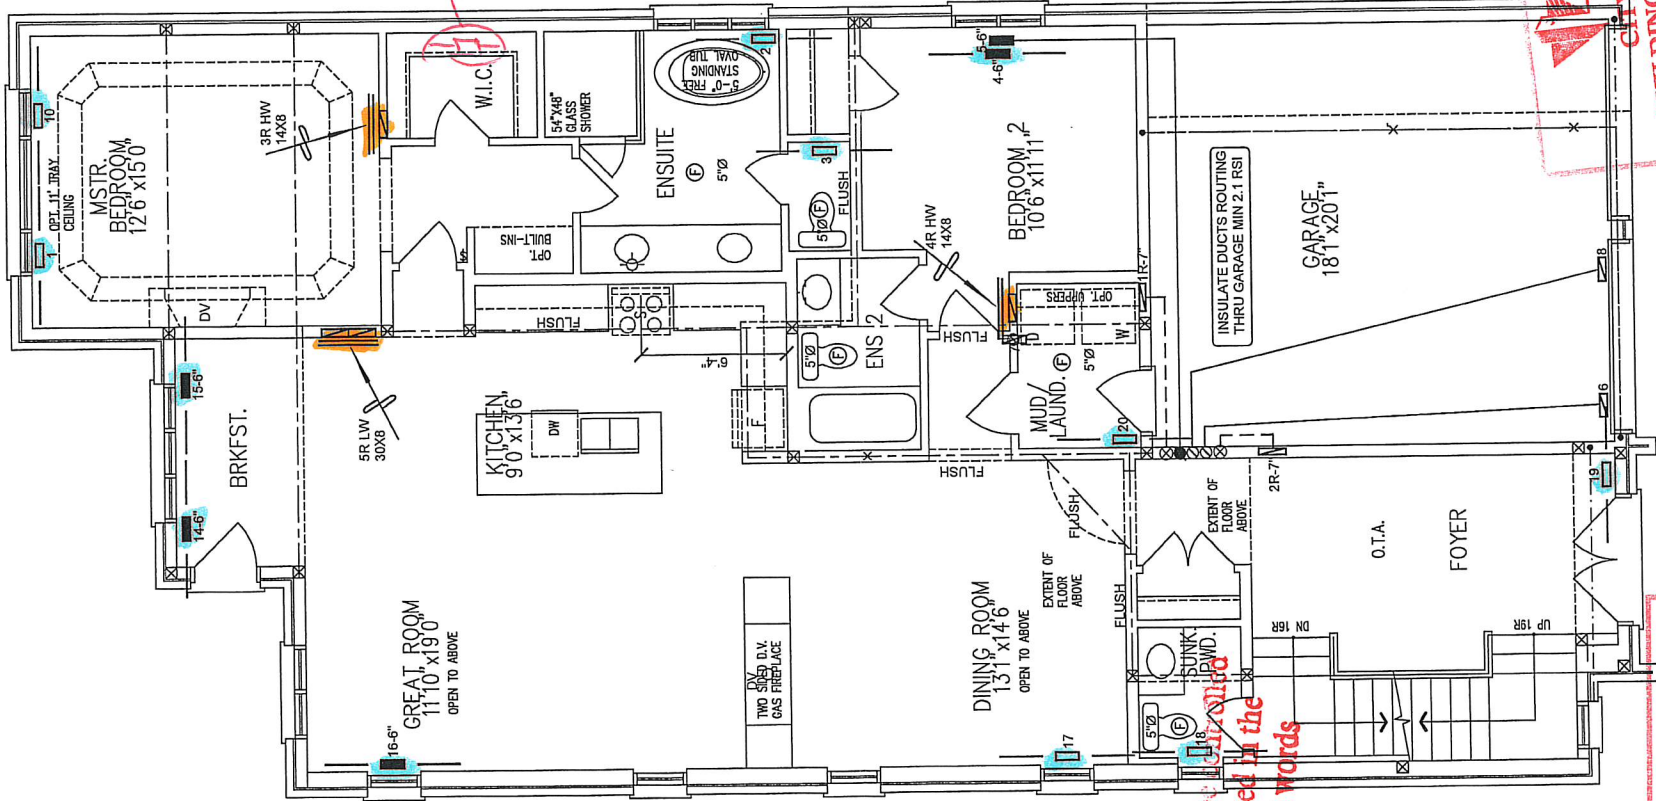

HEATING, VENTILATING AND AIR-CONDITIONING SYSTEMS SHALL BE DESIGNED, CONSTRUCTED AND INSTALLED IN ACCORDANCE WITH THE PROVISIONS OF DIVISION B - SECTION 6.2. OF THE 2012 BUILDING CODE COMPENDIUM

GROUND FLOOR PLAN EL. A

VAUGHAN  
CITY OF VAUGHAN  
BUILDING PERMIT DRAWINGS  
ALL CONSTRUCTION SHALL COMPLY WITH THE APPLICABLE REQUIREMENTS OF ONTARIO REGULATION 332/12, (AS AMENDED), FEB 2012 BUILDING CODE, MADE UNDER THE BUILDING CODE ACT

Supply or Return Air Duct exposed to an unheated space shall be insulated to provide a thermal resistance of not less than RSI 2.1 (R12)

see note #17

Two Principal Exhaust Fan shall be installed by a manual switch centrally located in the dwelling unit and identified by the words "Ventilation Fan."

ALL DRAWINGS, CALCULATIONS AND SPECIFICATIONS ARE THE PROPERTY OF HVAC DESIGNS LTD.® AND MAY NOT BE REPRODUCED, MODIFIED OR ALTERED WITHOUT EXPRESSED WRITTEN CONSENT. THE DRAWINGS ARE DATED AND USE OF THESE DRAWINGS AFTER ONE YEAR FROM THE DATED NOTED IS NOT AUTHORIZED. CONTRACTOR SHALL CHECK ALL CONDITIONS BEFORE PROCEEDING WITH WORK. LATEST MUNICIPAL APPROVED DRAWINGS ONLY TO BE USED DURING INSTALLATION OF HEATING SYSTEM. HVAC DESIGNS LTD. IS NOT LIABLE FOR ANY CLAIMS ARISING FROM UNAUTHORIZED USE OF THE DRAWINGS OR FROM ANY CHANGES TO ACCEPTED STANDARDS AND/OR THE ONTARIO BUILDING CODE.

Client

GOLD PARK HOMES

Project Name

PINE VALLEY & TESTON VAUGHAN, ONTARIO

THE MAPLEWOOD

4201

2640 sqft

HVAC DESIGNS LTD.

375 Finley Ave. Suite 202 - Ajax, Ontario  
L1S 2E2 Tel. 905.619.2300 - 905.420.5300 Fax 905.619.2375  
Email: info@hvacdesigns.ca  
Web: www.hvacdesigns.ca  
Specializing in Residential Mechanical Design Services

Installation to comply with the latest Ontario Building Code. All supply branch outlets shall be equipped with a manual balancing damper. Ductwork which passes through the garage or unheated spaces shall be adequately insulated and be gas-proofed.

Sheet Title

FIRST HEATING LAYOUT

Date

JAN/2018

Scale

1/8" = 1'-0"

BCIN#

19669

LO#

77464

CSA-F280-12



PACKAGE A1


WOD

LOD

I MICHAEL OTTOURKE HAVE REVIEWED AND TAKE RESPONSIBILITY FOR THE DESIGN WORK AND AM QUALIFIED TO SIGN THESE DRAWINGS IN ACCORDANCE WITH THE BUILDING CODE.

*Michael Ottourke*  
Michael Ottourke, BCIN# 19669  
HVAC DESIGNS LTD.
  
| HVAC LEGEND                                                                         |                           |                                                                                       |                                 |                                                                                       |                              |                                                                                       |                            |
|-------------------------------------------------------------------------------------|---------------------------|---------------------------------------------------------------------------------------|---------------------------------|---------------------------------------------------------------------------------------|------------------------------|---------------------------------------------------------------------------------------|----------------------------|
|  | SUPPLY AIR GRILLE         |  | 6" SUPPLY AIR BOOT ABOVE        |  | 14"x8" RETURN AIR GRILLE     |  | RETURN AIR STACK ABOVE     |
|  | SUPPLY AIR GRILLE 6" BOOT |  | SUPPLY AIR STACK FROM 2nd FLOOR |  | 30"x8" RETURN AIR GRILLE     |  | RETURN AIR STACK 2nd FLOOR |
|  | SUPPLY AIR BOOT ABOVE     |  | 6" SUPPLY AIR STACK 2nd FLOOR   |  | FRA- FLOOR RETURN AIR GRILLE |  | REDUCER                    |

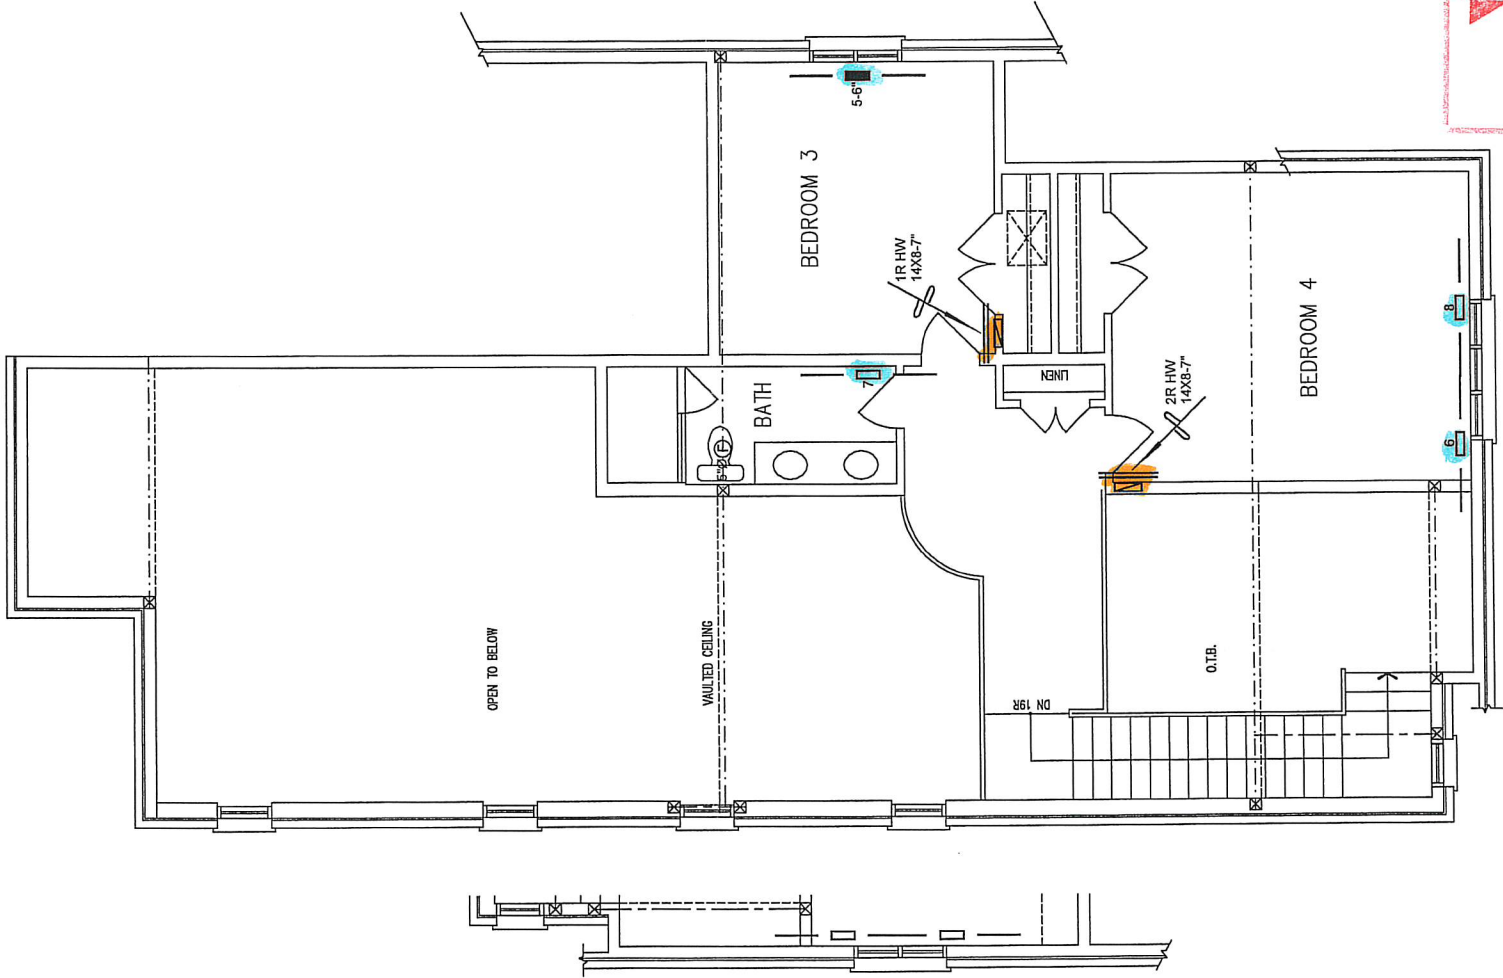

PART LOFT FLOOR PLAN EL. 'B'

HEATING, VENTILATING AND AIR-CONDITIONING SYSTEMS SHALL BE DESIGNED, CONSTRUCTED AND INSTALLED IN ACCORDANCE WITH THE PROVISIONS OF DIVISION B - SECTION 6.2. OF THE 2012 BUILDING CODE COMPENDIUM

LOFT FLOOR PLAN EL. 'A'

**VAUGHAN**  
CITY OF VAUGHAN  
BUILDING PERMIT DRAWINGS

ALL CONSTRUCTION SHALL COMPLY WITH THE APPLICABLE REQUIREMENTS OF ONTARIO REGULATION 332/12, (AS AMENDED), THE 2012 BUILDING CODE, MADE UNDER THE BUILDING CODE ACT

ALL DRAWINGS, CALCULATIONS AND SPECIFICATIONS ARE THE PROPERTY OF HVAC DESIGNS LTD.® AND MAY NOT BE REPRODUCED, MODIFIED OR ALTERED WITHOUT EXPRESSED WRITTEN CONSENT. THE DRAWINGS ARE DATED AND USE OF THESE DRAWINGS AFTER ONE YEAR FROM THE DATED NOTED IS NOT AUTHORIZED. CONTRACTOR SHALL CHECK ALL CONDITIONS BEFORE PROCEEDING WITH WORK. LATEST MUNICIPAL APPROVED DRAWINGS ONLY TO BE USED DURING INSTALLATION OF HEATING SYSTEM. HVAC DESIGNS LTD. IS NOT LIABLE FOR ANY CLAIMS ARISING FROM UNAUTHORIZED USE OF THE DRAWINGS OR FROM ANY CHANGES TO ACCEPTED STANDARDS AND/OR THE ONTARIO BUILDING CODE.

|              |                                          |             |                                   |              |
|--------------|------------------------------------------|-------------|-----------------------------------|--------------|
| Client       | GOLD PARK HOMES                          |             | Sheet Title                       |              |
|              | PINE VALLEY & TESTON<br>VAUGHAN, ONTARIO |             | SECOND FLOOR<br>HEATING<br>LAYOUT |              |
| Project Name | THE MAPLEWOOD<br>4201                    |             | Date                              | JAN/2018     |
|              |                                          |             | Scale                             | 1/8" = 1'-0" |
|              |                                          | BCIN# 19669 |                                   |              |
|              |                                          | LO#         | 77464                             |              |
|              |                                          |             |                                   |              |
|              |                                          |             |                                   |              |
**HVAC DESIGNS LTD.**

375 Finley Ave. Suite 202 - Ajax, Ontario  
L1S 2E2 Tel. 905.619.2300 - 905.420.5300 Fax 905.619.2375  
Email: info@hvacdsgns.ca  
Web: www.hvacdsgns.ca

Specializing in Residential Mechanical Design Services

Installation to comply with the latest Ontario Building Code. All supply branch outlets shall be equipped with a manual balancing damper. Ductwork which passes through the garage or unheated spaces shall be adequately insulated and be gas-proofed.