

(RC) COMPLETE ROOF (INCLUDING REAR) CONNECTED TO FRONT DOWNSPOUT AND CONNECTED TO RDC SERVICE CONNECTION

(RF) HALF ROOF CONNECTED TO FRONT DOWNSPOUT AND CONNECTED TO RDC SERVICE CONNECTION

(RR) HALF ROOF CONNECTED TO REAR DOWNSPOUT AND CONNECTED TO INFLTRATION TRENCH

1.1 - ROOF DRAINS TO BE CONNECTED AT THE FRONT TO RDC SERVICE CONNECTION FOR ROOF CONFIGURATIONS RC, RF, & RR (REFER TO SCS DWG. 906 DETAIL B)

1.2 - IF ROOF CONFIGURATION IS RR OR RC, FRONT ROOF DRAINS TO BE CONNECTED TO FRONT DOWNSPOUT & CONNECTED TO RDC SERVICE CONNECTION (REFER TO SCS DWG. 906 DETAIL B)

1.3 - IF ROOF CONFIGURATION IS RR, REAR ROOF DRAINS TO BE CONNECTED TO REAR DOWNSPOUT AND CONNECTED TO INFLTRATION TRENCH (REFER TO SCS DWG. 906 DETAIL A)

1.4 - THE CONTRACTOR SHALL CHECK AND VERIFY ALL GIVEN GRADE ELEVATIONS PRIOR TO COMMENCEMENT OF CONSTRUCTION. FOOTINGS TO BEAR ON NATURAL UNDISTURBED SOIL OR ROCK AND TO BE A MINIMUM OF 1.22m BELOW FINISHED GRADE

1.5 - ALL FRONT AND REAR YARDS SHALL BE GRADED AT A 2% - 5% GRADE WITHIN 6.0m OF THE DWELLING UNIT.

1.6 - MAXIMUM DRIVEWAY SLOPE SHALL BE 8%.

1.7 - THE MAXIMUM ALLOWABLE SLOPE IS 3:1 (HORIZONTAL AND VERTICAL) WITH A MINIMUM ELEVATION DIFFERENCE OF 600mm.

1.8 - DRIVEWAYS TO BE SET BACK A MINIMUM OF 1.0m FROM ABOVE GROUND SERVICES OR OTHER OBSTRUCTION.

1.9 - LOT HIGH POINT (HP) TO BE 2.0m UPSTREAM OF DOWNPOUTS

1.10 - ROOF LEADER EMERGENCY OVERFLOW TO DISCHARGE VIA SPLASH PAD. (REFER TO SCS DWG. 906 DETAIL A FOR ROOF CONFIGURATION RR AND DETAIL B FOR ROOF CONFIGURATION RC & RF)

1.11 - INFLTRATION TRENCHES NOT TO CROSS BETWEEN LOT LINES. (REFER TO SCS DWG. 906 DETAIL A)

1.12 - IF ROOF CONFIGURATION IS RR, REAR ROOF DOWNPOUTS CONNECTED TO 100mm CAP REMOVE CAP AND CONNECT TO REAR LOT INFLTRATION TRENCH. BUILDER IS RESPONSIBLE TO BUILD THE REAR YARD ROOF LEADER CONNECTION TO THE CAP AT THE TRENCHES (NTP.) REFER TO SCS DWG. 906 DETAIL A.

1.13 - BUILDER TO REFER TO SCS DWG. 906 DETAILS A & B FOR DETAILS ON THE INFLTRATION TRENCH.

LOT 131

WE HAVE REVIEWED THE SITE AND GRADING PLAN FOR THE PROPOSED BUILDING TO BE CONSTRUCTED, AND HEREBY CERTIFY THAT:

1. The proposed grading and appurtenant drainage works comply with sound engineering principles.
2. The proposed grading is in conformity with the grading plan approval for this subdivision and will not adversely affect adjacent lands.
3. The proposed building is compatible with the proposed grading.
4. The proposed water service curb stop is to be located in the grassed portion of the front yard.
5. The driveway conforms with the City of Vaughan By-Law 1-89 as amended and is a minimum 1.0 metre clear of all street landscape catch basins.
6. The proposed building is a minimum of 0.6 m side yard setback from a drainage swale.

SCS CONSULTING GROUP LTD.



Date: March 6/20 Reviewed By: M.R.C.

COVERAGE CALCULATION	
LOT NO.:	131
LOT AREA:	562.66 m ²
BLDG. AREA: (excl. porch)	0.00 m ²
LOT COVERAGE:	0.00 %
LANDSCAPE AREA:	0.00 m ²
LANDSCAPE COV.:	0.00 %
BUILDING HEIGHT	
MAX BUILDING HEIGHT:	11.00 m
FROM AVERAGE FIN. UNDER FRONT OF BUILDING TO MEAN ESTABLISHED GRADE:	229.03
F.F. TO TOP OF ROOF:	0.00 m
F.F. TO MEAN OF ROOF:	8.53 m
PROPOSED BLDG. HGT:	9.69 m
FRONT YARD LANDSCAPE AREA	
FRONT YARD AREA:	63.38 m ²
LANDSCAPE AREA:	37.30 m ²
COVERAGE (excl. lawn):	58.85 %
SOFT LANDSCAPE AREA	
SOFT LANDSCAPE AREA:	28.10 m ²
SOFT COVERAGE (excl. lawn):	75.34 %
REAR YARD LANDSCAPE AREA	
REAR YARD AREA:	173.16 m ²
SOFT LANDSCAPE AREA:	173.16 m ²
COVERAGE (60% MIN.):	100.00 %

ENGINEER'S SEAL: M. R. CATTO, P. ENG. 10000, PROVINCE OF ONTARIO, DATE: MAR 6/20

SITING AND GRADING PLAN

THE UNDERSIGNED HAS REVIEWED AND TAKES RESPONSIBILITY FOR THIS DESIGN AND HAS THE QUALIFICATIONS AND MEETS THE REQUIREMENTS SET OUT IN THE ONTARIO BUILDING CODE TO BE A DESIGNER.

QUALIFICATION INFORMATION

ALBIN WHITING

SIGNATURE


HUNT DESIGN ASSOCIATES INC.

19695

23177

BON

19695

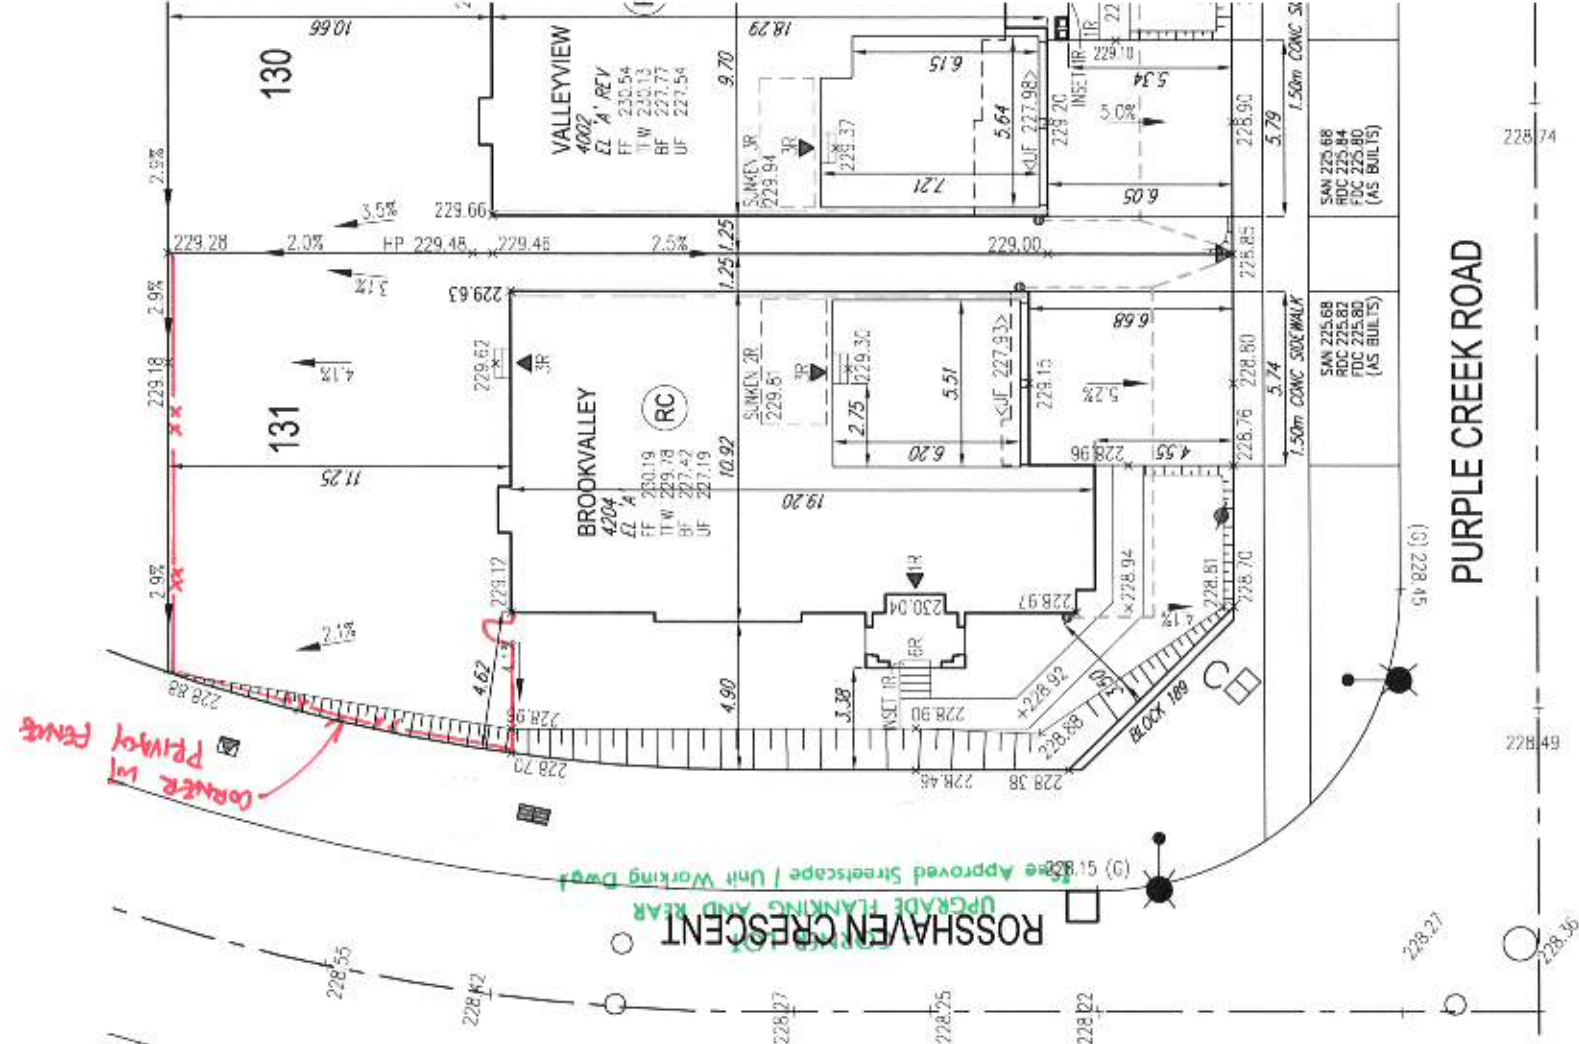

AIR CONDITIONER ROUGH
IN REQUIRED

It is the builder's complete responsibility to ensure that all plans submitted for approval fully comply with the Architectural Guidelines and all applicable regulations and provisions in the subdivision agreement. The Control Architect is not responsible in any way for examining or approving site (lotting) plans or working drawings with respect to any zoning or building code or permit matter or that any house can be properly built or located on its lot.

This is to certify that these plans comply with the applicable Architectural Design Guidelines approved by the City of VAUGHAN.

ARCHITECTURAL REVIEW & APPROVAL

MAR 10 2020

John G. Williams Limited, Architect

- GENERAL NOTES:
1. BUILDER TO VERIFY LOCATION OF UTILITIES AND OTHER SERVICES. IF MIN. DIMENSIONS ARE NOT MAINTAINED, BUILDER IS TO RELOCATE AT BUILDER'S EXPENSE.
 2. BUILDER TO VERIFY ELEV. OF STIL AND SAN. LATERALS IN RELATION TO BASEMENT US OF FOOTING ELEVATIONS FOR COMPLIANCE WITH MUNICIPAL STANDARDS PRIOR TO EXCAVATION.
 3. APPROVED PERMIT DRAWINGS & CONSTRUCTION NOTES MUST BE REVIEWED AND FOLLOWED IN CONJUNCTION WITH THE SITING AND GRADING PLAN. BUILDER TO VERIFY BUILDING ENVELOPE ON SITE PLAN MATCHES APPROVED PERMIT DRAWINGS & CONSTRUCTION NOTES PRIOR TO POURING CONCRETE. IF THERE ARE ANY DISCREPANCIES, THEY ARE TO BE BROUGHT TO THE ATTENTION OF HUNT DESIGN ASSOCIATES INC.
 4. UNLESS NOTED ON BUILDING ENVELOPE OR APPROVED PERMIT DRAWINGS & CONSTRUCTION NOTES, ALL TOP OF FOUNDATION WALLS INCLUDING GARAGE WALLS TO BE CONSISTENT WITH THE ELEVATION PROVIDED FOR TYP ON SITING AND GRADING PLAN. THE EXTERIOR OF THE FOUNDATION WALL TO BE PROVIDED WITH A REDUCTION OF THICKNESS FOR MASONRY VENEER AS REQUIRED.

ISSUED FOR FINAL APPROVAL

ISSUED FOR PRELIMINARY APPROVAL

AW 2020.03.03

-

-

-

-



IF FINISHED FLOOR

IF FINISHED FLOOR

SHEET NAME

PURPLE CREEK ROAD

GOLDPARK HOMES - 217020

PINE VALLEY, VAUGHAN ONT.

217020WSP01

8566 Woodbine Ave, Markham, ON L3R 0J7 T 905.737.5133 F 905.737.7326

131

131

131

131

131