


53-07-00

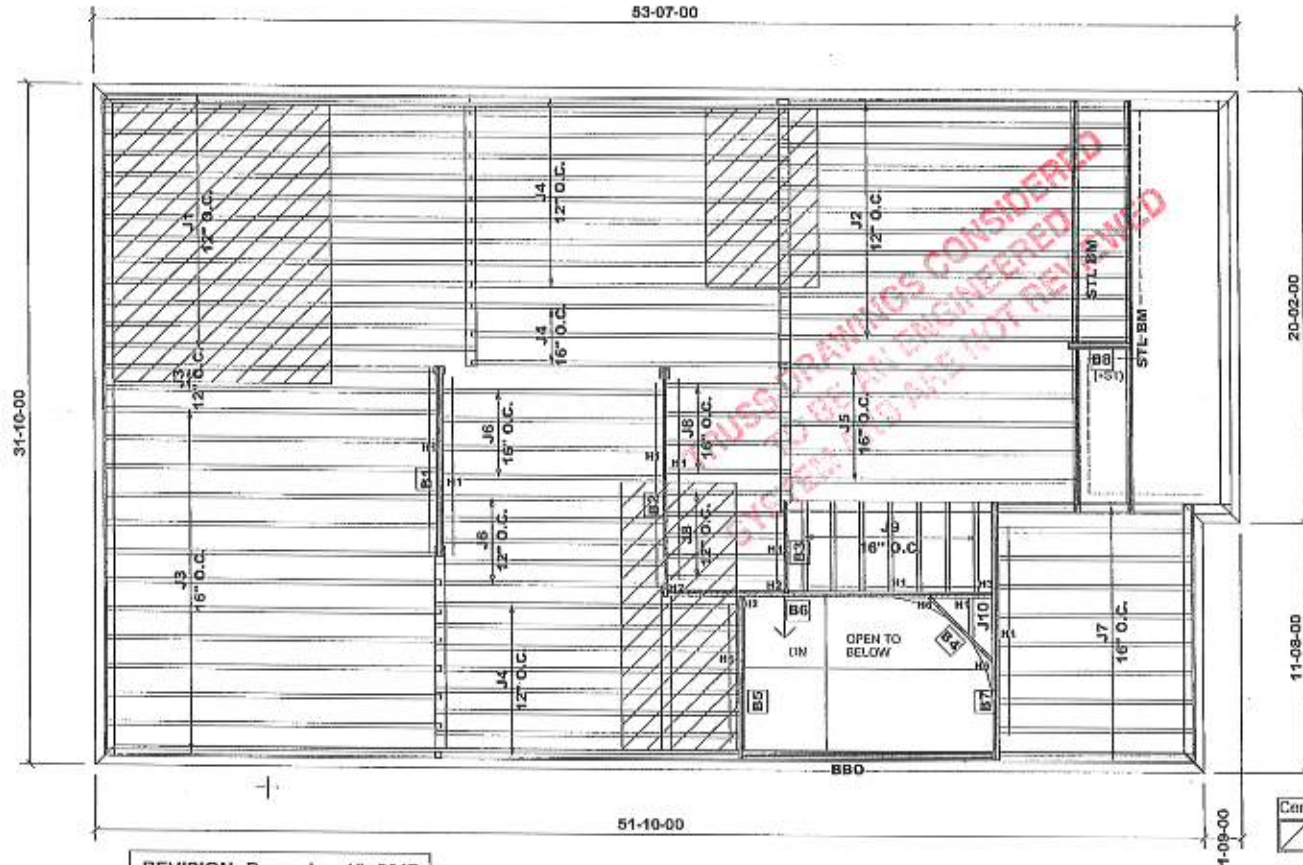

REVISION: December 18, 2017

MODEL: UNIT 4001 - ELA

## Second Floor Framing

Do not scale - refer to architectural plans for dimensions

| Products |           |                  |        |         |
|----------|-----------|------------------|--------|---------|
| PlotID   | Length    | Product          | Pieces | Net Qty |
| J1       | 18'-00-00 | 11 7/8" NI-20    | 1      | 13      |
| J2       | 17'-00-00 | 11 7/8" NI-20    | 1      | 12      |
| J3       | 16'-00-00 | 11 7/8" NI-20    | 1      | 15      |
| J4       | 15'-00-00 | 11 7/8" NI-20    | 1      | 21      |
| J5       | 14'-00-00 | 11 7/8" NI-20    | 1      | 6       |
| J6       | 11'-00-00 | 11 7/8" NI-20    | 1      | 9       |
| J7       | 10'-00-00 | 11 7/8" NI-20    | 1      | 10      |
| J8       | 8'-00-00  | 11 7/8" NI-20    | 1      | 9       |
| J9       | 5'-00-00  | 11 7/8" NI-20    | 1      | 7       |
| J10      | 2'-00-00  | 11 7/8" NI-20    | 1      | 1       |
| B6       | 15'-00-00 | VERSALAM-12 2.0E | 2      | 2       |
| B7       | 13'-00-00 | VERSALAM-12 2.0E | 2      | 2       |
| B2       | 11'-00-00 | VERSALAM-12 2.0E | 1      | 1       |
| B1       | 9'-00-00  | VERSALAM-12 2.0E | 2      | 2       |
| B5       | 8'-00-00  | VERSALAM-12 2.0E | 1      | 1       |
| B3       | 5'-00-00  | VERSALAM-12 2.0E | 1      | 1       |
| B4       | 5'-00-00  | VERSALAM-12 2.0E | 1      | 1       |
| B8       | 3'-00-00  | VERSALAM-12 2.0E | 2      | 2       |

## HANGER SCHEDULE

H1.....LT251188 (TM)  
H2.....HUS1.81/10(FM)  
H3.....HGUS410(FM)  
H8.....LSSU125(FM)

## NOTE:

TM.....TOP MOUNT HANGERS  
FM.....FACE MOUNT HANGERS


## RIMBOARD

1- 1/8" X 11 7/8" O.S.B.

SURFLOOR - 3/4" NAILED &amp; GLUED

APP - AS PER PLAN

BRO - BEAM BY OTHERS

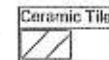

Ceramic tile application as per O.B.C. 9.30.6

1-2X6 SPF#2 Squash Block req'd on one side of each joist under interior load bearing wall. Multiple Squash Blocks are req'd under concentrated loads.

JT/PL: 45147/95234

Builder: Gold Park

Location: Vaughan

Designer: NL

Alpa Roof Trusses Inc.

Salesperson: Derek

LI: 290675

Project: Pine Valley

Date: November 17, 2017

Sheet: 1 of 6

Maple, Ontario

Home Lumber

FOR OFFICE USE ONLY

CITY OF VAUGHAN

BUILDING STANDARDS DEPARTMENT  
PLANS EXAMINATION

RECEIVED

ZONING

GRADING

BUILDING CODE

MECHANICAL


PLUMBING

FIRE

DATE REVIEWED

INITIAL

20-120001-6LD-00-CM

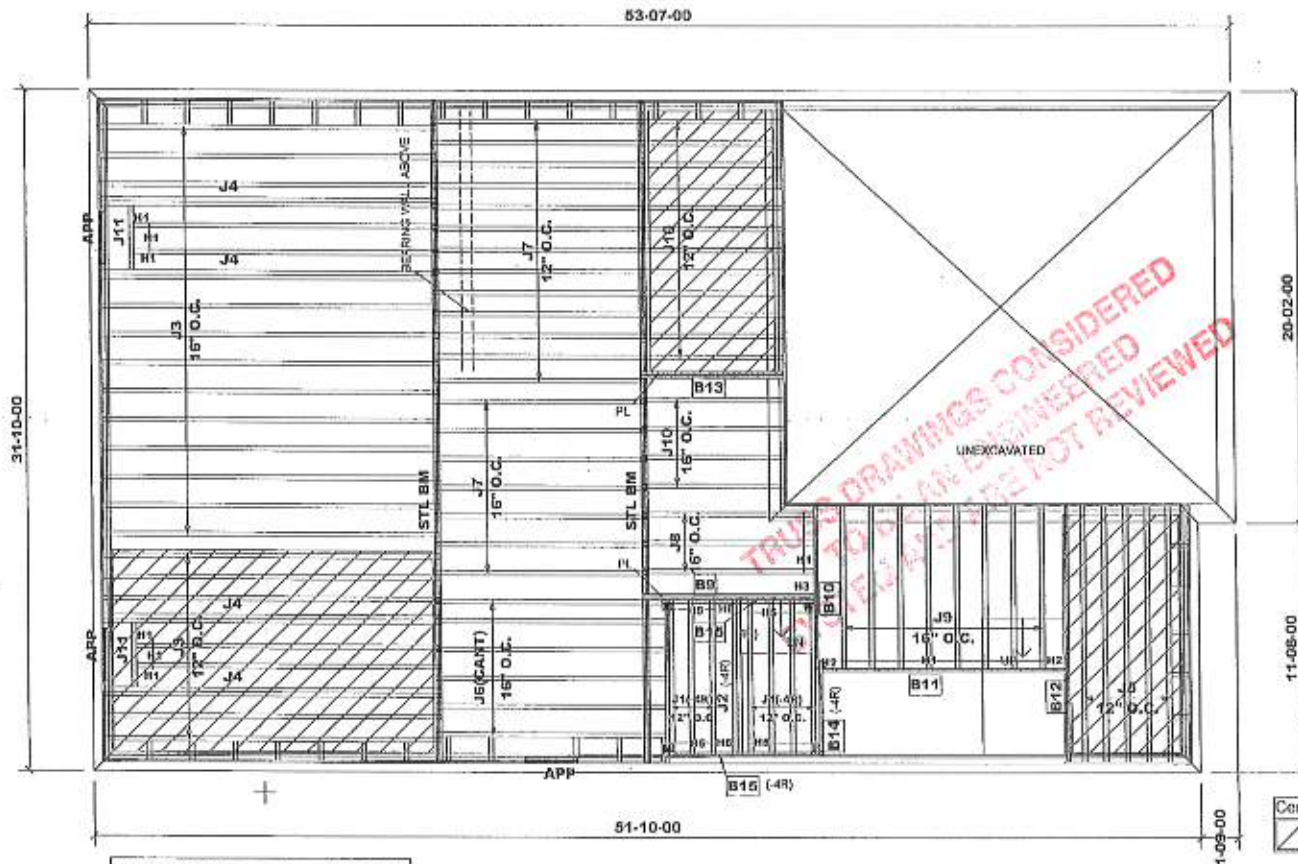

REVISION: December 18, 2017

MODEL: UNIT 4001 - EL.A+B

### First Floor Framing

Do not scale - refer to architectural plans for dimensions

5/16\"/>

| Products |          |                  |        |         |
|----------|----------|------------------|--------|---------|
| PlotID   | Length   | Product          | Pieces | Nel Qty |
| J1       | 8-00-00  | 9 1/2" NI-20     | 1      | 7       |
| J2       | 8-00-00  | 9 1/2" NI-20     | 2      | 2       |
| J3       | 16-00-00 | 11 7/8" NI-20    | 1      | 21      |
| J4       | 16-00-00 | 11 7/8" NI-20    | 2      | 8       |
| J5       | 12-00-00 | 11 7/8" NI-20    | 1      | 5       |
| J6       | 11-00-00 | 11 7/8" NI-20    | 1      | 6       |
| J7       | 10-00-00 | 11 7/8" NI-20    | 1      | 20      |
| J8       | 9-00-00  | 11 7/8" NI-20    | 1      | 3       |
| J9       | 8-00-00  | 11 7/8" NI-20    | 1      | 8       |
| J10      | 7-00-00  | 11 7/8" NI-20    | 1      | 16      |
| J11      | 3-00-00  | 11 7/8" NI-20    | 1      | 2       |
| B11      | 12-00-00 | VERSALAM-12 2.0E | 1      | 1       |
| B12      | 12-00-00 | VERSALAM-12 2.0E | 1      | 1       |
| B9       | 9-00-00  | VERSALAM-12 2.0E | 2      | 2       |
| B15      | 8-00-00  | VERSALAM-10 2.0E | 1      | 2       |
| B10      | 8-00-00  | VERSALAM-12 2.0E | 1      | 1       |
| B13      | 7-00-00  | VERSALAM-12 2.0E | 2      | 2       |
| B14      | 5-00-00  | VERSALAM-10 2.0E | 1      | 1       |

#### HANGER SCHEDULE

H1.....LT251188(TM)  
H2.....HUS1.6110(FM)  
H3.....LT258(TM)  
H5.....MIT39.5-2(TM)

#### NOTE:

TM.....TOP MOUNT HANGERS  
FM.....FACE MOUNT HANGERS

#### RIMBOARD

1. 1/8\"/>

SUBFLOOR - 3/4\"/>

APP - AS PER PLAN  
BDO - BEAM BY OTHERS

Ceramic tile application as per O.B.C. 9.30.6

Provide I-Joist Blocking between cantilevered joists (along bearing) and rimboard closure at ends.

1-2X0 SPF#2 Squash Block req'd on one side of each joist under interior load bearing wall. Multiple Squash Blocks are req'd under concentrated loads.

JT/PL: 45147/95234

LI: 290675

Builder: Gold Park

Project: Pine Valley

Location: Vaughan

Date: November 17, 2017

Designer: NL


Sheet: 2 of 6

Alpa Roof Trusses Inc.

Maple, Ontario

Salesperson: Derek

Home Lumber

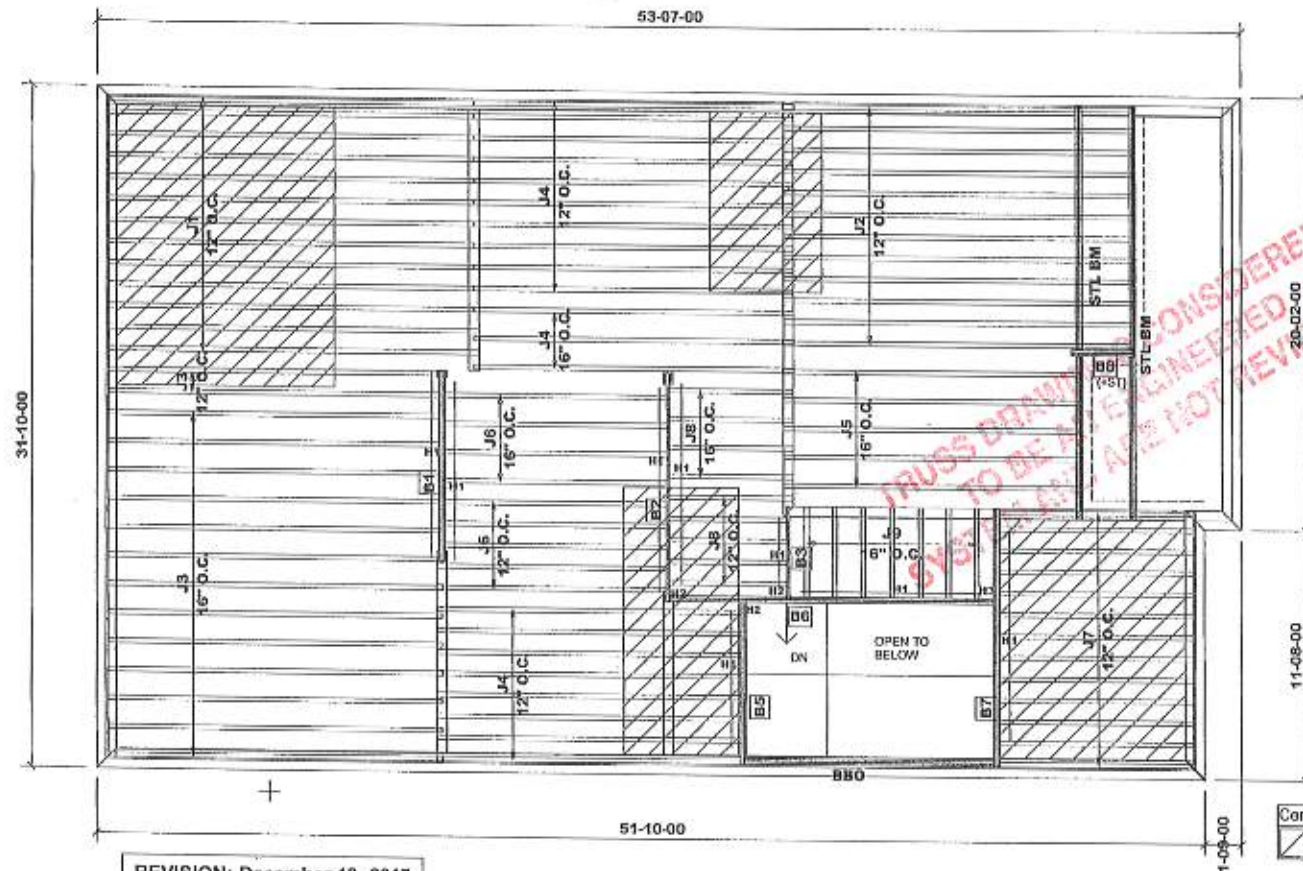

| Products |          |                  |        |         |
|----------|----------|------------------|--------|---------|
| PlotID   | Length   | Product          | Pieces | Net Qty |
| J1       | 18-00-00 | 11 7/8" NI-20    | 1      | 13      |
| J2       | 17-00-00 | 11 7/8" NI-20    | 1      | 12      |
| J3       | 18-00-00 | 11 7/8" NI-20    | 1      | 15      |
| J4       | 15-00-00 | 11 7/8" NI-20    | 1      | 21      |
| J5       | 14-00-00 | 11 7/8" NI-20    | 1      | 5       |
| J6       | 11-00-00 | 11 7/8" NI-20    | 1      | 9       |
| J7       | 10-00-00 | 11 7/8" NI-20    | 1      | 13      |
| J8       | 8-00-00  | 11 7/8" NI-20    | 1      | 9       |
| J9       | 5-00-00  | 11 7/8" NI-20    | 1      | 7       |
| B6       | 16-00-00 | VERSALAM-12 2.0E | 2      | 2       |
| B7       | 13-00-00 | VERSALAM-12 2.0E | 2      | 2       |
| B2       | 11-00-00 | VERSALAM-12 2.0E | 1      | 1       |
| B1       | 9-00-00  | VERSALAM-12 2.0E | 2      | 2       |
| B5       | 8-00-00  | VERSALAM-12 2.0E | 1      | 1       |
| B3       | 5-00-00  | VERSALAM-12 2.0E | 1      | 1       |
| B8       | 3-00-00  | VERSALAM-12 2.0E | 2      | 2       |

#### HANGER SCHEDULE

H1.....LT251188 (TM)  
H2.....HUS1.81/10(FM)  
H3.....HGUS410(FM)  
H6.....LSSU125(FM)

#### NOTE:

TM.....TOP MOUNT HANGERS  
FM.....FACE MOUNT HANGERS

#### RIMBOARD

1- 1/8" X 11 7/8" O.S.B.

SUBFLOOR - 3/4" NAILED & GLUED

APP - AS PER PLAN

BBO - BEAM BY OTHERS

Ceramic tile application as per O.B.C. 9.30.6

1-2X6 SPF#2 Squash Block req'd on one side of each joist under interior load bearing wall. Multiple Squash Blocks are req'd under concentrated loads.

REVISION: December 18, 2017

MODEL: UNIT 4001 - EL.A  
W/OPT. 2ND FLOOR

## Second Floor Framing

Do not scale - refer to architectural plans for dimensions

JT/PL: 45147/95234

LI: 290675

Builder: Gold Park

Project: Pine Valley

Location: Vaughan

Date: November 19, 2017

Designer: NL


Sheet: 3 of 6

Alpa Roof Trusses Inc.

Maple, Ontario

Salesperson: Derek

Home Lumber

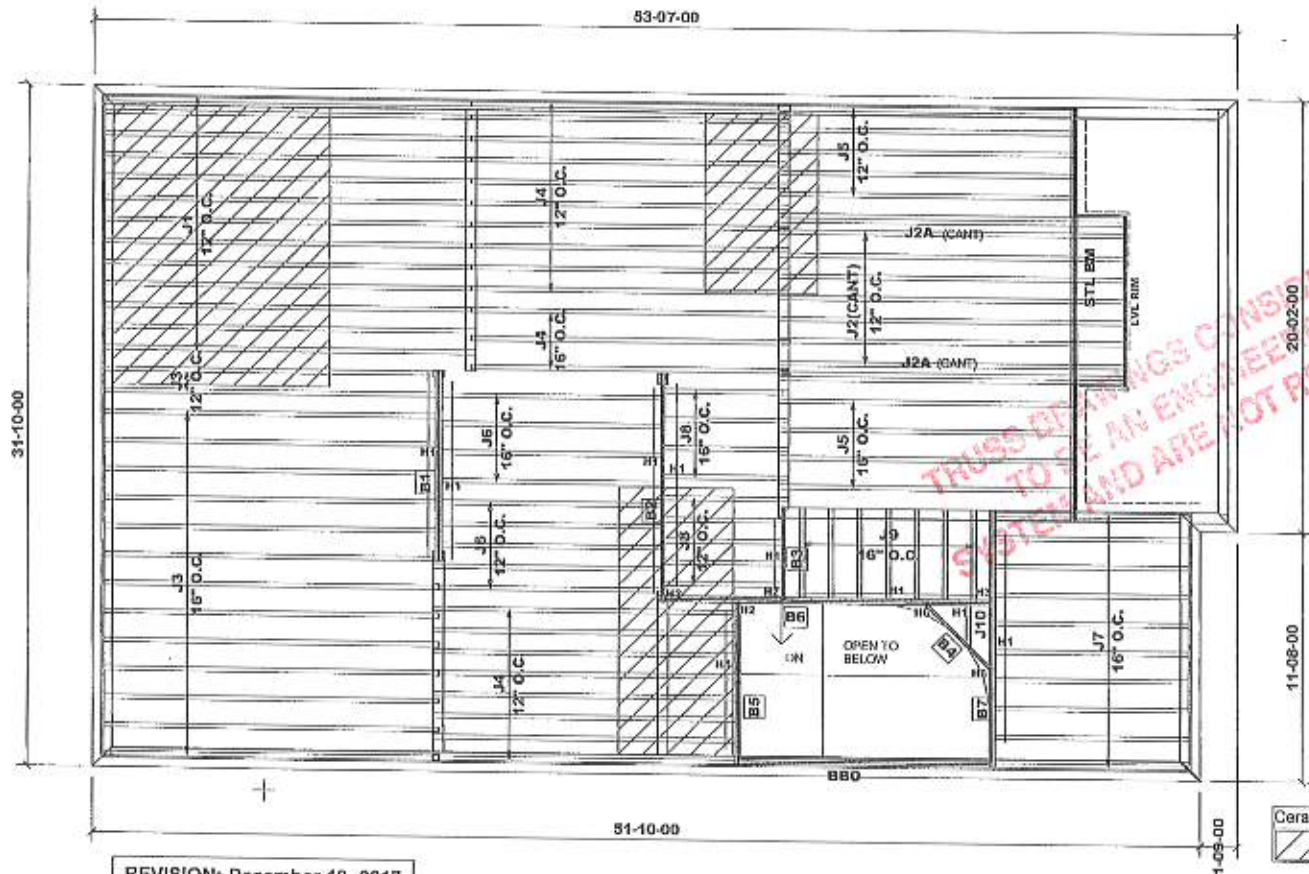

REVISION: December 18, 2017


MODEL: UNIT 4001 - EL.B

## Second Floor Framing

Do not scale - refer to architectural plans for dimensions

11 3/8\"/>

TOTAL LENGTH: 8'

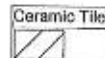

Ceramic Tile

| Products |          |                  |      |         |
|----------|----------|------------------|------|---------|
| ProdID   | Length   | Product          | Pies | Net Qty |
| J1       | 18-00-00 | 11 7/8" NI-20    | 1    | 13      |
| J2       | 17-00-00 | 11 7/8" NI-20    | 1    | 7       |
| J2A      | 17-00-00 | 11 7/8" NI-20    | 2    | 4       |
| J3       | 18-00-00 | 11 7/8" NI-20    | 1    | 15      |
| J4       | 15-00-00 | 11 7/8" NI-20    | 1    | 21      |
| J5       | 14-00-00 | 11 7/8" NI-20    | 1    | 9       |
| J6       | 11-00-00 | 11 7/8" NI-20    | 1    | 9       |
| J7       | 10-00-00 | 11 7/8" NI-20    | 1    | 10      |
| J8       | 6-00-00  | 11 7/8" NI-20    | 1    | 9       |
| J9       | 5-00-00  | 11 7/8" NI-20    | 1    | 7       |
| J10      | 2-00-00  | 11 7/8" NI-20    | 1    | 1       |
| B8       | 16-00-00 | VERSALAM-12 2.0E | 2    | 2       |
| B7       | 13-00-00 | VERSALAM-12 2.0E | 2    | 2       |
| B2       | 11-00-00 | VERSALAM-12 2.0E | 1    | 1       |
| B1       | 9-00-00  | VERSALAM-12 2.0E | 2    | 2       |
| B5       | 8-00-00  | VERSALAM-12 2.0E | 1    | 1       |
| LVL RIM  | 8-00-00  | VERSALAM-12 2.0E | 1    | 1       |
| B3       | 5-00-00  | VERSALAM-12 2.0E | 1    | 1       |
| B4       | 5-00-00  | VERSALAM-12 2.0E | 1    | 1       |

### HANGER SCHEDULE

H1.....LT2511BB (TM)  
H2.....HUS1.81/10(FM)  
H3.....HCUS410(FM)  
H8.....LSSU125(FM)

### NOTE:

TM.....TOP MOUNT HANGERS  
FM.....FACE MOUNT HANGERS

### RIMBOARD

1- 1/8\"/>

SUBFLOOR - 3/4\"/>

APP - AS PER PLAN  
BB0 - BEAM BY OTHERS

Ceramic tile application as per O.B.C. 9.30.6

Provide 1-Joist Blocking between cantilevered joists (along bearing) and rimboard closure at ends.

1-2X8 SPF#2 Squash Block req'd on one side of each joist under interior load bearing wall. Multiple Squash Blocks are req'd under concentrated loads.

JT/PL: 45147/95234

LI: 290675

Builder: Gold Park

Project: Pine Valley

Location: Vaughan

Date: November 17, 2017

Designer: NL


Sheet: 4 of 6

Alpa Roof Trusses Inc.

Maple, Ontario

Salesperson: Derek

Home Lumber

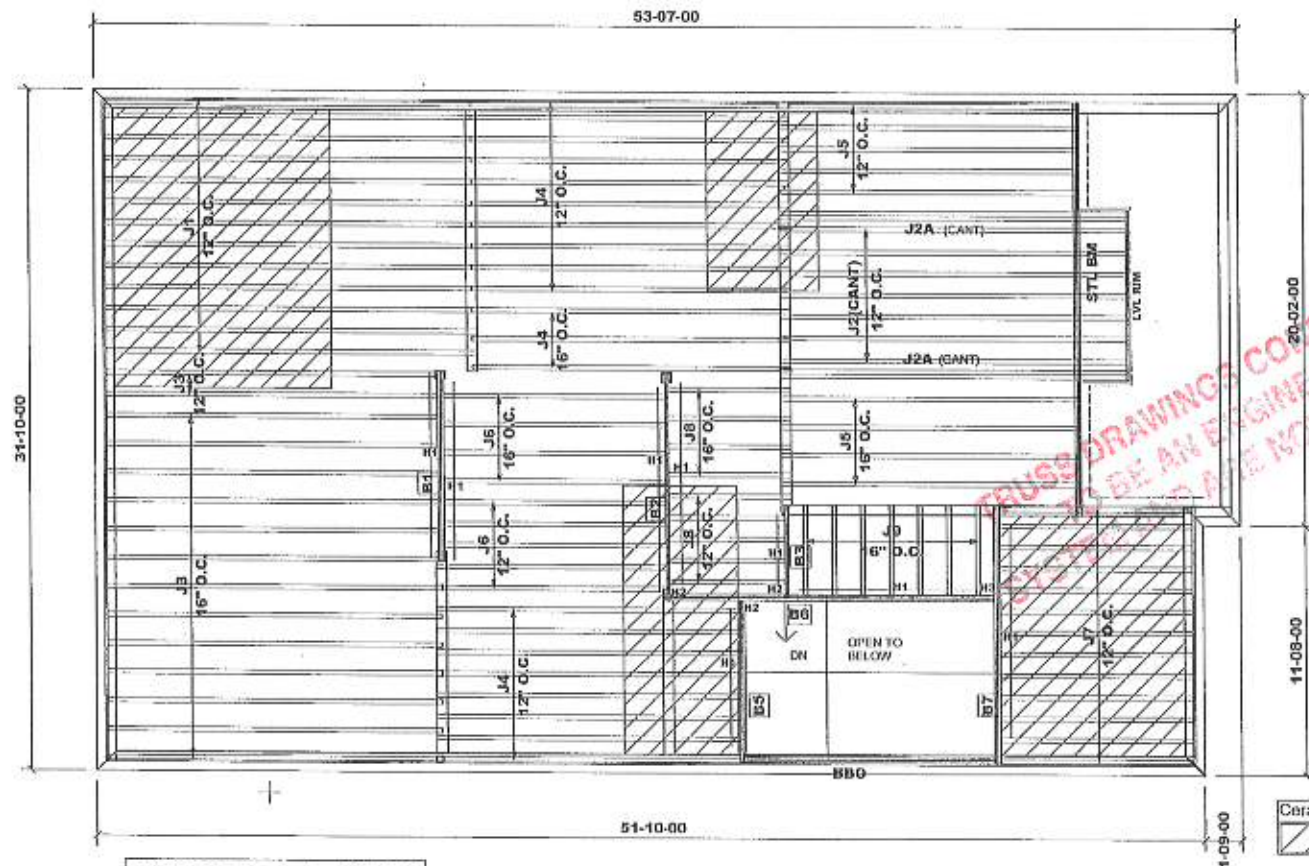

| Products |          |                  |        |         |
|----------|----------|------------------|--------|---------|
| PlotID   | Length   | Product          | Pieces | Net Qty |
| J1       | 18-00-00 | 11 7/8" NI-20    | 1      | 13      |
| J2       | 17-00-00 | 11 7/8" NI-20    | 1      | 7       |
| J2A      | 17-00-00 | 11 7/8" NI-20    | 2      | 4       |
| J3       | 16-00-00 | 11 7/8" NI-20    | 1      | 15      |
| J4       | 15-00-00 | 11 7/8" NI-20    | 1      | 21      |
| J5       | 14-00-00 | 11 7/8" NI-20    | 1      | 9       |
| J6       | 11-00-00 | 11 7/8" NI-20    | 1      | 9       |
| J7       | 10-00-00 | 11 7/8" NI-20    | 1      | 13      |
| J8       | 8-00-00  | 11 7/8" NI-20    | 1      | 9       |
| J9       | 5-00-00  | 11 7/8" NI-20    | 1      | 7       |
| B6       | 16-00-00 | VERSALAM-12 2.0E | 2      | 2       |
| B7       | 13-00-00 | VERSALAM-12 2.0E | 2      | 2       |
| B2       | 11-00-00 | VERSALAM-12 2.0E | 1      | 1       |
| B1       | 9-00-00  | VERSALAM-12 2.0E | 2      | 2       |
| B5       | 8-00-00  | VERSALAM-12 2.0E | 1      | 1       |
| LVL RIM  | 8-00-00  | VERSALAM-12 2.0E | 1      | 1       |
| B3       | 5-00-00  | VERSALAM-12 2.0E | 1      | 1       |

| HANGER SCHEDULE |                    |
|-----------------|--------------------|
| H1              | L 125118S (TM)     |
| H2              | HUS1.81/10(FM)     |
| H3              | HGUS410(FM)        |
| H6              | LSSU125(FM)        |
| NOTE:           |                    |
| TM              | TOP MOUNT HANGERS  |
| FM              | FACE MOUNT HANGERS |

| RIMBOARD                       |  |
|--------------------------------|--|
| 1- 1/8" X 11 7/8" O.S.B.       |  |
| SUBFLOOR - 3/4" NAILED & GLUED |  |
| APP - AS PER PLAN              |  |
| BBO - BEAM BY OTHERS           |  |

Ceramic tile application as per O.B.C. 9.30.6

Provide 1-Joist Blocking between cantilevered joists (along bearing) and rimboard closure at ends.

1-2X6 SPF#2 Squash Block req'd on one side of each joist under interior load bearing wall. Multiple Squash Blocks are req'd under concentrated loads.

REVISION: December 18, 2017

MODEL: UNIT 4001 - EL.B  
W/OPT. 2ND FLOOR

## Second Floor Framing

Do not scale - refer to architectural plans for dimensions

11 3/8" BLOCKING  
TOTAL LENGTH 8'

JT/PL: 45147/95234

LI: 290675

Builder: Gold Park

Project: Pine Valley

Location: Vaughan

Date: November 19, 2017

Designer: NL


Sheet: 5 of 6

Alpa Roof Trusses Inc.

Maple, Ontario

Salesperson: Derek

Home Lumber

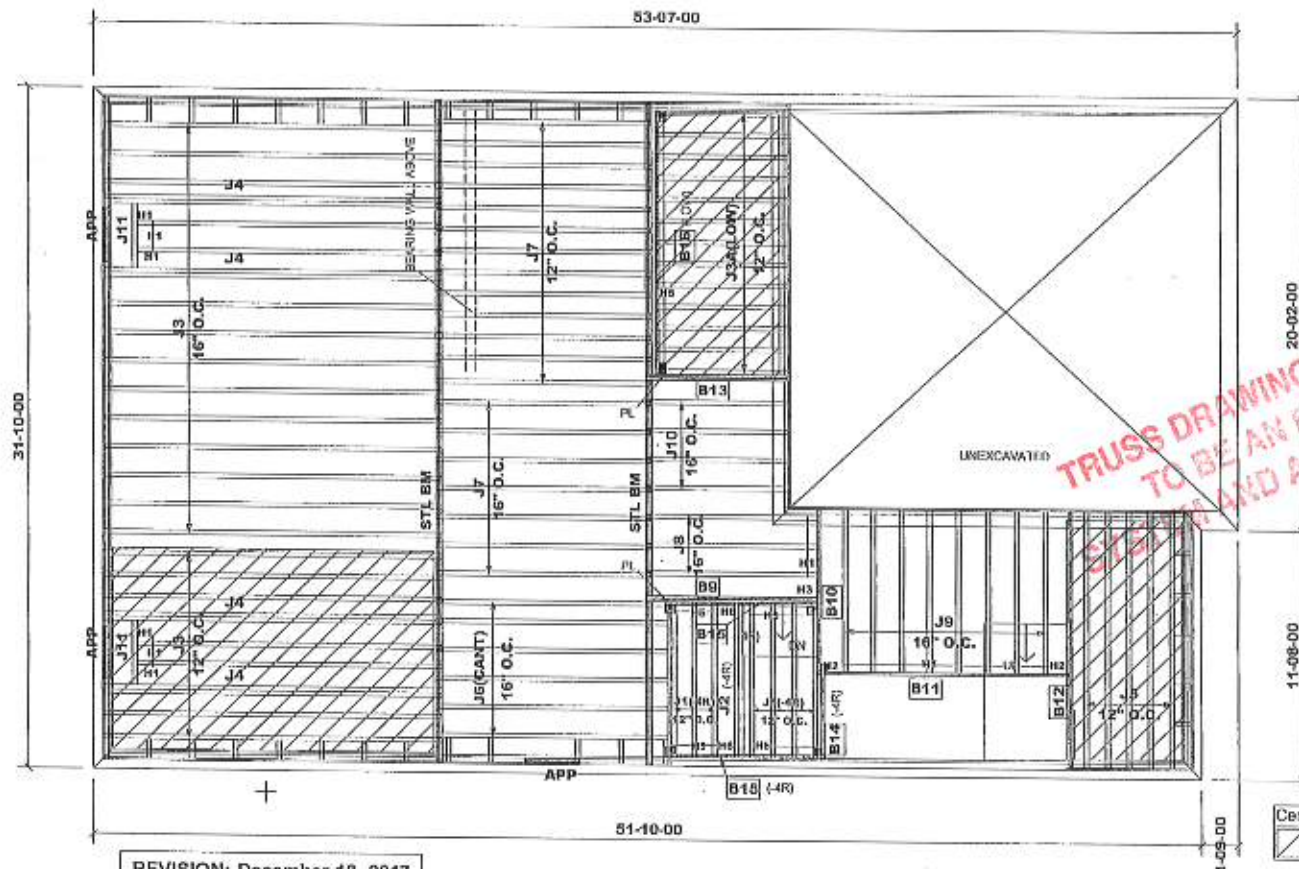

REVISION: December 18, 2017


MODEL: UNIT 4001 - EL.A+B  
W/SUNKEN

### First Floor Framing

Do not scale - refer to architectural plans for dimensions

11 TIE BLOCKING

TOTAL LENGTH: 61'

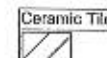

| Products |          |                  |        |         |
|----------|----------|------------------|--------|---------|
| PlotID   | Length   | Product          | Pieces | Net Qty |
| J1       | 8-00-00  | 9 1/2" NI-20     | 1      | 7       |
| J2       | 8-00-00  | 9 1/2" NI-20     | 2      | 2       |
| J3A      | 7-00-00  | 9 1/2" NI-20     | 1      | 13      |
| J3       | 16-00-00 | 11 7/8" NI-20    | 1      | 21      |
| J4       | 16-00-00 | 11 7/8" NI-20    | 2      | 8       |
| J5       | 12-00-00 | 11 7/8" NI-20    | 1      | 5       |
| J6       | 11-00-00 | 11 7/8" NI-20    | 1      | 6       |
| J7       | 10-00-00 | 11 7/8" NI-20    | 1      | 20      |
| J8       | 9-00-00  | 11 7/8" NI-20    | 1      | 3       |
| J9       | 8-00-00  | 11 7/8" NI-20    | 1      | 8       |
| J10      | 7-00-00  | 11 7/8" NI-20    | 1      | 4       |
| J11      | 3-00-00  | 11 7/8" NI-20    | 1      | 2       |
| B16      | 13-00-00 | VERSALAM-10 2.0E | 1      | 1       |
| B11      | 12-00-00 | VERSALAM-12 2.0E | 1      | 1       |
| B12      | 12-00-00 | VERSALAM-12 2.0E | 1      | 1       |
| B9       | 9-00-00  | VERSALAM-12 2.0E | 2      | 2       |
| B15      | 8-00-00  | VERSALAM-10 2.0E | 1      | 2       |
| B10      | 8-00-00  | VERSALAM-12 2.0E | 1      | 1       |
| D13      | 7-00-00  | VERSALAM-12 2.0E | 2      | 2       |
| B14      | 5-00-00  | VERSALAM-10 2.0E | 1      | 1       |

#### HANGER SCHEDULE

H1.....LT251108 (1M)  
H2.....HUS1.B1/10(FM)  
H3.....LT250(TM)  
H6.....MIT39.5-2(TM)

#### NOTE:

TM.....TOP MOUNT HANGERS  
FM.....FACE MOUNT HANGERS

#### RIMBOARD

1- 1/8" X 9 1/2" O.S.B.  
1- 1/8" X 11 7/8" O.S.B.

SUBFLOOR - 3/4" NAILED & GLUED

APP - AS PER PLAN  
BDO - BEAM BY OTHERS

Ceramic tile application as per O.B.C. 9.30.6

Provide I-Joist Blocking between cantilevered joists (along bearing) and rimboard closure at ends.

1-2X6 SPF#2 Squash Block req'd on one side of each joist under interior load bearing wall. Multiple Squash Blocks are req'd under concentrated loads.

JT/PL: 45147/95234

LI: 290675

Builder: Gold Park

Project: Pine Valley

Location: Vaughan

Date: November 17, 2017

Designer: NL

Sheet: 6 of 6

Alpa Roof Trusses Inc.

Maple, Ontario

Salesperson: Derek

Home Lumber



## Maximum Floor Spans

Live Load = 40 psf, Dead Load = 15 psf  
Simple Spans, L/360 Deflection Limit  
3/4" OSB G&N Sheathing

| Depth   | Series | Bare    |         |         |         |  | 1/2" Gypsum Ceiling |         |         |         |  |
|---------|--------|---------|---------|---------|---------|--|---------------------|---------|---------|---------|--|
|         |        | 12"     | 16"     | 19.2"   | 24"     |  | 12"                 | 16"     | 19.2"   | 24"     |  |
| 9-1/2"  | NI-20  | 15'-10" | 15'-0"  | 14'-5"  | 13'-5"  |  | 16'-4"              | 15'-5"  | 14'-6"  | 13'-5"  |  |
|         | NI-40x | 17'-0"  | 16'-0"  | 15'-5"  | 14'-9"  |  | 17'-5"              | 16'-5"  | 15'-10" | 15'-2"  |  |
|         | NI-60  | 17'-2"  | 16'-2"  | 15'-7"  | 14'-11" |  | 17'-6"              | 16'-7"  | 15'-11" | 15'-3"  |  |
|         | NI-70  | 18'-0"  | 16'-11" | 16'-3"  | 15'-7"  |  | 18'-5"              | 17'-3"  | 16'-9"  | 15'-11" |  |
|         | NI-80x | 18'-3"  | 17'-1"  | 16'-5"  | 15'-9"  |  | 18'-8"              | 17'-5"  | 16'-9"  | 15'-1"  |  |
| 11-7/8" | NI-20  | 17'-10" | 16'-10" | 16'-2"  | 15'-6"  |  | 18'-6"              | 17'-4"  | 16'-9"  | 15'-1"  |  |
|         | NI-40x | 19'-4"  | 17'-11" | 17'-3"  | 16'-6"  |  | 19'-11"             | 18'-6"  | 17'-9"  | 17'-0"  |  |
|         | NI-60  | 19'-7"  | 18'-2"  | 17'-5"  | 16'-9"  |  | 20'-2"              | 18'-9"  | 17'-12" | 17'-2"  |  |
|         | NI-70  | 20'-9"  | 19'-2"  | 18'-3"  | 17'-5"  |  | 21'-4"              | 19'-9"  | 18'-10" | 17'-10" |  |
|         | NI-80  | 21'-1"  | 19'-5"  | 18'-6"  | 17'-7"  |  | 21'-7"              | 20'-0"  | 19'-10" | 18'-0"  |  |
| 14"     | NI-90x | 21'-8"  | 20'-0"  | 19'-1"  | 18'-0"  |  | 22'-2"              | 20'-6"  | 19'-6"  | 18'-5"  |  |
|         | NI-40x | 21'-5"  | 19'-10" | 18'-11" | 17'-11" |  | 22'-1"              | 20'-6"  | 19'-7"  | 18'-7"  |  |
|         | NI-60  | 21'-10" | 20'-2"  | 19'-3"  | 18'-2"  |  | 22'-5"              | 20'-10" | 19'-11" | 18'-10" |  |
|         | NI-70  | 23'-0"  | 21'-3"  | 20'-3"  | 19'-2"  |  | 23'-8"              | 21'-11" | 20'-10" | 19'-9"  |  |
|         | NI-80  | 23'-5"  | 21'-7"  | 20'-7"  | 19'-5"  |  | 24'-0"              | 22'-3"  | 21'-2"  | 20'-0"  |  |
| 16"     | NI-90x | 24'-1"  | 22'-3"  | 21'-2"  | 20'-0"  |  | 24'-8"              | 22'-10" | 21'-9"  | 20'-7"  |  |
|         | NI-60  | 23'-9"  | 22'-0"  | 20'-11" | 19'-10" |  | 24'-6"              | 22'-9"  | 21'-8"  | 20'-6"  |  |
|         | NI-70  | 25'-1"  | 23'-2"  | 22'-0"  | 20'-10" |  | 25'-9"              | 23'-10" | 22'-9"  | 21'-6"  |  |
|         | NI-80  | 25'-6"  | 23'-6"  | 22'-4"  | 21'-2"  |  | 26'-1"              | 24'-2"  | 23'-1"  | 21'-10" |  |
|         | NI-90x | 26'-4"  | 24'-3"  | 23'-1"  | 21'-10" |  | 26'-11"             | 24'-11" | 23'-8"  | 22'-5"  |  |

| Depth   | Series | Mid-Span Blocking |         |         |         |  | Mid-Span Blocking and 1/2" Gypsum Ceiling |         |         |        |  |
|---------|--------|-------------------|---------|---------|---------|--|-------------------------------------------|---------|---------|--------|--|
|         |        | 12"               | 16"     | 19.2"   | 24"     |  | 12"                                       | 16"     | 19.2"   | 24"    |  |
| 9-1/2"  | NI-20  | 17'-1"            | 15'-5"  | 14'-6"  | 13'-5"  |  | 17'-1"                                    | 15'-5"  | 14'-6"  | 13'-5" |  |
|         | NI-40x | 18'-8"            | 17'-6"  | 16'-7"  | 15'-3"  |  | 19'-2"                                    | 17'-8"  | 16'-7"  | 15'-3" |  |
|         | NI-60  | 18'-11"           | 17'-8"  | 16'-10" | 15'-7"  |  | 19'-4"                                    | 18'-0"  | 16'-10" | 15'-7" |  |
|         | NI-70  | 20'-0"            | 18'-7"  | 17'-9"  | 17'-0"  |  | 20'-5"                                    | 19'-0"  | 18'-2"  | 17'-0" |  |
|         | NI-80  | 20'-3"            | 18'-10" | 17'-11" | 17'-2"  |  | 20'-8"                                    | 19'-3"  | 18'-4"  | 17'-5" |  |
| 11-7/8" | NI-20  | 20'-2"            | 18'-8"  | 17'-6"  | 16'-2"  |  | 20'-7"                                    | 18'-8"  | 17'-6"  | 16'-2" |  |
|         | NI-40x | 22'-1"            | 20'-4"  | 19'-5"  | 18'-7"  |  | 22'-5"                                    | 20'-11" | 19'-9"  | 17'-8" |  |
|         | NI-60  | 23'-4"            | 21'-8"  | 20'-8"  | 19'-7"  |  | 23'-10"                                   | 21'-2"  | 20'-3"  | 18'-8" |  |
|         | NI-70  | 23'-7"            | 21'-11" | 20'-11" | 19'-9"  |  | 24'-1"                                    | 22'-6"  | 21'-5"  | 20'-4" |  |
|         | NI-80x | 24'-3"            | 22'-6"  | 21'-5"  | 20'-4"  |  | 24'-8"                                    | 23'-0"  | 22'-0"  | 20'-9" |  |
| 14"     | NI-40x | 24'-5"            | 22'-9"  | 21'-8"  | 20'-10" |  | 25'-1"                                    | 23'-6"  | 22'-9"  | 21'-4" |  |
|         | NI-60  | 24'-10"           | 23'-1"  | 22'-0"  | 21'-10" |  | 25'-6"                                    | 23'-10" | 22'-9"  | 21'-4" |  |
|         | NI-70  | 26'-1"            | 24'-3"  | 23'-2"  | 21'-10" |  | 26'-8"                                    | 24'-11" | 23'-9"  | 22'-6" |  |
|         | NI-80  | 26'-6"            | 24'-7"  | 23'-5"  | 22'-2"  |  | 27'-1"                                    | 25'-3"  | 24'-1"  | 23'-9" |  |
|         | NI-90x | 27'-3"            | 25'-4"  | 24'-1"  | 22'-9"  |  | 27'-9"                                    | 25'-11" | 24'-8"  | 23'-4" |  |
| 16"     | NI-60  | 27'-3"            | 25'-5"  | 24'-2"  | 22'-10" |  | 28'-0"                                    | 26'-2"  | 25'-0"  | 23'-8" |  |
|         | NI-70  | 28'-8"            | 26'-8"  | 25'-4"  | 23'-11" |  | 29'-3"                                    | 27'-4"  | 26'-1"  | 24'-8" |  |
|         | NI-80  | 29'-1"            | 27'-0"  | 25'-9"  | 24'-4"  |  | 29'-8"                                    | 27'-5"  | 26'-5"  | 25'-0" |  |
|         | NI-90x | 29'-11"           | 27'-10" | 26'-5"  | 25'-0"  |  | 30'-5"                                    | 28'-5"  | 27'-2"  | 25'-8" |  |

1. Maximum clear span applicable to simple-span residential floor construction with a design live load of 40 psf and dead load of 15 psf. The ultimate limit states are based on the factored loads of 1.50L + 1.25D. The serviceability limit states include the consideration for floor vibration, a live load deflection limit of L/360 and a total load deflection limit of L/240.

2. Spans are based on a composite floor with glued-nailed oriented strand board (OSB) sheathing with a minimum thickness of 3/4 inch for a joist spacing of 24 inches or less. The composite floor may include 1/2 inch gypsum ceiling and/or one row of blocking at mid-span with strapping.

3. Minimum bearing length shall be 1-3/4 inches for the end bearings.

4. Bearing stiffeners are not required when joists are used with the spans and spacings given in this table, except as required for hangers.

5. This span chart is based on uniform loads. For applications with other than uniformly distributed loads, an engineering analysis may be required based on the use of the design properties. Tables are based on Limit States Design per CSA C86-09, NBC 2010, and CBC 2012.

6. Joists shall be laterally supported at supports and continuously along the compression edge. Refer to technical documentation for installation guidelines and construction details. Nordic Joists are listed in CCWC evaluation report 13032-R and APA Product Report PR-1274C.



Refer to the Installation Guide for Residential Floors for additional information.  
CMC EVALUATION REPORT 13032-R



## WEB HOLE SPECIFICATIONS

**JOISTS FOR CUTTING HOLES AND DUCT CHASE OPENINGS:**

The distance between the inside edge of the support and the centerline of any hole or duct chase opening shall be in compliance with the requirements of Table 1 or 2, respectively.

1-joint top and bottom flanges must NEVER be cut, notched, or otherwise modified.

Whenever possible, field-cut holes should be centered on the middle of the web.

The maximum size hole or the maximum depth of a duct chase opening that can be cut into an I-joint web shall equal the clear distance between the flanges of the I-joint minus 1/4 inch. A minimum of 1/8 inch should always be maintained between the top or bottom of the hole or opening and the adjacent I-joint flange.

5. The sides of square holes or longest sides of rectangular holes should not exceed 3/4 of the diameter or the maximum round hole permitted at that location.

6. Where more than one hole is necessary, the distance between adjacent hole edges shall exceed twice the diameter of the largest round hole or twice the size of the largest square hole (or twice the length of the longest side of the largest rectangular hole or duct chase opening) and each hole and duct chase opening shall be sized and located in compliance with the requirements of Tables 1 and 2, respectively.

7. A knockout is not considered a hole, may be utilized anywhere it occurs, and may be ignored for purposes of calculating minimum distances between holes and/or duct chase openings.

8. Holes measuring 1-1/2 inches or smaller are permitted anywhere in a cantilevered section of a joist. Holes of greater size may be permitted subject to verification.

9. A 1-1/2 inch hole or smaller can be placed anywhere in the web provided that it meets the requirements of rule number 8 also.

10. All holes and duct chase openings shall be cut in a workmanlike manner in accordance with the regulations listed above and as illustrated in Figure 7.

11. Limit three maximum size holes per span, of which one may be a duct chase opening.

12. A group of round holes or approximately the same location shall be permitted if they meet the requirements for a single round hole circumscribed around them.

TABLE 1

## LOCATION OF CIRCULAR HOLES IN JOIST WEBS

Simple or Multiple Span for Dead Loads up to 15 psf and Live Loads up to 40 psf

| Joist Depth | Joist Series | Minimum Distance from Inside Face of Any Support to Centre of Hole (ft. - in.) |       |       |      |       |       |       |       |       |       |       |         |
|-------------|--------------|--------------------------------------------------------------------------------|-------|-------|------|-------|-------|-------|-------|-------|-------|-------|---------|
|             |              | 2                                                                              | 3     | 4     | 5    | 6     | 6-1/4 | 7     | 8     | 8-5/8 | 9     | 10    | 10-3/4  |
| 1-1/2"      | NL-20        | 0-7"                                                                           | 1-3"  | 2-10" | 4-3" | 5-8"  | 6-0"  | ---   | ---   | ---   | ---   | ---   | 12-3/4" |
|             | NL-40s       | 1-3"                                                                           | 2-6"  | 4-0"  | 5-4" | 7-0"  | 7-5"  | ---   | ---   | ---   | ---   | ---   | ---     |
|             | NL-60        | 2-3"                                                                           | 3-6"  | 4-9"  | 6-3" | 8-0"  | 8-4"  | ---   | ---   | ---   | ---   | ---   | ---     |
|             | NL-80        | 2-3"                                                                           | 3-6"  | 5-0"  | 6-6" | 8-2"  | 8-8"  | ---   | ---   | ---   | ---   | ---   | ---     |
|             | NL-90s       | 0-7"                                                                           | 0-8"  | 1-3"  | 2-8" | 4-0"  | 4-4"  | 5-0"  | 6-6"  | 7-1"  | ---   | ---   | ---     |
| 11-7/8"     | NL-40s       | 0-7"                                                                           | 1-3"  | 2-8"  | 4-0" | 5-4"  | 6-0"  | 7-0"  | 8-10" | 10-0" | ---   | ---   | ---     |
|             | NL-60        | 1-3"                                                                           | 2-6"  | 4-0"  | 5-4" | 6-6"  | 7-0"  | 8-10" | 10-0" | 11-2" | ---   | ---   | ---     |
|             | NL-80        | 1-6"                                                                           | 2-10" | 4-2"  | 5-6" | 7-0"  | 7-5"  | 8-10" | 10-3" | 11-4" | ---   | ---   | ---     |
|             | NL-90        | 0-7"                                                                           | 1-5"  | 3-2"  | 4-2" | 5-4"  | 6-6"  | 8-1"  | 10-2" | ---   | ---   | ---   | ---     |
|             | NL-90s       | 0-7"                                                                           | 0-8"  | 0-8"  | 2-5" | 4-4"  | 4-9"  | 6-3"  | ---   | ---   | ---   | ---   | ---     |
| 14"         | NL-40s       | 0-7"                                                                           | 0-8"  | 1-3"  | 2-4" | 3-9"  | 4-3"  | 5-3"  | 6-3"  | 8-3"  | 10-2" | ---   | ---     |
|             | NL-60        | 0-7"                                                                           | 0-8"  | 1-3"  | 3-0" | 4-3"  | 4-8"  | 5-8"  | 7-3"  | 8-3"  | 9-3"  | 10-4" | 11-9"   |
|             | NL-80        | 0-7"                                                                           | 1-0"  | 2-0"  | 3-0" | 4-3"  | 4-9"  | 6-3"  | 7-3"  | 8-3"  | 9-3"  | 10-4" | 13-3"   |
|             | NL-90        | 0-7"                                                                           | 0-8"  | 0-8"  | 2-5" | 4-0"  | 4-5"  | 5-5"  | 7-5"  | 8-5"  | 9-5"  | 10-5" | 13-5"   |
|             | NL-90s       | 0-7"                                                                           | 0-8"  | 0-8"  | 2-5" | 4-0"  | 4-5"  | 5-5"  | 7-5"  | 8-5"  | 9-5"  | 10-5" | 13-5"   |
| 16"         | NL-40        | 0-7"                                                                           | 0-8"  | 1-3"  | 2-8" | 4-2"  | 4-7"  | 5-7"  | 6-7"  | 8-7"  | 10-7" | 12-7" | 13-9"   |
|             | NL-60        | 0-7"                                                                           | 1-0"  | 2-3"  | 3-6" | 4-10" | 5-3"  | 6-3"  | 7-3"  | 8-3"  | 9-3"  | 10-3" | 13-9"   |
|             | NL-80        | 0-7"                                                                           | 1-3"  | 2-6"  | 4-0" | 5-4"  | 6-3"  | 7-3"  | 8-3"  | 9-3"  | 10-3" | 11-3" | 14-0"   |
|             | NL-90        | 0-7"                                                                           | 0-8"  | 0-8"  | 2-5" | 4-0"  | 4-5"  | 5-5"  | 7-5"  | 8-5"  | 9-5"  | 10-5" | 13-9"   |
|             | NL-90s       | 0-7"                                                                           | 0-8"  | 0-8"  | 2-5" | 4-0"  | 4-5"  | 5-5"  | 7-5"  | 8-5"  | 9-5"  | 10-5" | 13-9"   |


Above table may be used for I-joint spacing of 24 inches on center or less.

Hole location distance is measured from inside face of supports to center of hole.

Distances in this chart are based on uniformly loaded joists.

The above table is based on the I-joints being used at their maximum spans. The minimum distance as given above may be reduced for shorter spans, contact your local distributor.

## FIELD-CUT HOLE LOCATOR

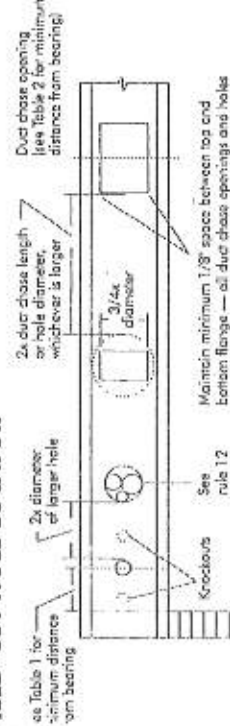

## SAFETY AND CONSTRUCTION PRECAUTIONS

**WARNING:** I-joints are not stable until completely installed, and will not carry any load until fully braced and sheathed.

**AVOID ACCIDENTS BY FOLLOWING THESE IMPORTANT GUIDELINES:**

1. Brace and nail each I-joint as it is installed, using hangers, blocking, panels, rim board, and/or cross-bracing at joist ends. When I-joints are applied continuously over interior supports and a load-bearing wall is planned at that location, blocking will be required at the interior support.
2. When the building is completed, the floor sheathing will provide lateral support for the top flanges of the I-joints. Until this sheathing is applied, temporary bracing, often called struts, or temporary sheathing must be applied to prevent I-joint rollover or buckling.
  - Temporary bracing or struts must be 1x4 inch minimum, at least 8 feet long and spaced no more than 8 feet on center, and must be secured with a minimum of two 2-1/2 inch nails fastened to the top surface of each joist. Nail the bracing to a lateral resist of the end of each box, lap ends of adjoining bracing over at least two I-joints.
  - On sheathing (temporary or permanent) can be nailed to the top flange of the first I-joint at the end of the bay.
3. For cantilevered I-joints, brace top and bottom flanges, and brace ends with dense panels, rim board, or cross-bracing.
4. Install and fully nail permanent sheathing to each I-joint before placing loads on the floor system. Then, stack building materials over damaged or weak joists.
5. Never install or damage I-joints.

Never stack building materials over unbraced I-joints. Once sheathed, do not over-stress I-joints with concentrated loads from building materials.



TABLE 2

## DUCT CHASE OPENING SIZES AND LOCATIONS

Simple Span Only

| Joist Depth | Joist Series | Minimum Distance from Inside Face of Supports to Centre of Opening (ft. - in.) |       |       |       |       |       |       |       |       |       |       |       |
|-------------|--------------|--------------------------------------------------------------------------------|-------|-------|-------|-------|-------|-------|-------|-------|-------|-------|-------|
|             |              | 8                                                                              | 10    | 12    | 14    | 16    | 18    | 20    | 22    | 24    | 26    | 28    | 30    |

1. Above table may be used for I-joint spacing of 24 inches on center or less.

2. Duct chase opening location distance is measured from inside face of supports to centre of opening.

3. The above table is based on simple-span joists only. For other applications, contact your local distributor.

4. Distances are based on uniformly loaded floor joists that meet the span requirements for a design load of 40 psf and dead load of 15 psf, and a live load deflection limit of L/160.

5. The above table is based on the I-joints being used at their maximum spans. The minimum distance given above may be reduced for shorter spans, contact your local distributor.



Knockouts are pre-cored holes provided for the contractor's convenience to install electrical or small plumbing lines. They are 1-1/2 inches in diameter, and are spaced 15 inches on center along the length of the I-joint. Where possible, it is preferable to use knockouts instead of field-cut holes.

Never drill, cut or notch the flange, or over-cut the web.

Holes in webs should be cut with a sharp saw.

For rectangular holes, avoid over-cutting the corners, as this can cause unnecessary stress concentrations. Slightly rounding the corners is recommended. Starting the rectangular hole by drilling a 1-inch diameter hole in each of the four corners and then making the cut between the holes is another good method to minimize damage to the I-joint.



## PRODUCT WARRANTY

Charniers Changemen warrants that, in accordance with our specifications, Nordic products are free from manufacturing defects in material and workmanship.

Furthermore, Charniers Changemen warrants that our products, when installed in accordance with our handling and installation instructions, will meet or exceed our specifications for the lifetime of the structure.



2-1 JOIST CANTILEVER DETAIL FOR BALCONIES (N+ WALL LOAD)


**CAUTION:** Carveers formed this way must be carefully checked to prevent moisture intrusion into the structure and potential decay of untreated floor joist members.



to prevent moisture  
infiltration into the structure  
and potential decay of  
untreated floor joists.


- 2x8 mt. Nail in buckle length and one with 2 rows of 3 nails at 6" o.c. and drift.
- 5x6 depth block with 1/8" gap between block and top flange of I-beam.
- 5x6 depth block with 2 rows of 3 nails at 6" o.c. and drift.
- Block holder to allow for all space provided to

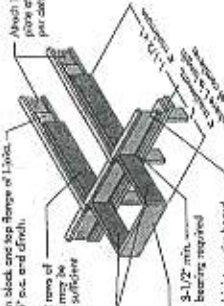


**Note:** This detail is applicable to cantilevers supporting a minimum specified uniform live load of 60 psf.

## Method 1 — Sheathing Reinforcement One Side

 


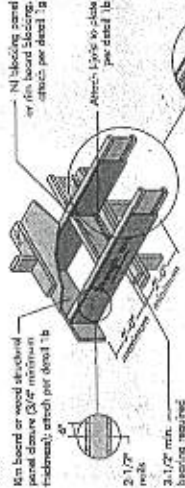

Method 7 — SHEATHING REINFORCEMENT TWO SIDES

- Use same installation as Method 1 but reinforce both sides of joist with sheathing.
- Use nailing pattern shown for Method 1 w/1" opposite face nailed other 2".

Note: Curvature surfaced plywood sheathing or equivalent (minimum thickness 3/8") required on sides of joist. Depth should match the full height of the joist. Nail with 2-1/2" nails at 6" o.c., top and bottom flanges. Install wide flat grain horizontal. Attach 1-1/2" to piece on all exposures.

④ American Method 2 — DOUBLE JOIST  
— No blocking band or rim board

**Fine board, or wood at eaves**, set at right angles to principal course  
**(2x6 minimum)**

**Interval; attach per detail 1b**

**Attach if possible**

**From main two rows of 2" wide x 10' o.e. end into finish row**  
**light web and tie block**  
**to floor joists. Offset nailing as per Lloyd web. Offset nailing from opposite face by 8"**

**blowing, attach per detail 1c**



required, maximum  
two nails per foot  
required if  
attached


Attachment  
Attachment

Attachment 1-1/2" x 3/4"  
to top plate of  
all supports per  
code

Block splices together with the blocks for the full length of the reinforcement. For joint lengths greater than 3 inches place an additional row of 2 bars along the full length of the reinforcement and lap each bar. Check when needed.

0

50) SHEATHING KING-PURCHEN

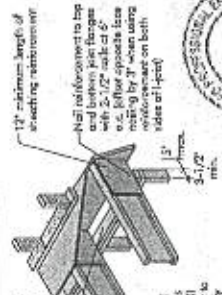


Note: Canadian softwood plywood sheathing or equivalent (minimum thickness 3/4") required on sides of joist. Depth shall match the full height of the joist. Nail with 2-1/2" nails at 6" o.c. top and bottom flange. Joist with type grain horizontal. Attach joist plate or all supports per detail 1b. We-

SEAT-BACK DETAIL

El: board or wood structural panel; closure [3/4" minimum thickness, except per cat] 1a.


- Provide full depth bonding between joists only support (not shown for clarity)
- Attach joists to plate at all supports per detail 1b.
- 3/4" minimum joist bearing required.

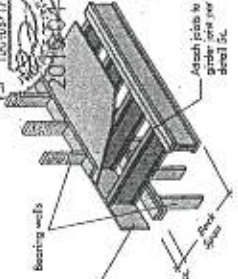

SEI AND CONNECTION

Vertical solid brown blades  
2nd 5-10" (No. 2 or better) nailed  
through joint web and web of girder  
using 2-1/2" nails.  
Blade ends 5" from outside edge.

- Notes:
- Verify gender joint capacity in the book.
  - exceeds the joint spacing.
  - About 4000 lb/ft<sup>2</sup> not shown in book.

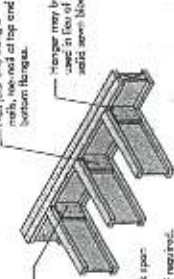

## FIGURE 4 (continued)

See table below for NE requirements of reinforced masonry.

[illegible]

1. 1) = No reinforcement required.
- 2 = 14' rebar with 3/4" wire placed on one side only.
- 3 = 14' reinforced with 2" wood placed on both sides, or double.
- 4 = 2" x 4" deeper joint or closer spacing.



## FIGURE 5 (continued)

See table below for NE reinforcements of requirements of contractor.

[illegible]

1. N = No influence required.
- 2 = M reinforced with 3/8" wire panel on one side only
- 3 = M reinforced with 3/8" wire panel on both sides, or one side by a rimmer joint or closer to it

2. Minimum design load shall be 700 lb./sq. ft. floor installation over load. Wall tie-in limited on wall load. Wall tie-in limited on minimum depth, whether clear









# INSTALLATION GUIDE FOR RESIDENTIAL FLOORS

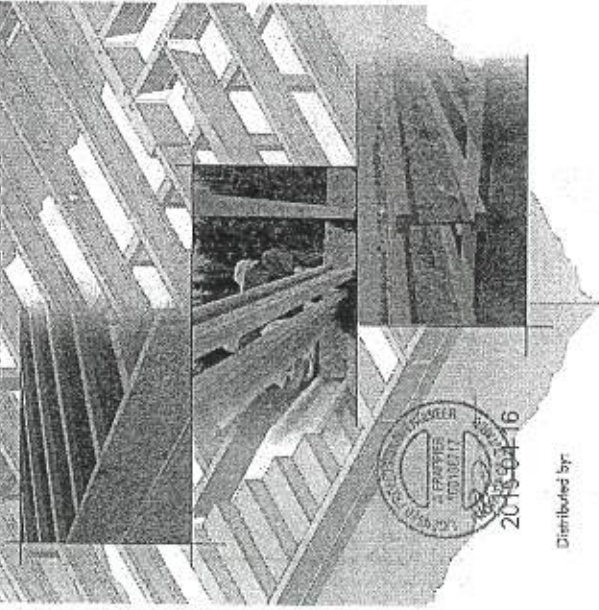

Distributed by:



## SAFETY AND CONSTRUCTION PRECAUTIONS



Do not walk on joists until fully fastened and braced, or serious injury can occur.



Never pick building materials up with one-handed joists. Once attached, do not over-stress joist with concentrated loads from blocking materials.


**WARNING**  
Joists are not stable until completely installed, and will not carry any load until fully braced and sheathed.

Avoid Accidents by Following these Important Guidelines:

1. Space and nail each joist as it is installed, using hangers, blocking panels, rim board, and/or cross-bracing to join ends. When joists are applied continuously over interior supports and a load-bearing wall, it is allowed at their location.
2. When the building is completed, the floor sheathing will provide lateral support for the top flange of the Joists. Until this sheathing is applied, temporary blocking, chain chokers, or temporary bracing must be applied to prevent lateral movement or buckling.
- Temporary bracing or chokers must be used for each end support, or least 8 feet long from the end of the joist. Temporary bracing must be applied to the top surface of the joist, and the blocking must be applied to the bottom of the joist. A minimum of two 2x12s must be used to brace the top surface of each joist. And the blocking must be applied to the bottom of each joist. Lay ends of blocking bracing over at least two joists.
- Or, sheathing (temporary or permanent) can be nailed to the top flange of the first 4 feet of joists at the end of the bay.
3. For continuous joists, brace top and bottom flanges, and install ends with chain chokers, rim board, or cross-bracing.
4. Install and fully nail permanent blocking to each joist before placing loads on the floor system. Then, install blocking materials over beams or walls only.
5. Never install a damaged joist.

Temporary storage or installation, failure to follow applicable building codes, failure to follow span ratings for Nordic Joists, failure to follow allowable hole size and locations, or failure to use web stiffeners when required can result in serious accidents. Follow these installation guidelines carefully.

## STORAGE AND HANDLING GUIDELINES

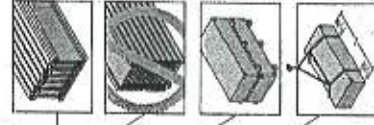


1. Bundle wrap can be slippery when wet. Avoid walking on wrapped bundles.
2. Store, stack, and handle joists vertically and load only.
3. Always stack and handle joists in the upright position only.
4. Do not store joists in direct contact with the ground or/for fences.
5. Protect joists from weather, and use spacers to separate bundles.
6. Bundled ends should be kept away from time of installation.
7. When handling joists with a crane or the job site, take a few simple precautions to prevent damage to the joists and injury to your work crew.
  - Pick joists in bundles as shipped by the supplier.
  - Orient the bundles so that the webs of the joists are vertical.
  - Pick the bundles at the 5th point, using a spreader bar if necessary.
8. Do not handle joists in a horizontal orientation.
9. NEVER USE OR TRY TO REPAIR A DAMAGED JOIST.

## INSTALLING NORDIC JOISTS


1. Before laying out floor system components, verify that joist flange widths match tongue widths. If not, contact your supplier.
2. Account for cutting to length. Joist flanges should never be cut, drilled, or modified.
3. Install joists to rest top and bottom flanges are within 1/2 inch of true vertical alignment.
4. Joists must be anchored securely to supports before floor sheathing is attached, and supports must be level.
5. Minimum bearing lengths: 1.36 inches for end bearing and 3.12 inches for intermediate bearing.
6. When using hangers, use joists firmly to tongue bottoms to minimize settlement.
7. Leave a 1/8-inch gap between the joist and end of a header.
8. Concentrated loads greater than those that can normally be sustained in residential construction should only be applied to the top surface of the top flange. Normal concentrated loads include track lighting fixtures, audio equipment and security cameras. Never support masonry or heavy loads from the joist's bottom flange. Whenever possible, suspend all loads from the top of the joist. On critical loads, blocking must be installed between the joists and the load.
9. Never install joists where they will be permanently exposed to weather, or where they will remain in direct contact with concrete or masonry.
10. Support ends of floor joists to prevent rafter. Use rim board, rim joist or joist blocking panels.
11. For joists installed over and between bearing walls, use full depth blocking panels, rim board, or sheath blocks to provide lateral support to the joists through the floor system to the wall or foundation below.
12. Due to twisting, common framing lumber and an edge may never be used as blocking or rim board. Joist blocking panels or other engineered wood products—such as rim board—must be cut to fit between the joists, and on 1-pitch-compatible decks selected.
13. Provide permanent lateral support of the bottom flange of all joists at interior supports of multiple span joists. Joists support the bottom flange of all continuous joists at the end support and use two joists in between. In the moment-resisting or moment-resisting system, blocking is not required under structural floor framing, such as second floor framing, or a response bracing or truss must be used.
14. If square-edge joists are used, edges must be supported between joists with full blocking. Close joints to blocking to maintain sheath. Blocking is not required under structural floor framing, such as second floor framing, or a response bracing or truss must be used.
15. Nail blocking. Joist ends must be nailed to the flange's top face in accordance with the applicable building code requirements or approved building plans.



FIGURE 1  
TYPICAL NORDIC JOIST FLOOR FRAMING AND CONSTRUCTION DETAILS

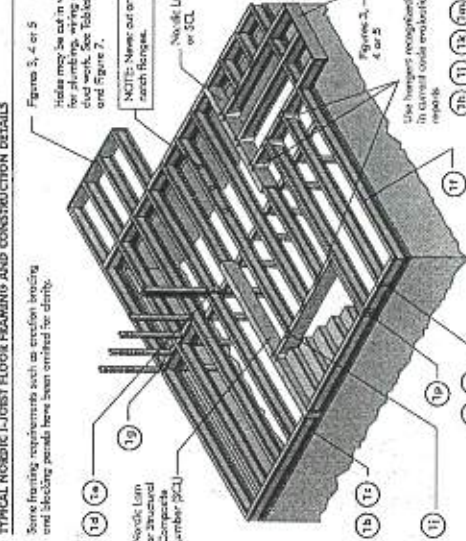


All walls shown in the above details are assumed to be continuous with walls unless otherwise noted. If (3.12) inch wide joists are used, the blocking must be 1.17 inch wide. Blocking lumber assumed to be Species-Flow No. 2 or better. Individual components are shown to scale for clarity.

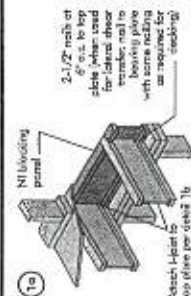

| Blocking Panel or Rim Joist | Maximum Fastener Uniform Vertical Spacing (in) |
|-----------------------------|------------------------------------------------|
| 1x12                        | 3.000                                          |

The uniform vertical fastener is limited to a face depth of 1/8 inch or less and is based on approved term load duration. It shall not be used for blocking or sheathing. For concentrated vertical load transfer, see detail 1d.

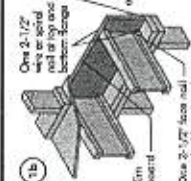


| Blocking Panel or Rim Joist | Maximum Fastener Uniform Vertical Spacing (in) |
|-----------------------------|------------------------------------------------|
| 2x12                        | 2.000                                          |

The uniform vertical fastener is limited to a face depth of 1/8 inch or less and is based on approved term load duration. It shall not be used for blocking or sheathing. For concentrated vertical load transfer, see detail 1d.



| Attachment of Rim Joist to Floor Joist   | Minimum Bearing Length (in)         |
|---|-------------------------------------|
| Attach rim joist to floor joist with one nail at top and bottom. Nail must provide 1 inch minimum penetration into floor joist. (See note: may be used.) | Minimum 1.242 inch bearing required |

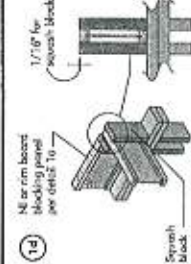

| Attachment of Blocking Panel to Joist   | Maximum Fastener Uniform Vertical Spacing (in) |
|---|------------------------------------------------|
| Attach blocking panel to joist with one nail at top and bottom. Nail must provide 1 inch minimum penetration into joist. (See note: may be used.) | Maximum 2.000 inch bearing required            |





Boise Cascade

## Double 1-3/4" x 11-7/8" VERSA-LAM® 2.0 3100 SP

Floor Beam\B01

## BC CALC® Design Report



Dry | 1 span | No cantilevers | 0/12 slope (deg)

November 19, 2017 08:23:44

Build 6080

Job Name: 45147 (4001)

Address: Pine Valley

City, Province, Postal Code: Vaughan, ON

Customer: Gold Park

Code reports: CCMC 12472-R

File Name: 290675.bcc


Description: Second Floor Framing

Specifier:

Designer: NL

Company: Alpa Roof Trusses

Misc:

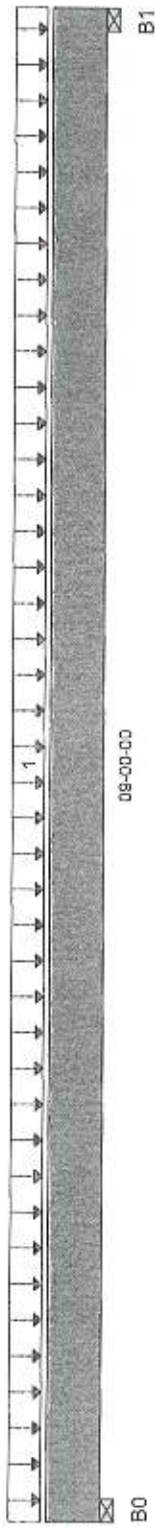

Total Horizontal Product Length = 09-00-00

## Reaction Summary (Down / Uplift) (lbs)

| Bearing    | Live      | Dead      | Snow | Wind |
|------------|-----------|-----------|------|------|
| B0, 3-1/2" | 2,370 / 0 | 1,239 / 0 |      |      |
| B1, 3-1/2" | 2,370 / 0 | 1,239 / 0 |      |      |

## Load Summary

| Tag Description | Load Type                       | Ref. | Start    | End      | Live | Dead | Snow | Wind      | Trib.    |
|-----------------|---------------------------------|------|----------|----------|------|------|------|-----------|----------|
| 1               | Unf. Area (lb/ft <sup>2</sup> ) | L    | 00-00-00 | 09-00-00 | 40   | 20   |      | 1.00 1.15 | 13-02-00 |

## Controls Summary

|                  | Factored Demand | Factored Resistance | Demand / Resistance | Load Case | Location |
|------------------|-----------------|---------------------|---------------------|-----------|----------|
| Pos. Moment      | 10,344 ft-lbs   | 35,392 ft-lbs       | 29.2%               | 1         | 04-06-00 |
| End Shear        | 3,651 lbs       | 14,464 lbs          | 25.2%               | 1         | 01-03-06 |
| Total Load Defl. | L/999 (0.098")  | n/a                 | n/a                 | 4         | 04-06-00 |
| Live Load Defl.  | L/999 (0.065")  | n/a                 | n/a                 | 5         | 04-06-00 |
| Max Defl.        | 0.098"          | n/a                 | n/a                 | 4         | 04-06-00 |
| Span / Depth     | 8.6             | n/a                 | n/a                 |           | 00-00-00 |
| Squash Blocks    | Valid           |                     |                     |           |          |

## Bearing Supports

|               | Dim. (L x W)    | Demand    | Demand / Resistance Support | Demand / Resistance Member | Material        |
|---------------|-----------------|-----------|-----------------------------|----------------------------|-----------------|
| B0 Wall/Plate | 3-1/2" x 3-1/2" | 5,104 lbs | 67.7%                       | 34.2%                      | Spruce Pine Fir |
| B1 Wall/Plate | 3-1/2" x 3-1/2" | 5,104 lbs | 67.7%                       | 34.2%                      | Spruce Pine Fir |

## Notes

Design meets Code minimum (L/240) Total load deflection criteria.

Design meets Code minimum (L/360) Live load deflection criteria.

Design meets User specified (1") Maximum Total load deflection criteria.

Calculations assume member is fully braced.

Resistance Factor phi has been applied to all presented results per CSA O86.

BC CALC® analysis is based on Canadian Limit States Design, as per NBCC 2010 and CSA O86.

Design based on Dry Service Condition.

Importance Factor : Normal Part code : Part 4

Nail one ply to another with  
 3 1/2" spiral nails @ 12"  
 o.c. staggered in 2 rows





Boise Cascade

## Single 1-3/4" x 11-7/8" VERSA-LAM® 2.0 3100 SP

Floor Beam\B02

Dry | 1 span | No cantilevers | 0/12 slope (deg)

November 19, 2017 08:23:45



BC CALCO® Design Report

Build 6080

Job Name: 45147 (4001)

Address: Pine Valley

City, Province, Postal Code: Vaughan, ON

Customer: Gold Park

Code reports: CCMC 12472-R

File Name: 290675.bcc


Description: Second Floor Framing

Specifier:

Designer: NL

Company: Alpa Roof Trusses

Misc:

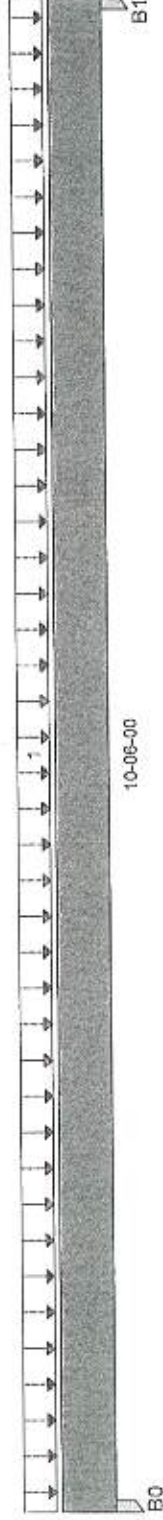

Total Horizontal Product Length = 10-06-00

## Reaction Summary (Down / Uplift) (lbs)

| Bearing    | Live      | Dead    | Snow | Wind |
|------------|-----------|---------|------|------|
| B0, 3-1/2" | 1,750 / 0 | 907 / 0 |      |      |
| B1, 3-1/2" | 1,750 / 0 | 907 / 0 |      |      |

## Load Summary

| Tag Description | Load Type          | Ref. | Start    | End      | Live | Dead | Snow | Wind      | Trib.    |
|-----------------|--------------------|------|----------|----------|------|------|------|-----------|----------|
| 1               | Unf. Area (lb/ft²) | L    | 00-00-00 | 10-06-00 | 40   | 20   |      | 1.00 1.15 | 08-04-00 |

## Controls Summary

|                  | Factored Demand | Factored Resistance | Demand / Resistance | Load Case | Location |
|------------------|-----------------|---------------------|---------------------|-----------|----------|
| Pos. Moment      | 9,023 ft-lbs    | 17,696 ft-lbs       | 51%                 | 1         | 05-03-00 |
| End Shear        | 2,841 lbs       | 7,232 lbs           | 39.3%               | 1         | 01-03-06 |
| Total Load Defl. | L/508 (0.237")  | 0.502"              | 47.2%               | 4         | 05-03-00 |
| Live Load Defl.  | L/772 (0.156")  | 0.335"              | 46.6%               | 5         | 05-03-00 |
| Max Defl.        | 0.237"          | 1"                  | 23.7%               | 4         | 05-03-00 |
| Span / Depth     | 10.1            | n/a                 | n/a                 |           | 00-00-00 |
| Squash Blocks    | Valid           |                     |                     |           |          |

## Disclosure

Completeness and accuracy of input must be verified by anyone who would rely on output as evidence of suitability for particular application. Output here based on building code-accepted design properties and analysis methods. Installation of Boise Cascade engineered wood products must be in accordance with current Installation Guide and applicable building codes. To obtain Installation Guide or ask questions, please call 1-800-964-6999 before installation.

BC CALCO®, BC FRAMER®, AJIS™, ALLJOIST®, BC RIM BOARD™, BCI®, BOISE GLULAM™, SIMPLE FRAMING SYSTEM®, VERSA-LAM®, VERSA-RIM PLUS®, VERSA-RIM®, VERSA-STRAND®, VERSA-STUD® are trademarks of Boise Cascade Wood Products L.L.C.

## Bearing Supports

|         | Dim. (L x W)    | Demand    | Demand / Resistance Support | Resistance Member | Material        |
|---------|-----------------|-----------|-----------------------------|-------------------|-----------------|
| B0 Post | 3-1/2" x 1-3/4" | 3,758 lbs | 35.4%                       | 50.3%             | Spruce Pine Fir |
| B1 Post | 3-1/2" x 1-3/4" | 3,758 lbs | 35.4%                       | 50.3%             | Spruce Pine Fir |

## Notes

Design meets Code minimum (L/240) Total load deflection criteria.

Design meets Code minimum (L/360) Live load deflection criteria.

Design meets User specified (1") Maximum Total load deflection criteria.

Calculations assume member is fully braced.

Resistance Factor phi has been applied to all presented results per CSA O86.

BC CALCO® analysis is based on Canadian Limit States Design, as per NBCC 2010 and CSA O86.

Design based on Dry Service Condition.

Importance Factor : Normal Part code : Part 4



S.152707



Boise Cascade

## Single 1-3/4" x 11-7/8" VERSA-LAM® 2.0 3100 SP

Floor Beam\B03

Dry | 1 span | No cantilevers | 0/12 slope (deg)


November 19, 2017 08:23:46

## BC CALC® Design Report



Build 6080  
 Job Name: 45147 (4001)  
 Address: Pine Valley  
 City, Province, Postal Code: Vaughan, ON  
 Customer: Gold Park  
 Code reports: CCMC 12472-R

File Name: 290675.bcc  
 Description: Second Floor Framing  
 Specifier: NL  
 Designer: NL  
 Company: Alpa Roof Trusses  
 Misc:

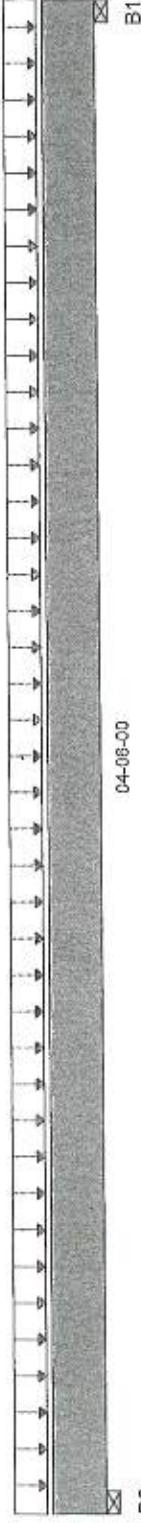

Total Horizontal Product Length = 04-06-00

## Reaction Summary (Down / Uplift) (lbs)

| Bearing    | Live    | Dead    | Snow | Wind |
|------------|---------|---------|------|------|
| B0, 3-1/2" | 330 / 0 | 179 / 0 |      |      |
| B1, 3-1/2" | 330 / 0 | 179 / 0 |      |      |

## Load Summary

| Tag Description | Load Type          | Ref. | Start    | End      | Live | Dead | Snow | Wind      | Trib.    |
|-----------------|--------------------|------|----------|----------|------|------|------|-----------|----------|
| 1               | Unf. Area (lb/ft²) | L    | 00-00-00 | 04-06-00 | 40   | 20   |      | 1.00 1.15 | 03-08-00 |

## Controls Summary

| Pos.             | Factored Demand | Factored Resistance | Demand / Resistance | Load Case | Location |
|------------------|-----------------|---------------------|---------------------|-----------|----------|
| Pos. Moment      | 652 ft-lbs      | 17,696 ft-lbs       | 3.7%                | 1         | 02-03-00 |
| End Shear        | 309 lbs         | 7,232 lbs           | 4.3%                | 1         | 01-03-06 |
| Total Load Defl. | L/998 (0.003")  | n/a                 | n/a                 | 4         | 02-03-00 |
| Live Load Defl.  | L/999 (0.002")  | n/a                 | n/a                 | 5         | 02-03-00 |
| Max Defl.        | 0.003"          | n/a                 | n/a                 | 4         | 02-03-00 |
| Span / Depth     | 4.1             | n/a                 | n/a                 |           | 00-00-00 |
| Squash Blocks    | Valid           |                     |                     |           |          |

## Disclosure

Completeness and accuracy of input must be verified by anyone who would rely on output as evidence of suitability for particular application. Output here based on building code-accepted design properties and analysis methods. Installation of Boise Cascade engineered wood products must be in accordance with current Installation Guide and applicable building codes. To obtain Installation Guide or ask questions, please call 1-800-964-6999 before installation.

## Bearing Supports

|               | Dim. (L x W)    | Demand  | Demand / Resistance Support | Resistance Member | Material        |
|---------------|-----------------|---------|-----------------------------|-------------------|-----------------|
| B0 Wall/Plate | 3-1/2" x 1-3/4" | 718 lbs | 19.1%                       | 9.6%              | Spruce Pine Fir |
| B1 Wall/Plate | 3-1/2" x 1-3/4" | 718 lbs | 19.1%                       | 9.6%              | Spruce Pine Fir |

## Notes

Design meets Code minimum (L/240) Total load deflection criteria.  
 Design meets Code minimum (L/360) Live load deflection criteria.  
 Design meets User specified (1") Maximum Total load deflection criteria.  
 Calculations assume member is fully braced.  
 Resistance Factor phi has been applied to all presented results per CSA O86.  
 BC CALC® analysis is based on Canadian Limit States Design, as per NBCC 2010 and CSA O86.  
 Design based on Dry Service Condition.  
 Importance Factor : Normal Part code : Part 4



S.152708



Boise Cascade

## Single 1-3/4" x 11-7/8" VERSA-LAM® 2.0 3100 SP

Floor Beam\B04

- Dry | 1 span | No cantilevers | 0/12 slope (deg)


November 19, 2017 08:23:46

## BC CALC® Design Report



Build 6080  
 Job Name:  
 Address:  
 City, Province, Postal Code: Vaughan, ON  
 Customer:  
 Code reports:

File Name: 290675.bcc  
 Description: Second Floor Framing  
 Specifier:  
 Designer: NL  
 Company: Alba Roof Trusses  
 Misc:

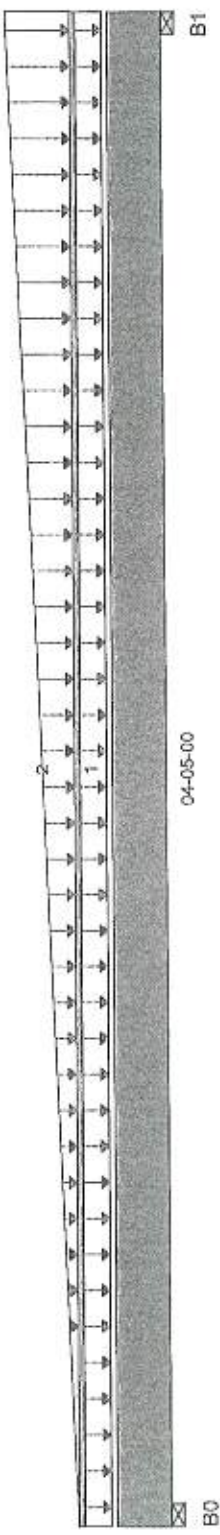

## Reaction Summary (Down / Uplift) (lbs)

| Bearing    | Live    | Dead   | Snow | Wind |
|------------|---------|--------|------|------|
| B0, 3-1/2" | 102 / 0 | 60 / 0 |      |      |
| B1, 3-1/2" | 150 / 0 | 79 / 0 |      |      |

## Load Summary

| Tag Description | Load Type           | Ref. | Start    | End      | Live | Dead | Snow | Wind      | Trib. |
|-----------------|---------------------|------|----------|----------|------|------|------|-----------|-------|
| 1               | Unf. Lin. (lb/ft)   | L    | 00-00-00 | 04-05-00 | 27   | 14   |      | 1.00 1.15 | n/a   |
| 2               | Trapezoidal (lb/ft) | L    | 00-00-00 | 04-05-00 | 0    | 0    |      |           | n/a   |
|                 |                     |      |          | 04-05-00 | 60   | 23   |      |           | n/a   |

## Controls Summary

|                  |                |               |      |   |          |
|------------------|----------------|---------------|------|---|----------|
| Pos. Moment      | 246 ft-lbs     | 17,696 ft-lbs | 1.4% | 1 | 02-03-14 |
| End Shear        | 206 lbs        | 7,232 lbs     | 2.9% | 1 | 03-01-10 |
| Total Load Defl. | L/999 (0.001") | n/a           | n/a  | 4 | 02-03-03 |
| Live Load Defl.  | L/999 (0.001") | n/a           | n/a  | 5 | 02-03-03 |
| Max Defl.        | 0.001"         | n/a           | n/a  | 4 | 02-03-03 |
| Span / Depth     | 4              | n/a           | n/a  |   | 00-00-00 |
| Squash Blocks    | Valid          |               |      |   |          |

## Disclosure

Completeness and accuracy of input must be verified by anyone who would rely on output as evidence of suitability for particular application. Output here based on building code-accepted design properties and analysis methods. Installation of Boise Cascade engineered wood products must be in accordance with current Installation Guide and applicable building codes. To obtain Installation Guide or ask questions, please call 1-800-964-6999 before installation.

## Bearing Supports

|               | Dim. (L x W)    | Demand  | Demand / Resistance Support | Resistance Member | Material        |
|---------------|-----------------|---------|-----------------------------|-------------------|-----------------|
| B0 Wall/Plate | 3-1/2" x 1-3/4" | 228 lbs | 6%                          | 3%                | Spruce Pine Fir |
| B1 Wall/Plate | 3-1/2" x 1-3/4" | 324 lbs | 8.6%                        | 4.3%              | Spruce Pine Fir |

## Notes

Design meets Code minimum (L/240) Total load deflection criteria.  
 Design meets Code minimum (L/360) Live load deflection criteria.  
 Design meets User specified (1") Maximum Total load deflection criteria.  
 Calculations assume member is fully braced.  
 Resistance Factor phi has been applied to all presented results per CSA O86.  
 BC CALC® analysis is based on Canadian Limit States Design, as per NBCC 2010 and CSA O86.  
 Design based on Dry Service Condition.  
 Importance Factor : Normal Part code : Part 4

BC CALC®, BC FRAMER®, AJS™, ALLJOIST®, BC RIM BOARD™, BCI®, BOISE GLULAM™, SIMPLE FRAMING SYSTEM®, VERSA-LAM®, VERSA-RIM PLUS®, VERSA-RIM®, VERSA-STRAND®, VERSA-STUD® are trademarks of Boise Cascade Wood Products L.L.C.





Boise Cascade

## Single 1-3/4" x 11-7/8" VERSA-LAM® 2.0 3100 SP

Floor Beam\B05




## BC CALC® Design Report

Dry | 1 span | No cantilevers | 0/12 slope (deg)

November 19, 2017 08:23:47

Build 6080  
 Job Name: 45147 (4001)  
 Address: Pine Valley  
 City, Province, Postal Code: Vaughan, ON  
 Customer: Gold Park  
 Code reports: CCMC 12472-R

File Name: 290675.bcc  
 Description: Second Floor Framing  
 Specifier:  
 Designer: NL  
 Company: Alpa Roof Trusses  
 Misc:

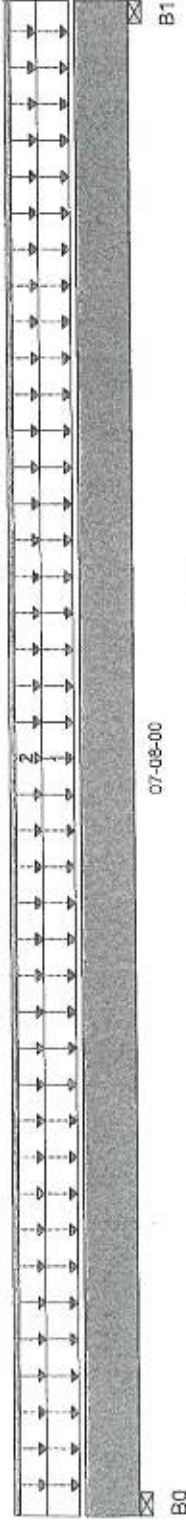

Total Horizontal Product Length = 07-08-00

## Reaction Summary (Down / Uplift) (lbs)

| Bearing    | Live      | Dead    | Snow | Wind |
|------------|-----------|---------|------|------|
| B0, 3-1/2" | 1,112 / 0 | 809 / 0 |      |      |
| B1, 3-1/2" | 1,112 / 0 | 809 / 0 |      |      |

## Load Summary

| Tag Description | Load Type                       | Ref. | Start    | End      | Live | Dead | Snow | Wind | Trib.    |
|-----------------|---------------------------------|------|----------|----------|------|------|------|------|----------|
| 1               | Unf. Area (lb/ft <sup>2</sup> ) | L    | 00-00-00 | 07-08-00 | 40   | 20   |      |      | 07-03-00 |
| 2               | Unf. Lin. (lb/ft)               | L    | 00-00-00 | 07-08-00 | 60   | 60   |      |      | n/a      |

## Controls Summary

|                  |                |               |       |   |          |
|------------------|----------------|---------------|-------|---|----------|
| Pos. Moment      | 4,539 ft-lbs   | 17,696 ft-lbs | 25.6% | 1 | 03-10-00 |
| End Shear        | 1,783 lbs      | 7,232 lbs     | 24.7% | 1 | 01-03-06 |
| Total Load Defl. | L/999 (0.062") | n/a           | n/a   | 4 | 03-10-00 |
| Live Load Defl.  | L/999 (0.036") | n/a           | n/a   | 5 | 03-10-00 |
| Max Defl.        | 0.062"         | n/a           | n/a   | 4 | 03-10-00 |
| Span / Depth     | 7.3            | n/a           | n/a   |   | 00-00-00 |
| Squash Blocks    | Valid          |               |       |   |          |

## Disclosure

Completeness and accuracy of input must be verified by anyone who would rely on output as evidence of suitability for particular application. Output here based on building code-accepted design properties and analysis methods. Installation of Boise Cascade engineered wood products must be in accordance with current Installation Guide and applicable building codes. To obtain Installation Guide or ask questions, please call 1-800-964-6999 before installation.

## Bearing Supports

|               | Dim. (L x W)    | Demand    | Demand / Resistance Support | Resistance Member | Material        |
|---------------|-----------------|-----------|-----------------------------|-------------------|-----------------|
| B0 Wall/Plate | 3-1/2" x 1-3/4" | 2,679 lbs | 71.1%                       | 35.8%             | Spruce Pine Fir |
| B1 Wall/Plate | 3-1/2" x 1-3/4" | 2,679 lbs | 71.1%                       | 35.8%             | Spruce Pine Fir |

## Notes

Design meets Code minimum (L/240) Total load deflection criteria.  
 Design meets Code minimum (L/360) Live load deflection criteria.  
 Design meets User specified (1") Maximum Total load deflection criteria.  
 Calculations assume member is fully braced.  
 Resistance Factor phi has been applied to all presented results per CSA O86.  
 BC CALC® analysis is based on Canadian Limit States Design, as per NBCC 2010 and CSA O86.  
 Design based on Dry Service Condition.  
 Importance Factor : Normal Part code : Part 4





Boise Cascade

# Double 1-3/4" x 11-7/8" VERSA-LAM® 2.0 3100 SP

Floor Beam\B06

Dry | 1 span | No cantilevers | 0/12 slope (deg)

November 19, 2017 08:23:47



## BC CALC® Design Report

Build 6080

Job Name:

Address:

City, Province, Postal Code: Vaughan, ON

Customer: Gold Park

Code reports: CCMC 12472-R

File Name: 290675.bcc


Description: Second Floor Framing

Specifier:

NL

Company: Alpa Roof Trusses

Misc:

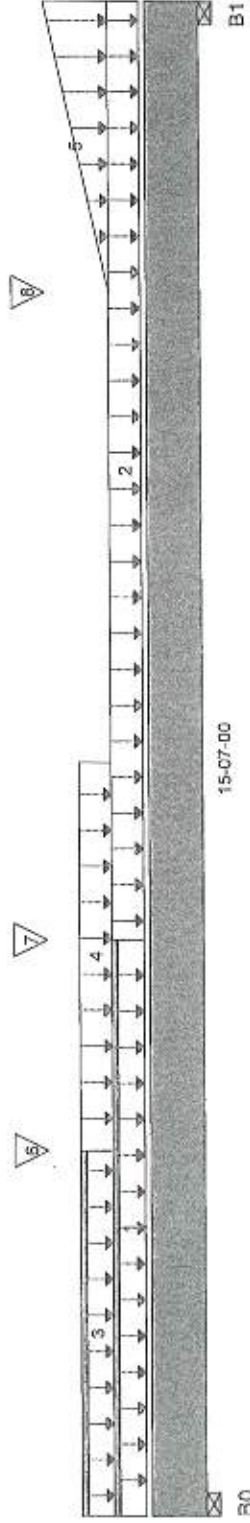

Total Horizontal Product Length = 15-07-00

## Reaction Summary (Down / Uplift) (lbs)

| Bearing    | Live      | Dead      | Snow | Wind |
|------------|-----------|-----------|------|------|
| B0, 3-1/2" | 1,772 / 0 | 1,129 / 0 |      |      |
| B1, 3-1/2" | 1,313 / 0 | 722 / 0   |      |      |

## Load Summary

| Tag | Description         | Load Type | Ref.     | Start    | End   | Live | Dead | Snow | Wind | Trib.    |
|-----|---------------------|-----------|----------|----------|-------|------|------|------|------|----------|
| 1   | Unf. Lin. (lb/ft)   | L         | 00-00-00 | 05-11-00 | 27    | 14   | 0.65 | 1.00 | 1.15 | n/a      |
| 2   | Unf. Area (lb/ft²)  | L         | 05-11-00 | 15-07-00 | 40    | 15   |      |      |      | 02-03-00 |
| 3   | Unf. Lin. (lb/ft)   | L         | 00-00-00 | 03-09-00 | 27    | 14   |      |      |      | n/a      |
| 4   | Unf. Area (lb/ft²)  | L         | 03-09-00 | 07-09-00 | 40    | 15   |      |      |      | 02-00-00 |
| 5   | Trapezoidal (lb/ft) | L         | 12-07-00 |          | 0     | 0    |      |      |      | n/a      |
| 6   | Conc. Pt. (lbs)     | L         | 03-09-00 | 03-09-00 | 1,112 | 809  |      |      |      | n/a      |
| 7   | Conc. Pt. (lbs)     | L         | 05-11-00 | 05-11-00 | 330   | 179  |      |      |      | n/a      |
| 8   | Conc. Pt. (lbs)     | L         | 12-07-00 | 12-07-00 | 102   | 60   |      |      |      | n/a      |

## Controls Summary

| Pos.             | Moment         | Factored Demand | Factored Resistance | Demand / Resistance | Load Case | Location |
|------------------|----------------|-----------------|---------------------|---------------------|-----------|----------|
| End Shear        | 3,901 lbs      | 14,811 ft-lbs   | 35,392 ft-lbs       | 41.8%               | 1         | 05-11-00 |
| Total Load Defl. | L/431 (0.421") | L/686 (0.265")  | 0.756"              | 55.7%               | 4         | 01-03-06 |
| Live Load Defl.  | 0.421"         | 1"              | 0.504"              | 52.5%               | 5         | 07-03-08 |
| Max Defl.        | 15.3           | Valid           | n/a                 | 42.1%               | 4         | 07-03-08 |
| Squash Blocks    |                |                 |                     | n/a                 |           | 00-00-00 |

## Bearing Supports

|               | Dim. (L x W)    | Demand    | Demand / Resistance Support | Resistance Member | Material        |
|---------------|-----------------|-----------|-----------------------------|-------------------|-----------------|
| B0 Wall/Plate | 3-1/2" x 3-1/2" | 4,069 lbs | 54%                         | 27.2%             | Spruce Pine Fir |
| B1 Wall/Plate | 3-1/2" x 3-1/2" | 2,873 lbs | 38.1%                       | 19.2%             | Spruce Pine Fir |

## Notes

Nail one ply to another with  
3 1/2" spiral nails @ 12"  
o.c. staggered in 2 rows



S152711



Bolise Cascade

## Double 1-3/4" x 11-7/8" VERSA-LAM® 2.0 3100 SP

Floor Beam\B07

BC CALC® Design Report



Dry | 1 span | No cantilevers | 0/12 slope (deg)

November 19, 2017 08:23:24

Build 6080

Job Name: 45147 (4001)

Address: Pine Valley

City, Province, Postal Code: Vaughan, ON

Customer: Gold Park

Code reports: CCMC 12472-R

File Name: 290675.bcc


Description: Second Floor Framing

Specifier:

Designer: NL

Company: Alpa Roof Trusses

Misc:

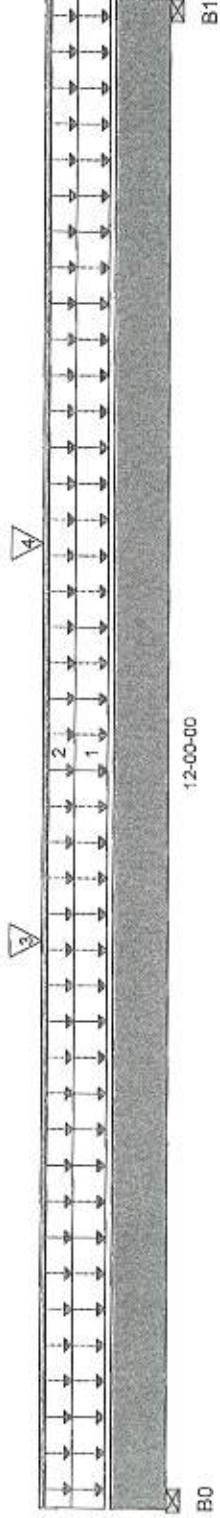

Total Horizontal Product Length = 12'-00-00

## Reaction Summary (Down / Uplift) (lbs)

| Bearing    | Live      | Dead      | Snow | Wind |
|------------|-----------|-----------|------|------|
| B0, 3"     | 1,857 / 0 | 1,388 / 0 |      |      |
| B1, 3-1/2" | 2,210 / 0 | 1,586 / 0 |      |      |

## Load Summary

| Tag Description | Load Type          | Ref. | Start    | End      | Live  | Dead | Snow | Wind | Trib.    |
|-----------------|--------------------|------|----------|----------|-------|------|------|------|----------|
| 1               | Unf. Area (lb/ft²) | L    | 00-00-00 | 12-00-00 | 40    | 20   |      |      | 04-09-00 |
| 2               | Unf. Lin. (lb/ft)  | L    | 00-00-00 | 12-00-00 | 27    | 74   |      |      | n/a      |
| 3               | Conc. Pt. (lbs)    | L    | 04-06-00 | 04-06-00 | 150   | 79   |      |      | n/a      |
| 4               | Conc. Pt. (lbs)    | L    | 07-08-00 | 07-08-00 | 1,313 | 722  |      |      | n/a      |

## Controls Summary

|                  | Factored Demand | Factored Resistance | Demand / Resistance | Load Case | Location |
|------------------|-----------------|---------------------|---------------------|-----------|----------|
| Pos. Moment      | 16,572 ft-lbs   | 35,392 ft-lbs       | 46.8%               | 1         | 07-08-00 |
| End Shear        | 4,590 lbs       | 14,464 lbs          | 31.7%               | 1         | 10-08-10 |
| Total Load Defl. | L/496 (0.28")   | 0.579"              | 48.4%               | 4         | 06-01-00 |
| Live Load Defl.  | L/845 (0.165")  | 0.386"              | 42.6%               | 5         | 06-01-00 |
| Max Defl.        | 0.28"           | 1"                  | 28%                 | 4         | 06-01-00 |
| Span / Depth     | 11.7            | n/a                 | n/a                 | 4         | 00-00-00 |
| Squash Blocks    | Valid           |                     |                     |           |          |

| Bearing       | Dim. (L x W)    | Demand    | Demand / Resistance Support | Demand / Resistance Member | Material        |
|---------------|-----------------|-----------|-----------------------------|----------------------------|-----------------|
| B0 Wall/Plate | 3" x 3-1/2"     | 4,520 lbs | 70%                         | 35.3%                      | Spruce Pine Fir |
| B1 Wall/Plate | 3-1/2" x 3-1/2" | 5,297 lbs | 70.3%                       | 35.4%                      | Spruce Pine Fir |

## Notes

Design meets Code minimum (L/240) Total load deflection criteria.

Design meets Code minimum (L/360) Live load deflection criteria.

Design meets User specified (1") Maximum Total load deflection criteria.

Calculations assume member is fully braced.

Resistance Factor phi has been applied to all presented results per CSA O86.

BC CALC® analysis is based on Canadian Limit States Design, as per NBCC 2010 and CSA O86.


Design based on Dry Service Condition.

Importance Factor : Normal Part code : Part 4

Nail one ply to another with

3 1/2" spiral nails @ 12"

o.c., staggered in 2 rows

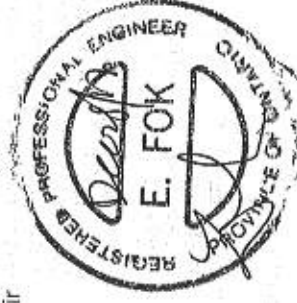

S152712



Boise Cascade

## Double 1-3/4" x 11-7/8" VERSA-LAM® 2.0 3100 SP

Floor Beam\B08



BC CALCO® Design Report

Dry | 1 span | No cantilevers | 0/12 slope (deg)

November 19, 2017 08:23:48

Build 6080

Job Name: 45147 (4001)

Address: Pine Valley

City, Province, Postal Code: Vaughan, ON

Customer: Gold Park

Code reports: CCMC 12472-R

File Name: 290675.bcc


Description: Second Floor Framing

Specifier:

Designer: NL

Company: Alpa Roof Trusses

Misc:

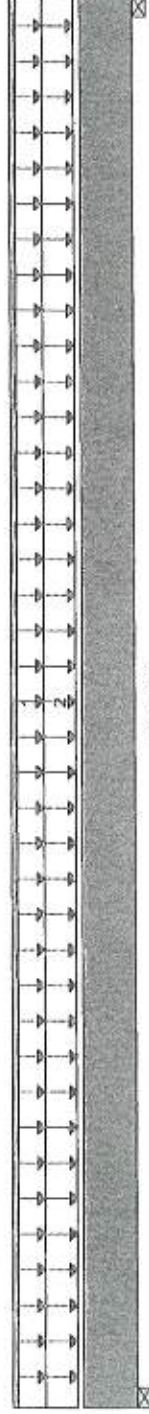

03-00-00

B1

Total Horizontal Product Length = 03-00-00

## Reaction Summary (Down / Uplift) (lbs)

| Bearing    | Live   | Dead    | Snow    | Wind |
|------------|--------|---------|---------|------|
| B0, 3-1/2" | 40 / 0 | 329 / 0 | 268 / 0 |      |
| B1, 3-1/2" | 41 / 0 | 329 / 0 | 268 / 0 |      |

## Load Summary

| Tag Description | Load Type           | Ref. | Start    | End      | Live | Dead | Snow | Wind | Trib.    |
|-----------------|---------------------|------|----------|----------|------|------|------|------|----------|
| 1               | Unf. Lin. (lb/ft)   | L    | 00-00-00 | 03-00-00 | 27   | 114  |      |      | n/a      |
| 2               | Unf. Area (lb/ft^2) | L    | 00-00-00 | 03-00-00 | 11   | 11   |      |      | 08-06-00 |

## Controls Summary

| Pos.             | Factored Demand | Factored Resistance | Demand / Resistance | Load Case | Location |
|------------------|-----------------|---------------------|---------------------|-----------|----------|
| Pos. Moment      | 449 ft-lbs      | 35,392 ft-lbs       | 1.3%                | 5         | 01-06-00 |
| End Shear        | 122 lbs         | 14,464 lbs          | 0.8%                | 5         | 01-03-06 |
| Total Load Defl. | L/999 (0")      | n/a                 | n/a                 | 13        | 01-06-00 |
| Live Load Defl.  | L/999 (0")      | n/a                 | n/a                 | 17        | 01-06-00 |
| Max Defl.        | 0"              | n/a                 | n/a                 | 13        | 01-06-00 |
| Span / Depth     | 2.6             | n/a                 | n/a                 |           | 00-00-00 |
| Squash Blocks    | Valid           |                     |                     |           |          |

## Bearing Supports

|               | Dim. (L x W)    | Demand  | Demand / Resistance Support | Demand / Resistance Member | Material        |
|---------------|-----------------|---------|-----------------------------|----------------------------|-----------------|
| B0 Wall/Plate | 3-1/2" x 3-1/2" | 834 lbs | 11.1%                       | 5.6%                       | Spruce Pine Fir |
| B1 Wall/Plate | 3-1/2" x 3-1/2" | 834 lbs | 11.1%                       | 5.6%                       | Spruce Pine Fir |

## Notes

Design meets Code minimum (L/240) Total load deflection criteria.

Design meets Code minimum (L/360) Live load deflection criteria.

Design meets User specified (1") Maximum Total load deflection criteria.

Calculations assume member is fully braced.

Resistance Factor phi has been applied to all presented results per CSA O86.

BC CALCO® analysis is based on Canadian Limit States Design, as per NBCC 2010 and CSA O86.

Design based on Dry Service Condition.

Importance Factor : Normal Part code : Part 4

Nail one ply to another with  
3 1/2" spiral nails @ 6"

o.c, staggered in 2 rows





Boise Cascade

BC CALCO® Design Report



Double 1-3/4" x 11-7/8" VERSA-LAM® 2.0 3100 SP


Floor Beam\B09

Dry [ 1 span | No cantilevers | 0/12 slope (deg)

November 19, 2017 08:23:48

Build 6080  
Job Name: 45147 (4001)  
Address: Pine Valley  
City, Province, Postal Code: Vaughan, ON  
Customer: Gold Park  
Code reports: CCMC 12472-R

File Name: 290675.bcc  
Description: First Floor Framing  
Specifier:  
Designer: NL  
Company: Alpa Roof Trusses  
Misc:

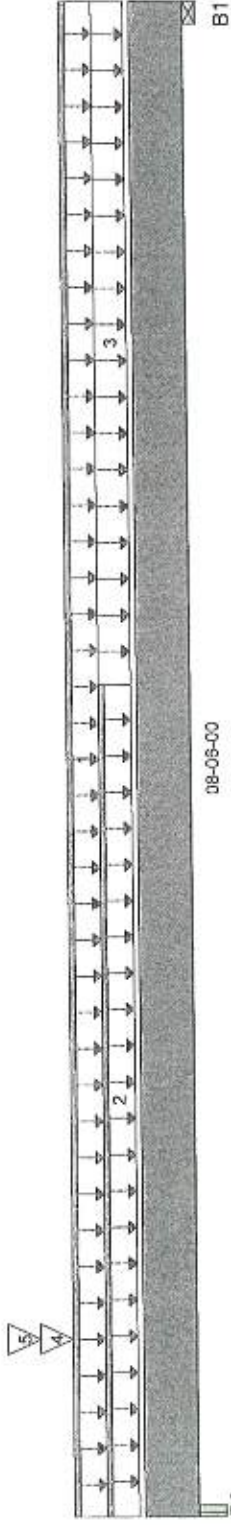

Total Horizontal Product Length = 08-06-00

### Reaction Summary (Down / Uplift) (lbs )

| Bearing    | Live      | Dead      | Snow | Wind |
|------------|-----------|-----------|------|------|
| B0, 3-1/2" | 3,347 / 0 | 2,174 / 0 |      |      |
| B1, 3-1/2" | 634 / 0   | 447 / 0   |      |      |

### Load Summary

| Tag Description | Load Type           | Ref. | Start    | End      | Live  | Dead  | Snow | Wind | Trib.    |
|-----------------|---------------------|------|----------|----------|-------|-------|------|------|----------|
| 1               | Unf. Lin. (lb/ft)   | L    | 00-00-00 | 08-06-00 | 27    | 14    |      |      | n/a      |
| 2               | Unf. Lin. (lb/ft)   | L    | 00-00-00 | 04-08-00 |       | 60    |      |      | n/a      |
| 3               | Unf. Area (lb/ft^2) | L    | 04-08-00 | 08-06-00 | 40    | 15    |      |      | 01-06-00 |
| 4               | Conc. Pl. (lbs)     | L    | 01-00-00 | 01-00-00 | 1,750 | 905   |      |      | n/a      |
| 5               | Conc. Pl. (lbs)     | L    | 01-00-00 | 01-00-00 | 1,772 | 1,129 |      |      | n/a      |

| Controls Summary |                | Factored Demand | Factored Resistance | Demand / Resistance | Load Case | Location |
|------------------|----------------|-----------------|---------------------|---------------------|-----------|----------|
| Pos. Moment      | 5,897 ft-lbs   | 35,392 ft-lbs   | 16.7%               | 1                   | 01-00-00  |          |
| End Shear        | 5,325 lbs      | 14,464 lbs      | 36.8%               | 1                   | 01-03-06  |          |
| Total Load Defl. | L/999 (0.043") | n/a             | n/a                 | 4                   | 03-09-13  |          |
| Live Load Defl.  | L/999 (0.025") | n/a             | n/a                 | 5                   | 03-09-13  |          |
| Max Defl.        | 0.043"         | n/a             | n/a                 | 4                   | 03-09-13  |          |
| Span / Depth     | 8.1            | n/a             | n/a                 |                     | 00-00-00  |          |
| Squash Blocks    | Valid          |                 |                     |                     |           |          |

| Bearing Supports |            | Dim. (L x W)    | Demand    | Demand / Resistance Support | Resistance Member | Material        |
|------------------|------------|-----------------|-----------|-----------------------------|-------------------|-----------------|
| B0               | Beam       | 3-1/2" x 3-1/2" | 7,739 lbs | 1.6%                        | 51.8%             | Steel           |
| B1               | Wall/Plate | 3-1/2" x 3-1/2" | 1,510 lbs | 20%                         | 10.1%             | Spruce Pine Fir |

### Notes

Design meets Code minimum (L/240) Total load deflection criteria.  
Design meets Code minimum (L/360) Live load deflection criteria.  
Design meets User specified (1") Maximum Total load deflection criteria.  
Calculations assume member is fully braced.  
Resistance Factor phi has been applied to all presented results per CSA O86.  
BC CALCO® analysis is based on Canadian Limit States Design, as per NBCC 2010 and CSA O86.  
Design based on Dry Service Condition.  
Importance Factor : Normal Part code : Part 4  
Nail one ply to another with  
3 1/2" spiral nails @ 12"  
o.c. staggered in 2 rows





Boise Cascade

## Single 1-3/4" x 11-7/8" VERSA-LAM® 2.0 3100 SP

Floor Beam\B10




## BC CALC® Design Report

Dry | 1 span | No cantilevers | 0°/12 slope (deg)

November 19, 2017 08:23:49

Build 6080  
 Job Name: 45147 (4001)  
 Address: Pine Valley  
 City, Province, Postal Code: Vaughan, ON  
 Customer: Gold Park  
 Code reports: CCMC 12472-R

File Name: 290675.bcc  
 Description: First Floor Framing  
 Specifier:  
 Designer: NL  
 Company: Alpa Roof Trusses  
 Misc:

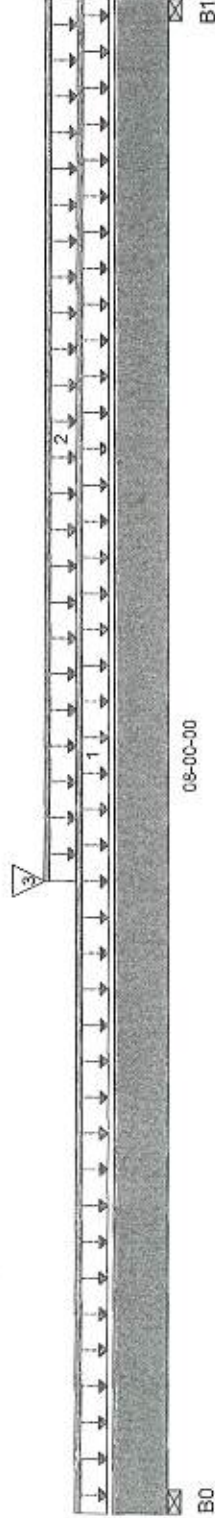

Total Horizontal Product Length = 08-00-00

## Reaction Summary (Down / Uplift) (lbs)

| Bearing    | Live    | Dead    | Snow | Wind |
|------------|---------|---------|------|------|
| B0, 3-1/2" | 516 / 0 | 361 / 0 |      |      |
| B1, 3-1/2" | 460 / 0 | 311 / 0 |      |      |

## Load Summary

| Tag Description | Load Type         | Ref. | Start    | End      | Live | Dead | Snow | Wind | Trib. |
|-----------------|-------------------|------|----------|----------|------|------|------|------|-------|
| 1               | Unf. Lin. (lb/ft) | L    | 00-00-00 | 08-00-00 | 27   | 14   |      |      | n/a   |
| 2               | Unf. Lin. (lb/ft) | L    | 03-04-00 | 08-00-00 | 27   | 14   |      |      | n/a   |
| 3               | Conc. Pt. (lbs)   | L    | 03-04-00 | 03-04-00 | 634  | 447  |      |      | n/a   |

## Controls Summary

|                  | Factored Demand | Factored Resistance | Demand / Resistance | Load Case | Location |
|------------------|-----------------|---------------------|---------------------|-----------|----------|
| Pos. Moment      | 3,443 ft-lbs    | 17,696 ft-lbs       | 19.5%               | 1         | 03-04-00 |
| End Shear        | 1,142 lbs       | 7,232 lbs           | 15.8%               | 1         | 01-03-06 |
| Total Load Defl. | L/999 (0.044")  | n/a                 | n/a                 | 4         | 03-10-06 |
| Live Load Defl.  | L/999 (0.026")  | n/a                 | n/a                 | 5         | 03-10-06 |
| Max Defl.        | 0.044"          | n/a                 | n/a                 | 4         | 03-10-06 |
| Span / Depth     | 7.6             | n/a                 | n/a                 |           | 00-00-00 |
| Squash Blocks    | Valid           |                     |                     |           |          |

## Disclosure

Completeness and accuracy of input must be verified by anyone who would rely on output as evidence of suitability for particular application. Output here based on building code-accepted design properties and analysis methods. Installation of Boise Cascade engineered wood products must be in accordance with current Installation Guide and applicable building codes. To obtain Installation Guide or ask questions, please call 1-800-964-6999 before installation.

## Bearing Supports

|               | Dim. (L x W)    | Demand    | Demand / Resistance Support | Demand / Resistance Member | Material        |
|---------------|-----------------|-----------|-----------------------------|----------------------------|-----------------|
| B0 Wall/Plate | 3-1/2" x 1-3/4" | 1,226 lbs | 32.5%                       | 16.4%                      | Spruce Pine Fir |
| B1 Wall/Plate | 3-1/2" x 1-3/4" | 1,078 lbs | 28.6%                       | 14.4%                      | Spruce Pine Fir |


## Notes

Design meets Code minimum (L/240) Total load deflection criteria.  
 Design meets Code minimum (L/360) Live load deflection criteria.  
 Design meets User specified (1") Maximum Total load deflection criteria.  
 Calculations assume member is fully braced.  
 Resistance Factor phi has been applied to all presented results per CSA O86.  
 BC CALC® analysis is based on Canadian Limit States Design, as per NBCC 2010 and CSA O86.

Design based on Dry Service Condition.

Importance Factor : Normal Part code : Part 4



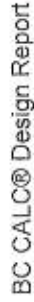

CCMC 12472-R

11-09-00

## Total Horizontal Product Length = 11-09-00

## Wind

| Tag | Description | Load Type                       | Ref. | Start    | End      | 1.00 | 0.65 | 1.00 | 1.15     |
|-----|-------------|---------------------------------|------|----------|----------|------|------|------|----------|
| 1   |             | Unf. Area (lb/ft <sup>2</sup> ) | L    | 00-00-00 | 07-10-00 | 40   | 15   |      | 04-00-00 |
| 2   |             | Unf. Area (lb/ft <sup>2</sup> ) | L    | 07-10-00 | 11-09-00 | 40   | 15   |      | 05-06-00 |
| 3   |             | Conc. Pt. (lbs)                 | L    | 07-10-00 | 07-10-00 | 850  | 319  |      | n/a      |

Completeness and accuracy of input must be verified by anyone who would rely on output as evidence of suitability for particular application. Output here based on building code-accepted design properties and analysis methods.

Installation of Boise Cascade engineered wood products must be in accordance with current Installation Guide and applicable building codes. To obtain Installation Guide or ask questions, please call 1-800-964-6999 before installation.


1-800-964-6999 before installation.

## Material

BC CALC®, BC FRAMER®, AJS™,  
ALLJOIST®, BC RIM BOARD™, BCI®,  
BOISE GLULAM™, SIMPLE FRAMING  
SYSTEM®, VERSA-LAM®, VERSA-RIM  
PLUS®, VERSA-RIM®,  
VERSA-STRAND® VERSA-STUD® are  
trademarks of Boise Cascade Wood  
Products L.L.C.

## Notes

Design meets Code minimum (L/240) Total load deflection criteria.  
Design meets Code minimum (L/360) Live load deflection criteria.  
Design meets User specified (1") Maximum Total load deflection criteria.  
Calculations assume member is fully braced.  
Resistance Factor phi has been applied to all presented results per CSA O86.  
BC CALCC® analysis is based on Canadian Limit States Design, as per NBCC 2010 and CSA O86.  
Design based on Dry Service Condition.  
Importance Factor : Normal Part code : Part 4

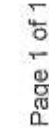

9142515



Boise Cascade

## Single 1-3/4" x 11-7/8" VERSA-LAM® 2.0 3100 SP

Floor Beam\B12

Dry | 1 span | No cantilevers | 0/12 slope (deg)


November 19, 2017 08:23:50

## BC CALCO® Design Report



Build 6080  
 Job Name: 45147 (4001)  
 Address: Pine Valley  
 City, Province, Postal Code: Vaughan, ON  
 Customer: Gold Park  
 Code reports: CCMC 12472-R

File Name: 290675.bcc  
 Description: First Floor Framing  
 Specifier:  
 Designer: NL  
 Company: Alpa Roof Trusses  
 Misc:

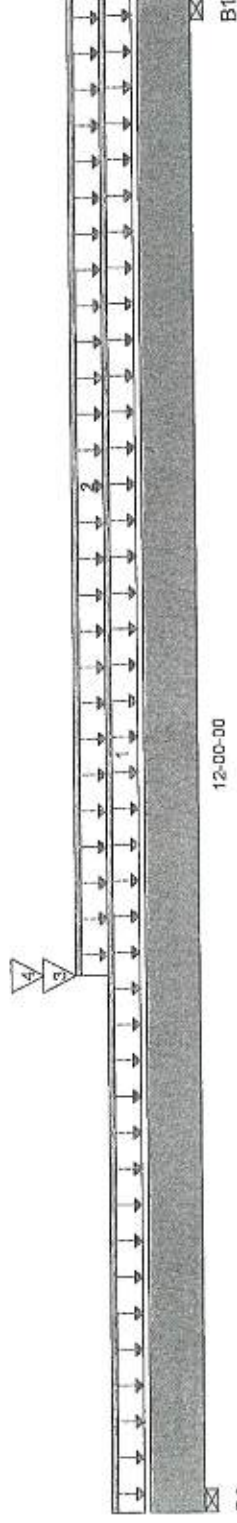

Total Horizontal Product Length = 12'-00"-00

## Reaction Summary (Down / Uplift) (lbs)

| Bearing    | Live      | Dead      | Snow | Wind |
|------------|-----------|-----------|------|------|
| B0, 3-1/2" | 1,603 / 0 | 1,053 / 0 |      |      |
| B1, 3-1/2" | 1,041 / 0 | 843 / 0   |      |      |

## Load Summary

| Tag Description | Load Type         | Ref. | Start    | End      | Live  | Dead | Snow | Wind | Trib. |
|-----------------|-------------------|------|----------|----------|-------|------|------|------|-------|
| 1               | Unf. Lin. (lb/ft) | L    | 00-00-00 | 12-00-00 | 27    | 74   |      |      | n/a   |
| 2               | Unf. Lin. (lb/ft) | L    | 04-03-00 | 12-00-00 | 27    | 14   |      |      | n/a   |
| 3               | Conc. Pt. (lbs)   | L    | 04-03-00 | 04-03-00 | 400   | 150  |      |      | n/a   |
| 4               | Conc. Pt. (lbs)   | L    | 04-03-00 | 04-03-00 | 1,711 | 677  |      |      | n/a   |

## Controls Summary

| Pos. Moment      | Factored Demand | Factored Resistance | Demand / Resistance | Load Case | Location |
|------------------|-----------------|---------------------|---------------------|-----------|----------|
| End Shear        | 13,703 ft-lbs   | 17,696 ft-lbs       | 77.4%               | 1         | 04-03-00 |
| Total Load Defl. | 3,542 lbs       | 7,232 lbs           | 49%                 | 1         | 01-03-06 |
| Live Load Defl.  | L/342 (0.405")  | 0.577"              | 70.3%               | 4         | 05-08-00 |
| Max Defl.        | L/556 (0.249")  | 0.385"              | 64.8%               | 5         | 05-06-12 |
| Span / Depth     | 0.405"          | 1"                  | 40.5%               | 4         | 05-08-00 |
| Squash Blocks    | 11.7            | n/a                 | n/a                 | 4         | 00-00-00 |

## Disclosure

Completeness and accuracy of input must be verified by anyone who would rely on output as evidence of suitability for particular application. Output here based on building code-accepted design properties and analysis methods. Installation of Boise Cascade engineered wood products must be in accordance with current Installation Guide and applicable building codes. To obtain Installation Guide or ask questions, please call 1-800-964-6999 before installation.

## Bearing Supports

|               | Dim. (L x W)    | Demand    | Demand / Resistance Support | Resistance Member | Material        |
|---------------|-----------------|-----------|-----------------------------|-------------------|-----------------|
| B0 Wall/Plate | 3-1/2" x 1-3/4" | 3,722 lbs | 98.8%                       | 49.8%             | Spruce Pine Fir |
| B1 Wall/Plate | 3-1/2" x 1-3/4" | 2,614 lbs | 69.4%                       | 35%               | Spruce Pine Fir |

## Notes

Design meets Code minimum (L/240) Total load deflection criteria.  
 Design meets Code minimum (L/360) Live load deflection criteria.  
 Design meets User specified (1") Maximum Total load deflection criteria.  
 Calculations assume member is fully braced.  
 Resistance Factor phi has been applied to all presented results per CSA O86.  
 BC CALCO® analysis is based on Canadian Limit States Design, as per NBCC 2010 and CSA O86.

Design based on Dry Service Condition.  
 Importance Factor : Normal Part code : Part 4





Boise Cascade

# BC CALCO® Design Report



## Double 1-3/4" x 11-7/8" VERSA-LAM® 2.0 3100 SP

Floor Beam\B13

Dry | 1 span | No cantilevers | 0/12 slope (deg)

November 19, 2017 08:23:50

Build 6080

Job Name: 45147 (4001)

Address: Pine Valley

City, Province, Postal Code: Vaughan, ON

Customer: Gold Park

Code reports: CCMC 12472-R

File Name: 290675.bcc


Description: First Floor Framing

Specifier:

Designer: NL

Company: Alpa Roof Trusses

Misc:

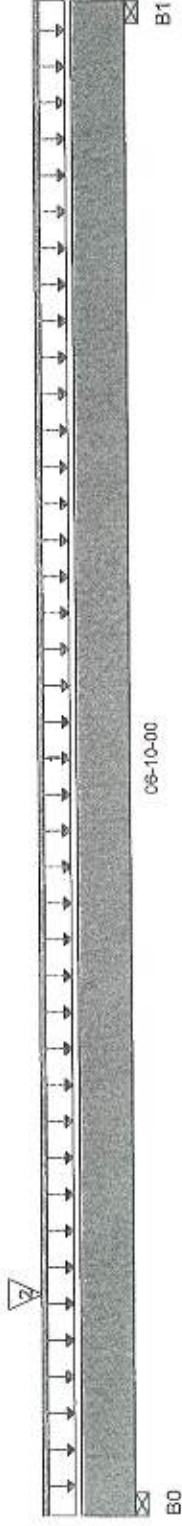

06-10-00

Total Horizontal Product Length = 06-10-00

### Reaction Summary (Down / Uplift) (lbs)

| Bearing    | Live      | Dead      | Snow | Wind |
|------------|-----------|-----------|------|------|
| B0, 3-1/2" | 1,723 / 0 | 1,134 / 0 |      |      |
| B1, 3-1/2" | 396 / 0   | 448 / 0   |      |      |

### Load Summary

| Tag | Description | Load Type         | Ref. | Start    | End      | Live  | Dead | Snow | Wind | Trib. |
|-----|-------------|-------------------|------|----------|----------|-------|------|------|------|-------|
| 1   |             | Unf. Lin. (lb/ft) | L    | 00-00-00 | 06-10-00 | 54    | 87   |      |      | n/a   |
| 2   |             | Conc. Pt. (lbs)   | L    | 01-00-00 | 01-00-00 | 1,750 | 905  |      |      | n/a   |

### Controls Summary

| Pos.             | Factored Demand | Factored Resistance | Demand / Resistance | Load Case | Location |
|------------------|-----------------|---------------------|---------------------|-----------|----------|
| Pos. Moment      | 2,992 ft-lbs    | 35,392 ft-lbs       | 8.5%                | 1         | 01-02-08 |
| End Shear        | 2,672 lbs       | 14,464 lbs          | 18.5%               | 1         | 01-03-06 |
| Total Load Defl. | L/999 (0.015")  | n/a                 | n/a                 | 4         | 03-01-13 |
| Live Load Defl.  | L/999 (0.008")  | n/a                 | n/a                 | 5         | 03-01-00 |
| Max Defl.        | 0.015"          | n/a                 | n/a                 | 4         | 03-01-13 |
| Span / Depth     | 6.4             | n/a                 | n/a                 |           | 00-00-00 |
| Squash Blocks    | Valid           |                     |                     |           |          |

### Bearing Supports

|               | Dim. (L x W)    | Demand    | Demand/Resistance Support | Demand/Resistance Member | Material        |
|---------------|-----------------|-----------|---------------------------|--------------------------|-----------------|
| B0 Wall/Plate | 3-1/2" x 3-1/2" | 4,002 lbs | 53.1%                     | 26.8%                    | Spruce Pine Fir |
| B1 Wall/Plate | 3-1/2" x 3-1/2" | 1,154 lbs | 15.3%                     | 7.7%                     | Spruce Pine Fir |

### Notes

Design meets Code minimum (L/240) Total load deflection criteria.

Design meets Code minimum (L/360) Live load deflection criteria.

Design meets User specified (1") Maximum Total load deflection criteria.

Calculations assume member is fully braced.

Resistance Factor phi has been applied to all presented results per CSA O86.

BC CALCO® analysis is based on Canadian Limit States Design, as per NBCC 2010 and CSA O86.

Design based on Dry Service Condition.

Importance Factor : Normal Part code : Part 4

Nail one ply to another with

3 1/2" spiral nails @ 12"

o.c. staggered in 2 rows






## BC CALC® Design Report

Dry | 1 span | No cantilevers | 0/12 slope (deg)

November 19, 2017 08:23:51

Build 6080  
 Job Name: 45147 (4001)  
 Address: Pine Valley  
 City, Province, Postal Code: Vaughan, ON  
 Customer: Gold Park  
 Code reports: CCMC 12472-R

File Name: 290675.bcc  
 Description: First Floor Framing  
 Specifier:  
 Designer: NL  
 Company: Alpa Roof Trusses  
 Misc:

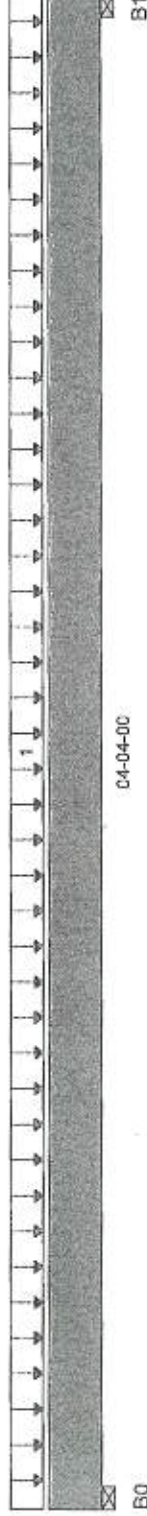

Total Horizontal Product Length = 04-04-00

## Reaction Summary (Down / Uplift) (lbs)

| Bearing    | Live    | Dead    | Snow | Wind |
|------------|---------|---------|------|------|
| B0, 3-1/2" | 520 / 0 | 205 / 0 |      |      |
| B1, 3-1/2" | 520 / 0 | 205 / 0 |      |      |

## Load Summary

| Tag Description | Load Type          | Ref. | Start    | End      | Live | Dead | Snow | Wind | Trib.    |
|-----------------|--------------------|------|----------|----------|------|------|------|------|----------|
| 1               | Unf. Area (lb/ft²) | L    | 00-00-00 | 04-04-00 | 40   | 15   | 1.00 | 1.15 | 06-00-00 |

## Controls Summary

|                  | Factored Demand | Factored Resistance | Demand / Resistance | Load Case | Location |
|------------------|-----------------|---------------------|---------------------|-----------|----------|
| Pos. Moment      | 898 ft-lbs      | 11,610 ft-lbs       | 7.7%                | 1         | 02-02-00 |
| End Shear        | 518 lbs         | 5,785 lbs           | 9%                  | 1         | 01-01-00 |
| Total Load Defl. | L/999 (0.007")  | n/a                 | n/a                 | 4         | 02-02-00 |
| Live Load Defl.  | L/999 (0.005")  | n/a                 | n/a                 | 5         | 02-02-00 |
| Max Defl.        | 0.007"          | n/a                 | n/a                 | 4         | 02-02-00 |
| Span / Depth     | 4.9             | n/a                 | n/a                 |           | 00-00-00 |
| Squash Blocks    | Valid           |                     |                     |           |          |

## Disclosure

Completeness and accuracy of input must be verified by anyone who would rely on output as evidence of suitability for particular application. Output here based on building code-accepted design properties and analysis methods. Installation of Boise Cascade engineered wood products must be in accordance with current Installation Guide and applicable building codes. To obtain Installation Guide or ask questions, please call 1-800-964-6999 before installation.

## Bearing Supports

|               | Dim. (L x W)    | Demand    | Demand / Resistance Support | Resistance Member | Material        |
|---------------|-----------------|-----------|-----------------------------|-------------------|-----------------|
| B0 Wall/Plate | 3-1/2" x 1-3/4" | 1,037 lbs | 27.5%                       | 13.9%             | Spruce Pine Fir |
| B1 Wall/Plate | 3-1/2" x 1-3/4" | 1,037 lbs | 27.5%                       | 13.9%             | Spruce Pine Fir |

## Notes

Design meets Code minimum (L/240) Total load deflection criteria.  
 Design meets Code minimum (L/360) Live load deflection criteria.  
 Design meets User specified (1") Maximum Total load deflection criteria.  
 Calculations assume member is fully braced.  
 Resistance Factor phi has been applied to all presented results per CSA O86.  
 BC CALC® analysis is based on Canadian Limit States Design, as per NBCC 2010 and CSA O86.

Design based on Dry Service Condition.  
 Importance Factor : Normal Part code : Part 4





Boise Cascade

## Single 1-3/4" x 9-1/2" VERSA-LAM® 2.0 3100 SP

Floor Beam\B15


Dry | 1 span | No cantilevers | 0/12 slope (deg)

November 19, 2017 08:23:51

## BC CALC® Design Report

Build 6080  
 Job Name: 45147 (4001)  
 Address: Pine Valley  
 City, Province, Postal Code: Vaughan, ON  
 Customer: Gold Park  
 Code reports: CCMC 12472-R

File Name: 290675.bcc  
 Description: First Floor Framing  
 Specifier:  
 Designer: NL  
 Company: Alpa Roof Trusses  
 Misc:

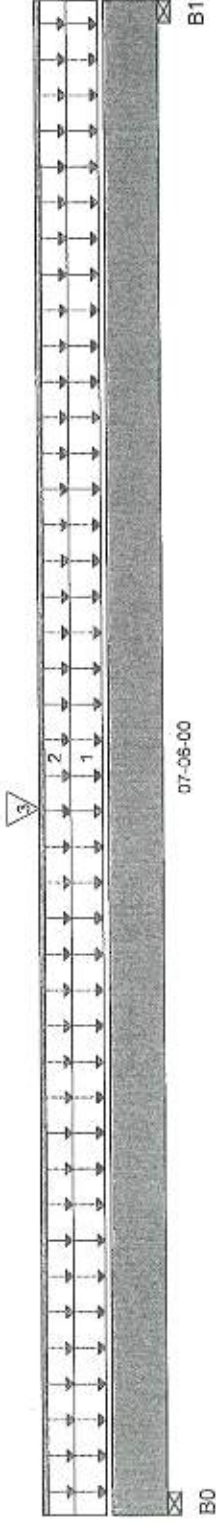

Total Horizontal Product Length = 07-06-00

## Reaction Summary (Down / Uplift) (lbs)

| Bearing    | Live    | Dead    | Snow | Wind |
|------------|---------|---------|------|------|
| B0, 3-1/2" | 749 / 0 | 726 / 0 |      |      |
| B1, 3-1/2" | 725 / 0 | 699 / 0 |      |      |

## Load Summary

| Tag | Description | Load Type                       | Ref. | Start    | End      | Live | Dead | Snow | Wind | Trib.    |
|-----|-------------|---------------------------------|------|----------|----------|------|------|------|------|----------|
| 1   |             | Unf. Area (lb/ft <sup>2</sup> ) | L    | 00-00-00 | 07-06-00 | 40   | 20   |      |      | 03-09-00 |
| 2   |             | Unf. Lin. (lb/ft)               | L    | 00-00-00 | 07-06-00 |      | 60   |      |      | n/a      |
| 3   |             | Conc. Plt. (lbs)                | L    | 03-06-00 | 03-06-00 | 349  | 377  |      |      | n/a      |

## Controls Summary

|                  |                |               |       |   |          |
|------------------|----------------|---------------|-------|---|----------|
| Pos. Moment      | 4,208 ft-lbs   | 11,610 ft-lbs | 36.2% | 1 | 03-06-00 |
| End Shear        | 1,599 lbs      | 5,785 lbs     | 27.6% | 1 | 01-01-00 |
| Total Load Defl. | L/999 (0.1")   | n/a           | n/a   | 4 | 03-08-03 |
| Live Load Defl.  | L/999 (0.051") | n/a           | n/a   | 5 | 03-08-03 |
| Max Defl.        | 0.1"           | n/a           | n/a   | 4 | 03-08-03 |
| Span / Depth     | 8.9            | n/a           | n/a   |   | 00-00-00 |
| Squash Blocks    | Valid          |               |       |   |          |

## Disclosure

Completeness and accuracy of input must be verified by anyone who would rely on output as evidence of suitability for particular application. Output here based on building code-accepted design properties and analysis methods. Installation of Boise Cascade engineered wood products must be in accordance with current Installation Guide and applicable building codes. To obtain Installation Guide or ask questions, please call 1-800-964-6999 before installation.

| Bearing Supports | Dim. (L x W)    | Demand    | Demand / Resistance Support | Resistance Member | Material        |
|------------------|-----------------|-----------|-----------------------------|-------------------|-----------------|
| B0 Wall/Plate    | 3-1/2" x 1-3/4" | 2,032 lbs | 53.9%                       | 27.2%             | Spruce Pine Fir |
| B1 Wall/Plate    | 3-1/2" x 1-3/4" | 1,961 lbs | 52%                         | 26.2%             | Spruce Pine Fir |

## Notes

Design meets Code minimum (L/240) Total load deflection criteria.  
 Design meets Code minimum (L/360) Live load deflection criteria.  
 Design meets User specified (1") Maximum Total load deflection criteria.  
 Calculations assume member is fully braced.  
 Resistance Factor phi has been applied to all presented results per CSA O86.  
 BC CALC® analysis is based on Canadian Limit States Design, as per NBCC 2010 and CSA O86.  
 Design based on Dry Service Condition.  
 Importance Factor : Normal Part code : Part 4

BC CALC® BC FRAMER®, AJST™, ALJOIST®, BC RIM BOARD™, BCI®, BOISE GLULAM™, SIMPLE FRAMING SYSTEM®, VERSA-LAM®, VERSA-RIM PLUS®, VERSA-RIM®, VERSA-STRAND®, VERSA-STUD® are trademarks of Boise Cascade Wood Products L.L.C.





Boise Cascade

## Single 1-3/4" x 9-1/2" VERSA-LAM® 2.0 3100 SP

Floor Beam/B16



BC CALC® Design Report

Dry | 1 span | No cantilevers | 0/12 slope (deg)

November 19, 2017 08:23:52

Build 6080

Job Name: 45147 (4001)

Address: Pine Valley

City, Province, Postal Code: Vaughan, ON

Customer: Gold Park

Code reports: CCMC 12472-R

File Name: 290675.bcc


Description: First Floor Framing

Specifier:

Designer: NL

Company: Alpa Roof Trusses

Misc:

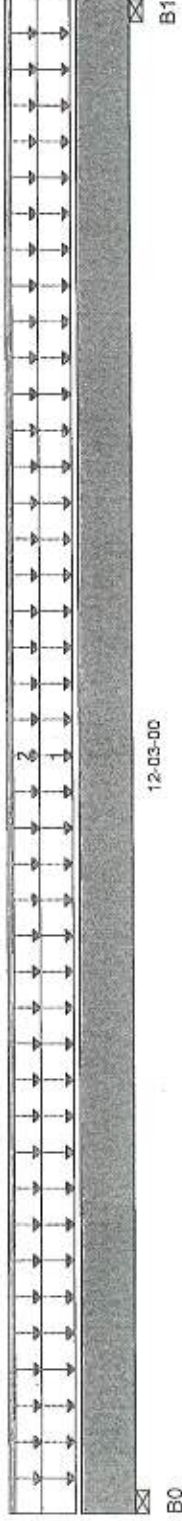

## Reaction Summary (Down / Uplift) (lbs)


## Load Summary

| Tag Description | Load Type          | Ref. | Start    | End      | Live | Dead | Snow | Wind | Trib.    |
|-----------------|--------------------|------|----------|----------|------|------|------|------|----------|
| 1               | Unf. Area (lb/ft²) | L    | 00-00-00 | 12-03-00 | 40   | 20   |      |      | 03-03-00 |
| 2               | Unf. Lin. (lb/ft)  | L    | 00-00-00 | 12-03-00 | 60   |      |      |      | n/a      |

## Controls Summary

| Pos.             | Factored Demand | Factored Resistance | Demand / Resistance | Load Case | Location |
|------------------|-----------------|---------------------|---------------------|-----------|----------|
| Pos. Moment      | 6,209 ft-lbs    | 11,610 ft-lbs       | 53.5%               | 1         | 06-01-08 |
| End Shear        | 1,801 lbs       | 5,785 lbs           | 31.1%               | 1         | 01-01-00 |
| Total Load Defl. | L/313 (0.452")  | 0.59"               | 76.7%               | 4         | 06-01-08 |
| Live Load Defl.  | L/626 (0.226")  | 0.393"              | 57.5%               | 5         | 06-01-08 |
| Max Defl.        | 0.452"          | 1"                  | 45.2%               | 4         | 06-01-08 |
| Span / Depth     | 14.9            | n/a                 | n/a                 |           | 00-00-00 |
| Squash Blocks    | Valid           |                     |                     |           |          |

## Disclosure

Completeness and accuracy of input must be verified by anyone who would rely on output as evidence of suitability for particular application. Output here based on building code-accepted design properties and analysis methods. Installation of Boise Cascade engineered wood products must be in accordance with current Installation Guide and applicable building codes. To obtain Installation Guide or ask questions, please call 1-800-964-6999 before installation.

## Bearing Supports

|               | Dim. (L x W)    | Demand    | Demand/Resistance Support | Resistance Member | Material        |
|---------------|-----------------|-----------|---------------------------|-------------------|-----------------|
| B0 Wall/Plate | 3-1/2" x 1-3/4" | 2,188 lbs | 58.1%                     | 29.3%             | Spruce Pine Fir |
| B1 Wall/Plate | 3-1/2" x 1-3/4" | 2,188 lbs | 58.1%                     | 29.3%             | Spruce Pine Fir |

## Notes

Design meets Code minimum (L/240) Total load deflection criteria.  
 Design meets Code minimum (L/360) Live load deflection criteria.  
 Design meets User specified (1") Maximum Total load deflection criteria.  
 Calculations assume member is fully braced.  
 Resistance Factor phi has been applied to all presented results per CSA O86.  
 BC CALC® analysis is based on Canadian Limit States Design, as per NBCC 2010 and CSA O86.  
 Design based on Dry Service Condition.  
 Importance Factor : Normal Part code : Part 4



BC CALC®, BC FRAMER®, AJST®, ALLJOIST®, BC RIM BOARD™, BCI®, BOISE GLULAM™, SIMPLE FRAMING SYSTEM®, VERSA-LAM®, VERSA-RIM PLUS®, VERSA-RIM®, VERSA-STRAND®, VERSA-STUD® are trademarks of Boise Cascade Wood Products L.L.C.

COMPANY PROJECT  
Nov. 17, 2017 15:39 45°47'(2001)  
Gold Park  
Dine Valley, Vaughan  
2-Nr 20-0131 *beside stair*

### Loads:

| Seed   | Type | Distribution | Per-<br>cent | Location [ft] | Magnitude | Dist |
|--------|------|--------------|--------------|---------------|-----------|------|
|        |      |              |              | Start         | Start     | End  |
| Seed1  | Dead | Full Area    |              |               | 30.00     | End  |
| Seed2  | Live | Full Area    |              |               | 40.00     | End  |
| Seed3  | Dead | Full Area    |              |               | 40.00     | End  |
| Seed4  | Dead | Full Area    |              | 3.92          | 1.89      | End  |
| Seed5  | Dead | Full Area    |              | 3.92          | 1.89      | End  |
## Maximum Reactions (lbs), Bearing Resistances (lbs) and Bearing Lengths (in) :

|                |       |       |  |
|----------------|-------|-------|--|
| Unfactored:    | 31"   | 32.1  |  |
| Dead           | 3.0   | 30.8  |  |
| Live           | 3.0   | 30.8  |  |
| Factored:      |       |       |  |
| Total          | 9.0   | 106.7 |  |
| Bearing:       |       |       |  |
| Resistance     |       |       |  |
| JOIST          | 300   | 3200  |  |
| SUPPORT        | 340   | 3400  |  |
| RESISTANCE     |       |       |  |
| JOIST          | 0.70  | 0.73  |  |
| SUPPORT        | 0.8   | 0.8   |  |
| Load case      | 42    | 42    |  |
| Length         | 1-3/4 | 1-3/4 |  |
| Min req'd      | 1-3/4 | 1-3/4 |  |
| Stiffener      | No    | No    |  |
| K <sub>2</sub> | 1.00  | 1.00  |  |
| KB support     | 1.00  | 768   |  |
| cap sup        | 768   | 1.00  |  |



## Limit States Design using CSA C85-14 and Vibration Criteria;


[illegible]

**Design Notes:**

1. Where the analysis and design are in accordance with the 2010 National Building Code of Canada (NBC Part 4) and the CSA O86-14 Engineering Design In Wood standard (May 2014 edition).
2. Where the analysis and design are in accordance with the 2010 National Building Code of Canada (NBC Part 4) and the CSA O86-14 Engineering Design In Wood standard (May 2014 edition).
3. Please verify that the default deflection limits are appropriate for your application.
4. Refer to technical documentation for installation guidelines and construction details.
5. Nordic Joists are listed in CCMC evaluation report 13032-R.
6. Joists shall be laterally supported at supports and continuously along the compression edge.
7. The design assumptions and specifications have been provided by the client. Any damages resulting from faulty or incorrect information, specifications, and/or design are furnished, and the correctness or accuracy of this information is not warranted. The design engineer assumes no responsibility for the structural adequacy of this component.
8. This analysis does not constitute a record of the structural integrity of the building nor suitability of the design assumptions made. Nordic Structures is responsible only for the structural adequacy of this component based on the design criteria and loadings shown.

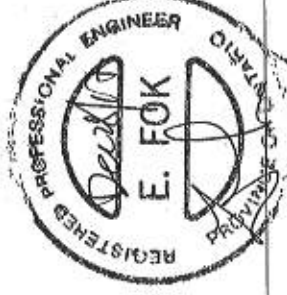

2262515

