



CONSTRUCTION SUMMARY

Lot: 150
Model: 40.00 A BRIARWOOD
Project/Phase: Pine Valley Forevergreen / 1

CONCRETE AND DRAIN

Invoice	Qty.	Description
2304 32699 23Apr20 NoCat	1	BACK-FLOW PREVENTER VALVE CONCRETE AND DRAIN

WINDOWS - BASEMENT

Invoice	Qty.	Description
2304 32698 23Apr20	4	BASEMENT WINDOWS - UPGRADE BASEMENT WINDOW SIZE TO 30 " X 24" - 8" FRAME WINDOWS - BASEMENT72,351WINDOWS - BASEMENT
2304 32698 23Apr20	4	BASEMENT WINDOWS - UPGRADE BASEMENT WINDOW SIZE TO 30 " X 24" - 8" FRAME WINDOWS - BASEMENT72,351WINDOWS - BASEMENT

This Document is Extremely Time Sensitive - Printed 23 Apr 20 at 10:06




SCHEDULE 'F'

PL-150
APRIL 22 2020

The Briarwood

40' SERIES

→ Elevation A • 2,870 sq.ft.
Elevation B • 2,860 sq.ft.

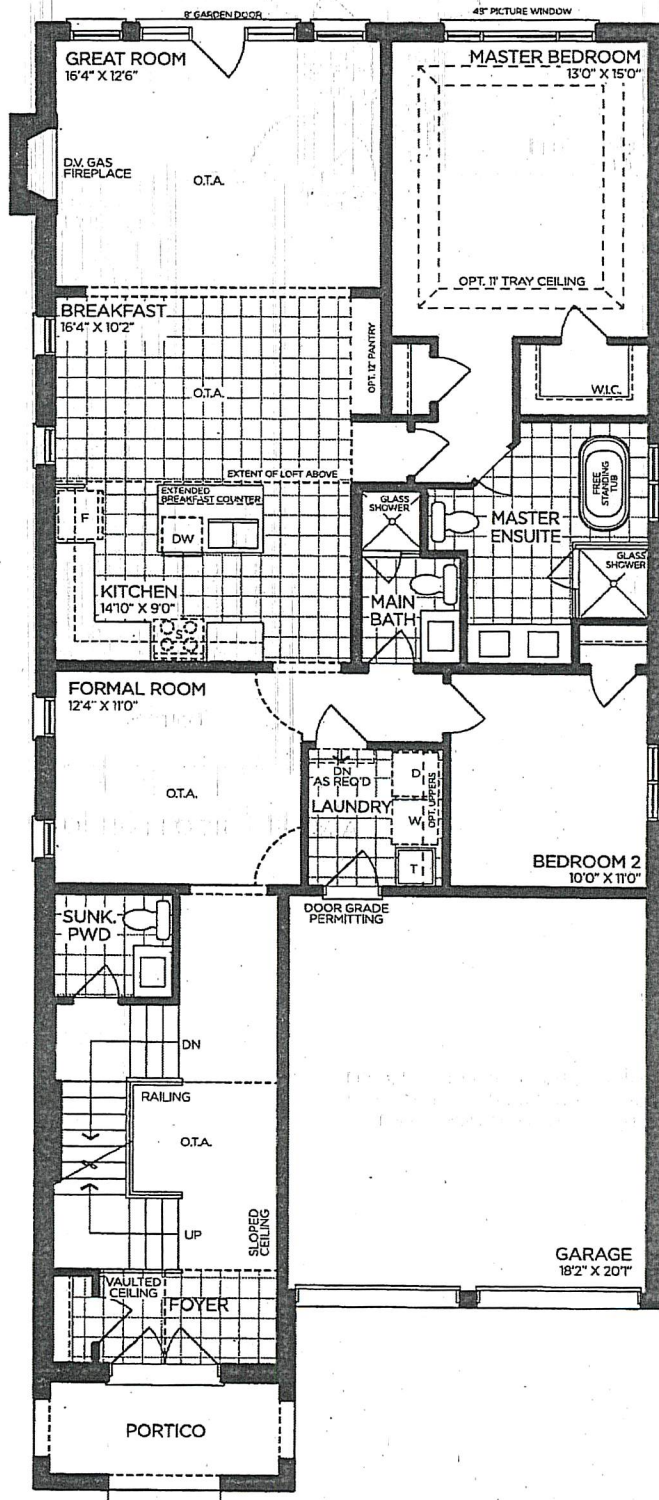

GROUND FLOOR | ELEV. A

VENDOR	
PURCHASER	
PURCHASER	

GOLDPARK

WORTH MORE™

Prices, figures, illustrations, sizes, features and finishes are subject to change without notice. Areas and dimensions are approximate and actual usable floor space may vary from the stated area. Layout may be reverse of the unit purchased. E. & O.E. 4000




SCHEDULE 'F'

PV-150 *sec 21.204*
APRIL 22 2023

The Briarwood

40' SERIES

→ Elevation A • 2,870 sq.ft.
Elevation B • 2,860 sq.ft.

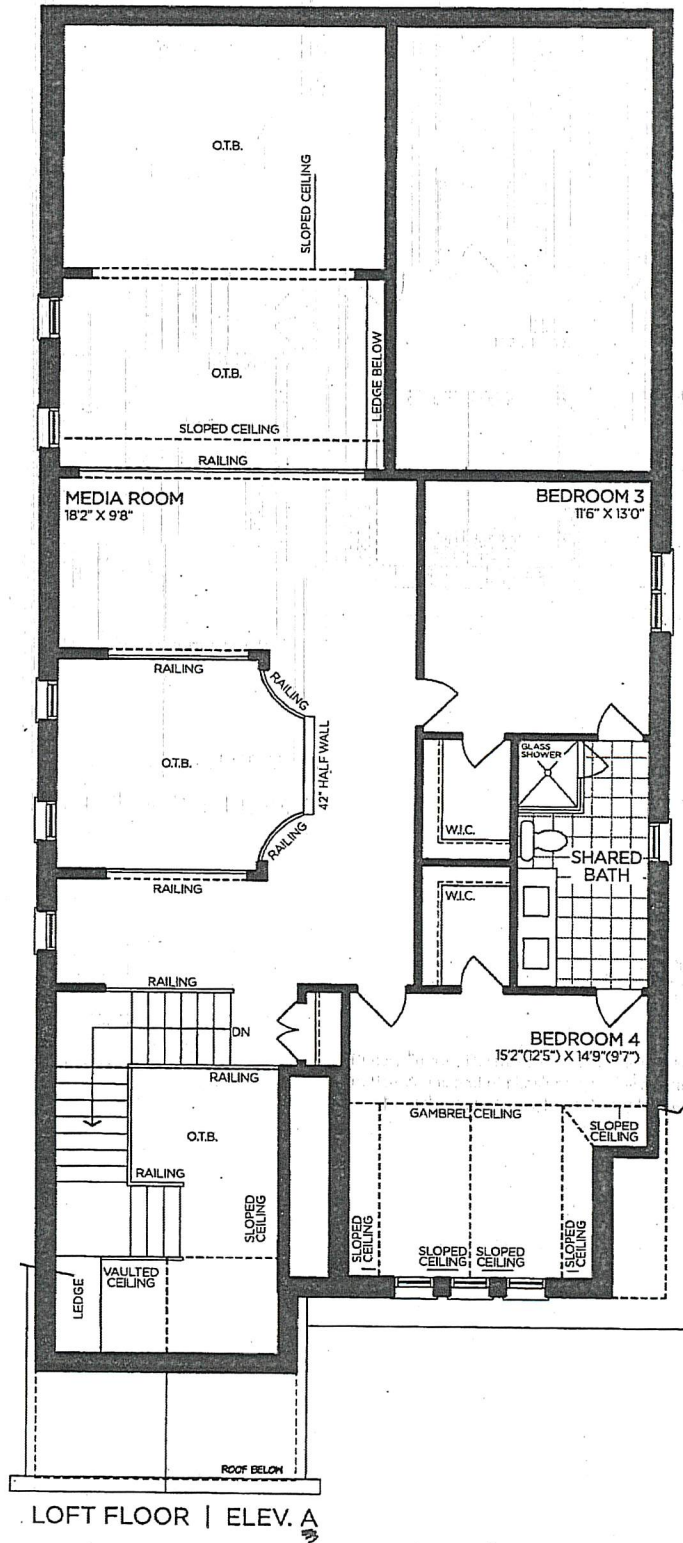

VENDOR	
PURCHASER	
PURCHASER	

GOLDPARK
WORTH MORE™

Prices, figures, illustrations, sizes, features and finishes are subject to change without notice. Areas and dimensions are approximate and actual usable floor space may vary from the stated area. Layout may be reverse of the unit purchased. E. & O.E. 4000

SCHEDULE 'F'




PV-150
APRIL 22 2020


see 2/20/20

The Briarwood 40' SERIES


→ Elevation A • 2,870 sq.ft.
Elevation B • 2,860 sq.ft.

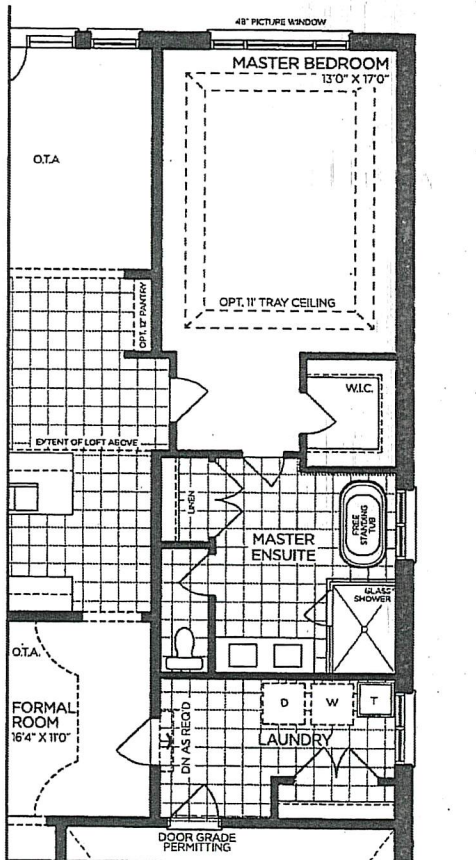


→ PART. OPT. GROUND FLOOR | ELEV. A
(ELEV. B SIMILAR)

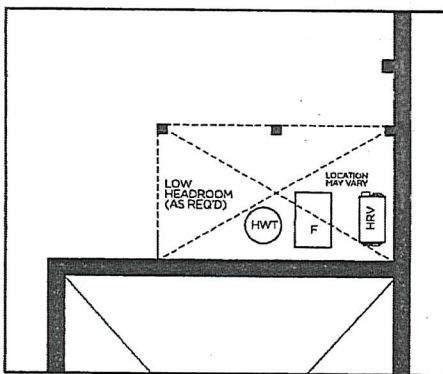

→ PART. BASEMENT | ELEV. A

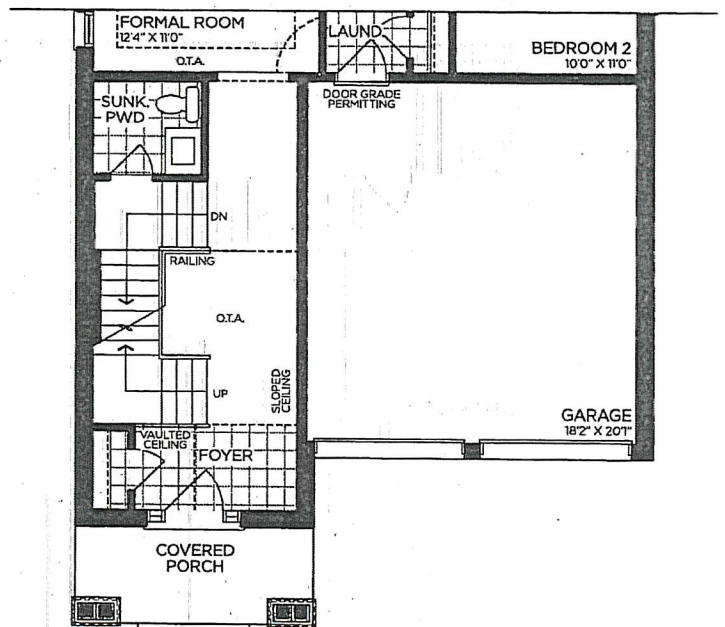

PART. GROUND FLOOR | ELEV. B

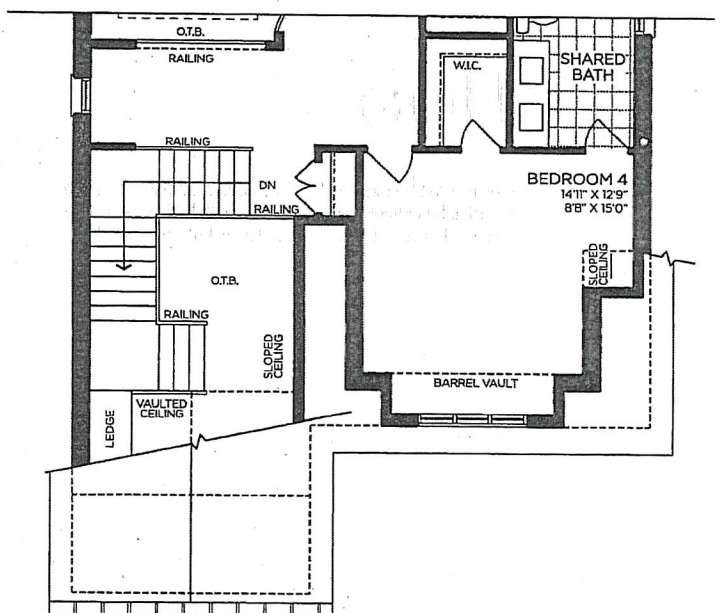

PART. LOFT FLOOR | ELEV. B

VENDOR
PURCHASER
PURCHASER

GOLDPARK
WORTH MORE™

Prices, figures, illustrations, sizes, features and finishes are subject to change without notice. Areas and dimensions are approximate and actual usable floor space may vary from the stated area. Layout may be reverse of the unit purchased. E. & O.E. 4000

SCHEDULE 'F'




PV-150
April 22 2020

see sketch

The Briarwood

40' SERIES

→ Elevation A • 2,870 sq.ft.
Elevation B • 2,860 sq.ft.

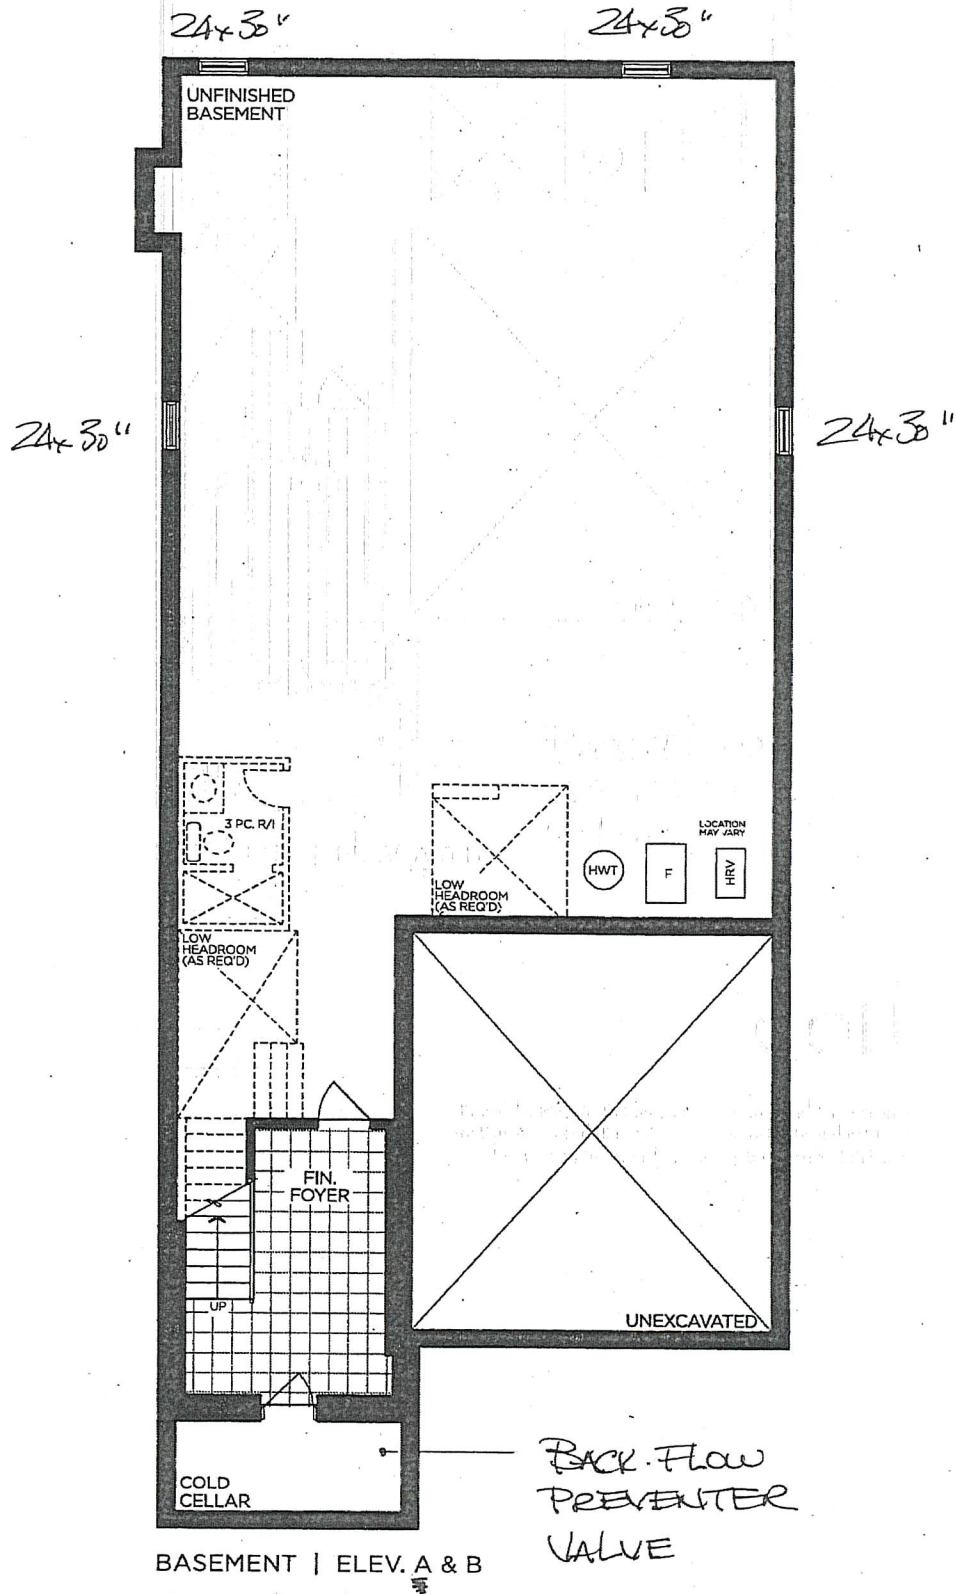

VENDOR

PURCHASER

PURCHASER

GOLDPARK

WORTH MORE™


Prices, figures, illustrations, sizes, features and finishes are subject to change without notice. Areas and dimensions are approximate and actual usable floor space may vary from the stated area. Layout may be reverse of the unit purchased. E. & O.E. 4000



SCHEDULE 'F'

PL-156
APRIL 22 2020

The
Briarwood
40' SERIES
→ Elevation A • 2,870 sq.ft.
Elevation B • 2,860 sq.ft.

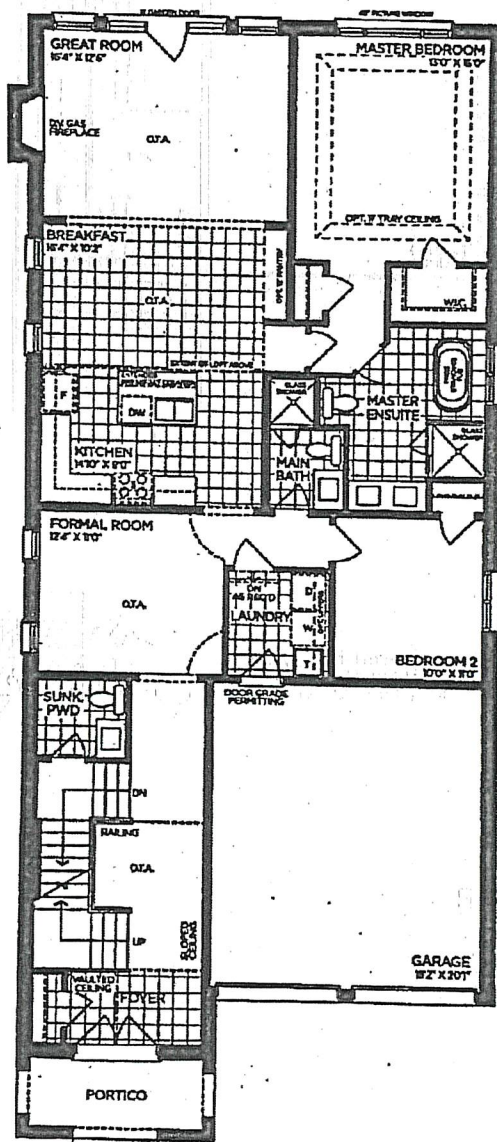

GROUND FLOOR | ELEV. A

VENDOR
PURCHASER
PURCHASER

GOLDPARK
WORTH MORE™

Prices, figures, illustrations, sizes, features and finishes are subject to change without notice. Areas and dimensions are approximate and actual usable floor space may vary from the stated area. Layout may be reverse of the unit purchased. E. & O.E. 4000




SCHEDULE 'F'

PV-150
APRIL 22 2023

[Handwritten initials]

The
Briarwood
40' SERIES
→ Elevation A • 2,870 sq.ft.
Elevation B • 2,860 sq.ft.

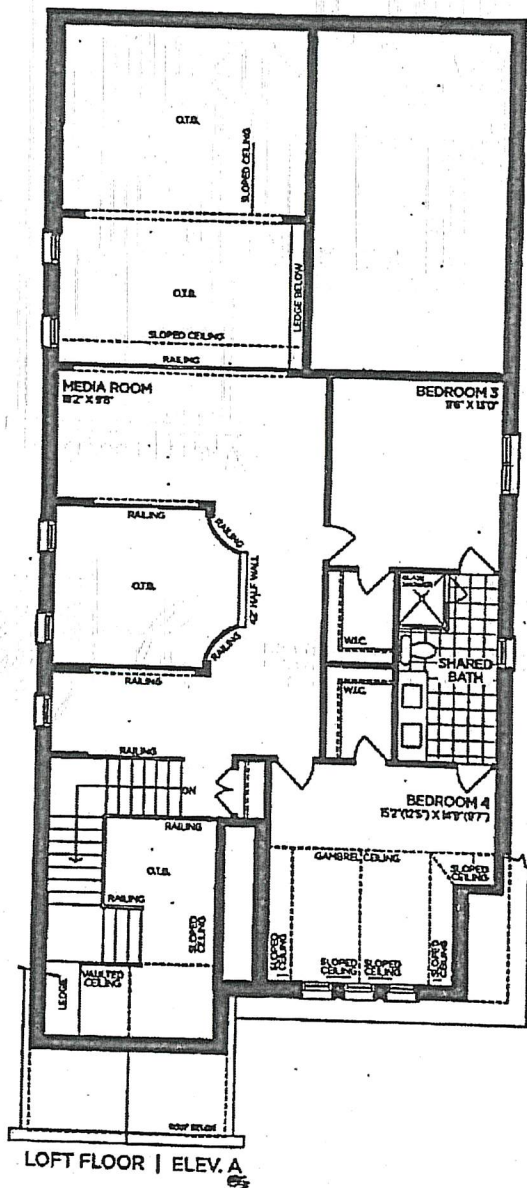

VENDOR _____
PURCHASER *[Signature]*
PURCHASER *[Signature]*

GOLDPARK
WORTH MORE™

Prices, figures, illustrations, sizes, features and finishes are subject to change without notice. Areas and dimensions are approximate and actual usable floor space may vary from the stated area. Layout may be reverse of the unit purchased. E. & O.E. 4000





SCHEDULE 'F'



PV-150
APRIL 22 2022



The
Briarwood
40' SERIES
→ Elevation A • 2,870 sq.ft.
Elevation B • 2,860 sq.ft.

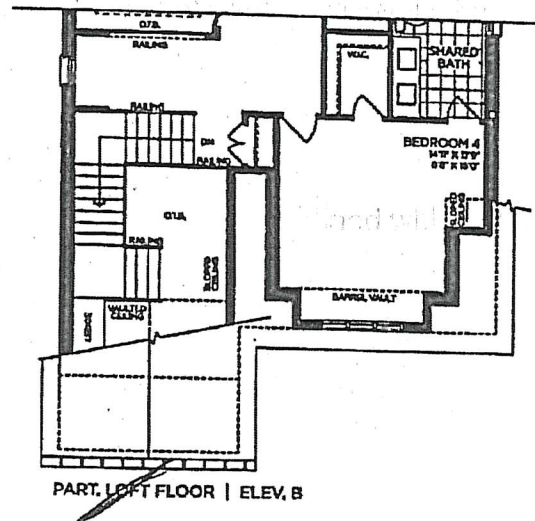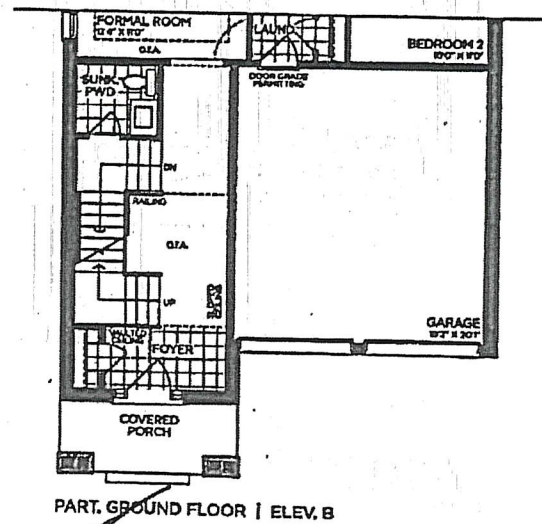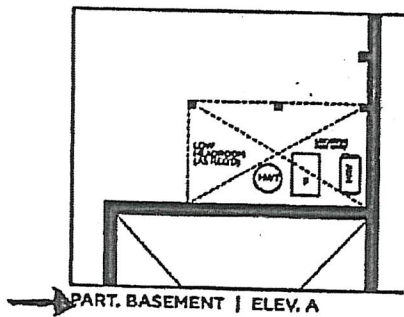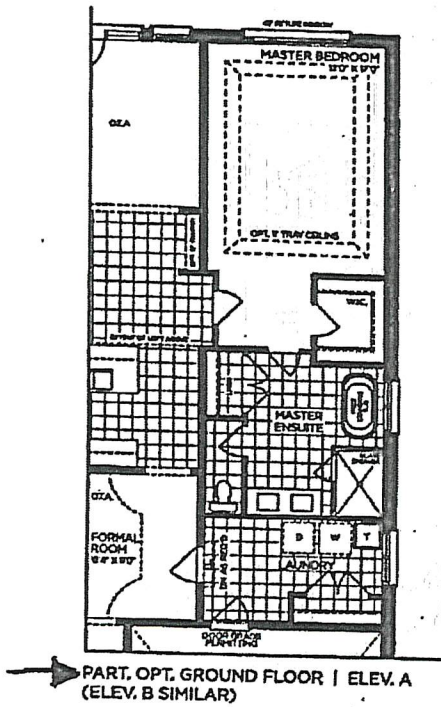

VENDOR
PURCHASER *O. D. D. D.*
PURCHASER *A. D. D. D.*

GOLDPARK
WORTH MORE™


Prices, figures, illustrations, sizes, features and finishes are subject to change without notice. Areas and dimensions are approximate and actual usable floor space may vary from the stated area. Layout may be reverse of the unit purchased. E. & Q.E. 4000



SCHEDULE 'F'

PV-150
APRIL 22 2020

The
Briarwood
40' SERIES
Elevation A • 2,870 sq.ft.
Elevation B • 2,860 sq.ft.

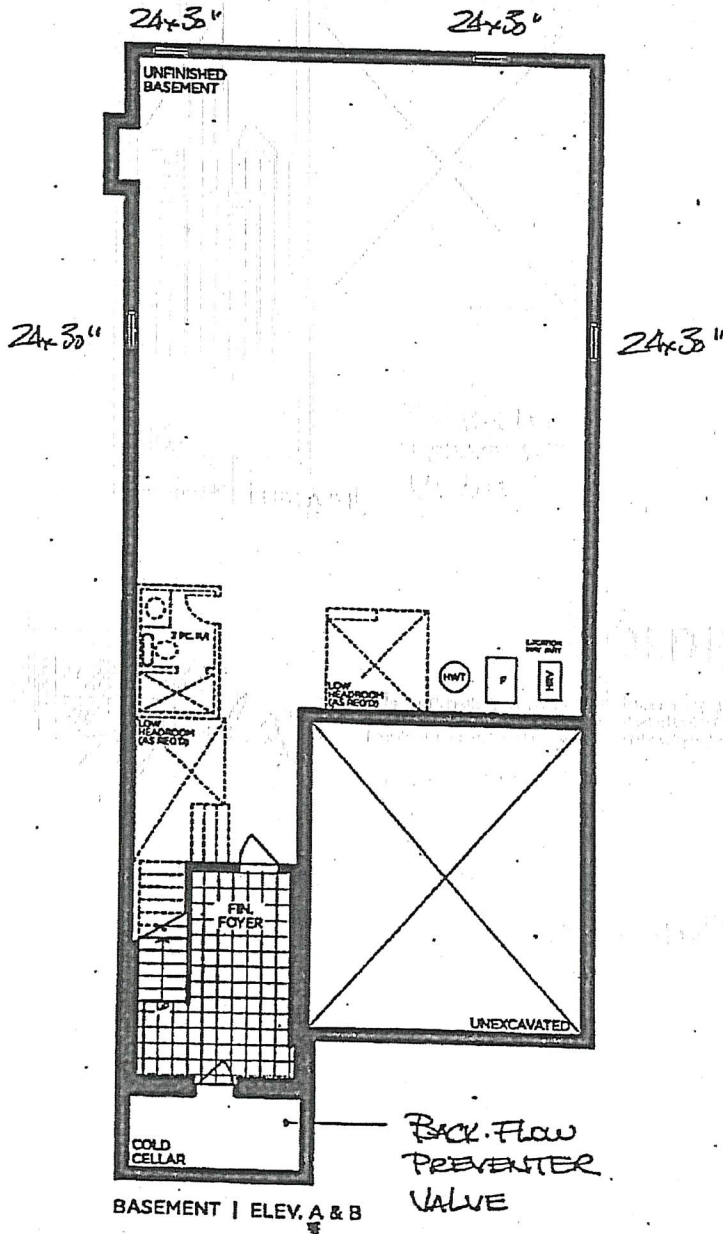

VENDOR .
PURCHASER *O. M. W. W. W.*
PURCHASER *A. D. F. F. F.*

GOLDPARK
WORTH MORE

Prices, figures, illustrations, sizes, features and finishes are subject to change without notice. Areas and dimensions are approximate and actual usable floor space may vary from the stated area. Layout may be reverse of the unit purchased. E & C.E. 4000