

GOLDPARK

WORTH MORE™

CONSTRUCTION SUMMARY

Lot: 98

Model: 50.05 B KNIGHTSWOOD

Project/Phase: Pine Valley Forevergreen / 1

CONCRETE AND DRAIN

Invoice	Qty.	Description
1969 31696 30Apr20 NoCat	1	BACK-FLOW PREVENTER VALVE CONCRETE AND DRAIN

FORM - FORMING

Invoice	Qty.	Description
1969 31697 30Apr20 **	1	KITCHEN REAR - OPT. COVERED LOGGIA AS PER PLAN MODEL OPTIONS 50.0572,579FORM - FORMING

FORMING

Invoice	Qty.	Description
1969 31698 30Apr20 NoCat	1	OPTIONAL COLD CELLAR (OPTIONAL COVERED LOGGIA MUST BE PURCHASED) FORMING
1969 32010 30Apr20 NoCat	1	***CUSTOM REVISION*** CREATE APPROX. 10' BASEMENT CEILING HEIGHT BELOW CABANA. DROP BASEMENT FLOOR BENEATH CABANA AREA APPROX. 1'-0" TO ALLOW FOR APPROX. 10' HEAD HEIGHT OF CLEARANCE. SEE PLAN FOR LOCATION FORMING
1969 32947 30Apr20 NoCat	1	OPTIONAL ELEVATOR: PANORAMA TYPE B SIZE: APPROX 40X52.5"D FORMING Elevator with approx. cab size 40"W x 52" D x 84"H servicing 4 stops (3 floors) and having a rear opening for garage. Elevator to come equipped with automatic bi-fold entry gates at front and rear. Elevator to have a load capacity of 1000lb.

WINDOWS - BASEMENT

Invoice	Qty.	Description
1969 31711 30Apr20	4	BASEMENT WINDOWS - UPGRADE BASEMENT WINDOW SIZE TO 30 " X 24" - 10" FRAME (PINEVALLEY 50 FOOT LOTS ONLY) WINDOWS - BASEMENT72,675WINDOWS - BASEMENT

This Document is Extremely Time Sensitive - Printed 30 Apr 20 at 8:48


SCHEDULE 'F'



The
Knightswood
50' SERIES

PV-98
APRIL 29, 2020
See attached
See attached

Elevation A • 4,445 sq.ft.
4,475 sq.ft. Opt. Elevator / 4,575 sq.ft. Opt. Service Stairs
→ Elevation B • 4,440 sq.ft.
4,475 sq.ft. Opt. Elevator / 4,575 sq.ft. Opt. Service Stairs
Elevation C • 4,525 sq.ft.
4,560 sq.ft. Opt. Elevator / 4,660 sq.ft. Opt. Service Stairs

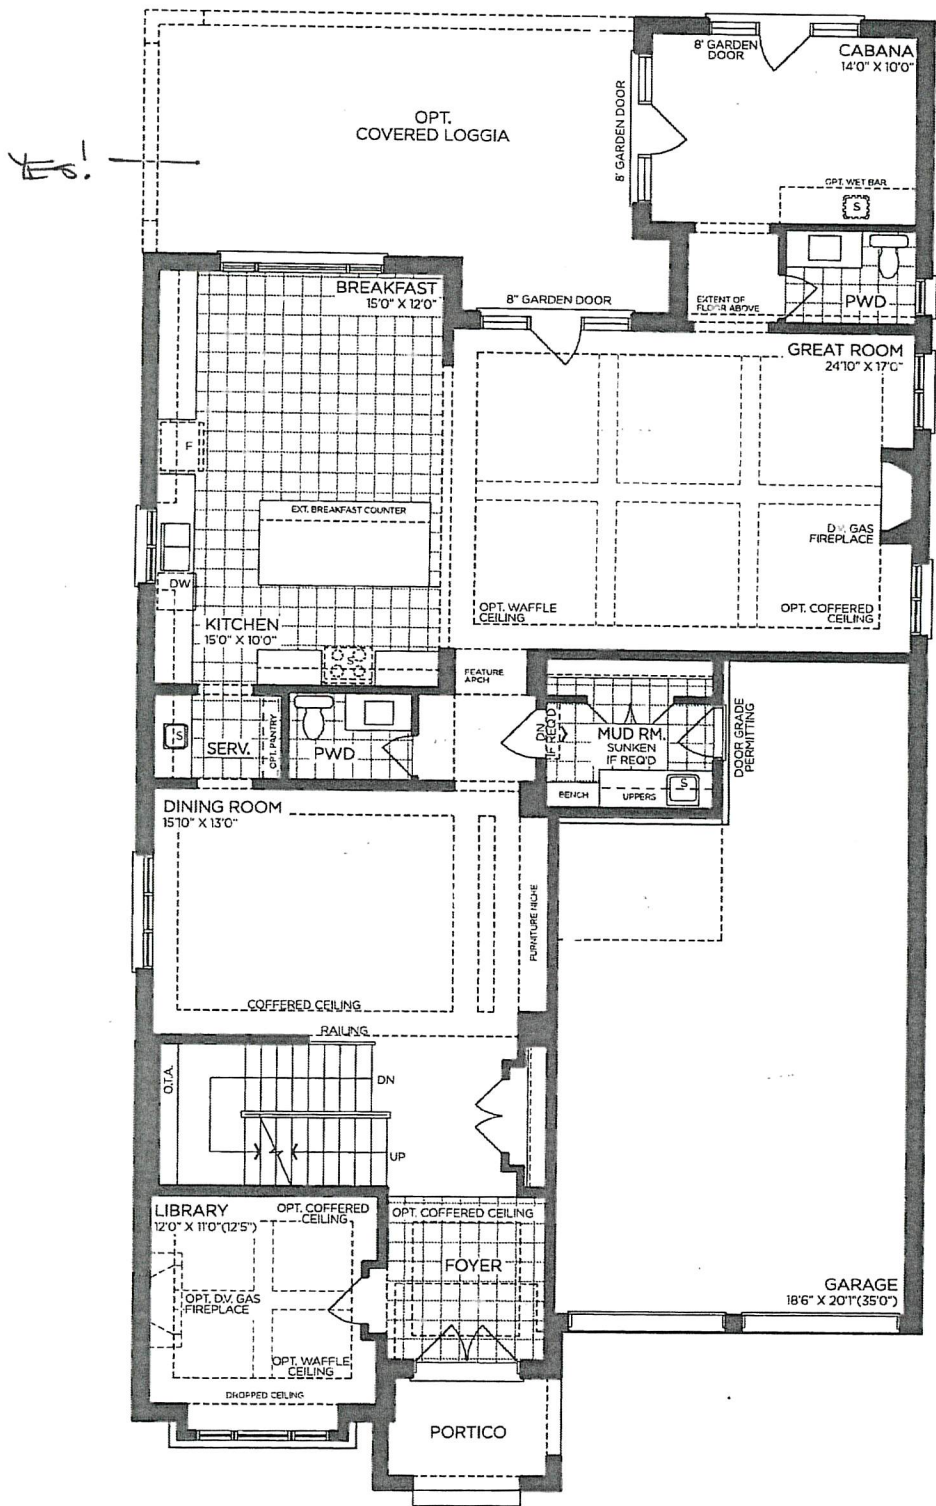

GROUND FLOOR | ELEV. A

VENDOR

PURCHASER

PURCHASER

GOLDPARK
WORTH MORE™

Prices, figures, illustrations, sizes, features and finishes are subject to change without notice. Areas and dimensions are approximate and actual usable floor space may vary from the stated area. Layout may be reverse of the unit purchased. E. & O.E. 5005


SCHEDULE 'F'



PV-98
APRIL 29, 2020
See attached

The Knightswood 50' SERIES

Elevation A • 4,445 sq.ft.
4,475 sq.ft. Opt. Elevator / 4,575 sq.ft. Opt. Service Stairs
→ Elevation B • 4,440 sq.ft.
4,475 sq.ft. Opt. Elevator / 4,575 sq.ft. Opt. Service Stairs
Elevation C • 4,525 sq.ft.
4,560 sq.ft. Opt. Elevator / 4,660 sq.ft. Opt. Service Stairs

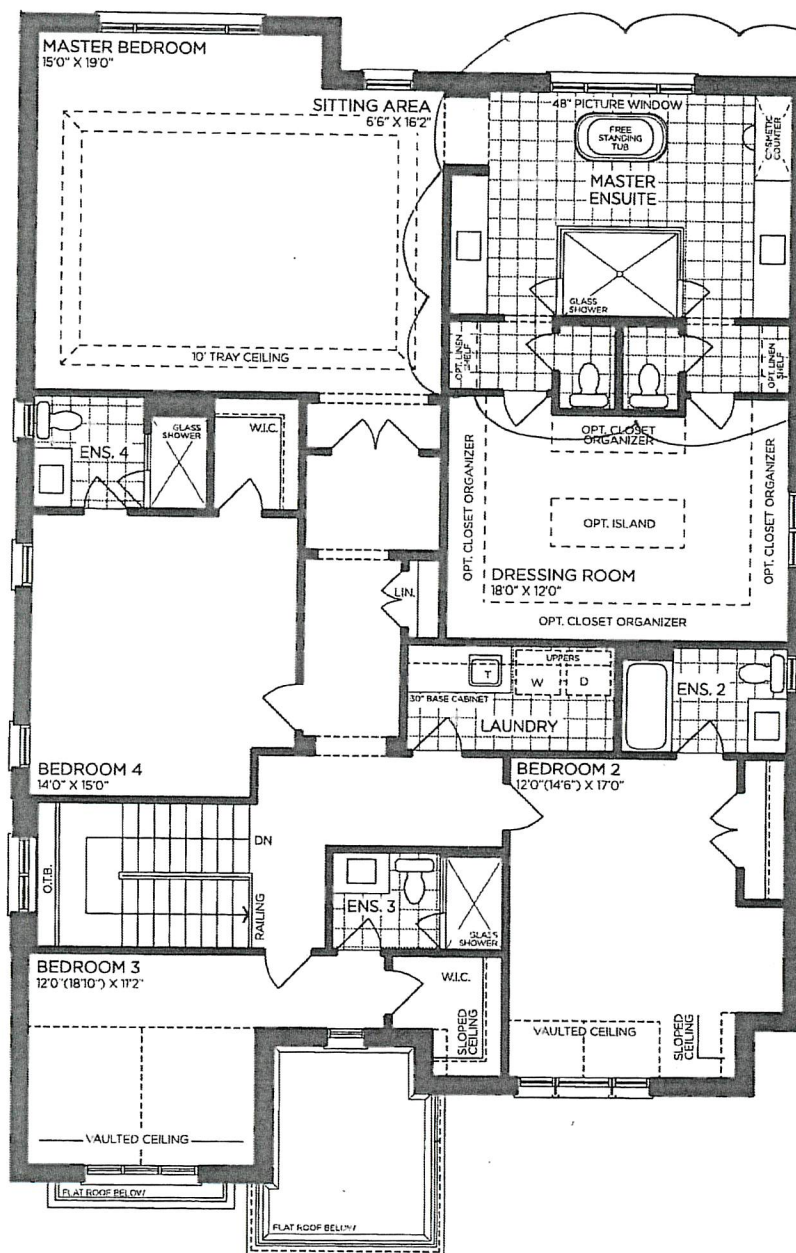

SECOND FLOOR | ELEV. A

VENDOR	
PURCHASER	
PURCHASER	

GOLDPARK
WORTH MORE™

Prices, figures, illustrations, sizes, features and finishes are subject to change without notice. Areas and dimensions are approximate and actual usable floor space may vary from the stated area. Layout may be reverse of the unit purchased. E. & O.E. 5005

SCHEDULE 'F'



AI-98 *Attached*
April 29 2020

The Knightswood

50' SERIES

Elevation A • 4,445 sq.ft.









4,475 sq.ft. Opt. Elevator / 4,575 sq.ft. Opt. Service Stairs

—Elevation B • 4,440 sq.ft.

4,475 sq.ft. Opt. Elevator / 4,575 sq.ft. Opt. Service Stairs

Elevation C • 4,525 sq.ft.

4,560 sq.ft. Opt. Elevator / 4,660 sq.ft. Opt. Service Stairs

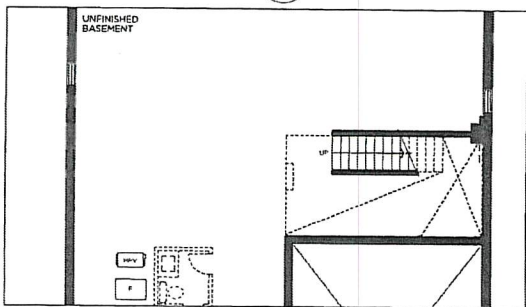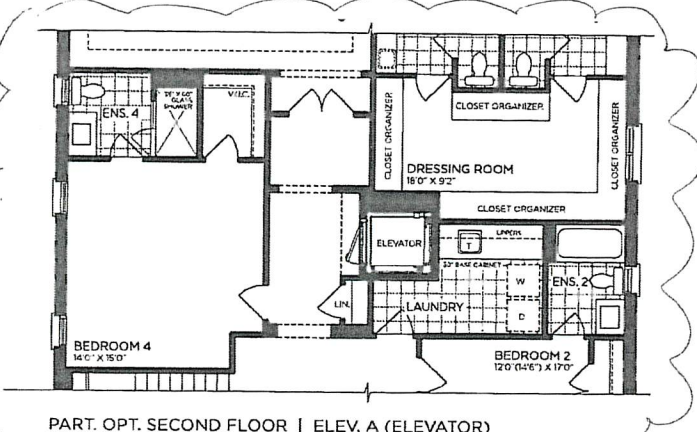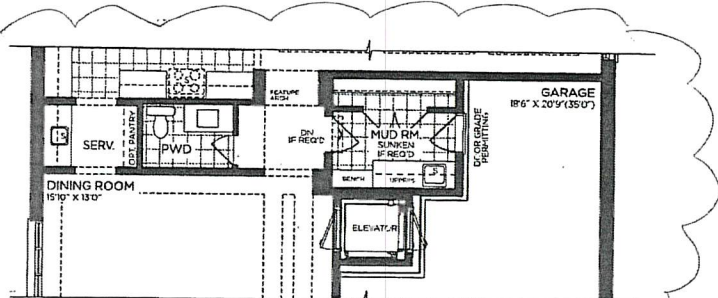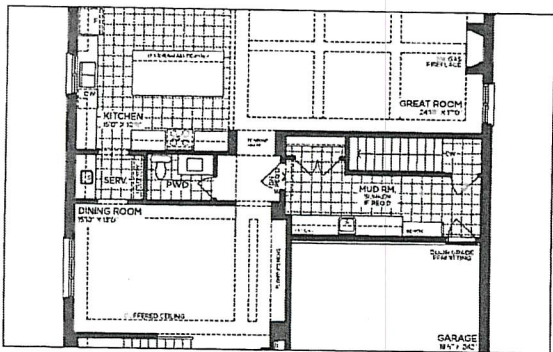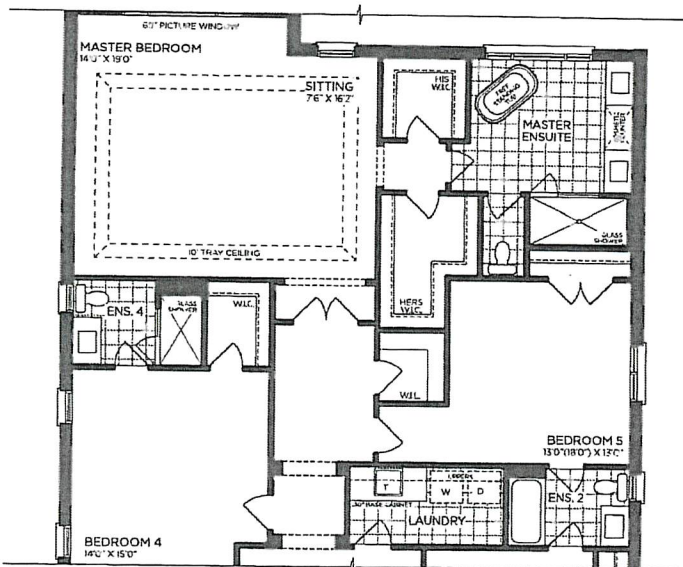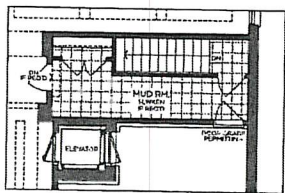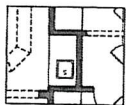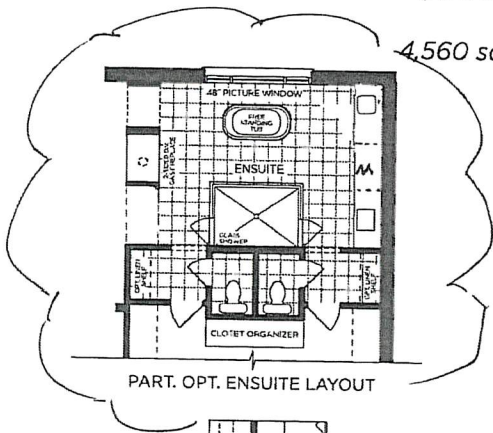

VENDOR

PURCHASER

PURCHASER

GOLDPARK
WORTH MORE™

Prices, figures, illustrations, sizes, features and finishes are subject to change without notice. Areas and dimensions are approximate and actual usable floor space may vary from the stated area. Layout may be reverse of the unit purchased. E. & O.E. 5005


SCHEDULE 'F'




PV-98
APRIL 29 2020
See attached

The Knightswood 50' SERIES


Elevation A • 4,445 sq.ft.
4,475 sq.ft. Opt. Elevator / 4,575 sq.ft. Opt. Service Stairs
→ Elevation B • 4,440 sq.ft.
4,475 sq.ft. Opt. Elevator / 4,575 sq.ft. Opt. Service Stairs
Elevation C • 4,525 sq.ft.
4,560 sq.ft. Opt. Elevator / 4,660 sq.ft. Opt. Service Stairs

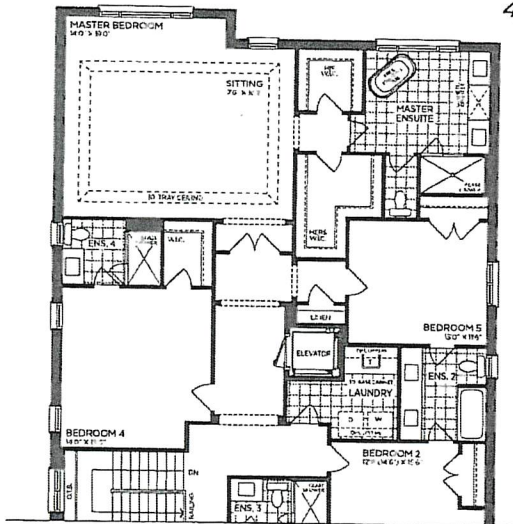


PART. OPT. SECOND FLOOR | ELEV. A (5 BEDROOMS - ELEVATOR)

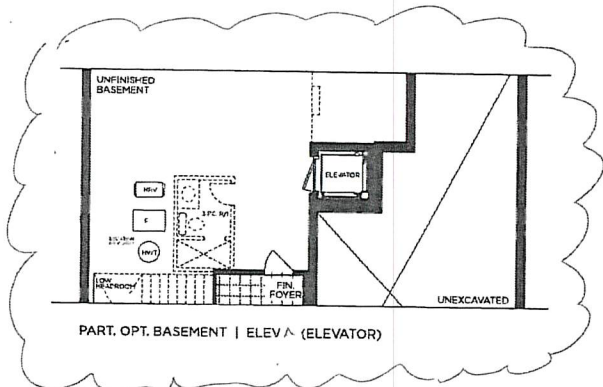


PART. OPT. BASEMENT | ELEV. A (ELEVATOR)

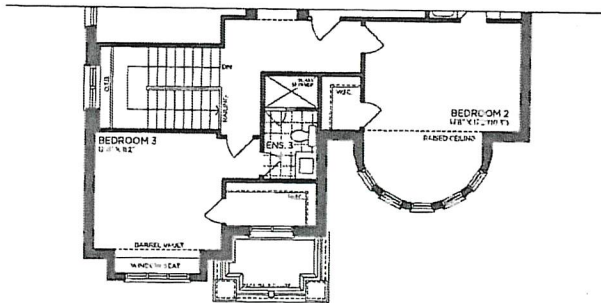


→ PART. SECOND FLOOR | ELEV. B

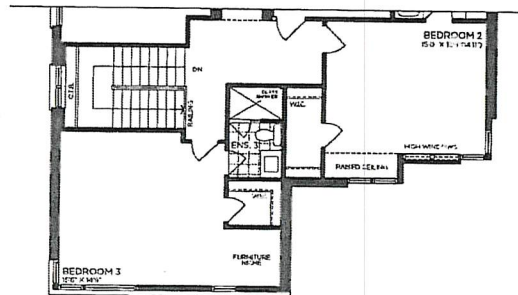


PART. SECOND FLOOR | ELEV. C

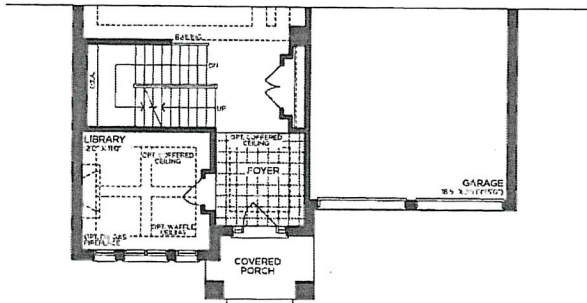


→ PART. GROUND FLOOR | ELEV. B

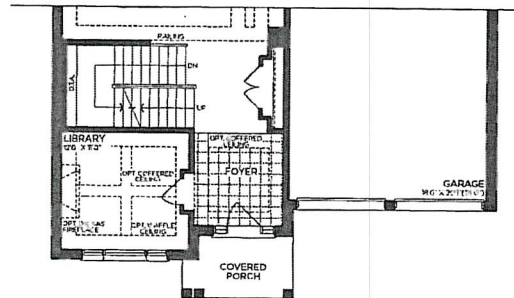

PART. GROUND FLOOR | ELEV. C

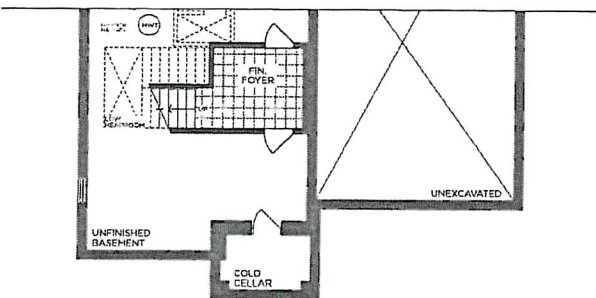

→ PART. BASEMENT | ELEV. B

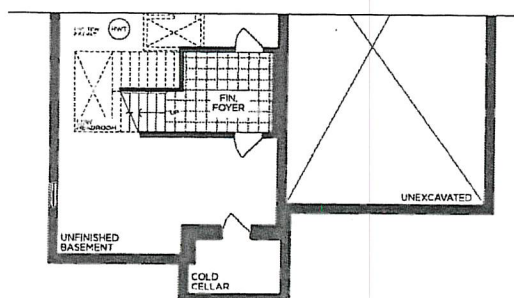

PART. BASEMENT | ELEV. C

VENDOR

PURCHASER

PURCHASER

GOLDPARK
WORTH MORE™

Prices, figures, illustrations, sizes, features and finishes are subject to change without notice. Areas and dimensions are approximate and actual usable floor space may vary from the stated area. Layout may be reverse of the unit purchased. E. & O.E. 5005

SCHEDULE 'F'



PV-082, ^{Per} attached
April 29, 2020

The Knightswood 50' SERIES

Elevation A • 4,445 sq.ft.


4,475 sq.ft. Opt. Elevator / 4,575 sq.ft. Opt. Service Stairs

→ Elevation B • 4,440 sq.ft.

4,475 sq.ft. Opt. Elevator / 4,575 sq.ft. Opt. Service Stairs

Elevation C • 4,525 sq.ft.

4,560 sq.ft. Opt. Elevator / 4,660 sq.ft. Opt. Service Stairs

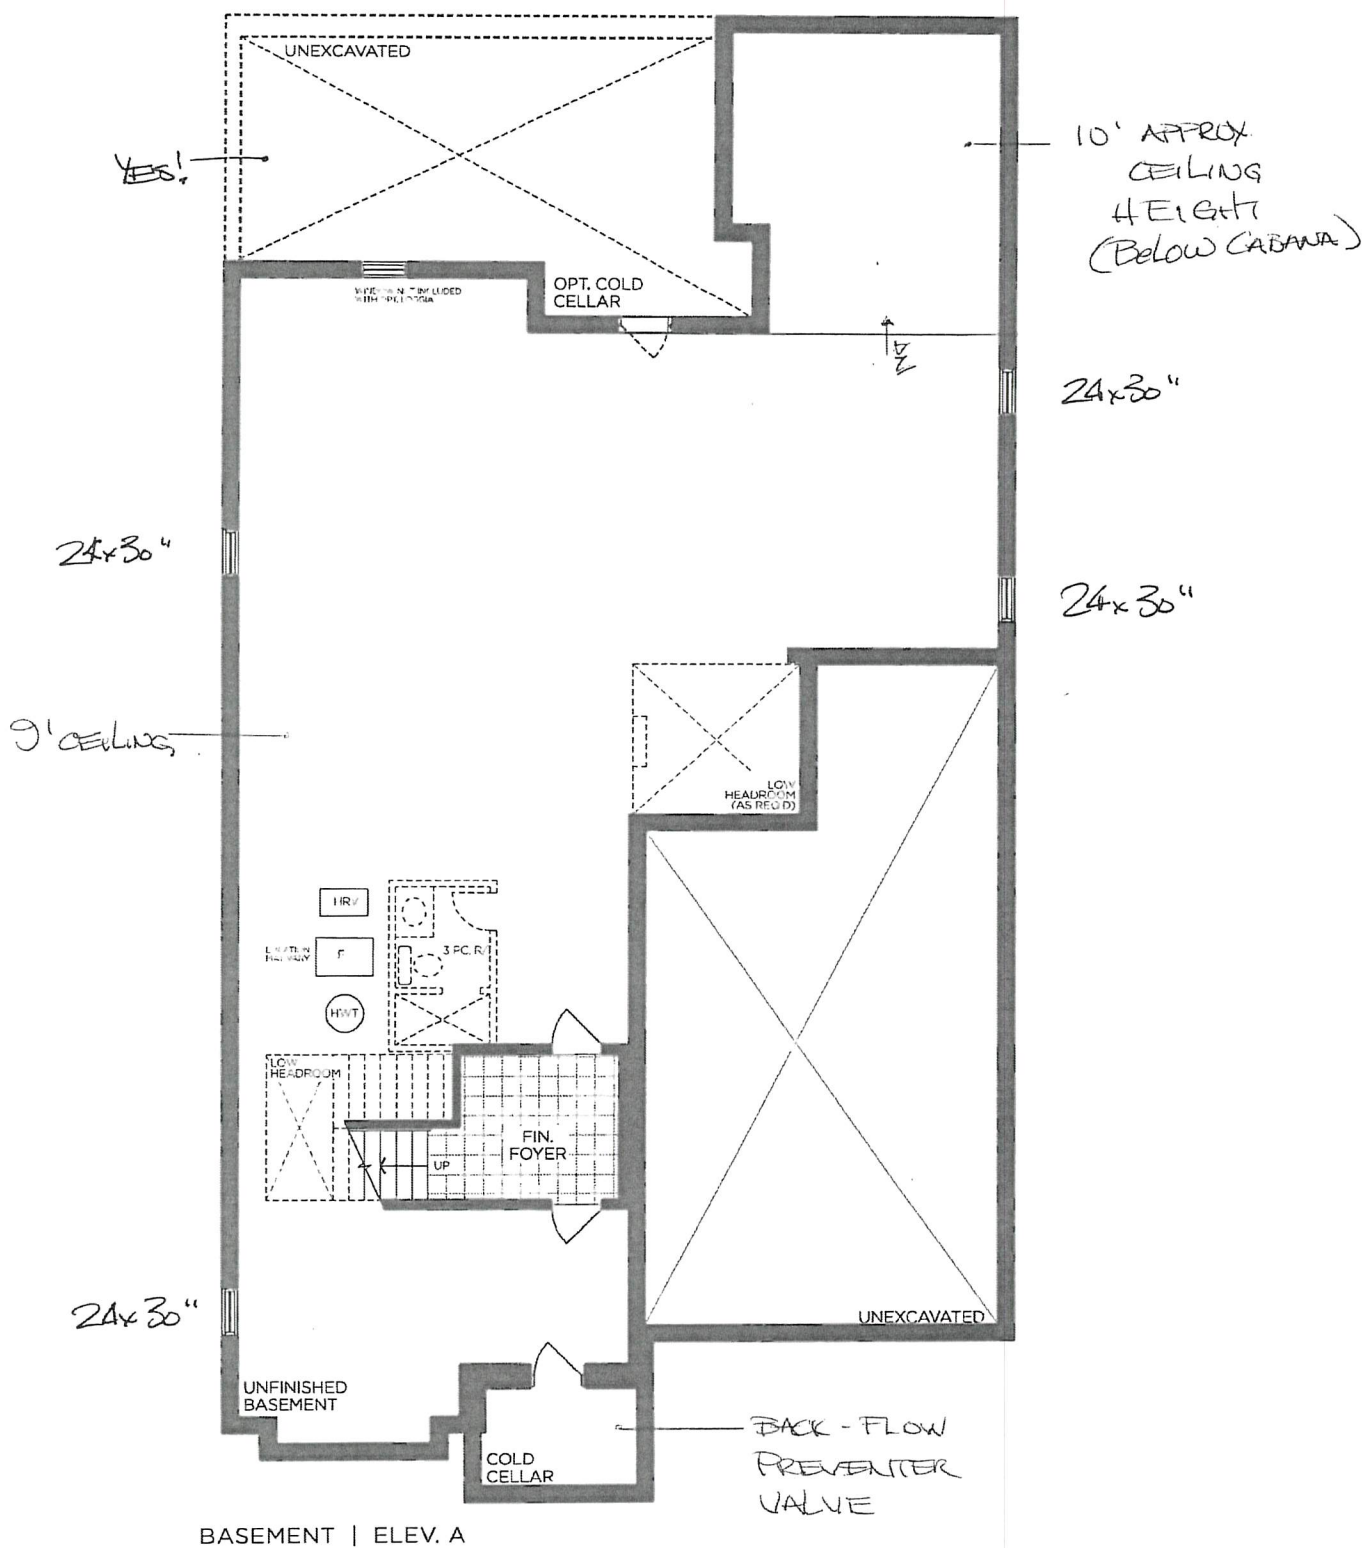

BASEMENT | ELEV. A

VENDOR

PURCHASER

PURCHASER

GOLDPARK
WORTH MORE™






WORTH MORE™

Prices, figures, illustrations, sizes, features and finishes are subject to change without notice. Areas and dimensions are approximate and actual usable floor space may vary from the stated area. Layout may be reverse of the unit purchased. E. & O.E. 5005



PINE VALLEY
FOREVERGREEN

ELEVATOR STANDARD

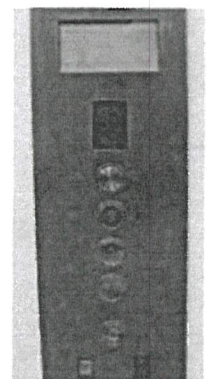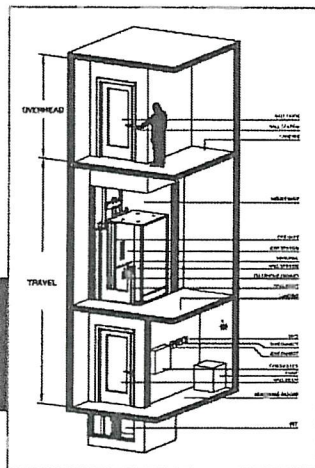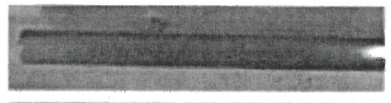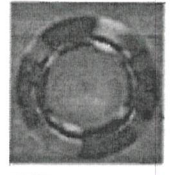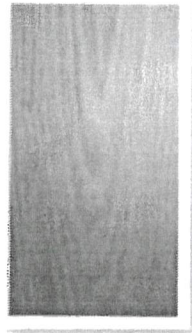

Standard Elevator Specs:

- WALL COVERING: Flat Oak
- CEILING PANEL: Same as wall covering / Flat Ceiling - 2 lights / LED Lighting 72mm Outside Diameter, Brushed Stainless Steel
- HANDRAIL: Round Stainless Steel
- DOOR/ENTRANCE: Automatic Bi-fold Door
- CONTROLS: Stainless Steel Rectangular Car Control Panel, Small Stainless Steel Rectangular Hall Station, Rectangular Phone Box (phone not included)

Lot#

88

Room:

(see attached plan)

Signature:

Date:

April 28 2020

Signature:

see attached

GOLDPARK
WORTH MORE


SCHEDULE 'F'



PN-98
APRIL 28, 2022

The
Knightswood
50' SERIES

Elevation A • 4,445 sq.ft.
4,475 sq.ft. Opt. Elevator / 4,575 sq.ft. Opt. Service Stairs
Elevation B • 4,440 sq.ft.
4,475 sq.ft. Opt. Elevator / 4,575 sq.ft. Opt. Service Stairs
Elevation C • 4,525 sq.ft.
4,560 sq.ft. Opt. Elevator / 4,660 sq.ft. Opt. Service Stairs

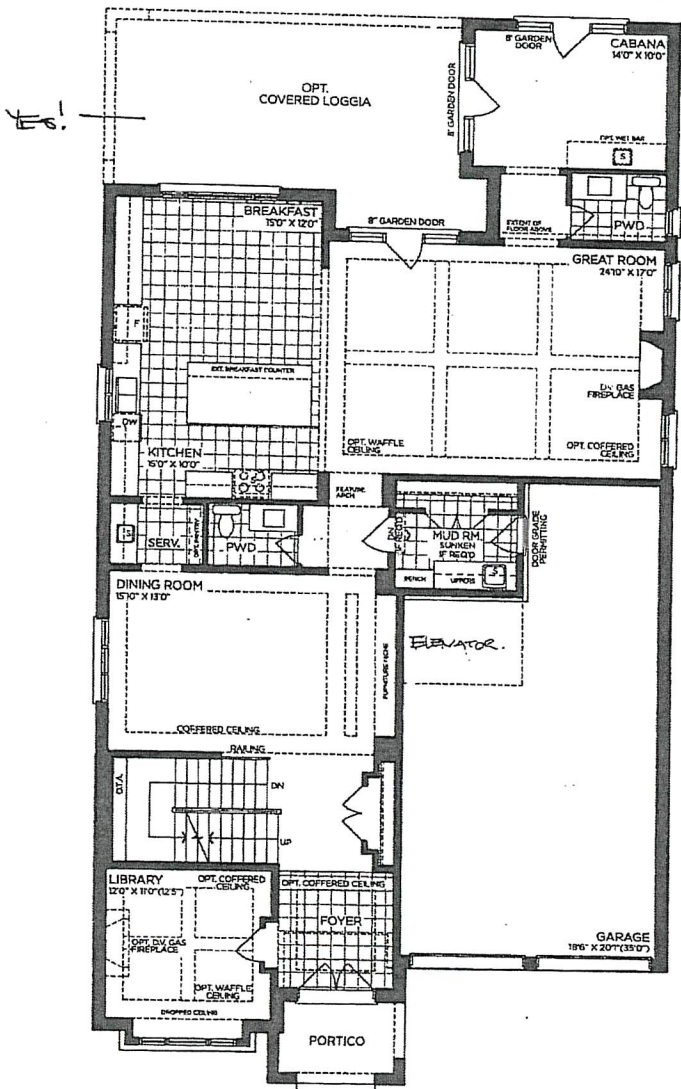

GROUND FLOOR | ELEV. A

VENDOR
PURCHASER
PURCHASER

GOLDPARK
WORTH MORE

Prices, figures, illustrations, sizes, features and finishes are subject to change without notice. Areas and dimensions are approximate and actual usable floor space may vary from the stated area. Layout may be reverse of the unit purchased. E. & O.E. 5005


SCHEDULE 'F'



PV-98
APRIL 28 2020

The
Knightswood
50' SERIES

Elevation A • 4,445 sq.ft.
4,475 sq.ft. Opt. Elevator / 4,575 sq.ft. Opt. Service Stairs
→ Elevation B • 4,440 sq.ft.
4,475 sq.ft. Opt. Elevator / 4,575 sq.ft. Opt. Service Stairs
Elevation C • 4,525 sq.ft.
4,560 sq.ft. Opt. Elevator / 4,660 sq.ft. Opt. Service Stairs

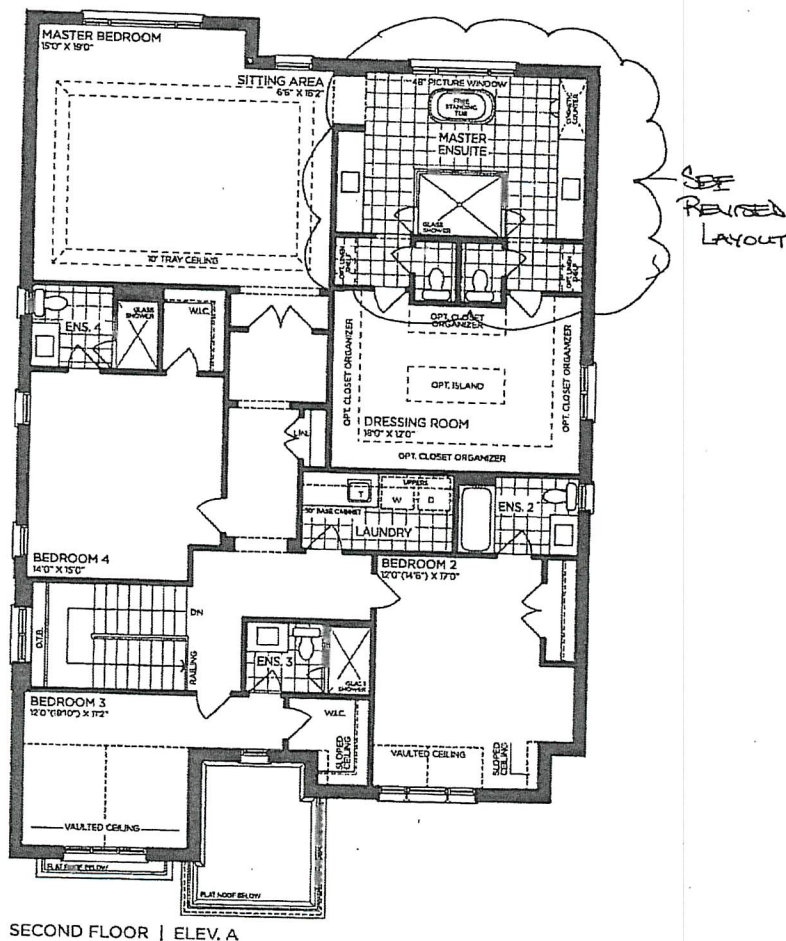

SECOND FLOOR | ELEV. A

VENDOR

PURCHASER

PURCHASER

GOLDPARK
WORTH MORE™

Prices, figures, illustrations, sizes, features and finishes are subject to change without notice. Areas and dimensions are approximate and actual usable floor space may vary from the stated area. Layout may be reverse of the unit purchased. E. & O.E. 5005


SCHEDULE 'F'



PI-0877
APRIL 28 2020

The Knightswood 50' SERIES


Elevation A • 4,445 sq.ft.
4,475 sq.ft. Opt. Elevator / 4,575 sq.ft. Opt. Service Stairs
Elevation B • 4,440 sq.ft.
4,475 sq.ft. Opt. Elevator / 4,575 sq.ft. Opt. Service Stairs
Elevation C • 4,525 sq.ft.
4,560 sq.ft. Opt. Elevator / 4,660 sq.ft. Opt. Service Stairs

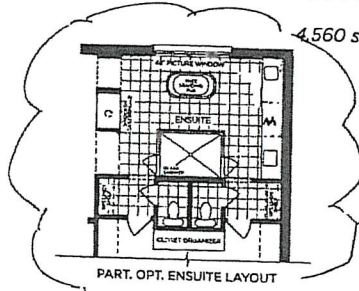


PART. OPT. ENSUITE LAYOUT




PART. OPT. WETBAR SITTING AREA

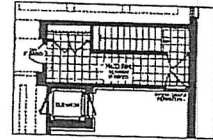


OPT. PART. GROUND FLOOR SERVICE STAIR W/ ELEVATOR | ELEV. A

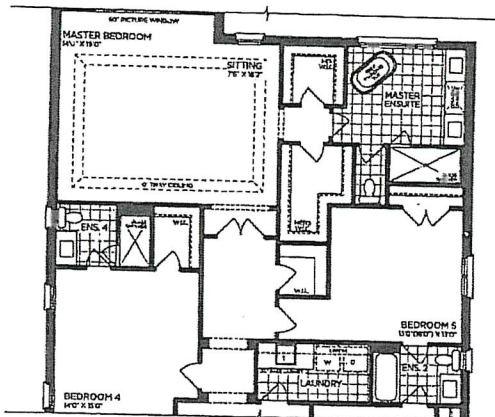


PART. OPT. SECOND FLOOR | ELEV. A (5 BEDROOMS)

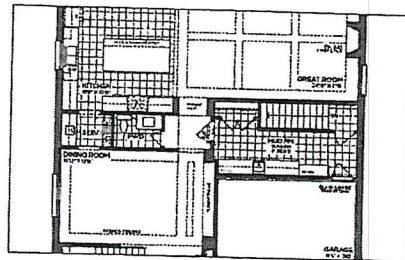


OPT. PART. GROUND FLOOR W/ SERVICE STAIR | ELEV. A

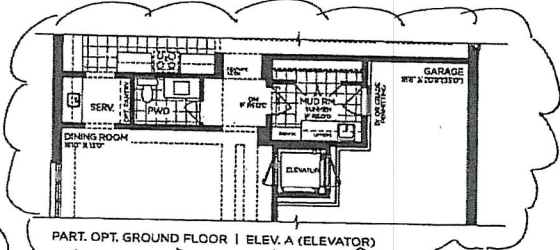

PART. OPT. GROUND FLOOR | ELEV. A (ELEVATOR)

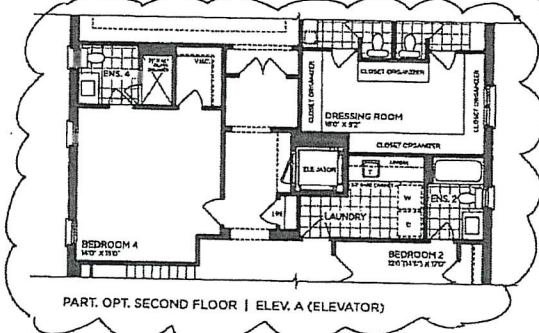

PART. OPT. SECOND FLOOR | ELEV. A (ELEVATOR)

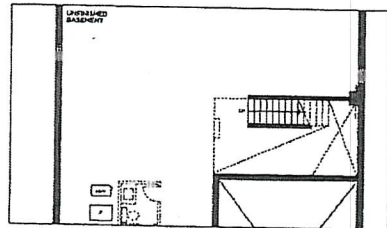

OPT. PART. BASEMENT W/ SERVICE STAIR | ELEV. A

VENDOR
PURCHASER
PURCHASER


GOLDPARK
WORTH MORE™

Prices, figures, illustrations, sizes, features and finishes are subject to change without notice. Areas and dimensions are approximate and actual usable floor space may vary from the stated area. Layout may be reverse of the unit purchased. E. & O.E. 5005











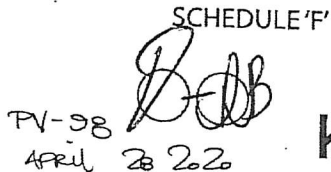

Elevation A • 4,445 sq.ft.
 4,475 sq.ft. Opt. Elevator / 4,575 sq.ft. Opt. Service Stairs
 → Elevation B • 4,440 sq.ft.
 4,475 sq.ft. Opt. Elevator / 4,575 sq.ft. Opt. Service Stairs
 Elevation C • 4,525 sq.ft.
 4,560 sq.ft. Opt. Elevator / 4,660 sq.ft. Opt. Service Stairs

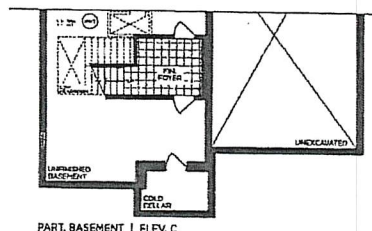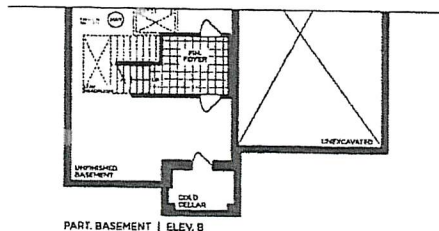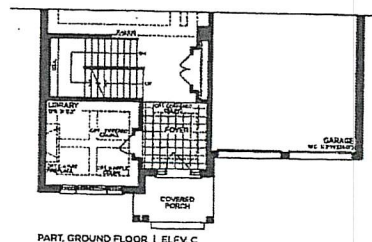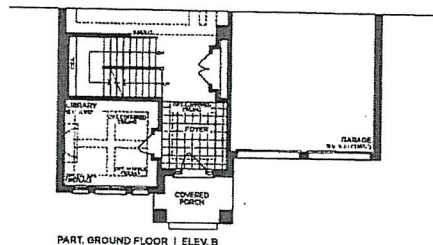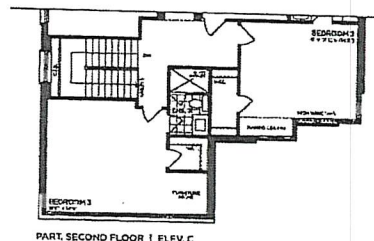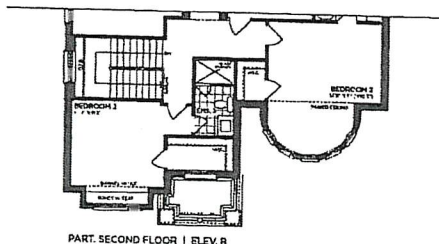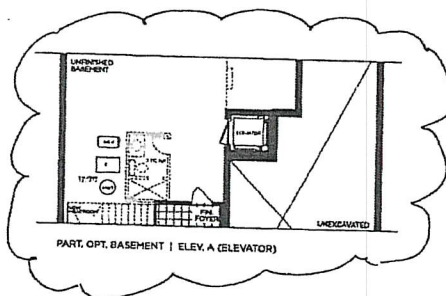

VENDOR _____
PURCHASER _____
PURCHASER _____

GOLDPARK
WORTH MORE

Prices, figures, illustrations, sizes, features and finishes are subject to change without notice. Areas and dimensions are approximate and actual usable floor space may vary from the stated area. Layout may be reverse of the unit purchased. E. & O.E. 5005

Purchase of the unit purchased. E. & O.E. 5005


SCHEDULE 'F'



PV-08
APRIL 28 2020

The
Knightswood
50' SERIES

Elevation A • 4,445 sq.ft.
4,475 sq.ft. Opt. Elevator / 4,575 sq.ft. Opt. Service Stairs
Elevation B • 4,440 sq.ft.
4,475 sq.ft. Opt. Elevator / 4,575 sq.ft. Opt. Service Stairs
Elevation C • 4,525 sq.ft.
4,560 sq.ft. Opt. Elevator / 4,660 sq.ft. Opt. Service Stairs

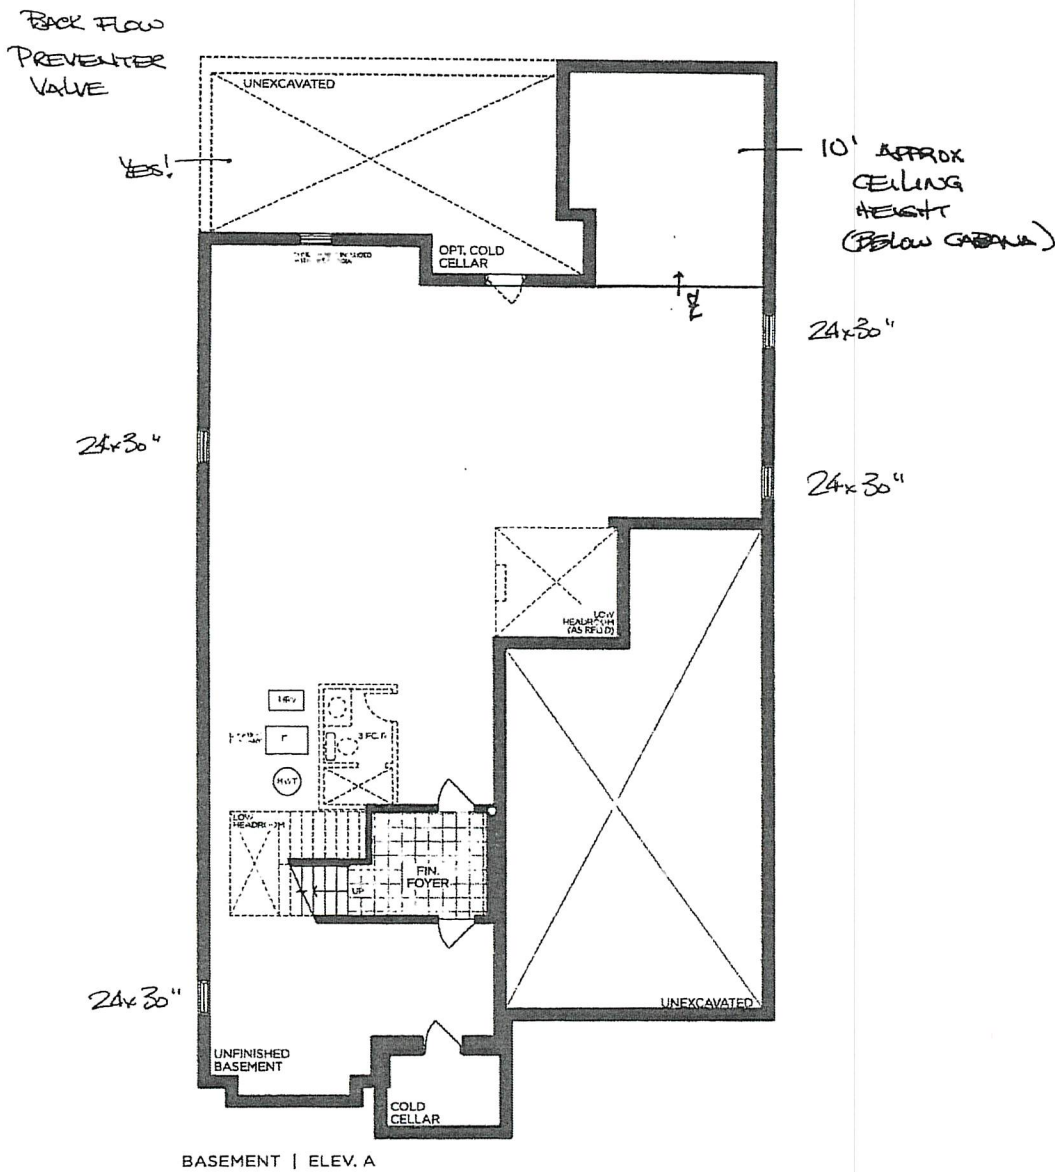

VENDOR







PURCHASER

PURCHASER

GOLDPARK
WORTH MORE™

Prices, figure illustrations, sizes, features and finishes are subject to change without notice. Areas and dimensions are approximate and actual usable floor space may vary from the stated area. Layout may be reverse of the unit purchased. E. & O.E. 5005

ELEVATOR STANDARD

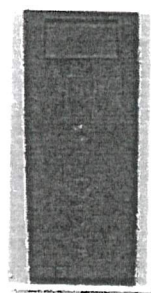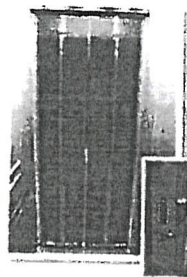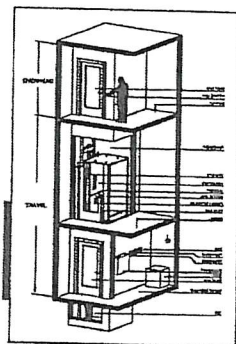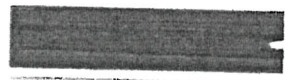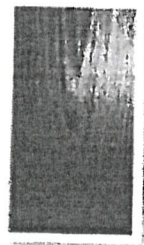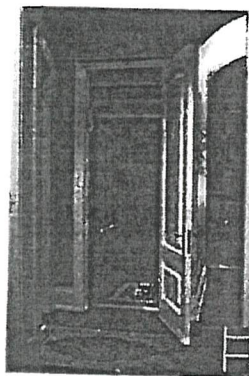


Standard Elevator Specs:

- WALL COVERING: Flat Oak
- CEILING PANEL: Same as wall covering / Flat Ceiling - 2 lights / LED Lighting 72mm Outside Diameter, Brushed Stainless Steel
- HANDRAIL: Round Stainless Steel
- DOOR/ENTRANCE: Automatic Bi-fold Door
- CONTROLS: Stainless Steel Rectangular Car Control Panel, Small Stainless Steel Rectangular Hall Station, Rectangular Phone Box (phone not included)

Lot# 88

Room: (see attached plan)

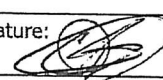Signature: 

Date: April 28 2020

Signature: 