



CONSTRUCTION SUMMARY

Lot: 106
Model: 50.05 B KNIGHTSWOOD
Project/Phase: Pine Valley Forevergreen / 1

CENTRAL VAC AND WIRING

Invoice	Qty.	Description
2297 32492	1	INSTALL VAC PAN UNDER KITCHEN SINK
		NETWORK AND WIRING 72,261 CENTRAL VAC AND WIRING
**		

CONCRETE AND DRAIN

Invoice	Qty.	Description
2235 31713	1	BACK FLOW PREVENTER VALVE
24Mar20 NoCat		CONCRETE AND DRAIN

DRYWALL

Invoice	Qty.	Description
2297 32492	1	INSTALL VAC PAN UNDER KITCHEN SINK
		NETWORK AND WIRING 72,261 DRYWALL
**		
2297 32493	1	GREAT ROOM - OPT. COFFERED CEILING AS PER PLAN
		MODEL OPTIONS 50.05 72,582 DRYWALL
**		
2297 32494	1	GREAT ROOM - OPT. WAFFLE CEILING, BEAM DETAIL AS PER PLAN (6 BOXES) OPTION #1 CTR-B07
		MODEL OPTIONS 50.05 72,581 DRYWALL
**		
2297 32495	1	LIBRARY - OPT. COFFERED CEILING AS PER PLAN
		MODEL OPTIONS 50.05 72,587 DRYWALL
**		
2297 32510	2	GARAGE DOOR OPENER (CHAMBERLAIN BELT DRIVE) - WITH 1 REMOTE - PRICE IS PER DOOR
		GARAGE DOORS 72,324 DRYWALL
**		



CONSTRUCTION SUMMARY

Lot: 106
Model: 50.05 B KNIGHTSWOOD
Project/Phase: Pine Valley Forevergreen / 1

ELECTRICAL

Invoice	Qty.	Description
2297 32493 **	1	GREAT ROOM - OPT. COFFERED CEILING AS PER PLAN MODEL OPTIONS 50.0572,582ELECTRICAL
2297 32494 **	1	GREAT ROOM - OPT. WAFFLE CEILING, BEAM DETAIL AS PER PLAN (6 BOXES) OPTION #1 CTR-B07 MODEL OPTIONS 50.0572,581ELECTRICAL
2297 32495 **	1	LIBRARY - OPT. COFFERED CEILING AS PER PLAN MODEL OPTIONS 50.0572,587ELECTRICAL
2297 32511 **	1	WIRELESS KEYPAD GARAGE DOOR ENTRY 877LM GARAGE DOORS72,323ELECTRICAL

ELECTRICAL

Invoice	Qty.	Description
2297 32585	1	KITCHEN: 110V WALL RECEPTACLE ON SEPARATE CIRCUIT - GAS FIRED COOKTOP - FOR AUX. EQUIPMENT - NOT A STOVE PLUG ELECTRICAL APPLIANCES72,273
2297 32497	1	KITCHEN: 110V WALL RECEPTACLE ON SEPARATE CIRCUIT - FOR BUILT-IN MICROWAVE - MICROWAVE NOT INCLUDED ELECTRICAL APPLIANCES72,272
2297 32498	1	KITCHEN: 110V WALL RECEPTACLE ON SEPARATE CIRCUIT - FOR BUILT-N STEAM OVEN - OVEN NOT INCLUDED ELECTRICAL APPLIANCES72,272
2297 32499	1	KITCHEN: 110V WALL RECEPTACLE ON SEPARATE CIRCUIT - FOR FREEZER - APPLIANCE NOT INCLUDED ELECTRICAL APPLIANCES72,272
2297 32749	1	KITCHEN: ADDITIONAL 220V RECEPTACLE ON A SEPARATE CIRCUIT - FOR BUILT-IN WALL OVEN - APPLIANCE NOT INCLUDED - DOES NOT INCLUDE BREAKER THAT IS TO BE INSTALLED BY LICENSED ELECTRICIAN AND ARRANGED BY HOMEOWNER AFTER CLOSING ELECTRICAL APPLIANCES72,282
2297 32789	1	SPICE KITCHEN: 110V WALL RECEPTACLE ON SEPARATE CIRCUIT - GAS FIRED APPLIANCE - FOR AUX. EQUIPMENT - NOT A STOVE PLUG ELECTRICAL APPLIANCES72,273



CONSTRUCTION SUMMARY

Lot: 106
Model: 50.05 B KNIGHTSWOOD
Project/Phase: Pine Valley Forevergreen / 1

ELECTRICAL

Invoice	Qty.	Description
2297 32490	1	GREAT ROOM: INTERIOR WALL OUTLET: ADDITIONAL 110V WALL INTERIOR RECEPTACLE ON EXISTING CIRCUIT FOR WALL MOUNTED TV - LOCATE APPROX 66" A.F.F. ABOVE FIREPLACE ELECTRICAL INTERIOR72,281
2297 32584	1	KITCHEN: FIXTURE: RELOCATE STANDARD CEILING MOUNT FIXTURE LOCATE ABOVE ISLAND, SEE PLAN ELECTRICAL INTERIOR72,307
2297 32506	3	MASTER ENSUITE X 2 + POWDER ROOM: INTERIOR WALL OUTLET: ADDITIONAL INTERIOR GFI RECEPTACLE - LOCATE BEHIND TOILET, RIGHT SIDE APPROX. 9" A.F.F. ELECTRICAL INTERIOR72,285 FOR *FUTURE* WASHLET
2297 32748	1	KITCHEN: FIXTURE: UNDER CABINET FLUORESCENT LIGHT FIXTURES - DOES NOT INCLUDE (AND REQUIRES) LIGHT VALANCE ELECTRICAL INTERIOR72,303

ELECTRICAL

Invoice	Qty.	Description
2297 32502	6	KITCHEN: 4" E/S LED INTERIOR POT LIGHT - GROUND FLOOR - EACH ELECTRICAL POTLIGHT72,289 INCLUDED IN APS
2297 32586	1	GREAT ROOM: UPGRADE STANDARD CEILING MOUNT FIXTURE TO (1) LED POT LIGHT - GROUND FLOOR - MUST SPECIFY LOCATION (CAN BE RELOCATED) ELECTRICAL POTLIGHT72,309
2297 32587	5	GREAT ROOM: 4" E/S LED INTERIOR POT LIGHT - GROUND FLOOR - EACH ELECTRICAL POTLIGHT72,289 USE SAME SWITCH AS STANDARD

ELECTRICAL

Invoice	Qty.	Description
2297 32504	2	KITCHEN: ROUGH-IN FOR CAPPED CEILING OUTLET (FUTURE LIGHT FIXTURE) - EACH ELECTRICAL ROUGH-IN72,667 APPROX CENTERED ABOVE ISLAND, USE SAME SWITCH AS STANDARD

FIREPLACE

Invoice	Qty.	Description
2297 32512	1	GREAT ROOM: FIREPLACE - ADD HEAT ACTIVATED FAN FIREPLACE ACCESSORIES72,321



CONSTRUCTION SUMMARY

Lot: 106
Model: 50.05 B KNIGHTSWOOD
Project/Phase: Pine Valley Forevergreen / 1

FORMING

Invoice	Qty.	Description
2235 31714 24Mar20 NoCat	1	OPTIONAL SERVICE STAIRS TO BASEMENT FORMING

FRAMING

Invoice	Qty.	Description
2297 32488 NoCat	1	***CUSTOM LAYOUT*** MAIN FLOOR POWDER ROOM: REVISE LAYOUT TO BECOME SPICE KITCHEN COMPLETE WITH CHIMNEY HOOD FAN, COUNTER PLUG, 220v ELECTRICAL FOR RANGE, CABINETRY GRANITE COUNTER, POCKET DOORS - SEE PLAN FOR LAYOUT, BASED ON STANDARD FINISHES FRAMING
2297 32700 NoCat	1	***CUSTOM LAYOUT** REVISE LAYOUT OF POWDER ROOM TO MAKE SPACE FOR SPICE KITCHEN - POWDER ROOM TO BE COMPLETE WITH STANDARD TOILET AND *PEDESTAL SINK* FRAMING
2297 32508 NoCat	1	***CUSTOM LAYOUT*** DELETE DOOR AND ENLARGE ARCHWAY LIBRARY/FOYER FRAMING
2297 32583	1	MASTER ENSUITE: SHOWER NICHE [SHAMPOO SHELF] - COMPLETE WITH MATCHING MARBLE JAMBS ON 4 SIDES, STANDARD TILE, APPROX. 12 X 18 INSTALLED VERTICALLY - SEE PLAN FOR PREFERRED LOCATION FRAMING72,631

GARAGE DOORS

Invoice	Qty.	Description
2297 32510	2	GARAGE DOOR OPENER (CHAMBERLAIN BELT DRIVE) - WITH 1 REMOTE - PRICE IS PER DOOR GARAGE DOORS72,324GARAGE DOORS
2297 32511	1	WIRELESS KEYPAD GARAGE DOOR ENTRY 877LM GARAGE DOORS72,323GARAGE DOORS

HVAC

Invoice	Qty.	Description
2297 32496	1	KITCHEN: GAS LINE ROUGH-IN - MAIN FLOOR FOR GAS COOKTOP - SEE PLAN FOR LOCATION HVAC72,224
2297 32788	1	SPICE KTICHEN: GAS LINE ROUGH-IN - MAIN FLOOR FOR APPLIANCE - SEE PLAN FOR LOCATION HVAC72,224



CONSTRUCTION SUMMARY

Lot: 106
Model: 50.05 B KNIGHTSWOOD
Project/Phase: Pine Valley Forevergreen / 1

NETWORK AND WIRING

Invoice	Qty.	Description
2297 32489	1	GREAT ROOM / MASTER BEDROOM / BEDROOM 3 / BASEMENT: ADDITIONAL CAT6 ETHERNET OUTLET - EACH (MUST SPECIFY LOCATION) NETWORK AND WIRING PACKAGE PRICE
		72,258
2297 32491	1	GREAT ROOM: CONDUIT PIPE - FOR WALL MOUNT TV - LOCATE APPROX. 66" A.F.F. ABOVE FIREPLACE, TERMINATING AT CABLE LOCATION NETWORK AND WIRING
		72,259
2297 32492	1	INSTALL VAC PAN UNDER KITCHEN SINK NETWORK AND WIRING
		72,261
		NETWORK AND WIRING
2297 32747	1	CONDUIT PIPE - FROM ATTIC TO BASEMENT - FROM ELECTRICAL PANEL IN BASEMENT TO APPROX CENTER OF ATTIC NETWORK AND WIRING
		72,260

NETWORKING/WIRING

Invoice	Qty.	Description
2297 32492	1	INSTALL VAC PAN UNDER KITCHEN SINK NETWORK AND WIRING
		72,261
		NETWORKING/WIRING
**		

PAINTING

Invoice	Qty.	Description
2297 32493	1	GREAT ROOM - OPT. COFFERED CEILING AS PER PLAN MODEL OPTIONS 50.05
		72,582
		PAINTING
**		
2297 32494	1	GREAT ROOM - OPT. WAFFLE CEILING, BEAM DETAIL AS PER PLAN (6 BOXES) OPTION #1 CTR-B07 MODEL OPTIONS 50.05
		72,581
		PAINTING
**		
2297 32495	1	LIBRARY - OPT. COFFERED CEILING AS PER PLAN MODEL OPTIONS 50.05
		72,587
		PAINTING
**		



Lot: 106

Model: 50.05 B KNIGHTSWOOD**Project/Phase: Pine Valley Forevergreen / 1**

FRAMING

Invoice	Qty.	Description
2297 32493 **	1	GREAT ROOM - OPT. COFFERED CEILING AS PER PLAN MODEL OPTIONS 50.05 72,582 PANL - FRAMING
2297 32494 **	1	GREAT ROOM - OPT. WAFFLE CEILING, BEAM DETAIL AS PER PLAN (6 BOXES) OPTION #1 CTR-B07 MODEL OPTIONS 50.05 72,581 PANL - FRAMING
2297 32495 **	1	LIBRARY - OPT. COFFERED CEILING AS PER PLAN MODEL OPTIONS 50.05 72,587 PANL - FRAMING
2297 32510 **	2	GARAGE DOOR OPENER (CHAMBERLAIN BELT DRIVE) - WITH 1 REMOTE - PRICE IS PER DOOR GARAGE DOORS 72,324 PANL - FRAMING

PLUMBING

Invoice	Qty.	Description
2297 32588	1	KITCHEN: ROUGH-IN 1/4" COLD WATER LINE TO FRIDGE PLUMBING 72,332
2297 32589	1	KITCHEN: ROUGH-IN 1/3 FOOT WATER LINE FOR BUILT-IN STEAM OVEN SEE ATTACHED PLAN FOR APPROX. LOCATION PLUMBING 72,338
2297 32750	1	KITCHEN: ROUGH-IN FOR KITCHEN POT FILLER (FIXTURE NOT INCLUDED) PLUMBING 72,346

ROUGH CARPENTRY

Invoice	Qty.	Description
2297 32493 **	1	GREAT ROOM - OPT. COFFERED CEILING AS PER PLAN MODEL OPTIONS 50.05 72,582 ROUGH CARPENTRY
2297 32494 **	1	GREAT ROOM - OPT. WAFFLE CEILING, BEAM DETAIL AS PER PLAN (6 BOXES) OPTION #1 CTR-B07 MODEL OPTIONS 50.05 72,581 ROUGH CARPENTRY
2297 32495 **	1	LIBRARY - OPT. COFFERED CEILING AS PER PLAN MODEL OPTIONS 50.05 72,587 ROUGH CARPENTRY

**Lot: 106****Model: 50.05 B KNIGHTSWOOD****Project/Phase: Pine Valley Forevergreen / 1**

INTERIOR DOORS

Invoice	Qty.	Description
2297 32790	19	2ND FLOOR: INCREASE HEIGHT OF DOOR TO 8FT SECOND FLOOR - PER DOOR
		INTERIOR DOORS 72,644

INTERIOR TRIM /MOULDINGS

Invoice	Qty.	Description
2297 32493 **	1	GREAT ROOM - OPT. COFFERED CEILING AS PER PLAN MODEL OPTIONS 50.05 72,582 INTERIOR TRIM /MOULDINGS
2297 32494 **	1	GREAT ROOM - OPT. WAFFLE CEILING, BEAM DETAIL AS PER PLAN (6 BOXES) OPTION #1 CTR-B07 MODEL OPTIONS 50.05 72,581 INTERIOR TRIM /MOULDINGS
2297 32495 **	1	LIBRARY - OPT. COFFERED CEILING AS PER PLAN MODEL OPTIONS 50.05 72,587 INTERIOR TRIM /MOULDINGS

KITCHEN AND BATH CABINETRY

Invoice	Qty.	Description
2297 32492	1	INSTALL VAC PAN UNDER KITCHEN SINK
		NETWORK AND WIRING
		72,261 KITCHEN AND BATH CABINETS
**		

MISC.

Invoice	Qty.	Description
1		



CONSTRUCTION SUMMARY

Lot: 106
Model: 50.05 B KNIGHTSWOOD
Project/Phase: Pine Valley Forevergreen / 1

WINDOWS - BASEMENT

Invoice	Qty.	Description
2235 31712 24Mar20	4	BASEMENT WINDOWS - UPGRADE BASEMENT WINDOW SIZE TO 30 " X 24" - 10" FRAME (PINEVALLEY 50 FOOT LOTS ONLY) WINDOWS - BASEMENT72,675WINDOWS - BASEMENT

WINDOWS AND DOORS

Invoice	Qty.	Description
2297 32509 NoCat	1	THRU OUT: BLACK INTERIOR WINDOWS WINDOWS AND DOORS

This Document is Extremely Time Sensitive - Printed 28 Apr 20 at 15:15

Prices, figures, illustrations, sizes, features and finishes are subject to change without notice. Areas and dimensions are approximate and actual usable floor space may vary from the stated area. Layout may be reverse of the unit purchased. E. & O.E. 5005

SCHEDULE 'F'




PV-106 *see attached*
MAR 20 2020 *see attached*

PV-106 *see attached*
APRIL 23 2020 *see attached*

The
Knightswood
50' SERIES

Elevation A • 4,445 sq.ft.
4,475 sq.ft. Opt. Elevator / 4,575 sq.ft. Opt. Service Stairs
→ Elevation B • 4,440 sq.ft.
4,475 sq.ft. Opt. Elevator / 4,575 sq.ft. Opt. Service Stairs
Elevation C • 4,525 sq.ft.
4,560 sq.ft. Opt. Elevator / 4,660 sq.ft. Opt. Service Stairs

8' Doors
on 2nd Floor

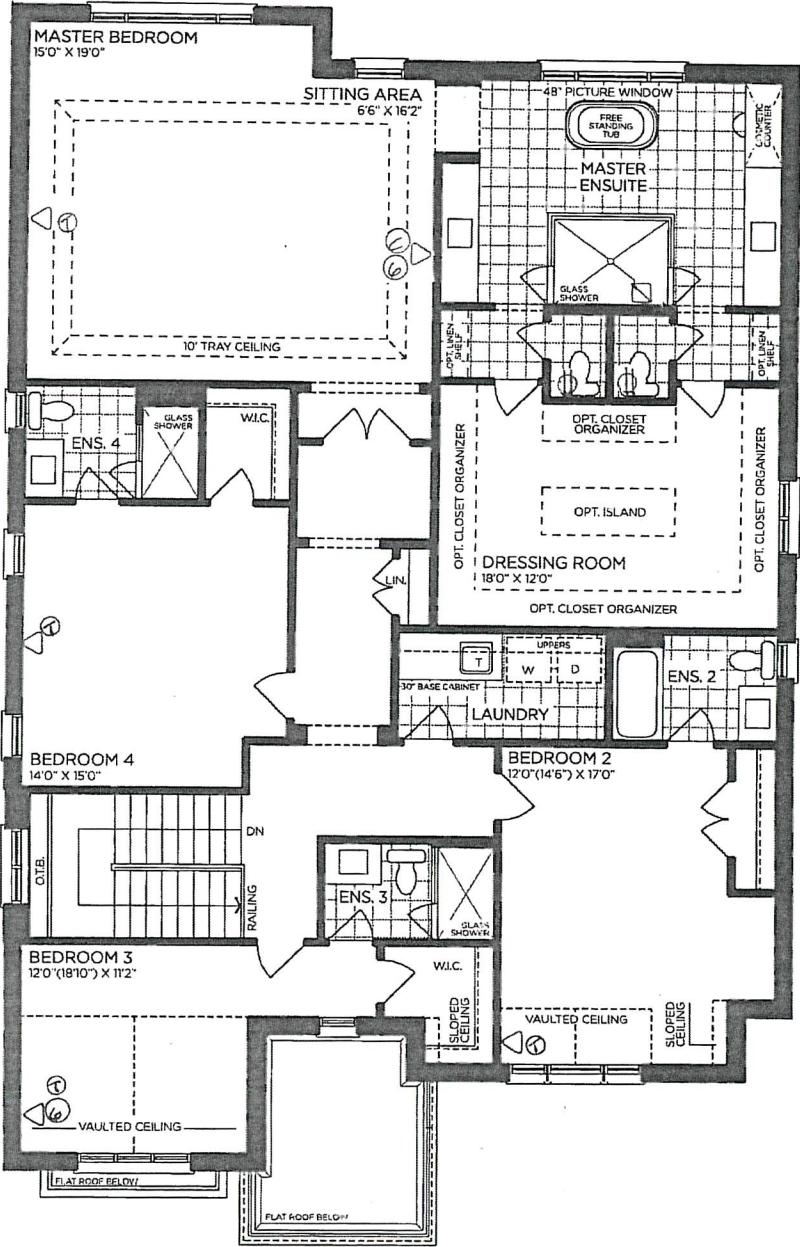

SECOND FLOOR | ELEV. A

VENDOR

PURCHASER

PURCHASER

GOLDPARK
WORTH MORE™

Prices, figures, illustrations, sizes, features and finishes are subject to change without notice. Areas and dimensions are approximate and actual usable floor space may vary from the stated area. Layout may be reverse of the unit purchased. E. & O.E. 5005

SCHEDULE 'F'




PV-106 *see attached*
MAR 20 2020 *see attached*
PV-106 *see attached*
APRIL 23 2020 *see attached*


The Knightswood

50' SERIES


Elevation A • 4,445 sq.ft.
4,475 sq.ft. Opt. Elevator / 4,575 sq.ft. Opt. Service Stairs
→ Elevation B • 4,440 sq.ft.
4,475 sq.ft. Opt. Elevator / 4,575 sq.ft. Opt. Service Stairs
Elevation C • 4,525 sq.ft.
4,560 sq.ft. Opt. Elevator / 4,660 sq.ft. Opt. Service Stairs

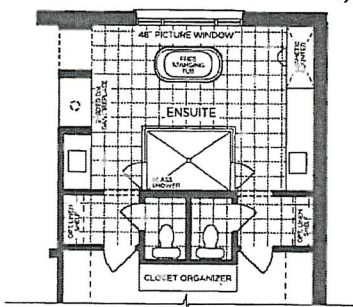


PART. OPT. ENSUITE LAYOUT

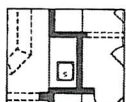


PART. OPT. WETBAR SITTING AREA

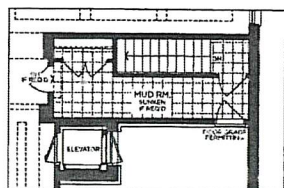


OPT. PART. GROUND FLOOR SERVICE STAIR W/ ELEVATOR | ELEV. A

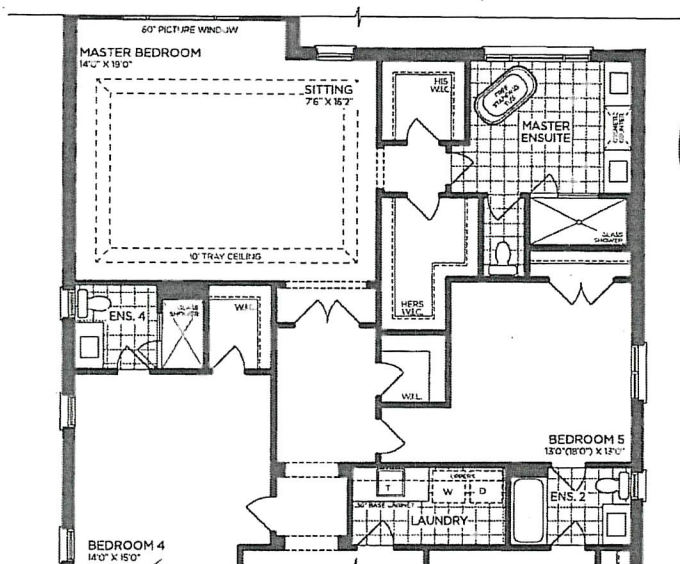


PART. OPT. SECOND FLOOR | ELEV. A (5 BEDROOMS)

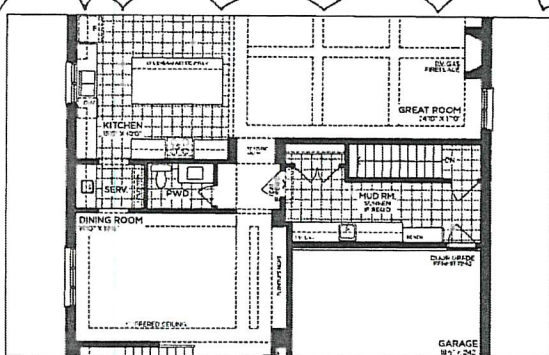


OPT. PART. GROUND FLOOR W/ SERVICE STAIR | ELEV. A

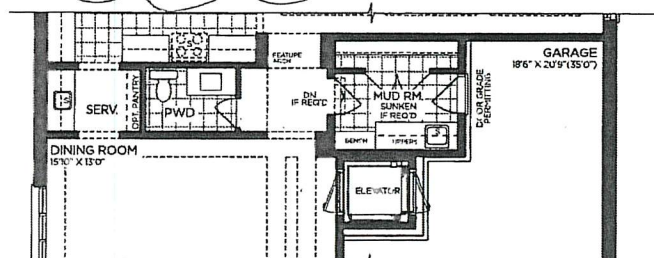

PART. OPT. GROUND FLOOR | ELEV. A (ELEVATOR)

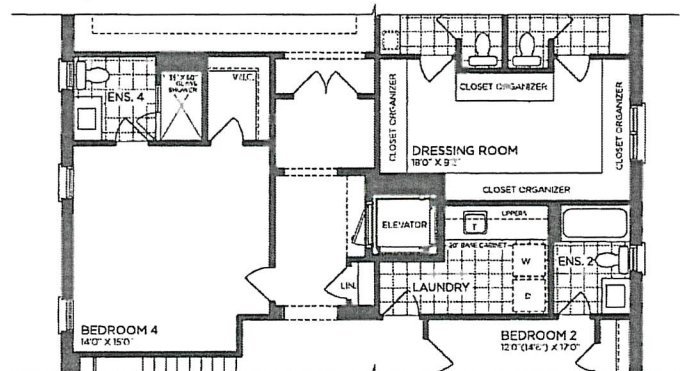

PART. OPT. SECOND FLOOR | ELEV. A (ELEVATOR)

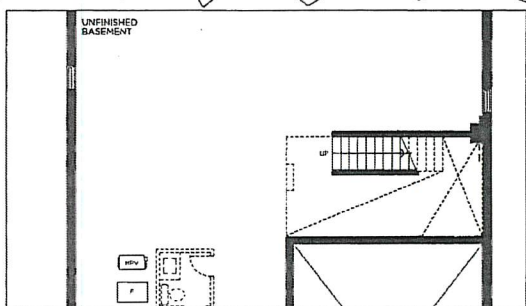

OPT. PART. BASEMENT W/ SERVICE STAIR | ELEV. A

VENDOR

PURCHASER

PURCHASER

GOLDPARK
WORTH MORE™

Prices, figures, illustrations, sizes, features and finishes are subject to change without notice. Areas and dimensions are approximate and actual usable floor space may vary from the stated area. Layout may be reverse of the unit purchased. E. & O.E. 5005

SCHEDULE 'F'



PV-106
March 20 2020
PV-106
APRIL 23 2020

see attached
see attached
see attached
see attached

The Knightswood

50' SERIES

Elevation A • 4,445 sq.ft.


4,475 sq.ft. Opt. Elevator / 4,575 sq.ft. Opt. Service Stairs

→ Elevation B • 4,440 sq.ft.


4,475 sq.ft. Opt. Elevator / 4,575 sq.ft. Opt. Service Stairs

Elevation C • 4,525 sq.ft.


4,560 sq.ft. Opt. Elevator / 4,660 sq.ft. Opt. Service Stairs

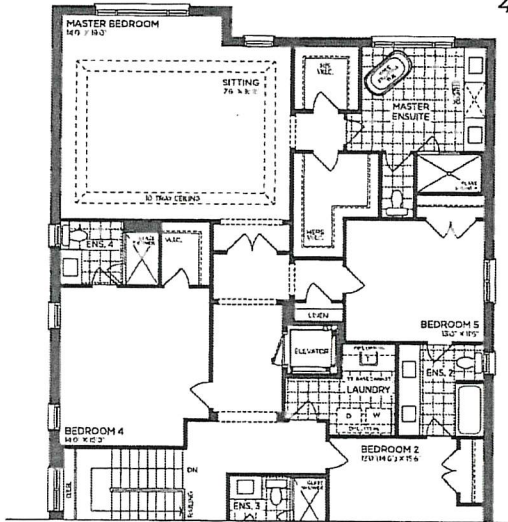


PART. OPT. SECOND FLOOR | ELEV. A (5 BEDROOMS - ELEVATOR)

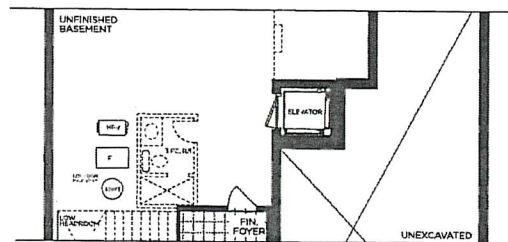


PART. OPT. BASEMENT | ELEV. A (ELEVATOR)

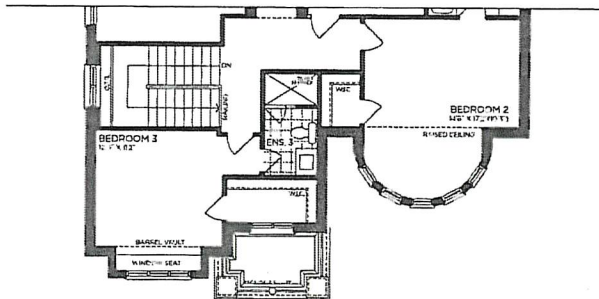


PART. SECOND FLOOR | ELEV. B

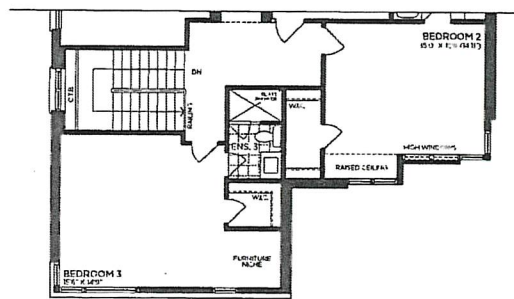


PART. SECOND FLOOR | ELEV. C

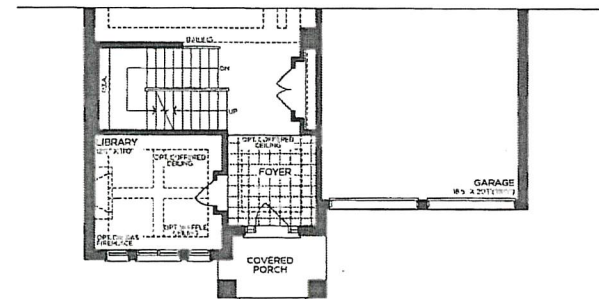


PART. GROUND FLOOR | ELEV. B

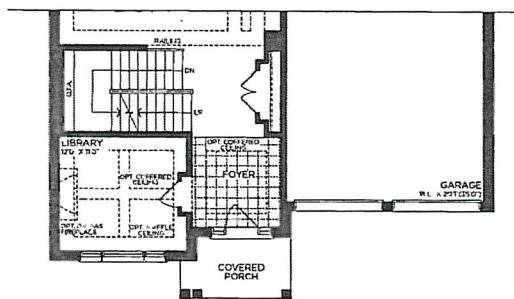

PART. GROUND FLOOR | ELEV. C

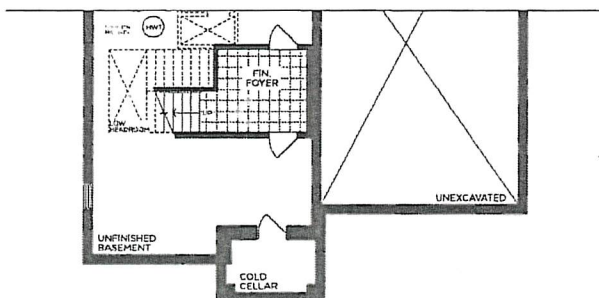

PART. BASEMENT | ELEV. B

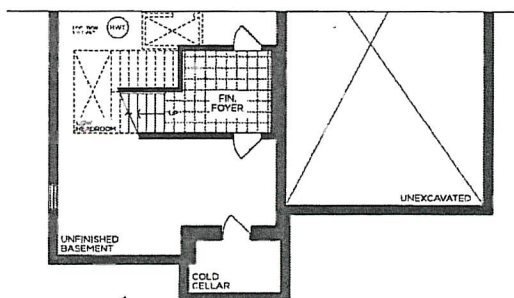

PART. BASEMENT | ELEV. C

VENDOR


PURCHASER

PURCHASER


GOLDPARK
WORTH MORE™

Prices, figures, illustrations, sizes, features and finishes are subject to change without notice. Areas and dimensions are approximate and actual usable floor space may vary from the stated area. Layout may be reverse of the unit purchased. E. & O.E. 5005

see attached
see attached
22

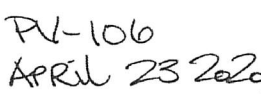

Elevation A • 4,445 sq.ft.
 4,475 sq.ft. Opt. Elevator / 4,575 sq.ft. Opt. Service Stairs
Elevation B • 4,440 sq.ft.
 4,475 sq.ft. Opt. Elevator / 4,575 sq.ft. Opt. Service Stairs
Elevation C • 4,525 sq.ft.
 4,560 sq.ft. Opt. Elevator / 4,660 sq.ft. Opt. Service Stairs

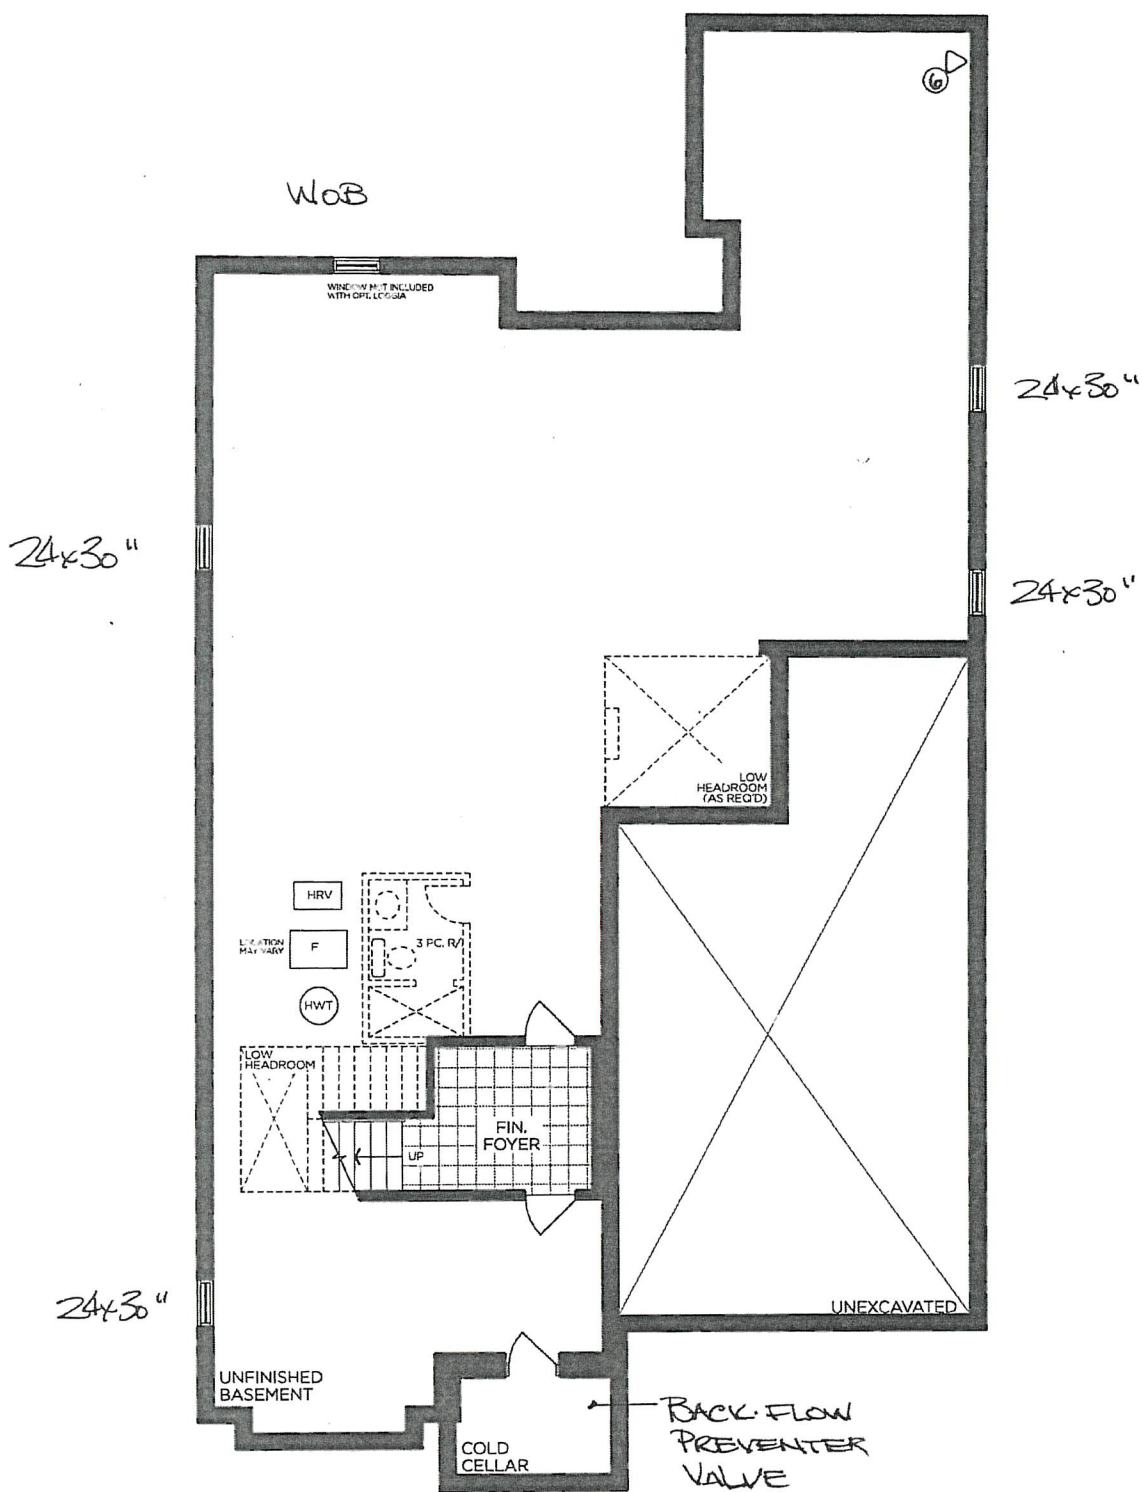

BASEMENT | ELEV. A

PURCHASER

GOLD PARK
WORTH MORE™

Prices, figures, illustrations, sizes, features and finishes are subject to change without notice. Areas and dimensions are approximate and actual usable floor space may vary from the stated area. Layout may be reverse of the unit purchased. E. & O. 5005

SCHEDULE 'F'



The Knightswood

50' SERIES


Elevation A - 4,445 sq.ft.
 4,475 sq.ft. Opt. Elevator / 4,575 sq.ft. Opt. Service Stairs
 → Elevation B - 4,440 sq.ft.
 4,475 sq.ft. Opt. Elevator / 4,575 sq.ft. Opt. Service Stairs
 Elevation C - 4,525 sq.ft.
 4,560 sq.ft. Opt. Elevator / 4,660 sq.ft. Opt. Service Stairs

SA

PY-106

April 27, 2020

BLACK WINDOWS
TURN OUT

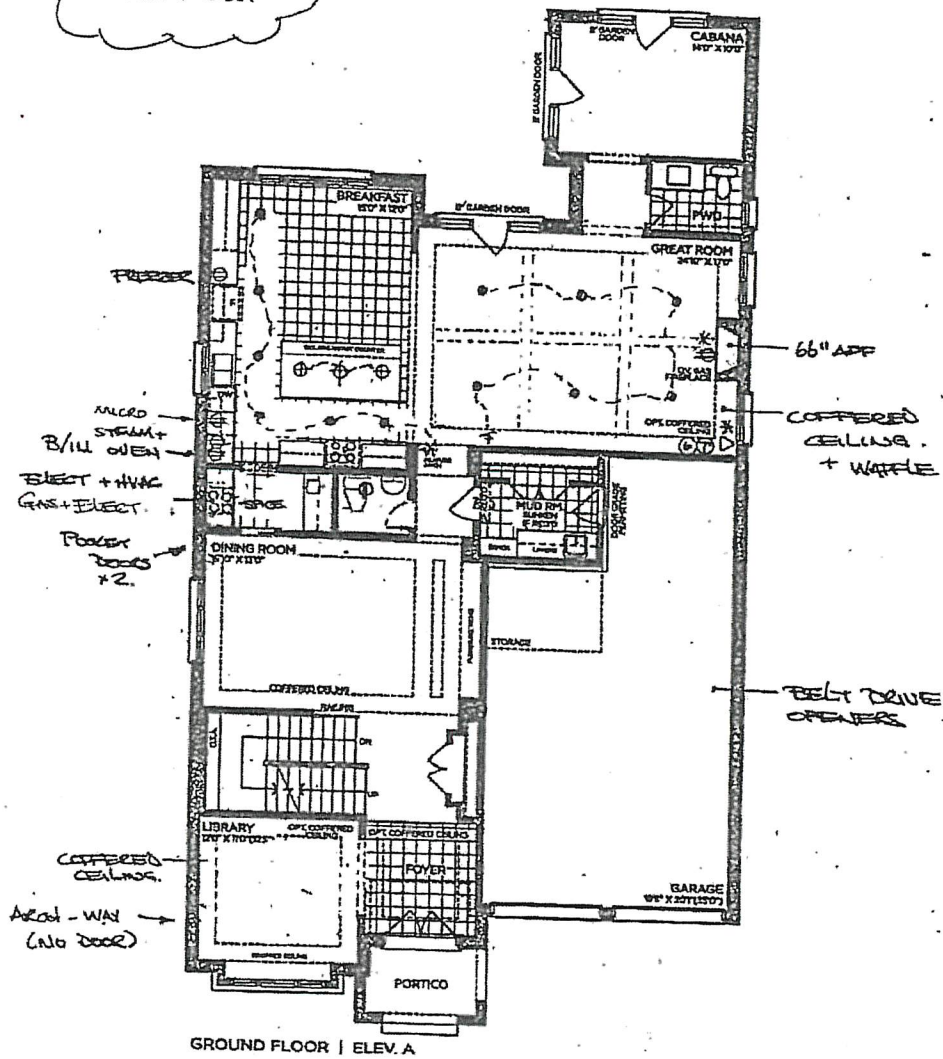

GROUND FLOOR | ELEV. A

VENDOR	
PURCHASER	<i>Samir Ali</i>
PURCHASER	<i>[Signature]</i>

GOLDPARK
WORTH MORE™

Prices, figures, illustrations, sizes, features and finishes are subject to change without notice. Areas and dimensions are approximate and actual usable floor space may vary from the stated area. Layout may be reverse of the unit purchased. E. & O.E. 5005

SCHEDULE 'F'



PV-106 sa sa


MARCH 20 2020

PV-106 sa sa
APRIL 23 2020

The
Knightswood
50' SERIES

Elevation A • 4,445 sq.ft.
4,475 sq.ft. Opt. Elevator / 4,575 sq.ft. Opt. Service Stairs
Elevation B • 4,440 sq.ft.
4,475 sq.ft. Opt. Elevator / 4,575 sq.ft. Opt. Service Stairs
Elevation C • 4,525 sq.ft.
4,560 sq.ft. Opt. Elevator / 4,660 sq.ft. Opt. Service Stairs

8' Doors
on 2nd Floor

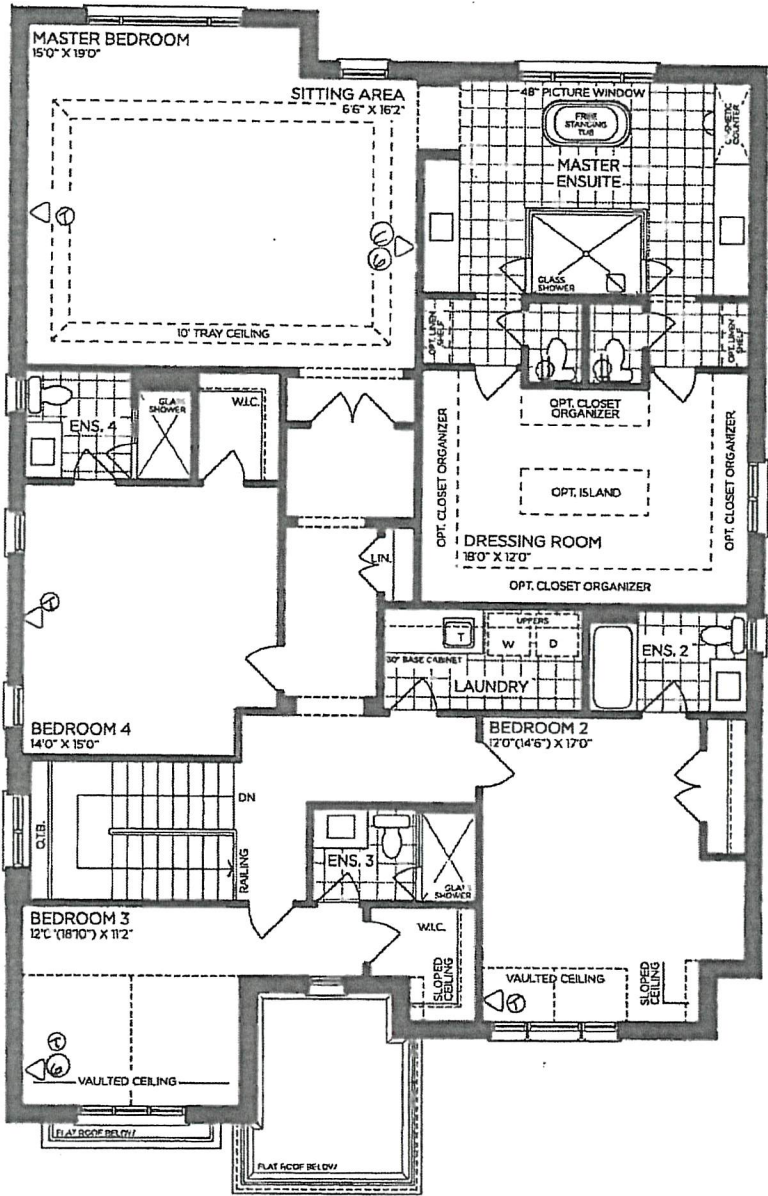

SECOND FLOOR | ELEV. A

VENDOR

PURCHASER

PURCHASER

GOLDPARK
WORTH MORE™

Prices, figures, illustrations, sizes, features and finishes are subject to change without notice. Areas and dimensions are approximate and actual usable floor space may vary from the stated area. Layout may be reverse of the unit purchased. E. & O.E. 5005


SCHEDULE 'F'



PV-106 ^{SA}
March 26 2020 ^{SA}
PV-106 ^{SA} ^{SA}
April 23 2020

The Knightswood 50' SERIES


Elevation A • 4,445 sq.ft.
4,475 sq.ft. Opt. Elevator / 4,575 sq.ft. Opt. Service Stairs
Elevation B • 4,440 sq.ft.
4,475 sq.ft. Opt. Elevator / 4,575 sq.ft. Opt. Service Stairs
Elevation C • 4,525 sq.ft.
4,560 sq.ft. Opt. Elevator / 4,660 sq.ft. Opt. Service Stairs

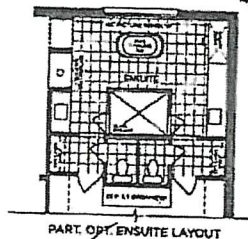


PART, OPT. ENSUITE LAYOUT




PART, OPT. WETBAR
SITTING AREA

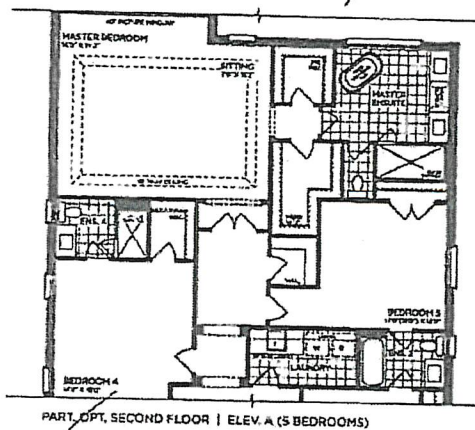


PART, OPT. SECOND FLOOR | ELEV. A (5 BEDROOMS)

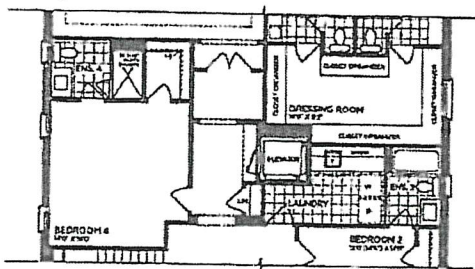


PART, OPT. SECOND FLOOR | ELEV. A (ELEVATOR)

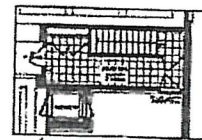


OPT. PART, GROUND FLOOR
SERVICE STAIR W/ ELEVATOR | ELEV. A

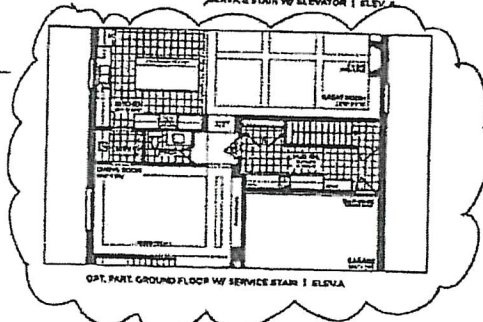

OPT. PART, GROUND FLOOR W/ SERVICE STAIR | ELEV. A

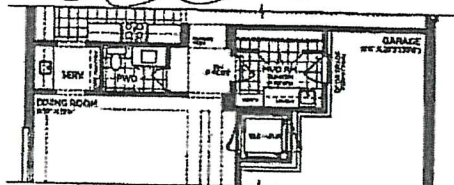

PART, OPT. GROUND FLOOR | ELEV. A (ELEVATOR)

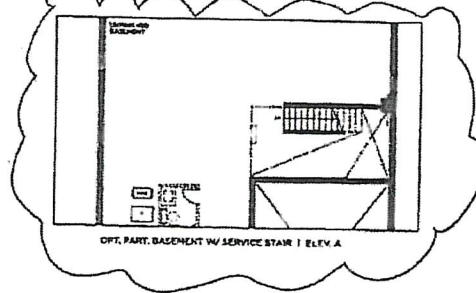

OPT. PART, BASEMENT W/ SERVICE STAIR | ELEV. A

VENDOR
PURCHASER
PURCHASER

GOLDPARK
WORTH MORE™

Prices, figures, illustrations, sizes, features and finishes are subject to change without notice. Areas and dimensions are approximate and actual usable floor space may vary from the stated area. Layout may be reverse of the unit purchased. E & O.E. 5005

SCHEDULE 'F'



PV-106

SP SA

March 2, 2020

PV-106

SP SA

April 23, 2020

The Knightswood

50' SERIES

Elevation A • 4,445 sq.ft.









4,475 sq.ft. Opt. Elevator / 4,575 sq.ft. Opt. Service Stairs

Elevation B • 4,440 sq.ft.

4,475 sq.ft. Opt. Elevator / 4,575 sq.ft. Opt. Service Stairs

Elevation C • 4,525 sq.ft.

4,560 sq.ft. Opt. Elevator / 4,660 sq.ft. Opt. Service Stairs

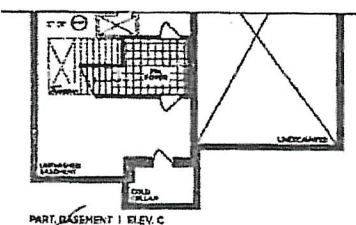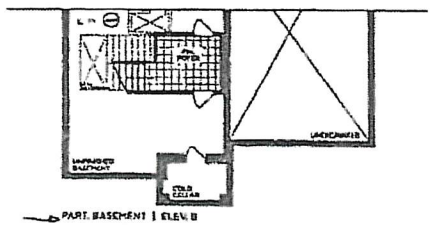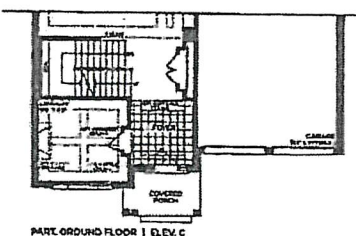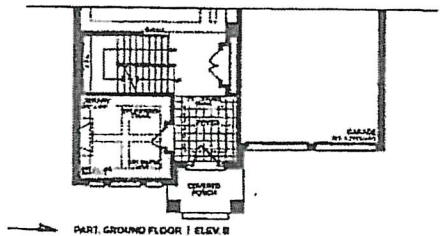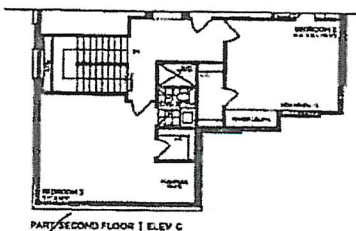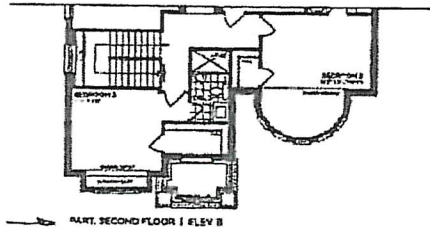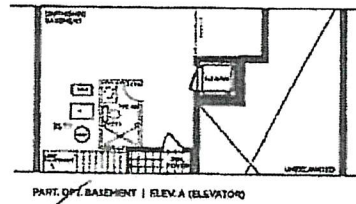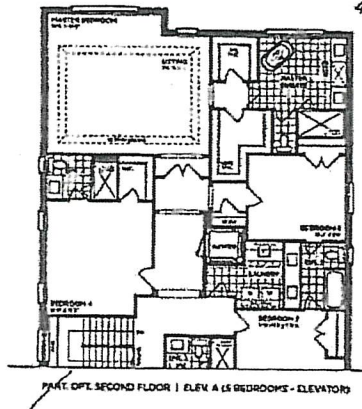

VENDOR

PURCHASER Samir Alf

PURCHASER [Signature]

GOLDPARK
WORTH MORE™

Prices, figures, illustrations, sizes, features and finishes are subject to change without notice. Areas and dimensions are approximate and actual usable floor space may vary from the stated area. Layout may be reverse of the unit purchased. E. & O.E. 5005


SCHEDULE 'F'



PV-106 (SA) (SA)
March 26 22
PV-106
APRIL 23 22 (SA) (SA)
(SA)

The
Knightswood
50' SERIES

Elevation A • 4,445 sq.ft.
4,475 sq.ft. Opt. Elevator / 4,575 sq.ft. Opt. Service Stairs
Elevation B • 4,440 sq.ft.
4,475 sq.ft. Opt. Elevator / 4,575 sq.ft. Opt. Service Stairs
Elevation C • 4,525 sq.ft.
4,560 sq.ft. Opt. Elevator / 4,660 sq.ft. Opt. Service Stairs

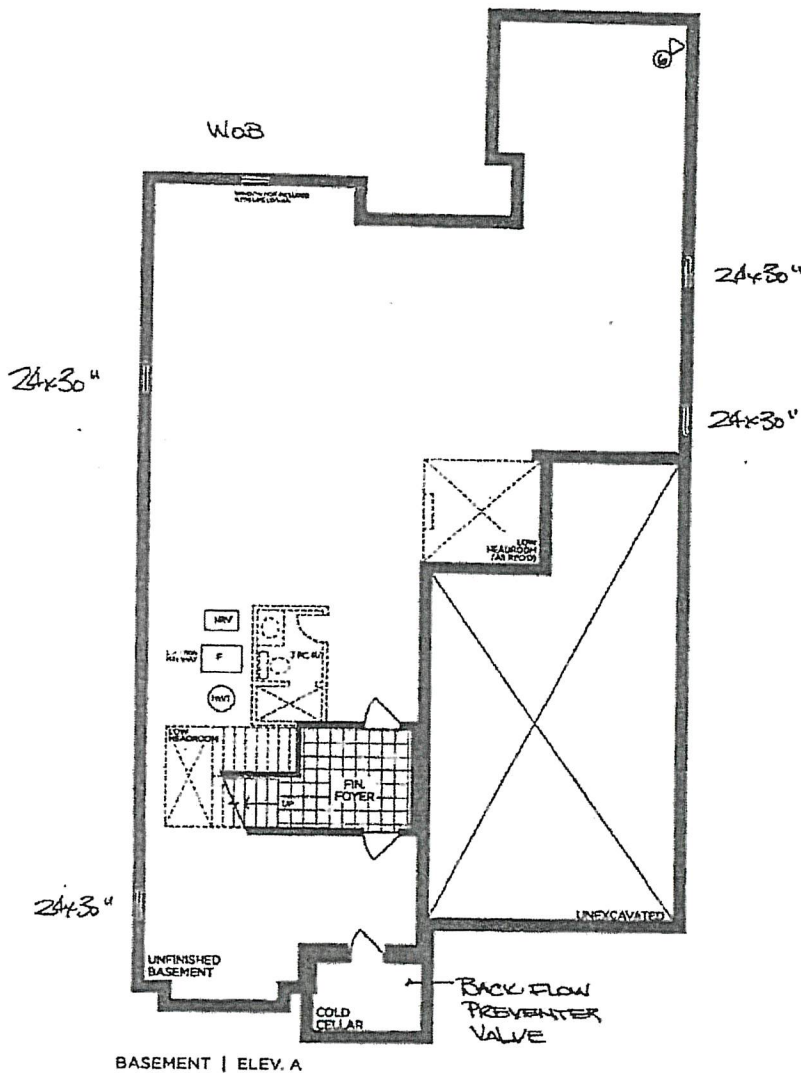

BASEMENT | ELEV. A

VENDOR
PURCHASER Samer Aziz
PURCHASER [Signature]

GOLDPARK
WORTH MORE™

Prices, figures, illustrations, sizes, features and finishes are subject to change without notice. Areas and dimensions are approximate and actual usable floor space may vary from the stated area. Layout may be reverse of the unit purchased. E & OE. 5005