

CONCRETE AND DRAIN

Invoice	Qty.	Description
2209 31298 18Mar20 NoCat	1	BACK-FLOW PREVENTER VALVE CONCRETE AND DRAIN

DRYWALL

Invoice	Qty.	Description
2296 32446 04May20 **	1	GREAT ROOM - OPT. COFFERED CEILING AS PER PLAN MODEL OPTIONS 40.0772,445DRYWALL
2296 32752 04May20 **	1	GREAT ROOM - OPT. WAFFLE CEILING, BEAM DETAIL AS PER PLAN (9 BOXES) OPTION # 1 CTR-B07 MODEL OPTIONS 40.0772,444DRYWALL

ELECTRICAL

Invoice	Qty.	Description
2296 32446 04May20 **	1	GREAT ROOM - OPT. COFFERED CEILING AS PER PLAN MODEL OPTIONS 40.0772,445ELECTRICAL
2296 32752 04May20 **	1	GREAT ROOM - OPT. WAFFLE CEILING, BEAM DETAIL AS PER PLAN (9 BOXES) OPTION # 1 CTR-B07 MODEL OPTIONS 40.0772,444ELECTRICAL

ELECTRICAL

Invoice	Qty.	Description
2296 32439 04May20	1	GREAT ROOM: INTERIOR WALL OUTLET: ADDITIONAL 110V WALL INTERIOR RECEPTACLE ON EXISTING CIRCUIT FOR WALL MOUNTED TV - LOCATE APPROX. 66" A.F.F. ABOVE FIREPLACE ELECTRICAL INTERIOR72,281
2296 32579 04May20	1	KITCHEN: FIXTURE: UNDER CABINET FLUORESCENT LIGHT FIXTURES - DOES NOT INCLUDE (AND REQUIRES) LIGHT VALANCE ELECTRICAL INTERIOR72,303



CONSTRUCTION SUMMARY

Lot: 111
Model: 40.07 A SUNCREST
Project/Phase: Pine Valley Forevergreen / 1

ELECTRICAL :

Invoice	Qty.	Description
2296 32753 04May20	1	LAUNDRY: ADD HINGE-ACTIVATED INTERIOR SWITCH ELECTRICAL SWITCH 72,278 FOR POTLIGHT IN CLOSET
2296 32463 04May20	1	KITCHEN: ADDITIONAL INTERIOR SWITCH ELECTRICAL SWITCH 72,278 SWITCH FOR POTLIGHTS
2296 32465 04May20	1	BREAKFAST: ADDITIONAL INTERIOR SWITCH ELECTRICAL SWITCH 72,278 FOR POTLIGHTS

INTERIOR TRIM /MOULDINGS

Invoice	Qty.	Description
2296 32446 04May20 **	1	GREAT ROOM - OPT. COFFERED CEIILING AS PER PLAN MODEL OPTIONS 40.07 72,445 INTERIOR TRIM /MOULDINGS
2296 32752 04May20 **	1	GREAT ROOM - OPT. WAFFLE CEILING, BEAM DETAIL AS PER PLAN (9 BOXES) OPTION # 1 CTR-B07 MODEL OPTIONS 40.07 72,444 INTERIOR TRIM /MOULDINGS

MISC.

Invoice	Qty.	Description
	1	

Invoice	Qty.	Description
	1	
	1	



CONSTRUCTION SUMMARY

Lot: 111
Model: 40.07 A SUNCREST
Project/Phase: Pine Valley Forevergreen / 1

Invoice	Qty.	Description
	1	
0	1	

Invoice	Qty.	Description
	1	

NETWORK AND WIRING

Invoice	Qty.	Description
2296 32438 04May20	1	GREAT ROOM: CONDUIT PIPE - FOR WALL MOUNT TV - LOCATE APPROX. 66" A.F.F. ABOVE FIREPLACE, TERMINATING AT CABLE -SEE PLAN NETWORK AND WIRING72,259
2296 32442 04May20	1	GREAT ROOM: ADDITIONAL CAT6 ETHERNET OUTLET - EACH SEE PLAN FOR LOCATION NETWORK AND WIRING72,258
2296 32441 04May20	1	KITCHEN: INSTALL VAC PAN UNDER KITCHEN SINK NETWORK AND WIRING72,261
2296 32444 04May20	1	CONDUIT PIPE - FROM ATTIC TO BASEMENT - AT ELECTRICAL PANEL TO APPROX CENTER OF ATTIC NETWORK AND WIRING72,260

PAINTING

Invoice	Qty.	Description
2296 32446 04May20 **	1	GREAT ROOM - OPT. COFFERED CEILING AS PER PLAN MODEL OPTIONS 40.0772,445PAINTING
2296 32752 04May20 **	1	GREAT ROOM - OPT. WAFFLE CEILING, BEAM DETAIL AS PER PLAN (9 BOXES) OPTION # 1 CTR-B07 MODEL OPTIONS 40.0772,444PAINTING



CONSTRUCTION SUMMARY

Lot: 111
Model: 40.07 A SUNCREST
Project/Phase: Pine Valley Forevergreen / 1

FRAMING

Invoice	Qty.	Description
2296 32446 04May20 **	1	GREAT ROOM - OPT. COFFERED CEILING AS PER PLAN MODEL OPTIONS 40.0772,445PANL - FRAMING
2296 32752 04May20 **	1	GREAT ROOM - OPT. WAFFLE CEILING, BEAM DETAIL AS PER PLAN (9 BOXES) OPTION # 1 CTR-B07 MODEL OPTIONS 40.0772,444PANL - FRAMING

PLUMBING

Invoice	Qty.	Description
2209 31626 18Mar20 NoCat	1	BACK-FLOW PREVENTER VALVE PLUMBING
2296 32443 04May20 NoCat	1	GARAGE: UPGRADE TO HOT/COLD HOSE BIB (FROM STANDARD COLD ONLY) PLUMBING

ROUGH CARPENTRY

Invoice	Qty.	Description
2296 32446 04May20 **	1	GREAT ROOM - OPT. COFFERED CEILING AS PER PLAN MODEL OPTIONS 40.0772,445ROUGH CARPENTRY
2296 32752 04May20 **	1	GREAT ROOM - OPT. WAFFLE CEILING, BEAM DETAIL AS PER PLAN (9 BOXES) OPTION # 1 CTR-B07 MODEL OPTIONS 40.0772,444ROUGH CARPENTRY

This Document is Extremely Time Sensitive - Printed 4 May 20 at 9:03

SCHEDULE 'F'




PV-111
APRIL 24 2020



The
Suncrest
40' SERIES

→ Elevation A • 2,520 sq.ft.
Elevation B • 2,535 sq.ft.

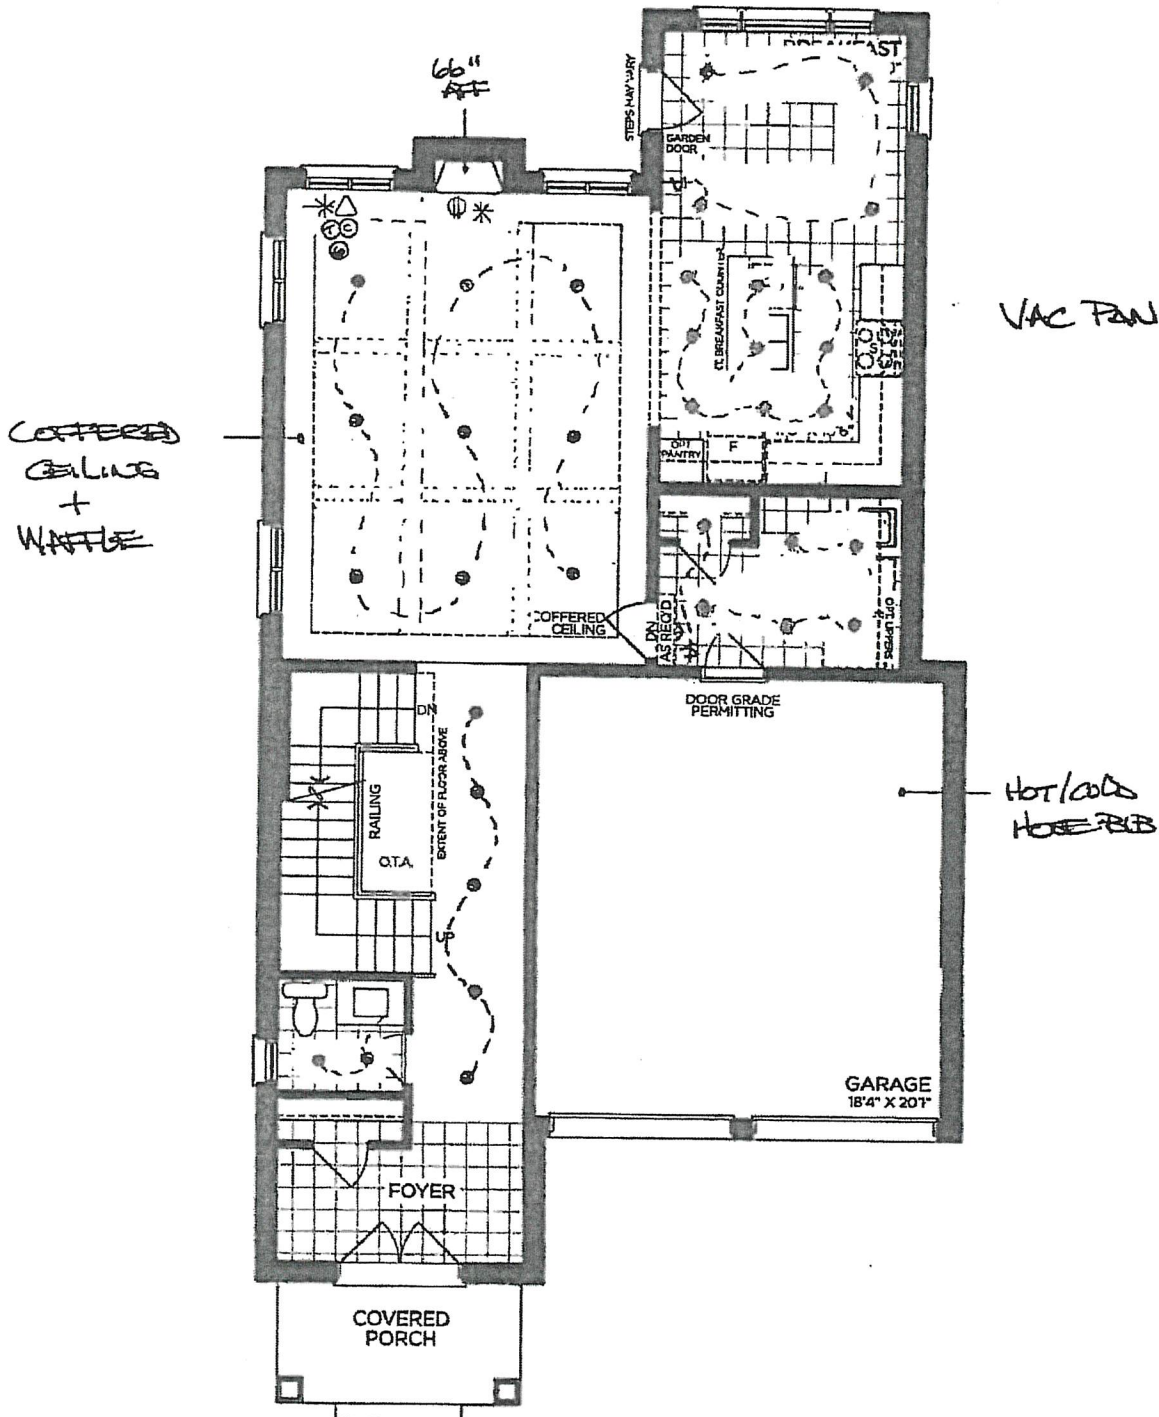


GROUND FLOOR | ELEV. A

VENDOR

PURCHASER

PURCHASER

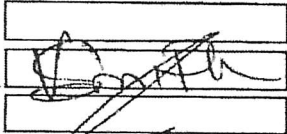

GOLDPARK
WORTH MORE™


Prices, figures, illustrations, sizes, features and finishes are subject to change without notice. Areas and dimensions are approximate and actual usable floor space may vary from the stated area. Layout may be reverse of the unit purchased. E. & O.E. 4007

SCHEDULE 'F'



PV- III
APRIL 24 2020

The
Suncrest
40' SERIES
→ Elevation A • 2,520 sq.ft.
Elevation B • 2,535 sq.ft.

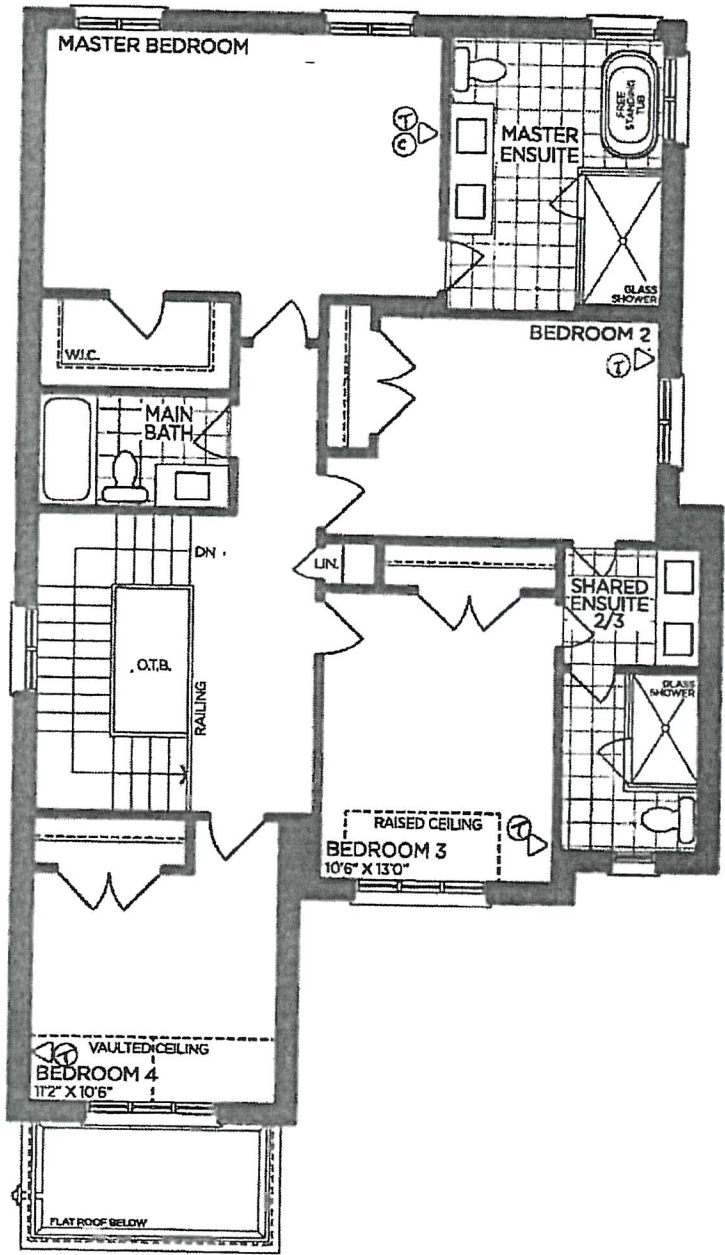

SECOND FLOOR | ELEV. A

VENDOR
PURCHASER
PURCHASER

GOLDPARK
WORTH MORE™

Prices, figures, illustrations, sizes, features and finishes are subject to change without notice. Areas and dimensions are approximate and actual usable floor space may vary from the stated area. Layout may be reverse of the unit purchased. E. & O.E. 4007




SCHEDULE 'F'

PV-111
April 24 2020

The Suncrest 40' SERIES

Elevation A • 2,520 sq.ft.
Elevation B • 2,535 sq.ft.

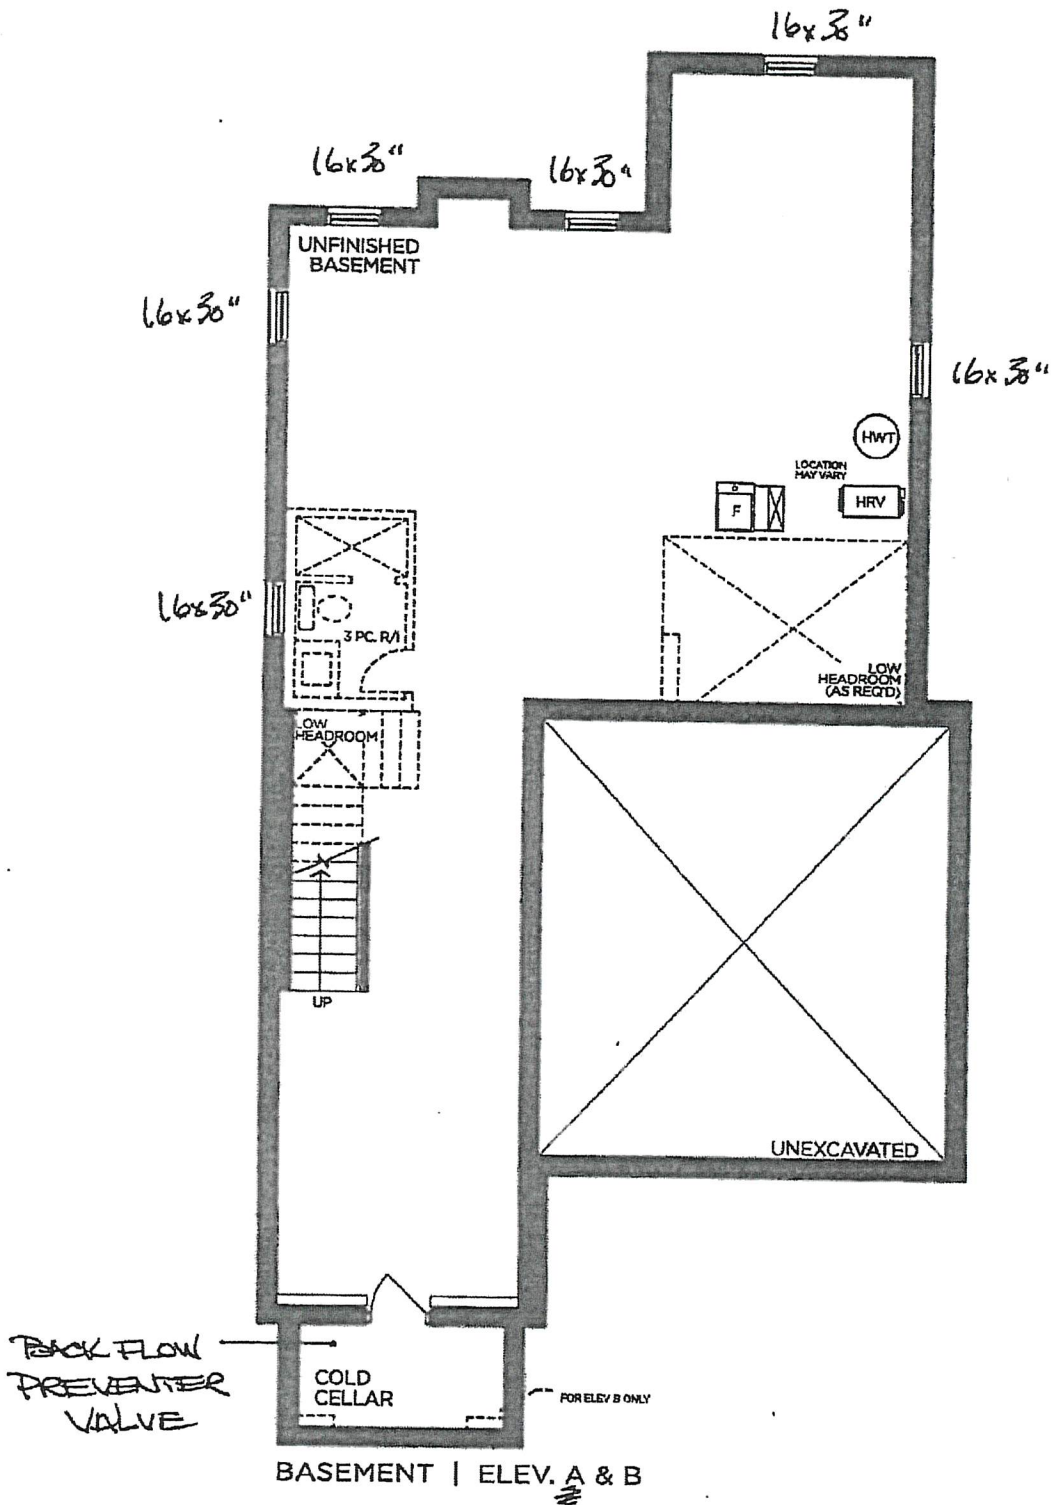

VENDOR
PURCHASER
PURCHASER

GOLDPARK
WORTH MORE™

Prices, figures, illustrations, sizes, features and finishes are subject to change without notice. Areas and dimensions are approximate and actual usable floor space may vary from the stated area. Layout may be reverse of the unit purchased. E. & O.E. 4007


SCHEDULE 'F'



PV-111
APRIL 24 2022
see attached
see attached

The
Suncrest
40' SERIES

→ Elevation A • 2,520 sq.ft.
Elevation B • 2,535 sq.ft.

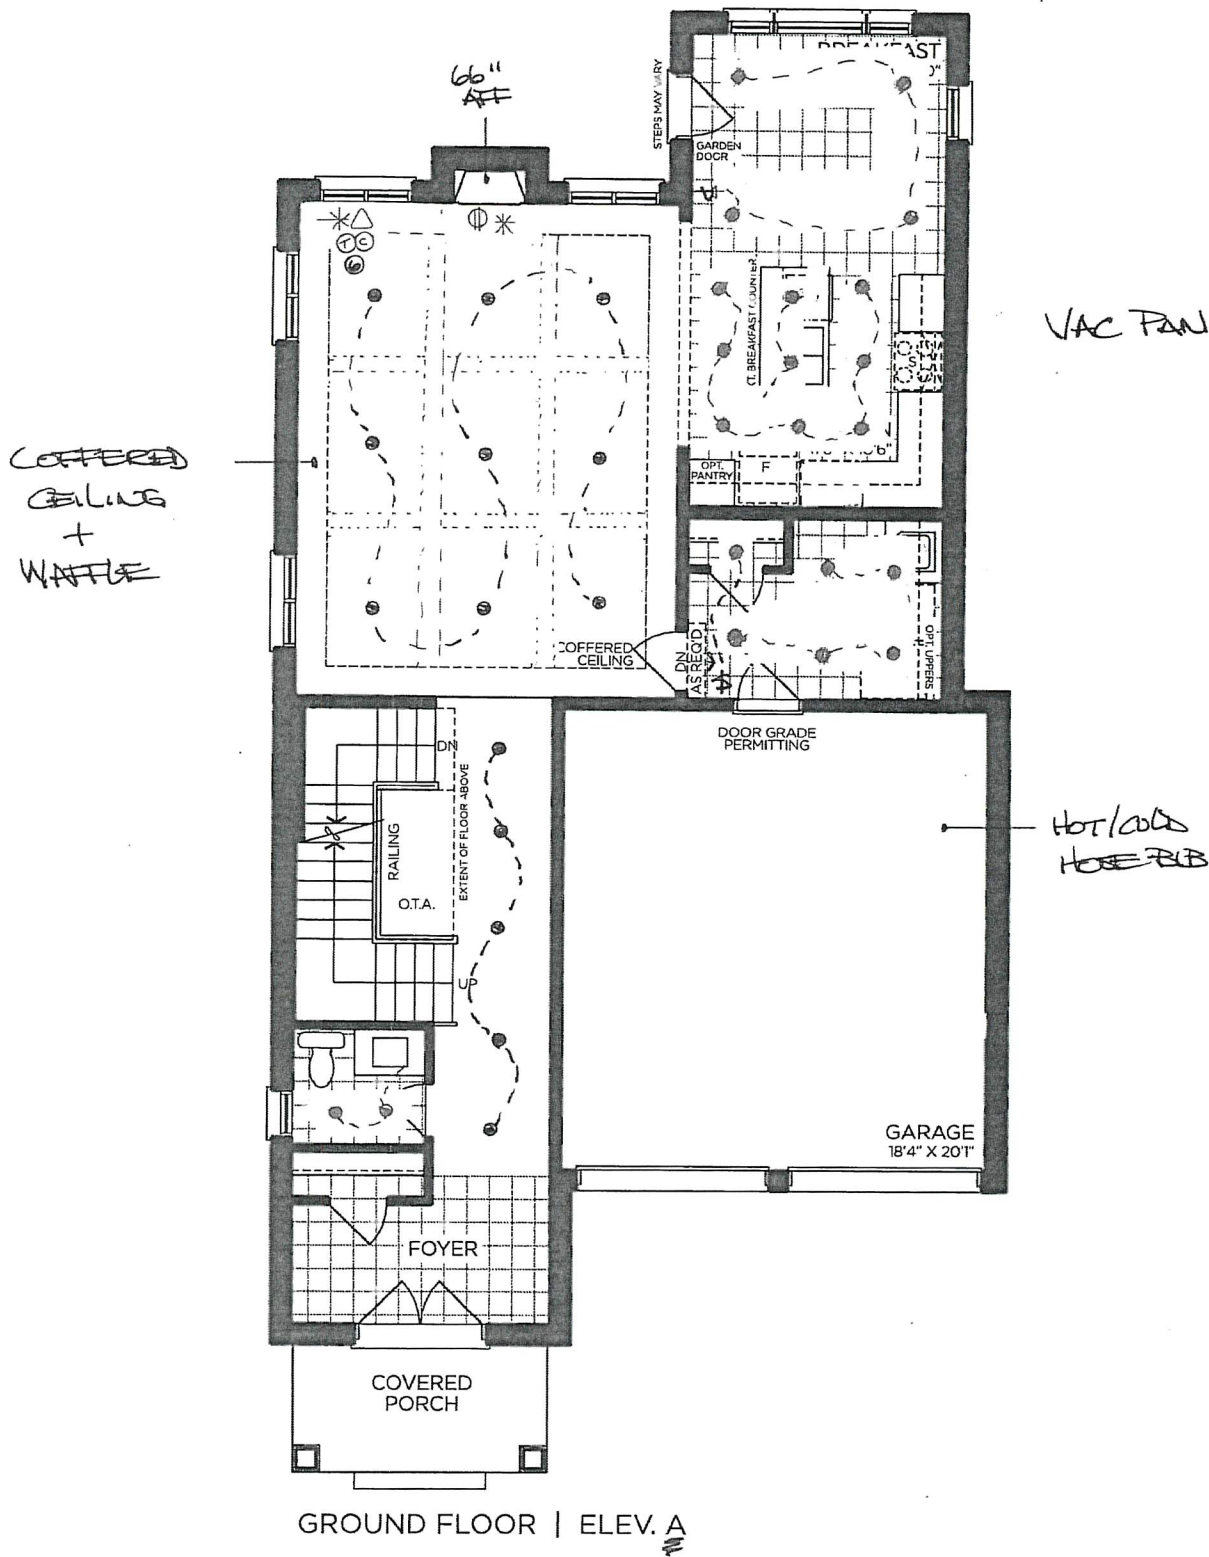

VENDOR

PURCHASER

PURCHASER

GOLDPARK
WORTH MORE™

Prices, figures, illustrations, sizes, features and finishes are subject to change without notice. Areas and dimensions are approximate and actual usable floor space may vary from the stated area. Layout may be reverse of the unit purchased. E. & O.E. 4007


SCHEDULE 'F'



PV- 111 *see attached* *see attached*
APRIL 24 2020

The
Suncrest
40' SERIES

→ Elevation A • 2,520 sq.ft.
Elevation B • 2,535 sq.ft.

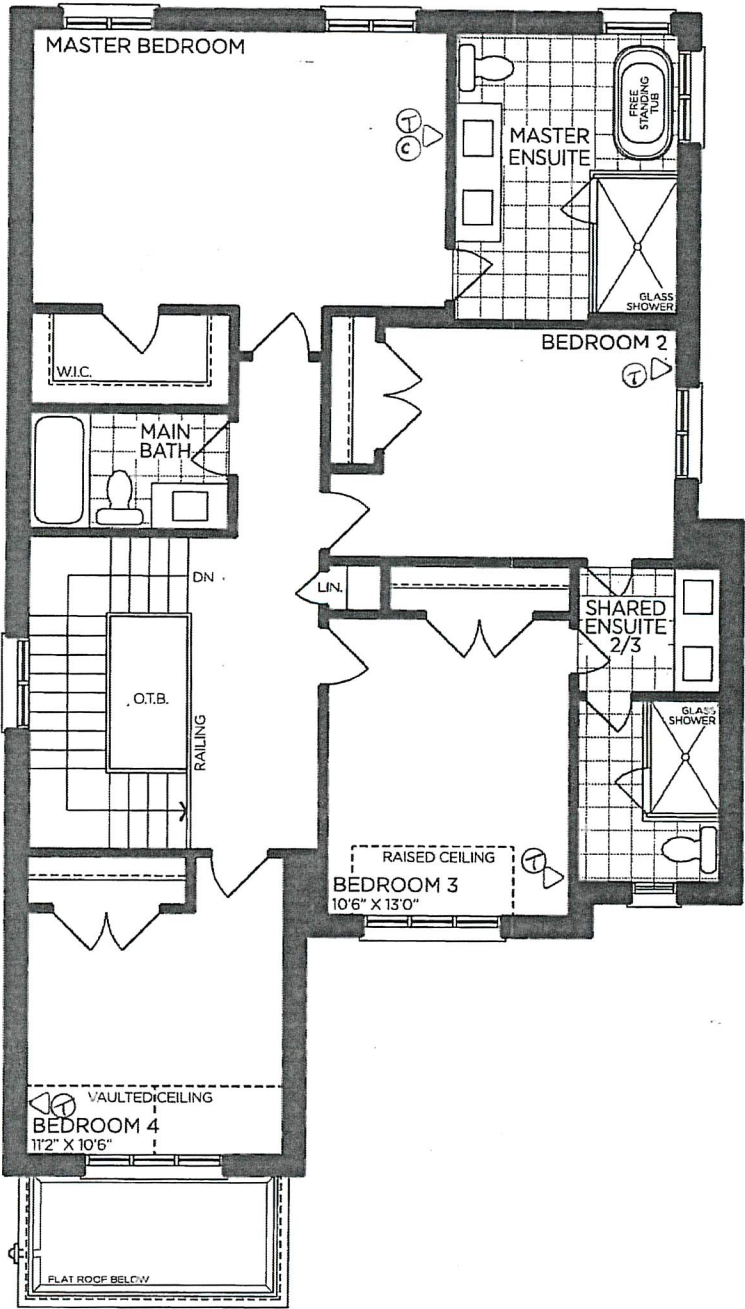

SECOND FLOOR | ELEV. A

VENDOR

PURCHASER

PURCHASER

GOLDPARK
WORTH MORE™

Prices, figures, illustrations, sizes, features and finishes are subject to change without notice. Areas and dimensions are approximate and actual usable floor space may vary from the stated area. Layout may be reverse of the unit purchased. E. & O.E. 4007


SCHEDULE 'F'



PV- III
APRIL 24 2020
See attached
See attached

The
Suncrest
40' SERIES

→ Elevation A • 2,520 sq.ft.
Elevation B • 2,535 sq.ft.

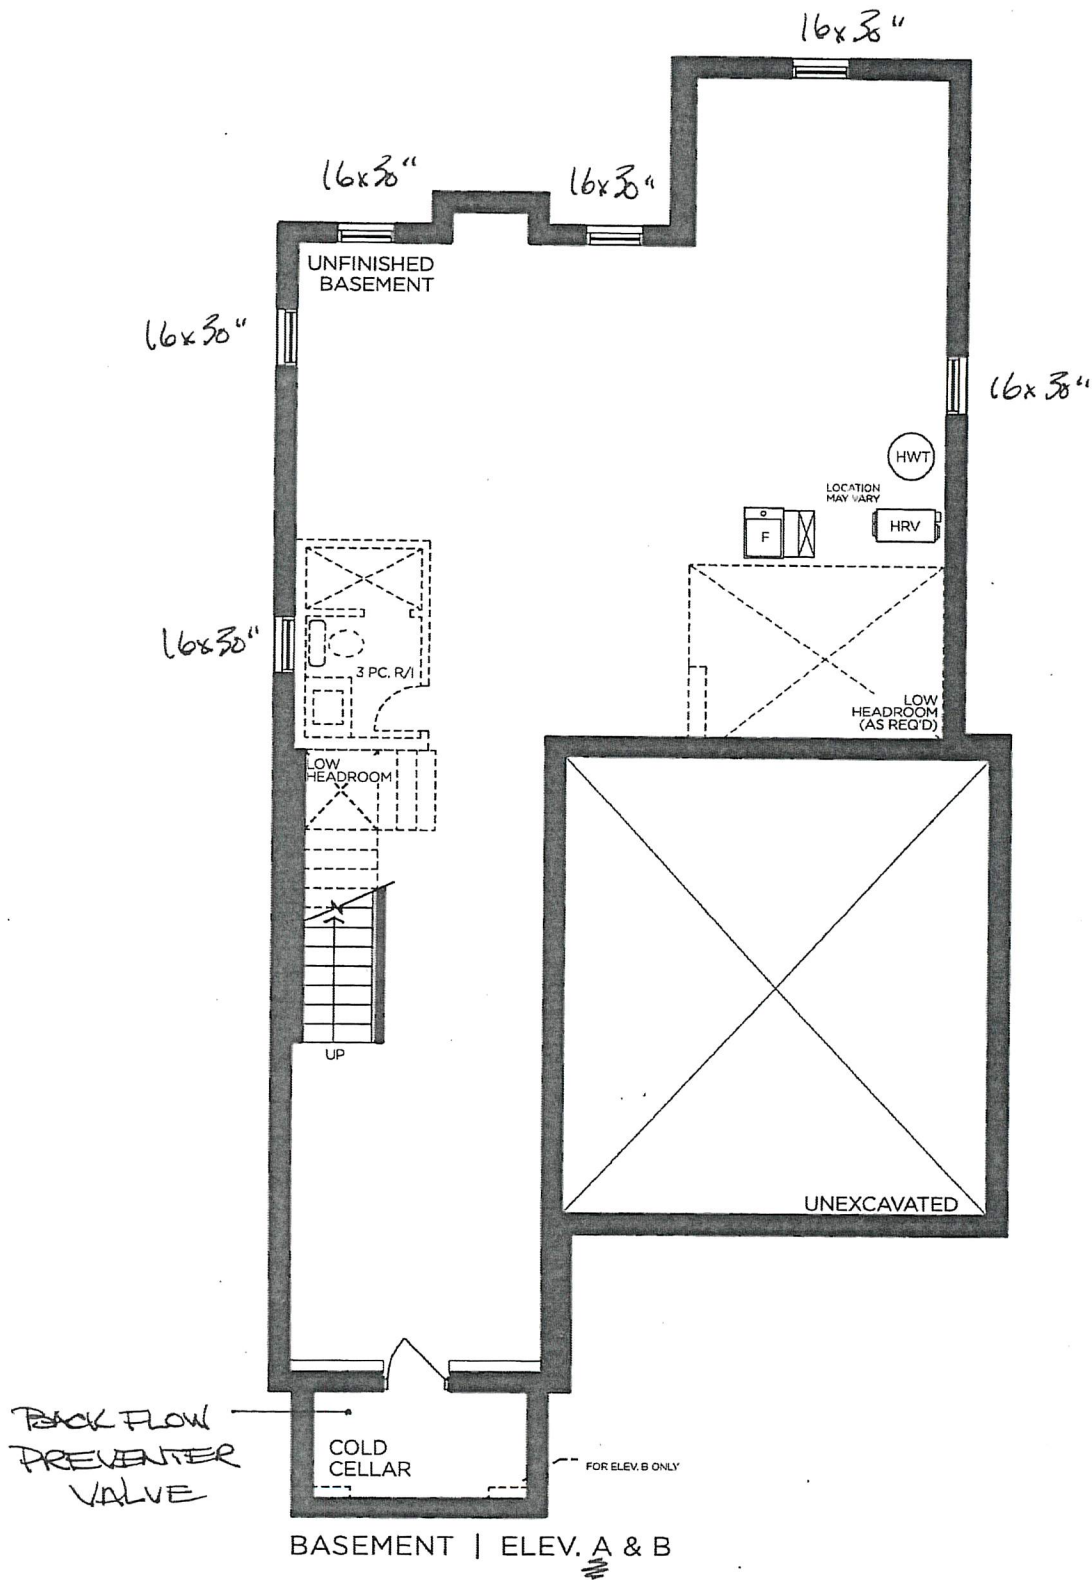

VENDOR

PURCHASER

PURCHASER

GOLDPARK
WORTH MORE™

Prices, figures, illustrations, sizes, features and finishes are subject to change without notice. Areas and dimensions are approximate and actual usable floor space may vary from the stated area. Layout may be reverse of the unit purchased. E. & O.E. 4007