

- (RC) COMPLETE ROOF (INCLUDING REAR) CONNECTED TO FRONT DOWNSPOUT AND CONNECTED TO RDC SERVICE CONNECTION.
(RF) HALF ROOF CONNECTED TO FRONT DOWNSPOUT AND CONNECTED TO RDC SERVICE CONNECTION.
(RR) HALF ROOF CONNECTED TO REAR DOWNSPOUT AND CONNECTED TO INFILTRATION TRENCH.

- 1.1 - ROOF DRAINS TO BE CONNECTED AT THE FRONT TO RDC SERVICE CONNECTION FOR ROOF CONFIGURATIONS RC, RF, & RR (REFER TO SCS DWG. 906 DETAIL B)
1.2 - IF ROOF CONFIGURATION IS RF OR RC, FRONT ROOF DRAINS TO BE CONNECTED TO FRONT DOWNSPOUT & CONNECTED TO RDC SERVICE CONNECTION. (REFER TO SCS DWG. 906 DETAIL B)
1.3 - IF ROOF CONFIGURATION IS RR, REAR ROOF DRAINS TO BE CONNECTED TO REAR ROOF DOWNSPOUT AND CONNECTED TO INFILTRATION TRENCH (REFER TO SCS DWG. 906 DETAIL A)
1.4 - THE CONTRACTOR SHALL CHECK AND VERIFY ALL GIVEN GRADE ELEVATIONS PRIOR TO COMMENCEMENT OF CONSTRUCTION. FOOTINGS TO BEAR ON NATURAL UNDISTURBED SOIL OR ROCK AND TO BE A MINIMUM OF 1.22m BELOW FINISHED GRADE.
1.5 - ALL FRONT AND REAR YARDS SHALL BE GRADED AT A 2%-5% GRADE WITHIN 6.0m OF THE DWELLING UNIT.
1.6 - MAXIMUM DRIVEWAY SLOPE SHALL BE 8%.
1.7 - THE MAXIMUM, ALLOWABLE SLOPE IS 3:1 (HORIZONTAL AND VERTICAL) WITH A MAXIMUM ELEVATION DIFFERENCE OF 600mm.
1.8 - DRIVEWAYS TO BE SET BACK A MINIMUM OF 1.0m, FROM ABOVE GROUND SERVICES OR OTHER OBSTRUCTION.
1.9 - LOT HIGH POINT (HP) TO BE 2.0m UPSTREAM OF DOWNSPOUTS
1.10 - ROOF LEADER EMERGENCY OVERFLOW TO DISCHARGE VIA SPLASH PAD. (REFER TO SCS DWG. 906 DETAIL A FOR ROOF CONFIGURATION RR AND DETAIL B FOR ROOF CONFIGURATION RC & RF)
1.11 - INFILTRATION TRENCHES NOT TO CROSS BETWEEN LOT LINES. (REFER TO SCS DWG. 906 DETAIL A)
1.12 - IF ROOF CONFIGURATION IS RR, REAR ROOF DOWNSPOUTS CONNECTED TO 100mmØ CAP. REMOVE CAP AND CONNECT TO REAR LOT INFILTRATION TRENCH. BUILDER IS RESPONSIBLE TO BUILD THE REAR YARD ROOF LEADER CONNECTION TO THE CAP AT THE TRENCHES (TYP.) REFER TO SCS DWG. 906 DETAIL A.
1.13 - BUILDER TO REFER TO SCS DWG. 906 DETAILS A & B FOR DETAILS ON THE INFILTRATION TRENCH.

LOT 147


WE HAVE REVIEWED THE SITE AND GRADING PLAN FOR THE PROPOSED BUILDING TO BE CONSTRUCTED, AND HEREBY CERTIFY THAT:

- The proposed grading and appurtenant drainage works comply with sound engineering principles.
- The proposed grading is in conformity with the grading plan approval for this subdivision and will not adversely affect adjacent lands.
- The proposed building is compatible with the proposed grading.
- The proposed water service curb stop is to be located in the grassed portion of the front yard.
- The driveway conforms with the City of Vaughan By-Law 1-88 as amended and is a minimum 1.0 metre clear of all street landscape catch basins.
- The proposed building is a minimum of 0.6 m side yard setback from a drainage swale.


SCS CONSULTING GROUP LTD.



Date: April 22/20 Reviewed By: M.R.C.

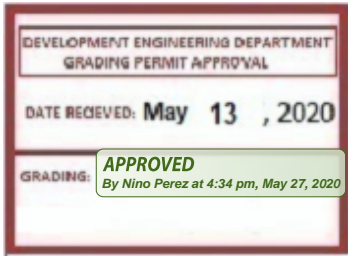

20-363 EP

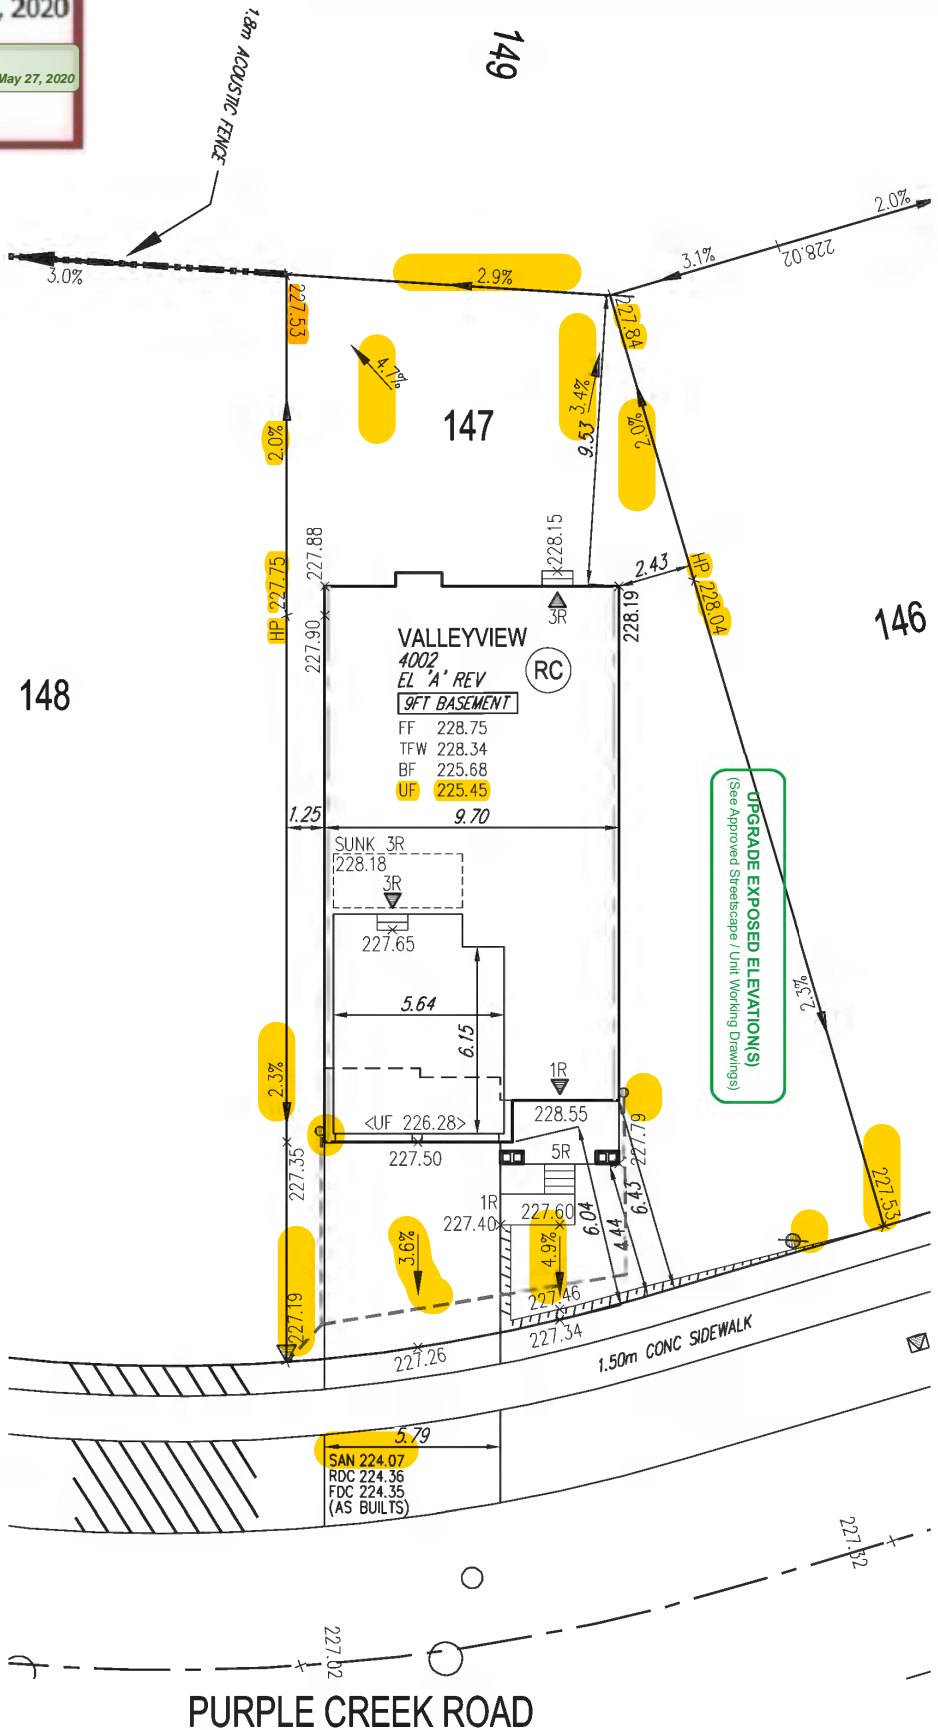

COVERAGE CALCULATION	
LOT NO.:	147
LOT AREA:	520.100000
BLDG. AREA: (INCL PORCH)	0.000000
LOT COVERAGE:	0.00 %
LANDSCAPE AREA:	0.000000
LANDSCAPE COV.:	0.00 %
BUILDING HEIGHT	
MAX BUILDING HEIGHT:	11.000000
FROM AVERAGE FIN. GRADE@ FRONT OF BUILDING TO MEAN	
ESTABLISHED GRADE:	227.50
F.F. TO TOP OF ROOF:	11.430000
F.F. TO MEAN OF ROOF:	8.790000
PROPOSED BLDG. HGT:	10.04 m
FRONT YARD LANDSCAPE AREA	
FRONT YARD AREA:	91.570000
LANDSCAPE AREA:	56.600000
COVERAGE (60% MIN.):	61.81 %
SOFT LANDSCAPE AREA:	51.700000
SOFT COVERAGE (80% MIN.):	91.34 %
REAR YARD LANDSCAPE AREA	
REAR YARD AREA:	119.300000
SOFT LANDSCAPE AREA:	119.300000
COVERAGE (60% MIN.):	100.00 %

ENGINEERED FILL LOTS	DOUBLE STM / SAN / FDC / RDC CONNECTION REFER TO SCS DWG. 902 DETAIL I-1 MODIFIED.
STREET TREE	SINGLE STM / SAN / FDC / RDC CONNECTION REFER TO SCS DWG. 902 DETAIL I-1 MODIFIED.
RETAINING WALL	INFILTRATION TRENCH
CATCH BASIN	

CONNECTION TO RDC LATERAL SERVICE AT THE FRONT OF THE HOUSE (SEE NOTE 1.1) AND CONNECTION TO REAR LOT INFILTRATION TRENCH WHEN ROOF CONFIGURATION IS RR (SEE NOTE 1.3)	SANITARY MANHOLE
STORM MANHOLE	VALVE & CHAMBER
VALVE & BOX	HYDRANT
AIR CONDITIONER	

WATER SERVICE	BELL PEDESTAL	HYDRO TRANSFORMER
HYDRO SERVICE	CABLE PEDESTAL	PADMOUNTED MOTOR
SHEET DRAINAGE	HYDRO POLE	EXISTING GRADES
STREET LIGHT PEDESTAL	HYDRO POLE GLY	PROPOSED GRADES
STREET LIGHT	STREET SIGN	SWALE DIRECTION
TRAFFIC SIGNAL POWER PEDESTAL	COMMUNITY MAILBOX	EMBANKMENT / BERM
		MAX 3:1 SLOPE

SANITARY LINE	STORM WATER LINE	WATERLINE	HYDRO LINE	GAS LINE	CABLE LINE	BELL	HYDRO, GAS, BELL, CABLE LINE
---------------	------------------	-----------	------------	----------	------------	------	------------------------------

DOWNSPOUTS	WINDOWS PERMITTED	45 MINUTE FIRE RATED WALL	SIDEYARD DISTANCE IS LESS THAN 1.2m TO LOT LINE (NO WINDOWS PERMITTED)	EXTERIOR DOOR LOCATION	EXTERIOR DOOR LOCATION IF GRADE PERMITS	SUMP PUMP AND SURFACE DISCHARGE LOCATION	UPGRADE ELEVATION	CHAIN LINK FENCE	FENCE AND GATE	PRIVACY FENCE	ACOUSTIC FENCE
------------	-------------------	---------------------------	------------------------------------------------------------------------	------------------------	-----------------------------------------	------------------------------------------	-------------------	------------------	----------------	---------------	----------------

FF FINISHED FLOOR	TFW TOP OF FOUNDATION WALL	BF BASEMENT FLOOR	UF UNDERSIDE OF FOOTING	WOD WALKOUT DECK	WOB WALKOUT BASEMENT	MOD MODIFIED	REV REVERSED	ND NO DOOR	HIGHLIGHTED GRADE
-------------------	----------------------------	-------------------	-------------------------	------------------	----------------------	--------------	--------------	------------	-------------------

SITING AND GRADING PLAN

THE UNDERSIGNED HAS REVIEWED AND TAKES RESPONSIBILITY FOR THIS DESIGN AND HAS THE QUALIFICATIONS AND MEETS THE REQUIREMENTS SET OUT IN THE ONTARIO BUILDING CODE TO BE A DESIGNER.

QUALIFICATION INFORMATION

Allan Whiting 23177

NAME SIGNATURE BCIN

HUNT DESIGN ASSOCIATES INC. 19695

HUNT DESIGN ASSOCIATES INC.

www.huntdesign.ca

GOLDPARK HOMES - 217020 PINE VALLEY, VAUGHAN ONT.

Drawn By: AW Checked By: AW Scale: 1:250 File Number: 217020WSP01

8966 Woodbine Ave, Markham, ON L3R 0J7 T 905.737.5133 F 905.737.7326

Lot / Page Number

147