

- (RC) COMPLETE ROOF (INCLUDING REAR) CONNECTED TO FRONT DOWNSPOUT AND CONNECTED TO RDC SERVICE CONNECTION.  
(RF) HALF ROOF CONNECTED TO FRONT DOWNSPOUT AND CONNECTED TO RDC SERVICE CONNECTION.  
(RR) HALF ROOF CONNECTED TO REAR DOWNSPOUT AND CONNECTED TO INFILTRATION TRENCH.

- 1.1 - ROOF DRAINS TO BE CONNECTED AT THE FRONT TO RDC SERVICE CONNECTION FOR ROOF CONFIGURATIONS RC, RF, & RR (REFER TO SCS DWG. 906 DETAIL B)  
1.2 - IF ROOF CONFIGURATION IS RF OR RC, FRONT ROOF DRAINS TO BE CONNECTED TO FRONT DOWNSPOUT & CONNECTED TO RDC SERVICE CONNECTION. (REFER TO SCS DWG. 906 DETAIL B)  
1.3 - IF ROOF CONFIGURATION IS RR, REAR ROOF DRAINS TO BE CONNECTED TO REAR ROOF DOWNSPOUT AND CONNECTED TO INFILTRATION TRENCH (REFER TO SCS DWG. 906 DETAIL A)  
1.4 - THE CONTRACTOR SHALL CHECK AND VERIFY ALL GIVEN GRADE ELEVATIONS PRIOR TO COMMENCEMENT OF CONSTRUCTION. FOOTINGS TO BEAR ON NATURAL UNDISTURBED SOIL OR ROCK AND TO BE A MINIMUM OF 1.22m BELOW FINISHED GRADE.  
1.5 - ALL FRONT AND REAR YARDS SHALL BE GRADED AT A 2%-5% GRADE WITHIN 6.0m OF THE DWELLING UNIT.  
1.6 - MAXIMUM DRIVEWAY SLOPE SHALL BE 8%.  
1.7 - THE MAXIMUM, ALLOWABLE SLOPE IS 3:1 (HORIZONTAL AND VERTICAL) WITH A MAXIMUM ELEVATION DIFFERENCE OF 600mm.  
1.8 - DRIVEWAYS TO BE SET BACK A MINIMUM OF 1.0m, FROM ABOVE GROUND SERVICES OR OTHER OBSTRUCTION.  
1.9 - LOT HIGH POINT (HP) TO BE 2.0m UPSTREAM OF DOWNSPOUTS  
1.10 - ROOF LEADER EMERGENCY OVERFLOW TO DISCHARGE VIA SPLASH PAD. (REFER TO SCS DWG. 906 DETAIL A FOR ROOF CONFIGURATION RR AND DETAIL B FOR ROOF CONFIGURATION RC & RF)  
1.11 - INFILTRATION TRENCHES NOT TO CROSS BETWEEN LOT LINES. (REFER TO SCS DWG. 906 DETAIL A)  
1.12 - IF ROOF CONFIGURATION IS RR, REAR ROOF DOWNSPOUTS CONNECTED TO 100mmØ CAP. REMOVE CAP AND CONNECT TO REAR LOT INFILTRATION TRENCH. BUILDER IS RESPONSIBLE TO BUILD THE REAR YARD ROOF LEADER CONNECTION TO THE CAP AT THE TRENCHES (TYP.) REFER TO SCS DWG. 906 DETAIL A.  
1.13 - BUILDER TO REFER TO SCS DWG. 906 DETAILS A & B FOR DETAILS ON THE INFILTRATION TRENCH.

LOT 15

WE HAVE REVIEWED THE SITE AND GRADING PLAN FOR THE PROPOSED BUILDING TO BE CONSTRUCTED, AND HEREBY CERTIFY THAT:


- The proposed grading and appurtenant drainage works comply with sound engineering principles.
- The proposed grading is in conformity with the grading plan approval for this subdivision and will not adversely affect adjacent lands.
- The proposed building is compatible with the proposed grading.
- The proposed water service curb stop is to be located in the grassed portion of the front yard.
- The driveway conforms with the City of Vaughan By-Law 1-88 as amended and is a minimum 1.0 metre clear of all street landscape catch basins.
- The proposed building is a minimum of 0.6 m side yard setback from a drainage swale.

SCS CONSULTING GROUP LTD.



Date: April 27/20 Reviewed By: M.R.C.

20- 362 EP

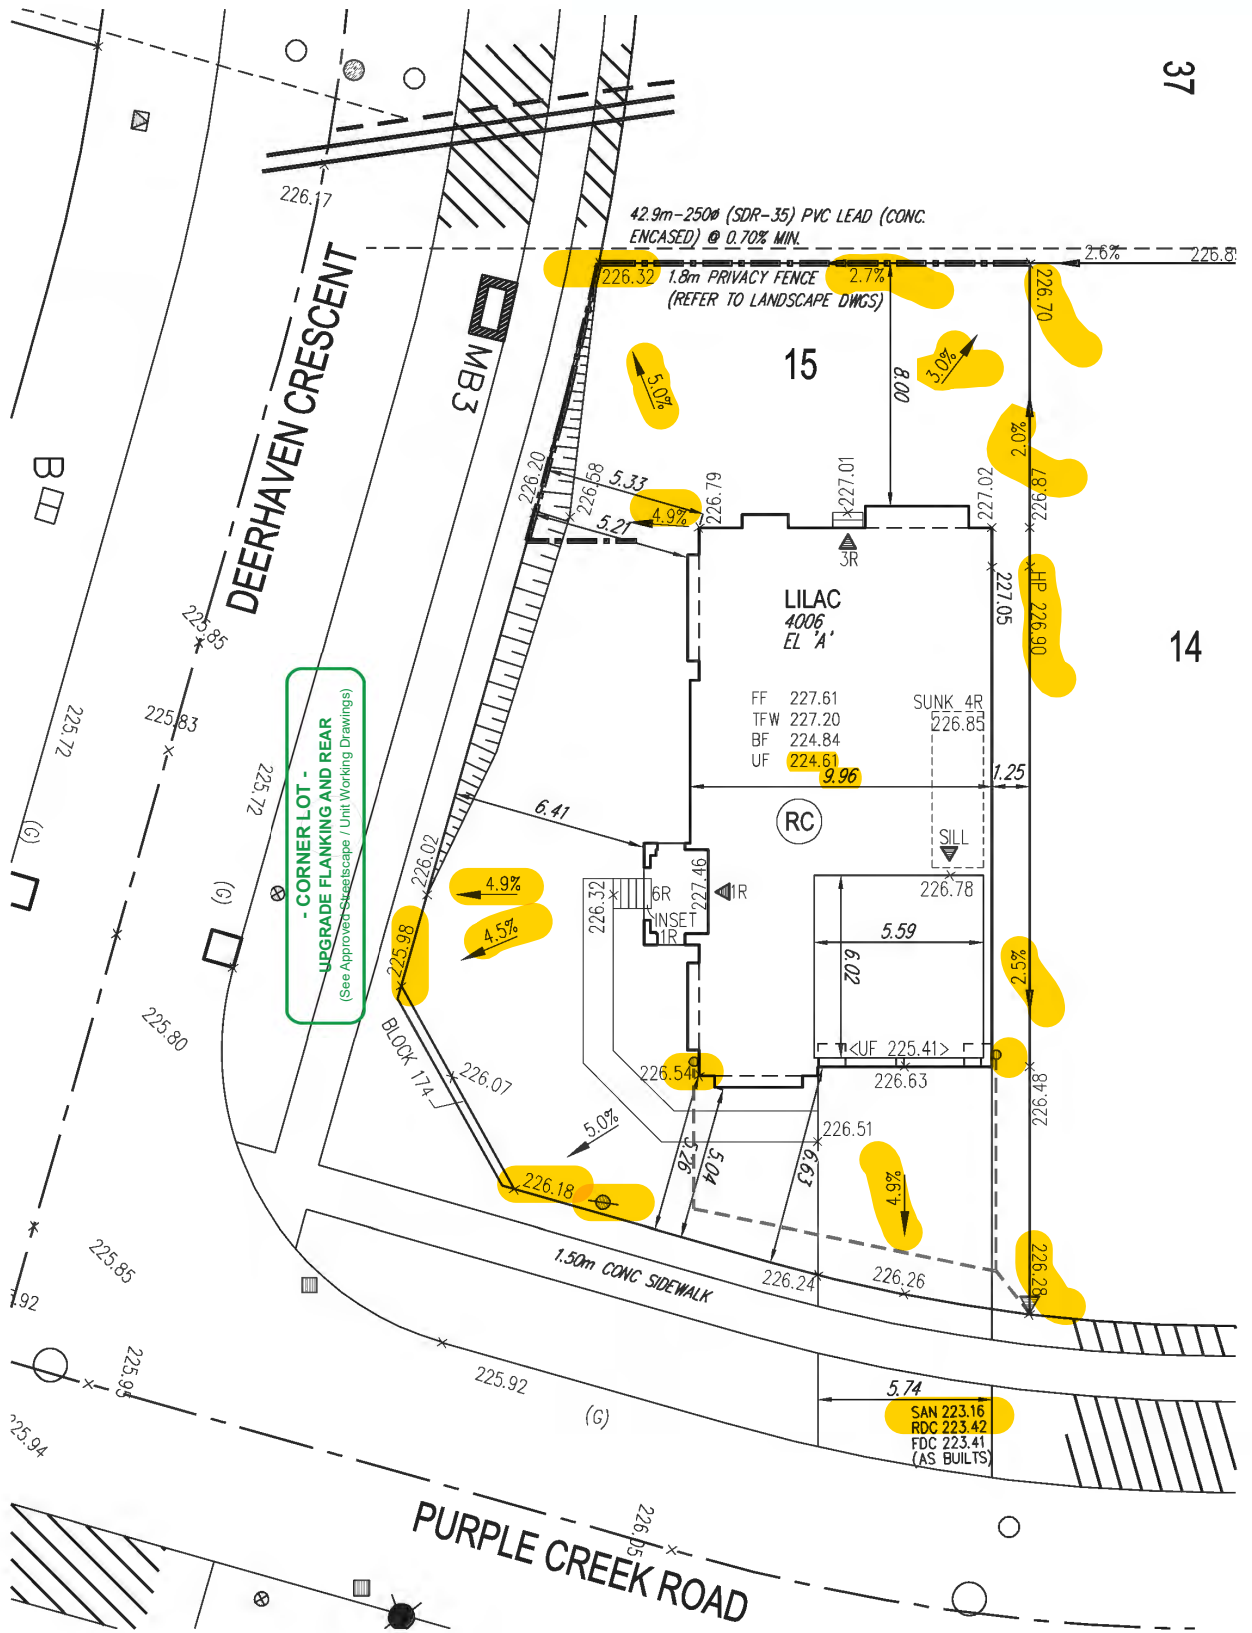

| COVERAGE CALCULATION                               |            |
|--|------------|
| LOT NO. :  | 15         |
| LOT AREA :   | 578.950000 |
| BLDG. AREA : (INCL. PORCH)                         | 0.000000   |
| LOT COVERAGE :                                     | 0.00 %     |
| LANDSCAPE AREA:                                    | 0.000000   |
| LANDSCAPE COV. :                                   | 0.00 %     |
| BUILDING HEIGHT                                    |            |
| MAX BUILDING HEIGHT:                               | 11.000000  |
| FROM AVERAGE FIN. GRADE@ FRONT OF BUILDING TO MEAN |            |
| ESTABLISHED GRADE:                                 | 226.54     |
| F.F. TO TOP OF ROOF:                               | 10.900000  |
| F.F. TO MEAN OF ROOF:                              | 8.520000   |
| PROPOSED BLDG. HGT:                                | 9.59 m     |
| FRONT YARD LANDSCAPE AREA                          |            |
| FRONT YARD AREA :                                  | 106.280000 |
| LANDSCAPE AREA :                                   | 64.900000  |
| COVERAGE (60% MIN.):                               | 61.07 %    |
| SOFT LANDSCAPE AREA:                               | 51.500000  |
| SOFT COVERAGE (60% MIN.):                          | 79.35 %    |
| REAR YARD LANDSCAPE AREA                           |            |
| REAR YARD AREA :                                   | 149.000000 |
| SOFT LANDSCAPE AREA :                              | 149.000000 |
| COVERAGE (60% MIN.):                               | 100.00 %   |




It is the builder's complete responsibility to ensure that all plans submitted for approval fully comply with the Architectural Guidelines and all applicable regulations and requirements including zoning provisions and any provisions in the subdivision agreement. The Control Architect is not responsible in any way for examining or approving site (lotting) plans or working drawings with respect to any zoning or building code or permit matter or that any house can be properly built or located on its lot.

This is to certify that these plans comply with the applicable Architectural Design Guidelines approved by the City of VAUGHAN.

JOHN G. WILLIAMS LTD., ARCHITECT  
ARCHITECTURAL CONTROL REVIEW AND APPROVAL  
APPROVED BY: [Signature]  
DATE: MAY 04, 2020  
This stamp certifies compliance with the applicable Design Guidelines only and bears no further professional responsibility.

- GENERAL NOTES:
- BUILDER TO VERIFY LOCATION OF UTILITIES AND OTHER SERVICES. IF MIN. DIMENSIONS ARE NOT MAINTAINED, BUILDER IS TO RELOCATE AT BUILDER'S EXPENSE.
  - BUILDER TO VERIFY ELEV. OF STM. AND SAN. LATERALS IN RELATION TO BASEMENT US OF FOOTING ELEVATIONS FOR COMPLIANCE WITH MUNICIPAL STANDARDS PRIOR TO EXCAVATION.
  - APPROVED PERMIT DRAWINGS & CONSTRUCTION NOTES MUST BE REVIEWED AND FOLLOWED IN CONJUNCTION WITH THE SITING AND GRADING PLAN. BUILDER TO VERIFY BUILDING ENVELOPE ON SITE PLAN MATCHES APPROVED PERMIT DRAWINGS & CONSTRUCTION NOTES PRIOR TO POURING CONCRETE. IF THERE ARE ANY DISCREPANCIES, THEY ARE TO BE BROUGHT TO THE ATTENTION OF HUNT DESIGN ASSOCIATES INC.
  - UNLESS NOTED ON BUILDING ENVELOPE OR APPROVED PERMIT DRAWINGS & CONSTRUCTION NOTES, ALL TOP OF FOUNDATION WALLS INCLUDING GARAGE WALLS TO BE CONSISTENT WITH THE ELEVATION PROVIDED FOR TFW ON SITING AND GRADING PLAN. THE EXTERIOR OF THE FOUNDATION WALL TO BE PROVIDED WITH A REDUCTION OF THICKNESS FOR MASONRY VENEER AS REQUIRED.

|                                 |    |            |
|---------------------------------|----|------------|
| -                               | -  | -          |
| -                               | -  | -          |
| ISSUED FOR FINAL APPROVAL       | AW | 2020.04.17 |
| ISSUED FOR PRELIMINARY APPROVAL | AW | 2020.04.03 |

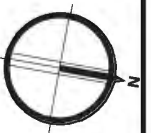

|                      |  |  |                  |                               |                   |                                 |                                  |
|----------------------|--|--|------------------|-------------------------------|-------------------|---------------------------------|----------------------------------|
| ENGINEERED FILL LOTS | DOUBLE STM / SAN / FDC / RDC CONNECTION, REFER TO SCS DWG. 902 DETAIL H1 MODIFIED. | CONNECTION TO RDC LATERAL SERVICE AT THE FRONT OF THE HOUSE (SEE NOTE 1.1) AND CONNECTION TO REAR LOT INFILTRATION TRENCH WHEN ROOF CONFIGURATION IS RR (SEE NOTE 1.3) | SANITARY MANHOLE | WATER SERVICE                 | BELL PEDESTAL     | HYDRO TRANSFORMER               | SAN - SANITARY LINE              |
| STREET TREE          | SINGLE STM / SAN / FDC / RDC CONNECTION, REFER TO SCS DWG. 902 DETAIL H1 MODIFIED. |  | STORM MANHOLE    | HYDRO SERVICE                 | CABLE PEDESTAL    | PADMOUNTED MOTOR                | STM - STORM WATER LINE           |
| RETAINING WALL       |  |  | VALVE & CHAMBER  | SHEET DRAINAGE                | HYDRO POLE        | EXISTING GRADES                 | W - WATERLINE                    |
| CATCH BASIN          | INFILTRATION TRENCH  | AIR CONDITIONER  | VALVE & BOX      | STREET LIGHT PEDESTAL         | HYDRO POLE GUY    | PROPOSED GRADES                 | H - HYDRO LINE                   |
|                      |  |  | HYDRANT          | STREET LIGHT                  | STREET SIGN       | EMBANKMENT / BERM MAX 3:1 SLOPE | G - GAS LINE                     |
|                      |  |  |                  | TRAFFIC SIGNAL POWER PEDESTAL | COMMUNITY MAILBOX |                                 | C - CABLE LINE                   |
|                      |  |  |                  |                               |                   |                                 | B - BELL                         |
|                      |  |  |                  |                               |                   |                                 | H - HYDRO, GAS, BELL, CABLE LINE |

## SITING AND GRADING PLAN

THE UNDERSIGNED HAS REVIEWED AND TAKES RESPONSIBILITY FOR THIS DESIGN AND HAS THE QUALIFICATIONS AND MEETS THE REQUIREMENTS SET OUT IN THE ONTARIO BUILDING CODE TO BE A DESIGNER.

QUALIFICATION INFORMATION  
Allan Whiting  
NAME  
REGISTRATION INFORMATION  
HUNT DESIGN ASSOCIATES INC.

23177  
BCIN

HUNT  
DESIGN ASSOCIATES INC.  
www.huntdesign.ca

GOLDPARK HOMES - 217020  
PINE VALLEY, VAUGHAN ONT.

Drawn By: OF  
Checked By: OF  
Scale: 1:250  
File Number: 217020WSP01  
8966 Woodbine Ave, Markham, ON L3R 0J7 T 905.737.5133 F 905.737.7326

Lot / Page Number  
15