

**Model: 50.03 B OAKGROVE****Project/Phase: Pine Valley Forevergreen / 1**

| Invoice | Qty. | Description |
|---------|------|-------------|
|---------|------|-------------|

| Invoice | Qty. | Description |
|---------|------|-------------|
|---------|------|-------------|

SCHEDULE 'F'



PV-99 *See attached*  
MAY 25 2026  
PV-99 *See attached*  
MAY 27 2026

The  
**Oakgrove**  
50' SERIES

Elevation A • 3,920 sq.ft.  
→ Elevation B • 3,905 sq.ft.  
Elevation C • 3,915 sq.ft.

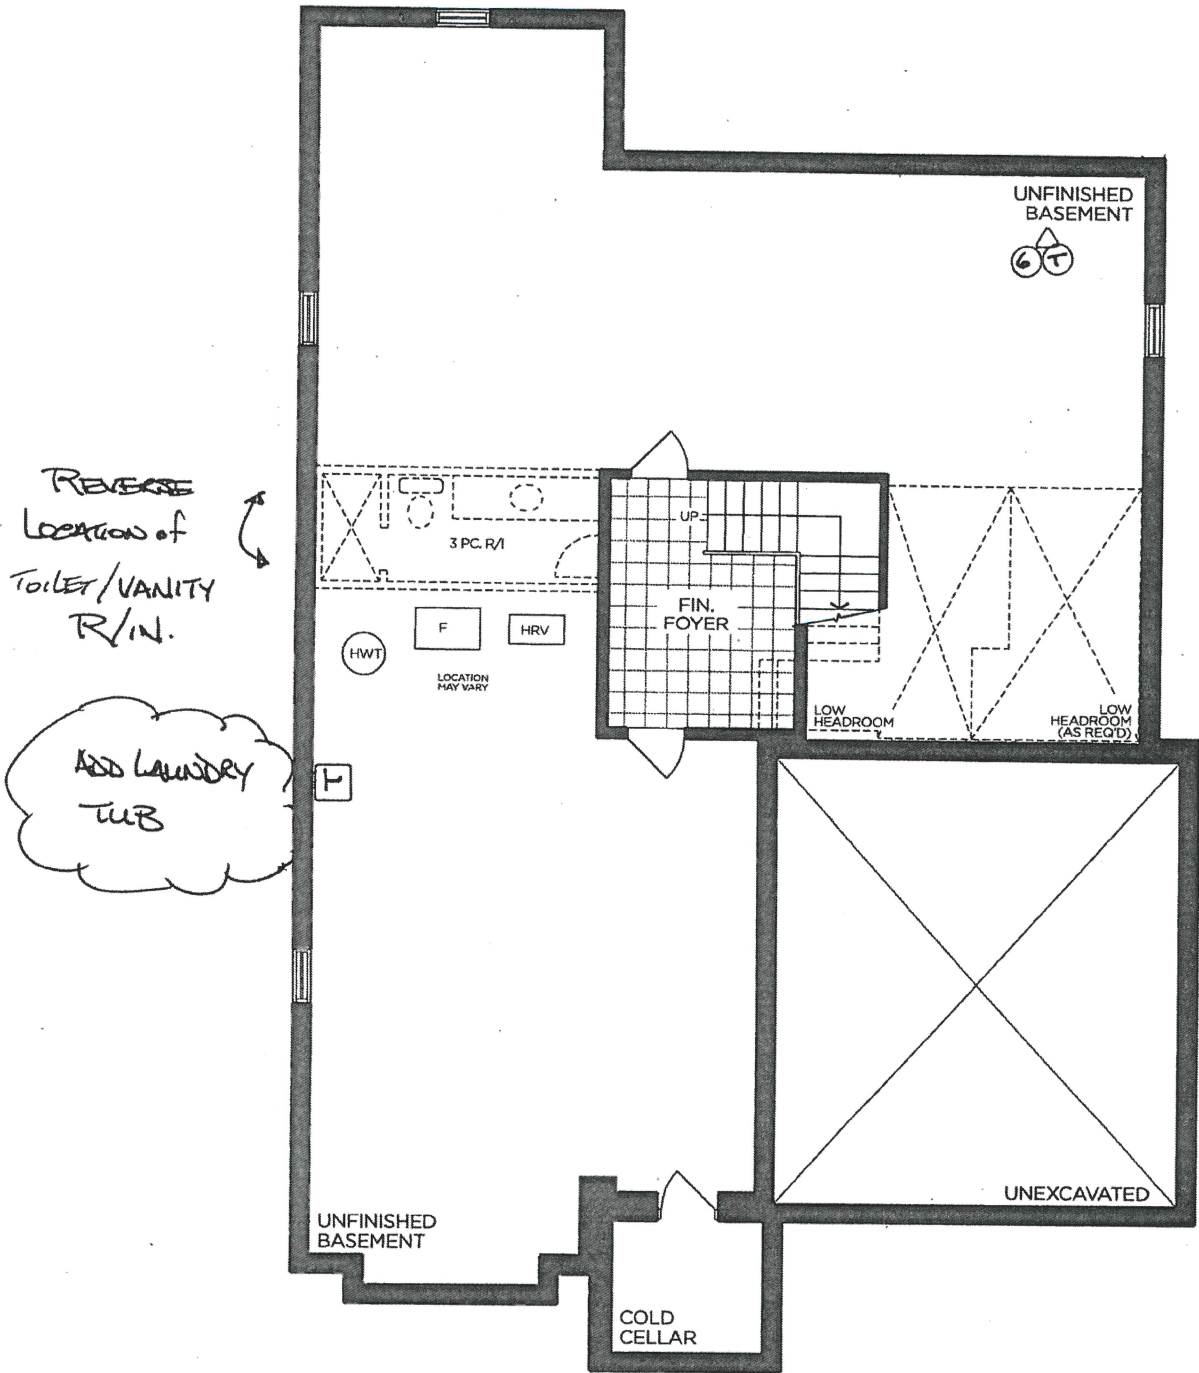

BASEMENT | ELEV. A

**GOLDPARK**  
WORTH MORE™

VENDOR

PURCHASER

PURCHASER

Prices, figures, illustrations, sizes, features and finishes are subject to change without notice. Areas and dimensions are approximate and actual usable floor space may vary from the stated area. Layout may be reverse of the unit purchased. E. & O.E. 5003


SCHEDULE 'F'



PV-99 *See date*  
MAY 25 2020  
PV-99 *See attached*  
MAY 27 2020

The  
**Oakgrove**  
50' SERIES

Elevation A • 3,920 sq.ft.  
Elevation B • 3,905 sq.ft.  
Elevation C • 3,915 sq.ft.

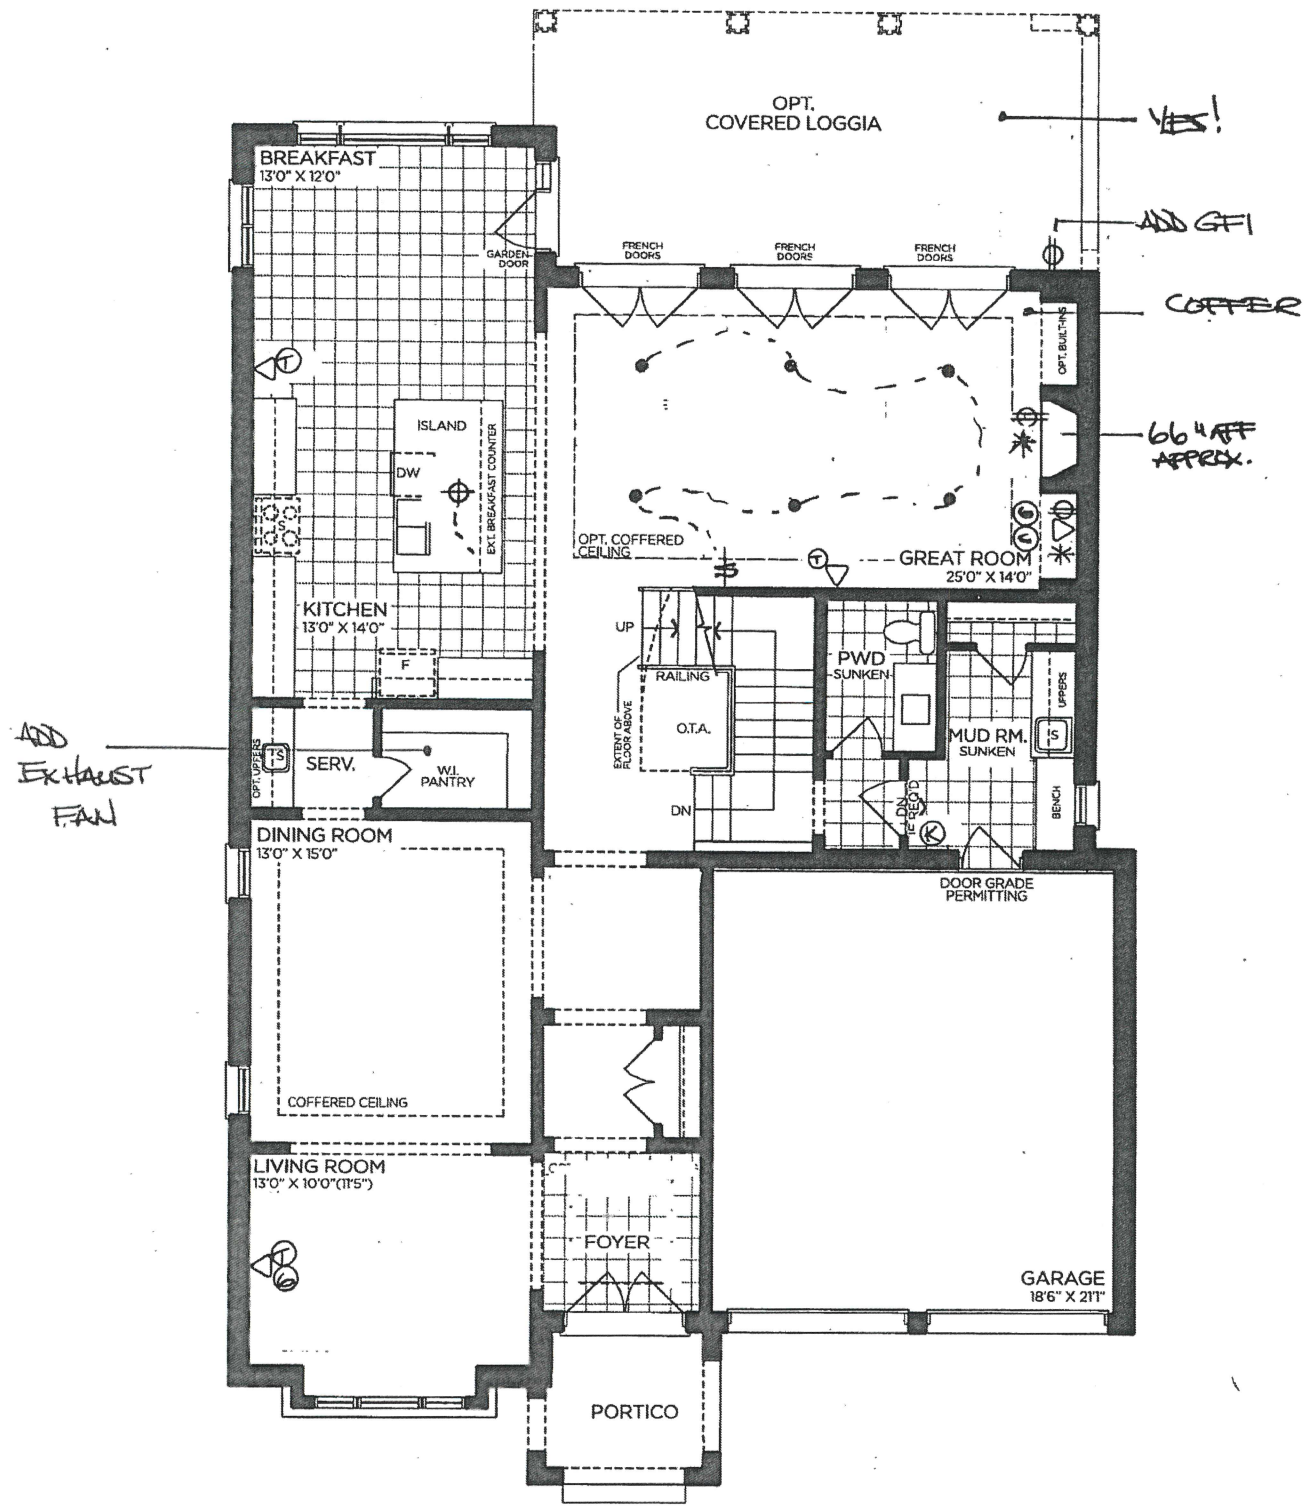

GROUND FLOOR | ELEV. A

**GOLDPARK**  
WORTH MORE™

VENDOR

PURCHASER

PURCHASER

Prices, figures, illustrations, sizes, features and finishes are subject to change without notice. Areas and dimensions are approximate and actual usable floor space may vary from the stated area. Layout may be reverse of the unit purchased. E. & O.E. 5003


SCHEDULE 'F'



PV-99 *see attached*  
MAY 25 2020  
PV-99 *see attached*  
MAY 27 2020

# The Oakgrove 50' SERIES

Elevation A • 3,920 sq.ft.  
→ Elevation B • 3,905 sq.ft.  
Elevation C • 3,915 sq.ft.

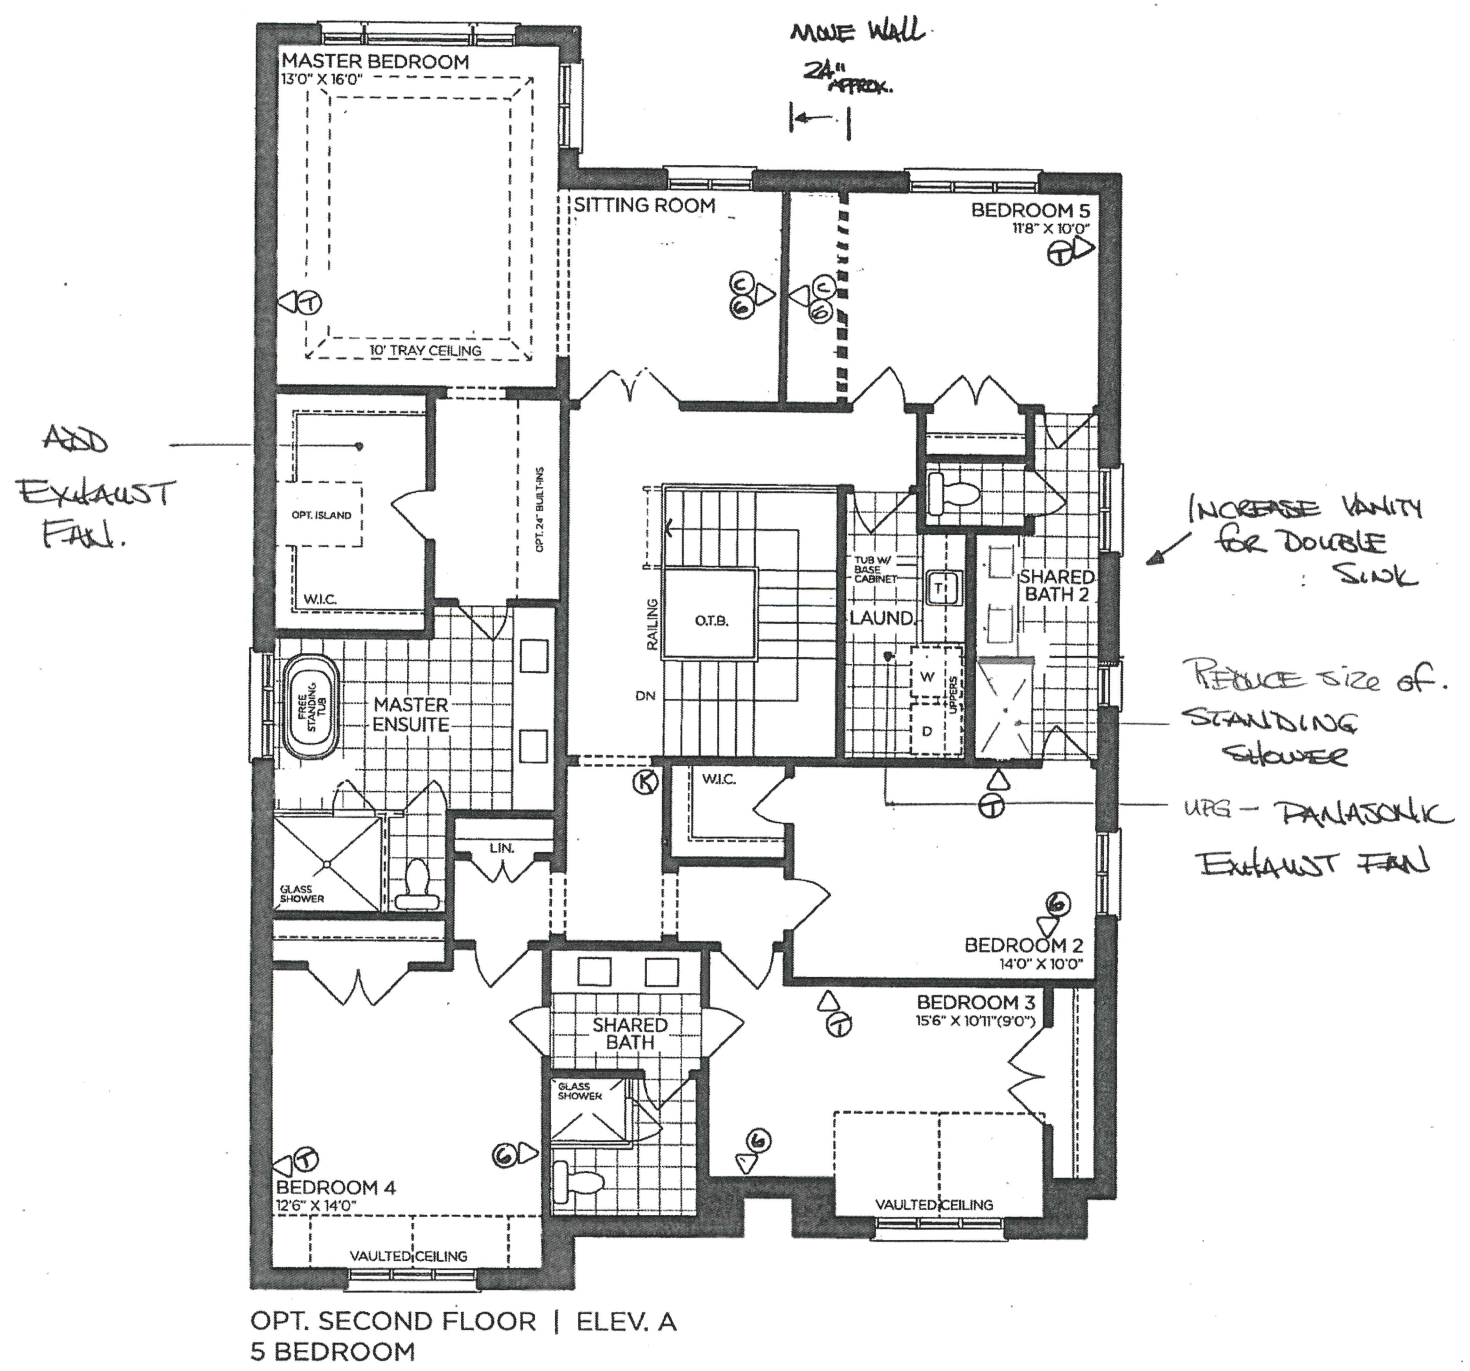

|           |                      |
|-----------|----------------------|
| VENDOR    | <input type="text"/> |
| PURCHASER | <input type="text"/> |
| PURCHASER | <input type="text"/> |

**GOLDPARK**  
WORTH MORE™

Prices, figures, illustrations, sizes, features and finishes are subject to change without notice. Areas and dimensions are approximate and actual usable floor space may vary from the stated area. Layout may be reverse of the unit purchased. E. & O.E. 5003



# SCHEDULE 'F'

PV-99 *kept*  
MAY 25 2026


PV-99 *S.B.*  
MAY 27 2026 *58*

## The Oakgrove 50' SERIES

Elevation A • 3,920 sq.ft.

→ Elevation B • 3,905 sq.ft.

Elevation C • 3,915 sq.ft.

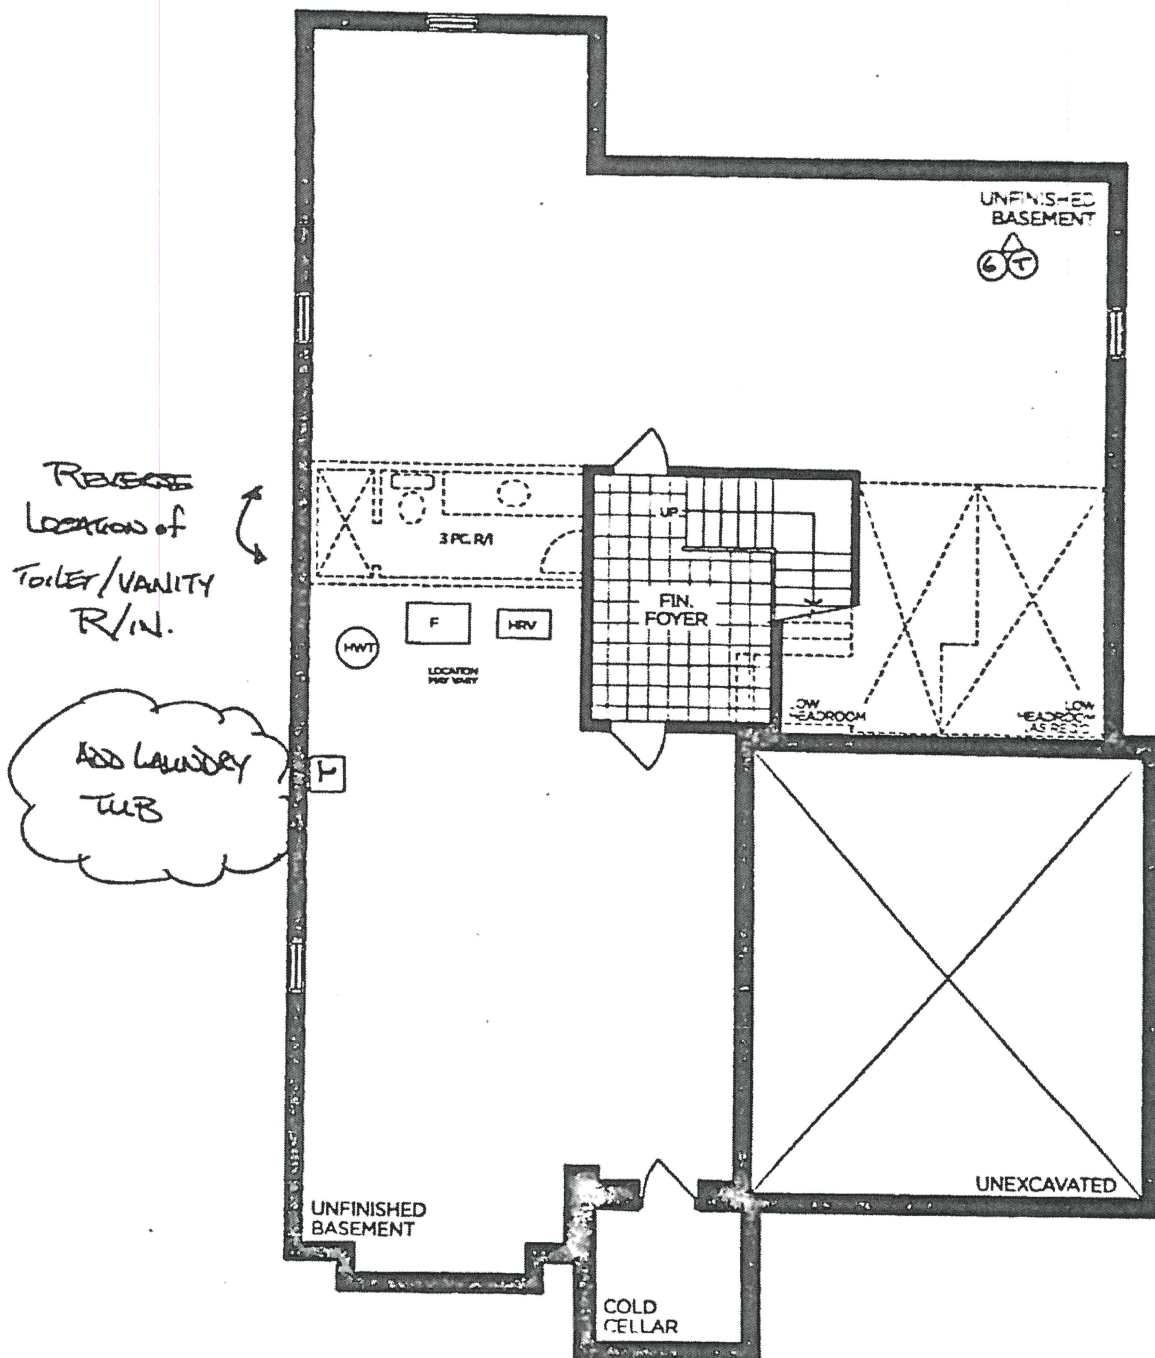



# SCHEDULE 'F'

PV-99 *see above*  
MAY 25 2020

PV-99  
MAY 27 2020 (S.B.) (S.J.)


## The Oakgrove

### 50' SERIES

Elevation A • 3,920 sq.ft.

→ Elevation B • 3,905 sq.ft.

Elevation C • 3,915 sq.ft.

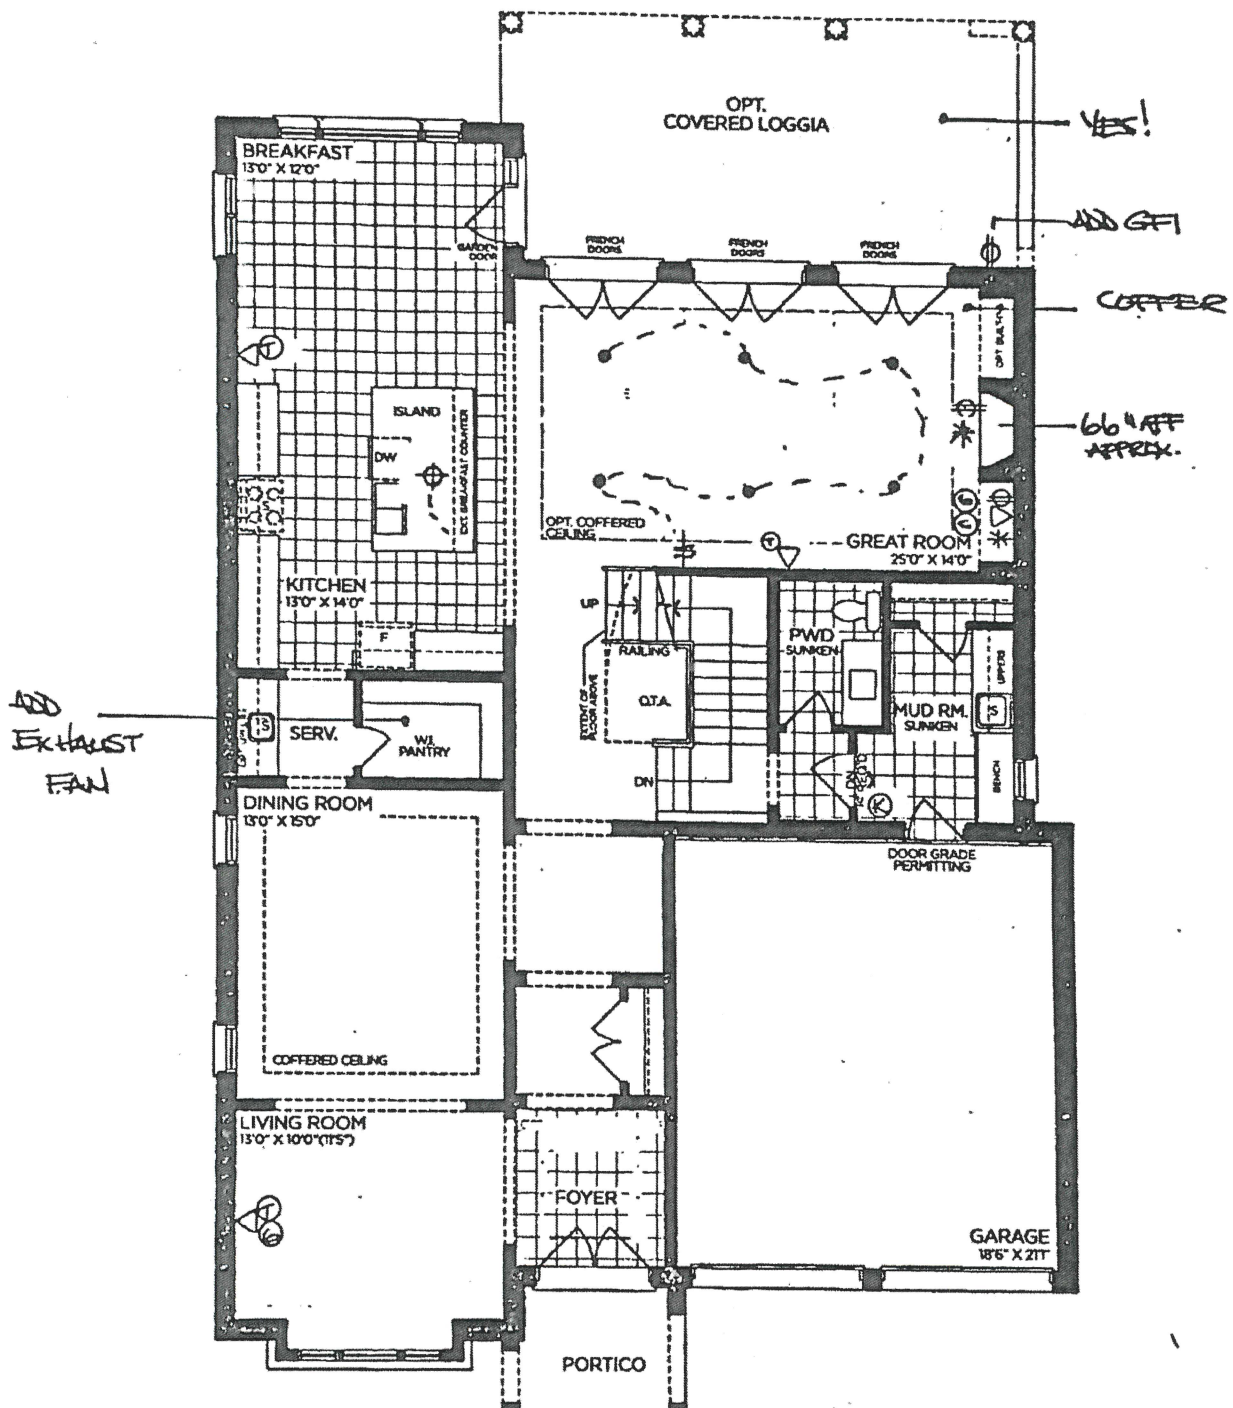

# SCHEDULE 'F'



PV-99 *See Note*  
MAY 25 2020

PV-99 *S.B. SJ*  
MAY 27 2020

## The Oakgrove 50' SERIES

Elevation A • 3,920 sq.ft.

→ Elevation B • 3,905 sq.ft.

Elevation C • 3,915 sq.ft.

