

SCHEDULE 'F'




PV-123
April 20, 2026
See attached

The Lilac

40' SERIES

Elevation A • 3,425 sq.ft.

→ Elevation B • 3,385 sq.ft.

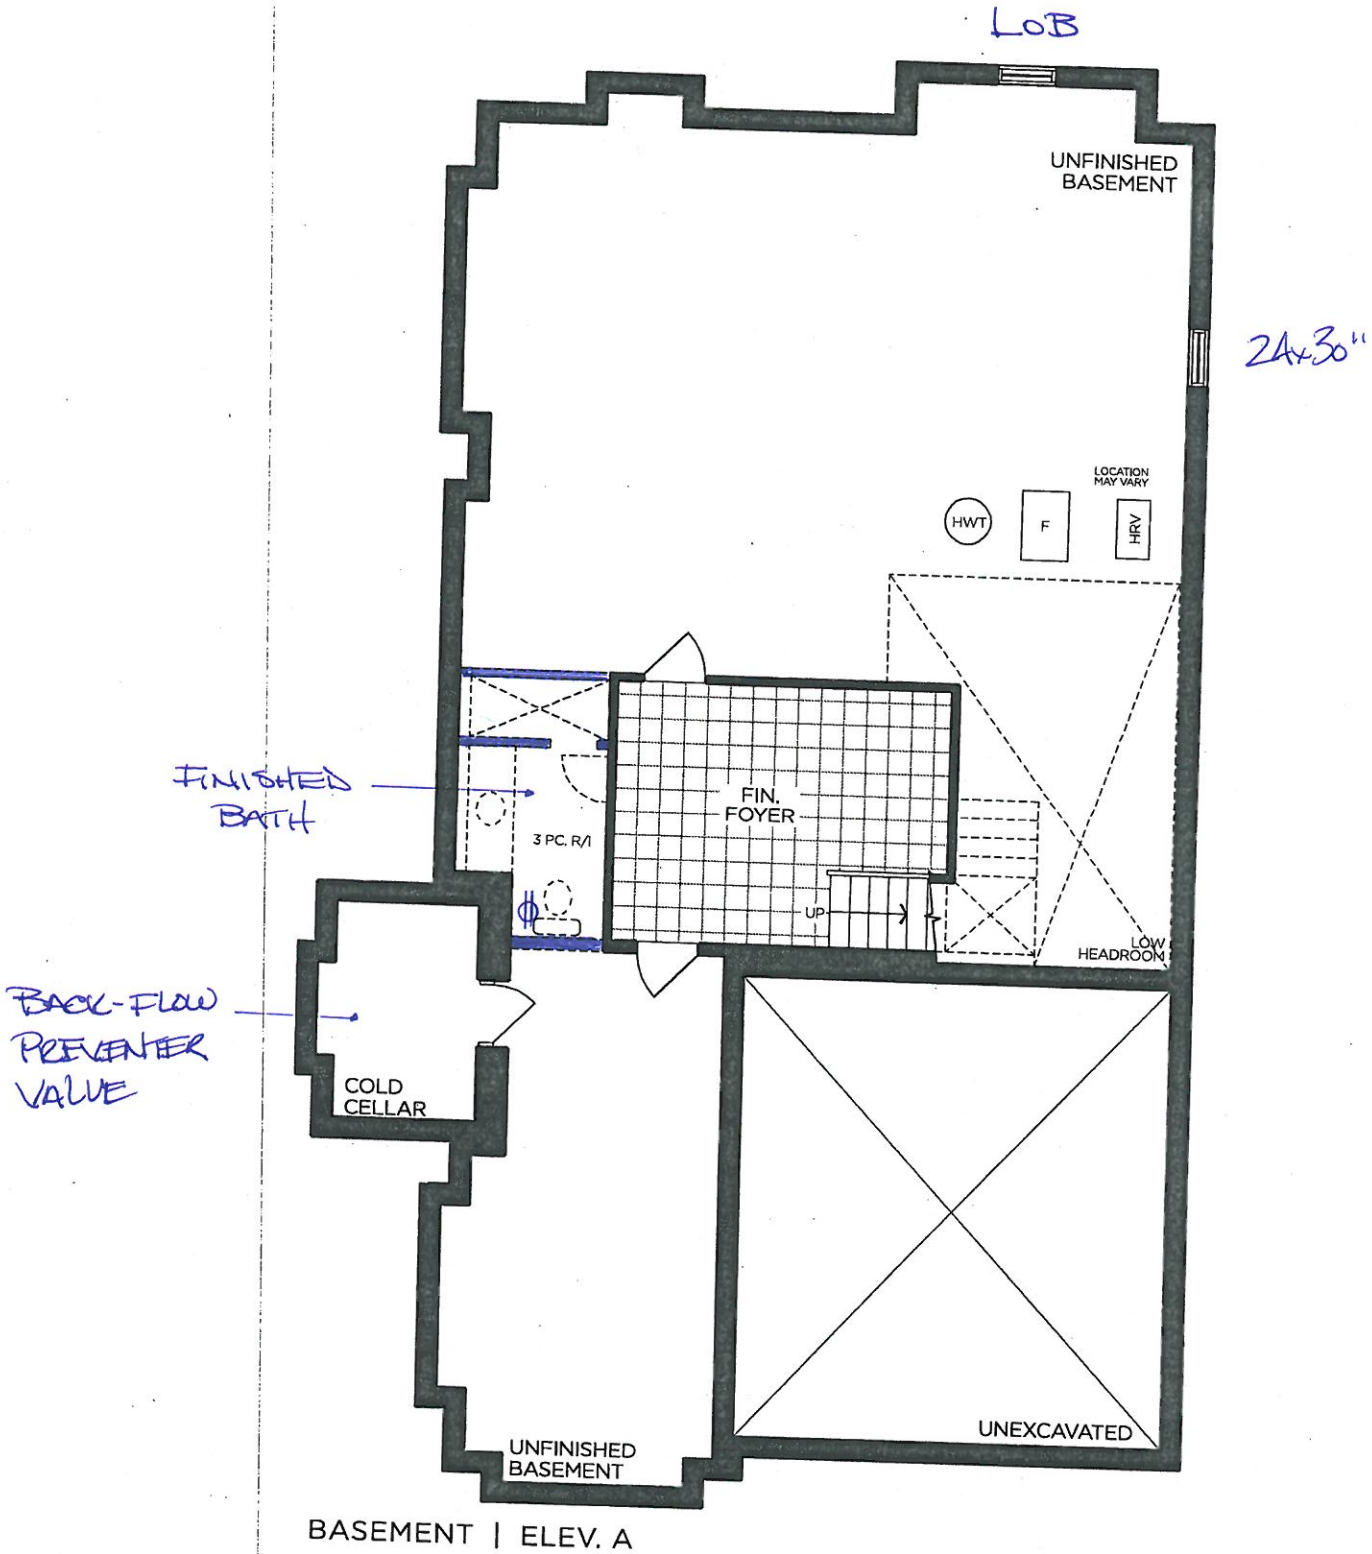

VENDOR

PURCHASER

PURCHASER

GOLDPARK
WORTH MORE™

Prices, figures, illustrations, sizes, features and finishes are subject to change without notice. Areas and dimensions are approximate and actual usable floor space may vary from the stated area. Layout may be reverse of the unit purchased. E. & O.E. 4006


SCHEDULE 'F'



PV-123 ^{See attached}
April 20 2020

The Lilac
40' SERIES

Elevation A • 3,425 sq.ft.
Elevation B • 3,385 sq.ft.

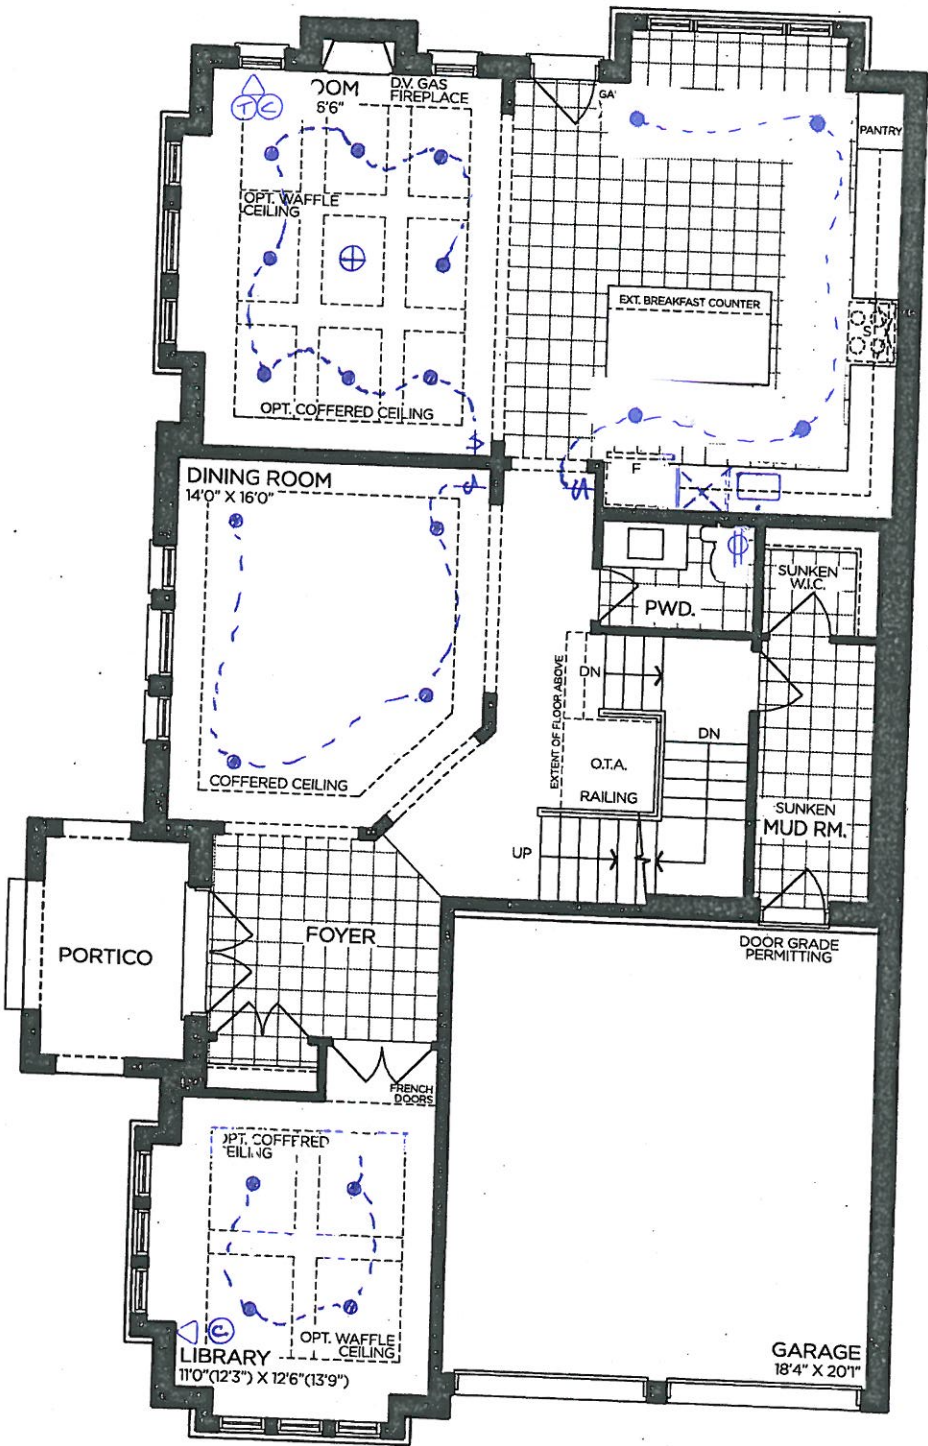

GROUND FLOOR | ELEV. A

VENDOR

PURCHASER

PURCHASER

GOLDPARK
WORTH MORE™

Prices, figures, illustrations, sizes, features and finishes are subject to change without notice. Areas and dimensions are approximate and actual usable floor space may vary from the stated area. Layout may be reverse of the unit purchased. E. & O.E. 4006

SCHEDULE 'F'




PV-123
APRIL 20 2020
See attached

The Lilac

40' SERIES

Elevation A • 3,425 sq.ft.

→ Elevation B • 3,385 sq.ft.

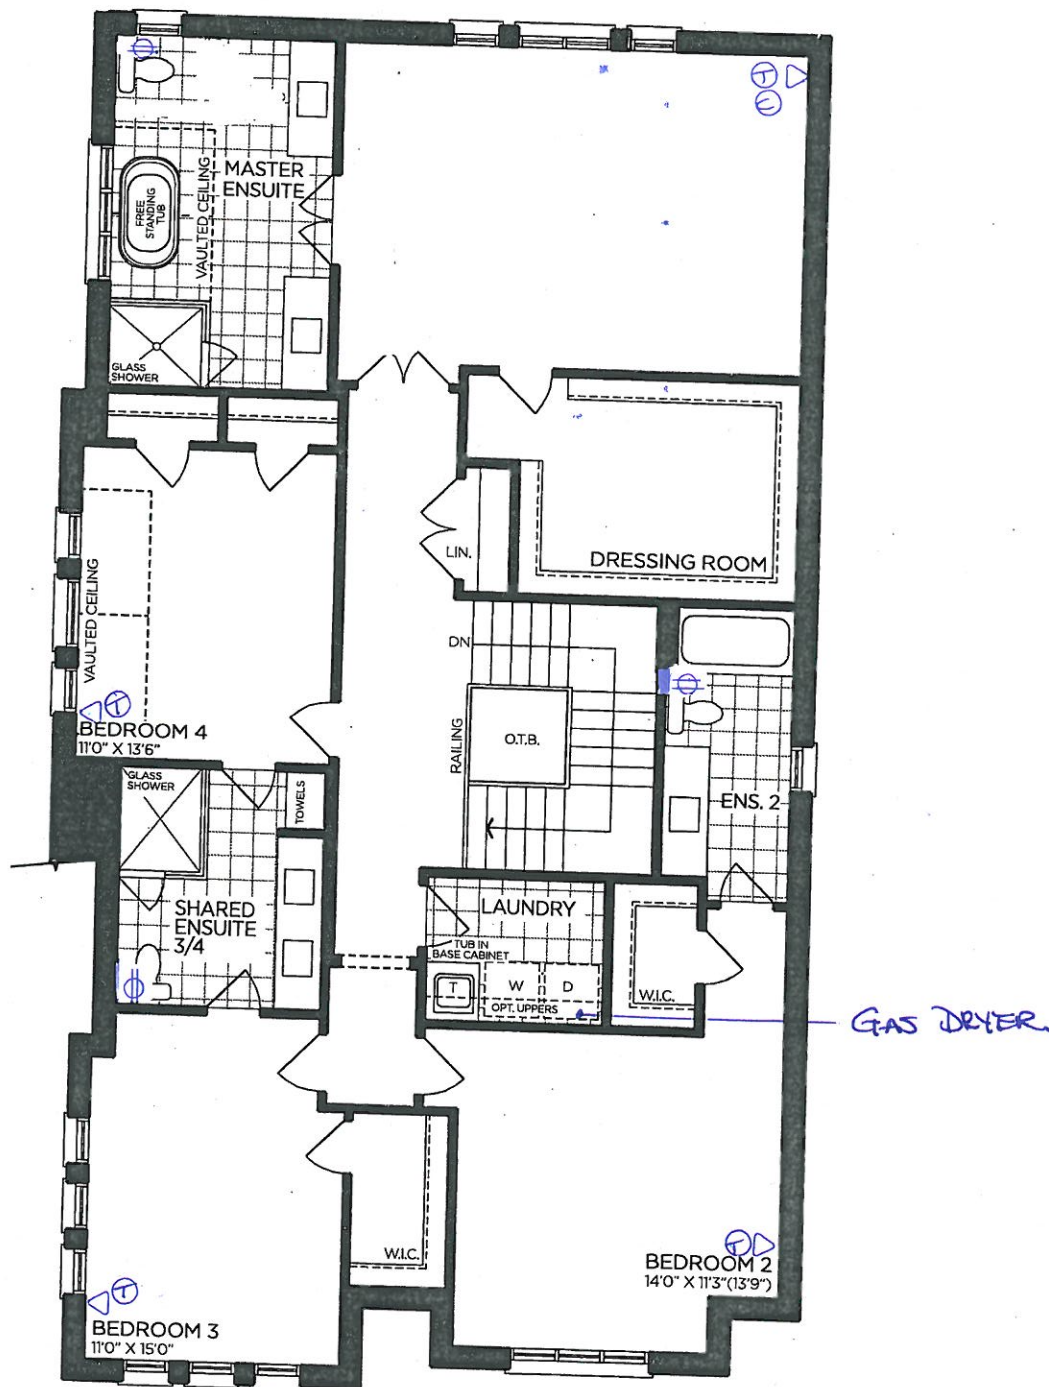

SECOND FLOOR | ELEV. A

VENDOR

PURCHASER

PURCHASER

GOLDPARK
WORTH MORE™

Prices, figures, illustrations, sizes, features and finishes are subject to change without notice. Areas and dimensions are approximate and actual usable floor space may vary from the stated area. Layout may be reverse of the unit purchased. E. & O.E. 4006



SCHEDULE 'F'

TV-123
April 20 2026


Handwritten signature

The Lilac

40' SERIES

Elevation A • 3,425 sq.ft.

Elevation B • 3,385 sq.ft.

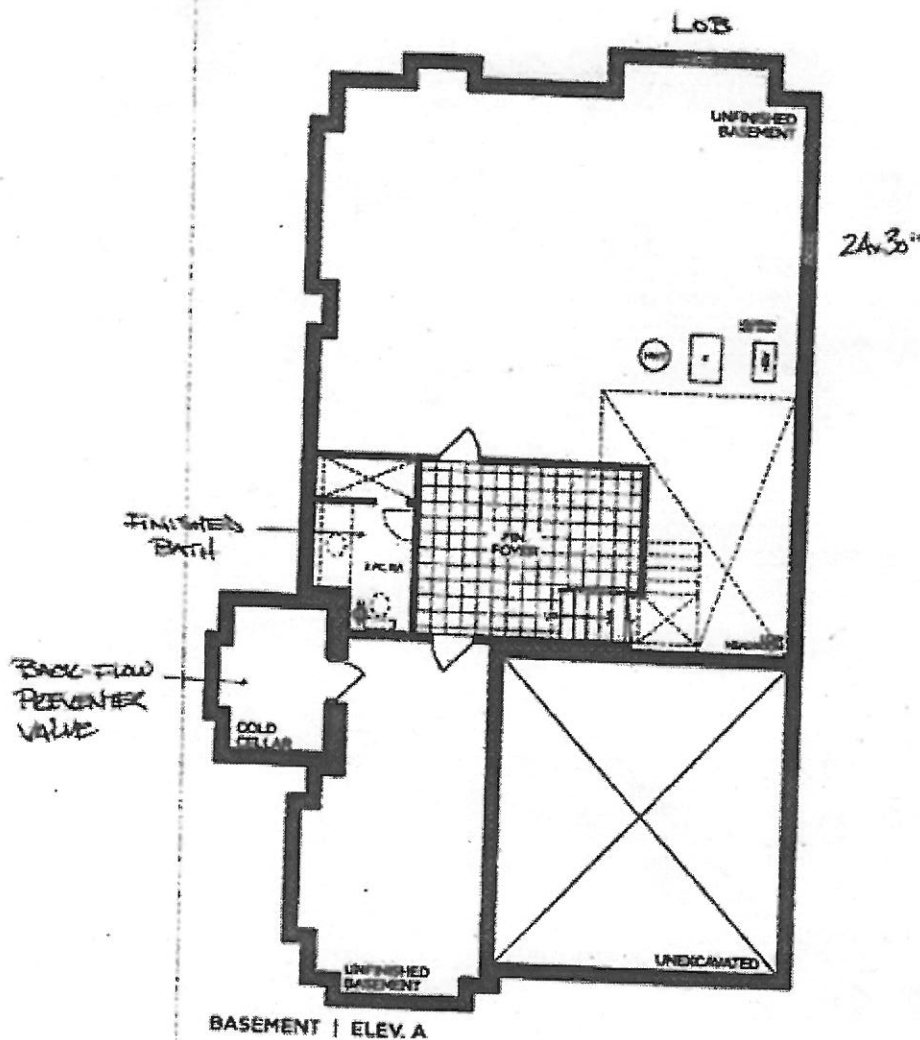

VENDOR	
PURCHASER	
PURCHASER	

GOLDPARK




SCHEDULE F

FV-123


April 2, 2020

The Lilac

40' SERIES

Elevation A • 3,425 sq.ft.

Elevation B • 3,385 sq.ft.

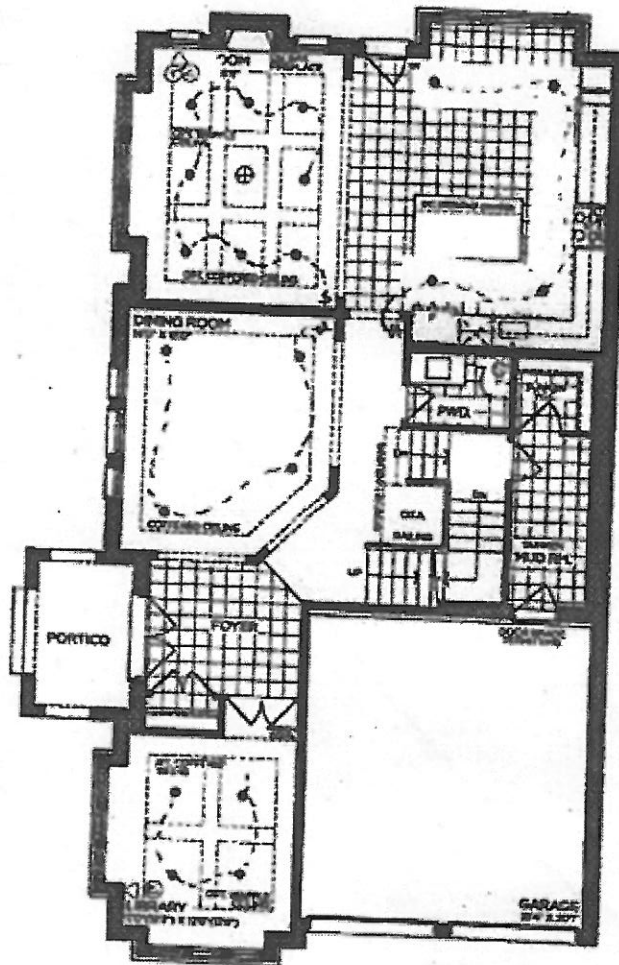

GROUND FLOOR | ELEV. A

VENDOR	
PURCHASER	
PURCHASER	

GOLDPARK
WORTH SHOP

Prices, figures, illustrations, views, features and finishes are subject to change without notice. Areas and dimensions are approximate and actual inside floor space may vary from the stated area. Layout may be reverse of the unit purchased. E & CZ 4006




SCHEDULE 'F'

PV-123

APRIL 20 2020

The
Lilac
40' SERIES
Elevation A - 3,425 sq.ft.
Elevation B - 3,585 sq.ft.

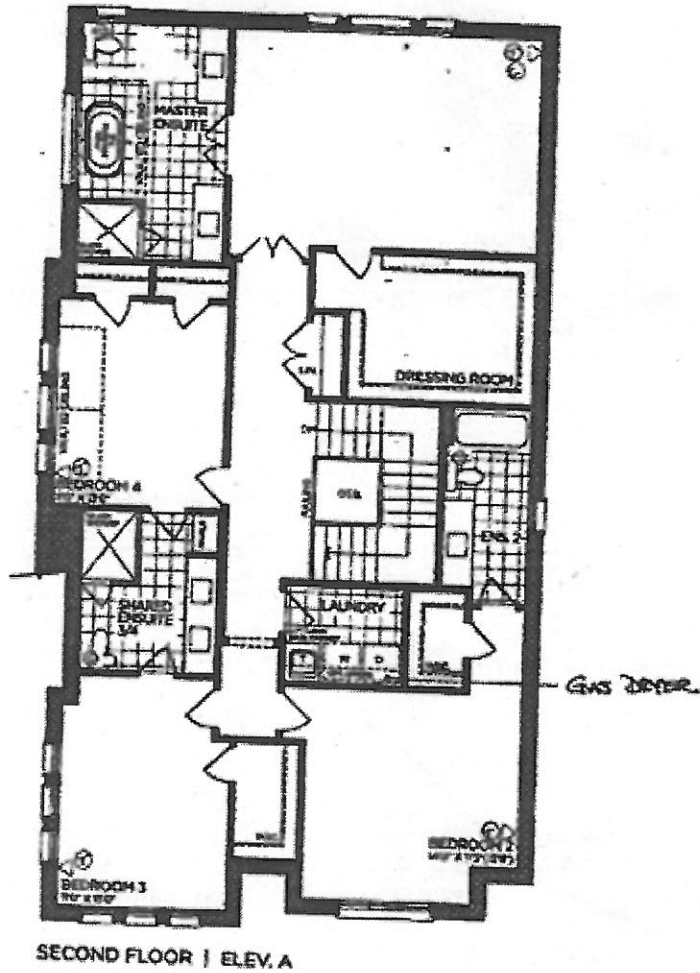

VENDOR

PURCHASER

PURCHASER

GOLDPARK

