






SCHEDULE 'F'

PV-127  
MAY 13 2020  
*See attached.*

The Brookside  
40' SERIES

Elevation A • 3,380 sq.ft.  
Elevation B • 3,350 sq.ft.

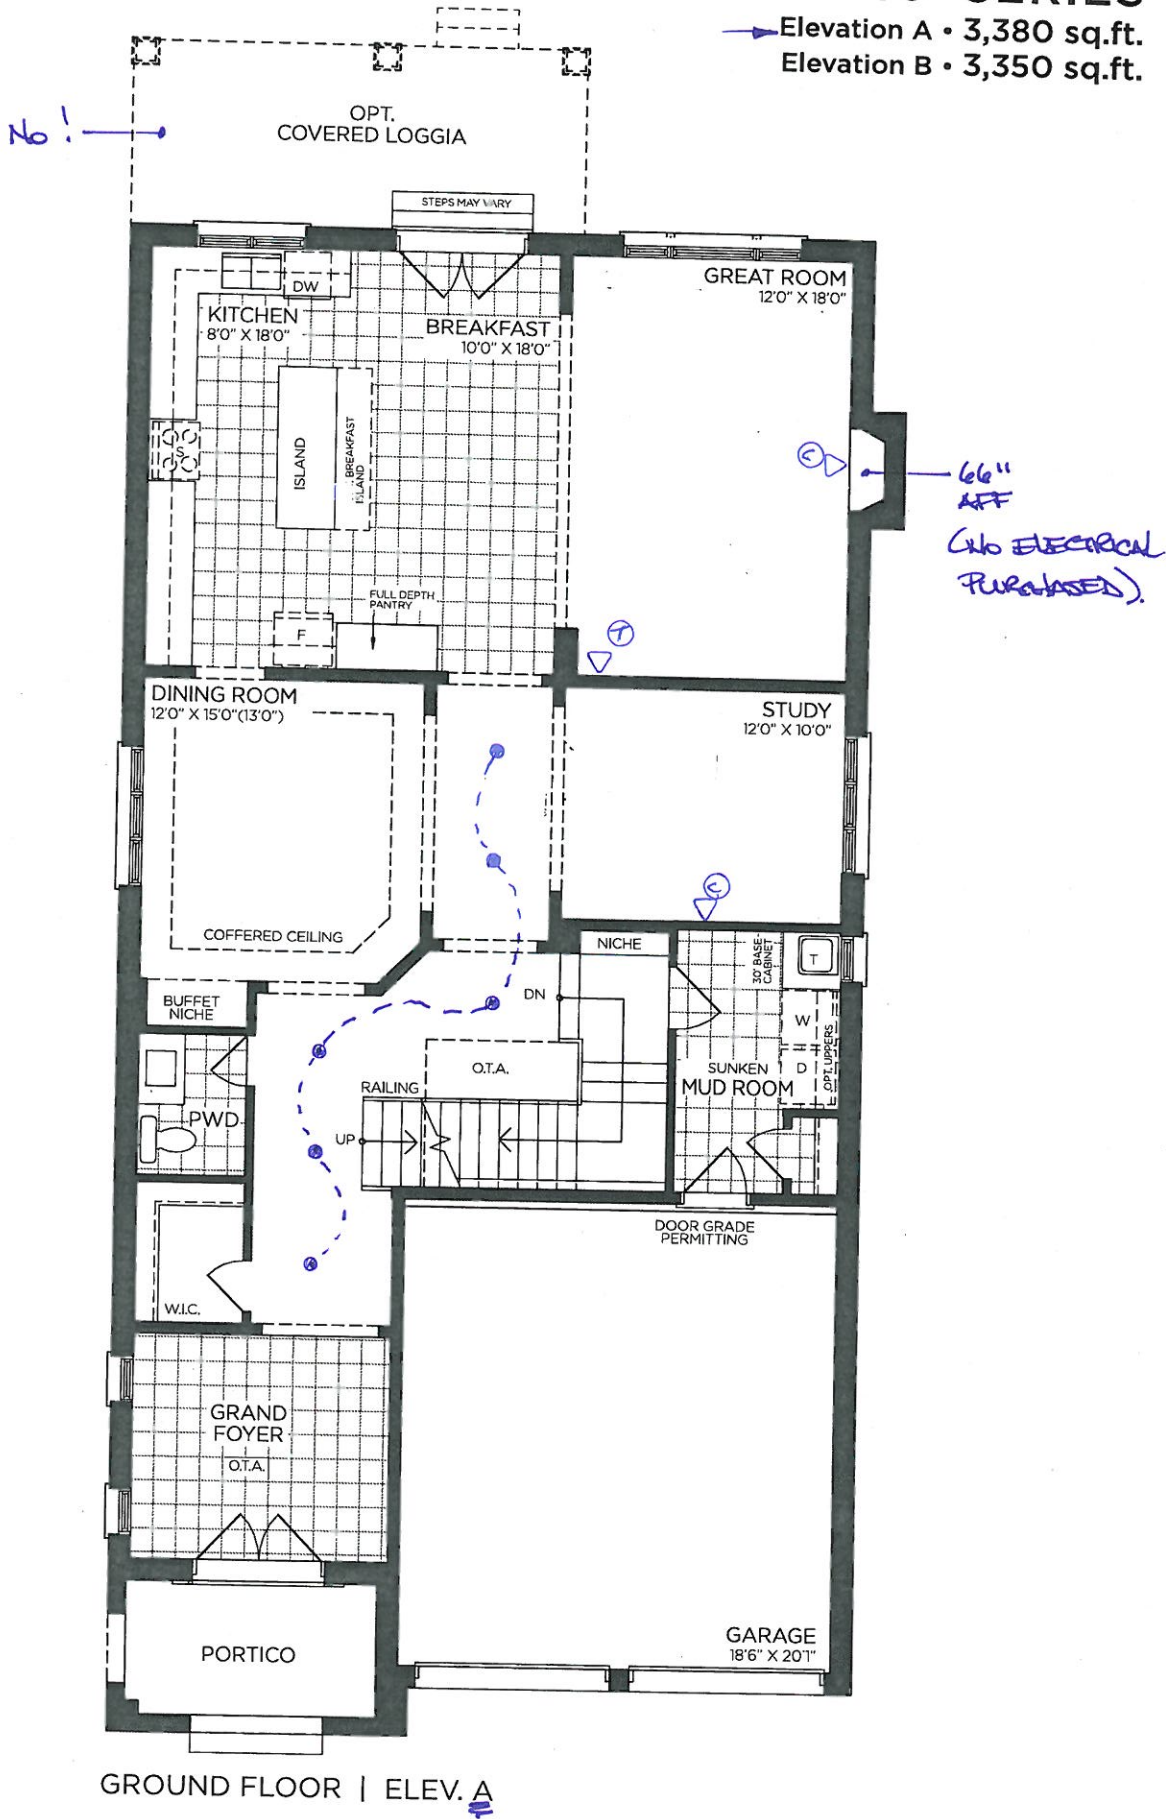

VENDOR

PURCHASER

PURCHASER

GOLDPARK  
WORTH MORE™

Prices, figures, illustrations, sizes, features and finishes are subject to change without notice. Areas and dimensions are approximate and actual usable floor space may vary from the stated area. Layout may be reverse of the unit purchased. E. & O.E. 4003


SCHEDULE 'F'



See attached  
PI-127  
MAY 13 2020

The Brookside  
40' SERIES

Elevation A • 3,380 sq.ft.  
Elevation B • 3,350 sq.ft.

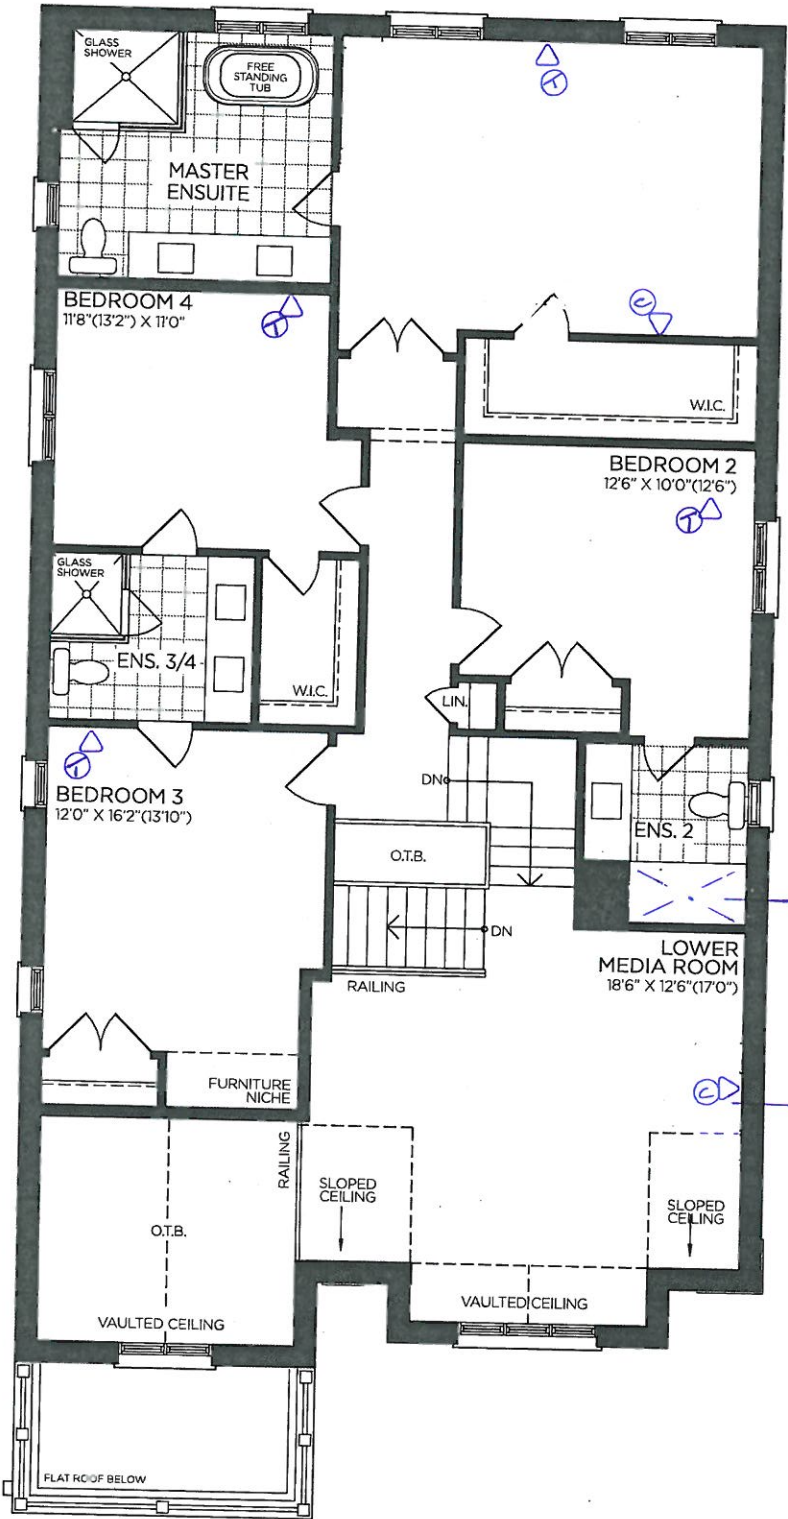

SECOND FLOOR | ELEV. A

VENDOR

PURCHASER

PURCHASER

GOLDPARK  
WORTH MORE™

Prices, figures, illustrations, sizes, features and finishes are subject to change without notice. Areas and dimensions are approximate and actual usable floor space may vary from the stated area. Layout may be reverse of the unit purchased. E. & O.E. 4003


SCHEDULE 'F'



See attached.  
PV-127  
MAY 13 2022

The Brookside  
40' SERIES

Elevation A • 3,380 sq.ft.  
Elevation B • 3,350 sq.ft.

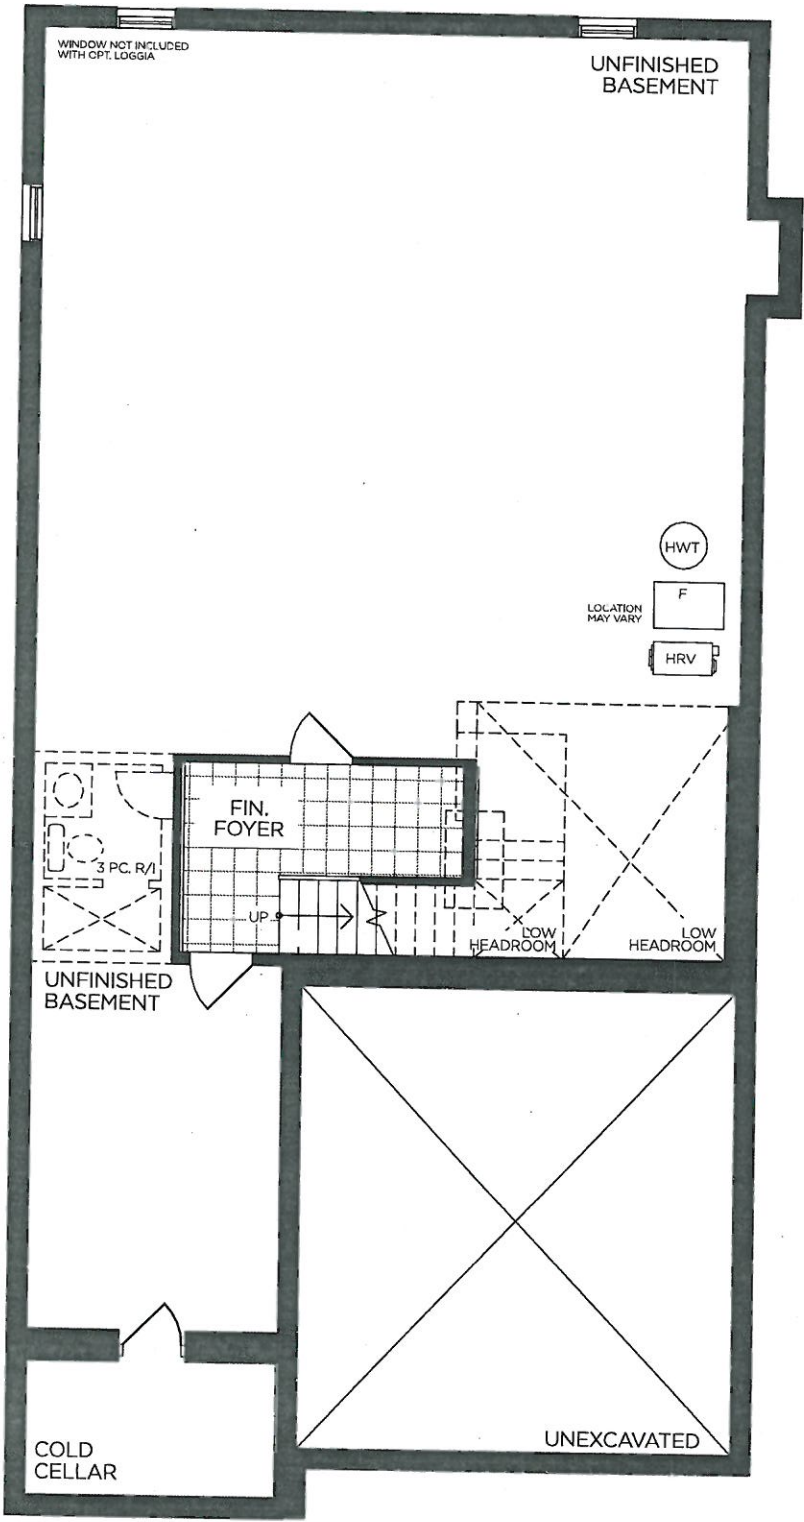

BASEMENT | ELEV. A

VENDOR

PURCHASER

PURCHASER

GOLDPARK  
WORTH MORE™

Prices, figures, illustrations, sizes, features and finishes are subject to change without notice. Areas and dimensions are approximate and actual usable floor space may vary from the stated area. Layout may be reverse of the unit purchased. E. & O.E. 4003






SCHEDULE 'F'

PV-127  
MAY 13 2020

# The Brookside 40' SERIES

Elevation A • 3,380 sq.ft.  
Elevation B • 3,350 sq.ft.

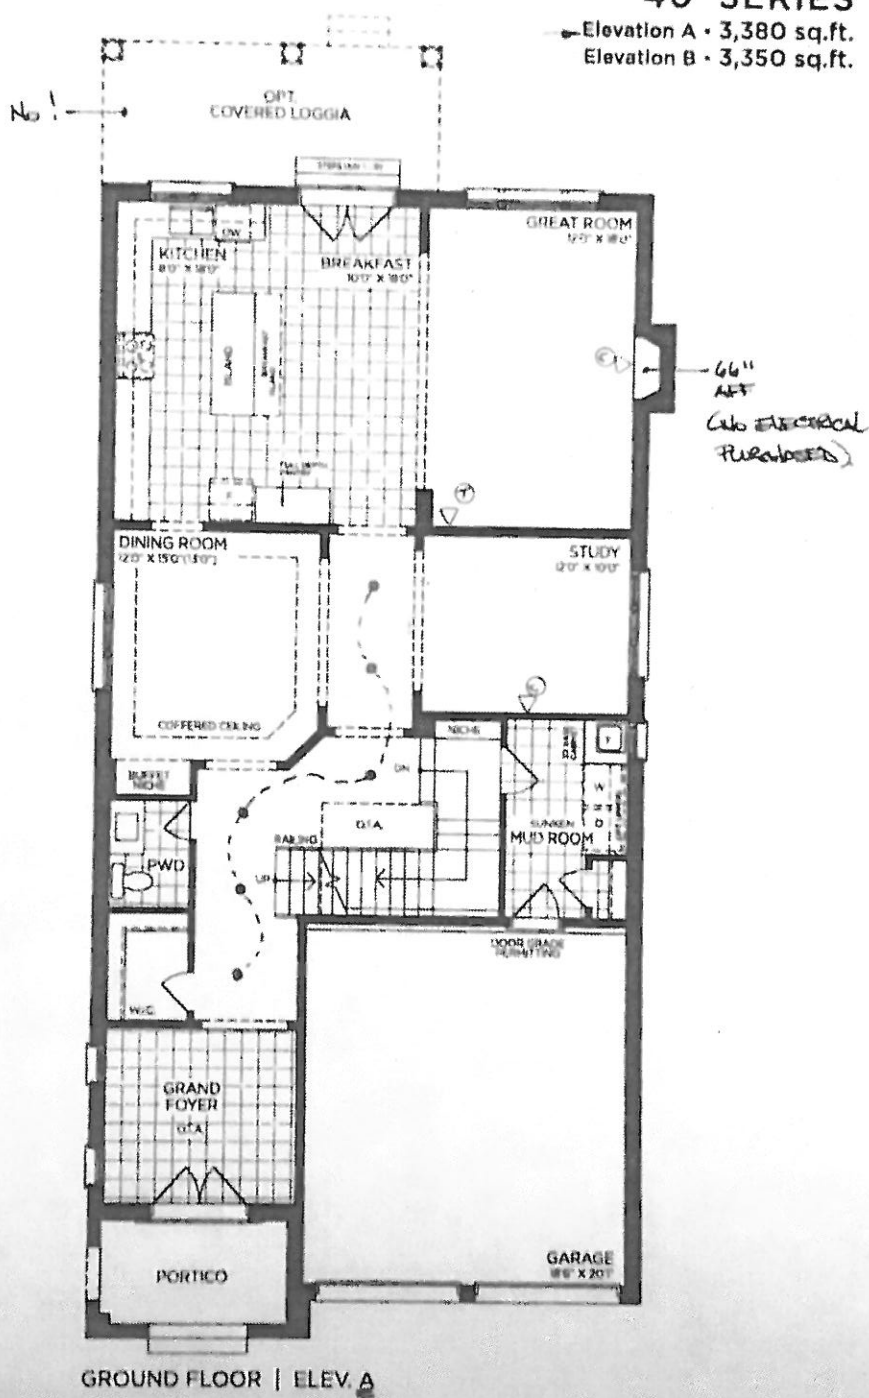

VENDOR   
PURCHASER   
PURCHASER

**GOLDPARK**  
WORTH MORE™


Prices, figures, illustrations, sizes, features and finishes are subject to change without notice. Areas and dimensions are approximate and actual usable floor space may vary from the stated area. Layout may be reverse of the unit purchased. E. & OE. 4003

SCHEDULE 'F'



PN-127 **B** **1**  
MAY 13 2020

The  
**Brookside**  
40' SERIES  
→ Elevation A • 3,380 sq.ft.  
Elevation B • 3,350 sq.ft.

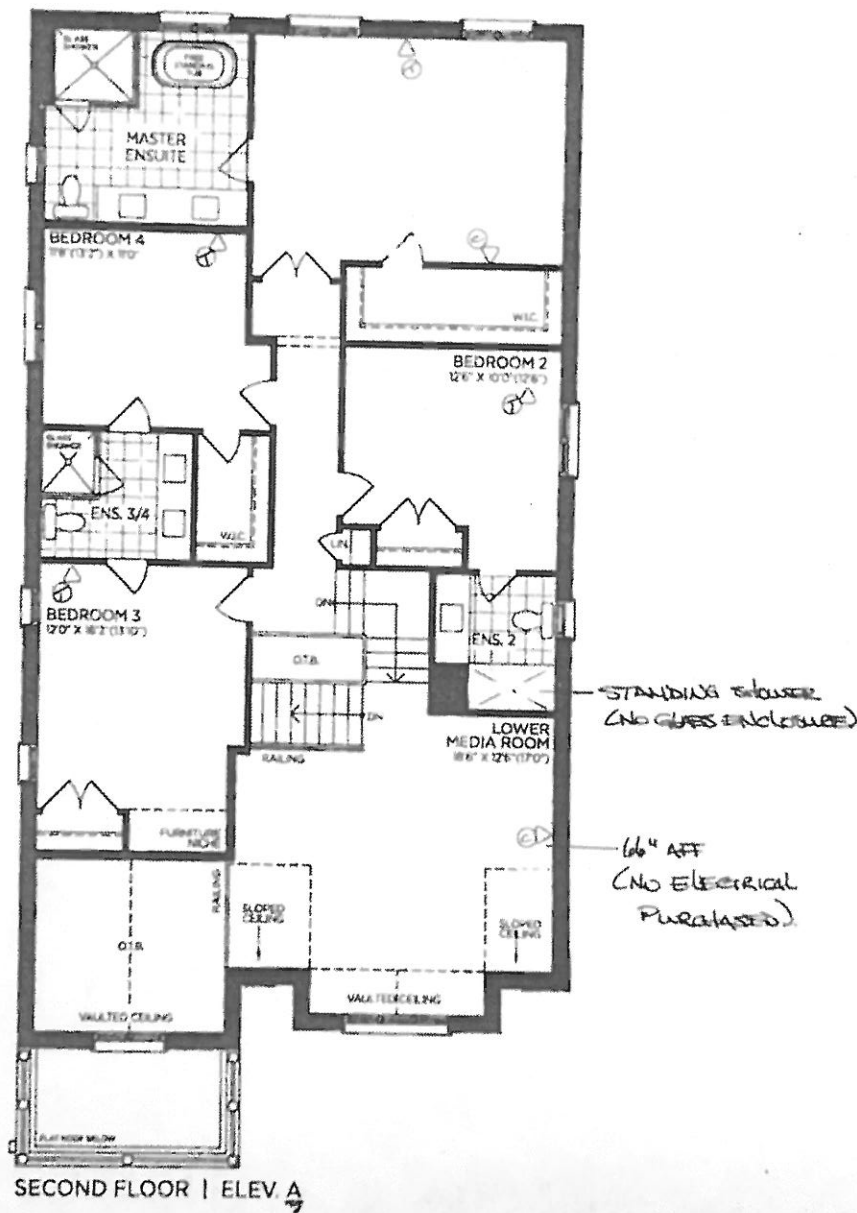

VENDOR

PURCHASER

PURCHASER

**GOLDPARK**  
WORTH MORE™

Prices, figures, illustrations, sizes, features and finishes are subject to change without notice. Areas and dimensions are approximate and actual usable floor space may vary from the stated area. Layout may be reverse of the unit purchased. E & OE 4001

SCHEDULE 'F'




PN-127  
MAY 13 2022

81

# The Brookside 40' SERIES

Elevation A - 3,380 sq.ft.  
Elevation B - 3,350 sq.ft.

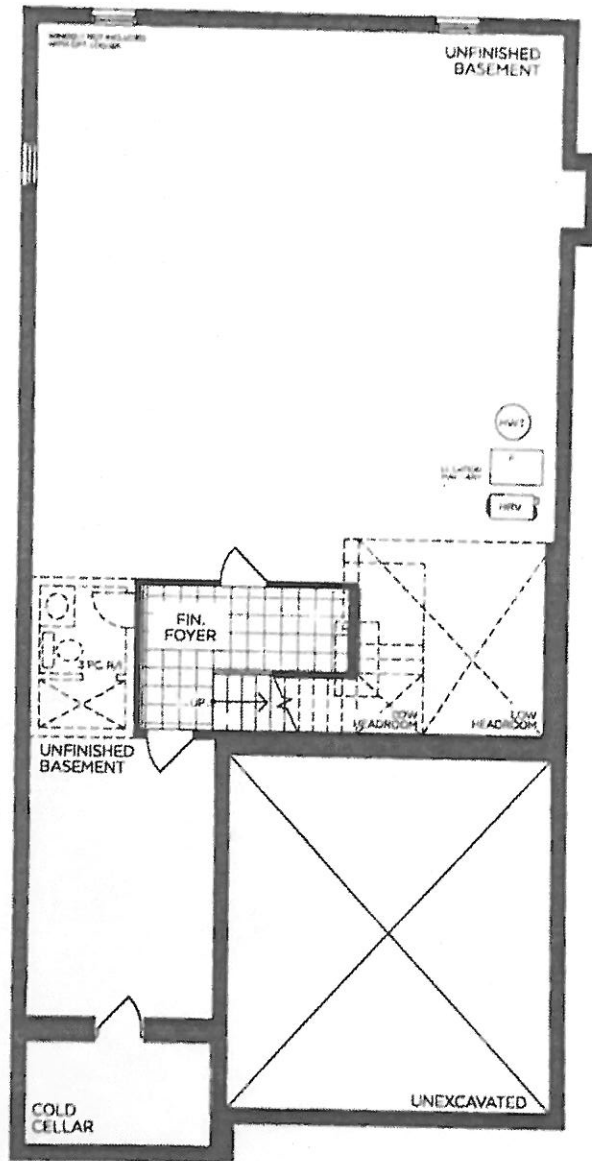

BASEMENT | ELEV. A

VENDOR   
PURCHASER   
PURCHASER

**GOLDPARK**  
WORTH MORE™

Prices, figures, illustrations, sizes, features and finishes are subject to change without notice. Areas and dimensions are approximate and actual usable floor space may vary from the stated area. Layout may be reverse of the unit purchased. E. & D.E. 4003