





GOLDPARK

WORTH MORE™

CONSTRUCTION SUMMARY

Lot: 150

Model: 40.00 A BRIARWOOD

Project/Phase: Pine Valley Forevergreen / 1

ELECTRICAL

Invoice	Qty.	Description
2331 72,310 24Jul20	2	.UPPER HALL: UPGRADE STANDARD CEILING MOUNT FIXTURE TO (1) LED POT LIGHT - SECOND FLOOR - SEE PLAN FOR LOCATION
2331 72,290 24Jul20	6	.UPPER HALL: 4" E/S LED INTERIOR POT LIGHT (INSULATED CEILING) - SECOND FLOOR - EACH  USE STANDARD SWITCHES
2331  24Jul20 NoCat	1	.GREAT ROOM: FIREPLACE - ADD HEAT ACTIVATED FAN

EXTERIOR COLOURS

Invoice	Qty.	Description
2331  24Jul20 NoCat	1	EXTERIOR COLOUR PACKAGE # BR.1

FIREPLACE

Invoice	Qty.	Description
2331  24Jul20 NoCat	1	.GREAT ROOM: FIREPLACE - ADD HEAT ACTIVATED FAN

FORMING

Invoice	Qty.	Description
2304  24Jul20 NoCat	4	.BASEMENT WINDOWS - UPGRADE BASEMENT WINDOW SIZE TO 30 " X 24" - 8" FRAME (QTY:4)

DisciplineMS.rpt 26jun20

Page 3 of 6  
Printed and Sent: 24-Jul-20








SCHEDULE 'F'



PV-150  
MAY 28 2020

The Briarwood  
40' SERIES  
→ Elevation A • 2,870 sq.ft.  
Elevation B • 2,860 sq.ft.

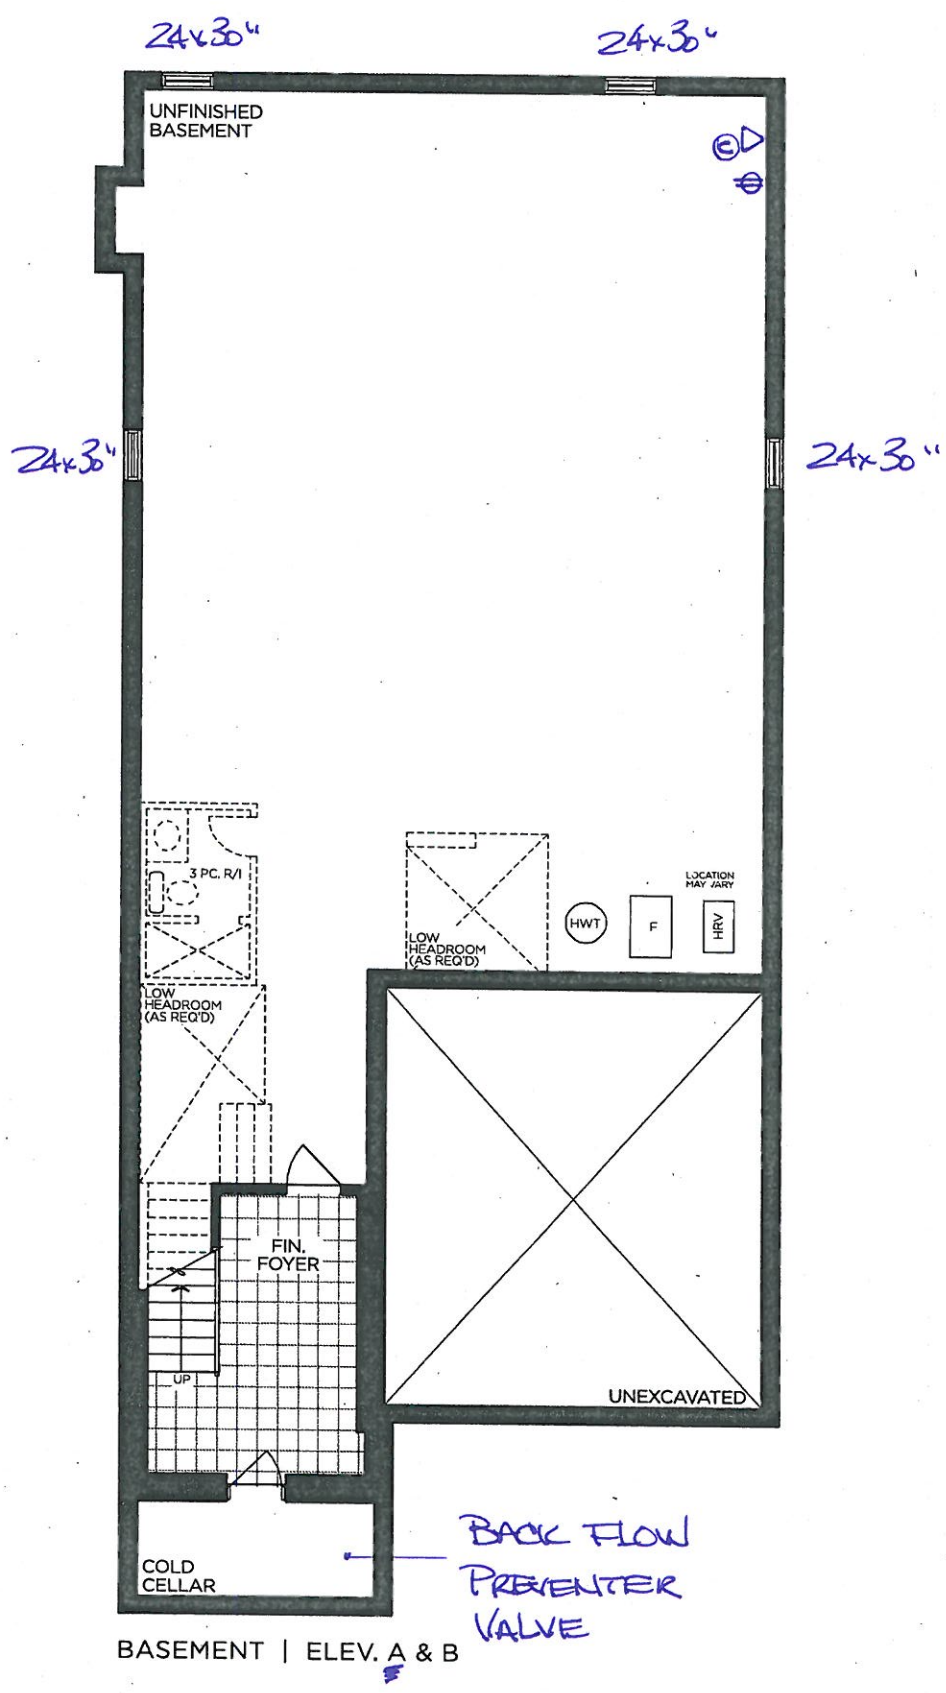

VENDOR

PURCHASER

PURCHASER


GOLDPARK  
WORTH MORE™

Prices, figures, illustrations, sizes, features and finishes are subject to change without notice. Areas and dimensions are approximate and actual usable floor space may vary from the stated area. Layout may be reverse of the unit purchased. E. & O.E. 4000



AL-150 *DD* *AK*  
MAY 28 2026

This Plan shows  
opt Ground floor.

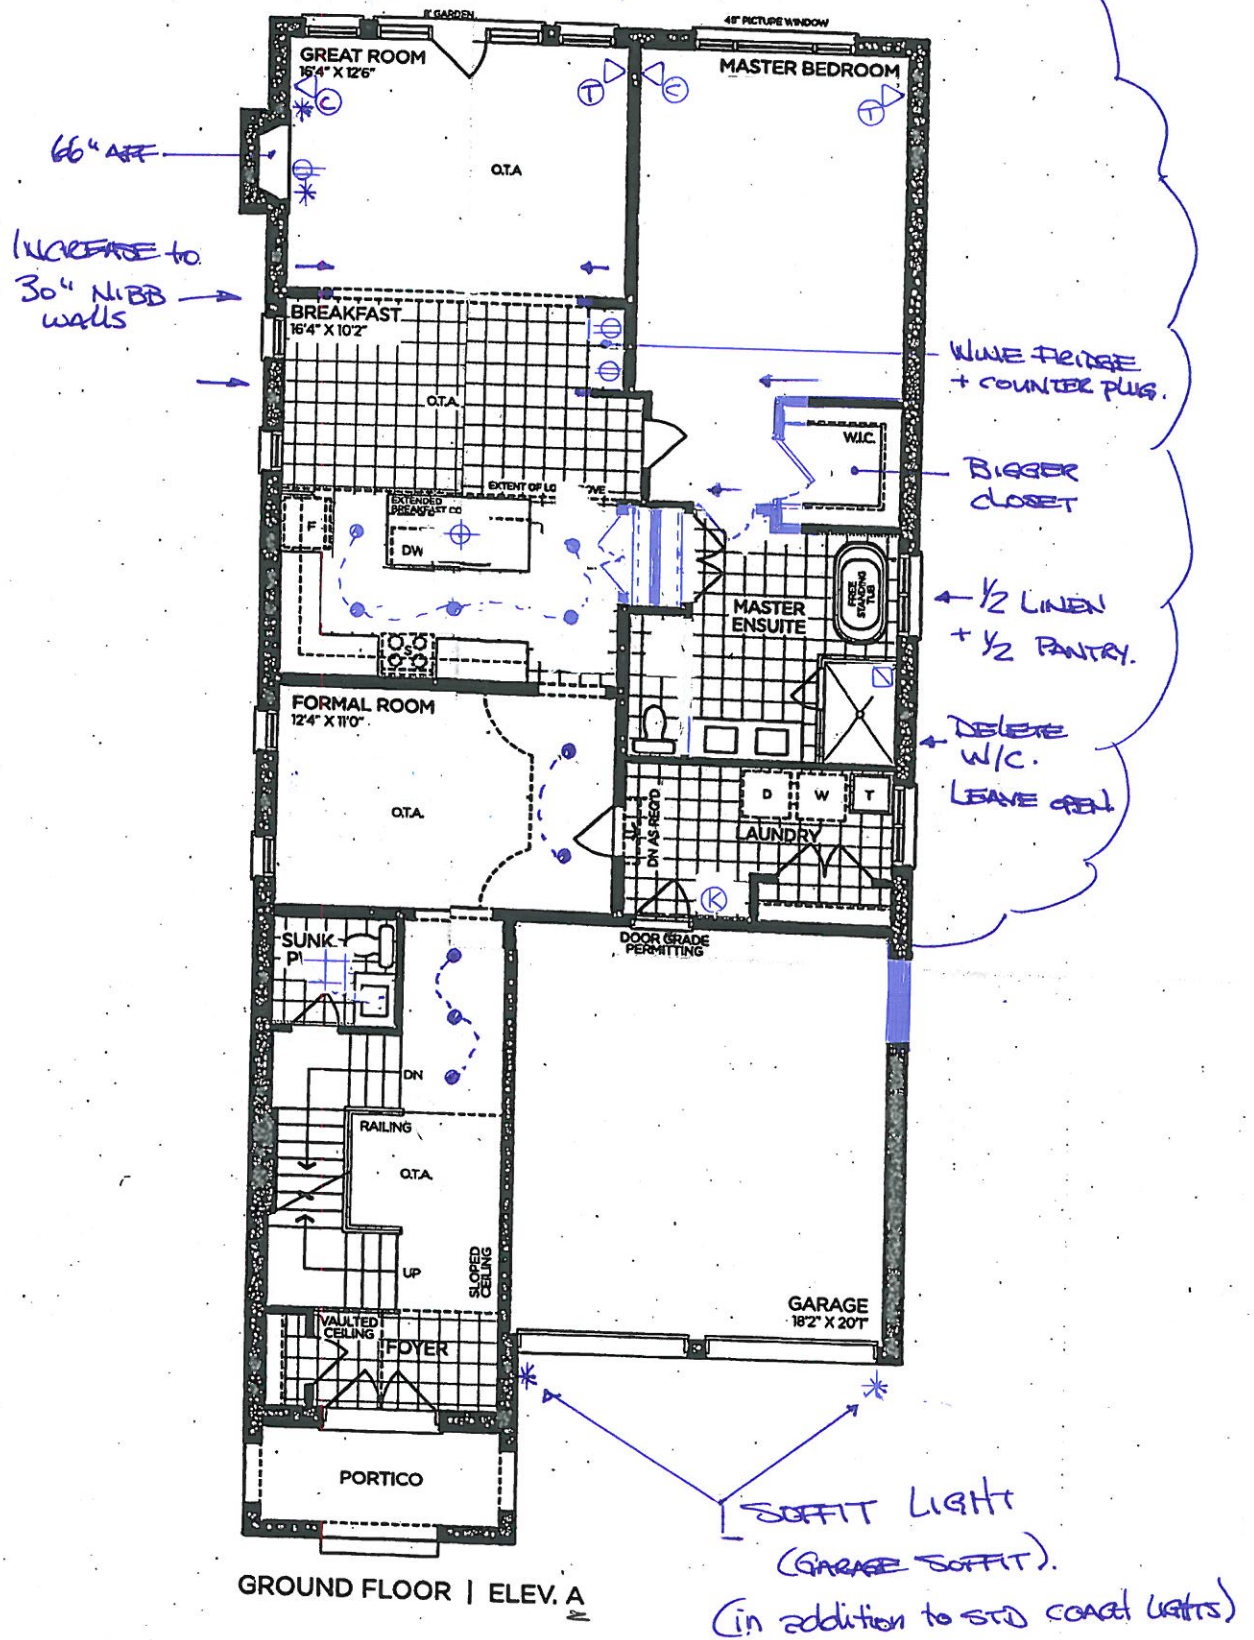

GROUND FLOOR | ELEV. A

VENDOR   
PURCHASER   
PURCHASER

**GOLDPARK**  
WORTH MORE™

Prices, figures, illustrations, sizes, features and finishes are subject to change without notice. Areas and dimensions are approximate and actual usable floor space may vary from the stated area. Layout may be reverse of the unit purchased. E. & O.E. 4000



SCHEDULE 'F'




PV-150  
MAY 28 2020

# The Briarwood

## 40' SERIES

→ Elevation A • 2,870 sq.ft.  
Elevation B • 2,860 sq.ft.

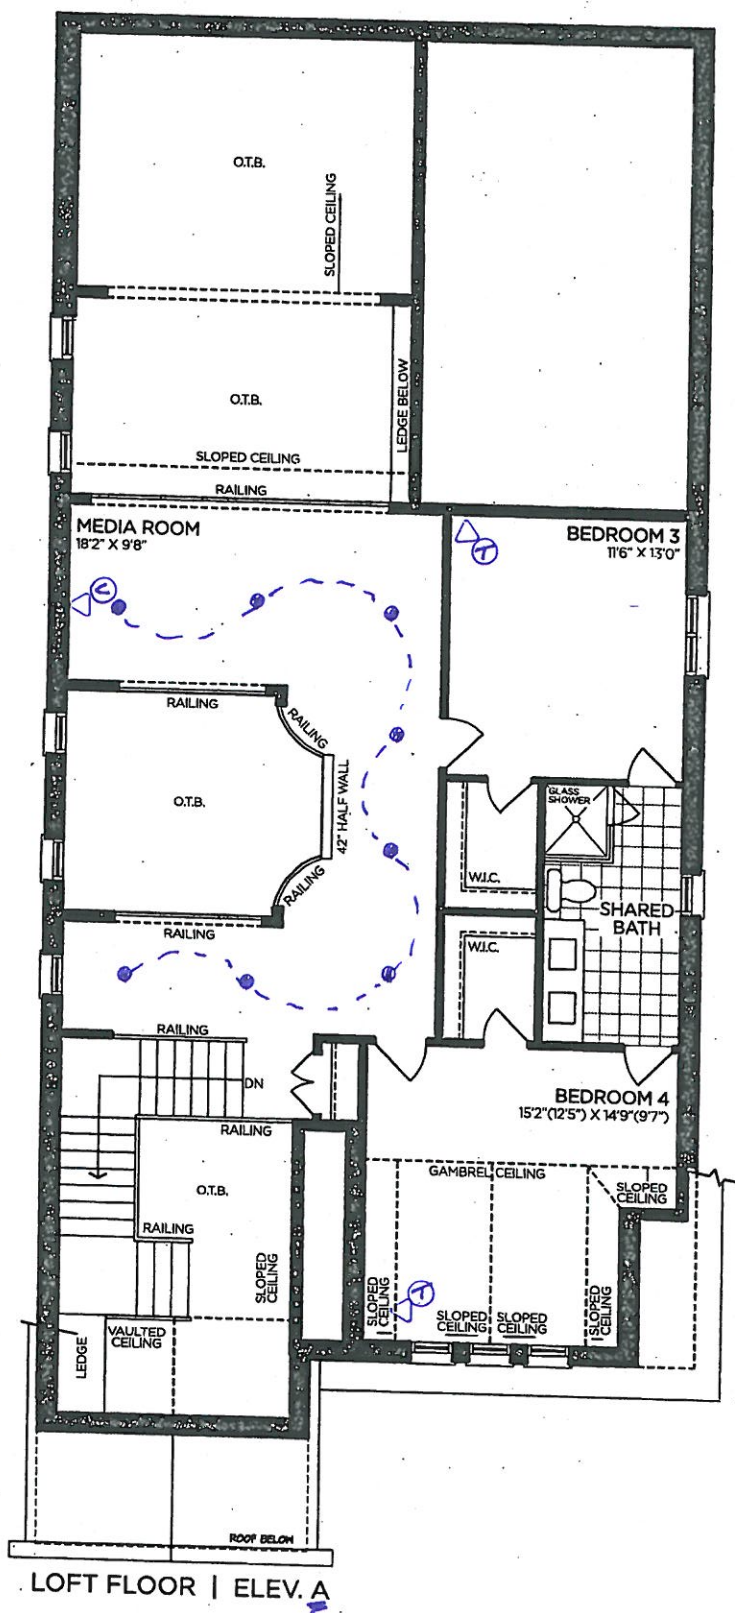

VENDOR

PURCHASER

PURCHASER

# GOLDPARK

WORTH MORE™

Prices, figures, illustrations, sizes, features and finishes are subject to change without notice. Areas and dimensions are approximate and actual usable floor space may vary from the stated area. Layout may be reverse of the unit purchased. E. & O.E. 4000