

LEGEND:

BRICK/ STONE VENEER ON SIDES OF STAIRS (POURED OR 'BRICK LEDGE' PRECAST)

DROP OR RAISE BANDING BY AMOUNT INDICATED.

ADD BANDING AND/OR TRIM AS INDICATED.

4 ADDED CAMBERED HEADERS

5 8'-0" X 8'-0" GARAGE DOORS.



PINE VALLEY, VAUGHAN ONT.

8966 Woodbine Ave, Markham, ON L3R 0J7 ■ T 905.737.5133 ■ F 905.737.7326 ■ 2018/09/11




LOT NUMBER: 98
UNIT NAME: THE KNIGHTSWOOD
ELEVATION: B (REV)
UNIT NUMBER: 5005

LOT NUMBER: 99 UNIT NAME: OAKGROVE ELEVATION: B UNIT NUMBER: 5003

LOT NUMBER: 100
UNIT NAME: FORESTCREST
ELEVATION: A (REV)
UNIT NUMBER: 4203

## PURPLE CREEK ROAD

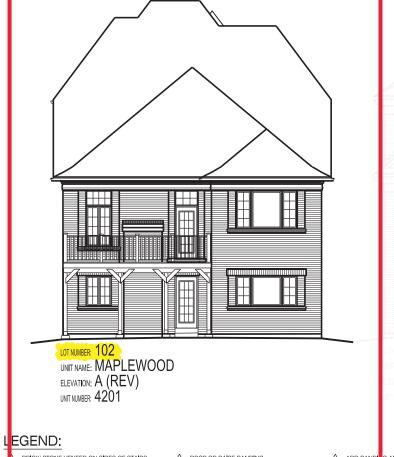



LOTS 98 - 100 \$ 102 (REAR) It is the builder's complete responsibility to ensure that all plans submitted for approval fully comply with the Architectural Guidelines and all applicable regulations and requirements including zoning provisions and any provisions in the subdivision agreement. The Control Architect is not responsible in any way for examining or approving site (lotting) plans or working drawings with respect to any zoning or building code or permit matter or that any house can be properly built or located on its lot. JOHN G. WILLIAMS LTD., ARCHITECT This is to certify that these plans comply with the applicable Architectural Design Guidelines approved by the City of VAUGHAN. is stamp certifies compliance with the applicabl Design Guidelines only and bears no further

**GOLDPARK HOMES - 217020** 

STREETSCAPES - (LOTS 98-103)

PINE VALLEY, VAUGHAN ONT.

8966 Woodbine Ave, Markham, ON L3R 0J7 ■ T 905.737.5133 ■ F 905.737.7326 ■ 2020/02/07