

**Lot: 106****Model: 50.05 B KNIGHTSWOOD****Project/Phase: Pine Valley Forevergreen / 1**

KITCHEN AND BATH CABINETRY

Invoice	Qty.	Description
2297 19Aug20 NoCat	1	.***CUSTOM LAYOUT*** MAIN FLOOR POWDER ROOM: REVISE LAYOUT TO BECOME SPICE KITCHEN COMPLETE WITH CHIMNEY HOOD FAN, COUNTER PLUG, 220v ELECTRICAL FOR RANGE, CABINETRY GRANITE COUNTER, POCKET DOORS - SEE PLAN FOR LAYOUT, BASED ON STANDARD FINISHES
2297 19Aug20 NoCat	1	.INSTALL VAC PAN UNDER KITCHEN SINK

NETWORK AND WIRING

Invoice	Qty.	Description
2297 72,258 19Aug20	1	.GREAT ROOM / MASTER BEDROOM / BEDROOM 3 / BASEMENT: ADDITIONAL CAT6 ETHERNET OUTLET - EACH (MUST SPECIFY LOCATION) PACKAGE PRICE
2297 72,259 19Aug20	1	.GREAT ROOM: CONDUIT PIPE - FOR WALL MOUNT TV - LOCATE APPROX. 66" A.F.F. ABOVE FIREPLACE, TERMINATING AT CABLE LOCATION.
2297 72,261 19Aug20	1	.INSTALL VAC PAN UNDER KITCHEN SINK
2297 72,260 19Aug20	1	CONDUIT PIPE - FROM ATTIC TO BASEMENT - FROM ELECTRICAL PANEL IN BASEMENT TO APPROX CENTER OF ATTIC

**Lot: 106****Model: 50.05 B KNIGHTSWOOD****Project/Phase: Pine Valley Forevergreen / 1**

STAIRS AND RAILINGS

Invoice	Qty.	Description
2235	1	OPTIONAL SERVICE STAIRS TO BASEMENT.
19Aug20 NoCat		

WINDOWS - BASEMENT

Invoice	Qty.	Description
2235 19Aug20 NoCat	4	.BASEMENT WINDOWS - UPGRADE BASEMENT WINDOW SIZE TO 30 " X 24" - 10" FRAME (PINEVALLEY 50 FOOT LOTS ONLY)

WINDOWS AND DOORS

Invoice	Qty.	Description
2297	1	.THRU OUT: BLACK INTERIOR WINDOWS
19Aug20 NoCat		

Prices, figures, illustrations, sizes, features and finishes are subject to change without notice. Areas and dimensions are approximate and actual usable floor space may vary from the stated area. Layout may be reverse of the unit purchased. E. & O. 5005

SCHEDULE 'F'




The
Knightswood
50' SERIES

PV-106 *see attached*
MAR 20 2020 *see attached*

PV-106 *see attached* 4,475 sq.ft. Opt. Elevator / 4,575 sq.ft. Opt. Service Stairs
APRIL 23 2020 *see attached* 4,475 sq.ft. Opt. Elevator / 4,575 sq.ft. Opt. Service Stairs
Elevation A • 4,445 sq.ft.
Elevation B • 4,440 sq.ft.
Elevation C • 4,525 sq.ft.
4,560 sq.ft. Opt. Elevator / 4,660 sq.ft. Opt. Service Stairs

8' Doors
on 2nd Floor

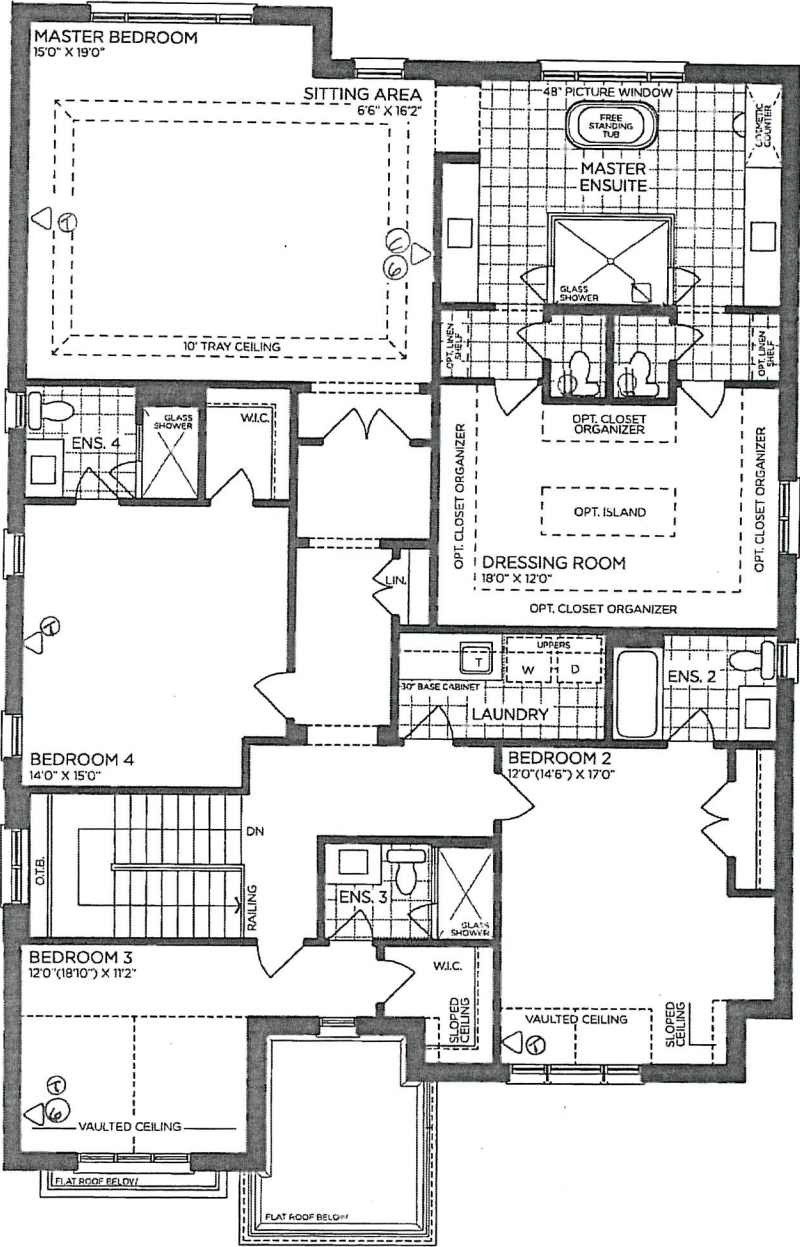

SECOND FLOOR | ELEV. A

VENDOR

PURCHASER

PURCHASER

GOLDPARK
WORTH MORE™

Prices, figures, illustrations, sizes, features and finishes are subject to change without notice. Areas and dimensions are approximate and actual usable floor space may vary from the stated area. Layout may be reverse of the unit purchased. E. & O.E. 5005

SCHEDULE 'F'




PV-106 *see attached*
MAR 20 2020 *see attached*
PV-106 *see attached*
APRIL 23 2020 *see attached*


The Knightswood

50' SERIES


Elevation A • 4,445 sq.ft.
4,475 sq.ft. Opt. Elevator / 4,575 sq.ft. Opt. Service Stairs
→ Elevation B • 4,440 sq.ft.
4,475 sq.ft. Opt. Elevator / 4,575 sq.ft. Opt. Service Stairs
Elevation C • 4,525 sq.ft.
4,560 sq.ft. Opt. Elevator / 4,660 sq.ft. Opt. Service Stairs

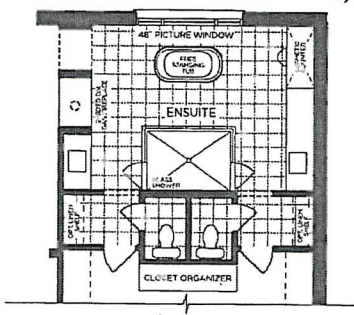


PART. OPT. ENSUITE LAYOUT

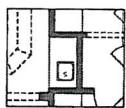


PART. OPT. WETBAR SITTING AREA

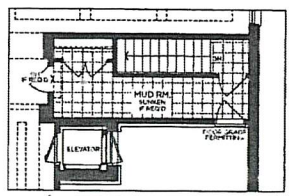


OPT. PART. GROUND FLOOR SERVICE STAIR W/ ELEVATOR | ELEV. A

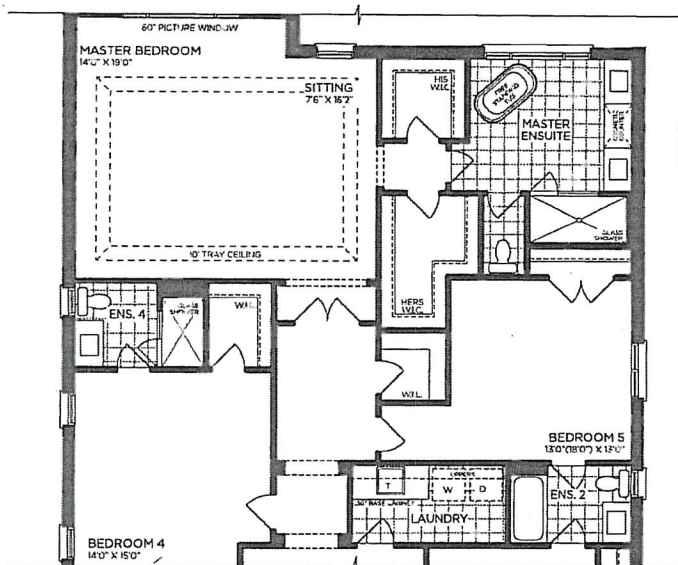


PART. OPT. SECOND FLOOR | ELEV. A (5 BEDROOMS)

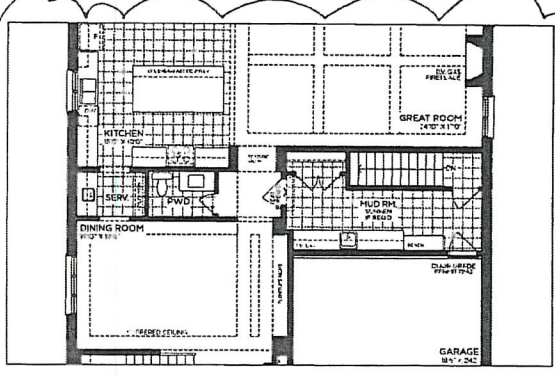


OPT. PART. GROUND FLOOR W/ SERVICE STAIR | ELEV. A

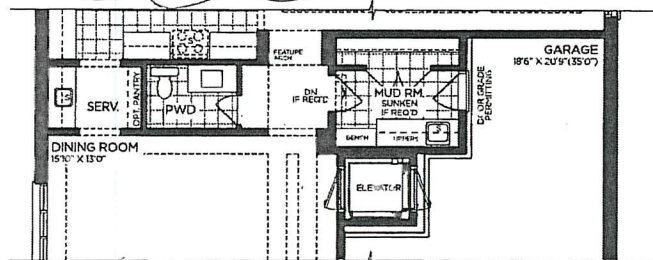

PART. OPT. GROUND FLOOR | ELEV. A (ELEVATOR)

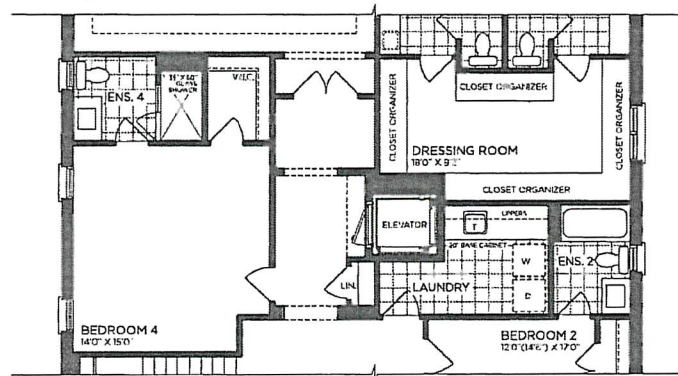

PART. OPT. SECOND FLOOR | ELEV. A (ELEVATOR)

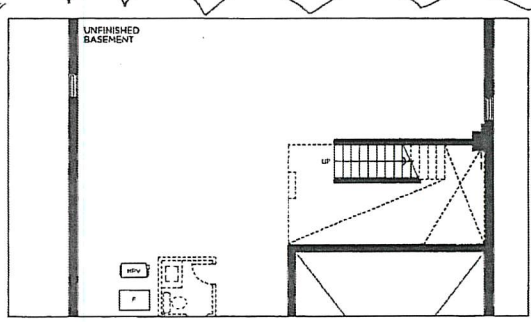

OPT. PART. BASEMENT W/ SERVICE STAIR | ELEV. A

VENDOR

PURCHASER

PURCHASER

GOLDPARK

WORTH MORE™

Prices, figures, illustrations, sizes, features and finishes are subject to change without notice. Areas and dimensions are approximate and actual usable floor space may vary from the stated area. Layout may be reverse of the unit purchased. E. & O.E. 5005

SCHEDULE 'F'



PV-106

March 20 2020

PV-106

April 23 2020

see attached
see attached

The Knightswood 50' SERIES

Elevation A • 4,445 sq.ft.


4,475 sq.ft. Opt. Elevator / 4,575 sq.ft. Opt. Service Stairs

→ Elevation B • 4,440 sq.ft.


4,475 sq.ft. Opt. Elevator / 4,575 sq.ft. Opt. Service Stairs

Elevation C • 4,525 sq.ft.


4,560 sq.ft. Opt. Elevator / 4,660 sq.ft. Opt. Service Stairs

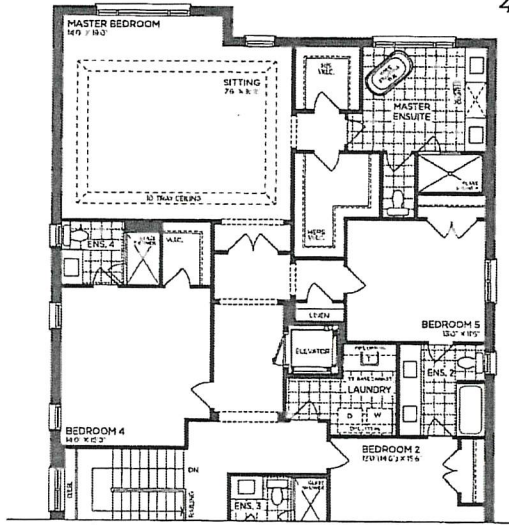


PART. OPT. SECOND FLOOR | ELEV. A (5 BEDROOMS - ELEVATOR)

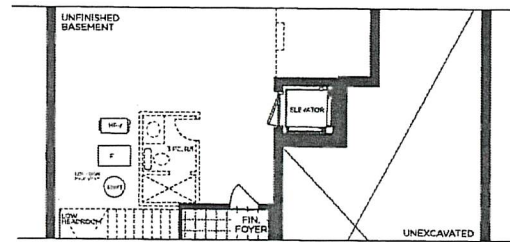


PART. OPT. BASEMENT | ELEV. A (ELEVATOR)

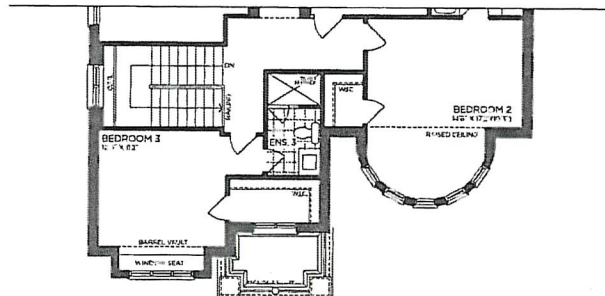


PART. SECOND FLOOR | ELEV. B

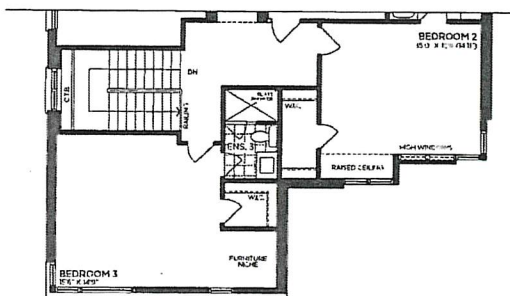


PART. SECOND FLOOR | ELEV. C

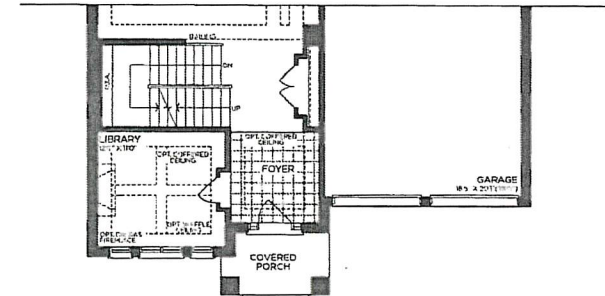


PART. GROUND FLOOR | ELEV. B

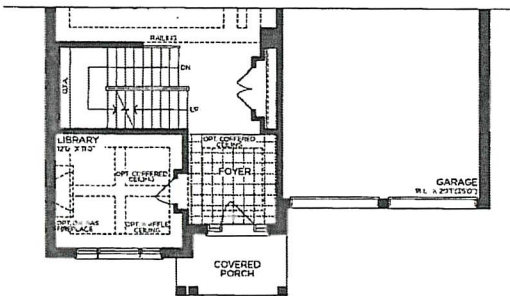

PART. GROUND FLOOR | ELEV. C

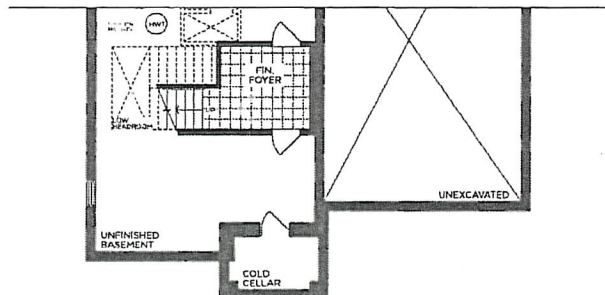

PART. BASEMENT | ELEV. B

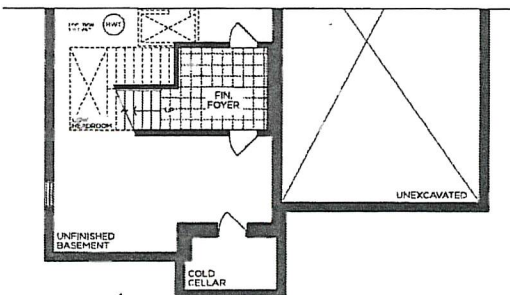

PART. BASEMENT | ELEV. C

VENDOR

PURCHASER

PURCHASER

GOLDPARK
WORTH MORE™

Prices, figures, illustrations, sizes, features and finishes are subject to change without notice. Areas and dimensions are approximate and actual usable floor space may vary from the stated area. Layout may be reverse of the unit purchased. E. & O.E. 5005


SCHEDULE 'F'



The
Knightswood
50' SERIES

PV-106 *see attached see attached*
March 20 2020
PV-106 *see attached see attached*
April 23 2020

Elevation A • 4,445 sq.ft.
4,475 sq.ft. Opt. Elevator / 4,575 sq.ft. Opt. Service Stairs
→ Elevation B • 4,440 sq.ft.
4,475 sq.ft. Opt. Elevator / 4,575 sq.ft. Opt. Service Stairs
Elevation C • 4,525 sq.ft.
4,560 sq.ft. Opt. Elevator / 4,660 sq.ft. Opt. Service Stairs

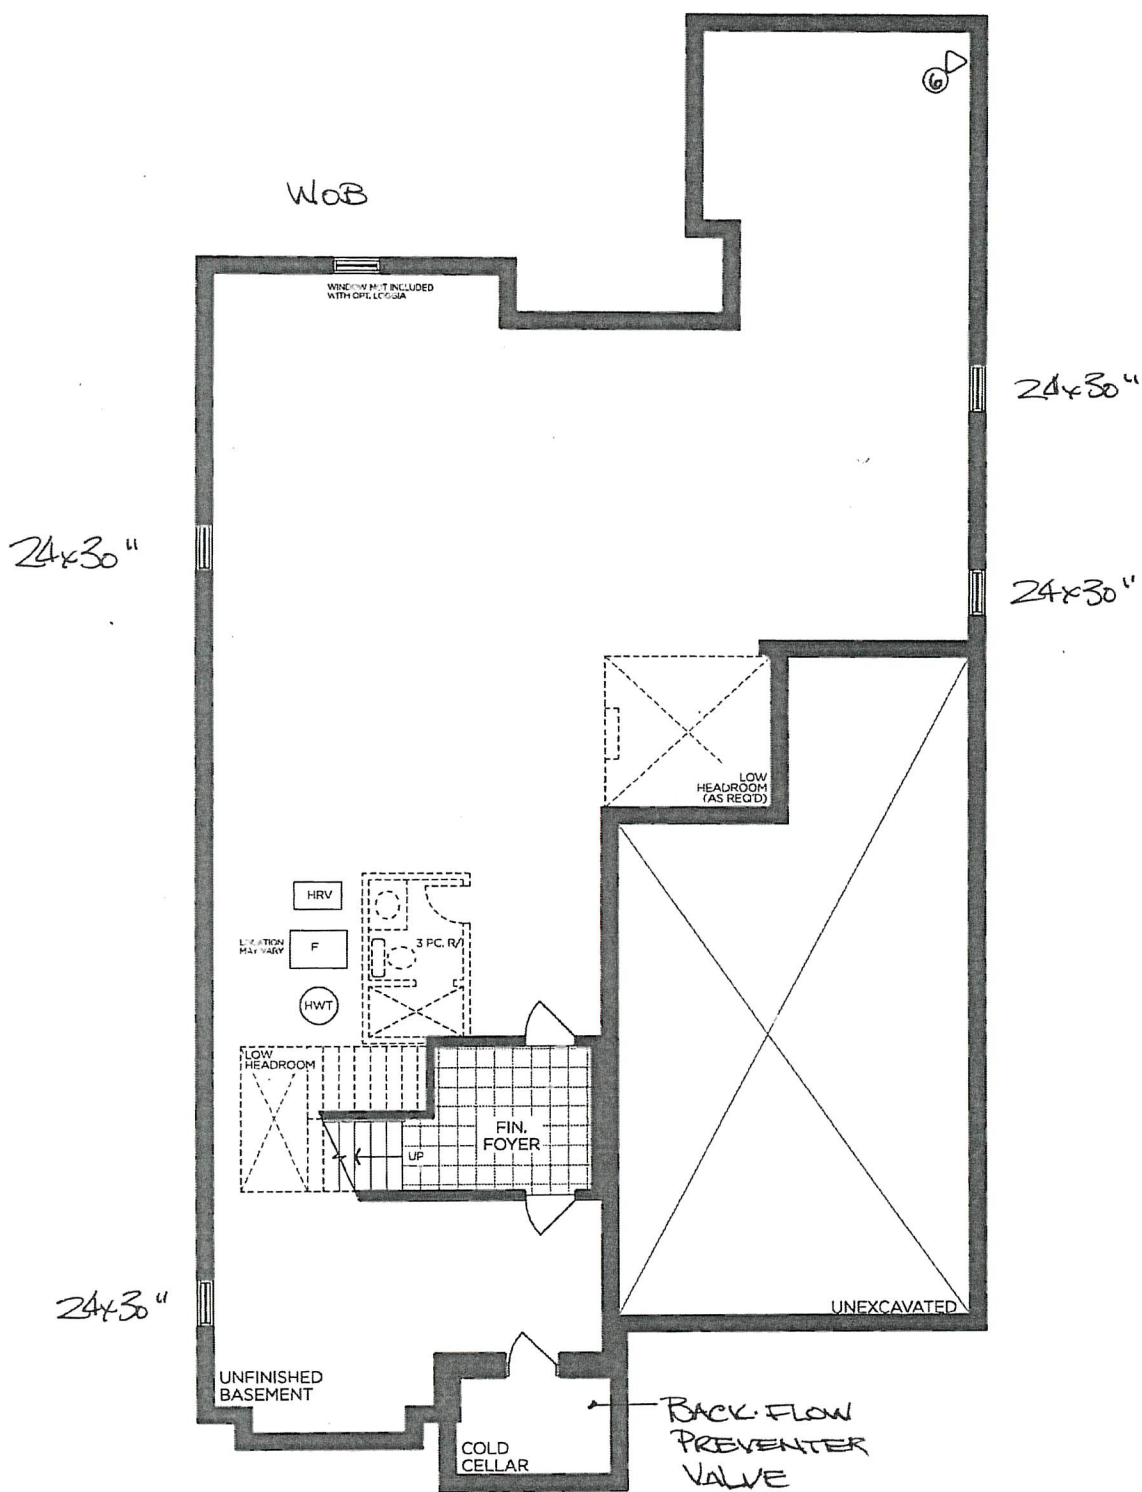

BASEMENT | ELEV. A

VENDOR

PURCHASER

PURCHASER

GOLDPARK
WORTH MORE™

Prices, figures, illustrations, sizes, features and finishes are subject to change without notice. Areas and dimensions are approximate and actual usable floor space may vary from the stated area. Layout may be reverse of the unit purchased. E. & O.E. 5005

SCHEDULE 'F'




The
Knightswood
50' SERIES

Elevation A - 4,445 sq.ft.
4,475 sq.ft. Opt. Elevator / 4,575 sq.ft. Opt. Service Stairs
→ Elevation B - 4,440 sq.ft.
4,475 sq.ft. Opt. Elevator / 4,575 sq.ft. Opt. Service Stairs
Elevation C - 4,525 sq.ft.
4,560 sq.ft. Opt. Elevator / 4,660 sq.ft. Opt. Service Stairs

SA
PY-106
April 27, 2020

Black Windows
Turn Out

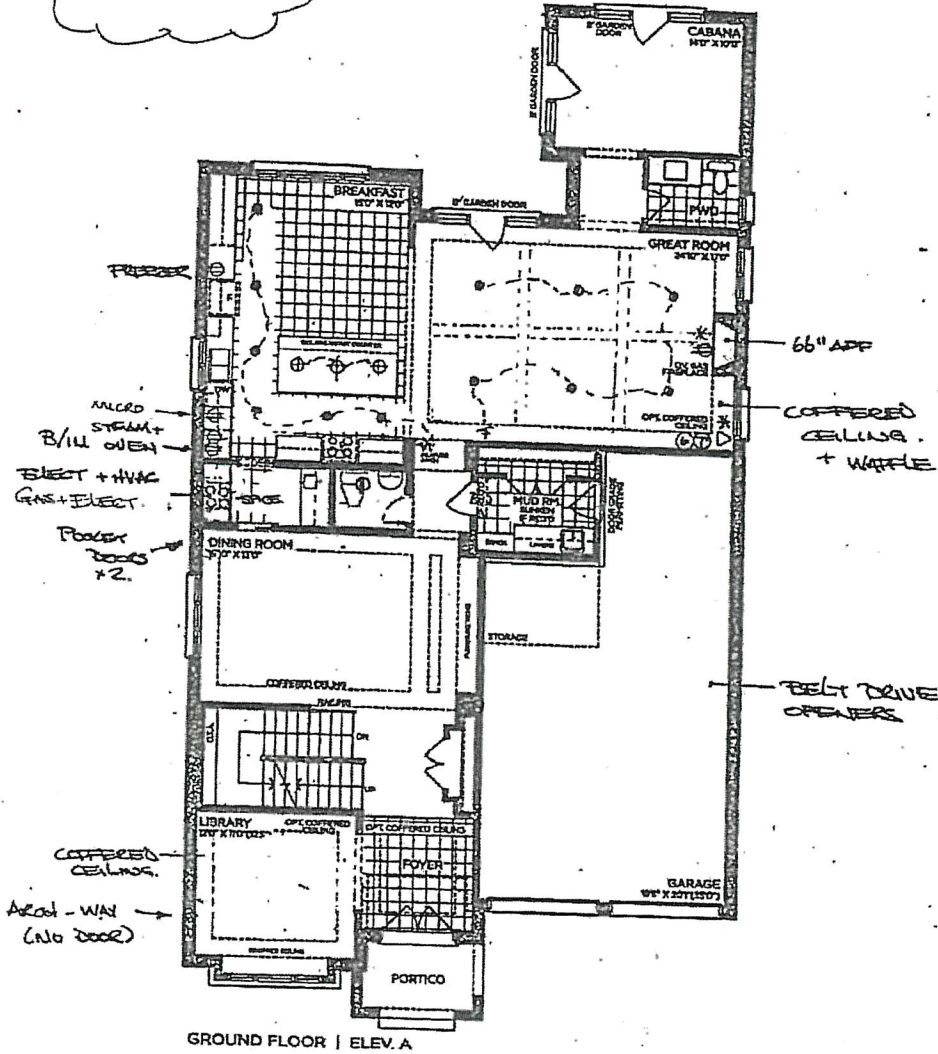

GROUND FLOOR | ELEV. A

VENDOR _____
PURCHASER Sander Aref
PURCHASER [Signature]

GOLDPARK
WORTH MORE™

Prices, figures, illustrations, sizes, features and finishes are subject to change without notice. Areas and dimensions are approximate and actual usable floor space may vary from the stated area. Layout may be reverse of the unit purchased. E. & O.E. 5005

SCHEDULE 'F'



PV-106 sa sa


MARCH 20 2020

PV-106 sa sa
APRIL 23 2020

The
Knightswood
50' SERIES

Elevation A • 4,445 sq.ft.
4,475 sq.ft. Opt. Elevator / 4,575 sq.ft. Opt. Service Stairs
Elevation B • 4,440 sq.ft.
4,475 sq.ft. Opt. Elevator / 4,575 sq.ft. Opt. Service Stairs
Elevation C • 4,525 sq.ft.
4,560 sq.ft. Opt. Elevator / 4,660 sq.ft. Opt. Service Stairs

8' Doors
on 2nd Floor

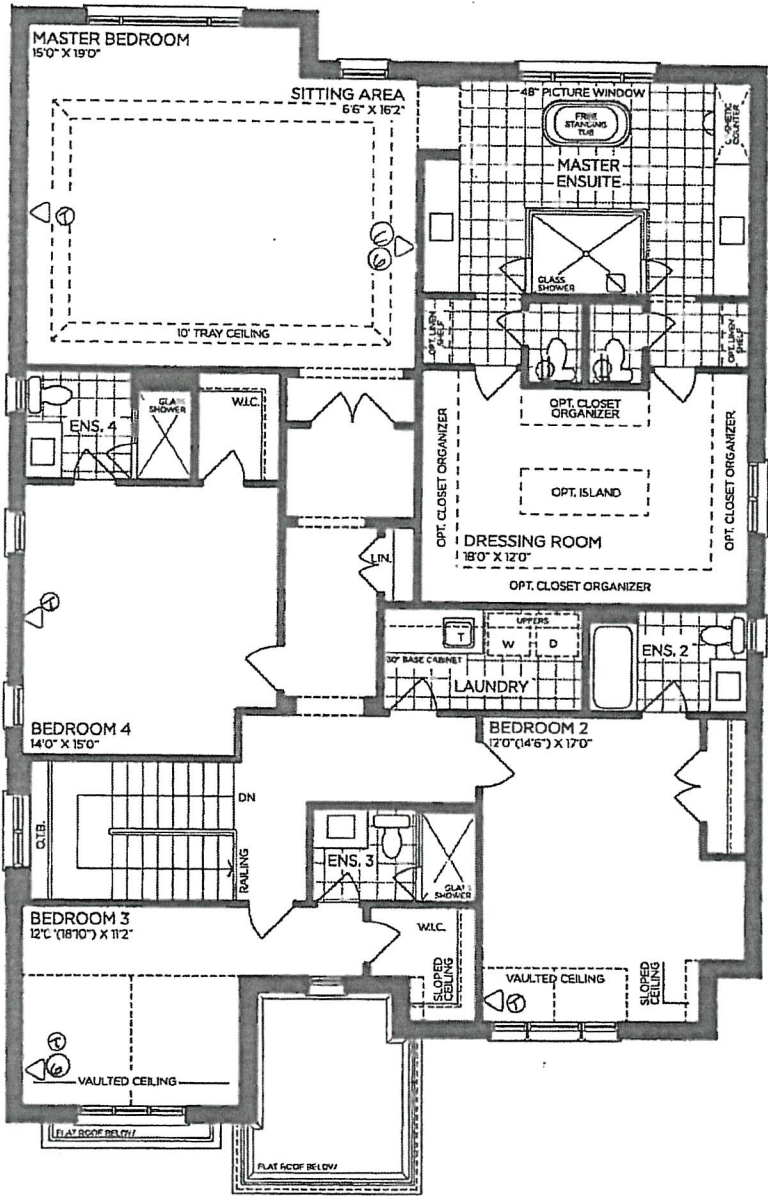

SECOND FLOOR | ELEV. A

VENDOR

PURCHASER

PURCHASER

GOLDPARK
WORTH MORE™

Prices, figures, illustrations, sizes, features and finishes are subject to change without notice. Areas and dimensions are approximate and actual usable floor space may vary from the stated area. Layout may be reverse of the unit purchased. E. & O.E. 5005

SCHEDULE 'F'



PV-106

MARCH 20 2020

PV-106

APRIL 23 2020


SA

SA

SA

4,475 sq.ft. Opt. Elevator / 4,575 sq.ft. Opt. Service Stairs
Elevation B • 4,440 sq.ft.
4,475 sq.ft. Opt. Elevator / 4,575 sq.ft. Opt. Service Stairs
Elevation C • 4,525 sq.ft.
4,560 sq.ft. Opt. Elevator / 4,660 sq.ft. Opt. Service Stairs


The Knightswood 50' SERIES

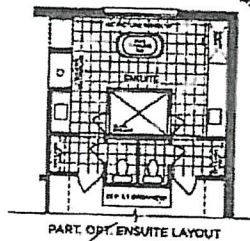


PART. OPT. ENSUITE LAYOUT




PART. OPT. WETBAR SITTING AREA

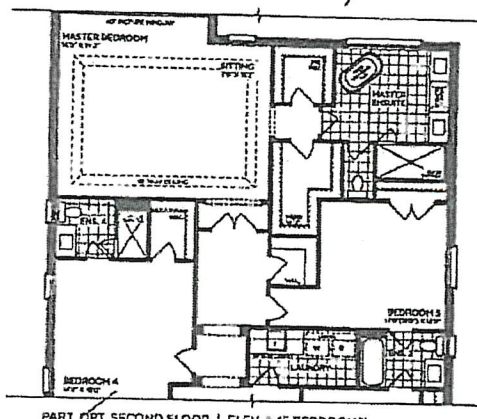


PART. OPT. SECOND FLOOR | ELEV. A (5 BEDROOMS)

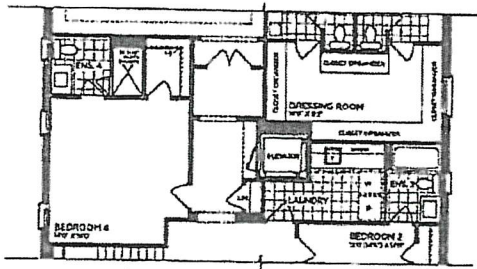


PART. OPT. SECOND FLOOR | ELEV. A (ELEVATOR)

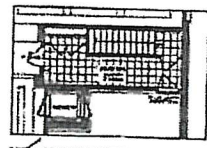


OPT. PART. GROUND FLOOR SERVICE STAIR W/ ELEVATOR | ELEV. A

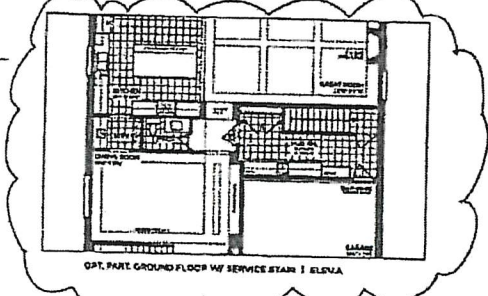

OPT. PART. GROUND FLOOR W/ SERVICE STAIR | ELEV. A

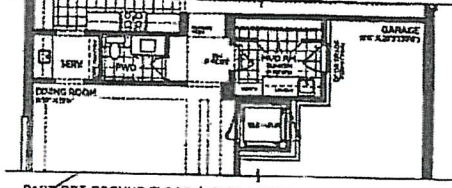

PART. OPT. GROUND FLOOR | ELEV. A (ELEVATOR)

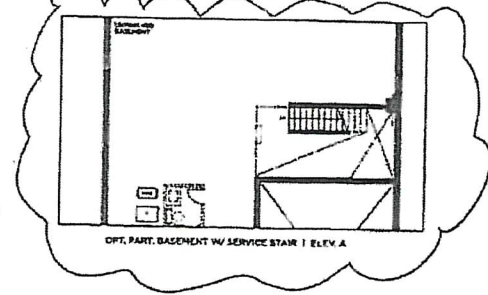

OPT. PART. BASEMENT W/ SERVICE STAIR | ELEV. A

VENDOR
PURCHASER
PURCHASER

GOLDPARK
WORTH MORE™

Prices, figures, illustrations, sizes, features and finishes are subject to change without notice. Areas and dimensions are approximate and actual usable floor space may vary from the stated area. Layout may be reverse of the unit purchased. E & O.E. 5005

SCHEDULE 'F'



PV-106

March 2, 2020

PV-106

April 23, 2020

SP SA

The Knightswood

50' SERIES

Elevation A • 4,445 sq.ft.









4,475 sq.ft. Opt. Elevator / 4,575 sq.ft. Opt. Service Stairs

Elevation B • 4,440 sq.ft.

4,475 sq.ft. Opt. Elevator / 4,575 sq.ft. Opt. Service Stairs

Elevation C • 4,525 sq.ft.

4,560 sq.ft. Opt. Elevator / 4,660 sq.ft. Opt. Service Stairs

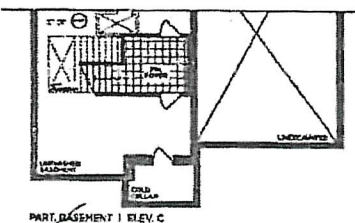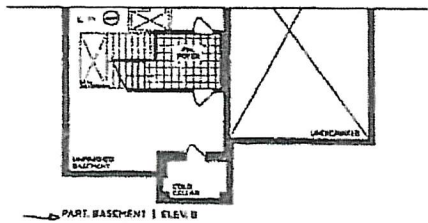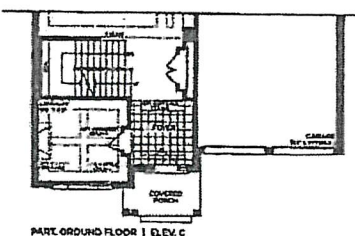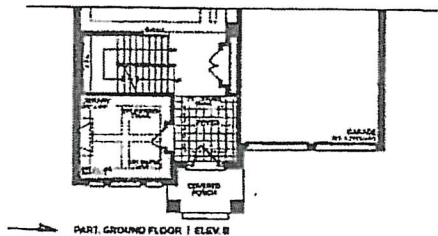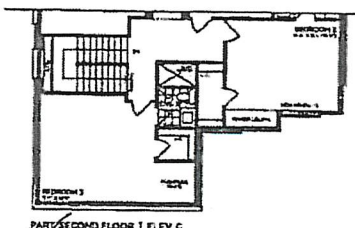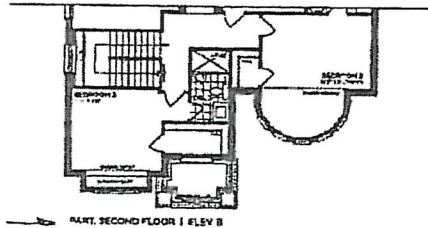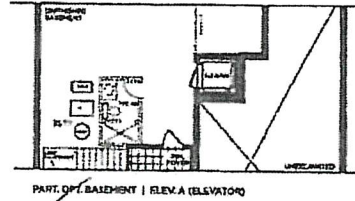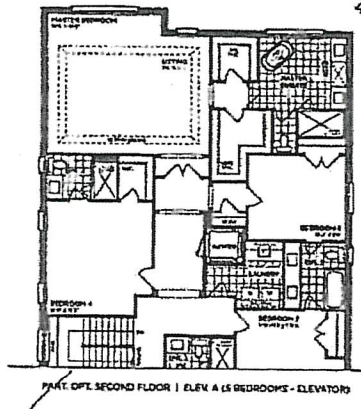

VENDOR

PURCHASER Samir Ali

PURCHASER [Signature]

GOLDPARK
WORTH MORE™

Prices, figures, illustrations, sizes, features and finishes are subject to change without notice. Areas and dimensions are approximate and actual usable floor space may vary from the stated area. Layout may be reverse of the unit purchased. E. & O.E. 5005


SCHEDULE 'F'



PV-106 (SA) (SA)
March 26 22
PV-106
APRIL 23 22 (SA) (SA)
(SA)

The
Knightswood
50' SERIES

Elevation A • 4,445 sq.ft.
4,475 sq.ft. Opt. Elevator / 4,575 sq.ft. Opt. Service Stairs
Elevation B • 4,440 sq.ft.
4,475 sq.ft. Opt. Elevator / 4,575 sq.ft. Opt. Service Stairs
Elevation C • 4,525 sq.ft.
4,560 sq.ft. Opt. Elevator / 4,660 sq.ft. Opt. Service Stairs

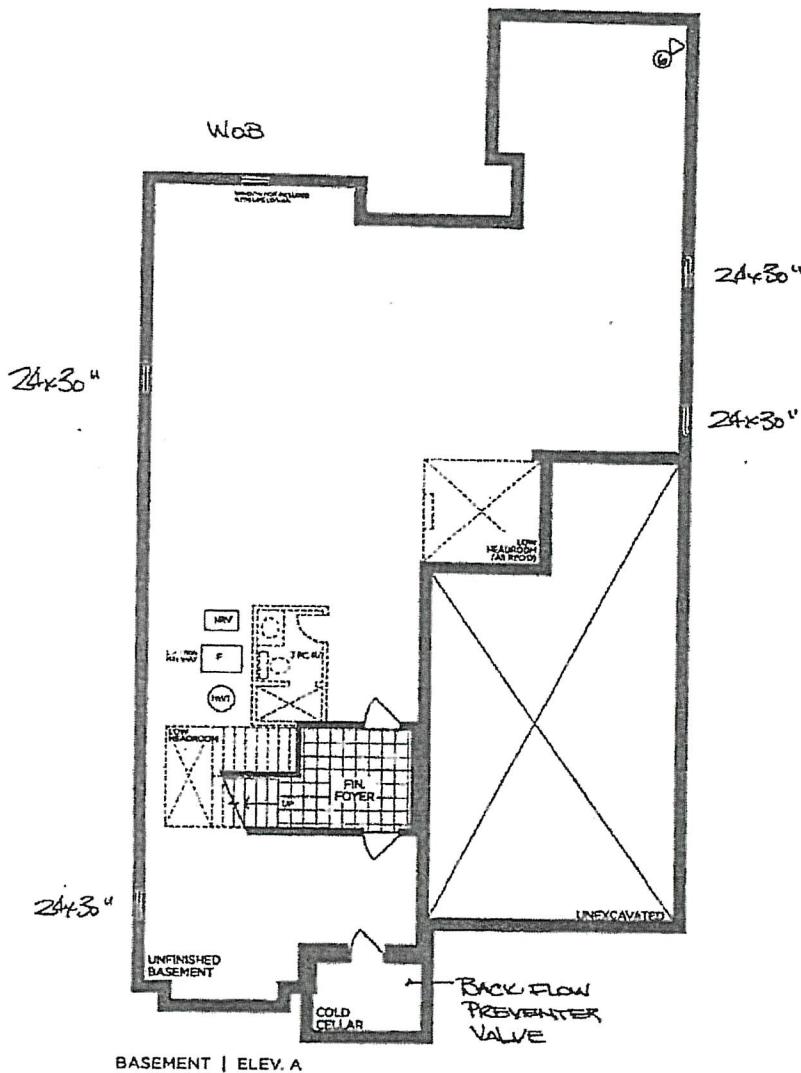

BASEMENT | ELEV. A

VENDOR
PURCHASER *Samir Aziz*
PURCHASER *[Signature]*

GOLDPARK
WORTH MORE™

Prices, figures, illustrations, sizes, features and finishes are subject to change without notice. Areas and dimensions are approximate and actual usable floor space may vary from the stated area. Layout may be reverse of the unit purchased. E & OE. 5005