

GOLDPARK

WORTH MORE™

CONSTRUCTION SUMMARY

Lot: 121

Model: 38-11 Elev A Schumann

Project/Phase: Brampton Encore / 2

APPLIANCES

Invoice	Qty.	Description
2248	1	APPLIANCE PACKAGE: FRIDGE/STOVE/DISHWASHER - STAINLESS STEEL + WASHER/DRYER - WHITE
21Apr20 NoCat		INCLUDED IN APS

CARPET

Invoice	Qty.	Description
2248	1	***CUSTOM LAYOUT*** MOVE WALL BETWEEN WIC/FORMER LAUNDRY ROOM APPROX 24" MAKING WIC SMALLER. FORMER LAUNDRY TO BECOME FUTURE OFFICE, WITH STANDARD CARPET ON FLOOR IN LIEU OF TILE.
21Apr20 NoCat		

CERAMIC

Invoice	Qty.	Description
2248	1	***CUSTOM LAYOUT*** RELOCATE LAUNDRY TO MAIN FLOOR MUDROOM/LAUNDRY DELETE CLOSET, ALLOW FOR STACKING WASHER/DRYER WITH TUB BESIDE. SEE PLAN FOR LOCATION (RELOCATE HVAC, PLUMBING, ELECTRICAL)
21Apr20 NoCat		
2363	1	MAIN FLOOR - FOYER / POWDER / KITCHEN-BREAKFAST / MUDROOM: UPGRADE 4 FLOOR TILE - 12X24" LAID IN STRAIGHT, STACKED PATTERN. SEE PLAN FOR TILE DIRECTION
17Sep20 NoCat		

CONCRETE AND DRAIN

Invoice	Qty.	Description
2248	1	ROUGH-IN - 3PC BASEMENT ROUGH-IN
28,894		
21Apr20 **		INCLUDED IN APS

CROWN MOULDING

Invoice	Qty.	Description
2363	1	**NOTE** KITCHEN: 10' CEILING PACKAGE INCLUDES CROWN & FURRING PANEL UP TO UNDERSIDE OF 12" BULKHEAD
17Sep20 NoCat		

DRYWALL

Invoice	Qty.	Description
2363	1	.KITCHEN/DINING ROOM: ADD APPROX 24" TO SHARED WALL AT KITCHEN/DINING ROOM, MAKING ARCHWAY NARROWER - SEE PLAN FOR LOCATION
17Sep20 NoCat		

DisciplineMS.rpt 26jun20

Page 1 of 7
Printed and Sent: 17-Sep-20

**Lot: 121**

Model: 38-11 Elev A Schumann
Project/Phase: Brampton Encore / 2

HVAC

Invoice	Qty.	Description
2248 21Apr20 NoCat	1	A/C- 2.5 TON INCLUDED IN APS
2248 28,874 21Apr20	1	KITCHEN: GAS LINE ROUGH - GROUND FLOOR
2248 28,879 21Apr20	1	HUMIDIFIER: WB3 - 17 (UP TO 3,000 SQ.FT.)
2248 21Apr20 NoCat	1	***CUSTOM LAYOUT*** RELOCATE LAUNDRY TO MAIN FLOOR MUDROOM/LAUNDRY DELETE CLOSET, ALLOW FOR STACKING WASHER/DRYER WITH TUB BESIDE. SEE PLAN FOR LOCATION (RELOCATE HVAC, PLUMBING, ELECTRICAL)

INTERIOR TRIM AND DOORS

Invoice	Qty.	Description
2248 28,841 21Apr20 **	1	SIDE DOOR- HOME TO EXTERIOR- AS PER PLAN AND GRADE PERMITTING INCLUDED IN APS
2248 21Apr20 NoCat	1	MAIN FLOOR CEILING 10FT Package includes taller doors & arches (96"), taller windows (front & rear), additional stairs/pickets/railing & kitchen cabinets to receive crown and furring panel over extended cabinets (come with 12" drywall bulkhead).
2363 17Sep20 NoCat	1	THRU OUT: UPGRADE INTERIOR DOORS TO MODERN FLAT PANEL DOOR 96" on MAIN FLOOR + 80" ON 2ND FLOOR
2363 17Sep20 NoCat	1	.KITCHEN/DINING ROOM: ADD APPROX 24" TO SHARED WALL AT KITCHEN/DINING ROOM, MAKING ARCHWAY NARROWER - SEE PLAN FOR LOCATION

WINDOWS AND DOORS

Invoice	Qty.	Description
2248 28,841 21Apr20 **	1	SIDE DOOR- HOME TO EXTERIOR- AS PER PLAN AND GRADE PERMITTING INCLUDED IN APS
2248 28,842 21Apr20 **	1	MANDOOR - GARAGE TO HOUSE- AS PER PLAN AND GRADE PERMITING INCLUDED IN APS
2248 21Apr20 NoCat	1	MAIN FLOOR CEILING 10FT Package includes taller doors & arches (96"), taller windows (front & rear), additional stairs/pickets/railing & kitchen cabinets to receive crown and furring panel over extended cabinets (come with 12" drywall bulkhead).

Scheduled Closing Date:

Purchaser: CHIRAG DHIRUBHAI GAJJAR & LAXMIBEN GA Property: 121

Telephone Res. / Bus: (416) 616-5386

Project: Brampton Encore - Phase 2

Decor Advisor: Yolande Somerville

Model and Elevation: 38-11 Elev A Schumann

Layout Changes: ☐ Yes ☒ NoSketch Attached: ☒ Yes ☐ NoExterior Colour Scheme:

1. Cabinetry

	Style and Colour	Counter	Hardware
Kitchen / Breakfast	P-400 pvc 'white crystal'	Granite: Grigio Sardo	*CH-46
Laundry Room	n/a	n/a	n/a
Powder Room	n/a	n/a	n/a
Twin Bath	P-400 pvc 'white crystal'	P-Lam #6698-46	cs1-24
Master Ensuite Bathroom	P-400 pvc 'white crystal'	P-Lam #6698-46	cs1-24
Second Ensuite Bathroom (If Applicable)	P-400 pvc 'white crystal'	P-Lam #6698-46	cs1-24

Comment

2. Floor Tile

	Selection
Entrance Vestibule	*12x24" Volkas polished 'White'
Main Hall	n/a
Kitchen / Breakfast	*12x24" Volkas polished 'White'
Laundry Room	*12x24" Volkas polished 'White' (mud room)
Powder Room	*12x24" Volkas polished 'White'
Twin Bath	13x13" Serpentine 'Beyaz-white'
Master Ensuite Bathroom	13x13" Serpentine 'Beyaz-white'
Second Ensuite Bathroom (If Applicable)	13x13" Serpentine 'Beyaz-white'
Lower Landing (If Applicable)	n/a

Comment

3. Wall Tile

	Selection	Listello/Inserts	Describe
M.Ens Tub skirt/splahsh	8x10" Splendour 'White'	☐ Yes ☒ No	
Master Ensuite Bathroom			
Tub Deck	8x10" Splendour 'White'	☐ Yes ☒ No	
Shower Stall	8x10" Splendour 'White'	☐ Yes ☒ No	
Bathroom Walls	n/a	☐ Yes ☒ No	
Second Ensuite Bathroom (If Applicable)	8x10" Splendour 'White'	☐ Yes ☒ No	
Twin Bath	8x10" Splendour 'White'	☐ Yes ☒ No	
Kitchen Backsplash	☐ Yes ☒ No		

Comment

Backsplash Behind Fridge

Purchaser: CHIRAG DHIRUBHAI GAJJAR & LAXMIBEN GA Property: 121

Telephone Res. / Bus: (416) 616-5386

Project: Brampton Encore - Phase 2

Decor Advisor: Yolande Somerville

Model and Elevation: 38-11 Elev A Schumann

4. Plumbing Fixtures

Master Ensuite Bathroom ☐ Second Ensuite ☐ Powder Room ☐
Other Room - Specify ☐ Other Washroom ☐

Comment

Standard thru out

5. Hardwood Flooring

	Type and Stain		Type and Stain
Main Hall	*3/4x5" White oak smooth 'Oracle'	Upper Landing	*GRAPHITE*3/4x5" rd.oak smooth
Kitchen / Breakfast	n/a	Upper Hall	n/a
Living Room	*3/4x5" White oak smooth 'Oracle'	Master Bedroom	n/a
Dining Room	*3/4x5" White oak smooth 'Oracle'	Bedroom #2	n/a
Family Room	*3/4x5" White oak smooth 'Oracle'	Bedroom #3	n/a
Den/Library	n/a	Bedroom #4	n/a
Entrance Vestibule	n/a	Bedroom #5	n/a
Lower Landing (If Applicable)	*GRAPHITE*3/4x5" rd.oak smooth	Other Room - Specify	

Comment

STAIRS WILL NOT MATCH HARDWOOD FLOORS IN COLOUR/TEXTURE/SPECIES - LANDINGS TO MATCH STAIRS, NOT HARDWOOD FLOORS

6. Carpeting

	Upgrade	Description
Ground Floor	☐	
Second Floor	☐	*Standard 4002-21 with std u/pad
	☐	

	Type	Area
Upgrade Underpad		
	Capped	Runner - *Upgrade
Carpet on Stairs		

Comment

7. Fireplace

	Living Room			Family Room			Other Room - Specify		
	Purchased	As Per Plan	N/A	Purchased	As Per Plan	N/A	Purchased	As Per Plan	N/A
Fireplace Type	☐	☐	☒	☐	☐	☒	☐	☐	☒
Mantle Type				*NONE*					
Colour / Stain				*NONE*					
Surround				*NONE*					
Hearth				*NONE*					

Comment

AUG 31 2020
Page 2 of 4

Scheduled Closing Date:

Purchaser: CHIRAG DHIRUBHAI GAJJAR & LAXMIBEN GA Property: 121

Telephone Res. / Bus: (416) 616-5386

Project: Brampton Encore - Phase 2

Decor Advisor: Yolande Somerville

Model and Elevation: 38-11 Elev A Schumann

8. Trim Carpentry

Interior Doors *Flat slab Front Door Glass Inserts Standard Door Handles Standard
Interior Trim Standard

Comment

*96" doors and arches on main floor + 80" on 2nd floor

9. Plaster Mouldings and Medallions

Standard Throughout ☐ Yes ☐ No ☒ N/A

Entrance Vestibule			Kitchen/Breakfast		
Main Hall			Den/Library		
Living Room			Lower Landing		
Dining Room			Other Room - Specify		
Family Room					

Comment

10. Railings and Spindles

Railing Package Standard oak
Railing Colour *Graphite Spindle Colour *Graphite
Stringer / Riser *Graphite Treads *Graphite
Oak Stairs ☒ Yes ☐ No ☐ N/A

Comment

11. Wall Paint / Ceilings

Throughout Finished Areas Cool White

Trim Paint White

Smooth Ceilings

Ground Floor ☒Second Floor ☐Note

Comment

SEPT. 3, 2020.

Purchaser: CHIRAG DHIRUBHAI GAJJAR & LAXMIBEN GA Property: 121

Telephone Res. / Bus: (416) 616-5386

Project: Brampton Encore - Phase 2

Decor Advisor: Yolande Somerville

Model and Elevation: 38-11 Elev A Schumann

12. Electrical

Hood Fan ☐ White ☒ Stainless ☐ N/A

Above Kitchen Cabinet Light ☐ Yes ☒ No

Below Kitchen Cabinet Light ☐ Yes ☒ No

Standard Appliances ☐

Over The Range Microwave ☐

Chimney Style Fan ☐

Comment

13. Heating and Air Conditioning

Air Conditioning YES

Gas Provisions Stove YES

Gas Provisions Dryer no

Gas Provisions Barbecue Std

Comment

14. Additional Comments

15. Disclaimers and Notes

- 1) Colours of all materials are as close as possible to builder's selection, but not necessarily identical due to variances in manufacturing.
- 2) Any extras listed above are null and void unless accompanied by a separate invoice/amendment. Said invoice must be paid in full.
- 3) The Purchaser acknowledges that after Interior Colour Selection form is signed and dated, no further changes will be permitted other than re-selection due to unavailability. _____ Purchaser's Initials
- 4) The Purchaser acknowledges reading and accepting the "Gold Park Homes Decor Centre Disclaimers" form. This document contains other miscellaneous disclaimers.

This Interior Colour Selection is final and approved by:

Signature: _____

Date: AUG 31 2020

encore
BRAMPTON

SCHEDULE 'F'

BEZ-121

APRIL 6 2020

August 31, 2020

The Schumann 38' SERIES

Elevation A • 3,050 sq.ft.
Elevation B • 3,050 sq.ft.

DELETE
FIREPLACE



10' CEILING
ON MAIN FLOOR.

GAS + ELECT.

smooth ceiling

EXTEND WALL
APPROX 24"
OVERS.

*REVISED
LAYOUT*

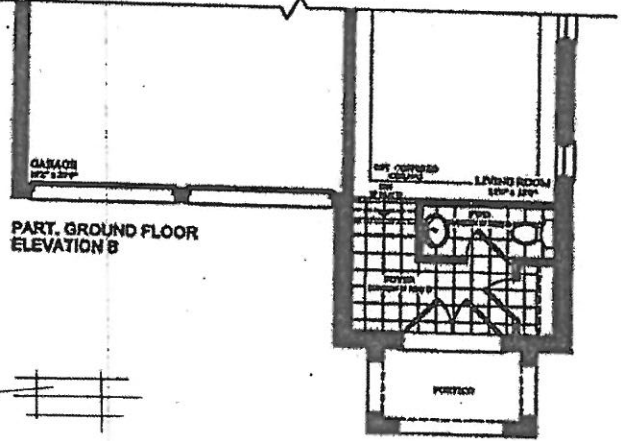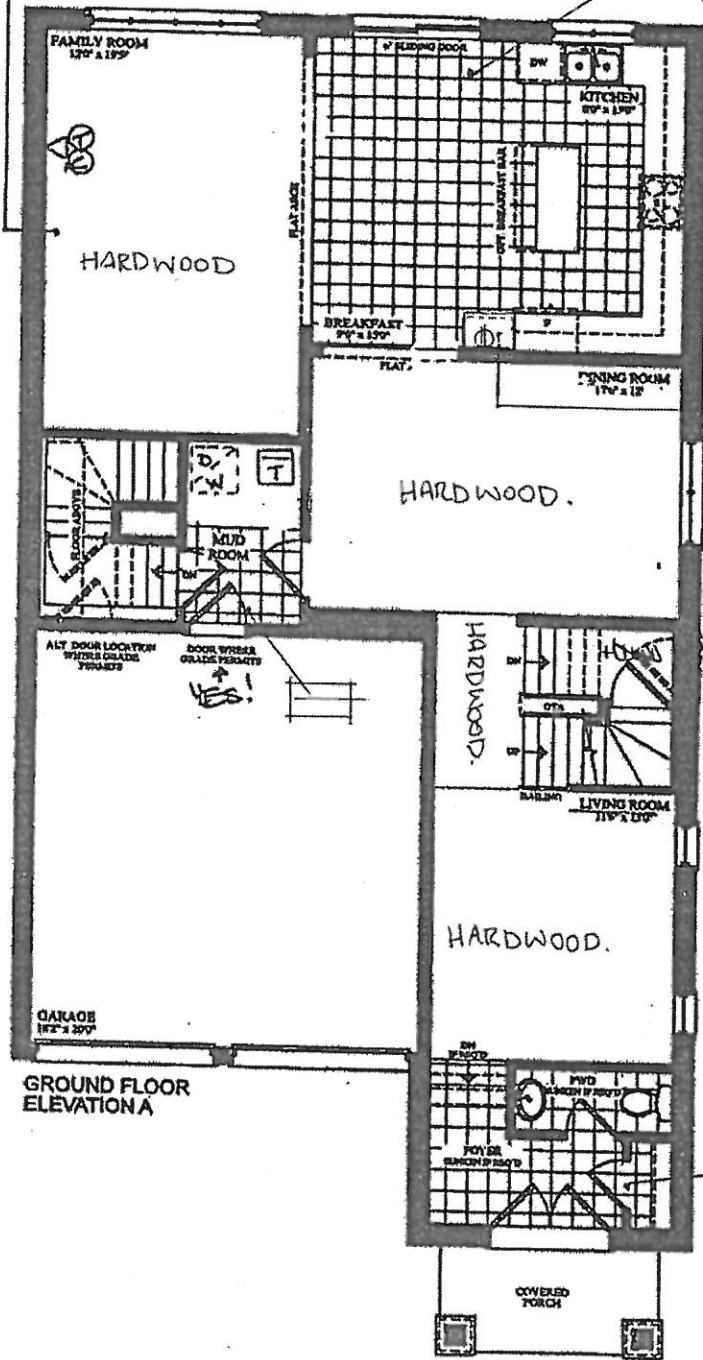

VENDOR

PURCHASER

PURCHASER

GOLDPARK
WORTH MORE™

Prices, figures, illustrations, sizes, features and finishes are subject to change without notice. Areas and dimensions are approximate and actual usable floor space may vary from the stated area. Layout may be reverse of the unit purchased. E. & O.E.

encore
BRAMPTON

SCHEDULE 'F'


The Schumann 38' SERIES

Elevation A • 3,050 sq.ft.
Elevation B • 3,050 sq.ft.

BEZ-121
APRIL 6 2020


August 31, 2020.

Y. K. K. K.

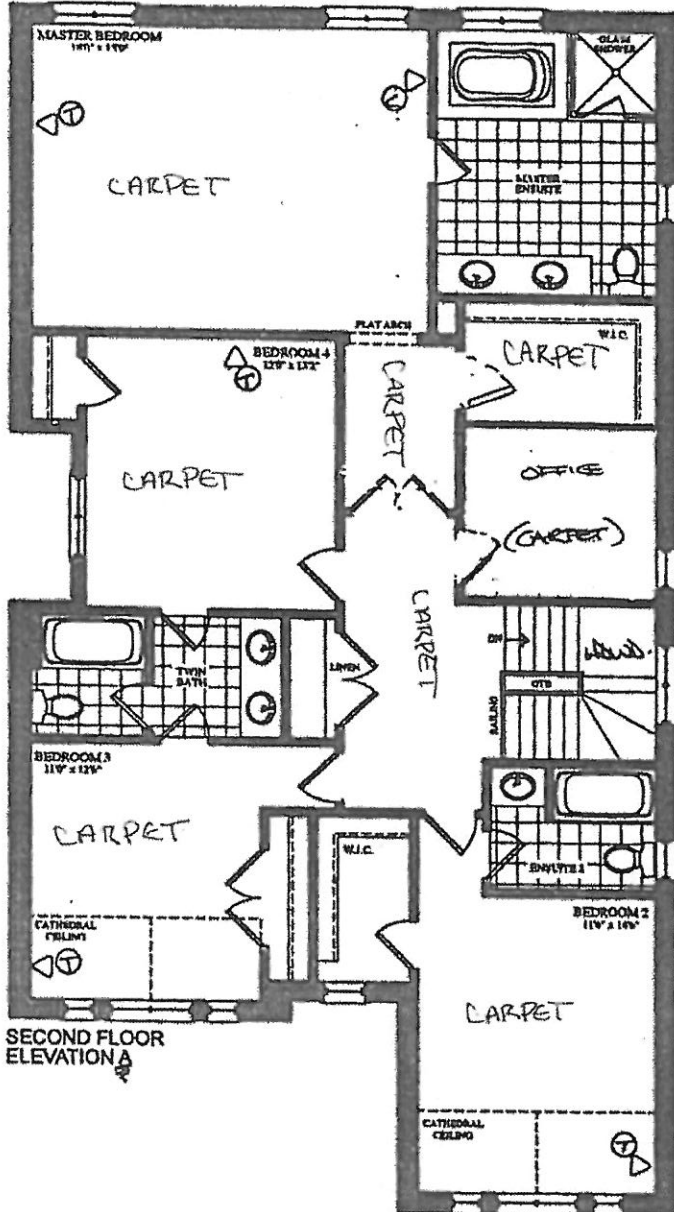

↑
MOVE WALL
APPROX 24"

REVISE
LAYOUT

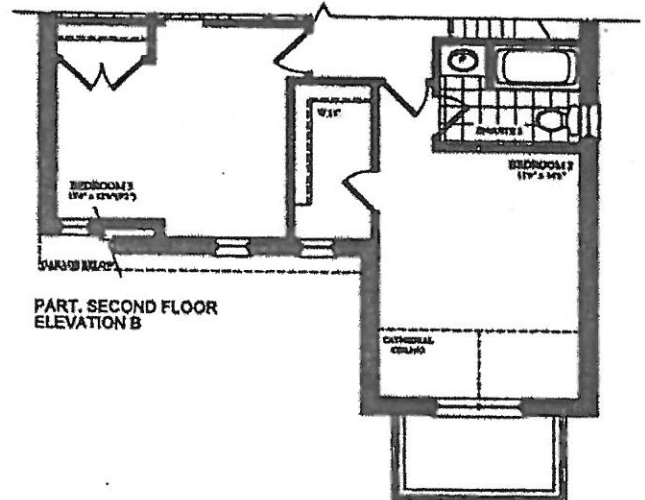

VENDOR

PURCHASER

PURCHASER

GOLDPARK
WORTH MORE™

Prices, figures, illustrations, sizes, features and finishes are subject to change without notice. Areas and dimensions are approximate and actual usable floor space may vary from the stated area. Layout may be reverse of the unit purchased, E. & O.E.

The Schumann 38' SERIES


→ Elevation A • 3,050 sq.ft.
Elevation B • 3,050 sq.ft.

BE2-121

APRIL 6 2020

August 31, 2020

legu

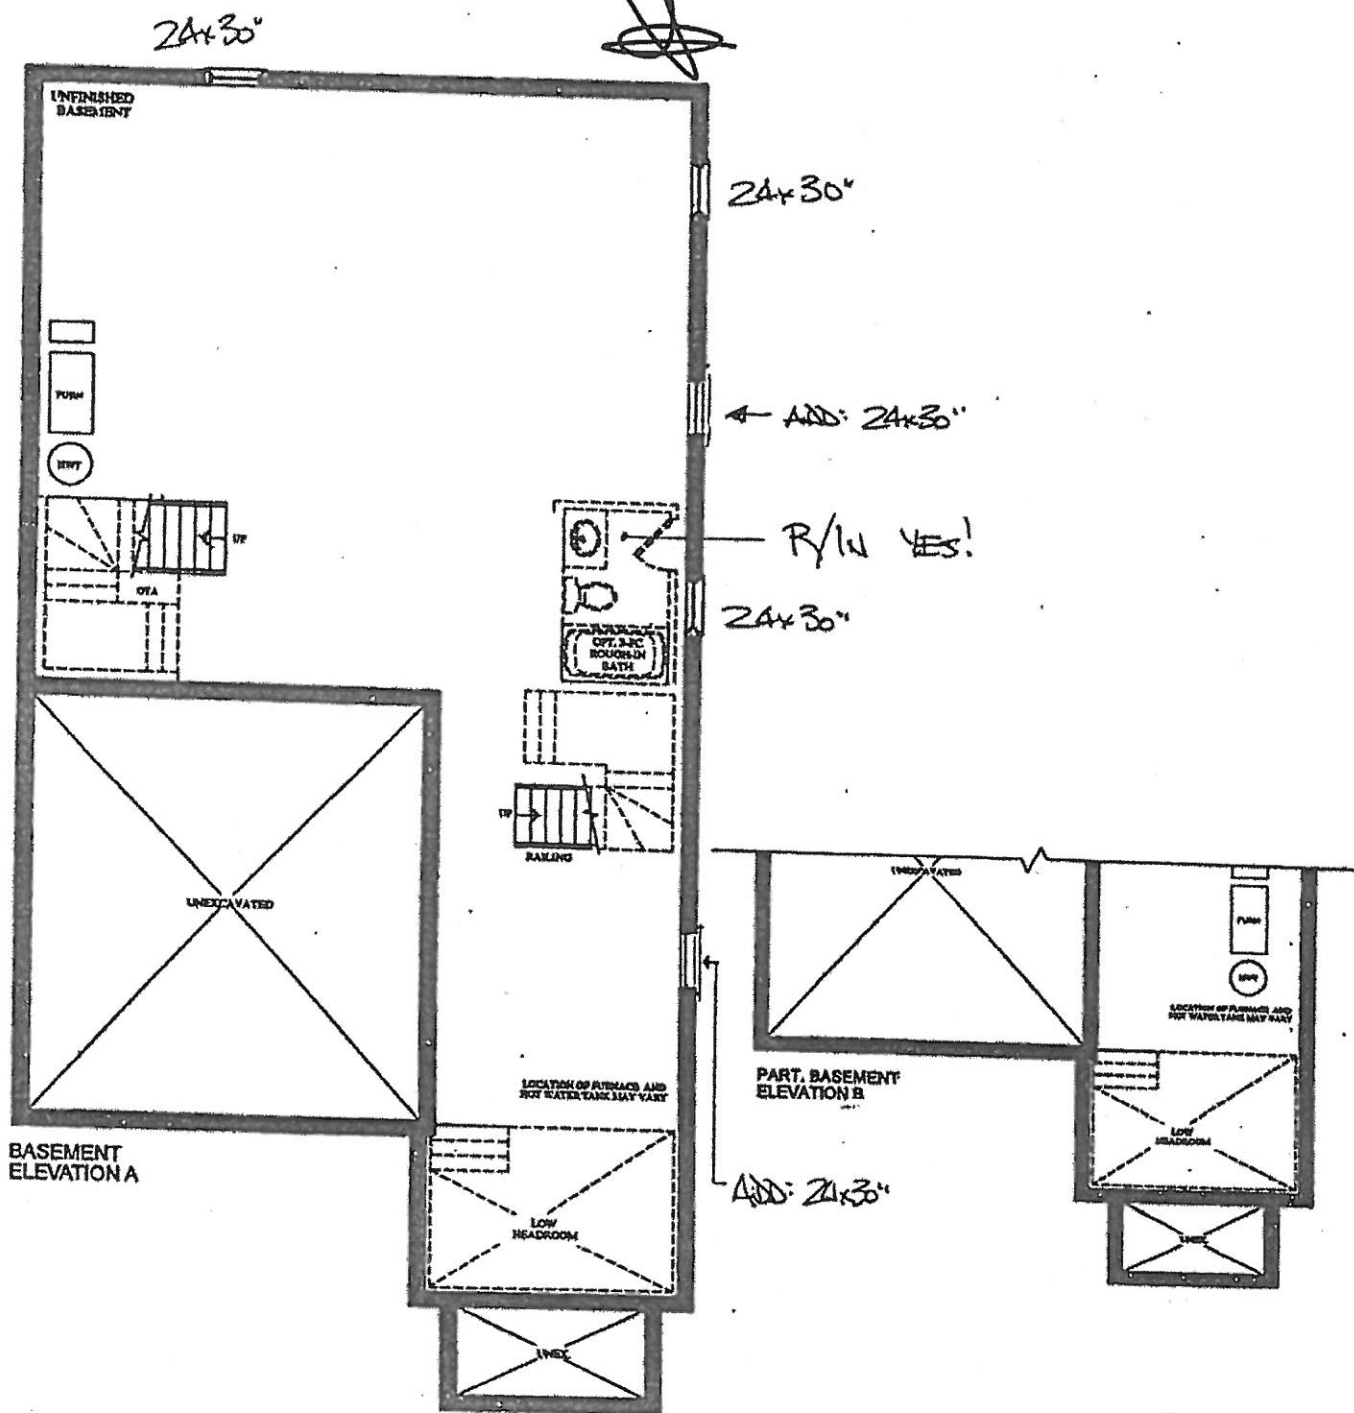

VENDOR

PURCHASER

PURCHASER

GOLDPARK
WORTH MORE™





Prices, figures, illustrations, sizes, features and finishes are subject to change without notice. Areas and dimensions are approximate and actual usable floor space may vary from the stated area. Layout may be reverse of the unit purchased. E. & O.E.

Item A. Wood grain and colour are characteristics of the product. We cannot guarantee that such grain and colour will always match.
Item B. Corina Kitchens Inc. reserves the right to alter dimensions and make technical changes without notice.

BE2-121
August 31 2020

Address:	Project: ENCORE 2	Phase:

This layout has been explained to the purchaser by Cortina Kitchens Inc. and is understood by the purchaser.

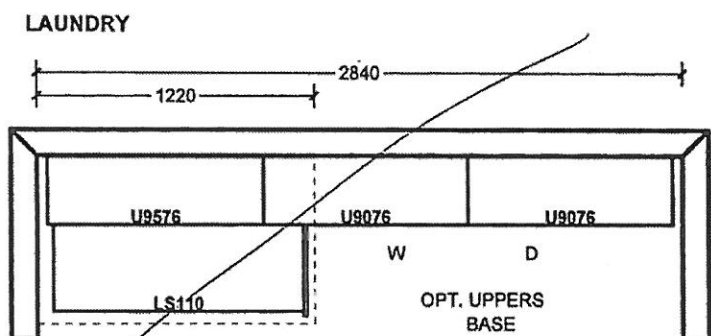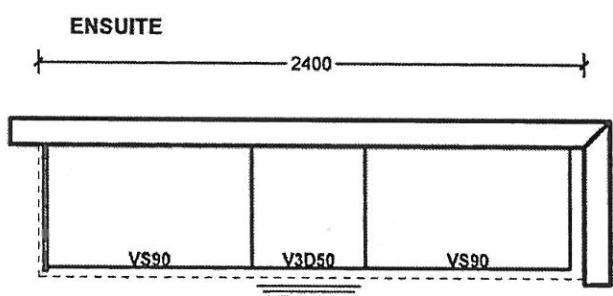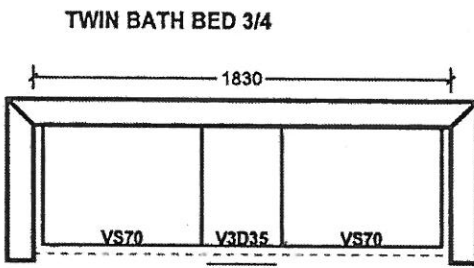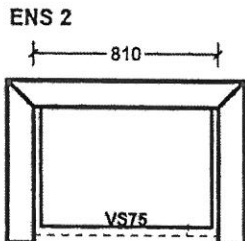

All prices subject to confirmation from head office.
This quotation is subject to the terms & conditions set out
in Cortina's Agreement of Purchase and Sale.

All agreements are contingent upon strikes, accidents, and delays beyond our control.
Please provide our installer with template for sinkholes or \$150.00 will be charged for callback.

ACCEPTED DATE: _____




Customer Signature Salesperson Signature Cortina Head Office Approval

Item A. Wood grain and colour are characteristics of the product. We cannot guarantee that such grain and colour will always match.
Item B. Cortina Kitchens Inc. reserves the right to alter dimensions and make technical changes without notice.



Granite, Marble,
Engineered Surfaces

- Standard 2CM & 3CM
- ⊖ Upgrade 1 2CM & 3CM
- ⊗ Upgrade 1 4 CM
- Upgrade 2

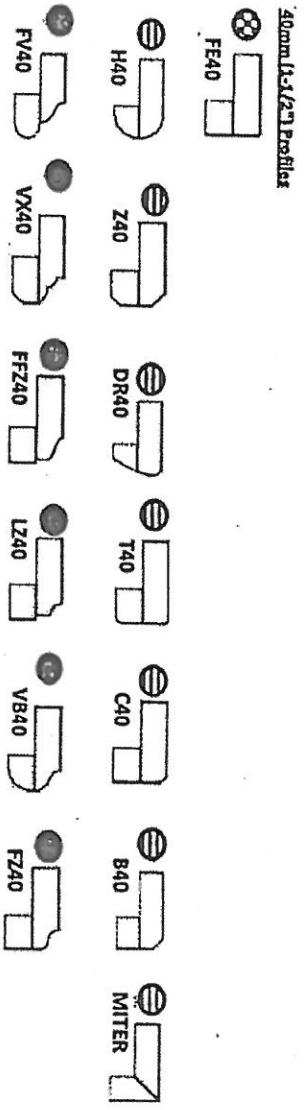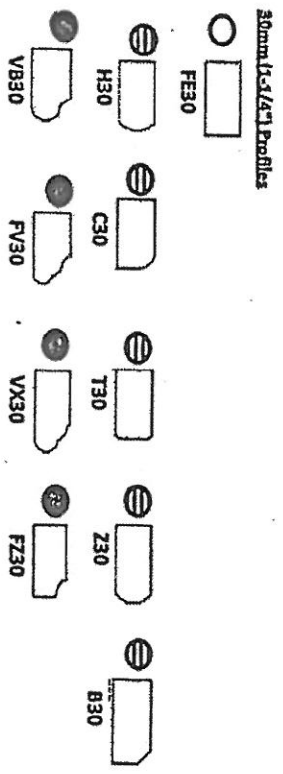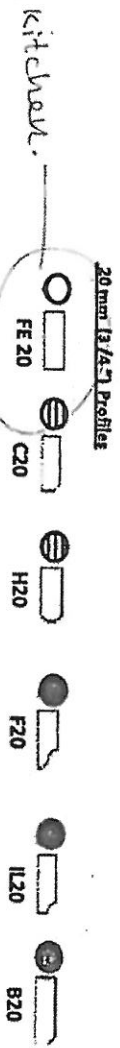

Note: All colours may not be available in 30mm at time ordered. Vendor reserves the right to use 40 mm edges (by lamination process).

*Mitre edge is available in Upgrade 1 for an overall thickness of 2". All other Mitre edge options will be an Upgrade 2 Edge.

Vendor
August 31


ARTINA

UPGRADE HARDWARE

BE2-121

August 31, 2020

UPGRADE HARDWARE

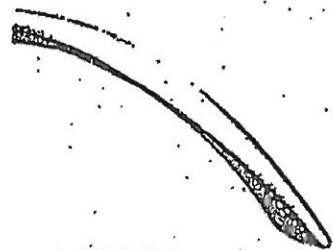

CH-32




CH-38




CH-44




CH-45

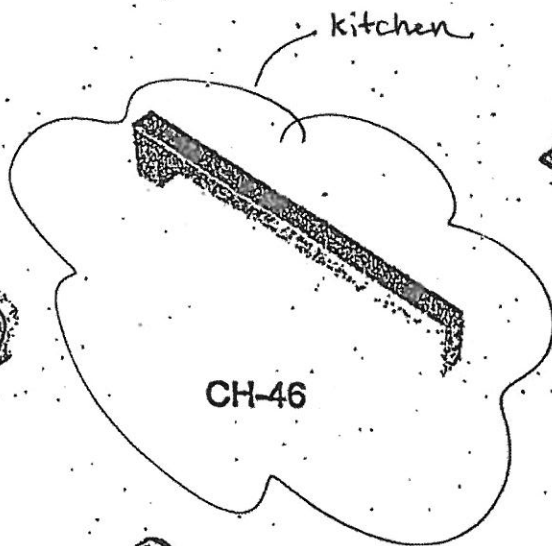


CH-46

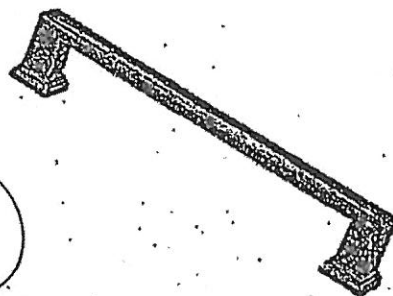

CH-47

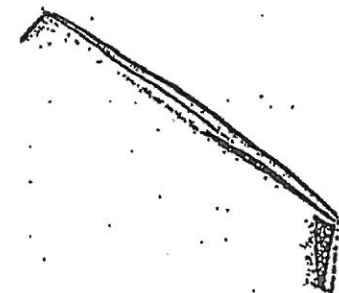


CH-48

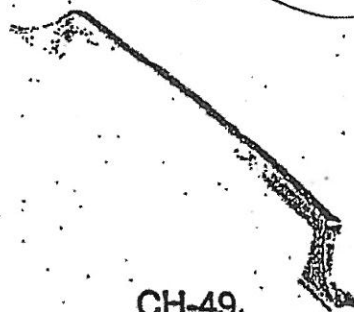


CH-49




CH-50

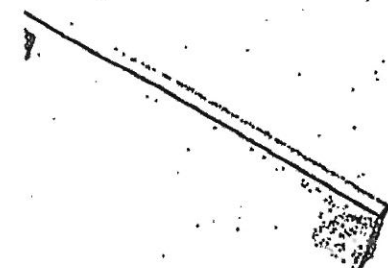

CH-51

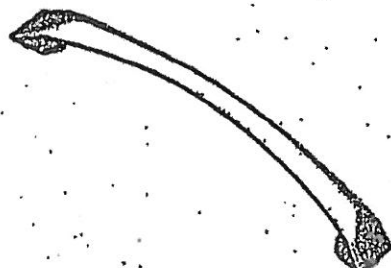

CH-52

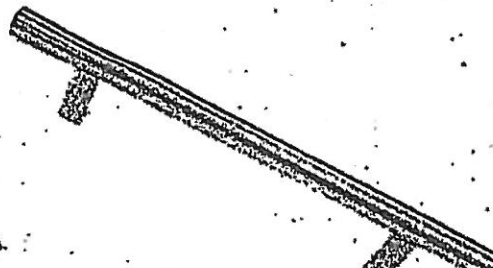

CH-53

NOTES:

IMAGES ARE FOR QUICK REFERENCE PURPOSES ONLY
ACTUAL SIZES AND FINISHES AS PER HARDWARE
SAMPLE BOARD PROVIDED TO DECOR CENTRE




CSI-6



CSI-10




CSI-14

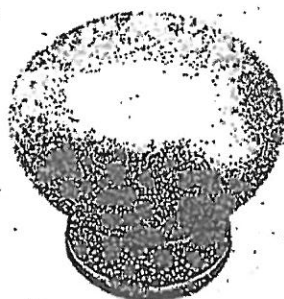

CSI-16



CSI-18

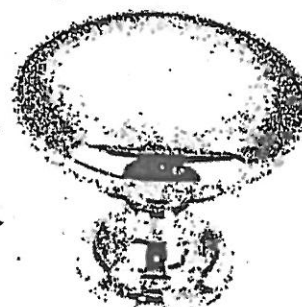

CSI-19




CSI-20




CSI-21




CSI-22

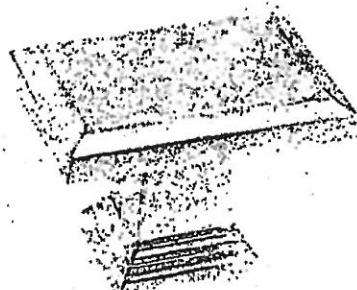

CSI-23

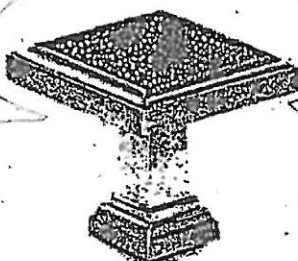

CSI-24

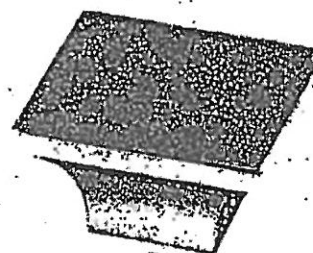

CSI-25

1. Master Ensuite
2. Twin Bath
3. Ensuite 2.

***NOTES:**

- IMAGES ARE FOR QUICK REFERENCE PURPOSES ONLY
- ACTUAL SIZES AND FINISHES AS PER HARDWARE SAMPLE BOARD PROVIDED TO DECOR CENTRE



BATHROOM ACCESSORIES

PROJECT: ENCORE 2

LOT: 121

INSTALL STANDARD BATHROOM ACCESSORIES
THRU OUT (TOWEL BAR, SOAP DISH, TISSUE
HOLDER) **location as per vendors discretion



DO *NOT* INSTALL STANDARD BATHROOM
ACCESSORIES THRU OUT (TOWEL BAR, SOAP
DISH, TISSUE HOLDER)



SIGNATURE: _____



Vendor

SIGNATURE: _____



DATE: August 31 2020

Gold Park Homes Décor

Centre Disclaimers

GOLDPARK
WORTH MORE

Through years of doing business, we at Gold Park Homes have encountered issues beyond our control. The following disclaimers apply to all instances of Purchaser's Extras forms and all Interior Colour Scheme forms.

FIREPLACES

Fireplace Marble: Due to the many variables that can affect the pattern and/or design, frequently the marble installed on the fireplace will not be identical to the samples. We will make every attempt to come as close to the samples as possible, but cannot be responsible for results which differ from the samples.

CERAMIC FLOOR TILE

Many variables including variegation can affect tile colour, pattern and/or design which mean installed tiles may not be identical to the samples. We will make every attempt to come as close as possible, but cannot be responsible for results which differ from the samples.

HARDWOOD FLOORING

The purchaser is advised that cupping and shrinkage are characteristics of hardwood flooring normally appearing after installation, especially when humidity levels are not regulated, and no warranty is provided by the flooring supplier with respect to such cupping and shrinkage. Furthermore, hardwood floors may also heave and warp when located at or close to entrance points of the home, where rain could make its way to the flooring. The vendor agrees to install any hardwood flooring ordered by the purchaser in a good and workmanlike manner, but shall not be responsible for, and is hereby released by the purchaser from responsibility and liability for cupping, shrinkage, heaving and warping of hardwood flooring in the above mentioned circumstances.

STAIRCASE VS FLOORING

WOOD SPECIES DIFFERENCE

The purchaser is aware and therefore accepts and acknowledges that the wood species of the staircase and flooring chosen do not match. This difference might result in an undesirable colour variance.

The purchaser is aware and therefore accepts and acknowledges that though the flooring is of the same species as the staircase the difference in product finishing may result in a stain colour variance.

The purchaser agrees that the vendor is to be exempt from any and all claims by the purchaser regarding this colour variance.

RAILINGS

All railings, pickets, posts, nosing's and stairs come from solid wood and veneered wood materials sourced from multiple locations and sources. As such there will be variations in grains and shades between the various natural components beyond our control. Due to this variance in material, all components will stain with colour or natural finish differently.

Iron pickets are wrought in nature and depending on the manufacturing process will have differences from picket to picket which is normal. Also the finish of the iron pickets is of a powder coated nature. This process can produce minor colour variations or tones. Furthermore, the assembly of the metal pickets can develop a natural rattle over time from vibration in the railing. Minor rattling is normal and is a part of the wrought iron picket assembly.

HOUSE EXTERIORS

Variations in subcontractors across different sites and varying site conditions may result in house exteriors that differ from the artist renderings. We cannot be responsible for results which differ from the artists renderings of elevations.

PLASTER MOULDINGS AND MEDALLIONS

Plaster mouldings will not be installed in open to above areas or areas with 2 storey elements.


STAIN COLOURS

Due to the many variables that can affect the outcome of a stain colour on wood, staircases, railings, and fireplaces, the colour may not be identical to samples. Factors such as density, age, humidity, air temperature, and the uniqueness of each piece of wood can result in wide variations in darkness or lightness. We will make every attempt to come as close to the sample as possible, but cannot be responsible for results which differ from the samples.

Stain on pre-finished hardwood floors will not be an exact match to the stain colours available on stairs, pickets and rails. The purchaser is responsible for choosing the stain on these areas to their satisfaction.

IN-WALL CONDUIT FOR AUDIO/VIDEO CABLES

It is important to note that due to the variation in framing requirements in different parts of your home, conduit lengths and routing can vary. In virtually all instances of ground floor installation (i.e. above a fireplace), conduit will first travel down into the basement below the floor joists, over to the termination point and back up into the main floor. As a result, it is best to measure the length of the conduit after occupancy with a "pull wire" before

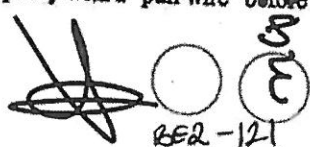
August 31, 2020

purchasing your cables. For above-fireplace installations, the conduit wall plate will be installed approximately 10" above the Fireplace Mantle, unless otherwise specified in the Construction Summary.

APPLIANCE SPECIFICATIONS

All appliance openings are set to builder's standard openings. Please advise Décor Centre at time of your structural appointment if custom sizing of cabinets is required for any built-in appliances. The purchaser is responsible for costs and fees associated with changes to pre-manufactured kitchens made subsequent to colour appointments.

Purchaser accepts & acknowledges that in order to accommodate upgraded appliances, all appliance specifications should be provided at the time of their structural appointment, should this not occur they must be provided to the Décor Center within one (1) week of completion of structural chart. Failure to do so may result in the need to revert to the standard appliance openings or in a delay in construction of your dwelling, as well as a cost of \$500 to re-open your structural file should changes be required. As a result we may be forced to extend the closing of your transaction. Due to failure to complete the above-mentioned selections and at no fault of our own, we reserve our right to hold you responsible for this delayed closing, including charging extra administration cost and interest on the balance due on closing.

Purchasers Accept Standard Appliance Openings (unless otherwise specified):
Fridge - 37-1/2"W x 73-1/2" High Approx.
Range - 30-1/2"D x 31-1/2"W Approx.
Dishwasher - 24" W Approx.

DELETION OF HOODFAN & CABINETS ABOVE STOVE:

The purchasers are aware that in requesting NOT TO INSTALL builder's standard hood fan and standard cabinets above stove they will receive NO STANDARD HOOD FAN and NO CREDIT. Purchasers are installing their own hood fan after closing and accept that it may waive any warranty associated with such a change.

Purchasers accept and acknowledge that the exhaust fan duct hole may be off-centered with the stove in the kitchen due to purchasers installing their own hood fan after closing. The vendor is exempt from adjusting such openings for the purchasers range hood.

ELECTRICAL FOR APPLIANCES

Pricing is subject to change based on the appliance specifications provided. Purchasers should provide proper appliance specifications and cut-out sheets in order for Gold Park to price extras accordingly.

KITCHEN CABINETS

The kitchen you order/purchase will undoubtedly contain slight colour variations. The degree of these variations is virtually impossible to determine before the kitchen is installed in its intended location. The amount of and type of lighting will also affect various highlights in the finish. Note: No two pieces of wood are identical. Variations in colour tone and grain patterns make a perfect colour match virtually impossible. It is generally agreed that these variations add to the natural beauty of a wood kitchen.

STAIN

Charcoal is a spray stain applied to Oak and Maple products with several characteristics that are important to be aware of when purchasing this product.

1. Shadow lines may be visible at the interior profile edges of a door or drawer front. If movement occurs shadow lines may increase or decrease, depending on the style and/or size of a door or drawer front.
2. Variation and unevenness may be visible in the finish.
3. Hairline cracks at the joints are created over time due to the nature of natural wood, caused by usage, humidity**, or dryness. They tend to be more visible to darker stains, than lighter wood stains.

** Relative humidity is recommended to be between 45% and 55%. Please refer to Cortina Kitchens "Cleaning, Care, Maintenance, & Warranty Information" guide.

Please be advised that Cortina Kitchens will not replace doors and/or parts that exhibit the above characteristics associated with this finish. These characteristics are not avoidable and are a result of the natural characteristics of wood and wood veneer, and the characteristics of darker stains on wood. The Charcoal stain is not available on doors in Group IV, Group IVA, Group V and Group VA.

Cortina Kitchens offers a wide variety of finishes, applied to oak and maple products. The subject finishes include the spray stains Cocoa, Espresso, Graphite as well as wiping stain Ebony.

Due to the very dark stains applied on natural maple and oak doors and joints, several characteristics are important to be noted when purchasing these products.

1. Shadow lines may be visible at the interior profile edges of a door or drawer front. If movement occurs shadow lines may increase or decrease, depending on the style and/or size of a door or drawer front.
2. Variation and unevenness may be visible in the finish.
3. Hairline cracks at the joints are created over time due to the nature of natural wood, caused by usage, humidity, or dryness. They tend to be more visible to darker stains, than lighter wood stains.

Please be advised that Cortina Kitchens will not replace doors nor parts that exhibit the above characteristics associated with this finish. These characteristics are not avoidable and are a result of the natural characteristics of wood and wood veneer, and the characteristics of darker stains on wood.





BE2-121

August 31, 2020.

CABINETRY DOOR HARDWARE

Cortina Kitchens' cabinetry doors and drawer fronts will be drilled to accept a standard knob or handle selected from Cortina's hardware boards. This drilling comes standard with the order, and is done ONLY in our shop, not on the job site.

For those not wanting Cortina's hardware drilling, the following applies:

No holes to be drilled on the doors and drawer fronts should be specified in writing on the colour chart and the P.O. If while in production, Cortina Kitchens misses this request, Cortina Kitchens and the Builder will not be held responsible to replace any or all doors and drawer fronts affected, and the customer agrees to accept the product as is. No hardware will be supplied or credited by Cortina Kitchens with this request. No charge will apply for this request.

PVC DOORS

All cabinets with PVC (Thermofoil) Doors come with melamine gables, panels and kick. The doors, crown moulding and light valance are PVC wrapped. Open shelves incorporated in design will only be available with melamine interiors. There will be variations in colour shades between the PVC parts (doors, crown and Light valance) and the melamine parts (open shelves, Gables, Panels and Kick) due to the difference in material.

Furring Panel with crown moulding to the ceiling is not available on all PVC door styles due to subtle variations in colour shades between the PVC parts (moulding) and the melamine parts (furring panel) due to the difference in material. Grain directions in wood grain pattern melamine, vary between the furring panel, crown moulding (horizontal) and the PVC doors (vertical).

GRANITE, MARBLE ENGINEERED SURFACES WAIVER

Granite and marble are naturally occurring products, and due to the many variables that can affect the pattern, colour and/or design and "pitting" of natural products slabs installed will not be identical to the samples displayed. We will make every attempt to come as close to the samples as possible, but cannot be responsible for results which differ from the samples. Every effort is made to provide granite counter tops as close as possible but the vendor is not responsible for results which differ from the sample displayed. All countertop surfaces may have seams & product pattern & shade can change in areas containing seams.

RESELECTIONS

It is not uncommon for flooring, such as tile, to become discontinued prior to its installation. Therefore it may be necessary to make a reselection of certain materials sometime during the build process. We cannot assure you that another choice approximating your selection will be available.

PLANS

Plans are subject to change without notice. Actual usable floor space may vary from the stated floor area. Layout for kitchen, furnace, HWT and laundry tub may vary from plan. Vertical and horizontal bulkhead, which are not shown on plan, may be required for plumbing and heating runs. E.&O.E.

PLEASE NOTE:

In the event the work on the house has progressed beyond the point where the items covered by these invoices cannot be installed without entailing any unusual expense, then this order is to be cancelled and any deposit paid in connection with the same is to be refunded to the purchaser.

The vendor will undertake to incorporate the work covered by the sales extra in the construction of the house but will not be liable to the purchaser in any way, if for any reason the work covered by the extra is not carried out. In that event, any monies paid in connection with the same shall be returned to the purchaser.

It is understood and agreed that if for any reason whatsoever the transaction of Purchase and Sale is not completed, the total cost of extras ordered are not refundable to the Purchaser(s).

Extras or changes will not be processed unless signed by the Vendor.

These extras may not be amended without the written consent of Gold Park Homes.

The purchaser(s) and the builder acknowledge and agree that this "Purchaser's Extra" form shall not be deemed to be part of the agreement of purchase and sale entered into between them, nor an addendum thereto.

No postdated cheques will be accepted.

No estimates or orders will be accepted once construction has commenced.

Should a refund be requested on any extras purchased, an 80% reimbursement of the purchase price will be given. (a \$50.00 minimum charge and a maximum \$250.00 charge will apply)

Estimates will only be considered when resubmitted on a signed Purchaser Extras form, accompanied by payment in full.

All prices are estimates only and may be subject to change. Should a change in price occur Gold Park Homes reserves the right to request from the purchaser an adjustment of the price or a refund limited to that item.

Purchasers are aware & accept that ANY changes made to upgrades after signing the Purchasers Extra Form are subject to a minimum administration fee of \$500. PLUS a 10% holdback fee.

Purchasers are aware that any request to add a percentage of upgrades from the purchaser's extras form will be processed only after the builder receives approval letter from the bank.


B&B-121
August 31, 2020

Please be advised that your failure to finalize your structural or colour selections may result in a delay in construction of your dwelling and we may have to extend closing of your transaction. Due to failure to complete the above-mentioned selections and at no fault of us, we reserve our right to hold you responsible for a delayed closing, including charging extra administration cost and interest on the balance due on closing.

Purchaser has attended a Colour appointment at the Decor Centre & has DECLINED any additional upgrades and accepts and acknowledges that there will be no further structural changes/additions/deletions to be made upon signing.

I hereby acknowledge reading and understanding the above copy and will not hold Gold Park Homes responsible for any issues in relation to above.

Purchasers Signatures




Date August 31 2020

BE2-121