



LOT NUMBER: 15
UNIT NAME: LILAC
ELEVATION: A CORNER REAR
UNIT NUMBER: 4006

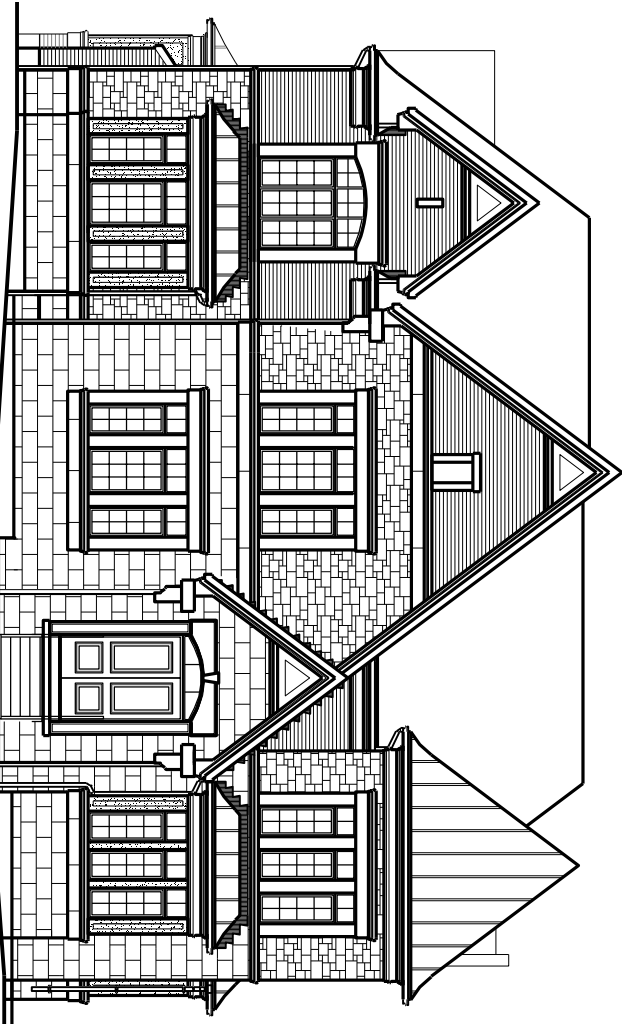


LOT NUMBER: 15
UNIT NAME: LILAC
ELEVATION: A CORNER FLANKAGE
UNIT NUMBER: 4006

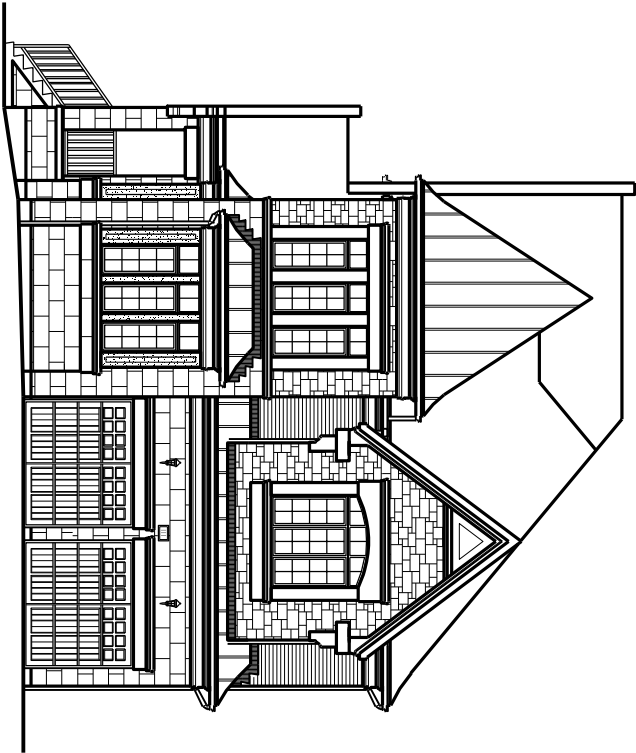

LOT NUMBER: 15
UNIT NAME: LILAC
ELEVATION: A CORNER FRONT
UNIT NUMBER: 4006

PURPLE CREEK ROAD

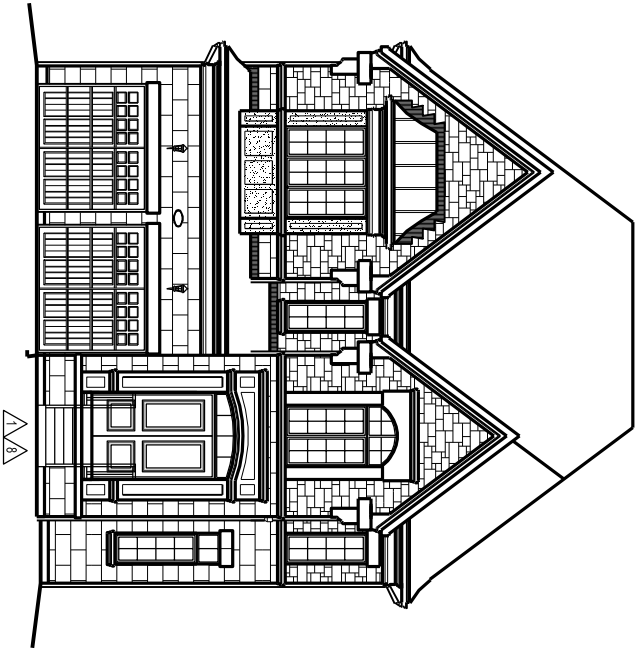

LOT NUMBER: 14
UNIT NAME: FORESTCREST
ELEVATION: A(REV)
UNIT NUMBER: 4203

LEGEND:

- 1

BRICK/ STONE VENER ON SIDES OF STAIRS
(POURED OR BRICK LEDGE PRECAST)
- 2

DROP OR RAISE RAINING
BY AMOUNT INDICATED.
- 3

ADD BANDING AND/OR TRIM
AS INDICATED.
- 4

ADDED CAMBERED HEADERS
- 5

8'-0" X 8'-0" GARAGE DOORS.
- 6

DROPPED OR RAISED SLOFT AS INDICATED.
- 7

ADJUSTED ROOF OVERHANG
AS INDICATED ON ROOF PLAN.
- 8

PROVIDE GUARD PER
CONSTRUCTION NOTE 11.
- 9

FOYER SUNKEN AS INDICATED
- 10

LIGHT FIXTURE RELOCATED
AS INDICATED.

It is the builder's complete responsibility to ensure that all plans submitted for approval fully comply with the Architectural Guidelines and all applicable regulations and requirements including zoning provisions and any provisions in the submitted design. The City of Vaughan Architect is not responsible in any way for examining or approving site (lotting) plans or working drawings with respect to any zoning or building code or permit matter or that any house can be properly built or located on its lot. This is to certify that these plans comply with the applicable Architectural Design Guidelines approved by the City of VAUGHAN.