
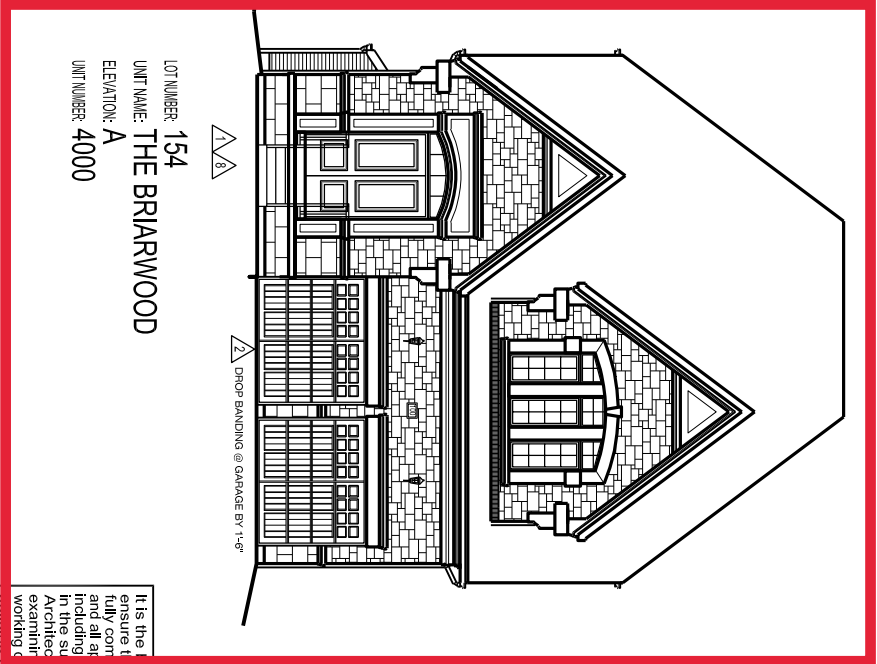
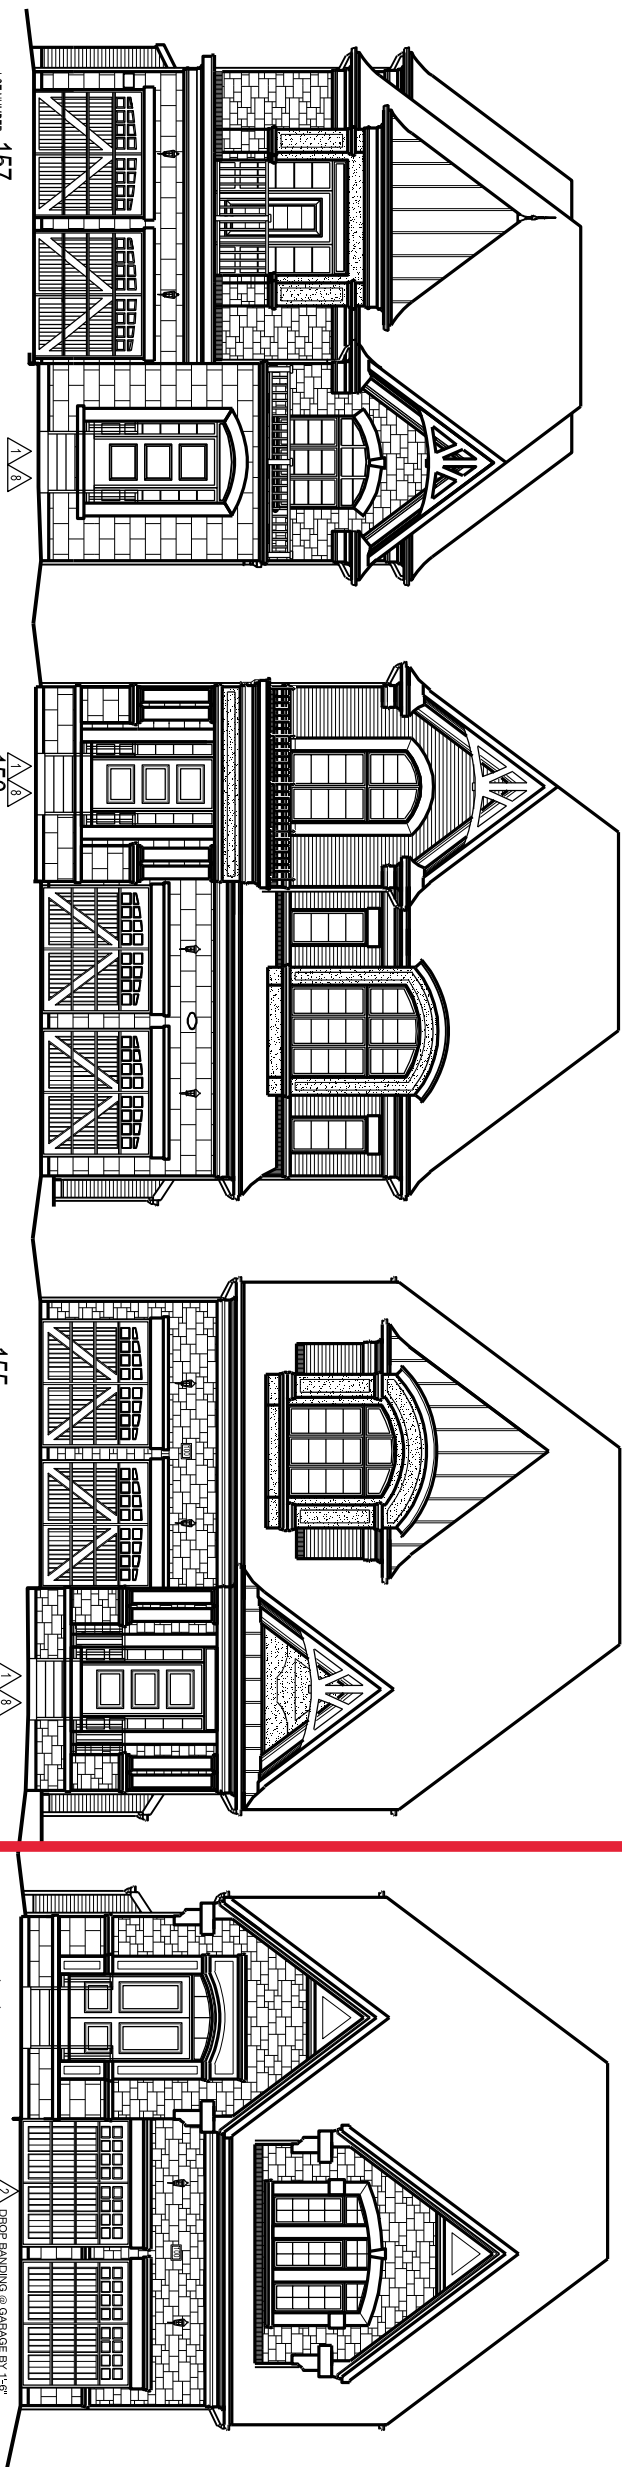


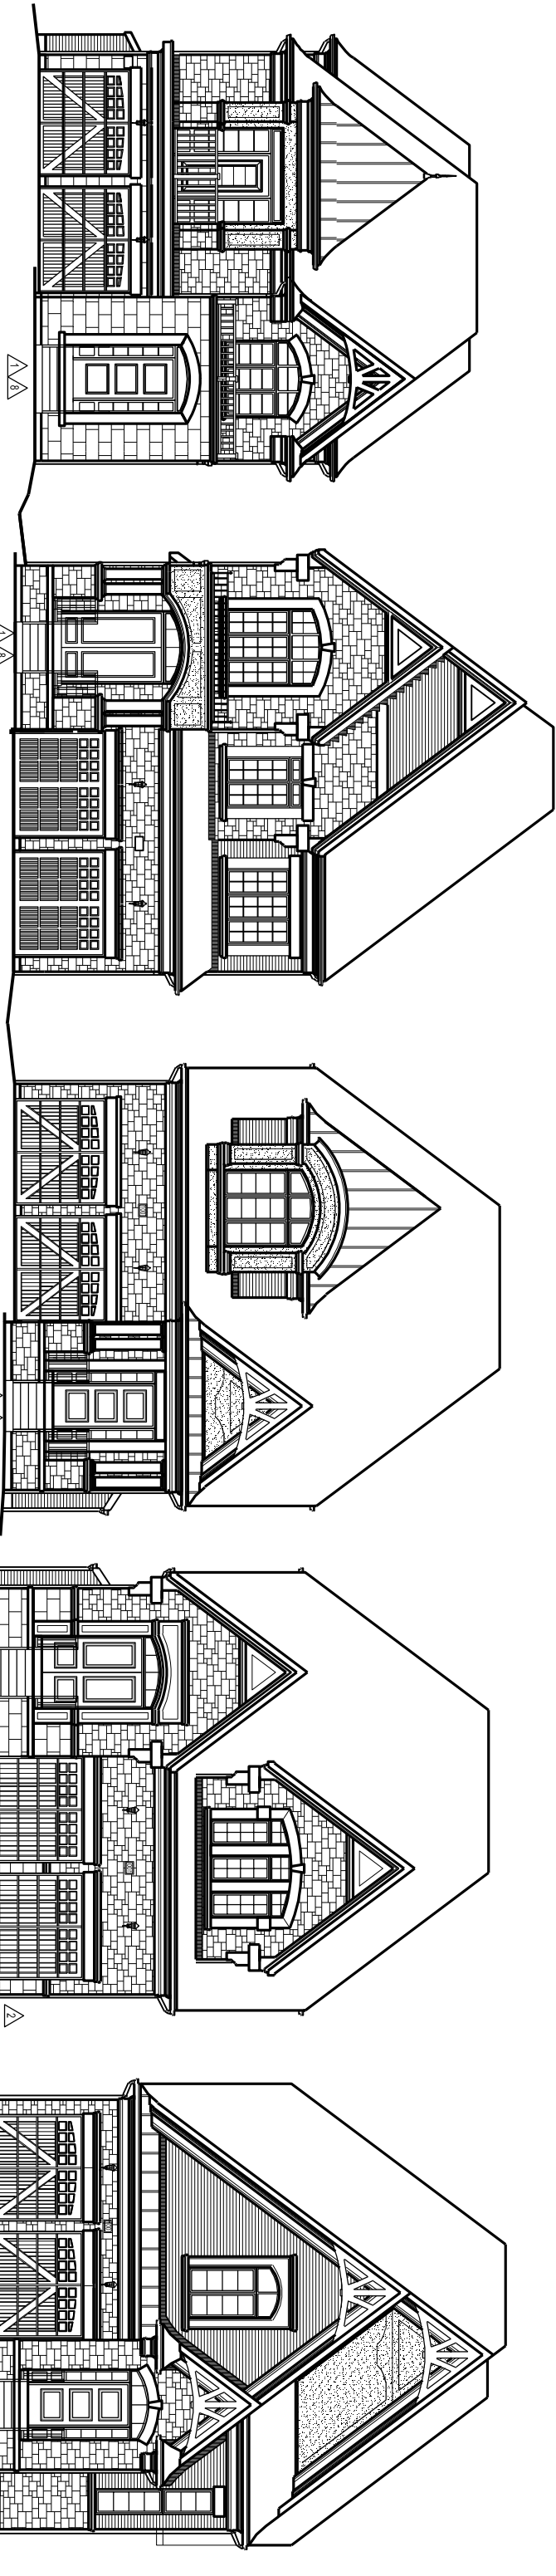

It is the architect's complete responsibility to ensure that all plans submitted for approval fully comply with the Architectural Guidelines and all applicable regulations and requirements including zoning provisions and any provisions in the applicable zoning bylaws. The architect is not responsible in any way for examining or approving site (lotting) plans or working drawings with respect to any zoning or building code or permit matter or that any house can be properly built or located on its lot. This is to certify that these plans comply with the applicable Architectural Design Guidelines approved by the City of VAUGHAN.

LEGEND:

1. BRICK/STONE VENER ON SIDES OF STAIRS
POURED OR BRICK LEUGE PRECAST
2. DROP OR RAISE RAINING
BY AMOUNT INDICATED.
3. ADD BANDING AND/OR TRIM
AS INDICATED.
4. ADDED CAMBERED HEADERS
5. 8'-0" X 8'-0" GARAGE DOORS.
6. PROPOSED OR RAISED SOFTT AS INDICATED.
7. ADJUSTED ROOF OVERHANG
AS INDICATED ON ROOF PLAN.
8. PROVIDE GUARD PER
CONSTRUCTION NOTE 11.
9. FOYER SUNKEN AS INDICATED
10. LIGHT FIXTURE RELOCATED
AS INDICATED.