




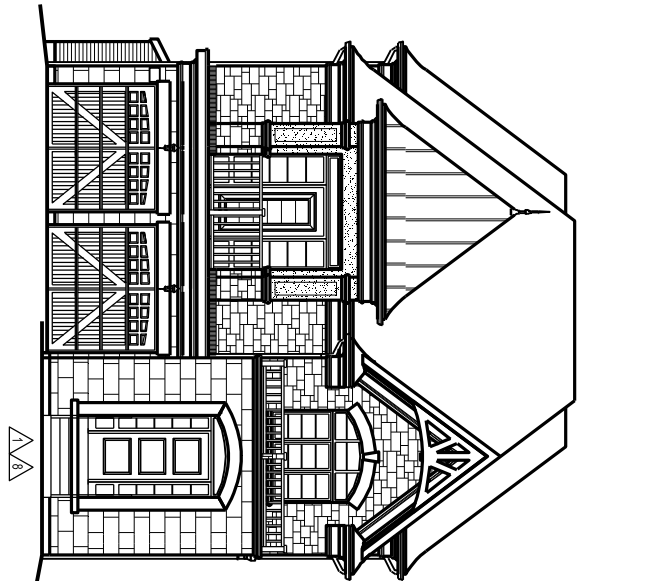


LOT NUMBER: 153  
UNIT NAME: BROOKSIDE  
ELEVATION: B (REV)  
UNIT NUMBER: 4003

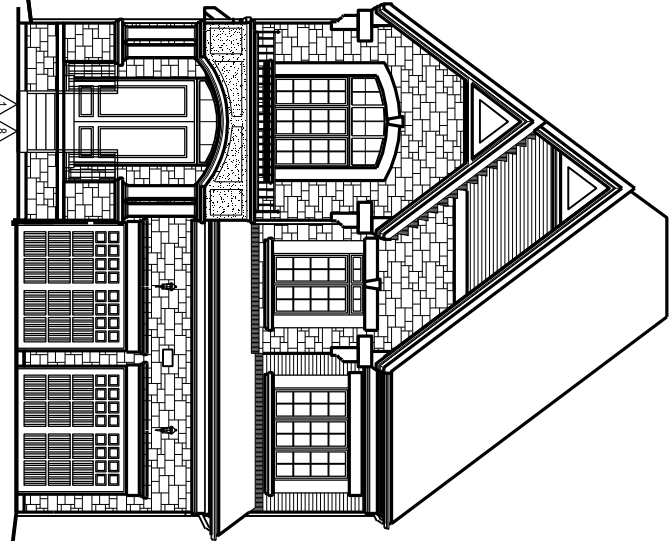


LOT NUMBER: 152  
UNIT NAME: VALLEYVIEW  
ELEVATION: A  
UNIT NUMBER: 4002

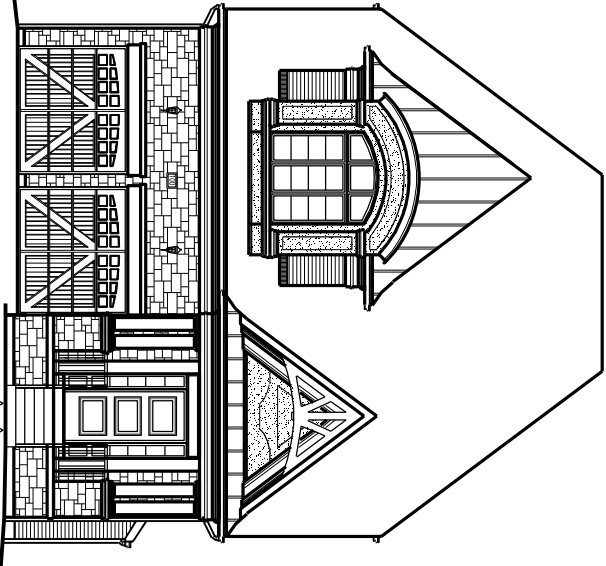


LOT NUMBER: 151  
UNIT NAME: THE BRIARWOOD  
ELEVATION: B (REV)  
UNIT NUMBER: 4000

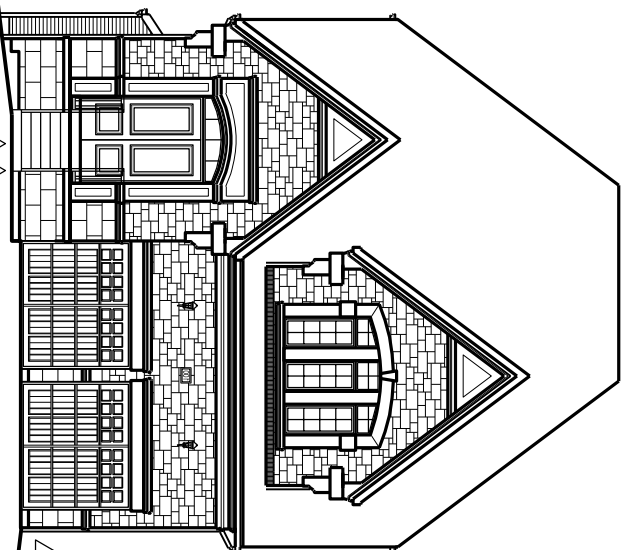


LOT NUMBER: 150  
UNIT NAME: THE BRIARWOOD  
ELEVATION: A  
UNIT NUMBER: 4000

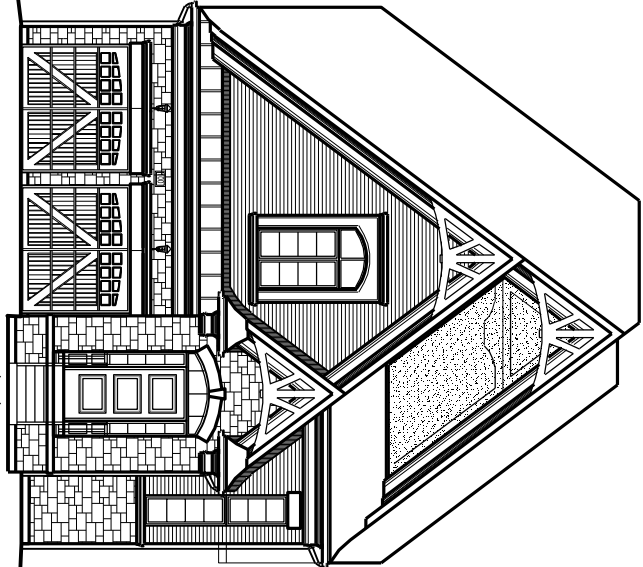


LOT NUMBER: 149  
UNIT NAME: MAPLEWOOD  
ELEVATION: B (REV)  
UNIT NUMBER: 4201

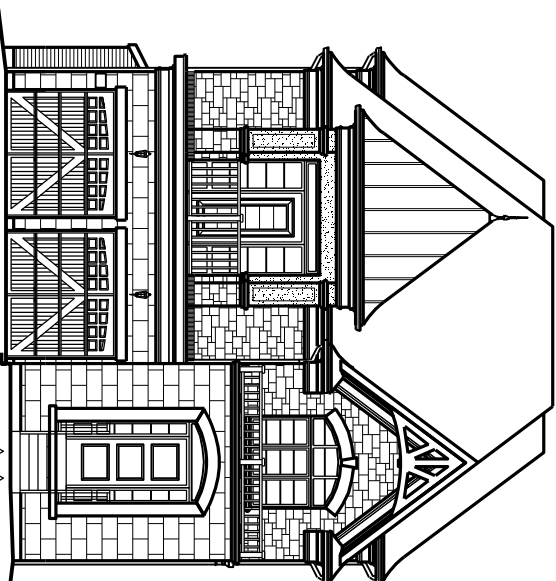


LOT NUMBER: 157  
UNIT NAME: BROOKSIDE  
ELEVATION: B (REV)  
UNIT NUMBER: 4003

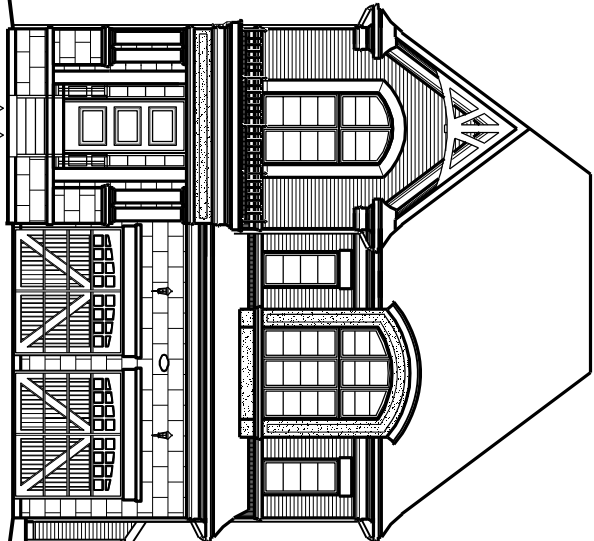

LOT NUMBER: 156  
UNIT NAME: SUMMERDALE  
ELEVATION: B  
UNIT NUMBER: 4001

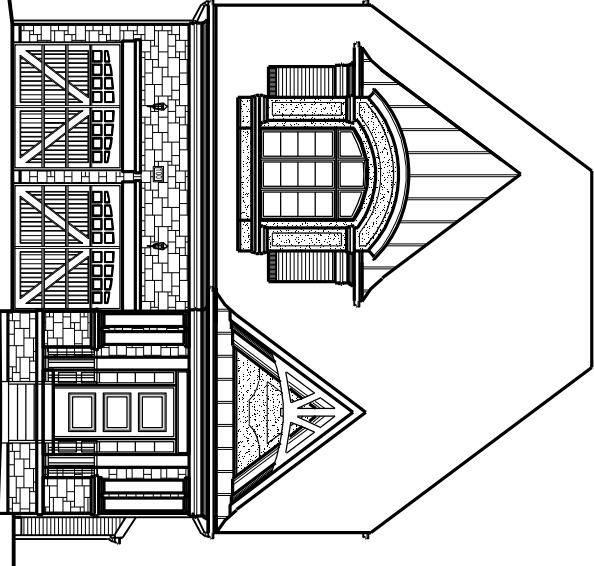


LOT NUMBER: 155  
UNIT NAME: THE BRIARWOOD  
ELEVATION: B (REV)  
UNIT NUMBER: 4000

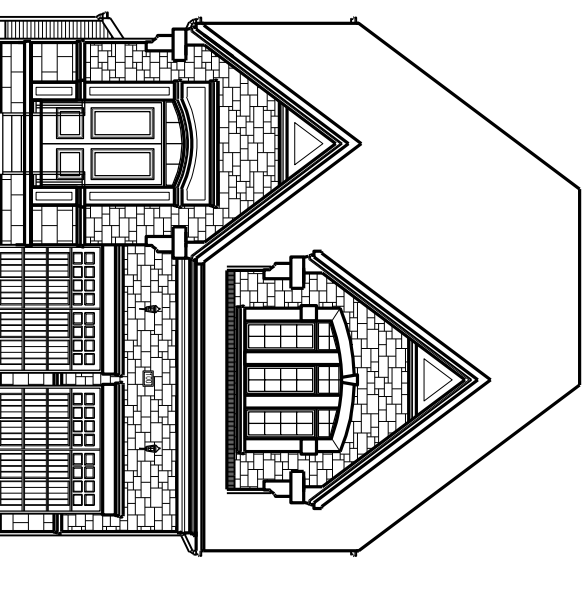

LOT NUMBER: 154  
UNIT NAME: THE BRIARWOOD  
ELEVATION: A  
UNIT NUMBER: 4000

▲ 1-6" DROP BANDING @ GARAGE BY 1-6"

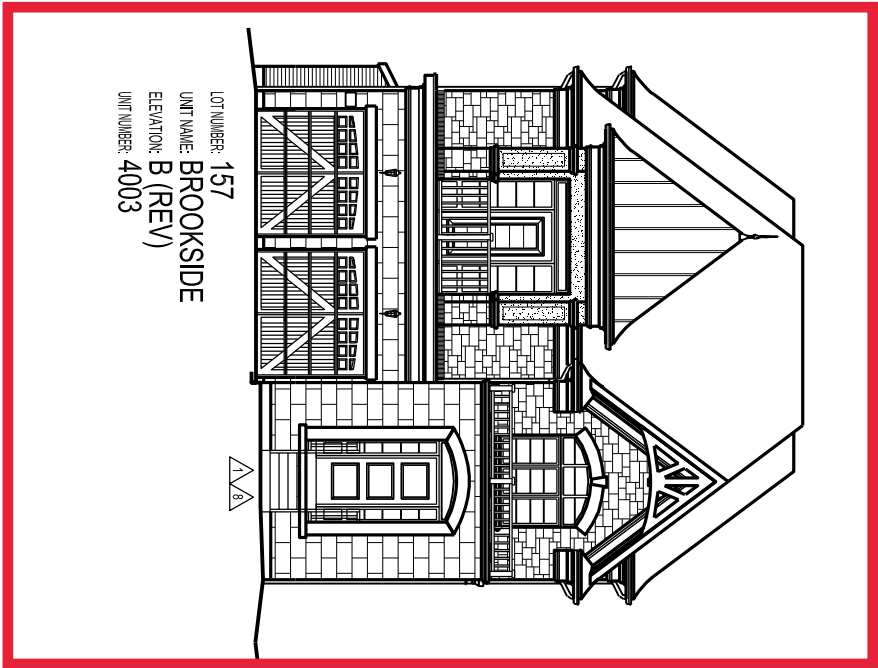

LEGEND:

▲ 1 BRICK/STONE VENER ON SIDES OF STAIRS  
POURED OR BRICK LEUGE PRECAST

▲ 2 DROP OR RAISE BANDING  
BY AMOUNT INDICATED.

▲ 3 ADD BANDING AND/OR TRIM  
AS INDICATED.

▲ 4 ADDED CAMBERED HEADERS

▲ 5 8'-0" X 8'-0" GARAGE DOORS.

▲ 6 PROVIDE GUARD PER  
CONSTRUCTION NOTE 11.

▲ 9 FOYER SUNKEN AS INDICATED

▲ 10 LIGHT FIXTURE RELOCATED.  
AS INDICATED.



DESIGN ASSOCIATES INC.  
WWW.HUNTDDESIGN.CA

GOLDPARK HOMES - 217020

PINE VALLEY, VAUGHAN ONT.

8966 Woodbine Ave. Markham, ON L3R 0J7 ■ T 905.737.5133 ■ F 905.737.7326 ■ 2020/09/15 ■ OF/NEA ■ 217020WSS01

STREETSCAPES - LOTS 150 - 157

PAGE XX

It is the builder's complete responsibility to ensure that all plans submitted for approval fully comply with the Architectural Guidelines and all applicable regulations and requirements including zoning provisions and any provisions in the applicable municipal by-laws. The Architect is not responsible in any way for examining or approving site (lotting) plans or working drawings with respect to any zoning or building code or permit matter or that any house can be properly built or located on its lot. This is to certify that these plans comply with the applicable Architectural Design Guidelines approved by the City of VAUGHAN.