



LOT NUMBER: 4  
UNIT NAME: FORESTCREST  
ELEVATION: B  
UNIT NUMBER: 4203

LOT NUMBER: 3  
UNIT NAME: THE ROSEDALE  
ELEVATION: B(REV)  
UNIT NUMBER: 4202

LOT NUMBER: 2  
UNIT NAME: FORESTCREST  
ELEVATION: A  
UNIT NUMBER: 4203


PINE HEIGHTS DRIVE



LOT NUMBER: 1  
UNIT NAME: THE BEAUMONT  
ELEVATION: A CORNER FRONT(REV)  
UNIT NUMBER: 5004



LOT NUMBER: 1  
UNIT NAME: THE BEAUMONT  
ELEVATION: A CORNER FLANKAGE-LOGGIA(REV)  
UNIT NUMBER: 5004

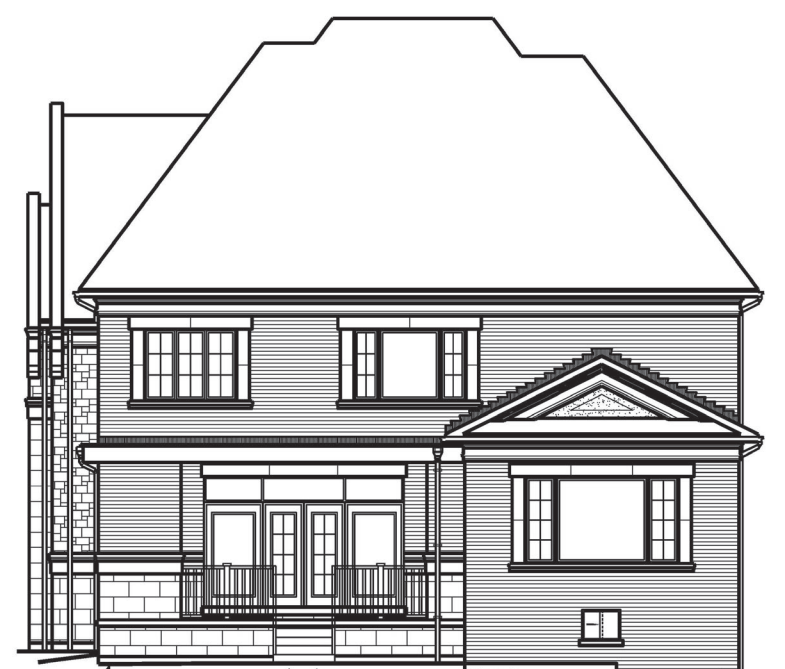

LOT NUMBER: 1  
UNIT NAME: THE BEAUMONT  
ELEVATION: A CORNER REAR-LOGGIA(REV)  
UNIT NUMBER: 5004

LEGEND:

- |   |   |   |                             |  |
|---|---|---|-----------------------------|--|
| 1 BRICK/STONE VENEER ON SIDES OF STAIRS (POURED OR "BRICK LEDGE" PRECAST) | 2 DROP OR RAISE BANDING BY AMOUNT INDICATED.        | 3 ADD BANDING AND/OR TRIM AS INDICATED.   | 4 ADDED CAMBERED HEADERS    | 5 8'-0" X 8'-0" GARAGE DOORS.            |
| 6 DROPPED OR RAISED SOFFIT AS INDICATED.                                  | 7 ADJUSTED ROOF OVERHANG AS INDICATED ON ROOF PLAN. | 8 PROVIDE GUARD PER CONSTRUCTION NOTE 11. | 9 FOYER SUNKEN AS INDICATED | 10 LIGHT FIXTURE RELOCATED AS INDICATED. |

**HUNT**  
DESIGN ASSOCIATES INC.  
www.huntdesign.ca

**GOLDPARK HOMES - 217020**  
PINE VALLEY, VAUGHAN ONT.

8966 Woodbine Ave, Markham, ON L3R 0J7 ■ T 905.737.5133 ■ F 905.737.7326 ■ 2020/10/15 ■ NEA ■ 217020WSS01

STREETSCAPES - LOTS 1-4

It is the builder's complete responsibility to ensure that all plans submitted for approval fully comply with the Architectural Guidelines and all applicable regulations and requirements including zoning provisions and any provisions in the subdivision agreement. The Control Architect is not responsible in any way for examining or approving site (lotting) plans or working drawings with respect to any zoning or building code or permit matter or that any house can be properly built or located on its lot.

This is to certify that these plans comply with the applicable Architectural Design Guidelines approved by the City of VAUGHAN.

LOT 1

JOHN G. WILLIAMS LTD., ARCHITECT  
ARCHITECTURAL CONTROL REVIEW  
AND APPROVAL

APPROVED BY:

DATE: OCT 16, 2020

This stamp certifies compliance with the applicable Design Guidelines only and bears no further professional responsibility.