

GOLDPARK

WORTH MORE™

CONSTRUCTION SUMMARY

Lot: 139

Model: 38-6 Elev.A SCARLATTI OPT- GFA1

Project/Phase: Brampton Encore / 2

CONCRETE AND DRAIN

Invoice	Qty.	Description
2477 28,894 17Nov20 **	1	ROUGH-IN - 3PC BASEMENT ROUGH-IN  INCLUDED IN APS
2477  17Nov20 NoCat	1	ROUGH-IN - 3PC BASEMENT ROUGH-IN  Included in APS

DRYWALL

Invoice	Qty.	Description
2477  17Nov20 NoCat	4	MAIN FLOOR; STANDARD DOOR EXTENDED HEIGHT 96" (PRICE PER DOOR) MAIN FLOOR 3 STOREY MODELS - 96"
2477  17Nov20 NoCat	3	MAIN FLOOR: EXTENDED HEIGHT ARCHWAY (PRICE PER DOORWAY) - 96"

ELECTRICAL

Invoice	Qty.	Description
2477 28,809 17Nov20	1	KITCHEN:110V WALL RECEPTACLE ON NORMAL CIRCUIT- LOCATE APPROX CENTER ABOVE PENINSULA - SEE PLAN FOR LOCATION
2477  17Nov20 NoCat	1	KITCHEN: SINGLE POLE SWITCH  FOR PENINSULA LIGHT
2477 28,811 17Nov20	1	200 AMP ELECTRICAL SERVICE
2477 28,810 17Nov20	1	KITCHEN; 220V WALL RECEPTICAL ON DEDICATED CIRCUIT- FOR 4 WIRE BUILT-IN WALL OVEN - SEE PLAN FOR LOCATION
2477 28,808 17Nov20	1	KITCHEN: 110V WALL RECEPTACLE ON DEDICATED CIRCUIT - GAS FIRED APPLIANCE - FOR AUX. EQUIPMENT - NOT A STOVE PLUG

DisciplineMS.rpt 26jun20

Page 1 of 6  
Printed and Sent: 17-Nov-20












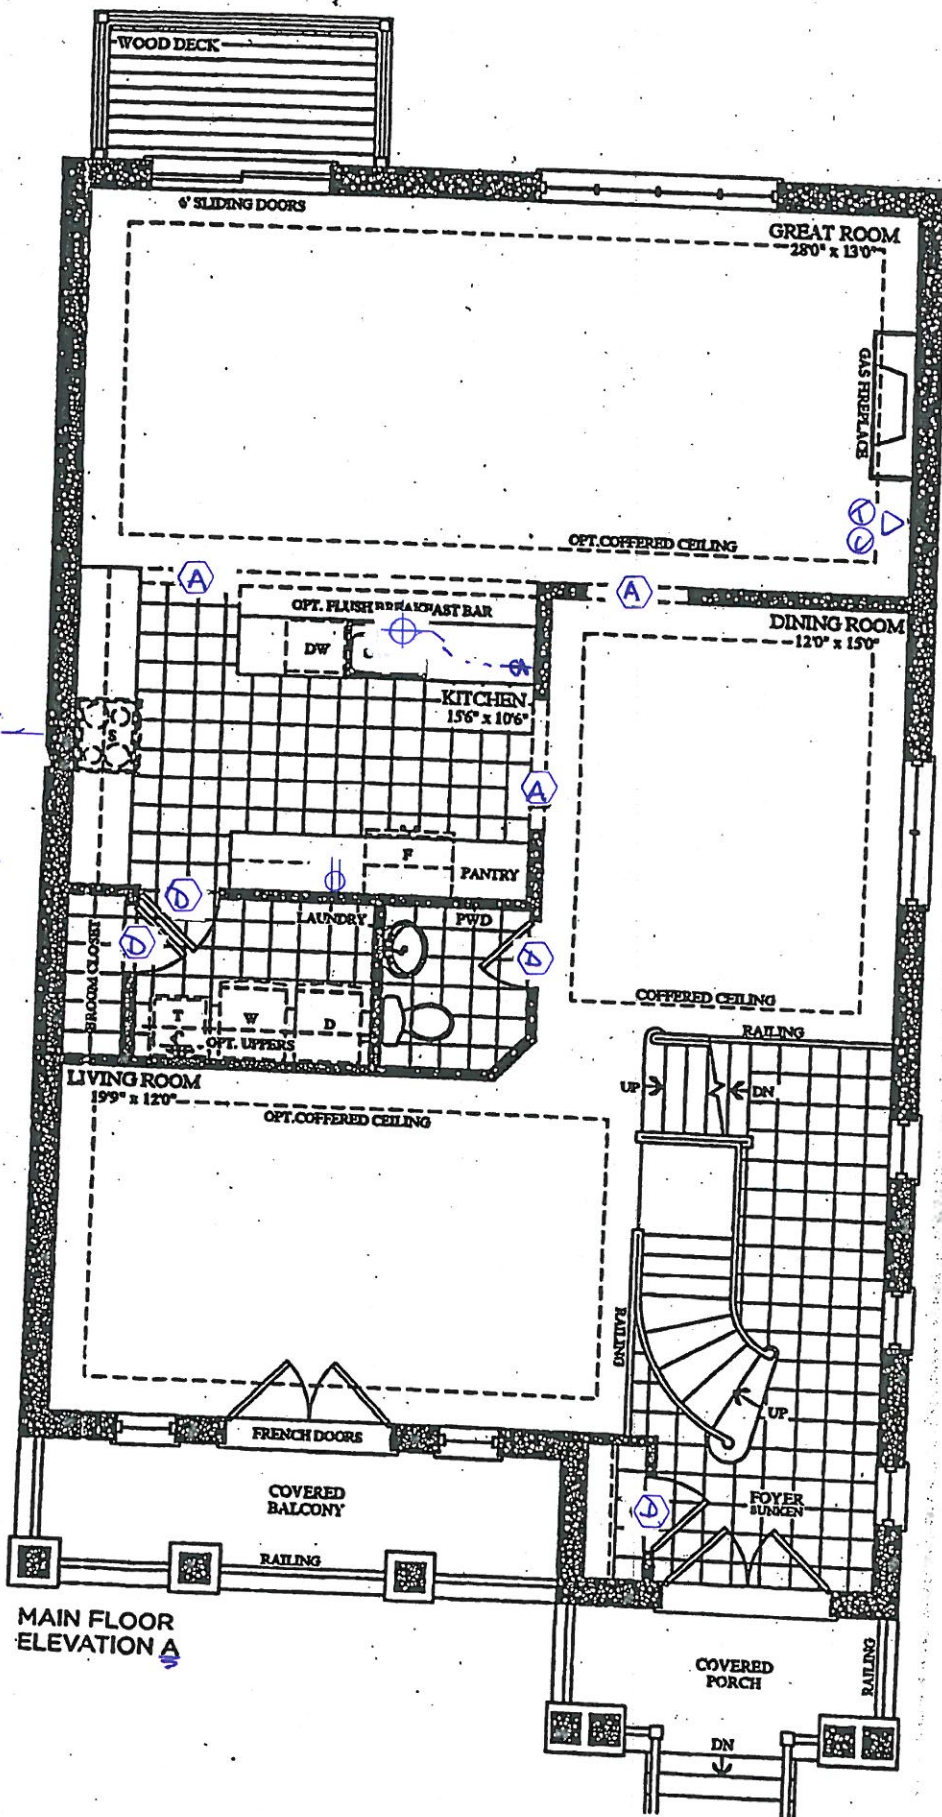

MAIN FLOOR  
ELEVATION A


BEZ-139  
OCT 13 2020

# The Scarlatti

Elevation A • 3,591 sq.ft. Elevation B • 3,578 sq.ft.

Prices, figures, illustrations, sizes, features and finishes are subject to change without notice. E.A.O.E. Areas and dimensions are approximate and actual usable floor space may vary from the stated area. Layout may be reverse of the unit purchased. E. & O.E.



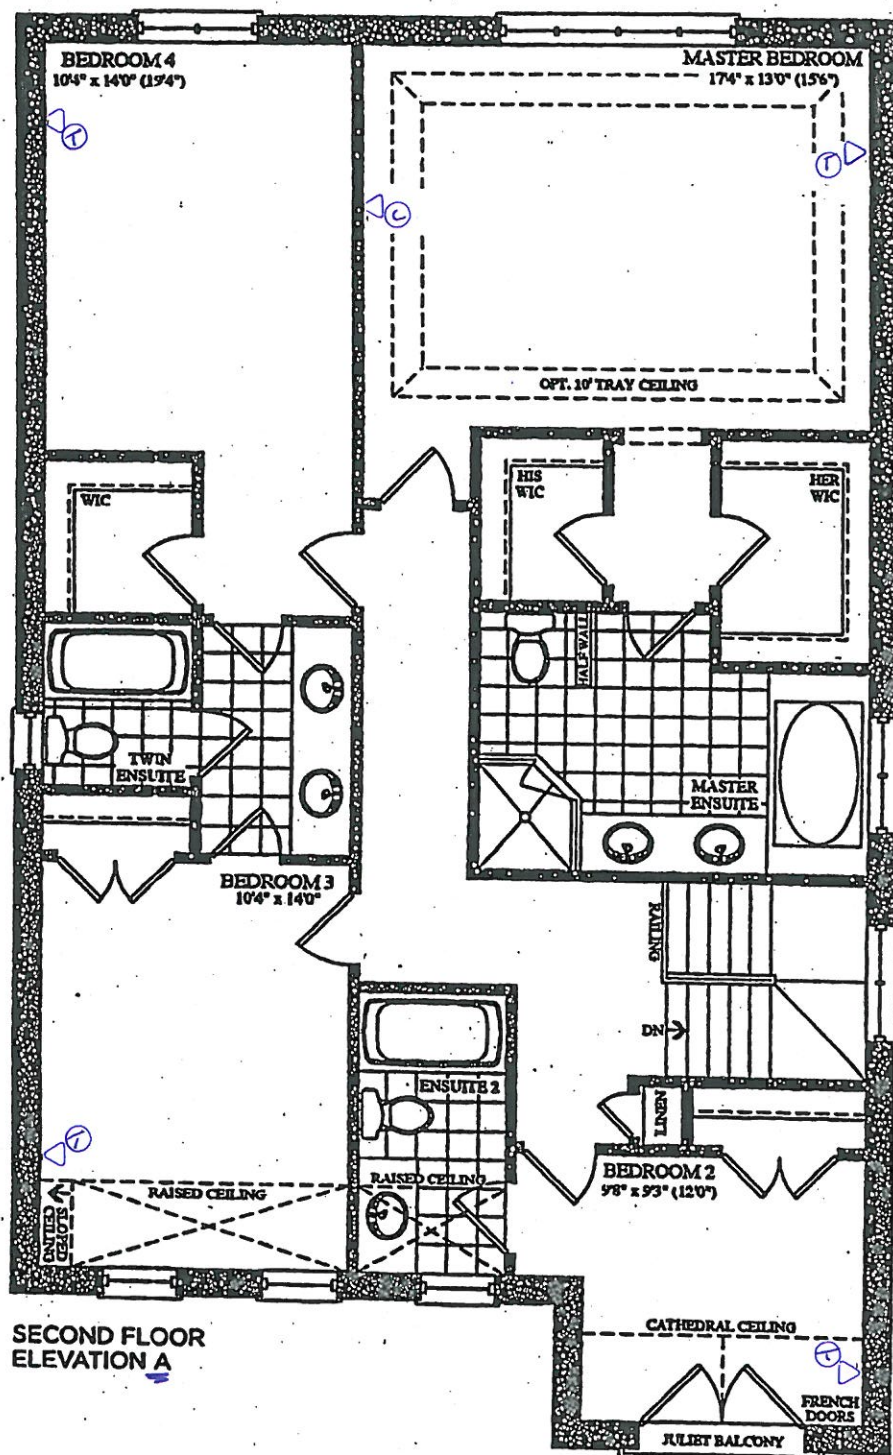


BEZ-139  
OCT 13 2020

# The Scarlati


Elevation A • 3,591 sq.ft. Elevation B • 3,578 sq.ft.

Prices, figures, illustrations, sizes, features and finishes are subject to change without notice. E.&O.E. Areas and dimensions are approximate and actual usable floor space may vary from the stated area. Layout may be reverse of the unit purchased. E. & O.E.




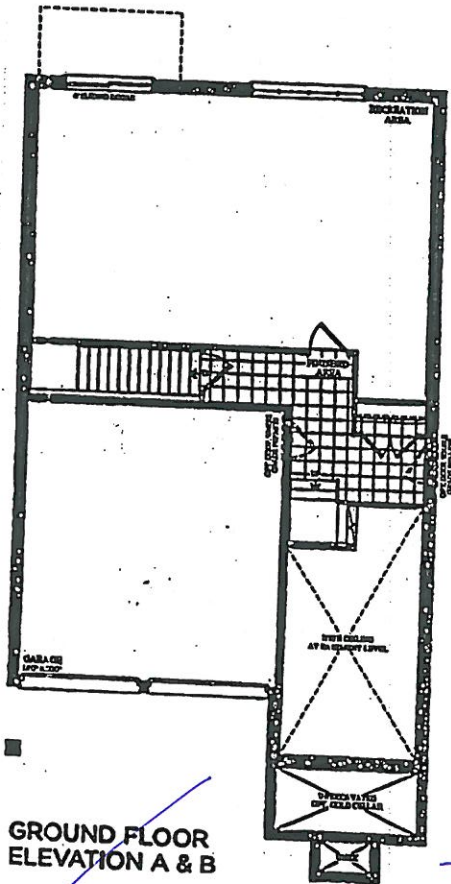


GROUND FLOOR  
ELEVATION A & B

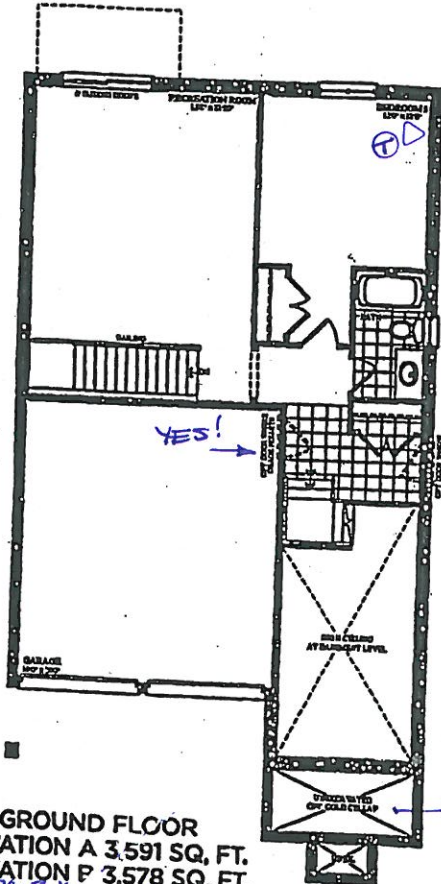

OPT. GROUND FLOOR  
ELEVATION A 3,591 SQ. FT.  
ELEVATION B 3,578 SQ. FT.

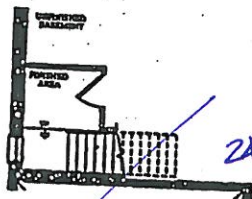

OPT. BASEMENT  
ELEVATION A & B

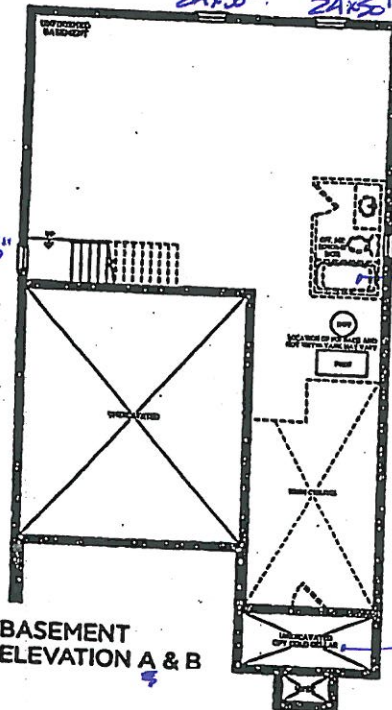

BASEMENT  
ELEVATION A & B

# The Scarlatti

→ Elevation A • 3,591 sq.ft. Elevation B • 3,578 sq.ft.

Prices, figures, illustrations, sizes, features and finishes are subject to change without notice. E.O.E. Areas and dimensions are approximate and actual usable floor space may vary from the stated area. Layout may be reverse of the unit purchased. E. & O.E.

BE2-139  
OCT 13 2020