

GOLDPARK

WORTH MORE™

CONSTRUCTION SUMMARY

Lot: 139

Model: 38-6 Elev.A SCARLATTI OPT- GFA1

Project/Phase: Brampton Encore / 2

CONCRETE AND DRAIN

Invoice	Qty.	Description
2477 28,894 27Nov20 **	1	ROUGH-IN - 3PC BASEMENT ROUGH-IN INCLUDED IN APS
2477 27Nov20 NoCat	1	ROUGH-IN - 3PC BASEMENT ROUGH-IN Included in APS

DRYWALL

Invoice	Qty.	Description
2477 27Nov20 NoCat	4	MAIN FLOOR; STANDARD DOOR EXTENDED HEIGHT 96" (PRICE PER DOOR) MAIN FLOOR 3 STOREY MODELS - 96"
2477 27Nov20 NoCat	3	MAIN FLOOR: EXTENDED HEIGHT ARCHWAY (PRICE PER DOORWAY) - 96"

ELECTRICAL


Invoice	Qty.	Description
2477 28,809 27Nov20	1	KITCHEN:110V WALL RECEPTACLE ON NORMAL CIRCUIT- LOCATE APPROX CENTER ABOVE PENINSULA - SEE PLAN FOR LOCATION
2477 27Nov20 NoCat	1	KITCHEN: SINGLE POLE SWITCH FOR PENINSULA LIGHT
2477 28,811 27Nov20	1	200 AMP ELECTRICAL SERVICE
2477 28,810 27Nov20	1	KITCHEN; 220V WALL RECEPTICAL ON DEDICATED CIRCUIT- FOR 4 WIRE BUILT-IN WALL OVEN - SEE PLAN FOR LOCATION
2477 28,808 27Nov20	1	KITCHEN: 110V WALL RECEPTACLE ON DEDICATED CIRCUIT - GAS FIRED APPLIANCE - FOR AUX. EQUIPMENT - NOT A STOVE PLUG

EXTERIOR COLOURS

Invoice	Qty.	Description
2477 27Nov20 NoCat	1	EXTERIOR COLOUR PACKAGE # 3

DisciplineMS.rpt 26jun20

Page 1 of 6
Printed and Sent: 27-Nov-20

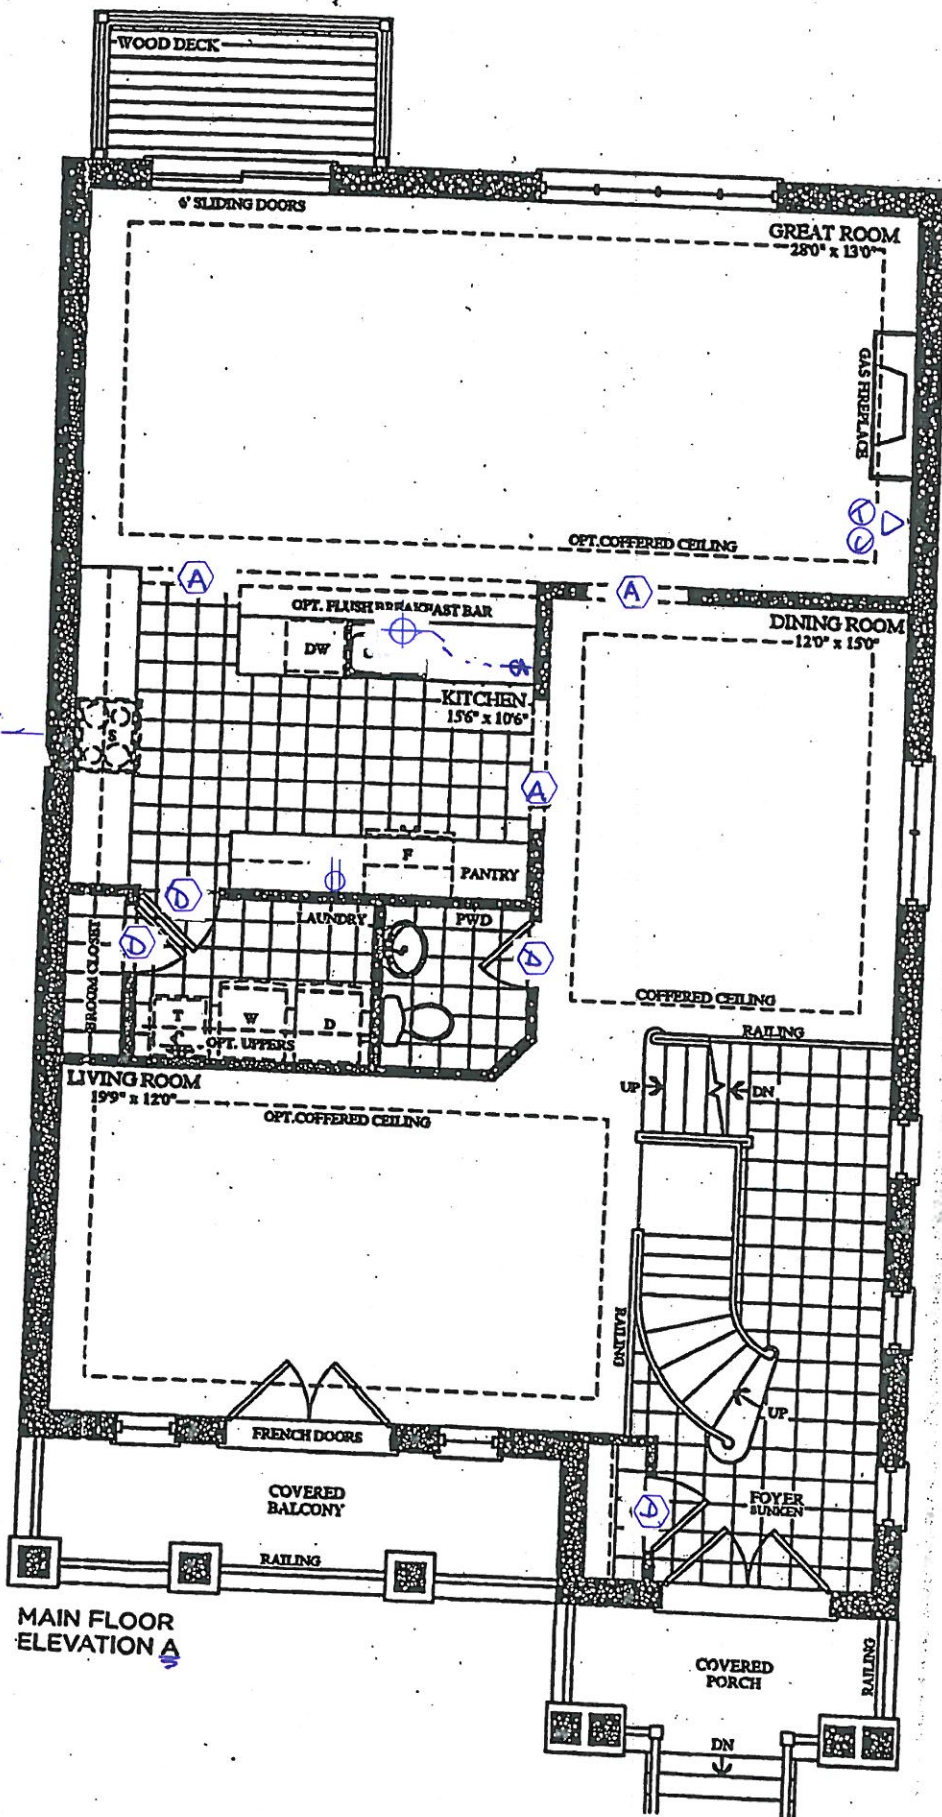


BEZ-139
OCT 13 2020

The Scarlatti

Elevation A • 3,591 sq.ft. Elevation B • 3,578 sq.ft.

Prices, figures, illustrations, sizes, features and finishes are subject to change without notice. E.A.O.E. Areas and dimensions are approximate and actual usable floor space may vary from the stated area. Layout may be reverse of the unit purchased. E. & O.E.

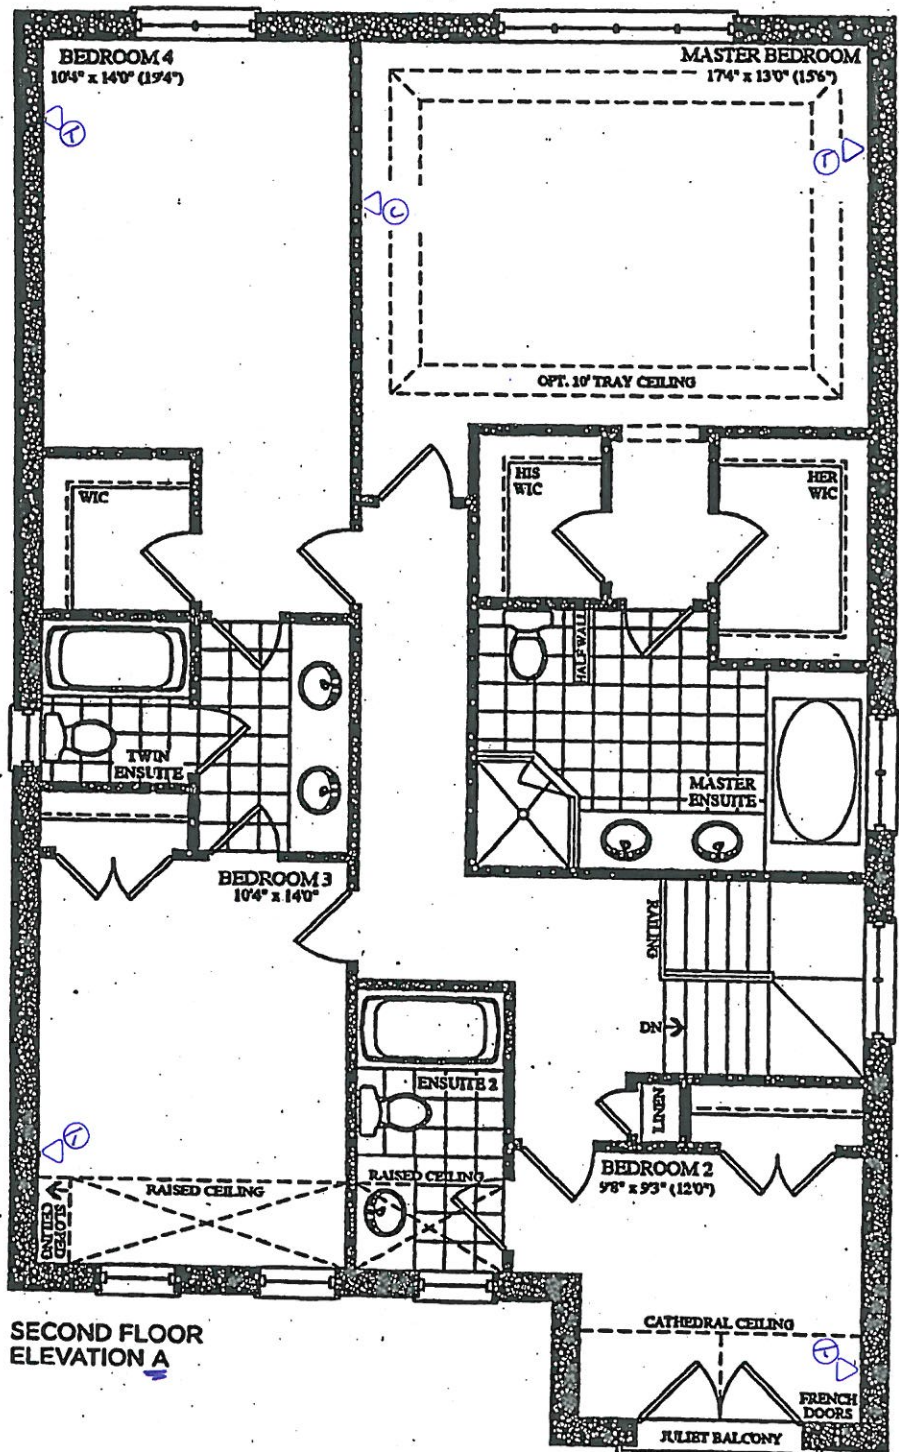


SECOND FLOOR
ELEVATION A

BE2-139
Oct 13 2020


The Scarlatti

Elevation A • 3,591 sq.ft. Elevation B • 3,578 sq.ft.


Prices, figures, illustrations, sizes, features and finishes are subject to change without notice. E.A.G.E. Areas and dimensions are approximate and actual usable floor space may vary from the stated area. Layout may be reverse of the unit purchased. E. & G.E.

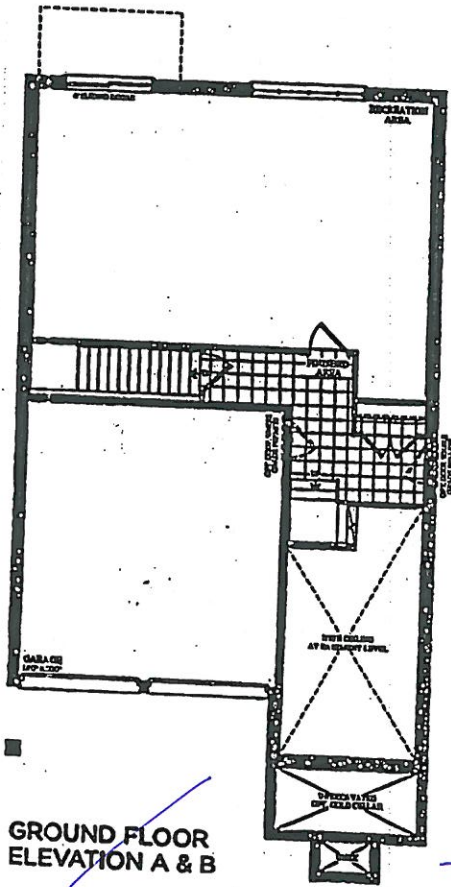


GROUND FLOOR
ELEVATION A & B

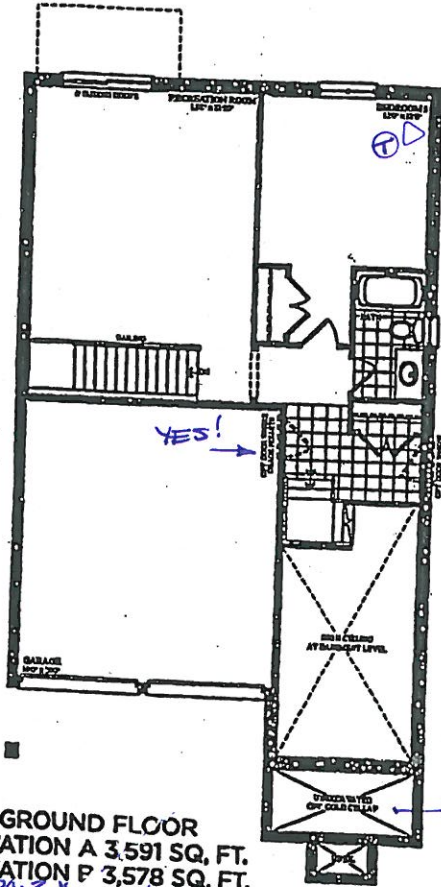

OPT. GROUND FLOOR
ELEVATION A 3,591 SQ. FT.
ELEVATION B 3,578 SQ. FT.

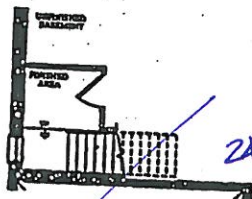

OPT. BASEMENT
ELEVATION A & B

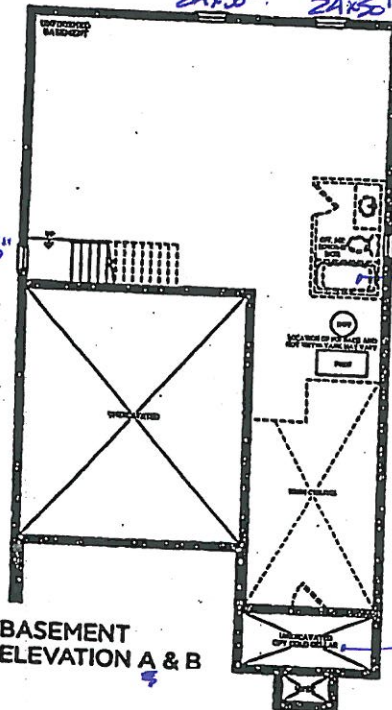

BASEMENT
ELEVATION A & B

The Scarlatti

Elevation A • 3,591 sq.ft. Elevation B • 3,578 sq.ft.

Prices, figures, illustrations, sizes, features and finishes are subject to change without notice. E.O.E. Areas and dimensions are approximate and actual usable floor space may vary from the stated area. Layout may be reverse of the unit purchased. E. & O.E.

BE2-139
OCT 13 2020