

Lot: 125

Model: 50.03 A OAKGROVE

Project/Phase: Pine Valley Forevergreen / 1

CER	AT	ATT.	\sim
CLK	A		

CERAM		Description
Invoice	Qty.	Description
2308	1	.SHOWER NICHE [SHAMPOO SHELF] - COMPLETE WITH MATCHING MARBLE JAMBS ON 4 SIDES, STANDARD TILE, APPROX. 12 X 18 INSTALLED VERTICALLY - SEE PLAN
29Oct20 NoCat		
2501	1	**CUSTOM LAYOUT** REVISE MUDROOM TO ALLOW SPACE FOR STANDING SHOWER IN POWDER ROOM. INCLUDES SHOWER POTLIGHT, FRAMELESS GLASS ENCLOSURE & STANDARD FINISHES
30Oct20 NoCat		
2506 35 10Nov20	1	FOYER: TILE, FLOOR , LEVEL 4- FRONT FOYER - 12X24" LAID IN STRAIGHT, STACKED PATTERN. SEE PLAN FOR TILE DIRECTION
2506 35 10Nov20	1	MUD ROOM: TILE, FLOOR , LEVEL 4- MUD ROOM - 12X24" LAID IN STRAIGHT, STACKED PATTERN. SEE PLAN FOR TILE DIRECTION
2506 35 10Nov20	1	BASEMENT FOYER: TILE, FLOOR, LEVEL 4- FINISHED BASEMENT FOYER - 12X24" LAID IN STRAIGHT, STACKED PATTERN. SEE PLAN FOR TILE DIRECTION
2506 35 10Nov20	1	POWDER ROOM: TILE, FLOOR , LEVEL 4- POWDER ROOM - 12X24" LAID IN STRAIGHT, STACKED PATTERN. SEE PLAN FOR TILE DIRECTION
2506 49 10Nov20	1	POWDER ROOM: TILE, WALL, LEVEL 4 - 12X24" LAID IN HORIZONTAL STACKED PATTERN.
2506 43 10Nov20	1	POWDER ROOM: TILE, SHOWER FLOOR, LEVEL 4- 2" square
2506 37 10Nov20	1	KITCHEN: TILE, FLOOR, LEVEL 5 - KITCHEN - 24X24" LAID IN STRAIGHT, STACKED PATTERN.
2506 35 10Nov20	1	LAUNDRY: TILE, FLOOR , LEVEL 3 - LAUNDRY - 12X24" LAID IN STRAIGHT, STACKED PATTERN. SEE PLAN FOR TILE DIRECTION
2506 37 10Nov20	1	MASTER ENSUITE: TILE, FLOOR , LEVEL 5 - MASTER ENSUITE - HEX
2506 51 10Nov20	1	MASTER ENSUITE: TILE, WALL, LEVEL 5 - MASTER ENSUITE - 3X12"
2506 10Nov20 NoCat	1	MASTER ENSUITE: INSTALL WALL TILE IN HERRINGBONE PATTERN

DisciplineMS.rpt 26jun20

Page 1 of 13



Lot: 125

Model: 50.03 A OAKGROVE

Project/Phase: Pine Valley Forevergreen / 1

CERAMIC

Invoice	Qty.	Description
2506	1	MASTER ENSUITE: ADD TILE TO SHOWER CEILING - LEVEL 5 + HERRINGBONE PATTERN
10Nov20 NoCat		3X12"
2506 43 10Nov20	1	MASTER ENSUITE: TILE, SHOWER FLOOR, LEVEL 2 - MASTER BEDROOM - 2" HEX
2506 37 10Nov20	1	ENSUITE 2: TILE, FLOOR , LEVEL 5 - ENSUITE # 2 - 12X24" LAID IN STRAIGHT, STACKED PATTERN. SEE PLAN FOR TILE DIRECTION
2506 51 10Nov20	1	ENSUITE 2: TILE, WALL, LEVEL 5 - ENSUITE # 2 - 12X24" LAID IN HORIZONTAL STACKED PATTERN
2506 35 10Nov20	1	SHARED BATH: TILE, FLOOR , LEVEL 3 - SHARED BATH - 12X24" LAID IN STRAIGHT, STACKED PATTERN. SEE PLAN FOR TILE DIRECTION
2506 48 10Nov20	1	SHARED BATH: TILE, WALL, LEVEL 3- SHARED BATH - 12X24" LAID HORIZONTAL STACKED
2506 10Nov20 NoCat	1	SHARED ENSUITE: ADD TILE TO SHOWER CEILING - SAME AS WALL TILE- LEVEL 3
2506 43 10Nov20	1	SHARED BATH: TILE, SHOWER FLOOR, LEVEL 2 - SHARED BATH - 2" HEX
2578 04Feb21 NoCat	1	REVISED COLOUR CHART UPDATE with TILE RESELECT FOR MASTER ENSUITE WALL TILE

CONCR	CONCRETE AND DRAIN		
Invoice	Qty.	Description	
2259	1	BACK-FLOW PREVENTER VALVE	
200 120			
29Oct20 NoCat			

DisciplineMS.rpt 26jun20 Page 2 of 13



Lot: 125

Model: 50.03 A OAKGROVE

Project/Phase: Pine Valley Forevergreen / 1

CROWN MOULDING

Invoice	Qty.	Description
2308	1	.GREAT ROOM - OPT. COFFERED CEILING - AS PER PLAN
29Oct20 NoCat		
2308	1	.LIVING ROOM - OPT. COFFERED CEILING - AS PER PLAN
29Oct20 NoCat		
2506	1	THRU OUT: UPGRADE 3 1/4" STEP BEVEL BB CASING, 7 1/4" BASE BOARD
10Nov20 NoCat		

DRYWALL

Invoice		Description
2308	1	.GREAT ROOM - OPT. COFFERED CEILING - AS PER PLAN
29Oct20 NoCat		
2308	1	.GREAT ROOM - OPT. WAFFLE CEILING, BEAM DETAIL AS PER PLAN (6 BOXES) OPTION#1 CTR-B07
29Oct20 NoCat		
2308	1	.LIVING ROOM - OPT. COFFERED CEILING - AS PER PLAN
29Oct20 NoCat		
2308	1	.LIVING ROOM - OPT. WAFFLE CEILING, BEAM DETAIL AS PER PLAN (6 BOXES) OPTION #1 CTR-B07
29Oct20 NoCat		
2308	19	.INCREASE HEIGHT OF DOOR TO 8FT SECOND FLOOR - PER DOOR
29Oct20 NoCat		
2308	1	***CUSTOM LAYOUT*** MASTER BEDROOM: DELETE WALL AND DOOR AT WIC
29Oct20 NoCat		
2308	1	.MASTER BEDROOM - OPT. SITTING AREA 10 FOOT TRAY CEILING - AS PER PLAN
29Oct20 NoCat		
2506	1	THRU OUT: ADD WINDOW STOOLS AND APRONS
10Nov20 NoCat		827 + 927

DisciplineMS.rpt 26jun20



Lot: 125

Model: 50.03 A OAKGROVE

Project/Phase: Pine Valley Forevergreen / 1

ELECTRICAL

ELECTRICAL		
Invoice	Qty.	Description
2308 72,281 29Oct20	1	.GREAT ROOM: INTERIOR WALL OUTLET: ADDITIONAL 110V WALL INTERIOR RECEPTACLE ON EXISTING CIRCUIT FOR WALL MOUNTED TV - LOCATE APPROX. 60" A.F.F. ABOVE LINEAR FIREPLACE
2308 72,282 29Oct20	1	.KITCHEN: ADDITIONAL 220V RECEPTACLE ON A SEPARATE CIRCUIT - FOR BUILT-IN WALL OVEN - APPLIANCE NOT INCLUDED - DOES NOT INCLUDE BREAKER THAT IS TO BE INSTALLED BY LICENSED ELECTRICIAN AND ARRANGED BY HOMEOWNER AFTER CLOSING
2308 72,273 29Oct20	1	.KITCHEN: 110V WALL RECEPTACLE ON SEPARATE CIRCUIT - GAS FIRED APPLIANCE - FOR AUX. EQUIPMENT - NOT A STOVE PLUG
2308 72,289 29Oct20	6	.KITCHEN: 4" E/S LED INTERIOR POT LIGHT - GROUND FLOOR - EACH INCLUDES 1 SWITCH INCLUDED IN APS
2308 72,307 29Oct20	1	.KITCHEN: FIXTURE: RELOCATE STANDARD CEILING MOUNT FIXTURE LOCATE APPROX CENTER ABOVE ISLAND
2308 72,667 29Oct20	2	.KITCHEN: ROUGH-IN FOR CAPPED CEILING OUTLET (FUTURE LIGHT FIXTURE) - EACH - LOCATE APPROX CENTERED ABOVE ISLAND USE SAME SWITCH AS STANDARD LIGHT
2308 72,303 29Oct20	1	.KITCHEN: FIXTURE: UNDER CABINET FLUORESCENT LIGHT FIXTURES - DOES NOT INCLUDE (AND REQUIRES) LIGHT VALANCE
2308 72,309 29Oct20	1	.MAIN HALL (AT STAIRS) UPGRADE STANDARD CEILING MOUNT FIXTURE TO (1) LED POT LIGHT - GROUND FLOOR -
2308 72,289 29Oct20	3	.MAIN HALL (AT STAIRS) 4" E/S LED INTERIOR POT LIGHT - GROUND FLOOR - EACH
2308 72,309 29Oct20	1	.MAIN HALL (AT CLOSET) UPGRADE STANDARD CEILING MOUNT FIXTURE TO (1) LED POT LIGHT - GROUND FLOOR -
2308 72,289 29Oct20	1	.MAIN HALL(AT CLOSET): 4" E/S LED INTERIOR POT LIGHT - GROUND FLOOR - EACH
2308 72,309 29Oct20	1	.LIVING ROOM: UPGRADE STANDARD CEILING MOUNT FIXTURE TO (1) LED POT LIGHT - GROUND FLOOR - SEE PLAN
2308 72,289 29Oct20	3	.LIVING ROOM: 4" E/S LED INTERIOR POT LIGHT - GROUND FLOOR - EACH

DisciplineMS.rpt 26jun20

Page 4 of 13



Lot: 125

Model: 50.03 A OAKGROVE

Project/Phase: Pine Valley Forevergreen / 1

ELECTRICAL

Invoice	Qty.	Description
2308 72,289	5	.GREAT ROOM: 4" E/S LED INTERIOR POT LIGHT - GROUND FLOOR - EACH
29Oct20		USE SAME SWITCH AS STANDARD LIGHT
2308 72,309 29Oct20	1	.GREAT ROOM: UPGRADE STANDARD CEILING MOUNT FIXTURE TO (1) LED POT LIGHT - GROUND FLOOR - SEE PLAN FOR LOCATION
2308	1	.UPGRADE MAIN FLOOR LINEAR 1 SIDED FIREPLACE - JADE SERIES 42" LINEAR DIRECT VENT GAS FIREPLACE, INCLUDES ELECTRICAL NOT INCLUSIVE OF MANTEL SURROUND-LOCATE *VIEWING AREA* APPROX 12" A.F.F.
29Oct20 NoCat		
2501	1	**CUSTOM LAYOUT** REVISE MUDROOM TO ALLOW SPACE FOR STANDING SHOWER IN POWDER ROOM. INCLUDES SHOWER POTLIGHT, FRAMELESS GLASS ENCLOSURE & STANDARD FINISHES
30Oct20 NoCat		

EXTERIOR COLOURS

Invoice	Qty.	Description
2308	1	EXTERIOR COLOUR PKG # BR. 1
29Oct20		
NoCat		

FIREPLACE

Invoice	Qty.	Description
2308 72,315 29Oct20	1	.UPGRADE MAIN FLOOR LINEAR 1 SIDED FIREPLACE - JADE SERIES 42" LINEAR DIRECT VENT GAS FIREPLACE, INCLUDES ELECTRICAL NOT INCLUSIVE OF MANTEL SURROUND-LOCATE *VIEWING AREA* APPROX 12" A.F.F.

FORMING

invoice	Qıy.	Description
2308 72,675 29Oct20	1	.BASEMENT WINDOWS - UPGRADE BASEMENT WINDOW SIZE TO 30 " X 24" - 10" FRAME (PINEVALLEY 50 FOOT LOTS ONLY) REAR WINDOW
2259 72,678 29Oct20	1	.**DELETE** EGRESS WINDOW (47X35X10" FRAME).
2259	3	.BASEMENT WINDOWS - UPGRADE BASEMENT WINDOW SIZE TO 30 " X 24" - 10" FRAME (PINEVALLEY 50 FOOT LOTS ONLY)
29Oct20 NoCat		

DisciplineMS.rpt 26jun20 Page 5 of 13



Lot: 125

Model: 50.03 A OAKGROVE

Project/Phase: Pine Valley Forevergreen / 1

FRAMING

FRAMII		
Invoice	Qty.	Description
2308 72,542 29Oct20	1	.GREAT ROOM - OPT. COFFERED CEILING - AS PER PLAN
2308 72,544 29Oct20	1	.GREAT ROOM - OPT. WAFFLE CEILING, BEAM DETAIL AS PER PLAN (6 BOXES) OPTION#1 CTR-B07
2308 72,546 29Oct20	1	.LIVING ROOM - OPT. COFFERED CEILING - AS PER PLAN
2308 72,548 29Oct20	1	.LIVING ROOM - OPT. WAFFLE CEILING, BEAM DETAIL AS PER PLAN (6 BOXES) OPTION #1 CTR-B07
2308 72,644 29Oct20	19	.INCREASE HEIGHT OF DOOR TO 8FT SECOND FLOOR - PER DOOR
2308	1	***CUSTOM LAYOUT*** MASTER BEDROOM: DELETE WALL AND DOOR AT WIC
29Oct20 NoCat		
2308 72,637 29Oct20	1	.SUN TUNNEL EXTENSION, 6 FOOT RIGID TUNNEL EXTENSION [2TR 6 FOOT] - UP TO 6 FOOT MAX.
2308 72,631 29Oct20	2	.SHOWER NICHE [SHAMPOO SHELF] - COMPLETE WITH MATCHING MARBLE JAMBS ON 4 SIDES, STANDARD TILE, APPROX. 12 X 18 INSTALLED VERTICALLY - SEE PLAN
2308 72,552 29Oct20	1	.MASTER BEDROOM - OPT. SITTING AREA 10 FOOT TRAY CEILING - AS PER PLAN
2308	1	.UPGRADE MAIN FLOOR LINEAR 1 SIDED FIREPLACE - JADE SERIES 42" LINEAR DIRECT VENT GAS FIREPLACE, INCLUDES ELECTRICAL NOT INCLUSIVE OF MANTEL SURROUND-LOCATE *VIEWING AREA* APPROX 12" A.F.F.
29Oct20 NoCat		
2259	4	.BASEMENT WINDOWS - UPGRADE BASEMENT WINDOW SIZE TO 30 " X 24" - 10" FRAME (PINEVALLEY 50 FOOT LOTS ONLY)- INCLUDES 1 REAR WINDOW
29Oct20 NoCat		
2501	1	**CUSTOM LAYOUT** REVISE MUDROOM TO ALLOW SPACE FOR STANDING SHOWER IN POWDER ROOM. INCLUDES SHOWER POTLIGHT, FRAMELESS GLASS ENCLOSURE & STANDARD FINISHES
30Oct20 NoCat		INCLUDED IN APS

DisciplineMS.rpt 26jun20



Lot: 125

Model: 50.03 A OAKGROVE

Project/Phase: Pine Valley Forevergreen / 1

GLASS AND MIRROR

Invoice	Qty.	Description
2501	1	**CUSTOM LAYOUT** REVISE MUDROOM TO ALLOW SPACE FOR STANDING SHOWER IN POWDER ROOM. INCLUDES SHOWER POTLIGHT, FRAMELESS GLASS ENCLOSURE & STANDARD FINISHES
30Oct20 NoCat		
2506	3	POWDER ROOM / MASTER ENSUITE / SHARED ENSUITE 3/4: UPGRADE SHOWER DOOR HARDWARE TO MT6X6 CHROME
10Nov20 NoCat		
2506	1	MASTER ENSUITE: MOEN 'ARRIS' SHOWER FAUCET + TUB FILLER + (2) SINGLE LEVER LAV FAUCET - CHROME #S93005/TS501001 + S43001 + TS22003EP/62320
10Nov20 NoCat		

DisciplineMS.rpt 26jun20 Page 7 of 13



Lot: 125

Model: 50.03 A OAKGROVE

Project/Phase: Pine Valley Forevergreen / 1

GRANITE MARBLE QUARTZ

Invoice		Description
2501	1	**CUSTOM LAYOUT** REVISE MUDROOM TO ALLOW SPACE FOR STANDING SHOWER IN POWDER ROOM. INCLUDES SHOWER POTLIGHT, FRAMELESS GLASS ENCLOSURE & STANDARD FINISHES
30Oct20 NoCat		
2506	1	POWDER ROOM: UPGRADE 6 QUARTZ COUNTER
10Nov20 NoCat		
2506	1	MUD ROOM: UPGRADE 6 QUARTZ COUNTER TOP
10Nov20 NoCat		
2506	1	KITCHEN: UPGRADE 5 QUARTZ COUNTER TOP
10Nov20 NoCat		
2506	1	KITCHEN: FULL HEIGHT SLAB BACKSPLASH - LEVEL 5 QUARTZ
10Nov20 NoCat		
2506	1	MASTER ENSUITE: UPGRADE 6 QUARTZ COUNTER
10Nov20 NoCat		
2506	1	ENSUITE 2: UPGRADE 5 QUARTZ COUNTER TOP
10Nov20 NoCat		
2506	1	KITCHEN: UPGRADE QUARTZ COUNTERS TO 3CM THICKNESS
10Nov20 NoCat		
2506	1	KITCHEN: COOKTOP CUT OUT
10Nov20 NoCat		
2506	1	ENSUITE 3/4: UPGRADE 4 QUARTZ COUNTER TOP
10Nov20 NoCat		
2506	1	POWDER ROOM: UPGRADE LAV FAUCET + SHOWER FAUCET TO MOEN 'ARRIS' BRUSHED NICKEL MODEL: TS22003EP/62320/S43001
10Nov20 NoCat		
2506	1	MUD ROOOM: UPGRADE SINK AND FAUCET TO: BLANCO 'QUATRUS R15 U BAR + STO 'ONE-HANDLE PD FAUCET' MODEL: #401517 + #S72308SRS
10Nov20 NoCat		
2506	1	KITCHEN: BLANCO QUATRUS R15 U 2 (DOUBLE SINK) / MODEL: #401519 SERVERY: BLANCO QUATRUS R15 U BAR / MODEL: #401515
10Nov20 NoCat		

DisciplineMS.rpt 26jun20

Page 8 of 13



Lot: 125

Model: 50.03 A OAKGROVE

Project/Phase: Pine Valley Forevergreen / 1

GRANITE MARBLE QUARTZ

Qty. Description

Invoice	Qty.	Description
2506	-	KITCHEN: UPGRADE FAUCET TO MOEN NIO - STAINLESS #S75005SRS SERVERY: UPGRADE FAUCET TO MEOEN NIO - BAR FAUCET - STAINLESS #S55005SRS
10Nov20 NoCat		

HARDWOOD

Invoice

29Oct20

2506 16 10Nov20	1	THRU OUT: ALL STANDARD AREAS - MAIN HALL/ LIBRARY/ DINING/ GREAT/ STUDY/ UPPER HALL/ MASTER BEDROOM/ BEDROOM 2/ BEDROOM 3/ BEDROOM 4: MIRAGE, 7 3/4" MAPLE, ENGINEERED HARDWOOD, 3/4" THK, FLAIR LIGHT CHARACTER TEXTURE, DURAMATT FINISH - LEVEL 7 HARDWOOD FLOORS WILL NOT MATCH STAIRS AND LANDINGS IN COLOUR/TEXTURE/SPECIES
HVAC		
Invoice	Qty.	Description
2308	1	.KITCHEN: GAS LINE ROUGH-IN - MAIN FLOOR FOR APPLIANCE - SEE PLAN FOR LOCATION
72,224		
29Oct20		
2308	1	.SUN TUNNEL EXTENSION, 6 FOOT RIGID TUNNEL EXTENSION [2TR 6 FOOT] - UP TO 6 FOOT MAX.
29Oct20 NoCat		
2308	1	.UPGRADE MAIN FLOOR LINEAR 1 SIDED FIREPLACE - JADE SERIES 42" LINEAR DIRECT VENT GAS FIREPLACE, INCLUDES ELECTRICAL NOT INCLUSIVE OF MANTEL SURROUND-LOCATE *VIEWING AREA* APPROX 12" A.F.F.

DisciplineMS.rpt 26jun20 Page 9 of 13



Lot: 125

Model: 50.03 A OAKGROVE

Project/Phase: Pine Valley Forevergreen / 1

INTERIOR TRIM AND DOORS

Invoice		Description DOORS
2308	1	.GREAT ROOM - OPT. COFFERED CEILING - AS PER PLAN
29Oct20 NoCat		
2308	1	.GREAT ROOM - OPT. WAFFLE CEILING, BEAM DETAIL AS PER PLAN (6 BOXES) OPTION#1 CTR-B07
29Oct20 NoCat		
2308	1	.LIVING ROOM - OPT. COFFERED CEILING - AS PER PLAN
29Oct20 NoCat		
2308	1	.LIVING ROOM - OPT. WAFFLE CEILING, BEAM DETAIL AS PER PLAN (6 BOXES) OPTION #1 CTR-B07
29Oct20 NoCat		
2308	19	.INCREASE HEIGHT OF DOOR TO 8FT SECOND FLOOR - PER DOOR
29Oct20 NoCat		
2308	1	***CUSTOM LAYOUT*** MASTER BEDROOM: DELETE WALL AND DOOR AT WIC
29Oct20 NoCat		
2308	1	SUN TUNNEL EXTENSION, 6 FOOT RIGID TUNNEL EXTENSION [2TR 6 FOOT] - UP TO 6 FOOT MAX.
29Oct20 NoCat		
2308	1	.UPGRADE MAIN FLOOR LINEAR 1 SIDED FIREPLACE - JADE SERIES 42" LINEAR DIRECT VENT GAS FIREPLACE, INCLUDES ELECTRICAL NOT INCLUSIVE OF MANTEL SURROUND-LOCATE *VIEWING AREA* APPROX 12" A.F.F.
29Oct20 NoCat		
2308	1	.MASTER BEDROOM - OPT. SITTING AREA 10 FOOT TRAY CEILING - AS PER PLAN
29Oct20 NoCat		
2259	4	.BASEMENT WINDOWS - UPGRADE BASEMENT WINDOW SIZE TO 30 " X 24" - 10" FRAME (PINEVALLEY 50 FOOT LOTS ONLY)- INCLUDES 1 REAR WINDOW
29Oct20 NoCat		
2506 155,906	1	THRU OUT: ADD FOR HINGES 3X3 SQUARE FLAT TIP THROUGHOUT
10Nov20		MATTE BLACK
2506 153,540	1	THRU OUT: UPGRADE 3 1/4" STEP BEVEL BB CASING, 7 1/4" BASE BOARD
10Nov20		UPGRADE
2506 153,828	1	THRU OUT: HALIFAX LEVER, IRON BLACK INTERIOR DOOR HARDWARE
10Nov20		UPGRADE

DisciplineMS.rpt 26jun20

Page 10 of 13



Lot: 125

Model: 50.03 A OAKGROVE

 $\label{lem:project/Phase: Pine Valley Forevergreen / 1} Project/Phase: Pine Valley Forevergreen / 1$

INTERIOR TRIM AND DOORS

Invoice		Qty.	Description
250)6	1	UPGRADE INTERIOR DOORS TO LINCOLN PARK,
155,4	405		
10No	v20		UPGRADE

KITCHEN AND BATH CABINETRY

Invoice	Qty.	Description
2501	1	**CUSTOM LAYOUT** REVISE MUDROOM TO ALLOW SPACE FOR STANDING SHOWER IN POWDER ROOM. INCLUDES SHOWER POTLIGHT, FRAMELESS GLASS ENCLOSURE & STANDARD FINISHES
30Oct20 NoCat		
2506	1	THRU OUT: SEE ATTACHED CABINETRY SCHEDULE
10Nov20 NoCat		

NETWORK AND WIRING

Invoice	Qty.	Description
2308 72,259 29Oct20	1	.GREAT ROOM: CONDUIT PIPE - FOR WALL MOUNT TV - LOCATE APPROX. 60" A.F.F. ABOVE LINEAR FIREPLACE TERMINATE AT CABLE LOCATION

PAINT

PAINT Invoice	Otr	Description
2308	1	.GREAT ROOM - OPT. COFFERED CEILING - AS PER PLAN
29Oct20		
NoCat		
2308	1	.GREAT ROOM - OPT. WAFFLE CEILING, BEAM DETAIL AS PER PLAN (6 BOXES) OPTION#1 CTR-B07
29Oct20		
NoCat		
2308	1	.LIVING ROOM - OPT. COFFERED CEILING - AS PER PLAN
29Oct20		
NoCat		
2308	1	.LIVING ROOM - OPT. WAFFLE CEILING, BEAM DETAIL AS PER PLAN (6 BOXES) OPTION #1 CTR-B07
29Oct20		
NoCat		
2308	19	.INCREASE HEIGHT OF DOOR TO 8FT SECOND FLOOR - PER DOOR
29Oct20		
NoCat		
2308	1	.MASTER BEDROOM - OPT. SITTING AREA 10 FOOT TRAY CEILING - AS PER PLAN
29Oct20		
NoCat		
2506	2	MAIN STAIRS: 2ND FLOOR TO BASEMENT: STAIN STAIRS AND LANDINGS
10Nov20 NoCat		STAIRS AND LAINDINGS WILL NOT MATCH HARDWOOD FLOORS IN COLOUR/TEXTURE/SPECIES

DisciplineMS.rpt 26jun20 Page 11 of 13



Lot: 125

Model: 50.03 A OAKGROVE

Project/Phase: Pine Valley Forevergreen / 1


Invoice	Qty.	Description
2501	1	**CUSTOM LAYOUT** REVISE MUDROOM TO ALLOW SPACE FOR STANDING SHOWER IN POWDER ROOM. INCLUDES SHOWER POTLIGHT, FRAMELESS GLASS ENCLOSURE & STANDARD FINISHES
30Oct20 NoCat		
2501	1	**CUSTOM LAYOUT** REVISE MUDROOM TO ALLOW SPACE FOR STANDING SHOWER IN POWDER ROOM. INCLUDES SHOWER POTLIGHT, FRAMELESS GLASS ENCLOSURE & STANDARD FINISHES
30Oct20 NoCat		
2506	1	POWDER ROOM: UPGRADE LAV FAUCET + SHOWER FAUCET TO MOEN 'ARRIS' BRUSHED NICKEL MODEL: TS22003EP/62320/S43001
10Nov20 NoCat		
2506	1	MUD ROOOM: UPGRADE SINK AND FAUCET TO: BLANCO 'QUATRUS R15 U BAR + STO 'ONE-HANDLE PD FAUCET' MODEL: #401517 + #S72308SRS
10Nov20 NoCat		
2506	1	KITCHEN: BLANCO QUATRUS R15 U 2 (DOUBLE SINK) / MODEL: #401519 SERVERY: BLANCO QUATRUS R15 U BAR / MODEL: #401515
10Nov20 NoCat		
2506	1	KITCHEN: UPGRADE FAUCET TO MOEN NIO - STAINLESS #S75005SRS SERVERY: UPGRADE FAUCET TO MEOEN NIO - BAR FAUCET - STAINLESS #S55005SRS
10Nov20 NoCat		
2506	1	MASTER ENSUITE: MOEN 'ARRIS' SHOWER FAUCET + TUB FILLER + (2) SINGLE LEVER LAV FAUCET - CHROME #S93005/TS501001 + S43001 + TS22003EP/62320
10Nov20 NoCat		

PLUMBING FIXTURES

Invoice	Qty.	Description
2308	1	.MASTER ENSUITE: UPGRADE SHOWER FAUCET TO MOEN `ARRIS` 3-FUNCTION RAIN SHOWER (from ceiling) - CHROME #TS22002EP/3372/TS23005/62320/3887EP/A725
29Oct20 NoCat		

STAIR AND RAILINGS

Invoice	Qty.	Description
2506	2	2ND FLOOR TO BASEMENT: ADD FOR GLASS PANEL IN LIEU OF PICKETS - UPG - GLASS PANEL
100,247		
10Nov20		UPPER HALL TO HAVE SMALLER PANELS TO FOLLOW CURVED AREA.
		SUPPORT POSTS MAY BE OUTSIDE OF NOSING TO FOLLOW CURVE.

STAIRS AND RAILINGS

70		
Invoice	Qty.	Description
2506	2	MAIN STAIRS: 2ND FLOOR TO BASEMENT: STAIN STAIRS AND LANDINGS
10Nov20 NoCat		STAIRS AND LAINDINGS WILL NOT MATCH HARDWOOD FLOORS IN COLOUR/TEXTURE/SPECIES

DisciplineMS.rpt 26jun20 Page 12 of 13



Lot: 125

Model: 50.03 A OAKGROVE

Project/Phase: Pine Valley Forevergreen / 1

TRIM AND DOORS

Invoice	Qty.	Description
2506	1	THRU OUT: ADD WINDOW STOOLS AND APRONS
10Nov20 NoCat		827 + 927

WINDOWS - BASEMENT

Invoice	Qty.	Description
2308 72,678 29Oct20	1	**DELETE** BASEMENT WINDOWS - EGRESS BASEMENT WINDOW 47 " X 35" DELETE
2308 29Oct20 NoCat	1	BASEMENT WINDOWS - UPGRADE BASEMENT WINDOW SIZE TO 30 " X 24" - 10" FRAME (PINEVALLEY 50 FOOT LOTS ONLY)- REAR WINDOW
2259 72,675 29Oct20	3	.BASEMENT WINDOWS - UPGRADE BASEMENT WINDOW SIZE TO 30 " X 24" - 10" FRAME (PINEVALLEY 50 FOOT LOTS ONLY)

WINDOWS AND DOORS

***************************************	* * ~	
Invoice	Qty.	Description
2308	1	.THRU OUT: UPGRADE TO BLACK INTERIOR WINDOWS
29Oct20		
NoCat		
2308	1	SUN TUNNEL EXTENSION, 6 FOOT RIGID TUNNEL EXTENSION [2TR 6 FOOT] - UP TO 6 FOOT MAX.
29Oct20		
NoCat		

DisciplineMS.rpt 26jun20 Page 13 of 13

GOLDPARK		INTERIOR COLOUR SCHEME			
WORTH MORE	*** NOTE: This is no	ot an approved document. Document	must be locked ***		
Purchaser: ABDI	JL, RAFAH MUDASSAR	Scheduled Closing Date: Tuesday, Novemb Property: 125 of Plan -	er 24, 2020		
Telephone Res. / Bus: (416)		Project: Pine Valley Foreve	orgroom Dhana 4		
D-20 100 100 100 100 100 100 100 100 100 1	de Somerville	Model and Elevation: 50.03 A OAKGRO			
Layout Changes: Yes	No Sketch Attacl	hed: Yes No Exterior Colour Schen			
1. Cabinetry		Exterior Colour Schen	ne:		
Kitchen / Breakfast	Style and Colour	Counter	Hardware		
W 95 00	*Medio 6 Oyster	*Quartz: 'Calacatta Nuvo'	bh0519		
Laundry Room Powder Room	Tribecca 'Arris'	P-Lam: Standard White	h03909		
	*Medio 6 Oyster	*Quartz: 'Calacatta Gold'	bh0813		
Mud Room	*Medio 6 Oyster	*Quartz: 'Calacatta Gold'	bh0813		
Master Ensuite Bathroom	*Willis 'Oyster'	*Quartz: 'Calacatta Gold'	bh0803		
Bathroom (If Applicable)	*Willis 'Oyster'	*Quartz: 'Organic White'	h04421		
Shared Ensuite 3/4	*Medio 6 'Clay'	*Quartz: 'Pearl Jasmine')Essa		
Comment	Medio o Clay	Quartz: Peari Jasmine	bh0803		
Comment					
a.					
2 Fl Til.					
2. Floor Tile	Selection	4111			
Entrance Vestibule	*12x24" Eterna matte 'V	/olkas' white	1		
Main Hall	n/a				
Kitchen / Breakfast	*24x24" Eterna matte 'V	/olkas' white			
Laundry Room	*12x24" Regal matte 'Shell White'				
Powder Room	*12x24" Eterna matte 'Volkas' white				
Mud Room	*12x24" Eterna matte 'V	/olkas' white			
Master Ensuite Bathroom	*Roma Hex 'Calacatta'				
Second Ensuite Bathroom (If Applicable)	*12x24" Marmorea matte "White" / Biarco Calacatta (matto)				
Lower Landing (If Applicable)	*12x24" Regal matte 'Shell White'				
Shared Ensuite	*12x24" Eterna matte 'Carrara White'				
Comment SHOWER FLOOR: POWDER - 2' HEX QUEBEC 'ARCTIC WHITE'	'Volkas matte 'WHITE' // MA	STER ENSUITE: 2" HEX QUEBEC 'ARCTIC WHITE' // S	HÄRED ENSUITE; 2"		
3. Wall Tile	Selection	Listello/Inserts Describe			
Powder room	*12x24" Volkas polish	Describe			
Tub De	eck * Reselection*				
	tall - 3x12" Roma Statuar				
	alls the Roma rala	catta! Yes No			
Second Ensuite Bathroom (If Applicable)	*12x24" Mrmorea mtt				
Shared Ensuite	and base seems	catta-polished Yes No			
Kitchen Backsplash	Yes No 4	arrara, White Pol Backsplash Behind Fridge)		

Slab FHBS - same as counter





Comment

GOLDPARK INTERIOR COLOUR SCHEME *** NOTE: This is not an approved document. Document must be locked *** Scheduled Closing Date: Tuesday, November 24, 2020 Purchaser: ABDUL, RAFAH MUDASSAR Property: 125 of Plan -Telephone Res. / Bus: (416) 859-9121 Project: Pine Valley Forevergreen - Phase 1 Decor Advisor: Yolande Somerville Model and Elevation: 50.03 A OAKGROVE 4. Plumbing Fixtures Second Ensuite **Powder Room** Master Ensuite Bathroom Other Room - Specify Other Washroom Comment Upgrade kitchen/servery + master ensuite + powder 5. Hardwood Flooring Type and Stain Type and Stain Main Hall **Upper Landing** Kitchen / Breakfast Upper Hall Living Room Master Bedroom **Dining Room** Bedroom #2 Family Room Bedroom #3 Den/Library Bedroom #4 **Entrance Vestibule** Bedroom #5 Other Room - Specify *3/4x7-3/4 Maple 'Snowdrift' Lower Landing (If Applicable) Comment Mirage: 3/4x7-3/4 Maple 'Snowdrift' 6. Carpeting Upgrade Description **Ground Floor** Second Floor Type Upgrade Underpad Runner - *Upgrade Carpet on Stairs Comment 7. Fireplace Living Room Family Room Other Room - Specify N/A Purchased As Per Plan N/A As Per Plan 0 Linear Gas Fireplace Type Mantle Type none Colour / Stain n/a Surround n/a Hearth none Comment

GOLDPARK INTERIOR COLOUR SCHEME *** NOTE: This is not an approved document. Document must be locked *** Scheduled Closing Date: Tuesday, November 24, 2020 Purchaser: ABDUL, RAFAH MUDASSAR Property: 125 of Plan -Telephone Res. / Bus: (416) 859-9121 Project: Pine Valley Forevergreen - Phase 1 Decor Advisor: Yolande Somerville Model and Elevation: 50.03 A OAKGROVE 8. Trim Carpentry Interior Doors *Lincoln Front Door Glass Inserts std Door Handles *Halifax black +hng *Board 6 -step bevel bb casing + 7-1/4" baseboard Comment 9. Plaster Mouldings and Medallions Standard Throughout O Yes O No N/A **Entrance Vestibule** Kitchen/Breakfast Main Hall Den/Library Living Room **Lower Landing Dining Room** Other Room - Specify **Family Room** Comment 10. Railings and Spindles Railing Package *Glass/stainless Railing Colour *Graphite Spindle Colour *Stainless/clear glass Stringer / Riser *Graphite Treads *Graphite Oak Stairs Yes O No \bigcirc N/A Comment Stairs and landings will not match hardwood floors in colour/texture/species 11. Wall Paint / Ceilings -Throughout Finished Areas Warm Grey Trim Paint White **Smooth Ceilings Ground Floor** Second Floor Note



Comment

GOLDPARK INTERIOR COLOUR SCHEME WORTH MORE: *** NOTE: This is not an approved document. Document must be locked *** Scheduled Closing Date: Tuesday, November 24, 2020 ABDUL, RAFAH MUDASSAR Purchaser: Property: 125 of Plan -Telephone Res. / Bus: (416) 859-9121 Project: Pine Valley Forevergreen - Phase 1 Decor Advisor: Yolande Somerville Model and Elevation: 50.03 A OAKGROVE 12. Electrical Hood Fan White O Stainless N/A Above Kitchen Cabinet Light O Yes No Below Kitchen Cabinet Light O Yes No Standard Appliances Over The Range Microwave Chimney Style Fan Comment 13. Heating and Air Conditioning Air Conditioning no **Gas Provisions Stove** yes Gas Provisions Dryer no Gas Provisions Barbecue std Comment 14. Additional Comments -15. Disclaimers and Notes 1) Colours of all materials are as close as possible to builder's selection, but not necessarily identical due to variances in manufacturing. 2) Any extras listed above are null and void unless accompanied by a separate invoice/amendment. Said invoice must be paid in full. 3) The Purchaser acknowledges that after Interior Colour Selection form is signed and dated, no further changes will be permitted other than re-selection due to unavailability. __ Purchaser's Initials

4) The Purchaser acknowledges reading and accepting the "Gold Park Homes Decor Centre Disclaimers" form. This document contains

Date:

Feb. 4,2021

Signature!

other miscellaneous disclaimers.

This Interior Colour Selection is final and approved by:



PV-125 Cabinetry Schedule

ROOM	DESCRIPTION	PRICE	QTY		TOTAL
KITCHEN	UPGRADE PERIMETER FROM SERIES 2 TO SERIES 5 - MEDIO (6) OYSTER		1		
	UPGRADE ISLAND FROM SERIES 2 TO SERIES 5 - MEDIO (6) OYSTER			\$	
	UPGRADE SERVERY FROM SERIES 2 TO SERIES 5 - MEDIO (6) OYSTER	100	1	\$	
	SUPPLY OPTIONAL SERVERY UPPERS IN SERIES 5 - MEDIO (6) OYSTER		1	\$	
	CONVERT FULL DOOR BASE CARINET IN SERVED 5 - MEDIC (6) OYSTER	10.0	1	\$	
	CONVERT FULL-DOOR BASE CABINET IN SERVERY INTO BANK OF 4 DRAWERS WITH 3/4" WHITE				
	EXTENSION DRAWERS		1	\$	
	ADD BEVEL GLASS INSERTS TO OPTIONAL SERVERY UPPERS		1	\$	
	UPGRADE HARDWARE: BH-051-09		1	\$	
	UPGRADE APPLIANCE HARDWARE: BAH-053-09 (FRIDGE & PANTRIES)	1.4	1	\$	
	LIGHT VALANCE ONLY		1	\$	
	ADD MODERN ASPEN RANGE HOOD CABINET PLANNED WITH 4" GAPS		1	\$	
	ADD RANGETOP CABINET IN STOVE LOCATION WITH 3/4" EXTENSION WHITE POT DRAWERS				
	BELOW		1	\$	
	CONVERT STD. CABINETS INTO A TALL DEEP PANTRY		1	\$	
	CONVERT FULL DOOR BASE CABINET INTO BASE POTS AND PANS DRAWERS WITH 3/4"		1	2	
	EXTENSION DRAWERS		2		
	CONVERT STD. CABINETS INTO A TALL DEEP BUILT-IN OVEN UNIT WITH 3/4" EXTENSION WHITE		1	\$	
	POT DRAWER BELOW				
			1	\$	
	HARDWOOD, IF ANY, RETURN TRIP FOR KICK PLATE ADJUSTMENTS		1	\$	
	RECYCLE CENTRE TO ISLAND BESIDE DISHWASHER - 4 BIN	4.7	1	\$	
	OPTION - ADD PUSH TO OPEN TOUCH LATCH HARDWARE TO REAR ISLAND		1	\$	
	ADD 3x STEEL PULL-OUT ACCESSORY TO FULL DOOR BASE CABINET - 12"W		1	\$	
	ADD OVERSIZED DUMMY DOORS TO SIDES OF ISLAND		1	\$	
	ADD CAMDEN STYLE FLUSH KICK PLATE TO 3 SIDES OF ISLAND		1	\$	
	ADD FLIP-UP HARDWARE FOR 48"W X 18"H FLIP-UP OVER FRIDGE & FOR PANTRIES		1	Ś	
	DISHWASHER DECOR PANEL		1	\$	
	FRIDGE DECOR PANELS FOR 48"W FRIDGE		1	\$	
			1	\$	
				\$	
POWDER ROOM	UPGRADE FROM SERIES 2 TO SERIES 5 - MEDIO 6 DYSTER				
1 OTT DELITIOON	UPGRADE HARDWARE - BH-081-03		1	\$	
			1	\$	
	SOFT-CLOSE HINGE CONVERSION		1	\$	
				\$	
MUD ROOM	UPGRADE FROM SERIES 2 TO SERIES 5 - MEDIO 6 OYSTER		1	\$	
	UPGRADE HARDWARE - BH-081-03		1	\$	
	SOFT-CLOSE HINGE CONVERSION		1	\$	
				5	
LAUNDRY ROOM	SOFT-CLOSE HINGE CONVERSION		1	Ś	
	STANDARD HARDWARE: H039-03		1	2	
MASTER ENSUITE	UPGRADE FROM SERIES 2 TO SERIES 5 - WILLIS OYSTER		1	\$	
	UPGRADE HARDWARE - BH-080-03		1	\$	
	SOFT-CLOSE HINGE CONVERSION		1	\$	
				\$	
				*	
SHARED BATH	UPGRADE FROM SERIES 2 TO SERIES 5 - MEDIO (6) CLAY		1	\$	
	UPGRADE HARDWARE - BH-080-03		1	\$	
	SOFT-CLOSE HINGE CONVERSION		1	Ś	
				\$	
				-	
BED 2 BATH	UPGRADE FROM SERIES 2 TO SERIES 5 - WILLIS OYSTER		1	4	
JAMII	SOFT-CLOSE HINGE CONVERSION		1	\$	
			1	\$	
	STANDARD HARDWARE: H044-21	0.00		\$	
				\$	
				-//	
		RY TOTAL:		\$	

LOT#: PV - 125	DATE: NOV. 5 , 2020	
SIGNATURE:		
SIGNATURE:		




The Oakgrove

50' SERIES

Elevation A • 3,920 sq.ft. Elevation B • 3,905 sq.ft. Elevation C • 3,915 sq.ft.

PV-125 Marad 30 2020 * REVISED APRIL 29 2020*

PV-125 Nov. 5, 2020. AP OPT. COVERED LOGGIA No! COTTER + WAFTE 60" AFF GAS+ELECT. BIN WEN. 2 PONTO D DINING ROOM HARDWOOD. HARDWOOD WAFFLE GARAGE 18'6" X 21'1" **PORTICO**

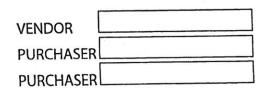


GROUND FLOOR | ELEV. A


GOLDPARK

WORTH MORE

Prices, figures, illustrations, sizes, features and finishes are subject to change without notice. Areas and dimensions are approximate and actual usable floor space may vary from the stated area. Layout may be reverse of the unit purchased. E. & O.E. 5003

SCHEDULE'F'

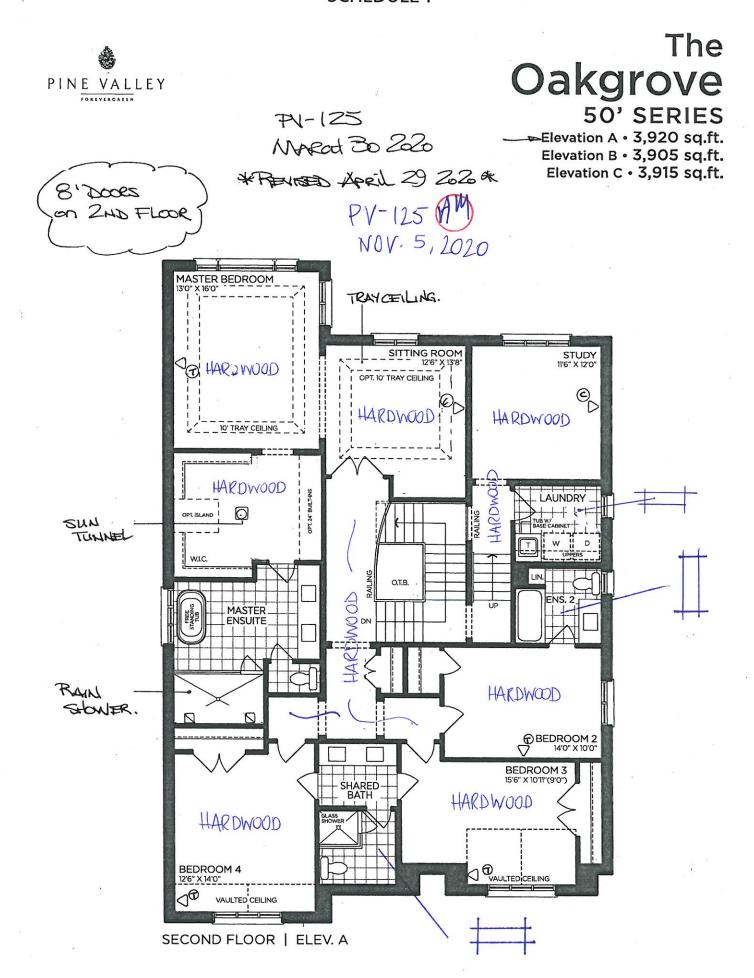

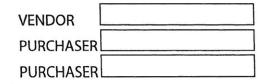

GOLDPARK

WORTH MORE


Prices, figures, illustrations, sizes, features and finishes are subject to change without notice. Areas and dimensions are approximate and actual usable floor space may vary from the stated area. Layout may be reverse of the unit purchased. E. & O.E. 5003

* Revised Powder Room *

PV-125.

Nov. 5 , 2020



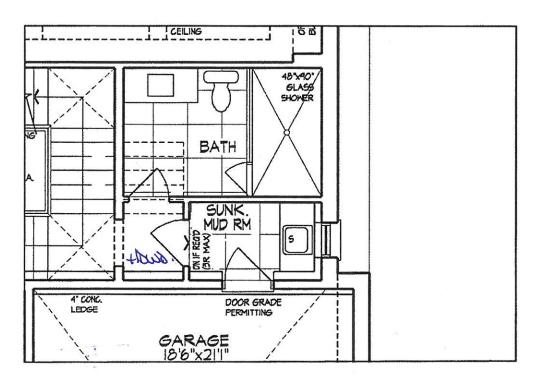

PARTIAL GROUND FLOOR PLAN, EL. 'A' - LOT 125

K-W

H

SCHEDULE'F'



MARCOL 30 2020 Oakgrove


* REVISED APRIL 29 2020 *

The

Elevation B • 3,905 sq.ft. Elevation C • 3,915 sq.ft.

PV-125 (779) Nov. 5, 2020


24×30"

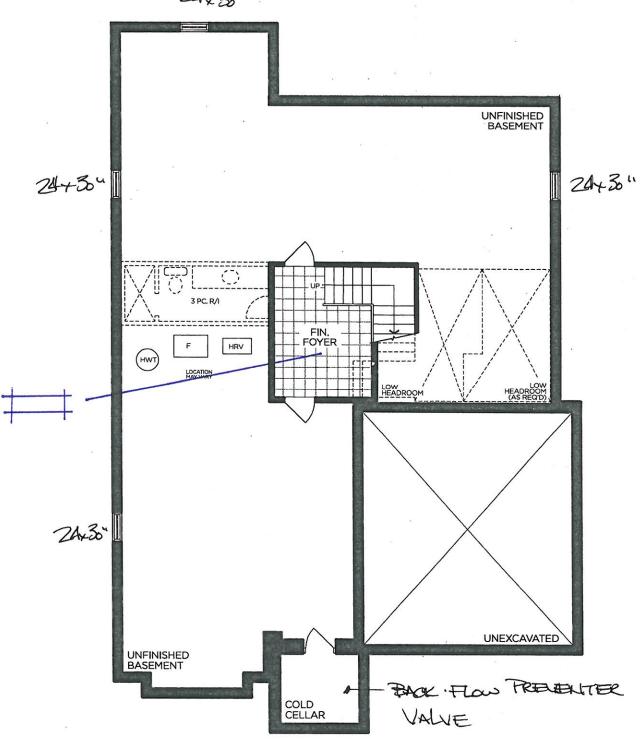



BASEMENT | ELEV. A

VENDOR PURCHASER PURCHASER GOLDPARK


Prices, figures, illustrations, sizes, features and finishes are subject to change without notice. Areas and dimensions are approximate and actual usable floor space may vary from the stated area. Layout may be reverse of the unit purchased. E. & O.E. 5003

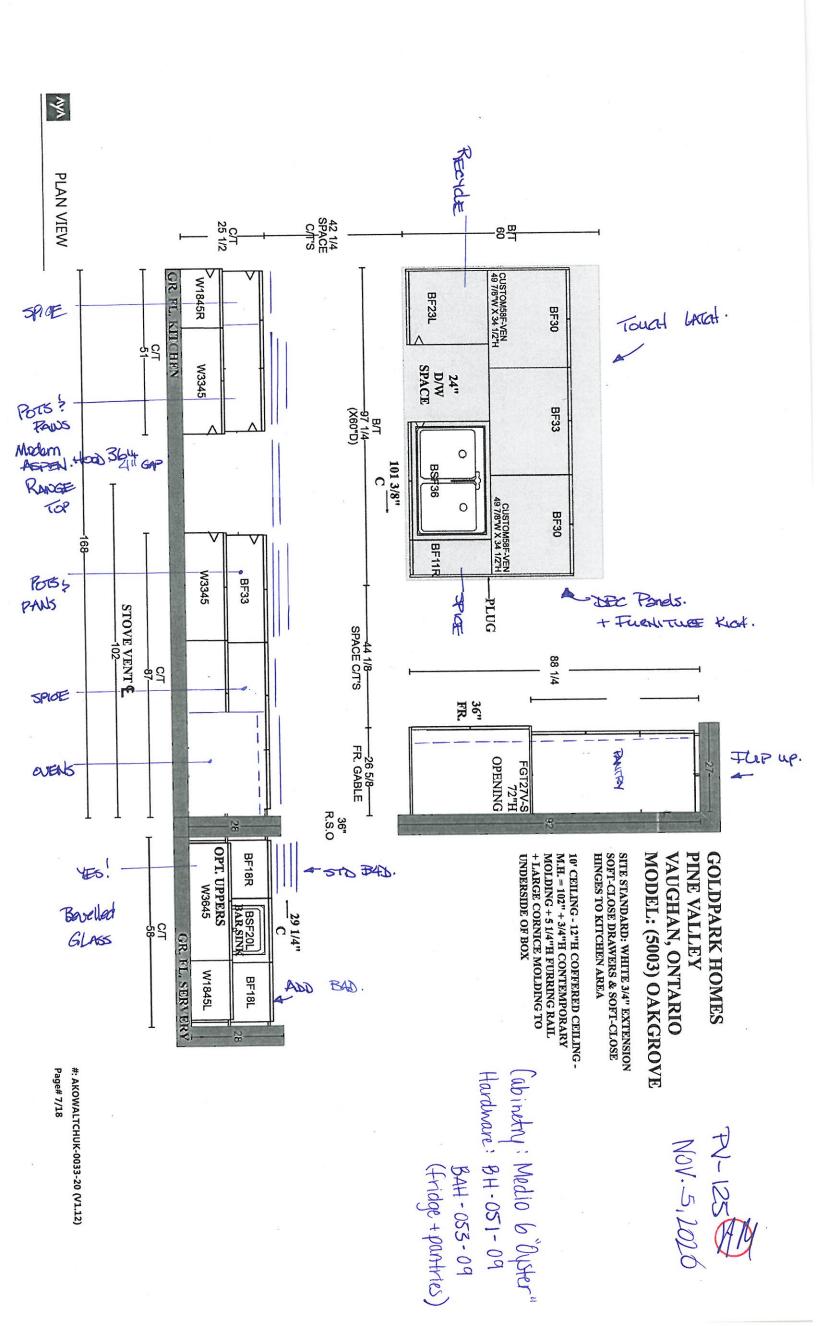

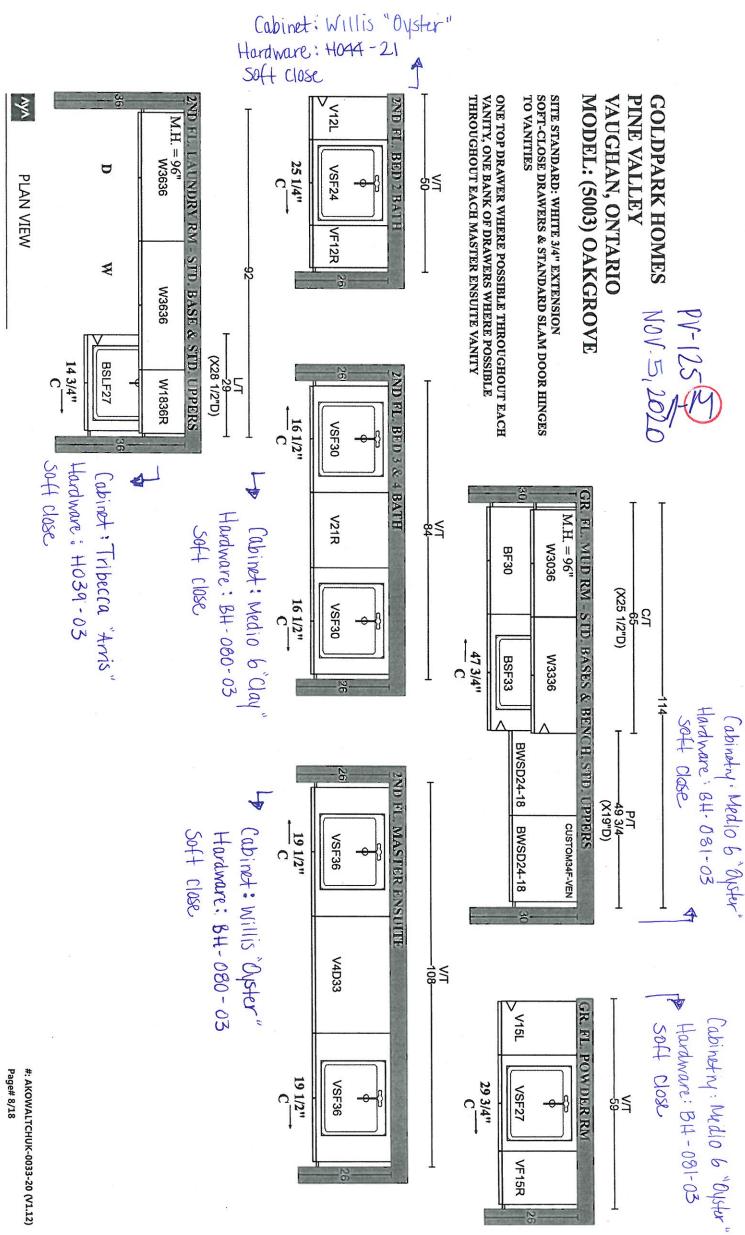

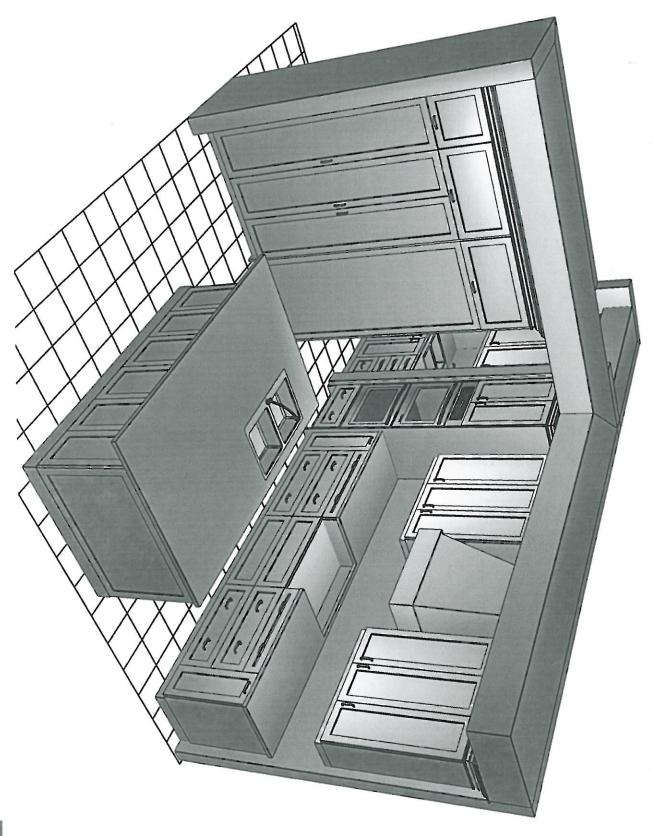


Nov. 5, 2010.

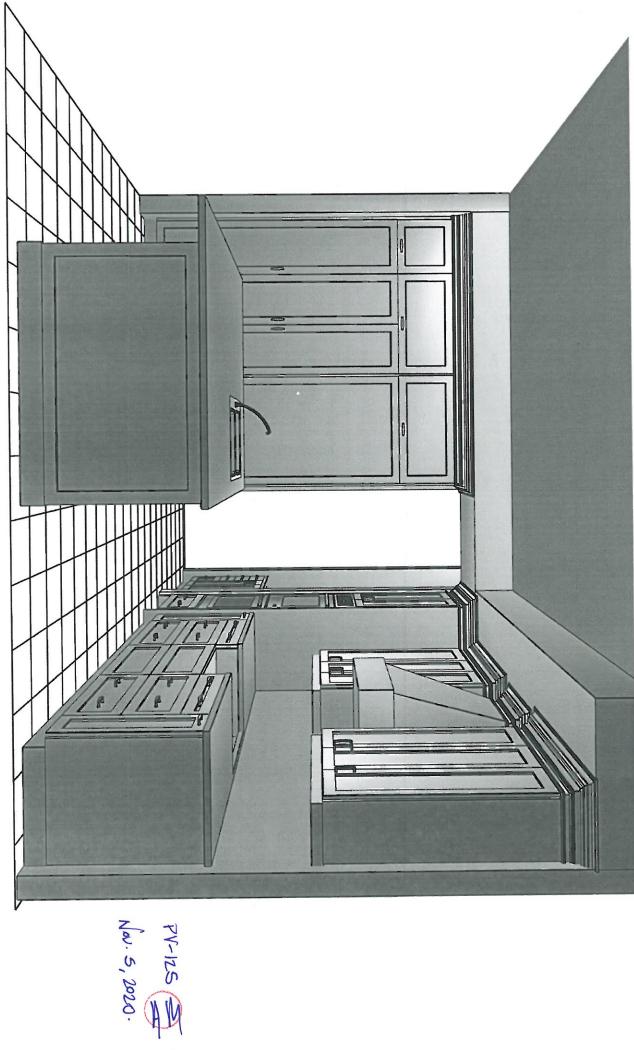


PERSPECTIVE VIEW

AKOWALTCHUK-0206-20

Nov. 5, 2020.

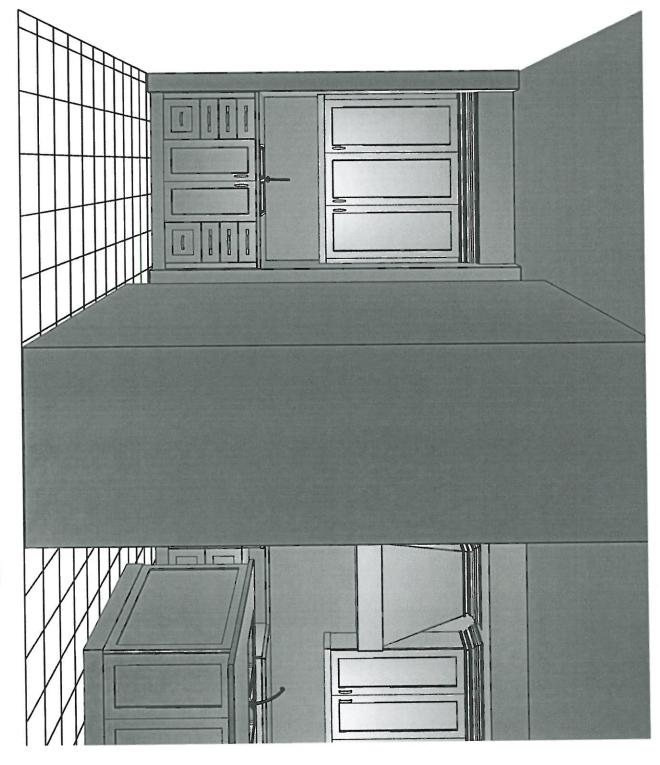

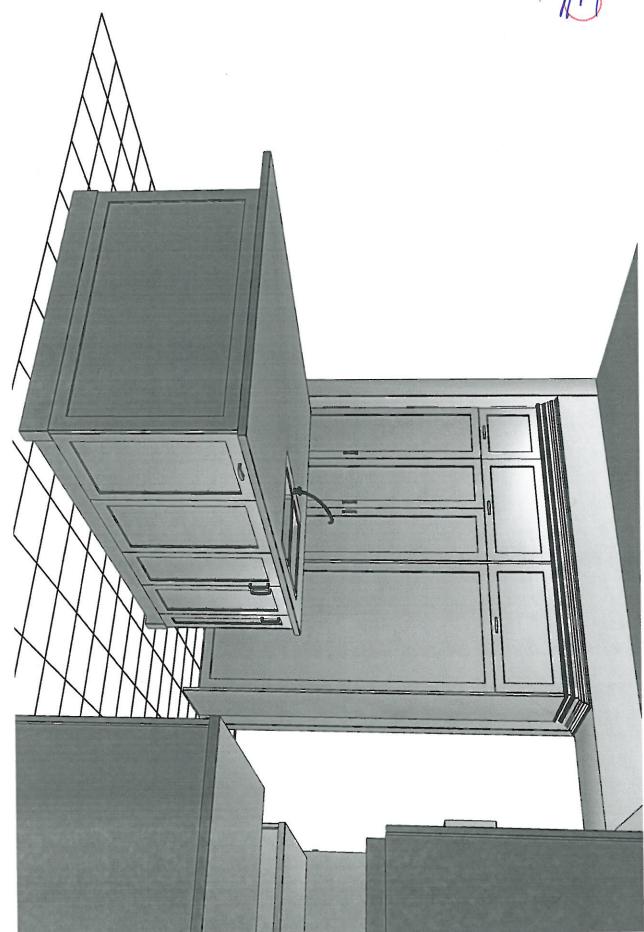



Single Handle Lav Faucet with Push-Button Drain without Overflow



CHROME	
BRUSHED NICKEL (BN)	
MATTE BLACK (BL)	
MODEL: S43001 Lav Faucet	
Lot# PV-125 Date: Nov 5,2020	Room: Powder Room
Signature:	
Signature:	



Eco-Performance Posi-Temp Tub/Shower Faucet



CHROME	from WALL
BRUSHED NICKEL (BN)	from CEILING
MATTE BLACK (BL)	
MODEL: TS22003EP Tub/Shower Trim / 62320 1/2" CC Valve	e / 116651 Shower Arm (from Ceiling)
Lot# 1V-125 Date: Nov 5 , 2020	Room: Powder Room
Signature:	
Signature:	



Two-Handle Roman Tub Faucet with Hand Shower



CHROME	CHROME Tub Drain Half Kit					
BRUSHED NICKEL (BN)	OTHER Tub Drain Half Kit					
MATTE BLACK (BL)						
MODEL: TS93004 Tub Faucet / 9796 1/2" CC Valve / T9033:	MODEL: TS93004 Tub Faucet / 9796 1/2" CC Valve / T90331 (BN, BL) Tub Drain Half Kit					
Lot# PV-125 Date: Nov. 5, 2020	Room: Master Ensuite					
Signature:						
Signature:						



Single Handle Lav Faucet with Push-Button Drain without Overflow



CHROME		
BRUSHED NICKEL (BN)		5 8 0 =
MATTE BLACK (BL)		
MODEL: S43001 Lav Faucet		w.
Lot# PV-125 Date: NOV 5 12020 Room: Master Ensulte	x2	
Signature:		
Signature:		



BLANCO - QUATRUS R15 U BAR Stainless Steel - Undermount 17" x 17" x 8"



Stainless Steel	GRID
MODEL 401515 Stainless Steel / 406492 Grid	
Lot# PV-125	
Room: Servery	Signature:
Date: Nov 5 , 2020	Signature:

CHROME

MATTE BLACK / BRUSHED GOLD (BL)



MOEN - NIO

One-Handle Bar Faucet



STAINLESS (SRS)
MODEL: S55005 Chrome / S55005BL Matte Black / S55005SRS Spot Resist Stainless
Lot# PV-125 Date: NOV. 5,2020 Room: Servery
Signature:
Signature:

CHROME


MATTE BLACK / BRUSHED GOLD (BL)

SPOT RESIST STAINLESS (SRS)



MOEN - NIO

One-Handle Pulldown Kitchen Faucet

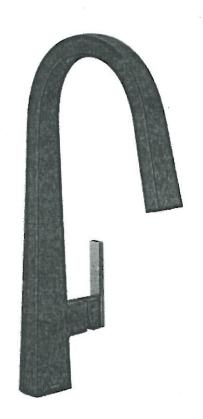

MODEL: S75005 Chrome / S75005BL Matte Black / S75005SRS Spot Resist Stainless	
Lot# PV-125 Date: Nov 5,2020 Room: Kitchen	
Signature:	
Signature:	¥



BLANCO - QUATRUS R15 U 2 Stainless Steel - Undermount 32" x 18" x 9"






32ⁿ कों के Y Y 14 1/2" 14 1/2"

Stainless Steel

MODEL 401519 Stainless Steel / 406454 Grid

Lot# pV-125	
Room: Kitchen	Signature:
Date: NoV 5 , 1020	Signature:




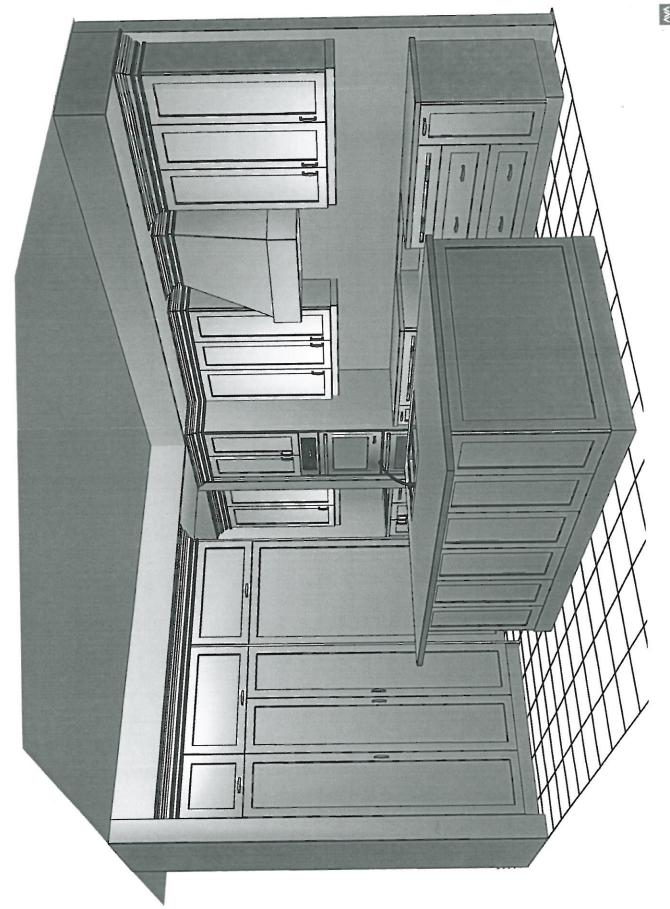



ASPEN MODERN HOOD


(Insert fan not included)

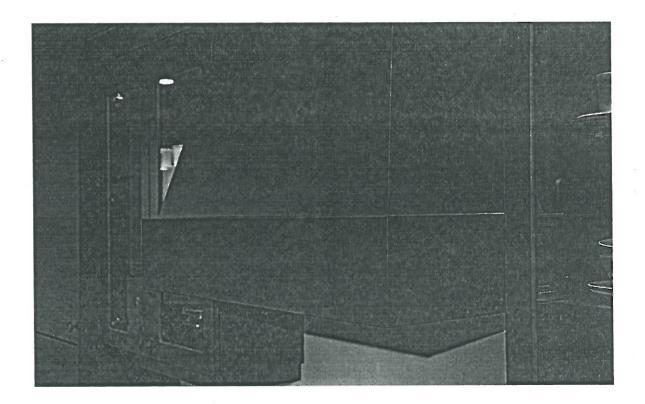

LOT# PV-125	ROOM: Kitchen	DATE: NOV 5 12020
SIGNATURE:	(
SIGNATURE:		



BLANCO - QUATRUS R15 U 1 MEDIUM Stainless Steel - Undermount 25" x 18" x 9"

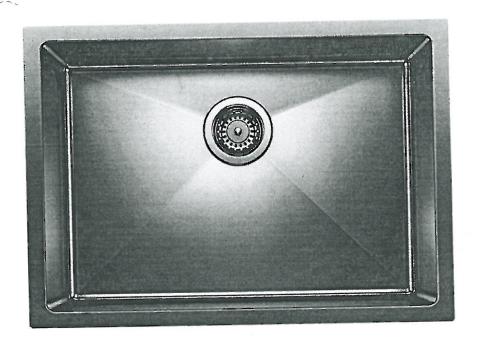

Stainless Steel	GRID	
MODEL 401517 Stainless / 406452 Grid		
Lot# p V-125		
Room: Mud Room	Signature:	
Date: Nav. 5 , 2020	Signature:	



MOEN - STO

One-Handle Pulldown Kitchen Faucet



CHROME
MATTE BLACK (BL)
STAINLESS (SRS)
BRUSHED GOLD (BG)
MATTE BLACK / CHROME (BLC)
MODEL: S72308 Chrome / S72308BL Matte Black / S72308SRS Stainless / S72308BG Brushed Gold / S72308BLC Matte Black + Chrome
Lot# PV-125 Date: NOV. 5 ,1020 Room: Mud Room
Signature:
Signature:



STONE COUNTERTOP EDGE PROFILES

	2CM EASED EDGE	LOCATION: THRU OUT
	3CM EASED EDGE	LOCATION: Kitchen
		- /
	4CM MITRED EDGE	LOCATION:
9		
	2CM OGEE EDGE	LOCATION:
		,
	-	
		a
LOT#: PV-125	DATE: NOV 5 , 2	026
SIGNATURE:		
SIGNATURE:		



BH-051-09

Modern Brushed Gold - Subtle Surge Pull 160mm C/C



T	0	0	Δ'	ГT	0	N	

Kitchen

LOT# PV-125	DATE: NOV 5, 2020	
SIGNATURE:		
SIGNATURE:		



BAH-053-09

Modern Brushed Gold - Subtle Surge Appliance 18"



LOCATION:

LOT#	24-1	25
------	------	----

DATE: NOV 5 ,2020

SIGNATURE:



SIGNATURE:



H001-02	H001-03	H001-04	
H009-03	H009-09		
House	I House	House	
H011-03	H011-05	H011-06	
H033-01	HO39-03 HO39-03		-
LOT # PV - 125 DATE:	Nov 5, 2020		_~
SIGNATURE:			
SIGNATURE:			




BH-081-03

PULL HARDWARE - BRUSHED NICKEL 160mm C/C



LOCATION:

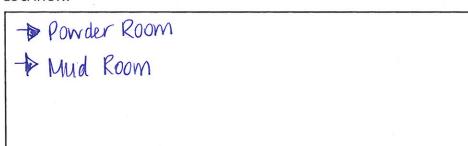

LOT# PV-125	DATE: NOV 5 2010		
SIGNATURE:			
SIGNATURE:	-		



BH-080-03

Brushed Nickel - Pull 128mm C/C



5 12020

LOCATION:

Master Ensuite
Twin Bath 3/4

LOT # PV - 125	DATE: NOV
----------------	-----------

SIGNATURE:




SIGNATURE:




H044 - 21

Antiqued Nickel 192mm C/C

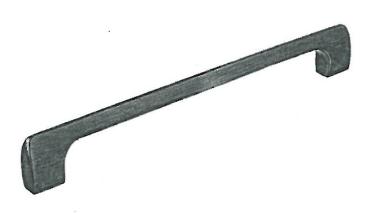


LOCATION:

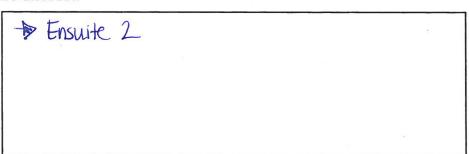


LOT# PV-125	DATE: NOV 5 12020
-------------	-------------------

SIGNATURE:

SIGNATURE:

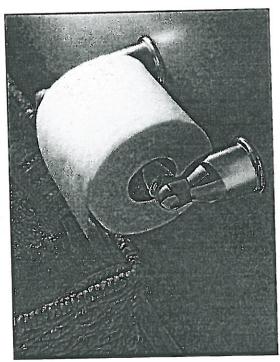



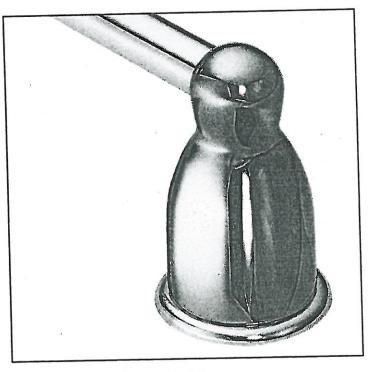

Towel Bar Mason - Chrome

* PLEASE SELECT ONE: *

INSTALL STANDARD BATHROOM ACCESSORIES THRU OUT (tissue holder + towel bar) *location as per vendors discretion*

DO NOT INSTALL STANDARD BATHROOM ACCESSORIES
THRU OUT *tissue holder + towel bar will not be provided*

4			
LOT# PV-125	DATE: NOV 5 12020		
SIGNATURE:			
SIGNATURE:		1	




Project:	Pine Valle	y		*	 Lot:	125
				¥	. 97	
Purchaser(s): Abdul	Rafah	Mudassa	<i>Y</i>		
Standard H	ood Fan Deletio	on				
	rledge that the ply, install and/o					sing.
Signature:	W					
Signature:					1	
Date:	Maylonology	5 .702				



MT6X6

Shower Door Handle

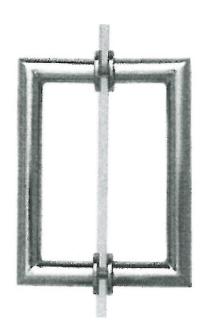

MT6X6 Shower Door Handle

6" x 6" back-to-back 3/4" dia. tube Cut and mitred corners with washers (Also available single sided)

V	CHROME
	MATTE BLACK

Lot#pV-125	Date: Nov 5 12020	Room, Master Ensuite, Ensuite 3/4
Signature:		
Signature:		



PROJECT PARTNER: Abdul Mudassar

SHIP TO:

Abdul Mudassar

lot no. 125 GOLD PARK HOMES KLEINBURG

REMINDER:

To ensure a smooth project it is the responsibility of the homeowner / purchaser of appliances to share all the attached specifications with their cabinet provider, contractor, or any other tradesperson so they have the information required to complete their work accurately. Product specifications are for planning purposes only and are subject to change without notice. Refer to installation instructions shipped with the product before cutting cabinets, counters, panels, etc.

Full Spec Package

Abdul Mudassar

Abdul Mudassar

lot no. 125 GOLD PARK HOMES KLEINBURG

Pages
3-4
5-8
9-16
17-20
21-22
23-25



Tasco Appliances

tascoappliance.ca

BOBBY NANDWANI

4163009545

Search 20201204231520007SC

Version 1.1

Fri, Dec 4, 2020 6:15 PM EST



steelcod.com/sp/tasc/XFUU4RE3

Note about page numbers:

Refrigerator with Internal Dispenser

Because the original manufacturer's documents are not altered in any way, the page numbers displayed on the page may not correspond to the page number within this package.

All specifications are intended for initial planning purposes only.

Manufacturers reserve the right to change specifications at any time without notice. Always consult the installation instructions found on the manufacturer's website or included with the appliances before installation.

IC-18FI-LH

26-28

Sub-Zero Refrigeration

18" Designer Column, Panel Ready, Freezer with Ice Maker

Note about page numbers:

Because the original manufacturer's documents are not altered in any way, the page numbers displayed on the page may not correspond to the page number within this package.

All specifications are intended for initial planning purposes only.

Manufacturers reserve the right to change specifications at any time without notice. Always consult the installation instructions found on the manufacturer's website or included with the appliances before installation.



SRT364G



FEATURES

Maintain control with four dual-stacked burners that go from 20,000 Btu down to a mere breath of flame

Simmer and melt sauces, soups, and marinades easily with the lower tier of the dual-stacked burner

Match other Sub-Zero, Wolf, and Cove products with heavy-gauge stainless steel and signature red infinite control knobs

Sear in seconds with the additional 15,000 Btu infrared griddle

Cleanup is a snap as sealed, seamless burner pans contain sloshes and spills

Move pots and pans effortlessly across the continuous cast-iron grates

Reignites flame automatically with spark ignition system

ACCESSORIES

11" Cutting Board

2-Burner Wok Grate

Black Knobs

Filler Trim

Griddle Cleaning Kit

Griddle Cleaning Pads

Griddle Cleaning Solution

Red Knobs

S-Grates

Stainless Steel Knobs

Stainless steel, brass or chrome bezels

High altitude conversion kits available


5" and 10" stainless steel risers, and 20" riser with shelf

Accessories available through an authorized dealer. For local dealer information, visit <u>subzero-wolf.com/locator</u>.





TOP CONFIGURATION

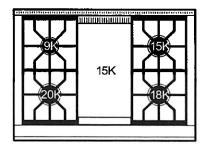

RANGETOP SPECIFICATIONS

- · Stainless-steel island trim (included)
- · Stainless-steel bezels
- 1 9,200 Btu burner
- 1 15,000 Btu burner
- 1 18,000 Btu burner
- · 1 20,000 Btu burner
- 1- Infrared 15,000 Btu (13,000 Btu LP) griddle



PRODUCT SPECIFICATIONS

Model SRT364G

35 7/8"W x 8 1/2"H x 28 1/2"D Dimensions

Electrical Supply 120 VAC, 60 Hz

Electrical Service 15 amp dedicated circuit


3/4" ID line Gas Supply

1/2" NPT female Gas Inlet

Receptacle 3-prong grounding-type


ELECTRICAL

GAS

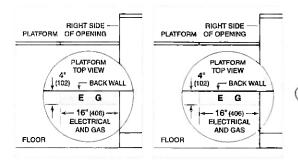


NOTE: Dimensions in parenthesis are in millimeters unless otherwise specified

DIMENSIONS

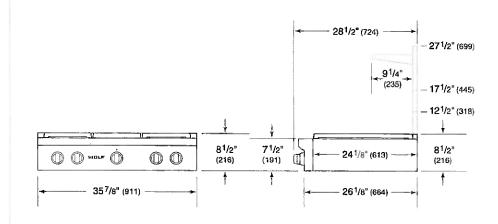

STANDARD INSTALLATION

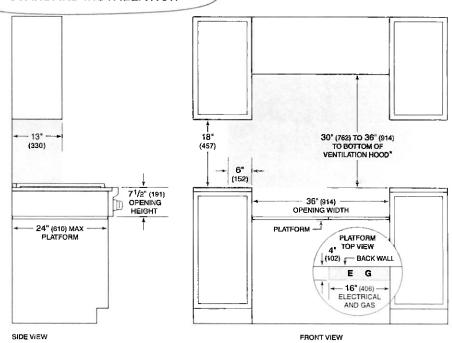

*Without ventilation hood, 36" (914) minimum clearance countertop to combustible materials, 44" (118) for charbroiler.

NOTE: Shaded area above countertop indicates minimum clearance to combustible surfaces,

combustible materials cannot be located within this area. Electrical and gas supply located through bottom of platform.

For island installation, 12" (305) minimum clearance back of range to combustible rear wall above countertop.

*

FEATURES

Preheats faster and cooks more consistently across all racks due to its advanced Dual VertiCross™ convection system

Assures predictably delicious results with a variety of modes, including Convection Roast, Proof, and Dehydrate

Prepares 50 popular dishes with the Gourmet feature that automatically adjusts cook times and temperatures

Includes options such as self-clean, delayed start, timed cook, Sabbath mode, and more

Handles multiple dishes simultaneously with our largest capacity oven (13 percent larger)

Insert a temperature probe to tell you exactly when it is done—and in gourmet mode, it will alert you the moment the dish is ready

Uncomplicate cooking with innovative, interactive color touchscreen controls

Makes a statement with Wolf's iconic red control knobs

Integrates beautifully into surrounding cabinetry with flush installation

Ensures excellent visibility via three bright halogen lights and large, triplepanel-glass door windows

Master your technique with tips and recipes from the Mastering the M series oven guide

ACCESSORIES

30" Broiler Pan

30" Premier Baking Sheet

Bake Stone Kit

Black Knobs

Black Knobs

Dehydration Kit

Dual Installation Kit

Full-Extension Ball Bearing Rack

Multi-Function Pan

Oven Rack

Oven Rack Set (3)

Red Knobs

Stainless Knobs

Stainless Knobs

Temperature Probe

Accessories available through an authorized dealer. For local dealer information, visit <u>subzero-wolf.com/locator</u>.





PRODUCT SPECIFICATIONS

Model

SO30PM/S/PH

Dimensions

29 7/8"W x 28 1/2"H x 23"D

Oven 1 Interior

25 1/4"W x 17 1/2"H x 19 7/8"D

Dimensions

Overall Capacity 5.1 cu. ft,

Usable Capacity 3.3 cu. ft.


Door Clearance 21 3/8"

Electrical Supply 240/208 VAC, 60 Hz

Electrical Service 30 amp dedicated circuit


Conduit Length 4 Feet

ELECTRICAL

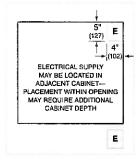


NOTE: Dimensions in parenthesis are in millimeters unless otherwise specified

DIMENSIONS

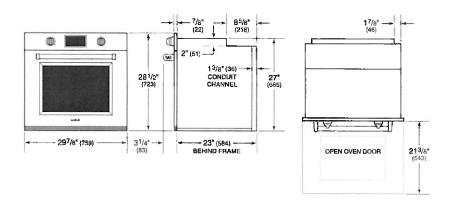

FLUSH INSTALLATION

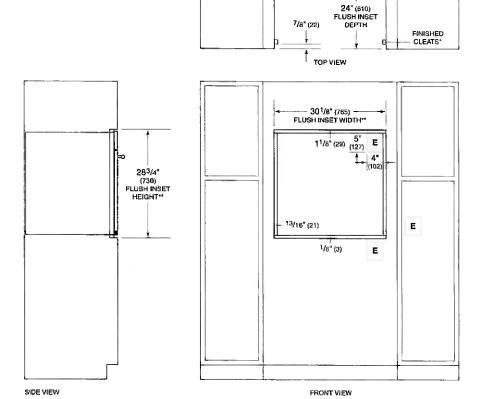

- *1" (25) minimum depth. Shaded areas will be visible and should be finished to match cabinetry.
- **Dimension provides minimum reveals.

NOTE: Location of electrical supply within opening may require additional cabinet depth.

30" M SERIES PROFESSIONAL SPEED OVEN

SPO30PM/S/PH

FEATURES

Available June 2019

Combines microwave, convection, and broil technologies to provide all-inone oven versatility

Provides more cooking power than a traditional microwave with the help of convection and broif

Assures predictably delicious results with 10 microwave power levels, convenient quick-start modes, and an intuitive Gourmet mode


Fits a 9-by-13 pan in the 1.6 cubic feet, stainless-steel interior

Micro Bake and Micro Roast modes reduce or completely eliminate preheat times

Frees up counter space with efficient drop-down door design

Coordinates with other Wolf built-in ovens and appliances with various handle and trim options

Master your technique with tips and recipes from the Mastering the Speed Oven guide

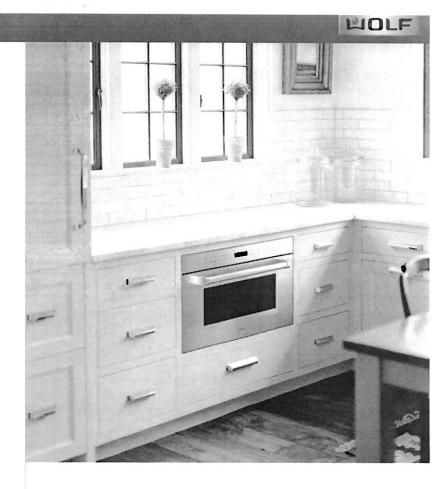

PRODUCT SPECIFICATIONS

Model

SPO30PM/S/PH

Dimensions

29 7/8"W x 17 7/8"H x 21 1/2"D

Capacity

1.6 cu. ft.

Door Clearance

14 3/16"

Electrical Supply

grounded, 240/208 VAC, 60 Hz

Electrical Service

15 amp dedicated circuit


Power Cord Length

6 Feet

Receptacle


NEMA 6-20R grounding type


ELECTRICAL

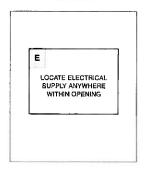

NOTE: Dimensions in parenthesis are in millimeters unless otherwise specified

DIMENSIONS

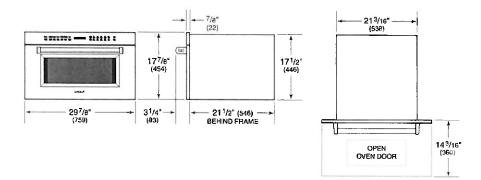

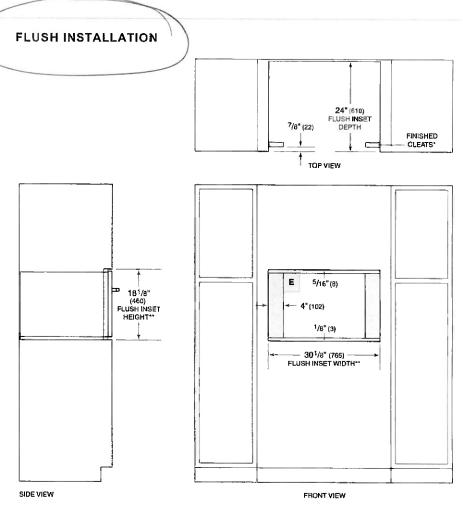

*Will be visible and should be finished to match cabinetry.

**Dimension provides minimum reveals



FEATURES

Adapts easily to differently shaped dishes and glasses with a heightadjustable middle rack and fold-down tines

Removes food and grease with three powerful spray arms and custom wash and dry options for different soil levels

Filters food efficiently through fine mesh for cleaner water throughout every cycle

Dries every type of dish, utensil, and pan thoroughly with a hot rinse and fan-assist

Operates in near silence that never interrupts

Matches classic Wolf and Sub-Zero stainless steel or accepts custom panels to integrate into any kitchen design

Opt for a stainless steel exterior panel for equal durability and a timeless, sophisticated look

Provides better visibility with interior LED lights

Maintains clean lines with sleek control panel and floor status light

Marvel at the durability of the stainless steel interior, built for decades of use

Monitor cycle progress, even start a new cycle, remotely. Receive alerts when rinse aid is low

ACCESSORIES

Pro Handle

Tubular Handle


24" Stainless Steel Door Panels

60cm Stainless Steel Door Panels

24" Stainless Steel Kickplates

60cm Stainless Steel Kickplates

Accessories are available through an authorized dealer. For local dealer information, visit subzero-wolf.com/locator.

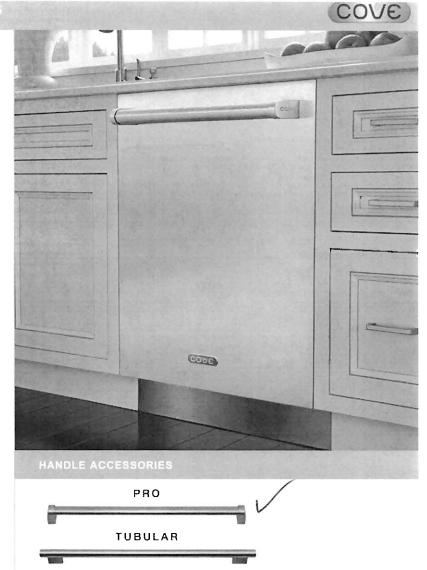

PRODUCT DETAILS

DISHWASHER

- · 4 LED lights (2 sides; 2 top)
- · 43 spray jets across three spray arms
- · Four-stage, fine mesh filter
- · Adjustable stemware rail
- · Adjustable cup shelf
- · Height-adjustable middle rack
- · Easy-glide bottom rack
- · Upper silverware rack
- · One large utensil basket



PRODUCT SPECIFICATIONS

Model DW2450

Dimensions 23 5/8"W x 34 1/2"H x 23 1/4"D

Door Clearance 26 3/4"

Sound Level 41 dBA (Model and cycle/option

dependent)

Electrical Supply 115 VAC, 60 Hz

Electrical Service 15 amp dedicated circuit

Receptacle 3-prong grounding-type

Cord Length

Water Connection 5' braided tubing with 3/8" female


compression fitting


Drain Connection 5' (1.5 m) corrugated tubing

Plumbing Pressure 30–140 psi

ELECTRICAL

PLUMBING

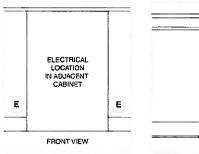


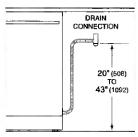

COVE OPENING WIDTH Cove dishwashers accommodate varying opening widths, A 23 5/8" (60 cm) width provides minimum reveals and is ideal for new construction. A 24" width is also common; however, reveals for a 24" opening will be larger than the reveals for a 23 5/8" opening unless the panel width is adjusted accordingly. 24" and 60 cm stainless steel panels are available and must be specified accordingly.


PANEL SPECIFICATIONS For complete panels specifications including width/height, weight requirements and thickness requirements visit subzero-wolf.com/reveal.

INTERIOR VIEW

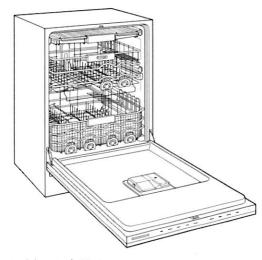


This illustration is intended for interior reference only and may not represent the exterior of the model being specified


DIMENSIONS

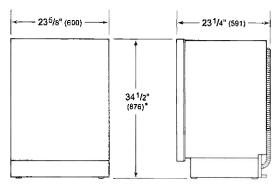


*34" (864) MIN TO345/8" (880) MAX

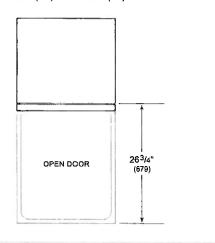

24" INSTALLATION

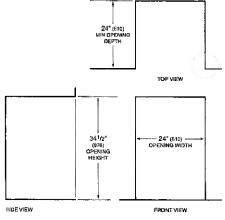

NOTE: 31/21 (99) finished returns will be visible and should be timehed to match cabinetry.

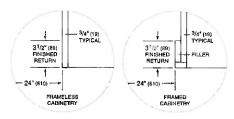

IMPORTANT NOTE: The dishwasher opening width determines the custom panel width. The panel width should be 1/4" (6) less than the opening width to achieve minimum reveals.

The panel dimensions in the chart below are based on a 341/2" (876) opening, with a 4" (102) toe kick and 1/8" (3) top reveal. For all other opening and toe kick heights, adjust the panel accordingly. The minimum panel height is 28" (711). The minimum toe kick height is 4" (102).


Finish all sides of the custom panel. They may be visible when the door is open.

Locate the handle near the top of the door. Handle mounting hardware must be flush with the back of the door panel.

PANEL DIMENSIONS		Н
23 ⁵ /8" (60 cm) Opening	23 ³ /8* (594)	303/8" (772)
24" (610) Opening	233/4" (603)	30 ³ /8" (772)

Max Weight (including handle)	20 lb (9 kg)*
Min Thickness	¹ /2" (13)

^{*}Less than 16 lb (7 kg) is optimal.

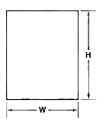

Panel dimensions

Stainless steel accessory door panels are available in two widths to accommodate a 235/8" (60 cm) or a 24" (610) opening. The panels are also available in two heights to accommodate a 4" (102) or 6" (152) toe kick. Refer to the chart below for panel dimensions. The panels are available through an authorized Cove dealer. For local dealer information, use the showroom, sales, and service search tool on coveappliance.com.

4" (102) TOE KICK	W	Н	
23 ⁵ /s" (60 cm) Opening	23 ³ /8" (594)	30 ³ /8" (772)	3/4" (19)
24" (610) Opening	23 ³ /4" (603)	303/8" (772)	³ /4" (19)
6" (152) TOE KICK	W		
23 ⁵ /s" (60 cm) Opening	23 ³ /8" (594)	283/8" (721)	3/4" (19)
24" (610) Opening	23 ³ /4" (603)	28 ³ /8" (721)	3/4" (19)

STANDARD HANDLES


Optional stainless steel tubular and pro handles are available through an authorized Cove dealer. For local dealer information, use the showroom, sales, and service search tool on coveappliance.com. Refer to the chart below for standard handle lengths for the dishwasher.

Tubular	21 ¹ / ₄ " (540)
Pro	191/2" (495)

Door Panel

KICKPLATE CLEARANCE


It is possible to adhere a custom kickplate to the factory kickplate. The height and thickness can vary, provided it does not impede the door panel rotation. Refer to the illustration below.

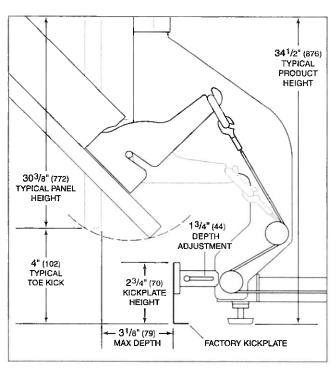

Toe kick area (side view)

KICKPLATE

The upper right corner of any kickplate exceeding 3³/8" (86) in height must be notched to allow for airflow. Refer to the illustration below.

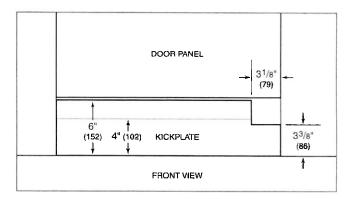

Kickplate notch

Sub-Zero, Sub-Zero & Design, Sub-Zero & Snowflake Design, Dual Refrigeration, The Living Kitchen, Great American Kitchens The Fine Art of Kitchen Design, Wolf, Wolf & Design, Wolf Gourmet, W & Design, red colored knobs, Cove, and Cove & Design are registered trademarks and service marks of Sub-Zero Group, Inc. and its subsidiaries, All other trademarks are property of their respective owners in the United States and other countries.





halogen lamps





stainless steel baffle slot filters



Arezzo provides professional grade performance, while being discreetly mounted inside the cabinetry. Arezzo is available in 28 1/2" width with a 600 CFM blower, and equipped with a 1200 CFM blower for widths of 34 1/2", 40 1/2" and 46 1/2" for extraordinary ventilating power.

The extra depth (22") is ideal for supporting powerful professional ranges. Plus the All-In-One design avoids the need to purchase a stainless liner. Metallic rotating knob controls operate the 4 speed blower and halogen lighting.

Easy maintenance, higher efficiency and a cleaner kitchen are ensured by Elica's patented Baffle Slot Filters, which capture a higher percentage of contaminants and hold larger volumes of grease than traditional baffle filters. Arezzo is designed for standard ducted installation only.



FEATURES

Size (in) & Type Finish 28", 34", 40" or 46" Wide Insert

Stainless Steel

Controls Metallic Rotating Knob

Illumination 2, 40 Watt Halogen Lamps, 1 Light Intensity (28" & 34") (bulbs included)

4, 40 Watt Halogen Lamps, 1 Light Intensity (40" & 46") (bulbs included)

Installation Type Ducted Installation Only

Blower Type 600 CFM, 4-Speed Internal (28" Unit)

1200 CFM, 4-Speed Internal (34", 40", 46" Units)

Biower Performance Speed 1, 90 CFM, 2.1 Sones / 380 CFM, 2.8 Sones

Speed 2, 330 CFM, 4.4 Sones / 660 CFM, 6.7 Sones Speed 3, 490 CFM, 7.8 Sones / 950 CFM, 8.5 Sones Speed 4, 600 CFM, 11.9 Sones / 1200 CFM, 14.3 Sones

Filter Type Dishwasher-Safe, Stainless Steel Baffle Slot

(2 w/ 28" Unit, 3 w/ 34" & 40" Units, 4 w/ 46" Unit)

Duct Transition 10" Round with Back Draft Damper (top only)

Electrical 120V-60Hz

550 Watts at 4.6 Amps (600 CFM) 1000 Watts at 8.3 Amps (1200 CFM)

Warranty 2 Year Parts & Labor, In-Home Service

ACCESSORIES

Replacement Grease Filter (1)


CODE: GF061A

Replacement Light Bulb (1)


CODE: 2006BH

Consumable parts are sold in units of one (1). Order accordingly.

LINE DRAWING

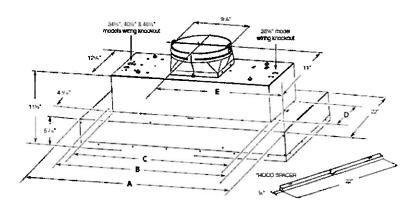

Range Hood mod.	DIMENSIONS					
	DIM A	DIM A + spacers	DIM B	DIM C mounting holes	DIM D mounting holes	DIM E
EAR628SS	285°	30*	241/4	22"	11"	14"
EAR134SS	3416*	36"	29"/14"	27%*	107m²	177
EAR140SS	40%"	A; *	29144	27%*	10/ы*	20"
EAR146SS	405	46'	53.44.	27%	10Vn/*	53.

 







FEATURES

All-refrigerator storage solves capacity problems

Ready to be fitted with custom panels and handles to blend with cabinetry

Air purification system fights spoilage, odors

Internal water dispenser works with seamless design

Water-filtration system reduces contaminants, chlorine taste and odor

Nano-coated spill-proof shelves for easy clean-up

Smart-touch controls for streamlined access to more settings

Rigorously tested in our U.S. manufacturing facilities to ensure decades

Exceptional 24/7 support from Madison, WI-based Customer Care team

Soft-close doors and drawers

Soft-on LED lights for varying degrees of brightness

Uniform 84" height

ACCESSORIES

Air Purification Cartridge

Egg Container

Stainless steel tubular handles

Stainless steel pro handles

Dual installation kits

Stainless steel front panels with tubular or pro handles

Stainless steel kickplate


Stainless steel side enclosure

Stainless steel top enclosure

Reduced toe kick divider for toe kicks from 2" to 3.875"

Replacement water filter

Accessories are available through an authorized Sub-Zero dealer. For local dealer information, visit subzero-wolf.com/locator.

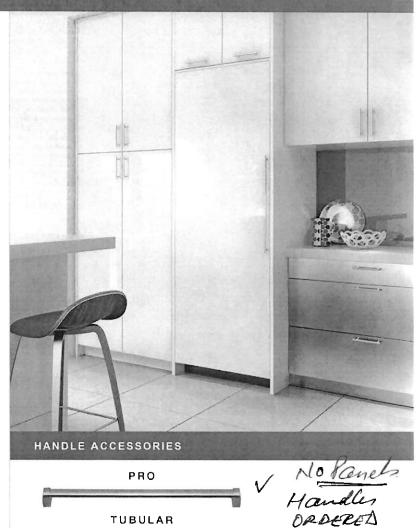


PRODUCT DETAILS

TUBULAR

REFRIGERATOR

- · Three adjustable glass shelves
- · Two crisper drawers with dividers
- · Deli drawer with dividers
- · Three adjustable door shelves
- · Two stationary door shelves
- · Adjustable dairy compartment
- · Air purification system

 

PRODUCT SPECIFICATIONS

Model

IC-30RID

Dimensions

30"W x 84"H x 24"D

Door Clearance

28 1/2"

Weight

400 lbs

Refrigerator Capacity

17,3 cu. ft.

Electrical Supply

115 VAC, 60 Hz

Electrical Service

15 amp dedicated circuit

Plumbing Supply

.

1/4" OD copper, braided stainless steel or

Plumbing Pressure


PEX tubing 35-120 psi


Receptacle

3-prong grounding-type


ELECTRICAL

PLUMBING

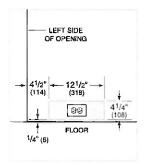

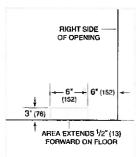



INTERIOR VIEW

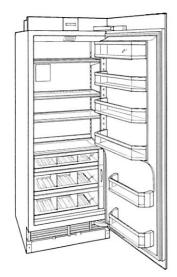


This illustration is intended for interior reference only and may not represent the exterior of the model being specified.

DIMENSIONS

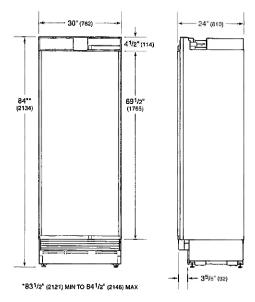

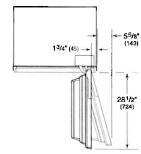


STANDARD INSTALLATION

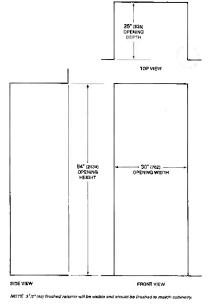



Panel Specifications

Single Model: IC-30RID

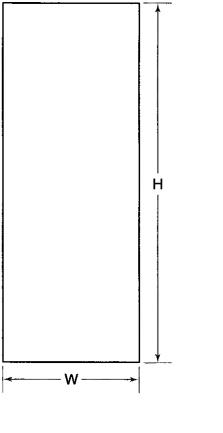

PANEL WIDTH HEIGHT MIN THICKNESS MAX WEIGHT Door $29 \, \%$ 79 % 79 % 75 lbs

PLEASE NOTE: Panel specs change slightly when units are combined. Visit http://www.subzero-wolf.com/trade-resources/reveal for exact dimensions.





FEATURES

Ready to be fitted with custom panels and handles to blend with cabinetry

Water-filtration system for ice reduces contaminants, chlorine taste and oder

Smart-touch controls for streamlined access to more settings

Soft-on LED lights for varying degrees of brightness

Uniform 84" height

Automatic ice maker with "max ice" feature

All-freezer storage solves capacity problems

Rigorously tested in our U.S. manufacturing facilities to ensure decades of use

Exceptional 24/7 support from Madison, WI-based Customer Care team

ACCESSORIES

Stainless steel tubular handles

Stainless steel pro handles

Dual installation kits

Stainless steel front panels with tubular or pro handles

Stainless steel kickplate


Stainless steel side enclosure

Stainless steel top enclosure

Reduced toe kick divider for toe kicks from 2" to 3.875"

Replacement water filter

Accessories are available through an authorized Sub-Zero dealer. For local dealer information, visit <u>subzero-wolf.com/locator</u>.

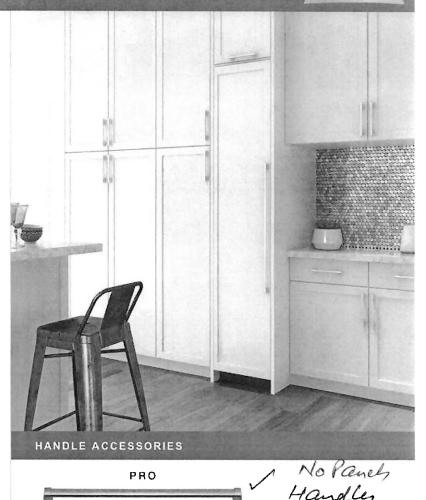

PRODUCT DETAILS

TUBULAR

FREEZER

- · Three adjustable wire shelves
- · Two storage drawers
- · Four adjustable door shelves
- · Ice drawer
- · Automatic ice maker

PRODUCT SPECIFICATIONS

Model IC-18FI

Dimensions 18"W x 84"H x 24"D

Door Clearance 16 1/2"

Weight 260 lbs

Freezer Capacity 8.4 cu. ft.

Electrical Supply 115 VAC, 60 Hz

Electrical Service 15 amp dedicated circuit

Plumbing Supply 1/4" OD copper, braided stainless steel or


PEX tubing


Plumbing Pressure 35–120 psi

Receptacle 3-prong grounding-type


ELECTRICAL

PLUMBING

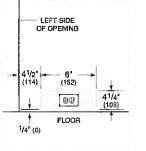

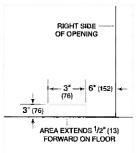



INTERIOR VIEW

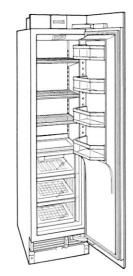


This illustration is intended for interior reference only and may not represent the exterior of the model being specified.

DIMENSIONS

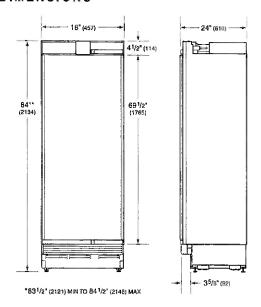


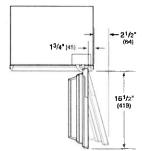

STANDARD INSTALLATION

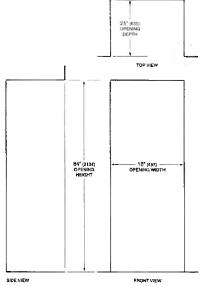

NOTE 31/2" (sa) finished returns will be visible and should be limithed to match cabinetr

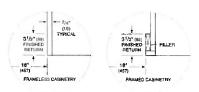


Panel Specifications

PANEL

Door

Single Model: IC-18FI

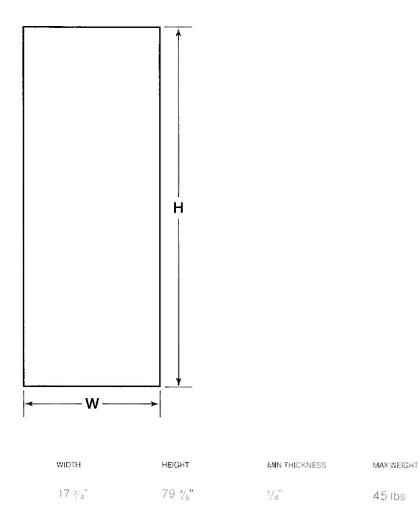

PLEASE NOTE: Panel specs change slightly when units are combined. Visit http://www.subzero-wolf.com/trade-resources/reveal for exact dimensions.