

GOLDPARK

WORTH MORE™

CONSTRUCTION SUMMARY

Lot: 82

Model: 50.04 B BEAUMONT

Project/Phase: Pine Valley Forevergreen / 1

BASEMENT WINDOWS

Invoice	Qty.	Description
2624 72,351 10Mar21	5	BASEMENT WINDOWS - UPGRADE BASEMENT WINDOW SIZE TO 30 " X 24" - 8" FRAME

CONCRETE AND DRAIN

Invoice	Qty.	Description
2624 101,930 10Mar21	1	BACK FLOW PREVENTER VALVE

EXTERIOR COLOURS

Invoice	Qty.	Description
2624 10Mar21 NoCat	1	EXTERIOR COLOURS PACKAGE: BR5

FORMING

Invoice	Qty.	Description
2624 72,560 10Mar21	1	MODEL OPTIONS 50.04 - KITCHEN REAR - OPT. COVERED LOGGIA AS PER PLAN


SCHEDULE 'F'



PV-82. attached
March 5 2021

The
Beaumont
50' SERIES

Elevation A • 4,170 sq.ft.
4,315 sq.ft. Opt. Elevator
→ Elevation B • 4,165 sq.ft.
4,315 sq.ft. Opt. Elevator
Elevation C • 4,250 sq.ft.
4,400 sq.ft. Opt. Elevator

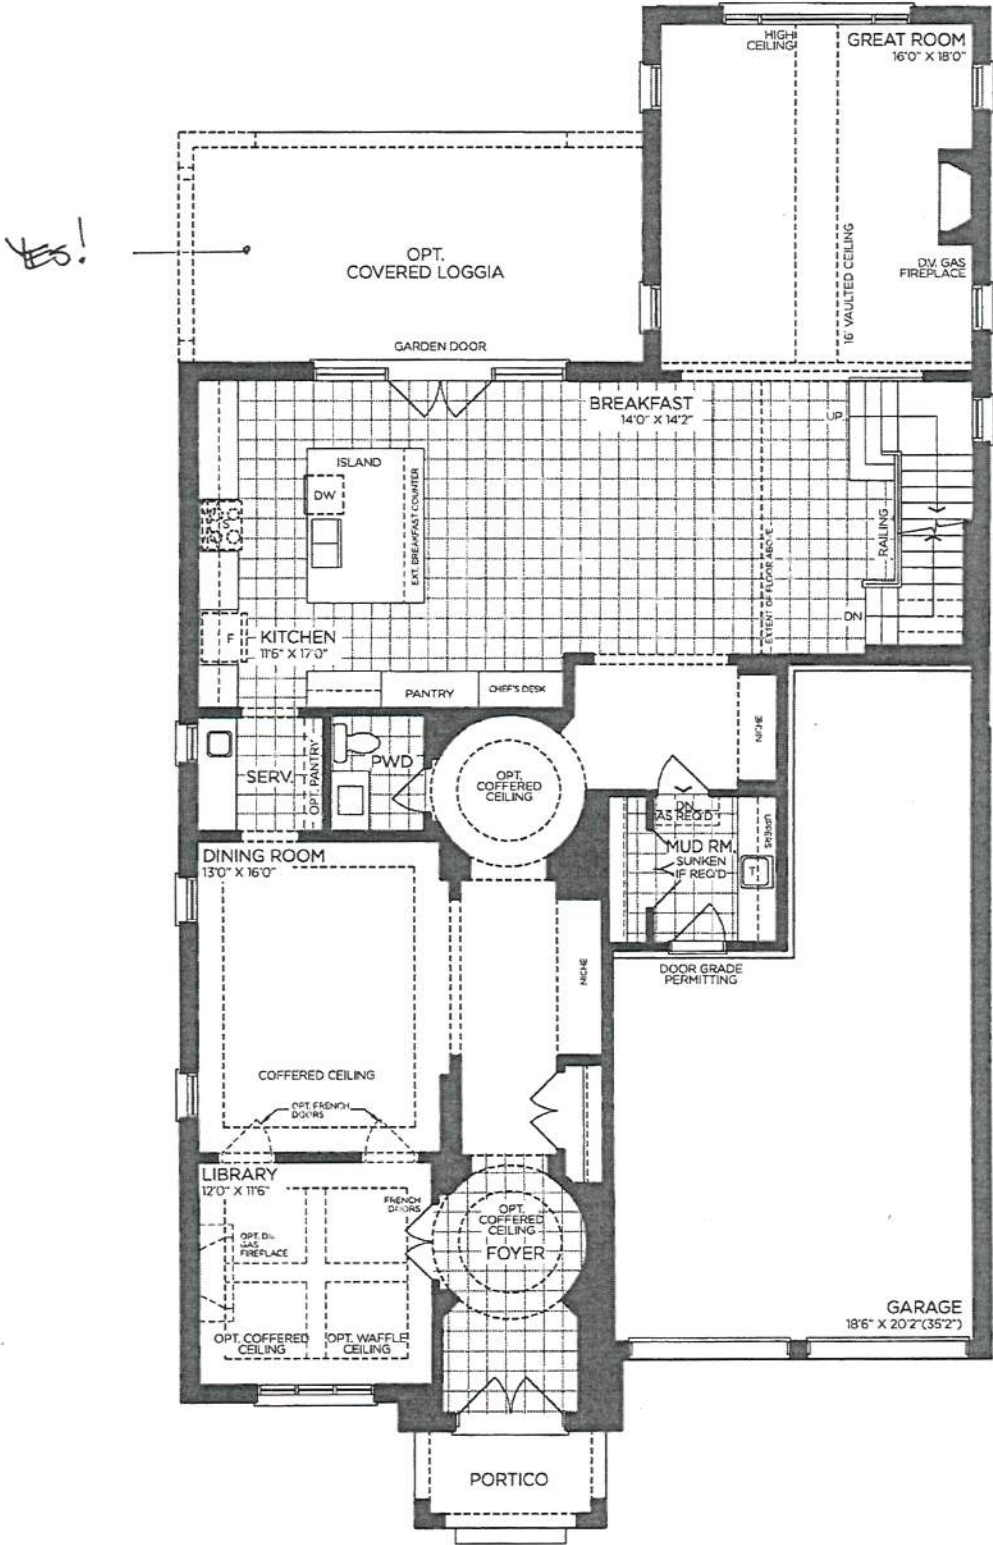

GROUND FLOOR | ELEV. A

VENDOR

PURCHASER

PURCHASER

GOLDPARK
WORTH MORE™

Prices, figures, illustrations, sizes, features and finishes are subject to change without notice. Areas and dimensions are approximate and actual usable floor space may vary from the stated area. Layout may be reverse of the unit purchased. E. & O.E. 5004



SCHEDULE 'F'
attached
FV-82
March 5 2021

The Beaumont

50' SERIES

Elevation A • 4,170 sq.ft.


4,315 sq.ft. Opt. Elevator

→ Elevation B • 4,165 sq.ft.

4,315 sq.ft. Opt. Elevator

Elevation C • 4,250 sq.ft.

4,400 sq.ft. Opt. Elevator

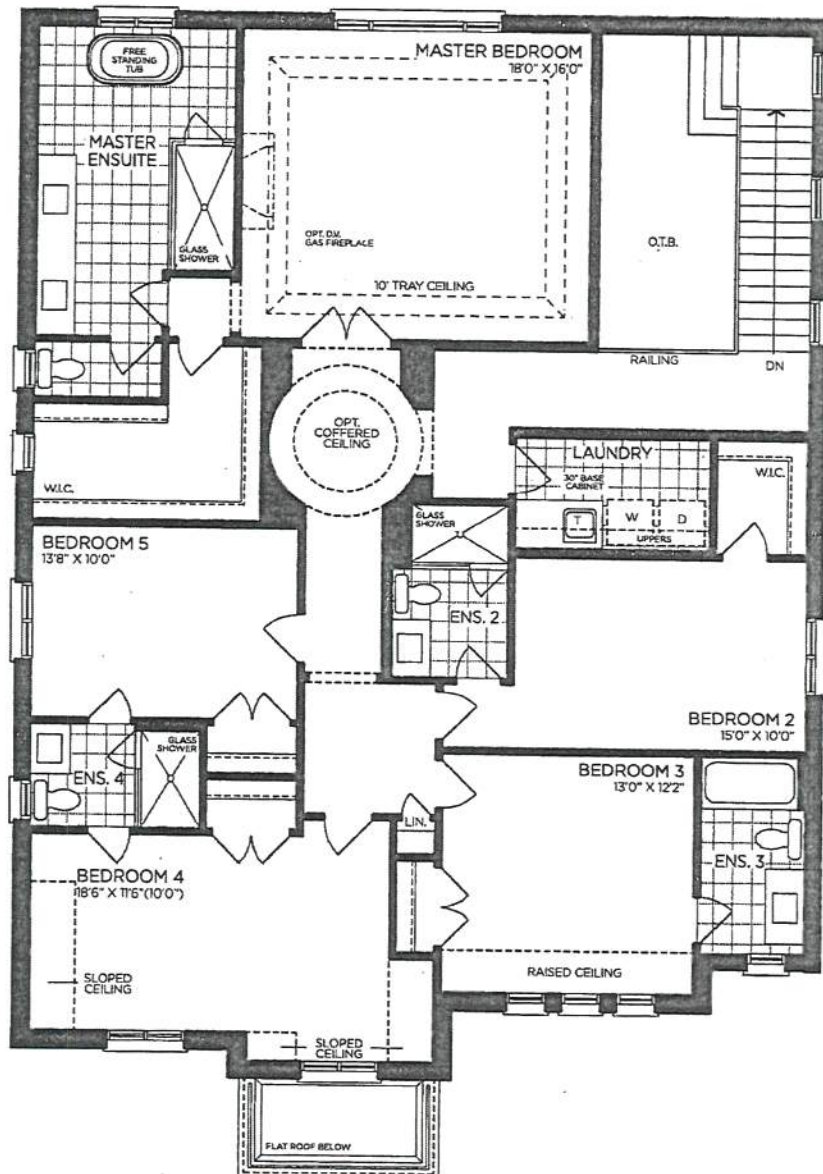

OPT. SECOND FLOOR | ELEV. A
5 BEDROOM

VENDOR
PURCHASER
PURCHASER

GOLDPARK
WORTH MORE™

Prices, figures, illustrations, sizes, features and finishes are subject to change without notice. Areas and dimensions are approximate and actual usable floor space may vary from the stated area. Layout may be reverse of the unit purchased. E. & O.E. 5004



SCHEDULE 'F'

attached
PV-82
March 5 2021

The Beaumont 50' SERIES

Elevation A • 4,170 sq.ft.


4,315 sq.ft. Opt. Elevator

→ Elevation B • 4,165 sq.ft.


4,315 sq.ft. Opt. Elevator

Elevation C • 4,250 sq.ft.


4,400 sq.ft. Opt. Elevator

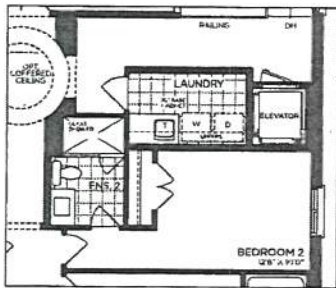


OPT. PART. SECOND FLOOR | ELEV. A
(ELEVATOR)

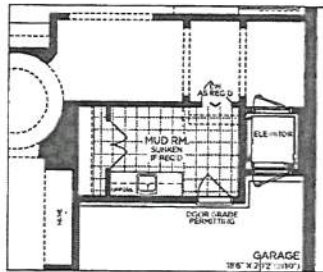


OPT. GROUND FLOOR | ELEV. A
(ELEVATOR)

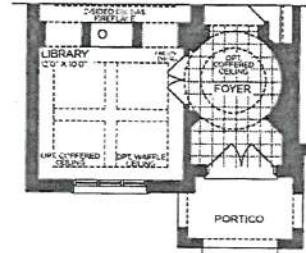


PART. OPT. LIBRARY GROUND FLOOR
ELEV. A, B & C

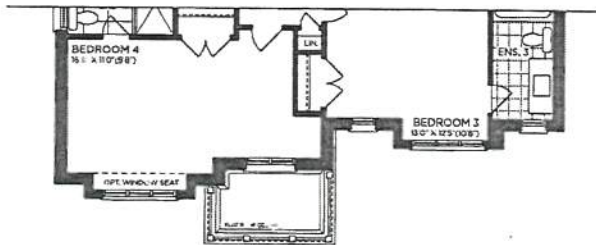


→ PART. OPT. SECOND FLOOR | ELEV. B
5 BEDROOM

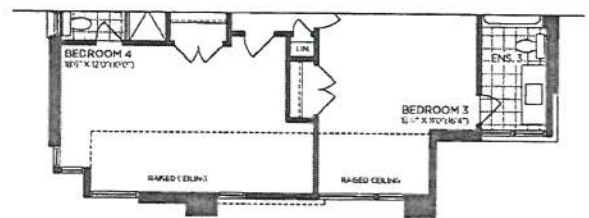


PART. OPT. SECOND FLOOR | ELEV. C
5 BEDROOM

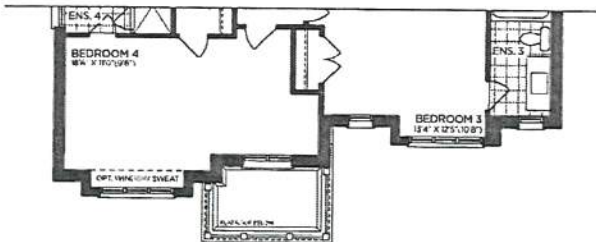


→ PART. SECOND FLOOR | ELEV. B

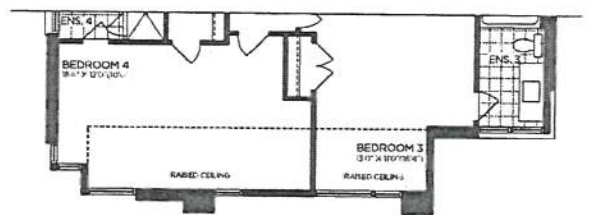


PART. SECOND FLOOR | ELEV. C

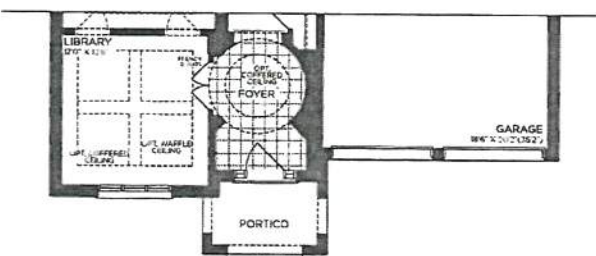


→ PART. GROUND FLOOR | ELEV. B

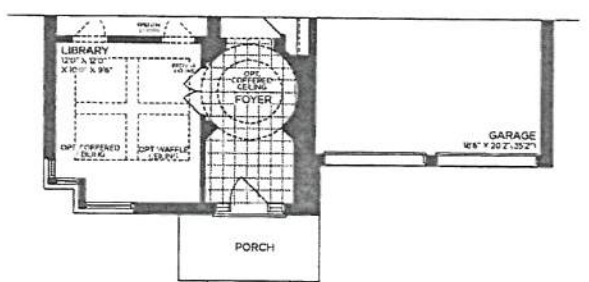


PART. GROUND FLOOR | ELEV. C

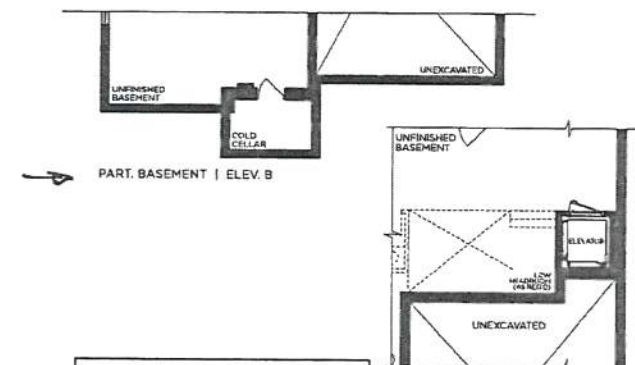

→ PART. BASEMENT | ELEV. B

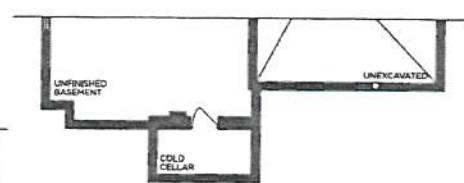

PART. BASEMENT | ELEV. C

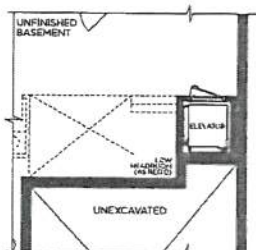

OPT. BASEMENT | ELEV. A
(ELEVATOR)

VENDOR

PURCHASER

PURCHASER

GOLDPARK
WORTH MORE™

Prices, figures, illustrations, sizes, features and finishes are subject to change without notice. Areas and dimensions are approximate and actual usable floor space may vary from the stated area. Layout may be reverse of the unit purchased. E. & O.E. 5004

SCHEDULE 'F'



PV-82 attached
March 5 2021


The
Beaumont
50' SERIES

Elevation A • 4,170 sq.ft.
4,315 sq.ft. Opt. Elevator

→ Elevation B • 4,165 sq.ft.
4,315 sq.ft. Opt. Elevator

Elevation C • 4,250 sq.ft.
4,400 sq.ft. Opt. Elevator

24x30"

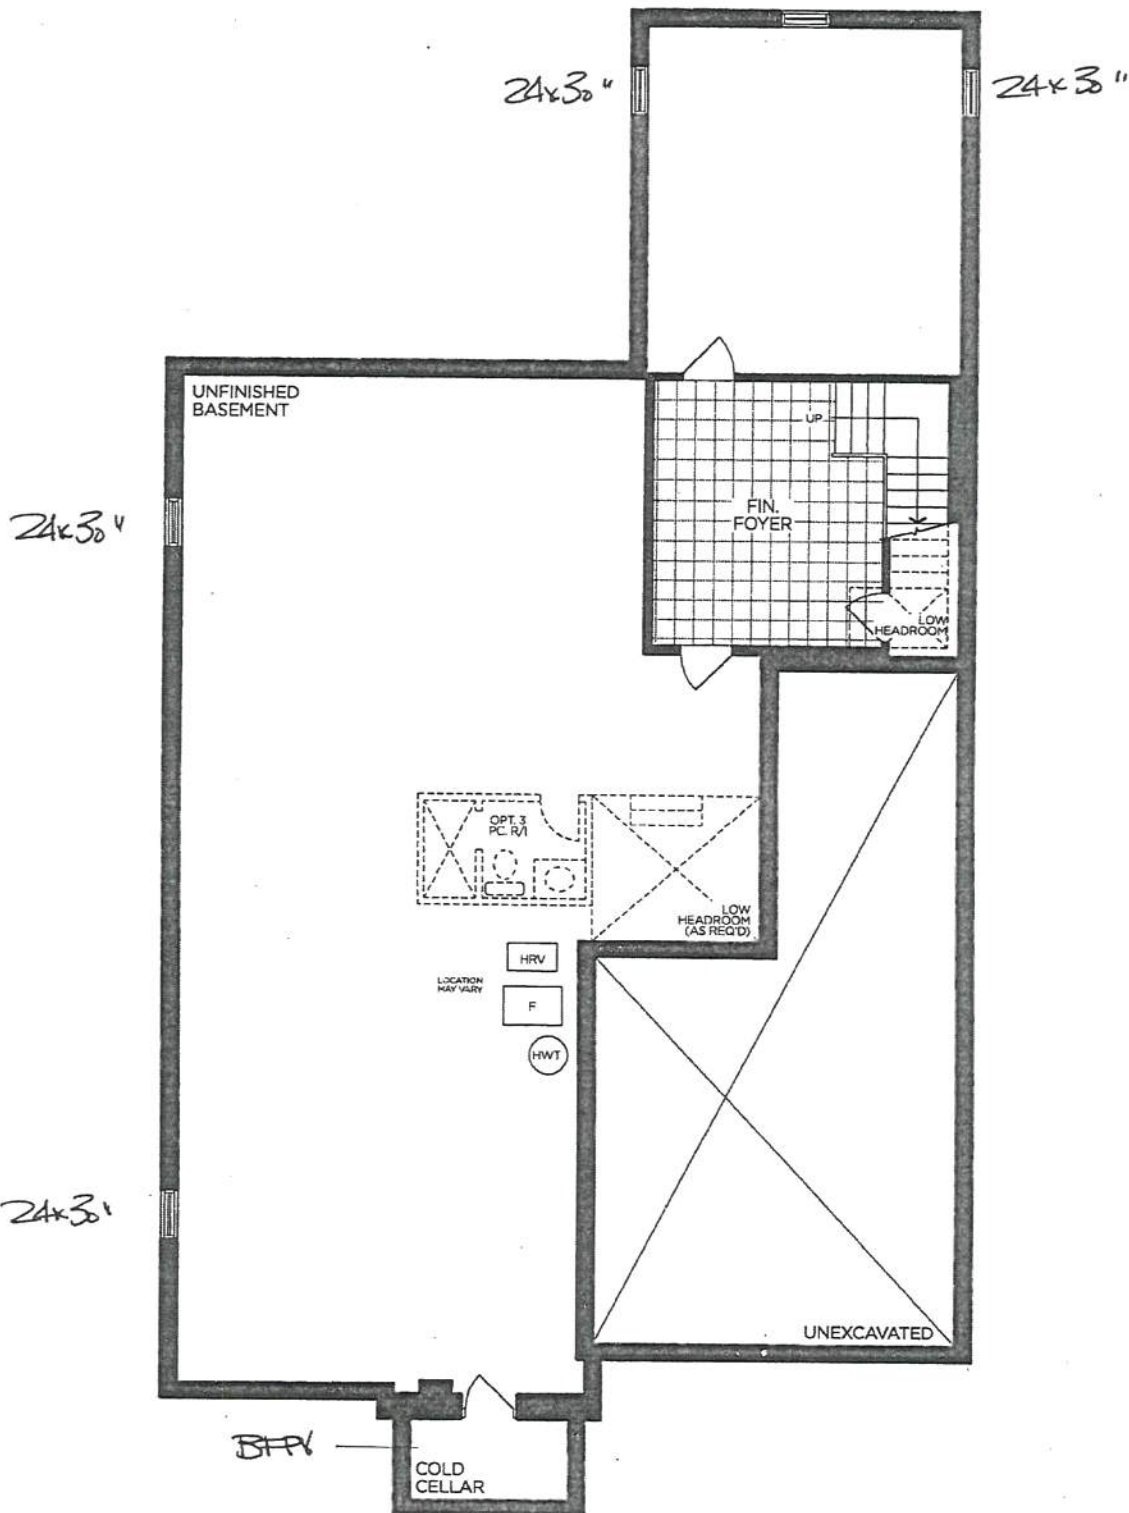

BASEMENT | ELEV. A

VENDOR

PURCHASER

PURCHASER

GOLDPARK
WORTH MORE™

Prices, figures, illustrations, sizes, features and finishes are subject to change without notice. Areas and dimensions are approximate and actual usable floor space may vary from the stated area. Layout may be reverse of the unit purchased. E. & O.E. 5004

SCHEDULE 'F'



PV-82.
MARCH 5 2021

The Beaumont

50' SERIES

Elevation A • 4,170 sq.ft.


4,315 sq.ft. Opt. Elevator

→ Elevation B • 4,165 sq.ft.

4,315 sq.ft. Opt. Elevator

Elevation C • 4,250 sq.ft.

4,400 sq.ft. Opt. Elevator

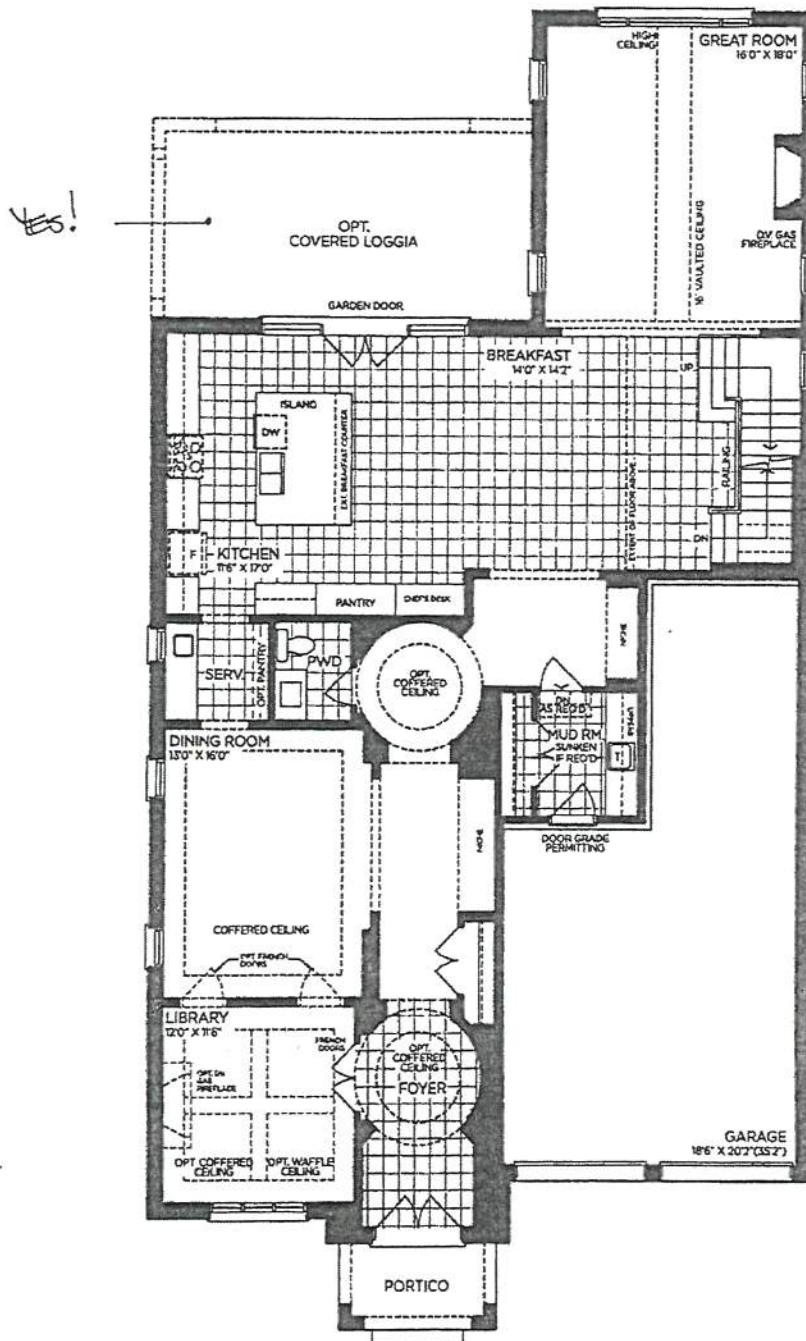

GROUND FLOOR | ELEV. A

VENDOR
PURCHASER
PURCHASER

GOLDPARK
WORTH MORE™

Prices, figures, illustrations, sizes, features and finishes are subject to change without notice. Areas and dimensions are approximate and actual usable floor space may vary from the stated area. Layout may be reverse of the unit purchased. E. & O.E. 5004

SCHEDULE 'F'



PV-82
MAY 5 2021

The Beaumont

50' SERIES

Elevation A • 4,170 sq.ft.


4,315 sq.ft. Opt. Elevator

Elevation B • 4,165 sq.ft.

4,315 sq.ft. Opt. Elevator

Elevation C • 4,250 sq.ft.

4,400 sq.ft. Opt. Elevator

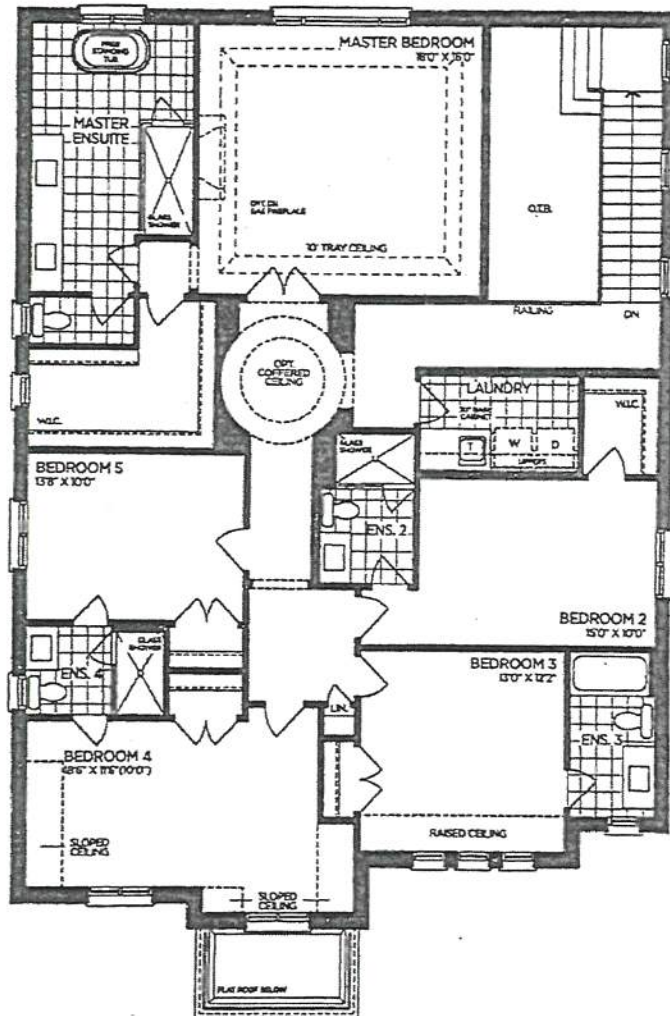

OPT. SECOND FLOOR | ELEV. A
5 BEDROOM

VENDOR
PURCHASER
PURCHASER

GOLDPARK
WORTH MORE™

Prices, figures, illustrations, sizes, features and finishes are subject to change without notice. Areas and dimensions are approximate and actual usable floor space may vary from the stated area. Layout may be reverse of the unit purchased. E. & O.E. 5004

SCHEDULE 'F'




PV-82
March 5 2021

The Beaumont 50' SERIES


Elevation A • 4,170 sq.ft.
4,315 sq.ft. Opt. Elevator

→ Elevation B • 4,165 sq.ft.
4,315 sq.ft. Opt. Elevator


Elevation C • 4,250 sq.ft.
4,400 sq.ft. Opt. Elevator

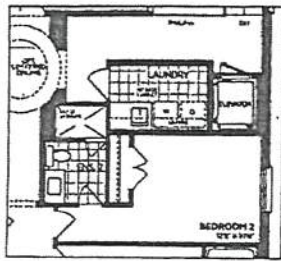


OPT. PART. SECOND FLOOR | ELEV. A
(ELEVATOR)

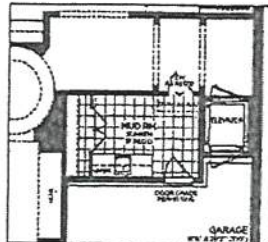


OPT. GROUND FLOOR | ELEV. A
(ELEVATOR)

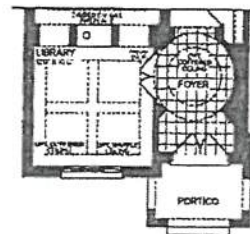


PART. OPT. LIBRARY GROUND FLOOR
ELEV. A, B & C

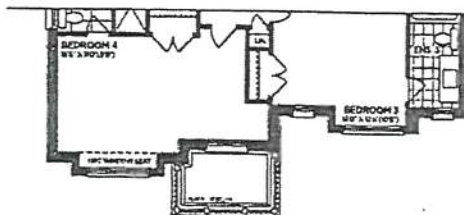


* → PART. OPT. SECOND FLOOR | ELEV. B
5 BEDROOM

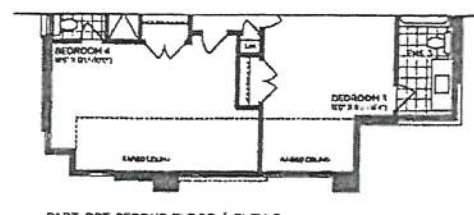


PART. OPT. SECOND FLOOR | ELEV. C
5 BEDROOM

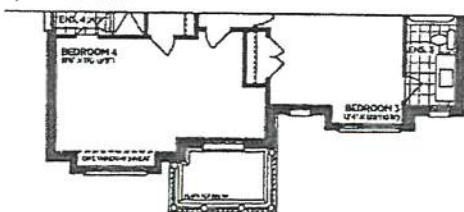


* → PART. SECOND FLOOR | ELEV. B

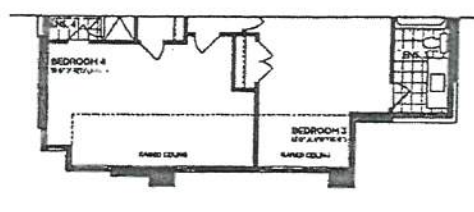


PART. SECOND FLOOR | ELEV. C

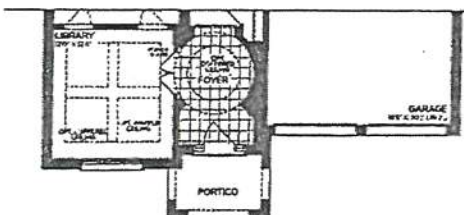


* → PART. GROUND FLOOR | ELEV. B

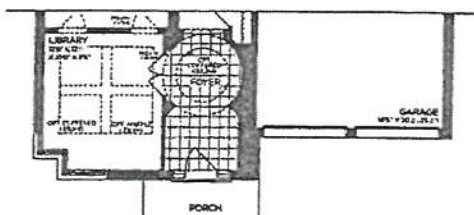


PART. GROUND FLOOR | ELEV. C

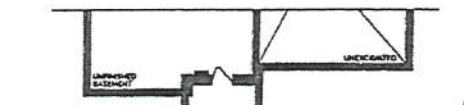

* → PART. BASEMENT | ELEV. B

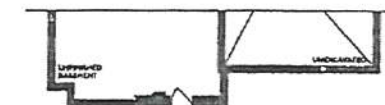

PART. BASEMENT | ELEV. C

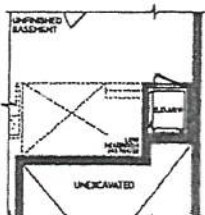

OPT. BASEMENT | ELEV. A
(ELEVATOR)

VENDOR

PURCHASER

PURCHASER

[Signature]

GOLDPARK
WORTH MORE™

Prices, figures, illustrations, sizes, features and finishes are subject to change without notice. Areas and dimensions are approximate and actual usable floor space may vary from the stated area. Layout may be reverse of the unit purchased. E. & O.E. 5004


SCHEDULE 'F'



PV-82
March 5 2021

The
Beaumont
50' SERIES

Elevation A • 4,170 sq.ft.
4,315 sq.ft. Opt. Elevator
→ Elevation B • 4,165 sq.ft.
4,315 sq.ft. Opt. Elevator
Elevation C • 4,250 sq.ft.
4,400 sq.ft. Opt. Elevator

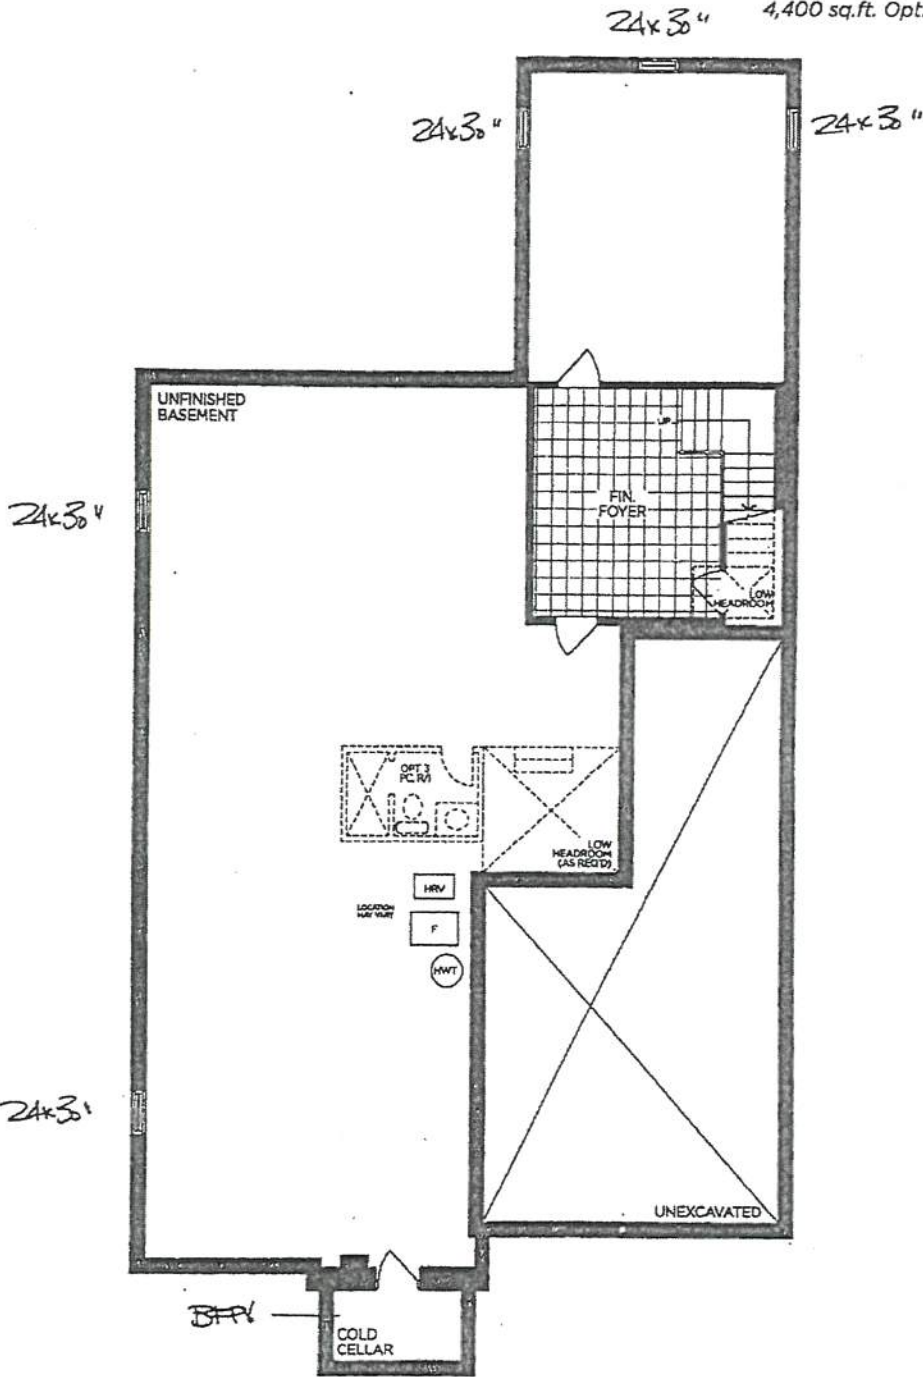

BASEMENT | ELEV. A

VENDOR
PURCHASER
PURCHASER

GOLDPARK
WORTH MORE™

Prices, figures, illustrations, sizes, features and finishes are subject to change without notice. Areas and dimensions are approximate and actual usable floor space may vary from the stated area. Layout may be reverse of the unit purchased. E. & O.E. 5004