



CONSTRUCTION SUMMARY

Lot: 51

Model: 42.02 B ROSEDALE OPT. LIBRARY

Project/Phase: Pine Valley Forevergreen / 1

CERAMIC

| Invoice                      | Qty. | Description   |
|------------------------------|------|---|
| 2694<br><br>12Apr21<br>NoCat | 1    | MASTER ENSUITE: SHOWER NICHE [SHAMPOO SHELF] - COMPLETE WITH MATCHING MARBLE JAMBS ON 4 SIDES, STANDARD TILE, APPROX. 12 X 18 INSTALLED VERTICALLY - SEE PLAN                                    |
| 2697<br>35<br>12Apr21        | 1    | MASTER ENSUITE: TILE, FLOOR , LEVEL 3 - 12X24" LAID IN STRAIGHT, STACKED PATTERN. SEE PLAN FOR TILE DIRECTION                                                                                    |
| 2697<br>45<br>12Apr21        | 1    | MASTER ENSUITE: FLOOR TILE, LEVEL 3 - 12X24" LAID IN HORIZONTAL STACKED PATTERN.   |
| 2697<br><br>12Apr21<br>NoCat | 1    | MASTER ENSUITE: UPGRADE 4 SHOWER FLOOR TILE   |
| 2697<br><br>12Apr21<br>NoCat | 1    | FYI - KITCHEN/BREAKFAST: MIRAGE, 3 5/16" RED OAK, TRUE BALANCE ENGINEERED HARDWOOD, 3/4", ADMIRATION TEXTURE CASHMERE FINISH - LEVEL 1<br><br>DO NOT SUPPLY/INSTALL CERAMIC IN KITCHEN/BREAKFAST |

DRYWALL

| Invoice                      | Qty. | Description   |
|------------------------------|------|---|
| 2694<br><br>12Apr21<br>NoCat | 1    | MASTER ENSUITE: SHOWER NICHE [SHAMPOO SHELF] - COMPLETE WITH MATCHING MARBLE JAMBS ON 4 SIDES, STANDARD TILE, APPROX. 12 X 18 INSTALLED VERTICALLY - SEE PLAN |
| 2694<br><br>12Apr21<br>NoCat | 1    | MASTER BEDROOM: MODEL OPTIONS 42.02. B - OPT. 10 FOOT TRAY CEILING AS PER PLAN                                                                                |
| 2694<br><br>12Apr21<br>NoCat | 1    | THRU OUT SECOND FLOOR: INCREASE HEIGHT OF DOOR TO 8FT SECOND FLOOR - PER DOOR                                                                                 |



CONSTRUCTION SUMMARY

Lot: 51

Model: 42.02 B ROSEDALE OPT. LIBRARY

Project/Phase: Pine Valley Forevergreen / 1

ELECTRICAL

| Invoice                         | Qty. | Description   |
|---------------------------------|------|---|
| 2694<br>72,281<br>12Apr21       | 1    | GREAT ROOM: INTERIOR WALL OUTLET: ADDITIONAL 110V WALL INTERIOR RECEPTACLE ON EXISTING CIRCUIT FOR WALL MOUNTED TV - APPROX. 66" A.F.F. AT FIREPLACE - SEE PLAN                     |
| 2694<br>72,273<br>12Apr21       | 1    | KITCHEN: 110V WALL RECEPTACLE ON SEPARATE CIRCUIT - GAS FIRED APPLIANCE - FOR AUX. EQUIPMENT - NOT A STOVE PLUG<br><br>GAS LINE NOT PURCHASED - HOME OWNER TO ADD OWN AFTER CLOSING |
| 2694<br>72,289<br>12Apr21       | 6    | KITCHEN: 4" E/S LED INTERIOR POT LIGHT - GROUND FLOOR - EACH - INCLUDES ONE SWITCH<br><br>INCLUDED IN APS                                                                           |
| 2694<br>72,213<br>12Apr21<br>** | 1    | HRV WITH 20 MINUTE LIGHT TIMER TO ALL WASHROOMS AND LAUNDRY ROOM, INCLUDES MAIN WALL CONTROLLER UP TO 4 OUTLETS                                                                     |
| 2694<br><br>12Apr21<br>NoCat    | 2    | LIBRARY + STUDY LOFT: ADD BRASS FLOOR MOUNTED ELECTRICAL OUTLET - APPROX CENTER OF ROOM                                                                                             |
| 2694<br>72,666<br>12Apr21       | 1    | KITCHEN: 50 AMP FOR WALL OVENS   |

FORMING

| Invoice                   | Qty. | Description                                                                                                  |
|---------------------------|------|---|
| 2694<br>72,206<br>12Apr21 | 1    | PINE VALLEY MODEL 42.02 ROSEDALE ELEV B - 9 FOOT BASEMENT CEILING HEIGHT IN LIEU OF STANDARD 8 FOOT CEILING. |

FRAMING

| Invoice                      | Qty. | Description   |
|------------------------------|------|---|
| 2694<br>72,631<br>12Apr21    | 1    | MASTER ENSUITE: SHOWER NICHE [SHAMPOO SHELF] - COMPLETE WITH MATCHING MARBLE JAMBS ON 4 SIDES, STANDARD TILE, APPROX. 12 X 18 INSTALLED VERTICALLY - SEE PLAN |
| 2694<br>72,468<br>12Apr21    | 1    | MASTER BEDROOM: MODEL OPTIONS 42.02. B - OPT. 10 FOOT TRAY CEILING AS PER PLAN<br><br>SQUARED OFF - NOT ANGLED                                                |
| 2694<br><br>12Apr21<br>NoCat | 1    | THRU OUT SECOND FLOOR: INCREASE HEIGHT OF DOOR TO 8FT SECOND FLOOR - PER DOOR                                                                                 |

GLASS AND MIRROR

| Invoice                      | Qty. | Description                                                                   |
|------------------------------|------|-------------------------------------------------------------------------------|
| 2697<br><br>12Apr21<br>NoCat | 3    | MASTER ENSUITE + ENSUITE 2 + ENSUITE 4: UPGRADE SHOWER DOOR HARDWARE - CHROME |



CONSTRUCTION SUMMARY

Lot: 51

Model: 42.02 B ROSEDALE OPT. LIBRARY

Project/Phase: Pine Valley Forevergreen / 1

GRANITE MARBLE QUARTZ

| Invoice                    | Qty. | Description                           |
|----------------------------|------|---------------------------------------|
| 2697<br>101,930<br>12Apr21 | 1    | KITCHEN: UPGRADE 4 GRANITE COUNTERTOP |

HARDWOOD

| Invoice              | Qty. | Description   |
|----------------------|------|---|
| 2697<br>1<br>12Apr21 | 1    | KITCHEN/BREAKFAST: MIRAGE, 3 5/16" RED OAK, TRUE BALANCE ENGINEERED HARDWOOD, 3/4", ADMIRATION TEXTURE CASHMERE FINISH - LEVEL 1   |
| 2697<br>1<br>12Apr21 | 1    | THRU OUT STD AREAS: LIBRARY, MAIN HALL/LIVING ROOM, GREAT ROOM, DINING ROOM, MASTER BEDROOM, BEDROOM 2, BEDROOM 3, BEDROOM 4, UPPER HALL/STUDY LOFT: MIRAGE, 3 5/16" RED OAK, TRUE BALANCE ENG HARDWOOD, 3/4", ADMIRATION TEXTURE CASHMERE FINISH - LEVEL 1 |

HVAC

| Invoice                   | Qty. | Description   |
|---------------------------|------|---|
| 2694<br>72,213<br>12Apr21 | 1    | HRV WITH 20 MINUTE LIGHT TIMER TO ALL WASHROOMS AND LAUNDRY ROOM, INCLUDES MAIN WALL CONTROLLER UP TO 4 OUTLETS |

INTERIOR DOORS AND TRIM

| Invoice                   | Qty. | Description                                                                   |
|---------------------------|------|-------------------------------------------------------------------------------|
| 2694<br>72,644<br>12Apr21 | 16   | THRU OUT SECOND FLOOR: INCREASE HEIGHT OF DOOR TO 8FT SECOND FLOOR - PER DOOR |

KITCHEN AND BATH CABINETRY

| Invoice                    | Qty. | Description                      |
|----------------------------|------|----------------------------------|
| 2697<br>101,930<br>12Apr21 | 1    | THRU OUT: SEE CABINETRY SCHEDULE |

NETWORK AND WIRING

| Invoice                   | Qty. | Description                                                                                        |
|---------------------------|------|---|
| 2694<br>72,260<br>12Apr21 | 1    | CONDUIT PIPE - FROM ATTIC TO BASEMENT - BY ELECTRICAL PANEL IN BASEMENT TO APPROX. CENTRE IN ATTIC |



CONSTRUCTION SUMMARY

Lot: 51

Model: 42.02 B ROSEDALE OPT. LIBRARY

Project/Phase: Pine Valley Forevergreen / 1

PAINT

| Invoice                      | Qty. | Description                                                                    |
|------------------------------|------|--------------------------------------------------------------------------------|
| 2694<br><br>12Apr21<br>NoCat | 1    | MASTER BEDROOM: MODEL OPTIONS 42.02. B - OPT. 10 FOOT TRAY CEILING AS PER PLAN |
| 2694<br><br>12Apr21<br>NoCat | 1    | THRU OUT SECOND FLOOR: INCREASE HEIGHT OF DOOR TO 8FT SECOND FLOOR - PER DOOR  |
| 2697<br><br>12Apr21<br>NoCat | 2    | MAIN STAIRS: 2ND FLOOR TO BASEMENT: STAIN STAIRS AND LANDINGS                  |

PLUMBING

| Invoice                      | Qty. | Description                                                                              |
|------------------------------|------|------------------------------------------------------------------------------------------|
| 2694<br>72,332<br>12Apr21    | 1    | KITCHEN: ROUGH-IN 1/4" COLD WATER LINE TO FRIDGE                                         |
| 2694<br><br>12Apr21<br>NoCat | 1    | MASTER ENSUITE: MOEN 'ALIGN' RAIN SHOWER (from ceiling) + HAND SHOWER/SLIDE BAR - CHROME |
| 2694<br><br>12Apr21<br>NoCat | 1    | KITCHEN: BLANCO QUATRUS SUPER SINGLE SINK - STAINLESS                                    |

WINDOWS AND DOORS

| Invoice                      | Qty. | Description   |
|------------------------------|------|---|
| 2694<br><br>12Apr21<br>NoCat | 1    | FYI - PINE VALLEY MODEL 42.02 ROSEDALE ELEV B - 9 FOOT BASEMENT CEILING HEIGHT IN LIEU OF STANDARD 8 FOOT CEILING. |

PV - 51 Cabinetry Schedule

| ROOM             | DESCRIPTION                                                         | PRICE | QTY | TOTAL |
|------------------|---------------------------------------------------------------------|-------|-----|-------|
| KITCHEN          | UPGRADE FROM SERIES 2 TO SERIES 5 - <i>MEDIO 6 OYSTER</i>           |       | 1   |       |
|                  | CONVERT CABINETRY TO TALL DEEP BUILT IN OVEN UNIT WITH DRAWER BELOW |       | 1   |       |
|                  | ADJUST CABINETRY FOR 36" RANGETOP (N/C)                             |       | 1   |       |
|                  | LEAVE 42" GAP IN UPPER CABINETS ABOVE RANGETOP (N/C)                |       | 1   |       |
|                  | ADD DECORATIVE HOOD CABINET - ASPEN RANGE                           |       | 1   |       |
|                  | ADD POTS AND PANS DRAWERS BELOW RANGETOP                            |       | 1   |       |
|                  | LEAVE 24" SPACE IN BASE CABINETRY FOR WINE FRIDGE (N/C)             |       | 1   |       |
|                  | RELOCATE 36" FRIDGE TO OTHER WALL                                   |       | 1   |       |
|                  | ADD TALL DEEP PANTRY UNIT BESIDE FRIDGE                             |       | 1   |       |
|                  | RETURN TRIP FOR HARDWOOD                                            |       | 1   |       |
| ISLAND           | UPGRADE FROM SERIES 2 TO SERIES 5 - <i>MEDIO 6 OYSTER</i>           |       | 1   |       |
|                  | ADD OVERSIZED PANELS TO SIDES OF ISLAND                             |       | 1   |       |
| CABINETRY TOTAL: |                                                                     |       |     |       |

\*\*\*HANDLE PLACEMENT: AT INSTALLERS DISCRETION\*\*\*

LOT #: PV-51

DATE: April 8, 2021

SIGNATURE: 

SIGNATURE: 

\*\*\* NOTE: This is not an approved document. Document must be locked \*\*\*

Scheduled Closing Date: November 30, 2021

Purchaser: Gianfranca Antonucci

Property: 51 of Plan -

Telephone Res. / Bus: / (647) 938-5297

Project: Pine Valley Forevergreen - Phase 1

Decor Advisor: Angela Phim

Model and Elevation: 42.02 B ROSEDALE OPT. LIBRARY

Layout Changes: ☒ Yes ☐ NoSketch Attached: ☒ Yes ☐ NoExterior Colour Scheme: 

## 1. Cabinetry

|                                         | Style and Colour       | Counter               | Hardware |
|-----------------------------------------|------------------------|-----------------------|----------|
| Kitchen / Breakfast                     | Medio 6 'Oyster'       | *Granite: Titanium LF | attach   |
| Laundry Room                            | Alban 'Storm Grey Oak' | P-Lam 'White'         | attach   |
| Powder Room                             | Alban 'Storm Grey Oak' | Quartz: 'Ice Snow'    | attach   |
| Mudroom                                 | Alban 'Storm Grey Oak' | P-Lam 'White'         | attach   |
| Master Ensuite Bathroom                 | Alban 'Storm Grey Oak' | Quartz: 'Ice Snow'    | attach   |
| Second Ensuite Bathroom (If Applicable) | Tribecca 'Arris'       | Quartz: 'Ice Snow'    | attach   |
| Ensuite 3                               | Tribecca 'Arris'       | Quartz: 'Ice Snow'    | attach   |

## Comment

Ensuite 4: Tribecca 'Arris' + Countertop: Quartz: 'Ice Snow'

## 2. Floor Tile

|                                         | Selection                                        |
|-----------------------------------------|--------------------------------------------------|
| Entrance Vestibule                      | 13x13" New Byzantine 'Pentellic Grey'            |
| Main Hall                               | n/a                                              |
| Kitchen / Breakfast                     | *see hardwood                                    |
| Laundry Room                            | 13x13" New Byzantine 'Pentellic Grey'            |
| Powder Room                             | 13x13" New Byzantine 'Pentellic Grey'            |
| Mudroom                                 | 13x13" New Byzantine 'Pentellic Grey'            |
| Master Ensuite Bathroom                 | *12x24" Eterna 'Imperial Grey' polished          |
| Second Ensuite Bathroom (If Applicable) | 13x13" Venus 'Ivory'                             |
| Lower Landing (If Applicable)           | 13x13" New Byzantine 'Pentellic Grey' (Basement) |
| Ensuite 3                               | 13x13" Venus 'Ivory'                             |

## Comment

Master Ensuite Shower Floor: \*Eterna HEX 'Grey' matte / Ensuite 4: 13x13" Venus 'Ivory' / thru-out shower floor: 2x2" standard 'white'

## 3. Wall Tile

|                                         | Selection                                                     | Listello/Inserts                                              | Describe |
|-----------------------------------------|---------------------------------------------------------------|---------------------------------------------------------------|----------|
| Ensuite 4                               | 8x10" Reflection 'White'                                      | <input type="radio"/> Yes <input checked="" type="radio"/> No |          |
| Master Ensuite Bathroom                 |                                                               |                                                               |          |
| Tub Deck                                |                                                               | <input type="radio"/> Yes <input checked="" type="radio"/> No |          |
| Shower Stall                            | *12x24" Eterna 'ImperialGrey' pol.                            | <input type="radio"/> Yes <input checked="" type="radio"/> No |          |
| Bathroom Walls                          |                                                               | <input type="radio"/> Yes <input checked="" type="radio"/> No |          |
| Second Ensuite Bathroom (If Applicable) | 8x10" Reflection 'White'                                      | <input type="radio"/> Yes <input checked="" type="radio"/> No |          |
| Ensuite 3                               | 8x10" Reflection 'White'                                      | <input type="radio"/> Yes <input checked="" type="radio"/> No |          |
| Kitchen Backsplash                      | <input type="radio"/> Yes <input checked="" type="radio"/> No | Backsplash Behind Fridge                                      |          |

## Comment



\*\*\* NOTE: This is not an approved document. Document must be locked \*\*\*

Scheduled Closing Date: November 30, 2021

Purchaser: Gianfranca Antonucci

Telephone Res. / Bus: / (647) 938-5297

Decor Advisor: Angela Phim

Property: 51 of Plan -

Project: Pine Valley Forevergreen - Phase 1

Model and Elevation: 42.02 B ROSEDALE OPT. LIBRARY

## 4. Plumbing Fixtures

Master Ensuite Bathroom

Second Ensuite

Powder Room

Other Room - Specify

Comment

Other Washroom

\*see attached plumbing upgrades

## 5. Hardwood Flooring

Main Hall

Type and Stain

Kitchen / Breakfast

\*3-5/16x3/4" RedOak, 'Charcoal'

Living Room

Dining Room

Family Room

Den/Library

Entrance Vestibule

Lower Landing  
(If Applicable)

Upper Landing

Upper Hall

Master Bedroom

Bedroom #2

Bedroom #3

Bedroom #4

Bedroom #5

Other Room - Specify

thru-out standard areas

Type and Stain

\*3-5/16x3/4" RedOak, 'Charcoal'

Comment

## 6. Carpeting

Ground Floor

Upgrade

Description

Second Floor

Upgrade Underpad

Type

Area

Carpet on Stairs

Capped

Runner - \*Upgrade

Comment

## 7. Fireplace

Living Room

Purchased

As Per Plan

N/A

Family Room

Purchased

As Per Plan

N/A

Other Room - Specify

Great Room

Purchased

As Per Plan

N/A

Fireplace Type

Mantle Type

Colour / Stain

Surround

Hearth

Comment

Standard Gas

Mediterranean

Arctic White

n/a

n/a

\*\*\* NOTE: This is not an approved document. Document must be locked \*\*\*

Scheduled Closing Date: November 30, 2021

Purchaser: Gianfranca Antonucci

Telephone Res. / Bus: / (647) 938-5297

Decor Advisor: Angela Phim

Property: 51 of Plan -

Project: Pine Valley Forevergreen - Phase 1

Model and Elevation: 42.02 B ROSEDALE OPT. LIBRARY

## 8. Trim Carpentry

Interior Doors Carrara

Front Door Glass Inserts std

Door Handles std

Interior Trim std package

Comment

## 9. Plaster Mouldings and Medallions

Standard Throughout ☐ Yes ☐ No ☒ N/A

Entrance Vestibule

Main Hall

Living Room

Dining Room

Family Room

Comment

Kitchen/Breakfast

Den/Library

Lower Landing

Other Room - Specify

## 10. Railings and Spindles

Railing Package Standard 2 Package

Railing Colour \*Mirage 'Dark Leaf'

Stringer / Riser \*Mirage 'Dark Leaf'

Spindle Colour \*Mirage 'Dark Leaf'

Treads \*Mirage 'Dark Leaf'

Oak Stairs

☒ Yes ☐ No ☐ N/A

## 11. Wall Paint / Ceilings

Throughout Finished Areas Cool White

Trim Paint White

Smooth Ceilings

Ground Floor



Second Floor



Note

Comment



Purchaser: Gianfranca Antonucci  
 Telephone Res. / Bus: / (647) 938-5297  
 Decor Advisor: Angela Phim

Scheduled Closing Date: November 30, 2021

Property: 51 of Plan -

Project: Pine Valley Forevergreen - Phase 1

Model and Elevation: 42.02 B ROSEDALE OPT. LIBRARY

### 12. Electrical

Hood Fan ☐ White ☐ Stainless ☒ N/A

Above Kitchen Cabinet Light ☐ Yes ☒ No

Below Kitchen Cabinet Light ☐ Yes ☒ No

Standard Appliances ☐

Over The Range Microwave ☐

Chimney Style Fan ☐

Comment

### 13. Heating and Air Conditioning

Air Conditioning

Gas Provisions Stove

Gas Provisions Dryer

Gas Provisions Barbecue

Comment

### 14. Additional Comments

### 15. Disclaimers and Notes

- Colours of all materials are as close as possible to builder's selection, but not necessarily identical due to variances in manufacturing.
- Any extras listed above are null and void unless accompanied by a separate invoice/amendment. Said invoice must be paid in full.
- The Purchaser acknowledges that after Interior Colour Selection form is signed and dated, no further changes will be permitted other than re-selection due to unavailability. \_\_\_\_\_ Purchaser's Initials
- The Purchaser acknowledges reading and accepting the "Gold Park Homes Decor Centre Disclaimers" form. This document contains other miscellaneous disclaimers.

This Interior Colour Selection is final and approved by:

Signature:  Date: \_\_\_\_\_



SCHEDULE 'F'

PV-51  
April 8, 2021


# The Rosedale

## 42' SERIES

Elevation A • 3,655 sq.ft.

Elevation B • 3,605 sq.ft.

Elevation C • 3,590 sq.ft.

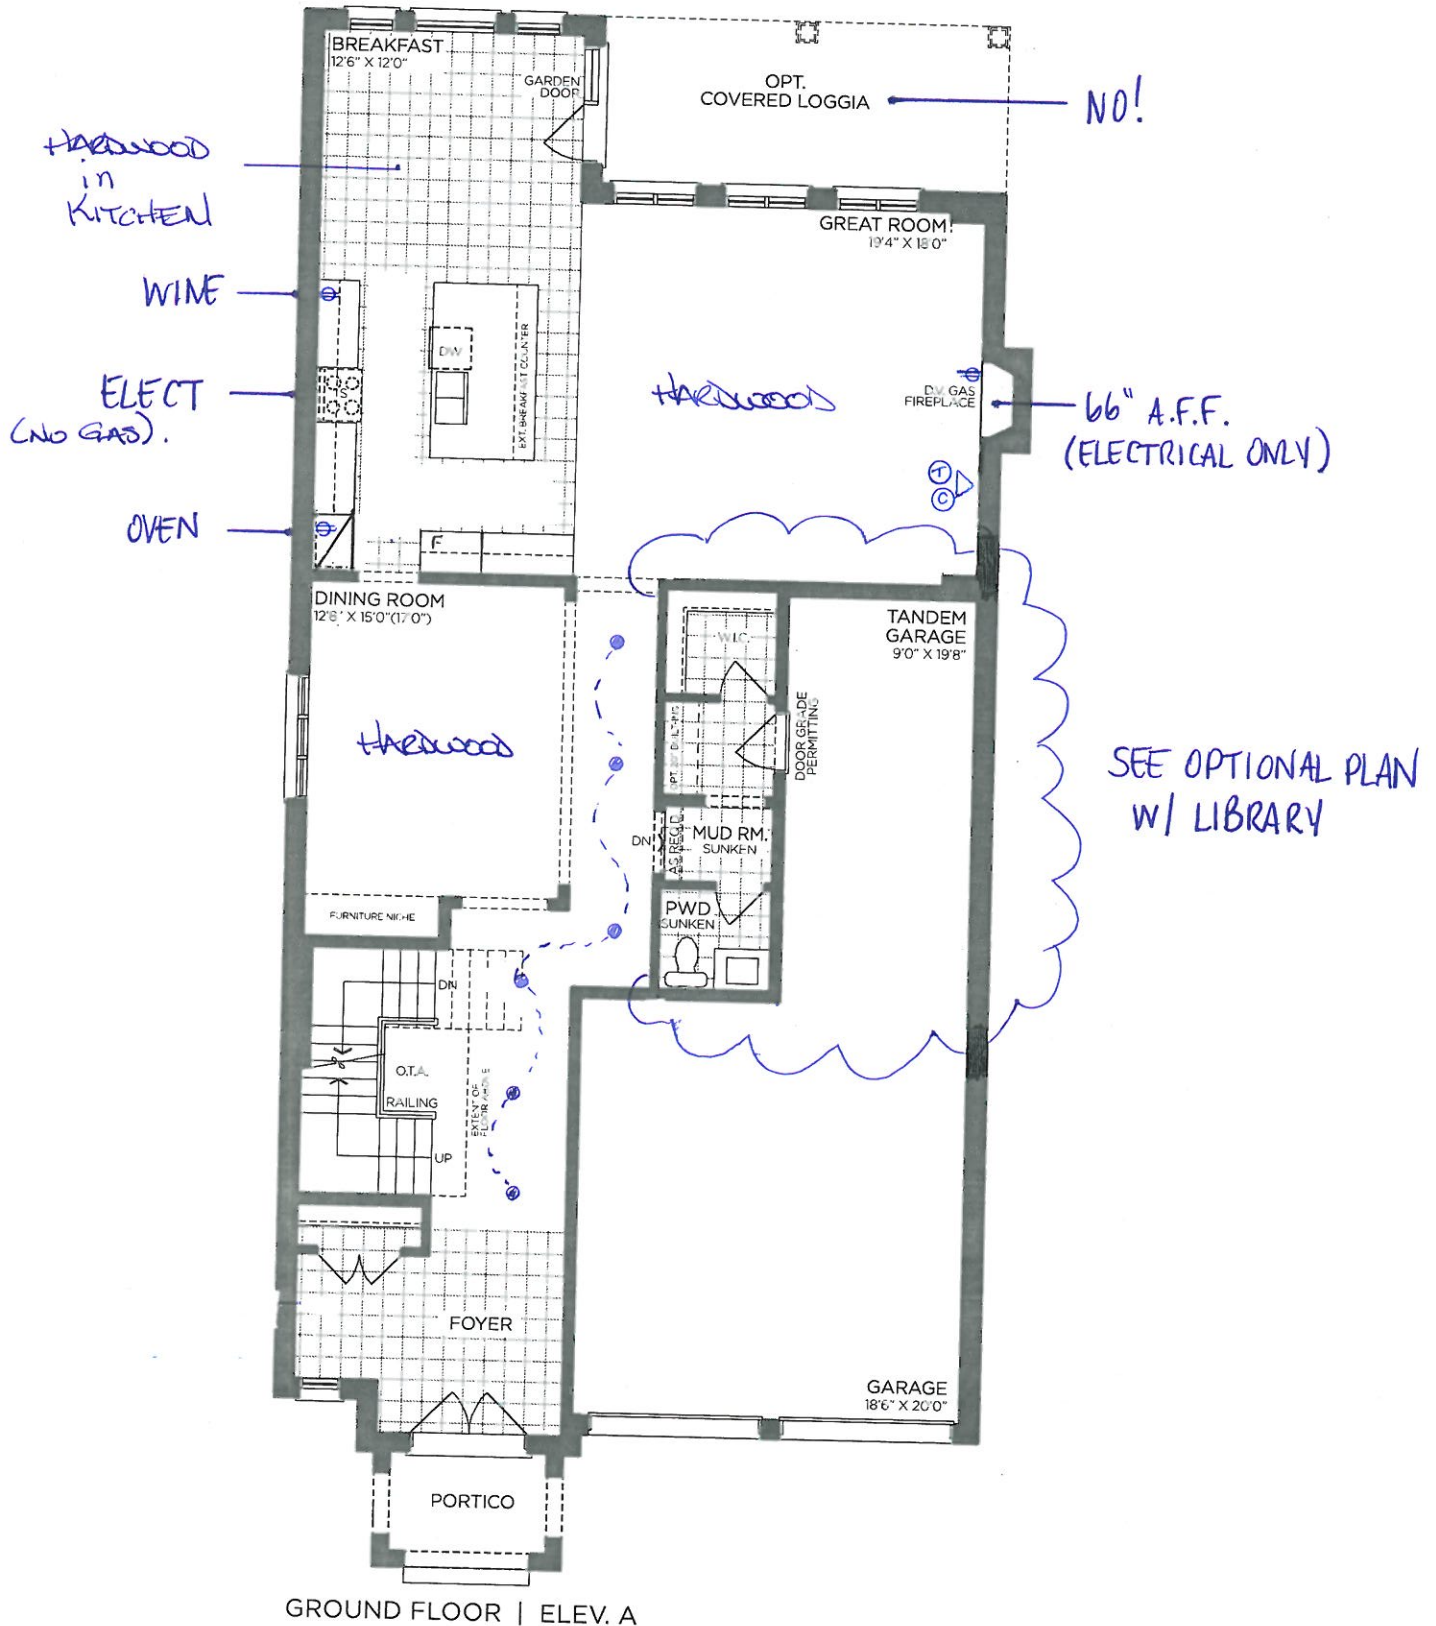

VENDOR   
PURCHASER   
PURCHASER

**GOLDPARK**  
WORTH MORE™

Prices, figures, illustrations, sizes, features and finishes are subject to change without notice. Areas and dimensions are approximate and actual usable floor space may vary from the stated area. Layout may be reverse of the unit purchased. E. & O.E. 4202

PR-51  
April 8, 2021

SCHEDULE 'F'














# The Rosedale

## 42' SERIES

Elevation A • 3,655 sq.ft.

Elevation B • 3,605 sq.ft.

Elevation C • 3,590 sq.ft.

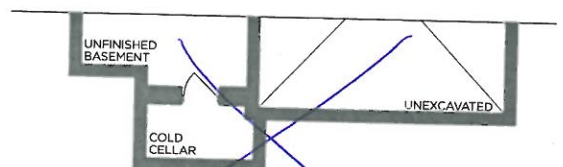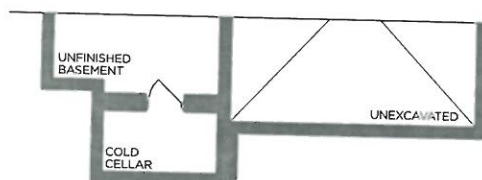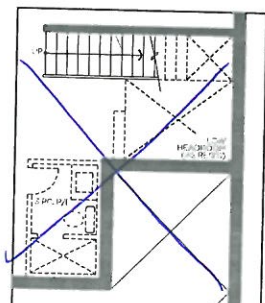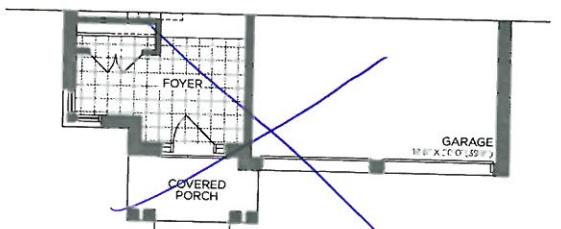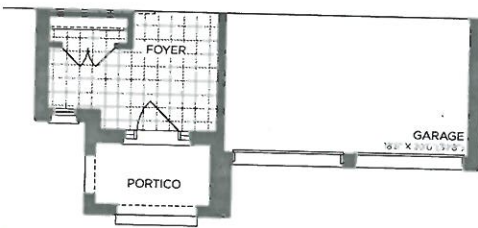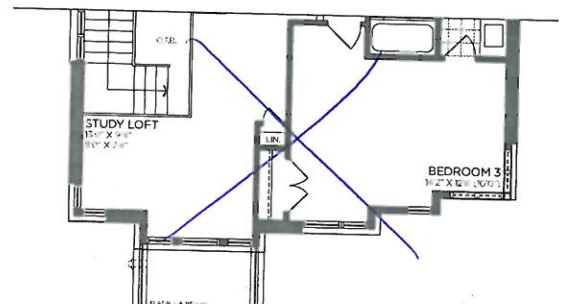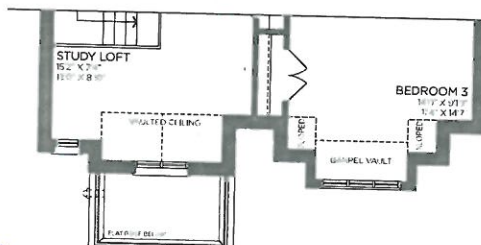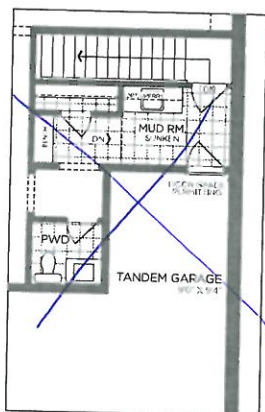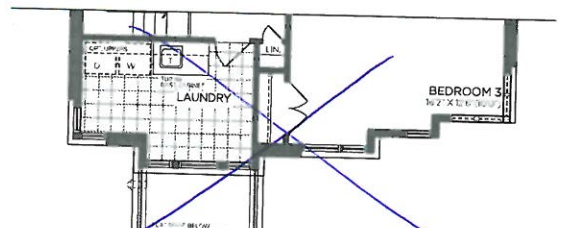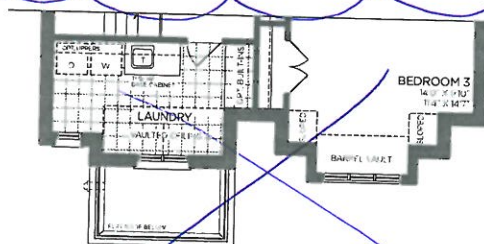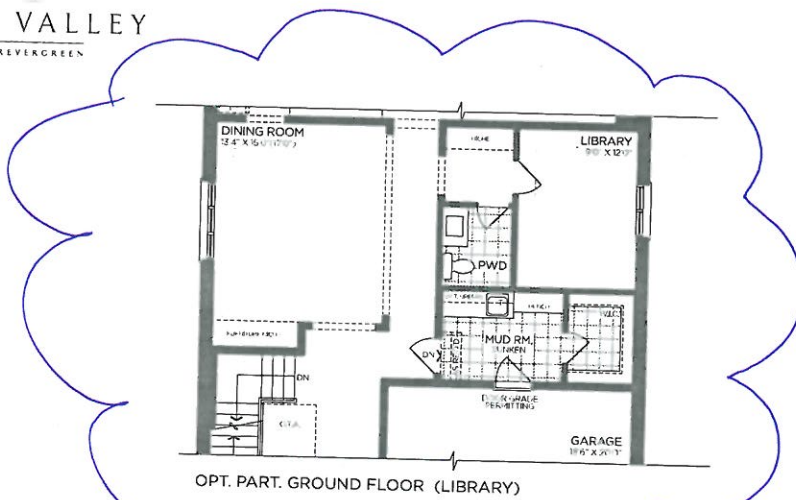

VENDOR   
PURCHASER   
PURCHASER

**GOLDPARK**  
WORTH MORE™

Prices, figures, illustrations, sizes, features and finishes are subject to change without notice. Areas and dimensions are approximate and actual usable floor space may vary from the stated area. Layout may be reverse of the unit purchased. E. & O.E. 4202




PV-51  
April 8, 2024

SCHEDULE 'F'

# The Rosedale

## 42' SERIES

Elevation A • 3,655 sq.ft.  
Elevation B • 3,605 sq.ft.  
Elevation C • 3,590 sq.ft.

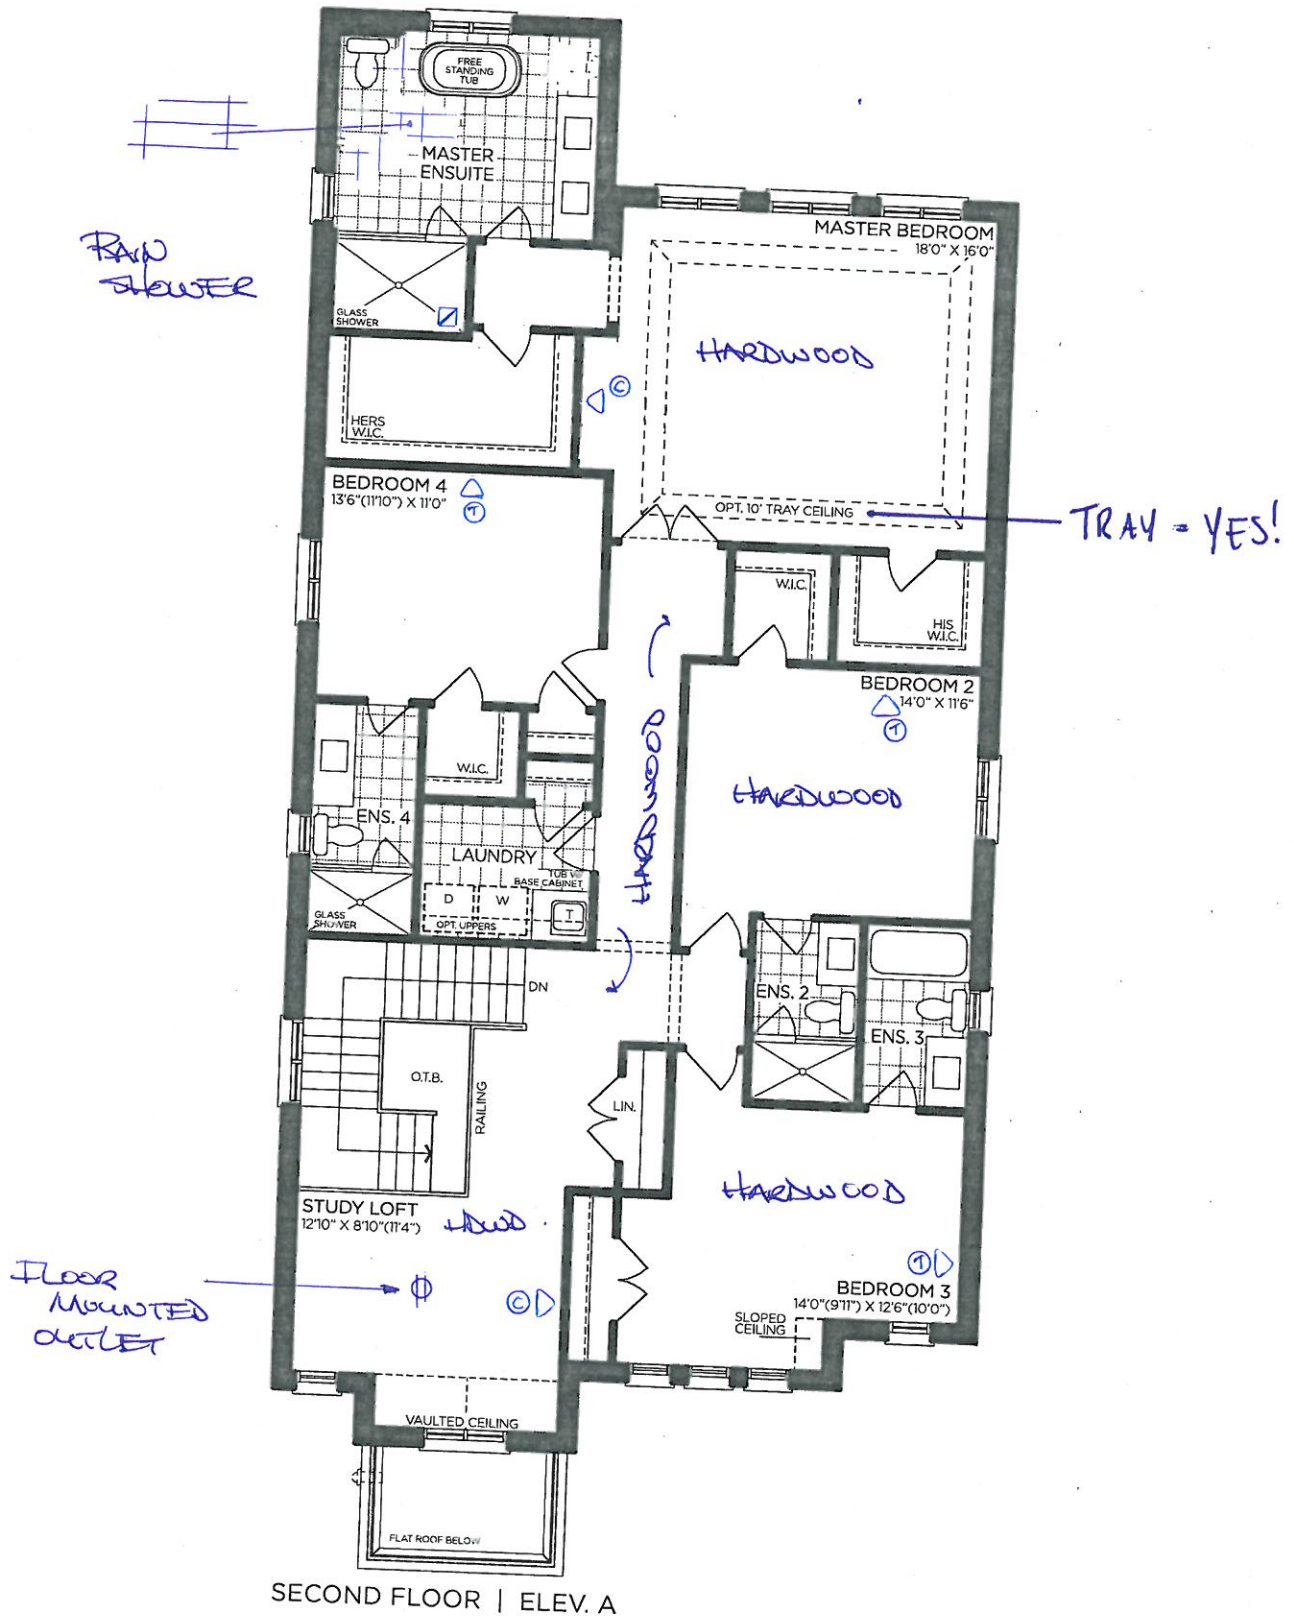

SECOND FLOOR | ELEV. A

VENDOR

PURCHASER

PURCHASER

**GOLDPARK**  
WORTH MORE™

Prices, figures, illustrations, sizes, features and finishes are subject to change without notice. Areas and dimensions are approximate and actual usable floor space may vary from the stated area. Layout may be reverse of the unit purchased. E. & O.E. 4202




SCHEDULE 'F'

PV-51 ~~61~~    
April 8, 2021

# The Rosedale

## 42' SERIES

Elevation A • 3,655 sq.ft.  
→ Elevation B • 3,605 sq.ft.  
Elevation C • 3,590 sq.ft.

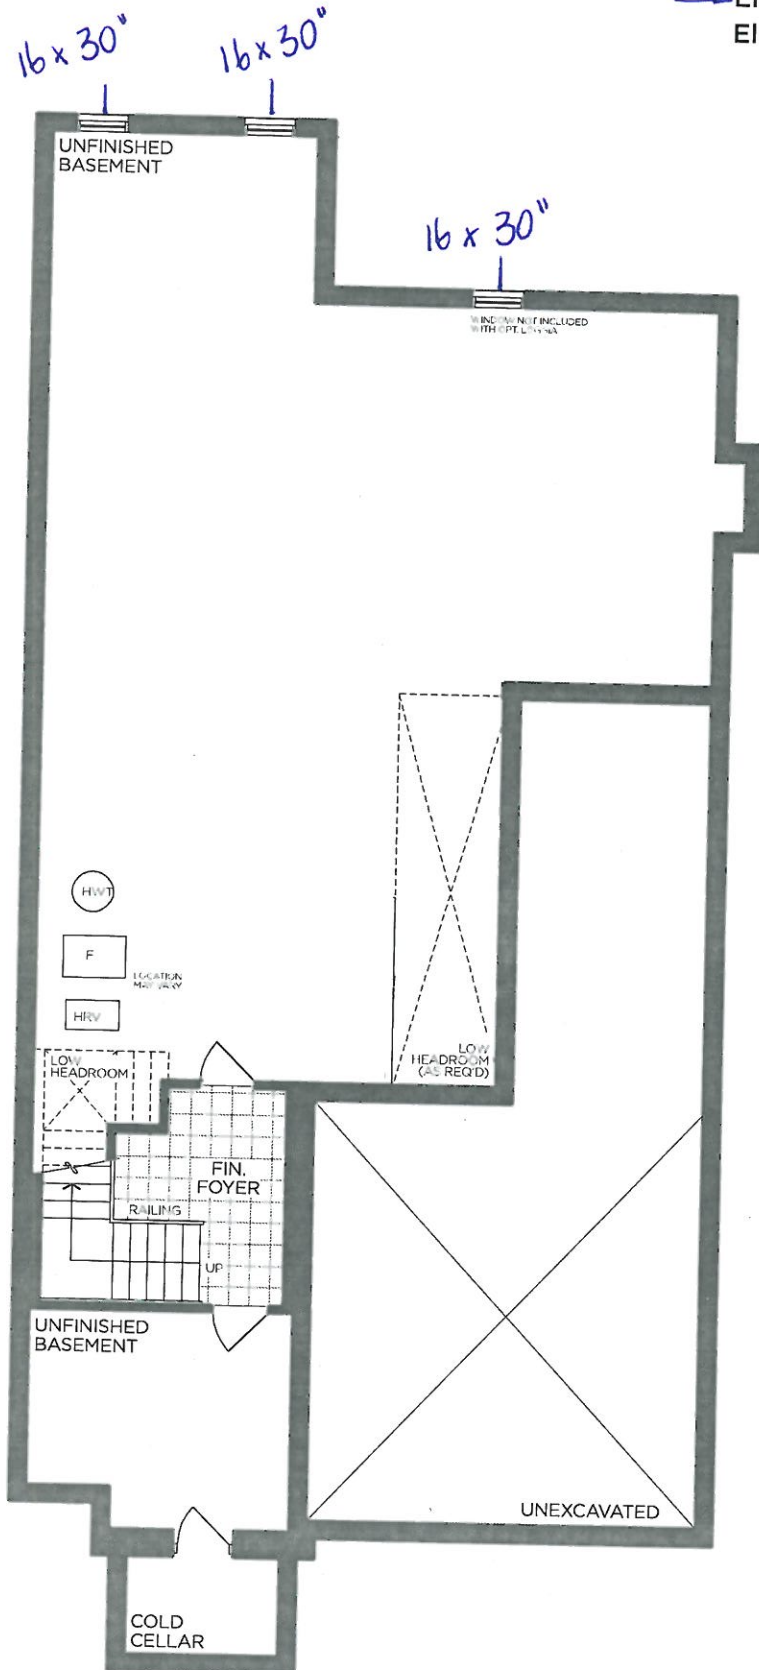

BASEMENT | ELEV. A


|           |                      |
|-----------|----------------------|
| VENDOR    | <input type="text"/> |
| PURCHASER | <input type="text"/> |
| PURCHASER | <input type="text"/> |

**GOLDPARK**  
WORTH MORE™

Prices, figures, illustrations, sizes, features and finishes are subject to change without notice. Areas and dimensions are approximate and actual usable floor space may vary from the stated area. Layout may be reverse of the unit purchased. E. & O.E. 4202

April 8, 2021

\* Return-trip for hardwood \*

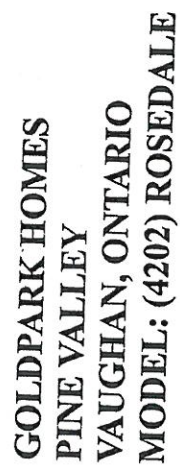


**SITE STANDARD: WHITE 3/4" EXTENSION  
SOFT-CLOSE DRAWERS & SOFT-CLOSE  
HINGES TO KITCHEN AREA**

10' CEILING - 12"H COFFERED CEILING -  
M.H. = 102" + 3/4"H CONTEMPORARY  
MOLDING + 5 1/4"H FURRING RAIL  
+ LARGE CORNICE MOLDING TO  
UNDERSIDE OF BOX


PLAN VIEW

RY-51  
April 8, 2021

Alban 'Storm Grey Oak'  
H011-03

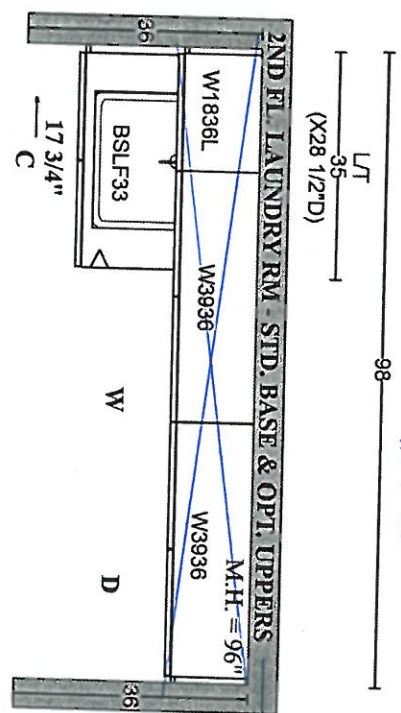

Alban 'Storm Grey Oak'  
H039-03

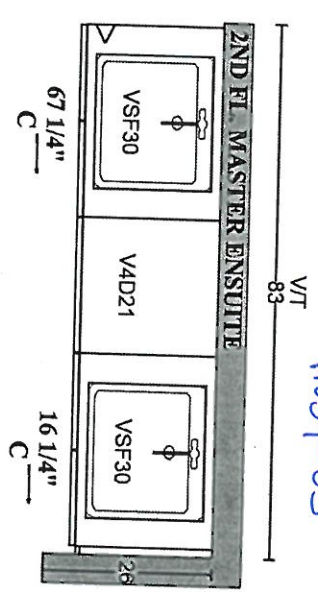


GOLDPARK HOMES  
PINE VALLEY  
VAUGHAN, ONTARIO  
MODEL: (4202) ROSEDALE


SITE STANDARD: WHITE 3/4" EXTENSION  
SOFT-CLOSE DRAWERS & STANDARD SLAM DOOR HINGES  
TO VANITIES

ONE TOP DRAWER WHERE POSSIBLE THROUGHOUT EACH  
VANITY, ONE BANK OF DRAWERS WHERE POSSIBLE  
THROUGHOUT EACH MASTER ENSUITE VANITY


Alban 'Storm Grey Oak'  
H011-03

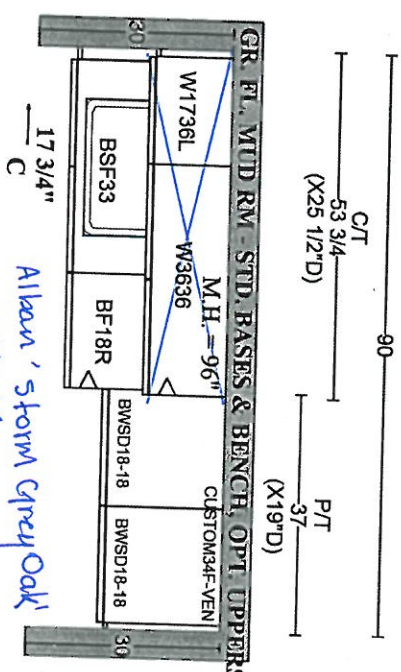


Alban  
'Storm Grey Oak'  
H011-03

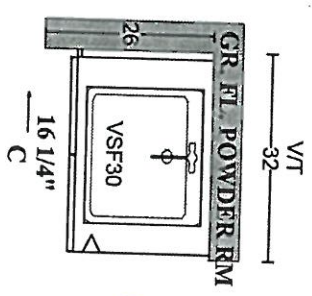


Tribeca 'Arriis'  
H039-03

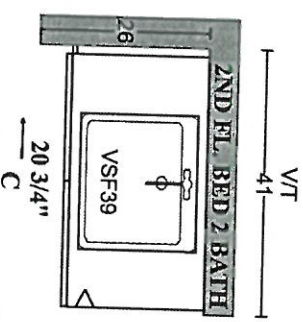

Tribeca 'Arriis'  
H039-03

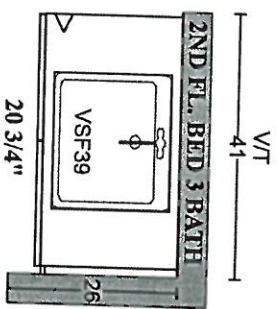

Tribeca 'Arriis'  
H039-03

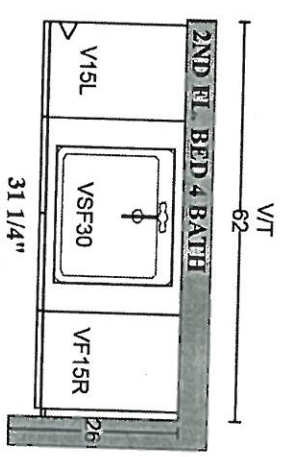

PLAN VIEW



PINE VALLEY  
FOREVERGREEN

STONE COUNTERTOP EDGE PROFILES




STANDARD 2CM EASED EDGE



LOCATION:

THRU OUT

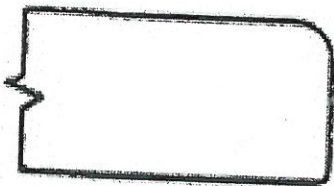


UPGRADE 3CM EASED EDGE

LOCATION:



UPGRADE 4CM MITRED EDGE

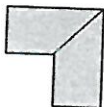

LOCATION:



UPGRADE 2CM OGEE EDGE

LOCATION:

LOT #:

51

DATE:

April 8, 2021

SIGNATURE:

SIGNATURE:

GOLDPARK  
WORTH MORE

# STANDARD HARDWARE / HANDLES



☐ H001-02



☐ H001-03



☐ H001-04



☐ H009-03



☐ H009-09



☒ H011-03


- Powder Room
- Laundry Room
- Mud Room



☐ H011-05



☐ H011-06

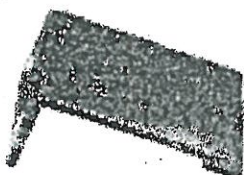

☐ H033-01



☒ H039-03

- Master Ensuite
- Ensuite 2
- Ensuite 3 → Ensuite 4

☒ \*NO HARDWARE  
→ Kitchen

LOT # 51



DATE: April 8, 2021

SIGNATURE:

SIGNATURE:

UPGRADE KITCHEN SINK

**BLANCO - QUATRUS R15 U SUPER SINGLE**  
Stainless Steel - Undermount  
32" x 18" x 9"

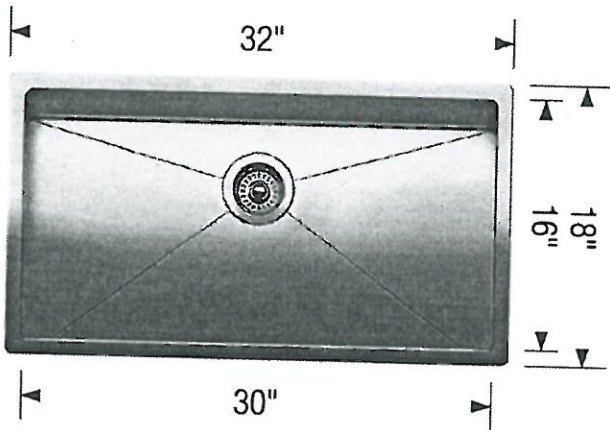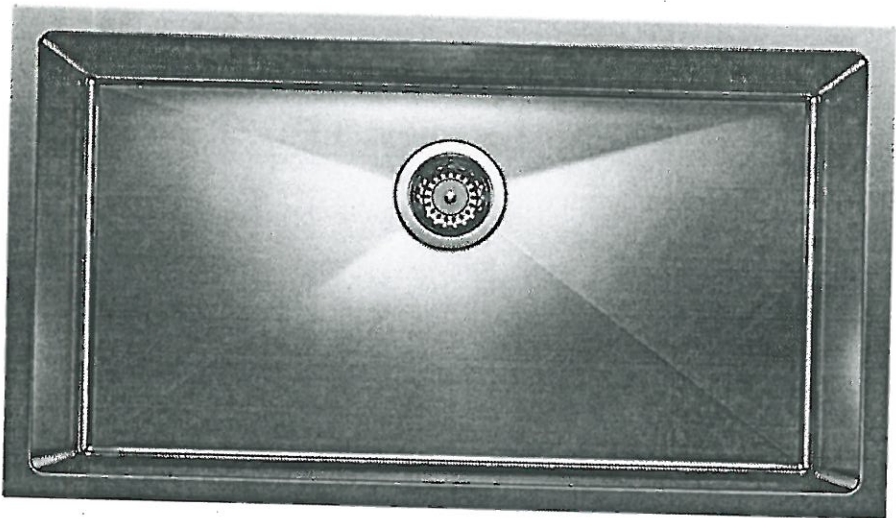

Stainless Steel

☒ GRID

MODEL 401518 Stainless Steel

Lot# PV-51

Room: Kitchen

Signature: 

Date: April 8, 2021

Signature: 




PINE VALLEY  
FOREVERGREEN

## PLUMBING UPGRADES

### MOEN - ALIGN

Posi-Temp SHOWER ONLY\* with 3 Function Transfer Valve/Trim and Slide Bar with Handshower

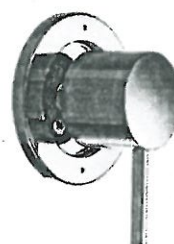

☒ CHROME

☐ BRUSHED NICKEL (BN)

☐ BRUSHED GOLD (BG)

☐ MATTE BLACK (BL)

\*from CEILING

MODEL: T2192EP / U361CI / UT4191 / 62320 / 3887EP / A725 / 226651

Lot# PV-51

Date: April 8, 2021

Room: Master Ensuite

Signature: 

Signature: 


GOLDPARK  
WORTH MORE™

UPGRADE SHOWER HARDWARE



SQ6X6

Shower Door Handle

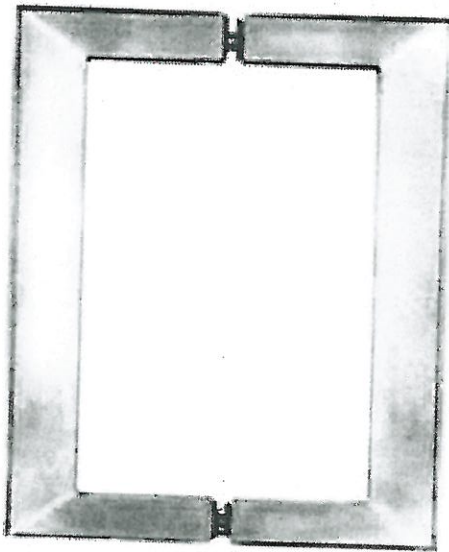

SQ6X6  
Shower Door Handle

6" x 6" back-to-back  
3/4" square tube  
(Also available single sided)

- ☒ CHROME
- ☐ MATTE BLACK


|                                                                                                |                     |                                            |
|------------------------------------------------------------------------------------------------|---------------------|--------------------------------------------|
| Lot# PV-51                                                                                     | Date: April 8, 2021 | Room: Master Ensuite, Ensuite 2, Ensuite 4 |
| Signature:  |                     |                                            |
| Signature:  |                     |                                            |

## BATHROOM ACCESSORIES




PINE VALLEY

FOREVERGREEN

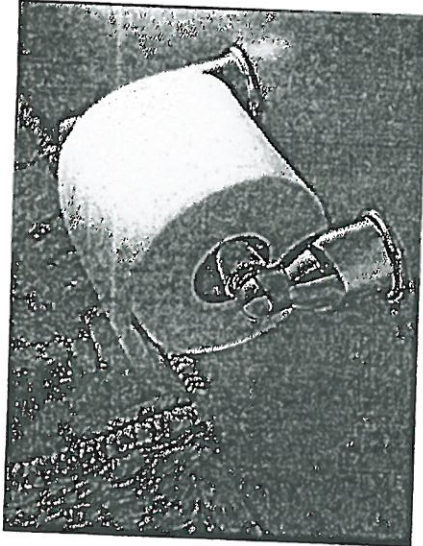

Tissue Holder  
Mason - Chrome

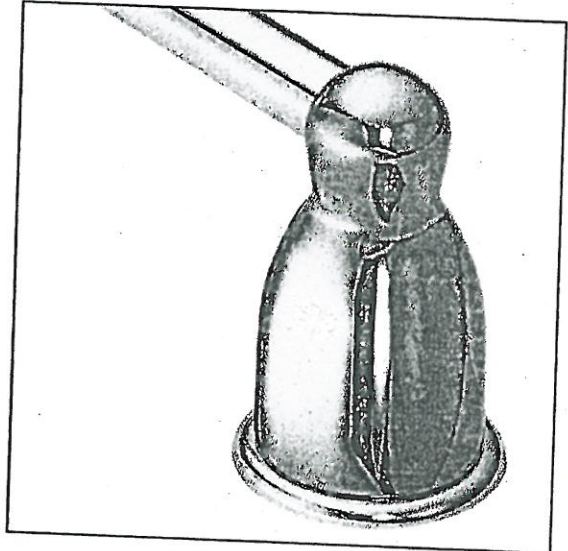

Towel Bar  
Mason - Chrome

**Please select one of the following:**

☐ INSTALL STANDARD BATHROOM ACCESSORIES THRU OUT  
(tissue holder + towel bar) *\*location as per vendors discretion\**

☒ **\*DO NOT\*** INSTALL STANDARD BATHROOM ACCESSORIES  
THRU OUT *\*tissue holder + towel bar will not be provided\**

LOT #

51

DATE:

April 8, 2021

SIGNATURE:


SIGNATURE:

UPGRADE DECORATIVE HOOD CABINET



ASPEN RANGE HOOD

(Insert fan not included)

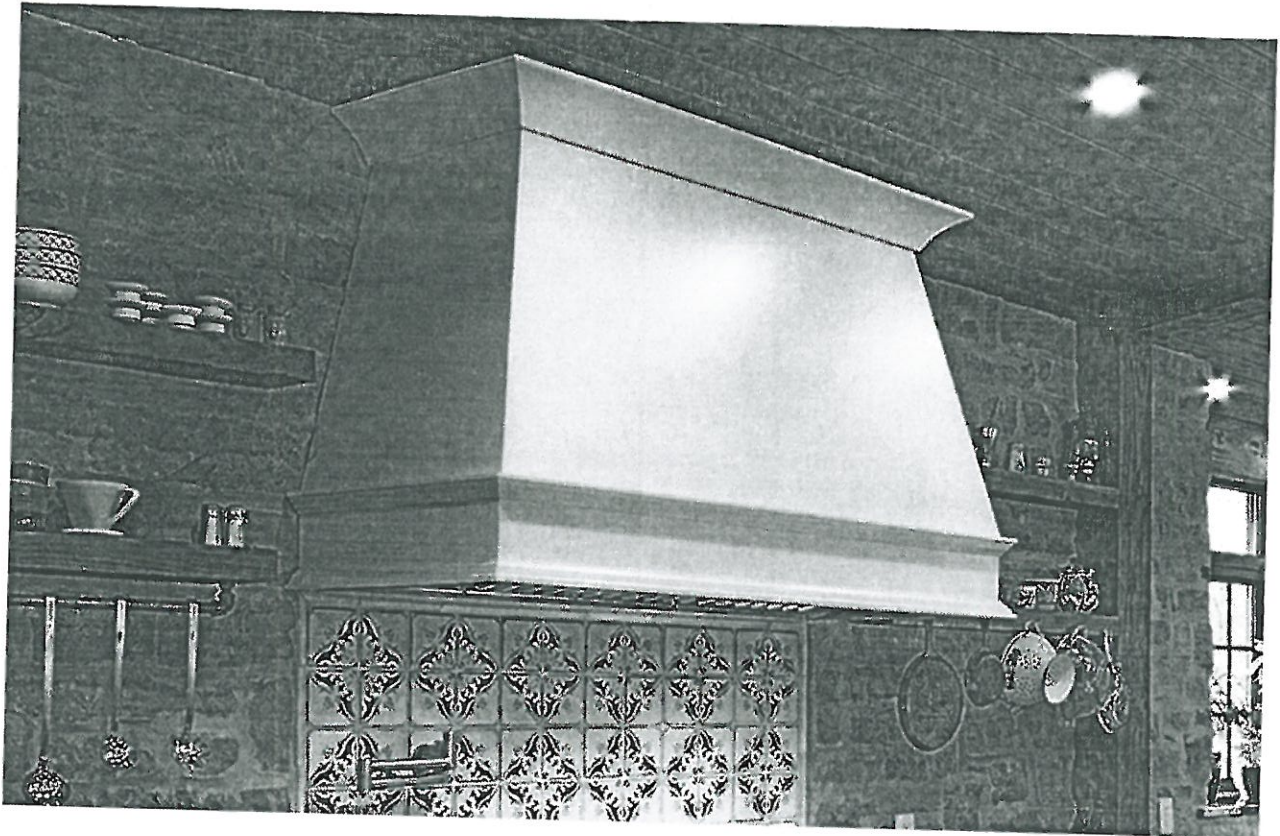

|                                                                                                |                        |                  |
|------------------------------------------------------------------------------------------------|------------------------|------------------|
| Lot#<br>PV-51                                                                                  | Date:<br>April 8, 2021 | Room:<br>Kitchen |
| Signature:  |                        |                  |
| Signature:                                                                                     |                        |                  |



Project: Pine Valley

Lot: 51

Purchaser(s): Gianfranca Antonucci & Christian Filippi

Standard Hood Fan Deletion

We acknowledge that the builder's standard hood fan will not be installed.  
Do not supply, install and/or credit. We will install our own hood fan after closing.

Signature: \_\_\_\_\_



Signature: \_\_\_\_\_

Date: April 8, 2021



CREDIT CARD AUTHORIZATION

PROJECT: Pine Valley

LOT: 51

---

AMOUNT TO BE APPLIED TO CREDIT CARD \$ 8,757.56

CARD NUMBER: 4520 2500 1454 2600

EXPIRY DATE: 10 / 23

AUTH. # 591

NAME ON CARD: Gianna Antonucci

I authorize the above to be added to my credit card for payment of extras.

SIGNATURE: \_\_\_\_\_

Gianna Antonucci

DATE: \_\_\_\_\_

April 9, 2021

## 36" SEALED BURNER RANGETOP - 6 BURNERS

WOLF

SRT366



### FEATURES

Maintain control with six dual-stacked burners that go from 20,000 Btu down to a mere breath of flame

Simmer and melt sauces, soups, and marinades easily with the lower tier of the dual-stacked burner

Match other Sub-Zero, Wolf, and Cove products with heavy-gauge stainless steel and signature red infinite control knobs

Cleanup is a snap as sealed, seamless burner pans contain splashes and spills

Move pots and pans effortlessly across the continuous cast-iron grates

Reignites flame automatically with spark ignition system

### ACCESSORIES

2-Burner Wok Grate

Black Knobs

Filler Trim

Red Knobs

S-Grates

Stainless Steel Knobs


Stainless steel, brass or chrome bezels

High altitude conversion kits available

5" and 10" stainless steel risers, and 20" riser with shelf

Accessories available through an authorized dealer.


For local dealer information, visit [subzero-wolf.com/locator](http://subzero-wolf.com/locator).

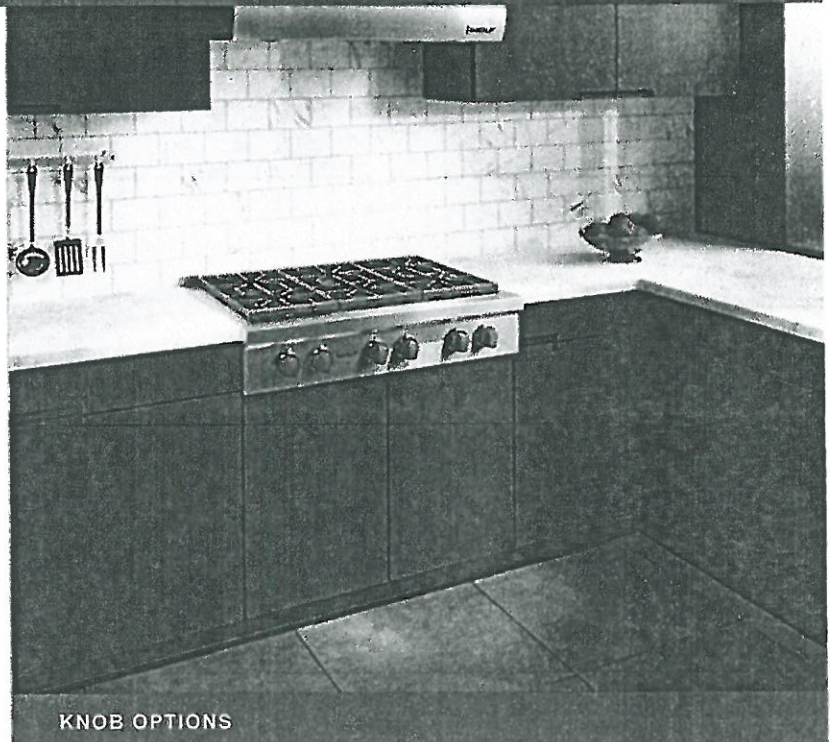

KNOB OPTIONS



### TOP CONFIGURATION

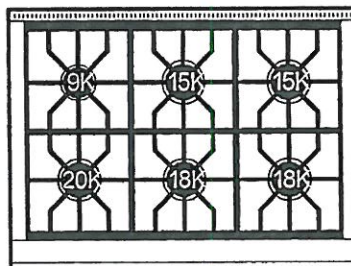

### RANGETOP SPECIFICATIONS

- Stainless-steel island trim (included)
- Stainless-steel bezels
- 1 - 9,200 Btu burner
- 2 - 15,000 Btu burners
- 2 - 18,000 Btu burners
- 1 - 20,000 Btu burner

April 8, 2021  
PV-51





# 36" DESIGNER OVER-AND-UNDER REFRIGERATOR/FREEZER WITH ICE MAKER - PANEL READY

SUB-ZERO

IT-36CI




## FEATURES

- Monitor and control remotely with Wi-Fi connectivity
- Accepts custom panels for an integrated look within cabinetry or stainless-steel accessory panels and handles to match other Sub-Zero, Wolf, and Cove products
- Preserves frozen foods with frigid, dry air
- Controls temperature within one degree of setpoint
- Locks in cold air with a magnetic door seal system
- Fight spoilage and odors with a NASA-inspired air purification system
- Filters water and ice, removing contaminants, chlorine taste, and odor
- Yields ice automatically and "max ice" for additional production
- Keeps produce fresher with high-humidity, sealed crisper and deli drawers
- Refer to freshness cards for tips on food preservation, use, and care
- Promotes easy clean-up with Nano-coated, spill-proof shelves
- Control brightness with soft-on LED lighting

## ACCESSORIES

- Air Purification Cartridge
- Egg Container
- Reduced Toe Kick Divider
- Stainless Steel Side Panel
- Stainless Steel Top Panel
- Water Filter
- Stainless Steel Tubular Handles
- Stainless Steel Pro Handles
- Dual Installation Kits
- Stainless Steel Door Panels With Pro Handle
- Stainless Steel Door Panels With Tubular Handle
- Stainless Steel Drawer Panels With Pro Handles
- Stainless Steel Drawer Panels With Tubular Handles
- Stainless Steel Dual Installation Kickplates

Accessories are available through an authorized dealer.  
For local dealer information, visit [subzero-wolf.com/locator](http://subzero-wolf.com/locator).

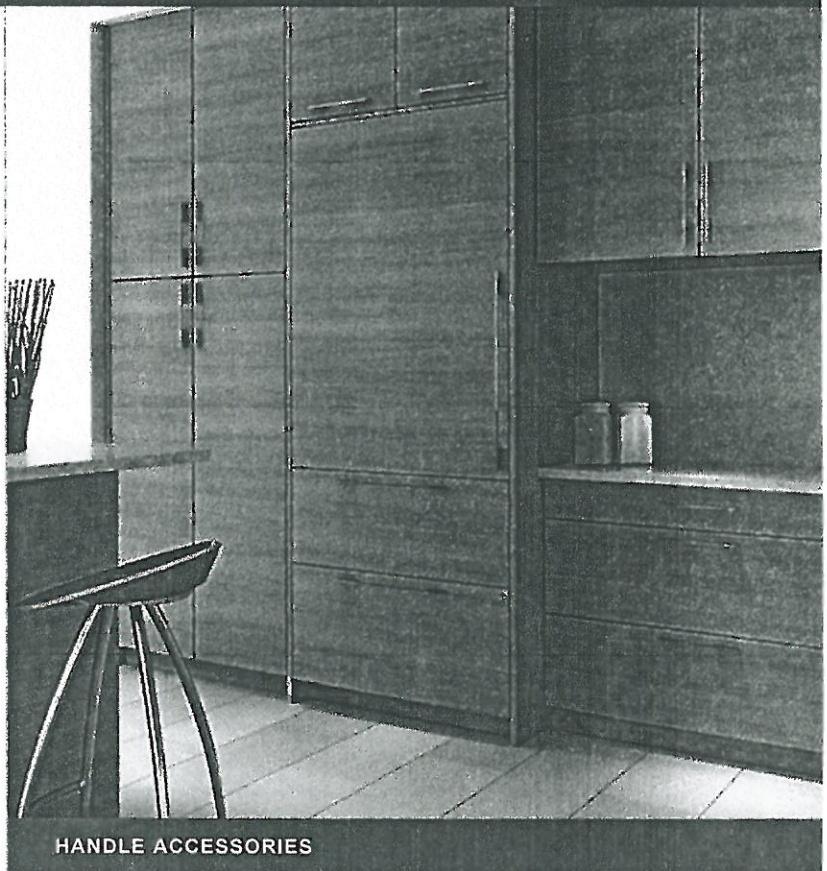

HANDLE ACCESSORIES

PRO



TUBULAR



## PRODUCT DETAILS

### REFRIGERATOR

- LED refrigerator and freezer lights
- 4 glass refrigerator shelves (3 adjustable; 1 stationary)
- Crisper drawer with dividers and sliding cover
- 3 door bins (2 adjustable; 1 stationary)
- 1 adjustable dairy compartment

### FREEZER

- 2 full-extension roll-out freezer drawers; one with adjustable dividers
- Automatic ice maker with removable ice container

April 8, 2021

PV-51



# 36" DESIGNER OVER-AND-UNDER REFRIGERATOR/FREEZER WITH ICE MAKER - PANEL READY



SUBZERO

## PRODUCT SPECIFICATIONS

|                       |                                                       |
|-----------------------|-------------------------------------------------------|
| Model                 | IT-36CI                                               |
| Dimensions            | 36"W x 84"H x 24"D                                    |
| Door Clearance        | 34 1/2"                                               |
| Drawer Clearance      | 18 3/8"                                               |
| Refrigerator Capacity | 13.3 cu. ft.                                          |
| Freezer Capacity      | 6.4 cu. ft.                                           |
| Electrical Supply     | 115 VAC, 60 Hz                                        |
| Electrical Service    | 15 amp dedicated circuit                              |
| Plumbing Supply       | 1/4" OD copper, braided stainless steel or PEX tubing |
| Plumbing Pressure     | 35-120 psi                                            |

## ELECTRICAL


## PLUMBING

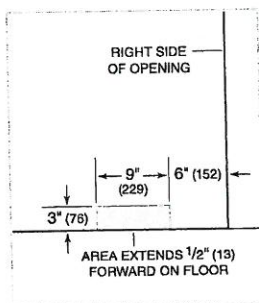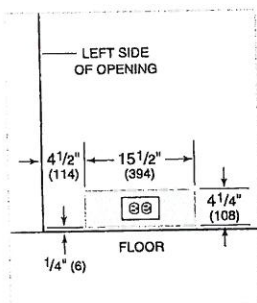

PANEL SPECIFICATIONS For complete panels specifications including width/height, weight requirements and thickness requirements visit [subzero-wolf.com/reveal](http://subzero-wolf.com/reveal).



NOTE: Dimensions in parenthesis are in millimeters unless otherwise specified

## INTERIOR VIEW

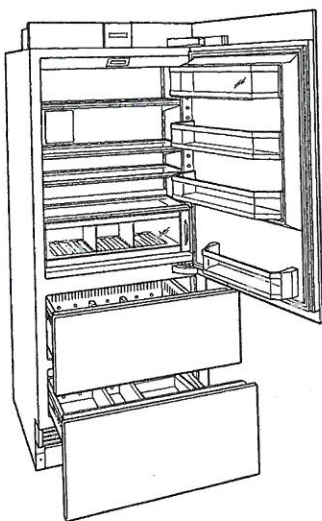


This illustration is intended for interior reference only and may not represent the exterior of the model being specified.

## DIMENSIONS

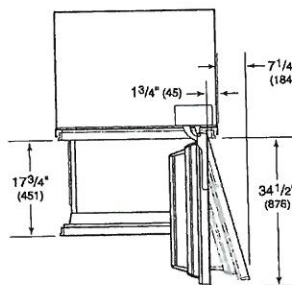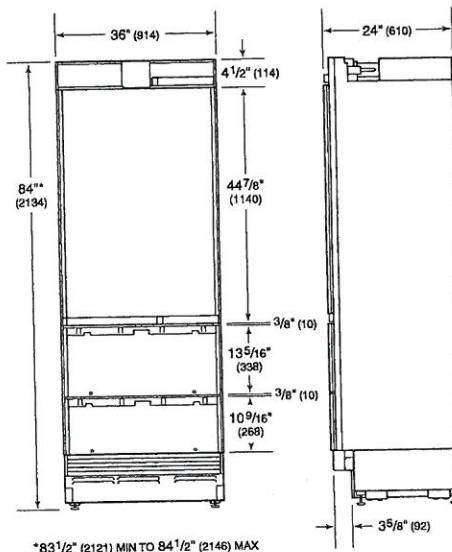

## STANDARD INSTALLATION

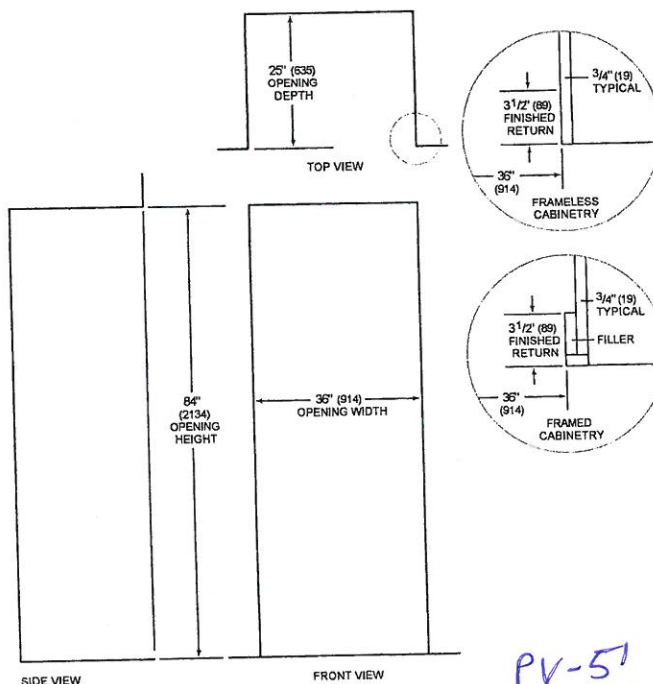


NOTE: 3 1/2" (89) finished returns will be visible and should be finished to match cabinetry

PV-51  
April 8, 2021

## Panel Specifications

Single Model: IT-36CI

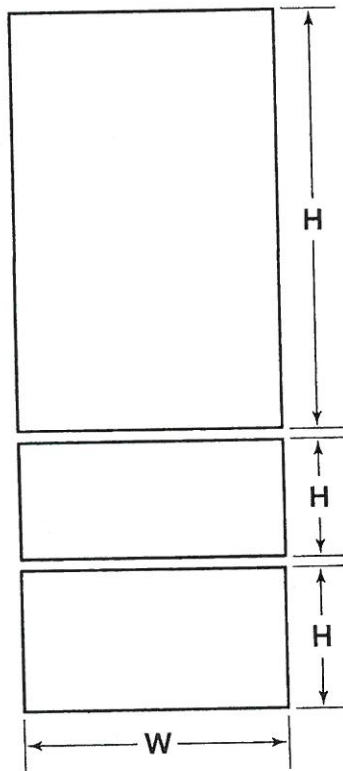

| PANEL          | WIDTH                            | HEIGHT                             | MIN THICKNESS                 | MAX WEIGHT |
|----------------|----------------------------------|------------------------------------|-------------------------------|------------|
| Door           | 35 <sup>3</sup> / <sub>4</sub> " | 49 <sup>3</sup> / <sub>8</sub> "   | <sup>5</sup> / <sub>8</sub> " | 60 lbs     |
| Drawer (Upper) | 35 <sup>3</sup> / <sub>4</sub> " | 13 <sup>9</sup> / <sub>16</sub> "  | <sup>5</sup> / <sub>8</sub> " | 15 lbs     |
| Drawer (Lower) | 35 <sup>3</sup> / <sub>4</sub> " | 16 <sup>11</sup> / <sub>16</sub> " | <sup>5</sup> / <sub>8</sub> " | 15 lbs     |

PLEASE NOTE: Panel specs change slightly when units are combined. Visit <http://www.subzerowolf.com/trade-resources/reveal> for exact dimensions.

April 8, 2021

PV-51

## Panel Planning Notes

Single Model: IT-36CI

For designer models, custom door panels and handle hardware must be provided.

The thickness of the custom panel can vary. A minimum 5/8" (16) thick panel is required, but the thickness can be increased provided it does not exceed the weight limit.

The depth of each designer model is 24" (610). Allow for panel thickness when planning the finished opening depth.

D-style handles are recommended. Door handles must be located near the edge of the panel opposite the hinge and should be centered top to bottom.

Typical panel dimensions are based on an 84" (2134) finished height for column and tall models and 1/8" (3) reveals. Panel dimensions must be adjusted accordingly for all other installations. Finish all sides of custom panels. They will be visible when the door/drawer is open.

Stainless steel tubular and pro handles are available through an authorized Sub-Zero dealer.

Drawer handles must be located near the top edge of each panel.

### Minimum Panel Thickness

5/8"

### Standard Handle Lengths (Optional)

| HANDLE         | TUBULAR | PRO     |
|----------------|---------|---------|
| IT-36CI Door   | 33 1/4" | 31 1/2" |
| IT-36CI Drawer | 33 1/4" | 31 1/2" |


April 8, 2021

PV-SI

### Door Panel Height

Typical panel dimensions are based on an 84" (2134) finished height for column and tall models and 34 1/2" (876) for drawer models, with a 4" (102) toe kick and 1/8" (3) reveals. Panel dimensions must be adjusted accordingly for all other installations.


The height of the custom door panel can extend beyond the typical panel height, provided it does not exceed the weight limit.

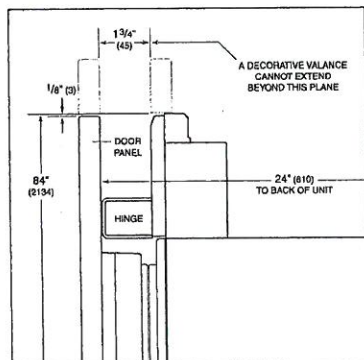

Upper valance—column and tall (side view).

### Toe Kick Clearance

The height of the toe kick area can extend beyond the typical toe kick height, provided it does not exceed the dimensions in the illustration below. Toe kick heights from 2" (51) to 3 7/8" (98) require a reduced toe kick accessory available through an authorized Sub-Zero dealer.

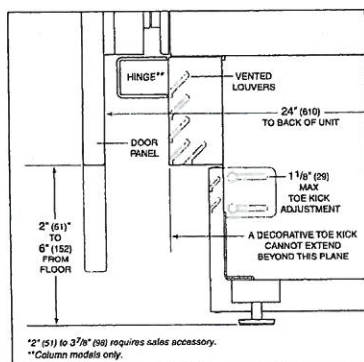

Toe kick (side view).

April 8, 2021  
PR-51


April 8, 2021  
PV-51



# LDP6797\*

## Top Control Dishwasher with QuadWash™

- 15 Place Settings
- QuadWash™
- 9 Wash Cycles
- EasyRack™ Plus with 3rd Rack and Glide Rail
- 44 dBA LoDecibel™ Quiet Operation
- NeveRust™ Stainless Steel Tub
- ENERGY STAR® Qualified
- Available in Black Stainless Steel, **NEW** Matte Black Stainless Steel, Stainless Steel, Black and White

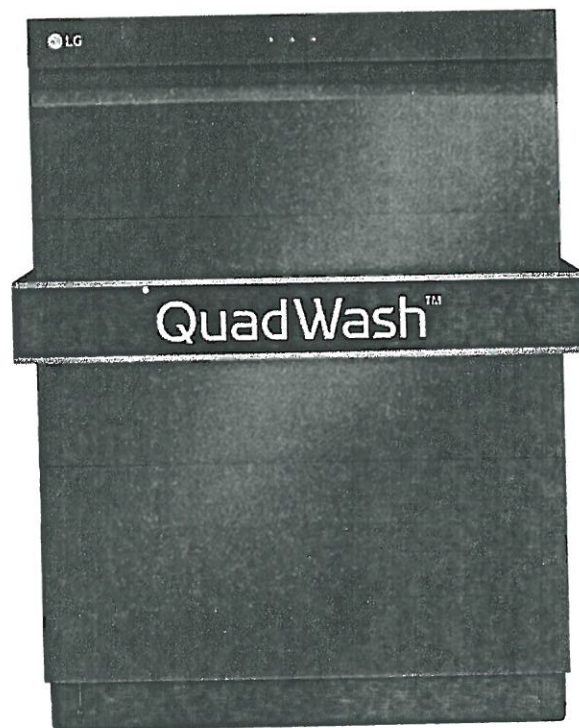

| CAPACITY                     |       |
|------------------------------|-------|
| Total Place Settings         | 15    |
| Upper Rack Dish Height Limit | 7.1"  |
| Lower Rack Dish Height Limit | 12.5" |

| RACKS AND BASKETS                     |                                  |
|---------------------------------------|----------------------------------|
| Cutlery Baskets                       | Yes                              |
| Cup Rack                              | Yes                              |
| Stemware Holder                       | Yes                              |
| Fold Down Tines                       | Yes (Half Fold on Upper & Lower) |
| BPA-Free Nylon Coated Racks and Tines | Yes                              |
| Rack Handle                           | Yes (Upper/Lower)                |
| Glide Rail                            | Yes (Upper)                      |
| EasyRack™ Plus System                 | Yes                              |
| Height Adjustable Upper Rack          | Yes (One Touch; 3 Level)         |
| Height-Adjustable 3rd Rack            | Yes                              |


| STYLE AND DESIGN                    |                                                                                   |
|-------------------------------------|-----------------------------------------------------------------------------------|
| Control Panel Location              | Top                                                                               |
| Electronic Controls                 | Hidden SmoothTouch™ Controls with LED Display                                     |
| SignalLight™ Cycle Indicator Lights | 3                                                                                 |
| Time Remaining Indicator            | Yes (LED)                                                                         |
| Tub Material                        | NeveRust™ Stainless Steel                                                         |
| Tub Light                           | No                                                                                |
| Handle                              | Flush                                                                             |
| All Available Colors                | Black Stainless Steel, Matte Black Stainless Steel, Stainless Steel, Black, White |
| Scratch-Resistant                   | Yes (Black Stainless Steel Model Only)                                            |
| Fingerprint Resistant               | Yes (Black Stainless Steel Model Only)                                            |

| FEATURES                                                                           |   |
|------------------------------------------------------------------------------------|---|
| TrueSteam®                                                                         | No                                                                                                 |
| QuadWash®                                                                          | Yes                                                                                                |
| Inverter Direct Drive Motor                                                        | Yes                                                                                                |
| LoDecibel™ Quiet Operation                                                         | 44 dBA                                                                                             |
| Number of Wash Cycles                                                              | 9 (Auto, Heavy, Delicate, Normal, Turbo, Download Cycle, Machine Clean, Rinse, Express)            |
| Number of Options                                                                  | 8 (Dual Zone, Half Load, Energy Saver, High Temp, Extra Dry, Delay Start, Control Lock, Night Dry) |
| Number of Spray Arms                                                               | 3 (Top, Upper, Lower)                                                                              |
| SenseClean™ Wash System                                                            | Yes                                                                                                |
| Vario Wash                                                                         | Yes                                                                                                |
| Detergent and Rinse-Aid Dispenser                                                  | Yes                                                                                                |
| Hybrid Condensing Drying System                                                    | Yes                                                                                                |
| End of Cycle Indicator                                                             | Yes (Beeper + END indication on display)                                                           |
| Hidden Water Heater                                                                | Yes                                                                                                |
| Safety Float Switch (Leaks)                                                        | Yes                                                                                                |
| Soil (Turbidity) Sensor                                                            | Yes                                                                                                |
| Tub Insulation (Damping Sheet, Sound Absorbing Material (felt), Base)              | Yes                                                                                                |
| BPA-Free Nylon Coated Racks and Tines                                              | Yes                                                                                                |
| Anti-Bacterial Treatment (Sump, Inner / Outer filter, Drain pump case, Drain hose) | Yes                                                                                                |
| Balanced Door                                                                      | Yes                                                                                                |
| Multi-Level (5) Water Direction                                                    | Yes (Top Nozzle (Down), Upper Nozzle (Up/Down), Lower Nozzle (Up/Down))                            |
| 3-Stage Filtration System                                                          | Yes                                                                                                |
| SMART THING™ TECHNOLOGY                                                            |   |
| Wi-Fi                                                                              | Yes                                                                                                |
| NFC Tag On                                                                         | No                                                                                                 |

| POWER RATINGS          |         |
|------------------------|---------|
| ENERGY STAR® Qualified | Yes     |
| CEE Tier               | 1       |
| Energy Use (kWh/Year)  | 258 kWh |
| Water Factor (WF)      | 2.8     |

| LIMITED WARRANTY                  |          |
|-----------------------------------|----------|
| Labor                             | 1 Year   |
| Parts                             | 2 Years  |
| Control Board and Rack Parts      | 5 Years  |
| Direct Drive Motor                | 10 Years |
| Stainless Steel Door Liner or Tub | Lifetime |

| UPC CODES                             |              |
|---------------------------------------|--------------|
| LDP6797ST Stainless Steel             | 048231022156 |
| LDP6797BD Black Stainless Steel       | 048231022187 |
| LDP6797BM Matte Black Stainless Steel | 048231025041 |
| LDP6797WW White                       | 048231022170 |
| LDP6797BB Black                       | 048231022163 |

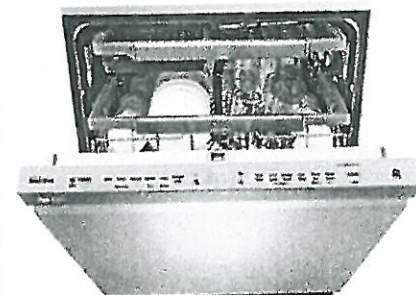

© 2017 LG Electronics USA, Inc. All rights reserved. "LG Life's Good" is a registered trademark of LG Corp. All other product and brand names are trademarks or registered trademarks of their respective owners. Design, features and specifications are subject to change without notice. Non-metric weights and measurements are approximate. Some features may require Internet access. Content and services may vary by product and are subject to change without notice. 5/2/17

# LDP6797\*

## QUICK INSTALL & CLEARANCES

For full installation directions/clearances please refer to the corresponding User Manual and Installation Guide.

### DIMENSIONS / CLEARANCES / WEIGHT


|                                         |                        |
|-----------------------------------------|------------------------|
| Product Dimensions (in) (W x H x D)     | 23.75" x 33.6" x 24.6" |
| Product Weight (lbs)                    | 81.6 lbs               |
| Depth with Door Closed with Handle (in) | 27-1/8"                |
| Depth with Door Open (in)               | 50.5"                  |
| Clearances (W x H x D)                  | 24" x 33.5" x 24"      |
| Carton Dimensions (in) (W x H x D)      | 28" x 34.7" x 29.6"    |
| Shipping Weight with Carton (lbs)       | 94.8 lbs               |

### POWER RATINGS

|                        |         |
|------------------------|---------|
| ENERGY STAR® Qualified | Yes     |
| CEE Tier               | 1       |
| Energy Use (kWh/Year)  | 258 kWh |
| Water Factor (WF)      | 2.8     |

### PREPARING ELECTRICAL WIRING

- Operate this appliance with the correct voltage as shown in your User Manual and on the rating plate. Connect it to a dedicated, properly grounded branch circuit which is protected by a time delay fuse. Connect the appliance using 3-wires, including a ground wire.
- If an outlet and other power connector are used, it should be in an accessible location adjacent to and not behind the dishwasher and within 4 ft. of the dishwasher's side.
- The wiring must be grounded properly. If in doubt, have it checked by a qualified electrician. Do not connect any other appliance to the same outlet.
- Route the wiring.
- Make sure the electrical cable is oriented in the right side channel.

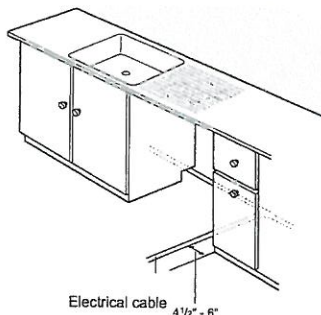


### WARNING

- For personal safety, remove house fuse or open circuit breaker before installation.
- Do not use an extension cable or adapter with this dishwasher.
- If you find any damage to the dishwasher, contact your retailer or contractor.

### PREPARING CABINET OPENING

- This dishwasher is designed to fit a standard dishwasher opening. An opening may be needed on both sides to route plumbing and electrical connections.
- Select a location as close to the sink as possible for easy connections to water and drain lines.
- To ensure proper drainage, install the dishwasher no more than 12 ft. from the sink.
- If installing the dishwasher in a corner, leave a minimum of 2" between the dishwasher and the adjacent wall.
- To allow for proper clearance of plumbing and electrical, use the template included with the literature to determine the clearance on the side of the cabinet where the cabinet meets the back wall. Using a 2 1/2" diameter hole saw, drill a hole in the target area as shown on the template.

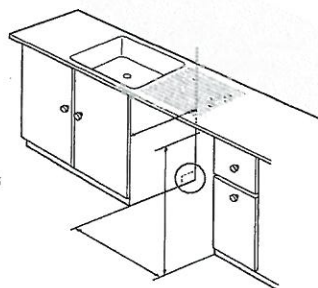

### WARNING


Don't use existing holes unless they are in the target area. Otherwise, the water supply and drain hose may be damaged by being crushed or kinked.

### CAUTION

Failure to properly locate the hole for the water and drain lines may prevent the dishwasher from installing flush with the cabinets and could result in kinked or damaged lines. Installation damage is not covered by the warranty, and leaks caused by improper installation may result in property damage.

### PREPARING WATER SUPPLY CONNECTION

- Make sure the house water supply is turned off before connecting the dishwasher water lines.
- Connect the dishwasher to a hot water supply with a temperature range between 120 °F (49 °C) and 149 °F (65 °C). This temperature range provides the best washing results and shortest cycle time. To prevent damage to dishes, the temperature should not exceed 149 °F (65 °C).
- When connecting the dishwasher water line, sealing tape or compound should be used on pipe threads to avoid leaks. Tape or compound should not be used on compression fittings.
- The water supply tube must be located in the left side channel.

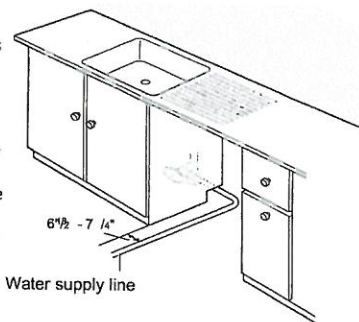

### NOTE

Use new hoses when connecting to the water supply. Do not reuse old hoses.



PR-51

April 8, 2021

DO30PM/S/PH



## FEATURES

Cook for a crowd, with two ovens and twice the capacity

Preheats faster and cooks more consistently across all racks due to its advanced Dual VertiCross™ convection system

Assures predictably delicious results with a variety of modes, including Convection Roast, Proof, and Dehydrate

Prepares 50 popular dishes with the Gourmet feature that automatically adjusts cook times and temperatures

Handles multiple dishes simultaneously with our largest capacity oven (13 percent larger)

Insert a temperature probe to tell you exactly when it is done—and in gourmet mode, it will alert you the moment the dish is ready

Uncomplicate cooking with innovative, interactive color touchscreen controls

Makes a statement with Wolf's iconic red control knobs

Integrates beautifully into surrounding cabinetry with flush installation

Ensures excellent visibility via three bright halogen lights and large, triple-panel-glass door windows

Master your technique with tips and recipes from the Mastering the M series oven guide

## ACCESSORIES

30" Broiler Pan

30" Full-Extension Ball-Bearing Oven Rack

30" Premier Baking Sheet

30" Standard Oven Rack

Bake Stone Kit

Black Knobs

Dehydration Kit

Full-Extension Ball Bearing Rack

Multi-Function Pan

Oven Rack Set (3)

Red Knobs

Stainless Knobs

Temperature Probe

Accessories available through an authorized dealer.

For local dealer information, visit [subzero-wolf.com/locator](http://subzero-wolf.com/locator).



KNOB OPTIONS




April 8, 2021

PV-SI

## PRODUCT SPECIFICATIONS


|                            |                                |
|----------------------------|--------------------------------|
| Model                      | DO30PM/S/PH                    |
| Dimensions                 | 29 7/8"W x 50 7/8"H x 23"D     |
| Oven 1 Interior Dimensions | 25 1/4"W x 17 1/2"H x 19 7/8"D |
| Oven 2 Interior Dimensions | 25 1/4"W x 17 1/2"H x 19 7/8"D |
| Overall Capacity           | 5.1 cu. ft.                    |
| Usable Capacity            | 3.3 cu. ft.                    |
| Door Clearance             | 21 3/8"                        |
| Electrical Supply          | 240/208 VAC, 60 Hz             |
| Electrical Service         | 50 amp dedicated circuit       |
| Conduit Length             | 5 Feet                         |

## ELECTRICAL

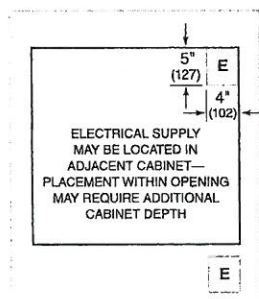


NOTE: Dimensions in parenthesis are in millimeters unless otherwise specified

## DIMENSIONS

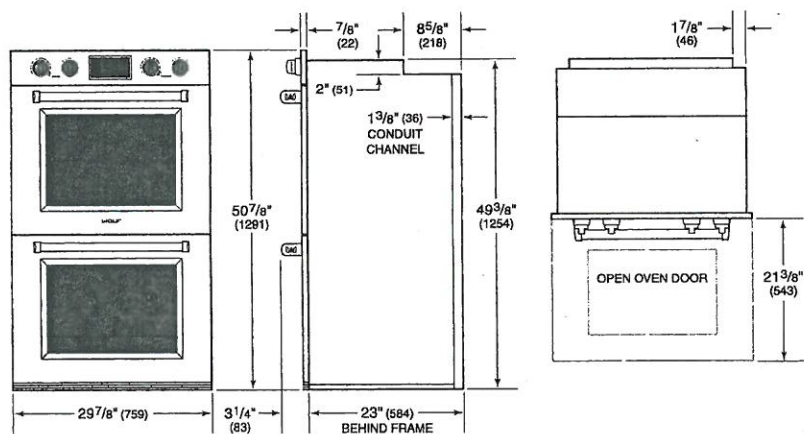

## STANDARD INSTALLATION

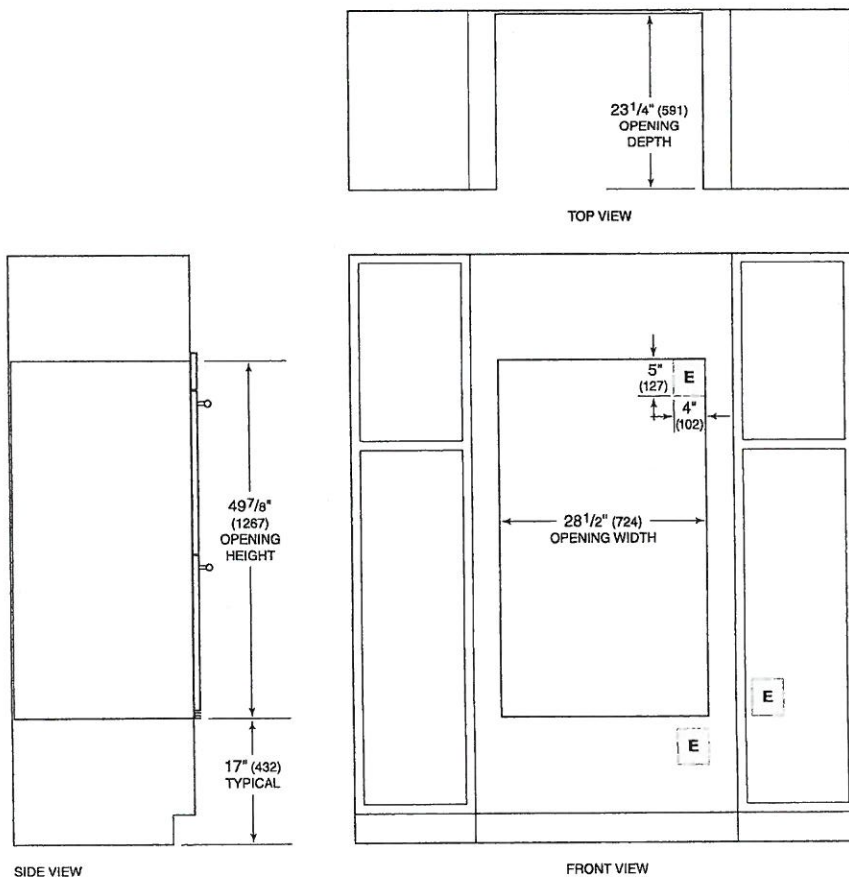

SIDE VIEW

FRONT VIEW

NOTE: Location of electrical supply within opening may require additional cabinet depth.

April 8, 2021

PV-SI

DO30PM/S/PH



## FEATURES

Cook for a crowd, with two ovens and twice the capacity

Preheats faster and cooks more consistently across all racks due to its advanced Dual VertiCross™ convection system

Assures predictably delicious results with a variety of modes, including Convection Roast, Proof, and Dehydrate

Prepares 50 popular dishes with the Gourmet feature that automatically adjusts cook times and temperatures

Handles multiple dishes simultaneously with our largest capacity oven (13 percent larger)

Insert a temperature probe to tell you exactly when it is done—and in gourmet mode, it will alert you the moment the dish is ready

Uncomplicate cooking with innovative, interactive color touchscreen controls

Makes a statement with Wolf's iconic red control knobs

Integrates beautifully into surrounding cabinetry with flush installation

Ensures excellent visibility via three bright halogen lights and large, triple-panel-glass door windows

Master your technique with tips and recipes from the Mastering the M series oven guide

## ACCESSORIES

30" Broiler Pan

30" Full-Extension Ball-Bearing Oven Rack

30" Premier Baking Sheet

30" Standard Oven Rack

Bake Stone Kit

Black Knobs

Dehydration Kit

Full-Extension Ball Bearing Rack

Multi-Function Pan

Oven Rack Set (3)

Red Knobs

Stainless Knobs

Temperature Probe

Accessories available through an authorized dealer.

For local dealer information, visit [subzero-wolf.com/locator](http://subzero-wolf.com/locator).




Apr 18, 2021  
PR-51




# PRODUCT SPECIFICATIONS

|                            |                                |
|----------------------------|--------------------------------|
| Model                      | DO30PM/S/PH                    |
| Dimensions                 | 29 7/8"W x 50 7/8"H x 23"D     |
| Oven 1 Interior Dimensions | 25 1/4"W x 17 1/2"H x 19 7/8"D |
| Oven 2 Interior Dimensions | 25 1/4"W x 17 1/2"H x 19 7/8"D |
| Overall Capacity           | 5.1 cu. ft.                    |
| Usable Capacity            | 3.3 cu. ft.                    |
| Door Clearance             | 21 3/8"                        |
| Electrical Supply          | 240/208 VAC, 60 Hz             |
| Electrical Service         | 50 amp dedicated circuit       |
| Conduit Length             | 5 Feet                         |

# DIMENSIONS

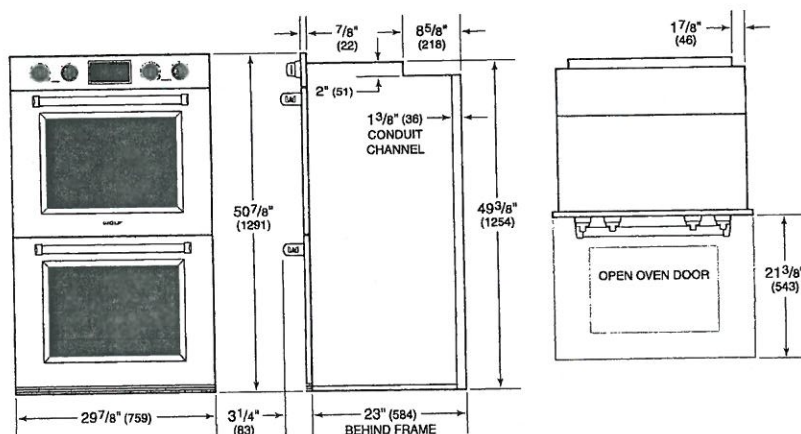


# ELECTRICAL

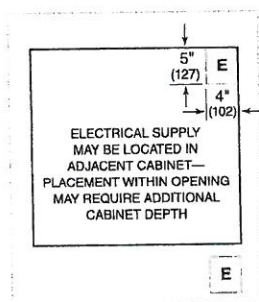

NOTE: Dimensions in parenthesis are in millimeters unless otherwise specified

# FLUSH INSTALLATION

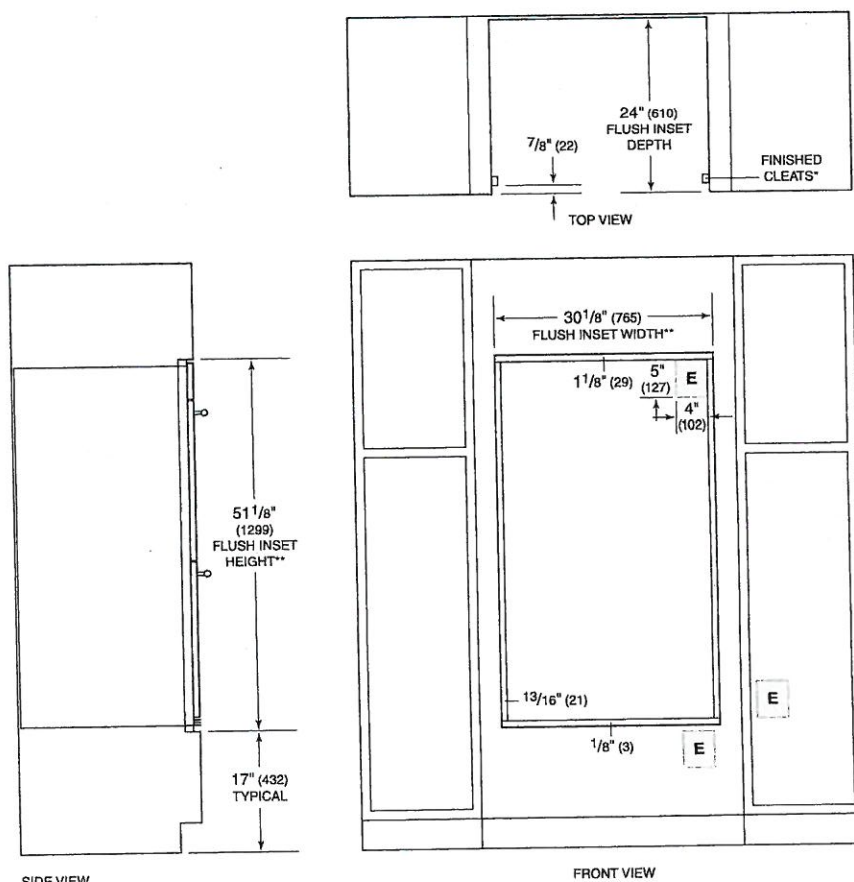

\*1\"/>


NOTE: Location of electrical supply within opening may require additional cabinet depth.

\* SU90934X  
SU90946X  
SU90955X


## SU 909

stainless steel AISI 430

\* LEAVE STD 6" DUCT \*

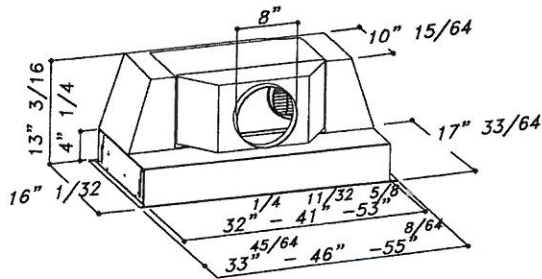

Back vented

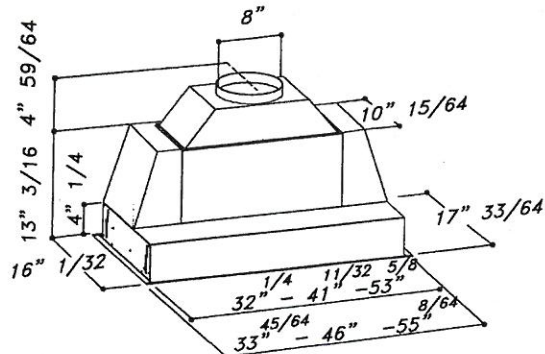

Top vented

|               |   |
|---------------|---|
| MOTOR         | Dual Motor Aluminium die-cast housing 1100 CFM<br>Pressure: 800 Pa<br>Noise level: 66 dBA/5.1 sones                          |
| LIGHTING      | 2x1W Led spot for 34" and 46"<br>4x1W Led spot for 55"                                                                       |
| CONTROL PANEL | Chromed push button 4 Speeds + timer +light                                                                                  |
| GREASE FILTER | Commercial style baffle filters                                                                                              |
| AIR OUTLET    | 8"   |
| DISCHARGE     | Vertical and horizontal   |
| CUT OUT       | 32"15/32 x 16"1/8 SU909 34" version<br>44"23/32 x 16"1/8 SU909 46" version<br>53"3/4 x 16"1/8 SU909 55" version              |
| ACCESSORIES   | Charcoal filters: KF7 (Order 2 pcs for SU909 34" version)<br>KF7 (Order 3 pcs for SU909 46"/55" version)<br>Cod. 60080477002 |

Apr 18, 2021  
PV-51

## LG LAUNDRY

## WM4500HBA

5.0 cu.ft. Front Load Washer with TurboWash™ 360°  
and Built-In Intelligence

5.0 cu. ft. Mega Capacity  
TurboWash™ 360° Technology  
AI Fabric Sensor/ Smart Pairing™  
ezDispense™ Automatic Dispenser  
AAFA Certified LG washer  
LG ThinQ® Technology / Proactive Customer Care  
ColdWash™ Technology  
Direct Drive Motor 10-Year Limited Warranty  
ENERGY STAR® Certified  
Closet Depth  
NeveRust™ Stainless Steel Tub and Lifters

## AVAILABLE COLORS



BLACK STEEL



## LG ThinQ®

Enjoy new ways to control your  
home with LG smart appliances

- Use the ThinQ® app to start the laundry while you're out
- Get alerts when the cycle is finished
- With Smart Pairing™, the washer can tell the dryer to select a compatible drying cycle

works with the  
Google Assistant

WORKS WITH  
alexa

## SUMMARY

|                                  |   |
|----------------------------------|---|
| Type                             | Front Load Washer   |
| Capacity (cu.ft.)                | 5.0 cu. ft.   |
| Matching Electric Dryer          | DLEX4500B   |
| Matching Gas Dryer               | DLGX4501B   |
| Color                            | Black Steel (B)   |
| <b>APPEARANCE</b>                |   |
| Hard Buttons                     | Yes   |
| Touch Buttons                    | Yes   |
| Dial-A-Cycle™                    | Yes   |
| <b>ENERGY</b>                    |   |
| ENERGY STAR® Most Efficient 2019 | Yes   |
| ENERGY STAR® Qualified           | Yes   |
| CEE Tier                         | Advanced   |
| IMEF                             | 3.1   |
| IWF                              | 2.9   |
| <b>WASH PROGRAMS</b>             |   |
| No. of Programs                  | 14   |
| Wash Programs                    | Normal, Heavy Duty, Bedding, Sanitary, Allergiene™, Bright White, Tub Clean, Delicates, Perm. Press, Sportswear, Towels, Speed Wash, Rinse+Spin, Downloaded                     |
| <b>WASH OPTIONS</b>              |   |
| No. of Options                   | 15   |
| Options                          | TurboWash®, Steam, Fresh Care, Pre-wash, Remote Start, Delay Wash, Wi-Fi, Add Item, Extra Rinse, Control Lock, Drum Light, ColdWash, Spin Only, Detergent Level, Softener Level |
| <b>WASH DETAILS</b>              |   |
| No. of Wash/Rinse Temps          | 5   |
| Wash/Rinse Temps                 | Extra Hot, Hot, Warm, Cold, Tap Cold   |

## No. of Spin Speeds

## Spin Speeds

## Max RPM

## Water Levels

## No. of Soil Levels

## FABRIC CARE FEATURES

## AI DD™

## TurboWash™ 360 Technology

## Steam Technology

## Allergiene™ Cycle

## Sanitary Cycle

## ColdWash™ Option

## SenseClean™ System

## CONVENIENCE FEATURES

## TrueBalance™ Anti-Vibration System

## 4 Tray Dispenser

## LoDecibel™ Quiet Operation

## End of Cycle Signal

## LoadSense

## Child Lock

## Auto Suds Removal

## Leveling Legs

## Easy Loading TiTub™

## ThinQ® TECHNOLOGY

## SmartDiagnosis™ (v3.0)

## Wi-Fi

## Remote Start and Cycle Monitor

## Energy Monitoring

## MOTOR AND AGITATOR

## Motor Type

## Axis

5

Extra High, High, Medium, Low, No Spin

1300

Load Sensing

5

Yes

Yes

Yes

Yes

Yes

Yes

Yes

Yes

ezDispense cartridge(Detergent, Softener), Main Wash, Bleach(cup)

Yes

Yes

Yes

Yes

Yes

4 Adjustable Legs

Yes

Yes

Yes

Yes

Yes

Inverter Direct Drive Motor

Horizontal

## MATERIALS AND FINISHES

## NeveRust™ Stainless Steel Drum

## Cabinet

## Control Panel

## Top Plate

## Door / Rim

## Door Cover

## All Available Colors

## CERTIFICATION

## AAFA

## POWER SOURCE

## Ratings

## Electrical Requirements

## Type

## OPTIONS/ACCESSORIES

## Pedestal

## Pedestal (WxHxD)

## LG Sidekick™ Pedestal Washer

## LG Sidekick™ Pedestal Washer (WxHxD)

## Stacking Kit

## DIMENSIONS

## Product (WxHxD)

## Depth with Door Open

## Carton (WxHxD)

## Weight (Product/Carton)

## LIMITED WARRANTY

## Parts and Labor

## Direct Drive Motor

## Drum

## UPC CODES

## WM4500HBA (Black Steel)

Yes

PCM

Plastic

Painted

Glass/Chrome

Dark Black Tinted Square Cover

Black Steel (B)

Yes

UL Listed

120V, 10 Amps

Electric

WDP4B

27 x 14 1/8 x 30 3/4 (50 9/16 D with door open)

WD100CB

27 x 14 1/8 x 30 3/4 (50 9/16 D with door open)

KSTK1

27" x 39" x 33 1/4"

(53 1/4" D with door open)

29 23/32" x 43 4/32" x 33 28/32"

201.5 / 215.2 lbs

1 Year

10 Years

3 Years

048231026772

April 8, 2021

PR-51

**⚠ WARNING**

- Certain internal parts are intentionally not grounded and may present a risk of electric shock only during servicing. Service personnel- Do not contact the following parts while the appliance is energized: pump, valve, motor, control board.

**Tools Needed**

- ① Pliers
- ② Flat-Blade Screwdriver
- ③ Level

**Choosing the Proper Location**

Check the following requirements for the install location before installing the washer.

- Allow for sufficient space between the walls and the washer for installation.
- Make sure that the floor is clean, dry and free of dust, dirt, water and oil so the leveling feet cannot slide easily. Leveling feet that can move or slide on the floor can contribute to excess vibration and noise.
- If the floor has too much flex, reinforce it to make it more rigid. If the floor is not solid, it may cause severe vibration and noise.
- If a drain pan must be used, take extra care to follow the instructions provided with the drain pan and make sure the leveling feet are adjusted for firm and even contact with the pan. Use of drain pans and failure to properly level the washer may result in increased vibration and noise during operation.

**Power Outlet**

- The power outlet must be within **60 inches (1.5 m)** of either side of the washer.
- Position the washer so that the outlet and plug are easily accessible.
- Do not overload the outlet with more than one appliance.
- The outlet must be grounded in accordance with current electrical wiring codes and regulations.
- Use a time-delay fuse or circuit breaker.


- It is the personal responsibility and obligation of the washer owner to have a proper outlet installed by a qualified electrician.

**Flooring**

- To minimize noise and vibration, install the washer on a level, solidly constructed floor capable of supporting the washer without flexing or bouncing.
- The washer must be installed on firm flooring to minimize vibration during the spin cycle. Concrete flooring is best, but a wood floor is sufficient, provided it is built to FHA standards.
- The floor under the washer must not slope more than 1 inch (2.5 cm) from front to back or side to side.
- Installing on carpeting and soft tile surfaces is not recommended.
- Never install the washer on a platform or weakly supported structure.

**Floor Installation**

To ensure sufficient clearance for water inlet hoses, drain hose and airflow, allow minimum clearances of at least **1 inch (2.5 cm)** at the sides and **4 inches (10 cm)** behind the washer. Be sure to allow for wall, door, or floor moldings that may increase the required clearances.

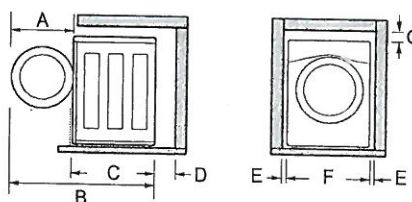


| Dimensions and Clearances |                    |
|---------------------------|--------------------|
| A                         | 24 3/4" (62.6 cm)  |
| B                         | 57 3/4" (146.6 cm) |
| C                         | 33 1/4" (84 cm)    |
| D                         | 4" (10 cm)         |
| E                         | 1" (2.5 cm)        |

| Dimensions and Clearances |               |
|---------------------------|---------------|
| F                         | 27" (70 cm)   |
| G                         | 1/4" (0.5 cm) |

### Stacking or Pedestal Installation

The washer can be stacked under a dryer or on top of a pedestal or pedestal washer.

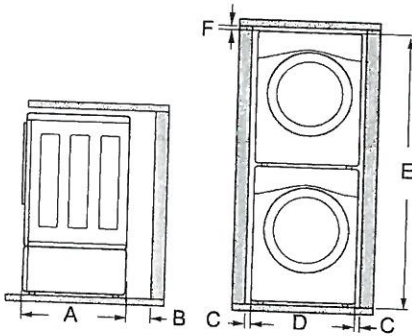

| Dimensions and Clearances |                    |
|---------------------------|--------------------|
| A                         | 33 1/4" (84 cm)    |
| B                         | 4" (10 cm)         |
| C                         | 1" (0.5 cm)        |
| D                         | 27" (70 cm)        |
| E                         | 77 1/2" (196.8 cm) |
| F                         | 1/4" (0.5 cm)      |

### NOTE

- Refer to the instructions packaged with the optional pedestal kit before stacking appliance on pedestal.
- Do not use a drain pan with a pedestal or pedestal washer installation as it can block the drawer. Using a drain pan may result in increased vibration and noise during operation.

## Unpacking and Removing Shipping Material

Remove all shipping materials from the washer for proper operation and inspect it for shipping damage.

### CAUTION


- Failure to remove shipping materials can cause excessive noise and vibration.

## Unpacking Shipping Material

\* This feature is only available on some models.


Lift the washer off the foam base.

- After removing the carton and shipping material, lift the washer off the foam base.
- Make sure the plastic drum support ①\* comes off with the base and is not stuck to the bottom of the washer.
- If you must lay the washer down to remove the carton base ②, always protect the side of the washer and lay it carefully on its side. Do not lay the washer on its front or back.

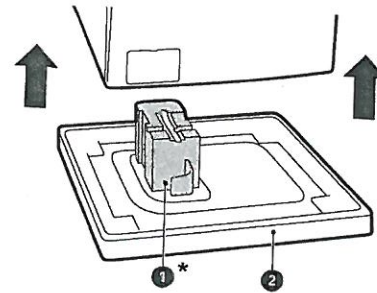

## Removing Shipping Material

- Remove the bolt assemblies.
  - Starting with the bottom two shipping bolts ③, use the included wrench to fully loosen all 4 shipping bolts by turning them counterclockwise.
  - Remove the bolt assemblies (bolts and retainers) by wiggling them slightly while pulling them out.

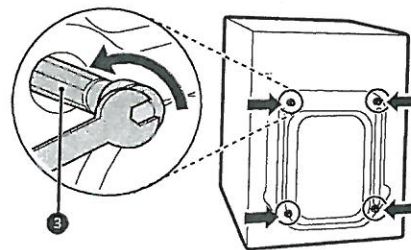


- Install the hole caps.

- Locate the hole caps ④ included in the accessory pack or attached to the back of

April 8, 2021   
 PV-51 

## Clearances

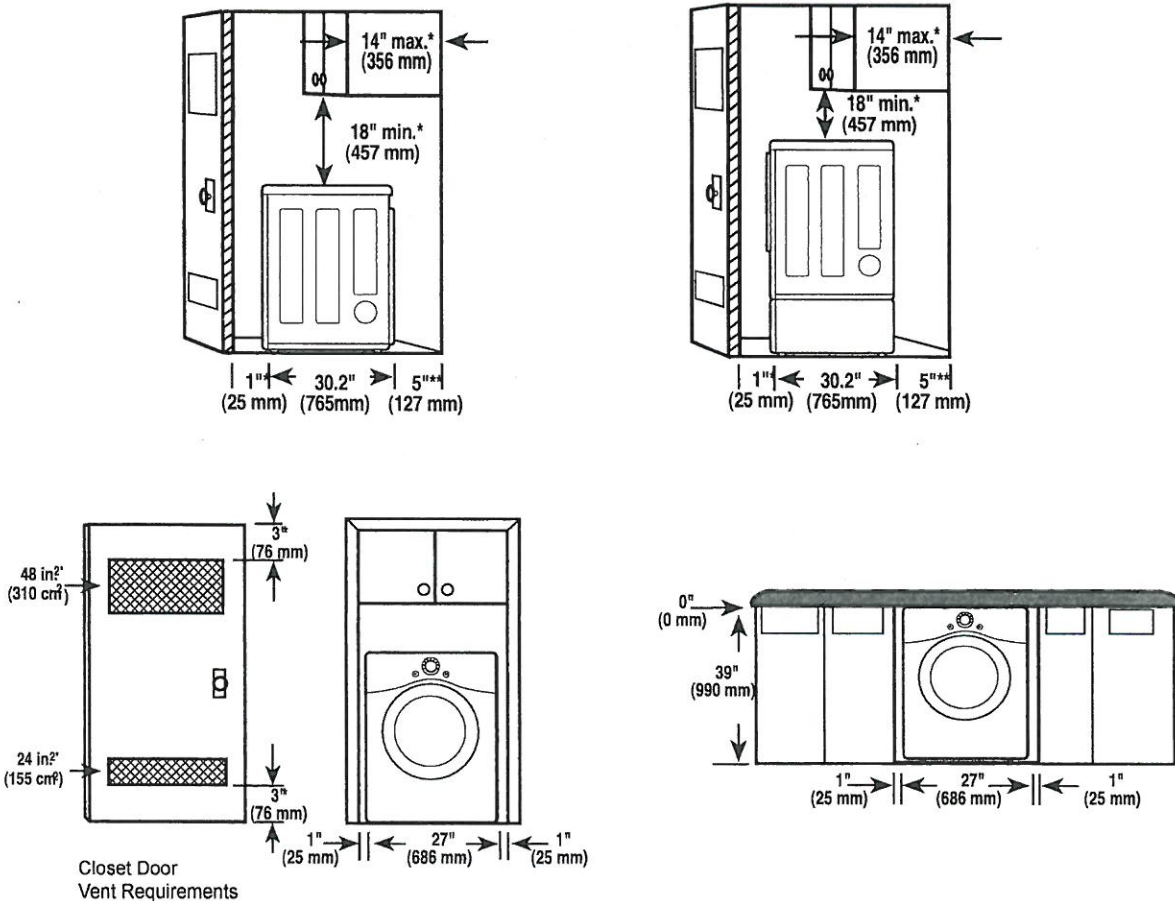

### Installation Spacing for Recessed Area or Closet Installation

The following clearances are recommended for this dryer. This dryer has been tested for clearances of 1 inch (2.5 cm) on the sides and rear. Recommended clearances should be considered for the following reasons:

- Additional clearances should be considered for ease of installation and servicing.
- Additional clearances should be considered on all sides of the dryer to reduce noise transfer. For closet installation, with a door, minimum ventilation openings in the top and bottom of the door are required. Louvered doors with equivalent ventilation openings are acceptable.


#### Closet Ventilation Requirements

Closets with doors must have both an upper and lower vent to prevent heat and moisture buildup in the closet. One upper vent opening with a minimum opening of 48 sq. in. (310 cm²) must be installed no lower than 6 feet above the floor. One lower vent opening with a minimum opening of 24 sq. in. (155 cm²) must be installed no more than one foot above the floor. Install vent grills in the door or cut down the door at the top and bottom to form openings. Louvered doors with equivalent ventilation openings are also acceptable.

#### NOTE

- There should be at least a little space around the dryer (or any other appliance) to eliminate the transfer of vibration from one appliance to another. If there is enough vibration, it could cause appliances to make noise or come into contact, causing paint damage and further increasing noise.

## Installation Spacing for Recessed Area or Closet, with Stacked Washer and Dryer

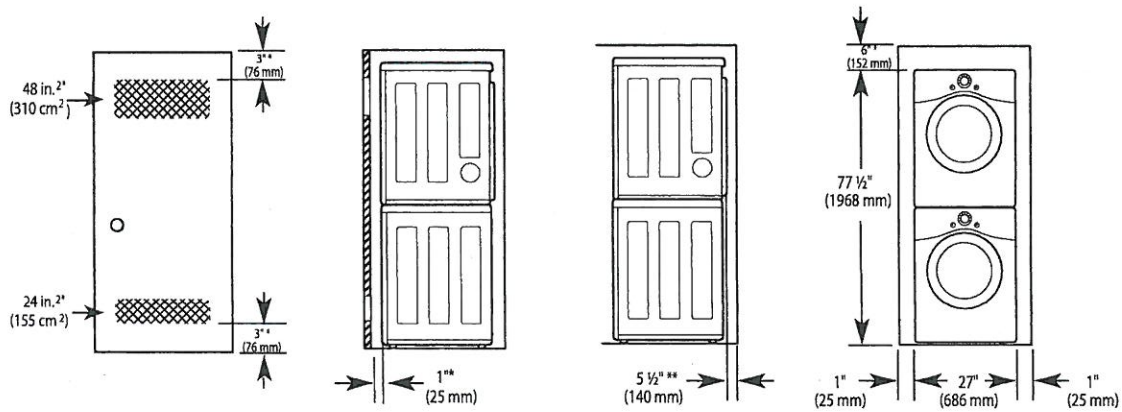


\* Required spacing

\*\* For side or bottom venting, 2-inch (5.1 cm) of spacing is allowed.

## Installation Spacing for Cabinet

For cabinet installation with a door, minimum ventilation openings in the top of the cabinet are required.

\* Required spacing

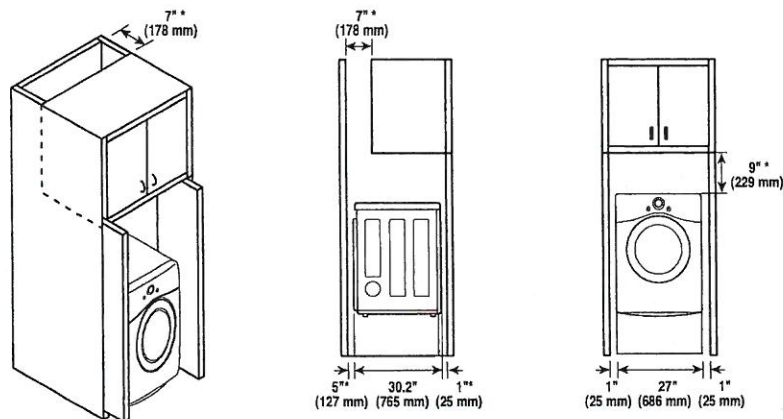

April 8, 2021

PV-51

## LG LAUNDRY

## DLEX4500B / DLGX4501B

7.4 cu.ft. Front Load Dryer with TurboSteam™ and Built-In Intelligence

PV-51  
April 8, 2021

KEY FEATURES

7.4 cu. ft. Ultra Large Capacity  
TurboSteam™ Technology  
AI Fabric Sensor/ Smart Pairing™  
LG ThinQ® Technology / Proactive Customer Care  
FlowSense™ Duct Clogging and Lint Filter Indicators  
ENERGY STAR® Certified  
Closet Depth  
LoDecibel™ Quiet Operation  
Reversible Door  
Wrinkle Care Option

## AVAILABLE COLORS



BLACK STEEL





SMART APPLIANCE

## LG ThinQ®

Enjoy new ways to control your home with LG smart appliances

- Use the ThinQ® app to start the laundry while you're out
- Get alerts when the cycle is finished
- With Smart Pairing™, the washer can tell the dryer to select a compatible drying cycle

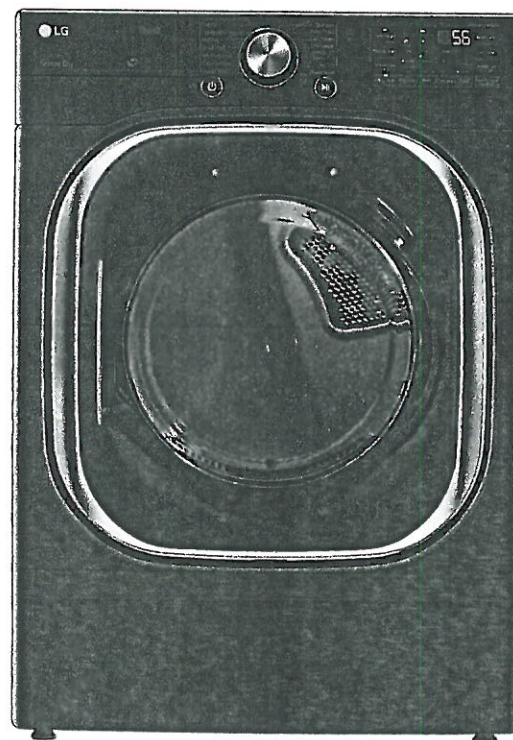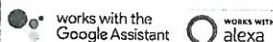

PRODUCT FEATURES

## SUMMARY

|                 |                  |
|-----------------|------------------|
| Type            | Front Load Dryer |
| Capacity        | 7.4 cu. ft.      |
| Matching Washer | WM4500HBA        |
| Sensor Dry      | Yes              |
| Steam           | Yes              |
| Color           | Black Steel (B)  |

## APPEARANCE

|                                                  |     |
|--------------------------------------------------|-----|
| Intelligent Electronic Controls with LED Display | Yes |
| Dial-A-Cycle™                                    | Yes |
| Touch Buttons                                    | Yes |

## DRYER PROGRAMS

|                       |   |
|-----------------------|---|
| No. of Programs       | 14   |
| Programs (Sensor Dry) | Normal, Heavy Duty, Bedding, Small Load, Anti Bacterial, Steam-Sanitary™, SteamFresh™, Perm Press, Delicates, Sportswear, Towels, Speed Dry (Manual Dry), Air Dry (Manual Dry), Downloaded |
| No. of Options        | 12   |
| Options               | More Time, Less Time, Damp Dry Signal, Wrinkle Care, Control Lock, Wi-Fi, Energy Saver, TurboSteam™, Reduce Static, Remote Start, Drum Light, Signal                                       |
| Temperature Settings  | High, Med.High, Medium, Low, Ultra Low   |
| Drying Levels         | Very Dry, More Dry, Normal Dry, Less Dry, Damp Dry   |
| Manual Dry Times      | 60 min., 50 min., 40 min., 30 min., 20 min., More Time/Less Time   |

## FABRIC CARE FEATURES

|                                                  |             |
|--------------------------------------------------|-------------|
| A.I Dry                                          | Yes         |
| Sensor Dry                                       | Yes         |
| Precise Temperature Control with Variable Heater | Yes         |
| Steam                                            | TurboSteam™ |

## CONVENIENCE FEATURES

|                                            |                                              |
|--------------------------------------------|----------------------------------------------|
| 3 Minute Installation Check                | Yes                                          |
| LoDecibel™ Quiet Operation                 | Yes                                          |
| End of Cycle Signal                        | Yes                                          |
| Drum Light                                 | Yes                                          |
| Reversible Door                            | Yes                                          |
| FlowSense™ Duct Clogging Indicator         | Yes                                          |
| Wrinkle Care Option                        | Yes                                          |
| Child Lock                                 | Yes                                          |
| Venting Option                             | Electric: 4 Way Venting / Gas: 3 Way Venting |
| 4 Adjustable Legs                          | Yes                                          |
| Remaining Time Display/Status Indicator(s) | Yes                                          |

## ThinQ® TECHNOLOGY

|                                |             |
|--------------------------------|-------------|
| SmartDiagnosis™ (v3.0)         | Yes         |
| Wi-Fi                          | Yes         |
| Remote Start and Cycle Monitor | Yes         |
| Energy Monitoring              | Yes (Wi-Fi) |

## ENERGY

|                        |                            |
|------------------------|----------------------------|
| ENERGY STAR® Certified | Yes                        |
| CEF                    | Electric: 3.94 / Gas: 3.49 |

## MATERIALS AND FINISHES

|                                |                                |
|--------------------------------|--------------------------------|
| NeveRust® Stainless Steel Drum | Yes                            |
| Tub Rear                       | Painted                        |
| Cabinet                        | Painted Steel                  |
| Door                           | Dark Black Tinted Square Cover |
| All Available Colors           | Black Steel (B)                |

## POWER SOURCE

|                         |                                               |
|-------------------------|-----------------------------------------------|
| Ratings                 | CSA Listed                                    |
| Electrical Requirements | 120V, 15 Amps (Gas) / 240V 30 Amps (Electric) |
| Type                    | Electric, Gas                                 |
| BTU Rating              | 10,000 Feet                                   |

## OPTIONS

|                   |                                                |
|-------------------|------------------------------------------------|
| LP Conversion Kit | 383EEL3002D                                    |
| Side Venting Kit  | 383EEL9001B                                    |
| Pedestal          | WDP4B                                          |
| Pedestal (WxHxD)  | 27 x 14 1/8 x 30 3/4 (50 1/2 D with door open) |

## DIMENSIONS (ELECTRIC)

|                      |                             |
|----------------------|-----------------------------|
| Product (WxHxD)      | 27" x 38 11/16" x 29 3/4"   |
| Depth with Door Open | 51"                         |
| Carton (WxHxD)       | 29 1/2" x 42 1/4" x 31 1/4" |
| Weight (Product)     | 136 lbs                     |
| Weight (Carton)      | 155 lbs                     |

## DIMENSIONS (GAS)

|                      |                             |
|----------------------|-----------------------------|
| Product (WxHxD)      | 27" x 38 11/16" x 29 3/4"   |
| Depth with Door Open | 51"                         |
| Carton (WxHxD)       | 29 1/2" x 42 1/4" x 31 1/4" |
| Weight (Product)     | 139.4 lbs                   |
| Weight (Carton)      | 158.4 lbs                   |

## LIMITED WARRANTY

|               |          |
|---------------|----------|
| Parts & Labor | 1 Year   |
| Drum          | 10 Years |

## UPC CODES

|                         |              |
|-------------------------|--------------|
| DLEX4500B (Black Steel) | 048231026789 |
| DLGX4501B (Black Steel) | 048231026796 |
| WM4500HBA (Black Steel) | 048231026772 |

## Installation Location Requirements

### WARNING

- Read all installation instructions completely before installing and operating your dryer! It is important that you review this entire manual before installing and using your dryer. Detailed instructions concerning electrical connections, gas connections, and exhaust requirements are provided on the following pages.

ENGLISH

The installation requires:

- A location that allows for proper exhaust installation. A gas dryer must be exhausted to the outdoors. See Venting the Dryer.
- A grounded electrical outlet located within 2 ft. (61 cm) of either side of the dryer. See Connecting Electric Dryers.
- A sturdy floor to support the total dryer weight of 200 lb (90.7 kg). The combined weight of a companion appliance should also be considered.
- No other fuel-burning appliance can be installed in the same closet as a dryer.
- Additional clearances might be required for wall, door and floor moldings.
- Companion appliance spacing should also be considered.

### NOTE

- The floor must be level, with a maximum slope of 1 inch (2.5 cm) under the entire dryer. Clothes may not tumble properly, and automatic sensor cycles may not operate correctly if the dryer is not level.
- For garage installation, you will need to place the dryer at least 18 inches (45.7 cm) above the floor. The standard pedestal height is 15 inches (38 cm). You will need 18 inches (45.7 cm) from the garage floor to the bottom of the dryer.
- Do not operate your dryer at temperatures below 45 °F (7 °C). At lower temperatures, the dryer might not shut off at the end of an automatic cycle. This can result in longer drying times.
- The dryer must not be installed or stored in an area where it will be exposed to water and/or weather.
- Check code requirements that limit, or do not permit, installation of the dryer in garages, closets, mobile homes or sleeping quarters. Contact your local building inspector.

April 8, 2021

PK-SI

## Venting the Dryer

### ⚠ WARNING



To reduce the risk of fire or explosion, electric shock, property damage, injury to persons or death when using this appliance, follow basic safety precautions, including the following:

- Do not crush or collapse ductwork.
- Do not allow ductwork to rest on or contact sharp objects.
- If connecting to existing ductwork, make sure it is suitable and clean before installing the dryer.
- Venting must conform to local building codes.
- Gas dryers **MUST** exhaust to the outdoors.
- Use only 4-inch (10.2 cm) rigid, semi-rigid or flexible metal ductwork inside the dryer cabinet and for venting outside.
- To reduce the risk of fire, combustion, or accumulation of combustible gases, **DO NOT** exhaust dryer air into an enclosed and unventilated area, such as an attic, wall, ceiling, crawl space, chimney, gas vent, or concealed space of a building.
- To reduce the risk of fire, **DO NOT** exhaust the dryer with plastic or thin foil ducting.
- The exhaust duct must be 4-inch (10.2 cm) in diameter with no obstructions. The exhaust duct should be kept as short as possible. Make sure to clean any old ducts before installing your new dryer.
- Rigid, semi-rigid or flexible metal ducting is recommended for use between the dryer and the wall. All non-rigid metal transition duct must be UL-listed. Use of other materials for transition duct could affect drying time.
- **DO NOT** use sheet metal screws or other fasteners which extend into the duct that could catch lint and reduce the efficiency of the exhaust system. Secure all joints with duct tape.
- Do not exceed the recommended duct length limitations noted in the chart. Failure to follow these instructions may result in extended drying times, fire or death.

### ⚠ WARNING

- Ductwork is not provided with the dryer. You should obtain the necessary ductwork locally. The vent hood should have hinged dampers to prevent backdraft when the dryer is not in use.
- The total length of flexible metal duct must not exceed 8 ft. (2.4 m).

## Ductwork
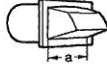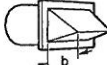
| Wall Cap Type   | Number of 90° Elbows | Maximum length of 4-inch diameter rigid metal duct |
|---|----------------------|----------------------------------------------------|
| <br><br>a: 4" (10.2 cm) | 0                    | 65 ft. (19.8 m)                                    |
|   | 1                    | 55 ft. (16.8 m)                                    |
|   | 2                    | 47 ft. (14.3 m)                                    |
|   | 3                    | 36 ft. (11.0 m)                                    |
| <br>b: 2.5" (6.35 cm)                                                                                  | 0                    | 55 ft. (16.8 m)                                    |
|   | 1                    | 47 ft. (14.3 m)                                    |
|   | 2                    | 41 ft. (12.5 m)                                    |
|   | 3                    | 30 ft. (9.1 m)                                     |
|   | 4                    | 22 ft. (6.7 m)                                     |

### NOTE

- Deduct 6 ft. (1.8 m) for each additional elbow. Do not use more than four 90° elbows.
- In Canada, only those foil-type flexible ducts, if any, specifically identified for use with the appliance by the manufacturer should be used. In the United States, only those foil-type flexible ducts, if any, specifically identified for use with the appliance by the manufacturer and that comply with the Outline for Clothes Dryer Transition Duct, Subject 2158A, should be used.

April 8, 2021  
PV-SV


## Routing and Connecting Ductwork

### NOTE


Follow the guidelines below to maximize drying performance and reduce lint buildup and condensation in the ductwork. Ductwork and fittings are NOT included and must be purchased separately.

- Use 4-inch (10.2 cm) diameter rigid, semi-rigid or flexible metal ductwork.
- The exhaust duct run should be as short as possible.
- Use as few elbow joints as possible.
- The male end of each section of exhaust duct must point away from the dryer.
- Use duct tape on all duct joints.
- Insulate ductwork that runs through unheated areas in order to reduce condensation and lint buildup on duct surfaces.
- Incorrect or inadequate exhaust systems are not covered by the dryer warranty. Dryer failures or service required because of such exhaust systems will not be covered by the dryer warranty.

## Correct Venting

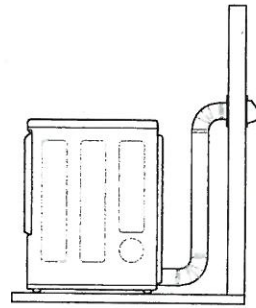

## Incorrect Venting

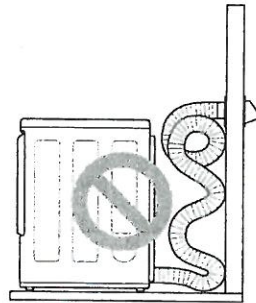

ENGLISH

April 8, 2021

PV-51