

Lot: 2

Model: 42.03 A FORESTCREST

Project/Phase: Pine Valley Forevergreen / 1

APPLIA	APPLIANCES		
Invoice	Qty.	Description	
2573	1	APPLIANCE SPECIFICATION ATTACHED - SIGNED COPY	
19Mar21 NoCat			
2676	1	KITCHEN: HOOD FAN SPEC - SIGNED COPY ATTACHED	
31Mar21 NoCat			
2459 72,217	1	KITCHEN - UPGRADE TO 8" DUCT (EXTERIOR WALL) IN LIEU OF STANDARD OFFERING	
26Apr21 **			
2459	1	KITCHEN - UPGRADE TO 8" DUCT (EXTERIOR WALL) IN LIEU OF STANDARD OFFERING	
26Apr21 ** NoCat			
2459	1	KITCHEN - UPGRADE TO 8" DUCT (EXTERIOR WALL) IN LIEU OF STANDARD OFFERING	
26Apr21 ** NoCat			

BASEN	MENT	WINI	DOWS
	וועווע	** 1	D()

BASEM	BASEMENT WINDOWS		
Invoice	Qty.	Description	
2459 72,351 26Apr21	2	BASEMENT WINDOWS - UPGRADE BASEMENT WINDOW SIZE TO 30 " X 24" - 8" FRAME	

DisciplineMS.rpt 23feb21 Page 1 of 17



Lot: 2

Model: 42.03 A FORESTCREST

Project/Phase: Pine Valley Forevergreen / 1

CFR	AMIC
CLINA	

Invoice	Qty.	Description
2523	2	.MASTER ENSUITE + ENSUITE 3: SHOWER NICHE [SHAMPOO SHELF] - COMPLETE WITH MATCHING MARBLE JAMBS ON 4 SIDES, STANDARD TILE, APPROX. 12 X 18 INSTALLED VERTICALLY - SEE PLAN FOR LOCATION
22Dec20 NoCat		
2573 37	1	FOYER: TILE, FLOOR - LEVEL 5 - 12x24" LAID IN STRAIGHT, STACKED PATTERN. SEE PLAN FOR DIRECTION
19Mar21		
2573 37 19Mar21	1	POWDER ROOM: TILE, FLOOR - LEVEL 5 - 12x24" LAID IN STRAIGHT, STACKED PATTERN. SEE PLAN FOR DIRECTION
2573 46 19Mar21	1	ENSUITE 2: TILE, WALL - LEVEL 1 - 2X8" - LAID IN HORIZONTAL PATTERN
2573 35 19Mar21	1	ENSUITE 3: TILE, FLOOR - LEVEL 3 - 12x24" LAID IN STRAIGHT STACKED PATTERN. SEE PLAN FOR DIRECTION
2573 49 19Mar21	1	ENSUITE 3: TILE, WALL - LEVEL 3 - 12x24" LAID IN HORIZONTAL, STACKED PATTERN
2573 43 19Mar21	1	ENSUITE 3: TILE, SHOWER FLOOR - LEVEL 2 - 2" HEX
2573 43 19Mar21	1	ENSUITE 4: TILE, SHOWER FLOOR, LEVEL 4 - 2x2"
2573 46 19Mar21	1	ENSUITE 4: TILE, WALL, LEVEL 3 - 12x24" LAID IN STRAIGHT, STACKED PATTERN.
2573 32 19Mar21	1	ENSUITE 5: TILE, FLOOR , LEVEL 1 - 12X24" LAID IN STRAIGHT, STACKED PATTERN. SEE PLAN FOR TILE DIRECTION
2573 43 19Mar21	1	ENSUITE 5: TILE, SHOWER FLOOR - LEVEL 2 - HEX
2573 46	1	ENSUITE 5: TILE, WALL, LEVEL 2 **NOTE**
19Mar21		LONG WALLS : 12X24" LAID IN VERTICAL STACKED SHORT WALL: HEX
2573 37 19Mar21	1	MASTER ENSUITE: TILE, FLOOR , LEVEL 5 - 12x24" LAID STRAIGHT, STACKED PATTERN. SEE PLAN FOR TILE DIRECTION

DisciplineMS.rpt 23feb21 Page 2 of 17



Lot: 2

Model: 42.03 A FORESTCREST

Project/Phase: Pine Valley Forevergreen / 1

		TTO
CEE	ZΔN	/

Invoice	Qty.	Description
2573 44 19Mar21	1	MASTER ENSUITE: TILE, SHOWER FLOOR, LEVEL 3 - PENNY ROUND
2573 51 19Mar21	1	MASTER ENSUITE: TILE, WALL, LEVEL 5 **NOTE** LONG WALL - PENNY ROUNDS SHORT WALLS - 12X24" LAID IN VERTICAL STACKED
2573 19 19Mar21	1	MASTER ENSUITE: TILE GROUT UPGRADE, FLOOR + WALL - AT BLACK TILES
2573 19 19Mar21	1	ENSUITE 3: TILE GROUT UPGRADE, SHOWER FLOOR , UPG GROUT
2573 36 19Mar21	1	ENSUITE 2: TILE, FLOOR - 12x24" - LEVEL 4 - LAID IN STRAIGHT STACKED PATTERN - SEE PLAN FOR DIRECTION
2573 35 19Mar21	1	ENSUITE 4: TILE, FLOOR , 12x 24" - LEVEL 3 - LAID IN STRAIGHT STACKED PATTERN - SEE PLAN FOR DIRECTION
2573 19Mar21 NoCat	1	FYI-KITCHEN/BREAKFAST/SERVERY: MIRAGE, 7 3/4"x3/4", WHITE OAK, FLAIR LIGHT CHARACTER, DURAMATT - LEVEL 7 DO NOT SUPPLY/INSTALL CERAMIC IN KITCHEN/BREAKFAST/SERVERY
2459 26Apr21 NoCat	1	**CUSTOM LAYOUT** REDUCE SIZE OF MASTER WIC, TO ALLOW FOR ADDITIONAL 3-PIECE BATHROOM (ENSUITE 2) - COMPLETE WITH TUB AND STANDARD FINISHES - SEE PLAN FOR LOCATION
2459 26Apr21 NoCat	1	**CUSTOM LAYOUT** RELOCATE EXISTING LAUNDRY ROOM FROM 2ND FLOOR TO MAIN FLOOR MUD ROOM - REMOVE EXISTING LOWER CABINETS TO ALLOW SPACE FOR APPLIANCES - SEE PLAN FOR LOCATION
2459 26Apr21 NoCat	1	**CUSTOM LAYOUT** ADD LAUNDRY FOR STACKING MACHINES AND LAUNDRY TUB + CREATE LARGER WIC AND ADD WHIRLPOOL TUB - SEE PLAN FOR LOCATION
2751 07May21 NoCat	1	TILE RE-SELECTION: MASTER ENSUITE - FLOOR TILE, ENSUITE 5, FLOOR + SHOWER TILE + WALL TILE. SEE ATTACHED REVISED COLOUR CHART FOR RE-SELECTION

DisciplineMS.rpt 23feb21 Page 3 of 17



Lot: 2

Model: 42.03 A FORESTCREST

Project/Phase: Pine Valley Forevergreen / 1

CONCRETE AND DRAIN

Invoice	Qty.	Description
2459	1	BACK-FLOW PREVENTER VALVE
26Apr21 NoCat		
2459	1	**CUSTOM LAYOUT** RELOCATE EXISTING LAUNDRY ROOM FROM 2ND FLOOR TO MAIN FLOOR MUD ROOM - REMOVE EXISTING LOWER CABINETS TO ALLOW SPACE FOR APPLIANCES - SEE PLAN FOR LOCATION
26Apr21 NoCat		
2459	1	**CUSTOM LAYOUT** ADD LAUNDRY FOR STACKING MACHINES AND LAUNDRY TUB + CREATE LARGER WIC AND ADD WHIRLPOOL TUB - SEE PLAN FOR LOCATION
26Apr21 NoCat		

CROWN MOULDING

In	ivoice	Qty.	Description
	2459		GREAT ROOM: MODEL OPTIONS 42.03 - GREAT ROOM - OPT. WAFFLE CEILING, BEAM DETAIL AS PER PLAN (8 BOXES) OPTION #1 CTR-B07
	26Apr21 NoCat		

DRYWALL

Invoice	Qty.	Description
2523 72,324 22Dec20 **	2	GARAGE DOOR OPENER (CHAMBERLAIN BELT DRIVE) - WITH 1 REMOTE - PRICE IS PER DOOR
2459 72,351 26Apr21 **	2	BASEMENT WINDOWS - UPGRADE BASEMENT WINDOW SIZE TO 30 " X 24" - 8" FRAME
2459 72,484 26Apr21	1	GREAT ROOM: MODEL OPTIONS 42.03 - GREAT ROOM - OPT. COFFERED CEILING AS PER PLAN
2459 72,486 26Apr21	1	GREAT ROOM: MODEL OPTIONS 42.03 - GREAT ROOM - OPT. WAFFLE CEILING, BEAM DETAIL AS PER PLAN (8 BOXES) OPTION #1 CTR-B07
2459 72,690 26Apr21 **	1	DELETE KITCHEN BULKHEAD, IF POSSIBLE, SITE APPROVAL REQUIRED
2459 26Apr21 ** NoCat	1	DELETE KITCHEN BULKHEAD, IF POSSIBLE, SITE APPROVAL REQUIRED

DisciplineMS.rpt 23feb21 Page 4 of 17



Lot: 2

Model: 42.03 A FORESTCREST Project/Phase: Pine Valley Forevergreen / 1

ELECTRICAL

ELECT	_	AL Description
2523 72,289	12	KITCHEN & BREAKFAST: 4" E/S LED INTERIOR POT LIGHT - GROUND FLOOR - EACH
22Dec20		SEE PLAN FOR LOCATION
2523	2	KITCHEN & BREAKFAST: ADDITIONAL INTERIOR SWITCH
72,278 22Dec20		for potlights
2523 72,290	5	UPPER HALL: 4" E/S LED INTERIOR POT LIGHT (INSULATED CEILING) - SECOND FLOOR - EACH
22Dec20		IN LIEU OF STANDARD CEILING LIGHTS - USE STANDARD SWITCHES SEE PLAN FOR LOCATION
2573 72,273 19Mar21	1	KITCHEN: 110V WALL RECEPTACLE ON SEPARATE CIRCUIT - GAS FIRED RANGE - FOR AUX. EQUIPMENT - NOT A STOVE PLUG
2573	1	FYI-KITCHEN: QUARTZ FULL HEIGHT BACKSPLASH - LEVEL 6
19Mar21 NoCat		
2459 72,351	2	BASEMENT WINDOWS - UPGRADE BASEMENT WINDOW SIZE TO 30 " X 24" - 8" FRAME
26Apr21		
2459	1	STUDY: INTERIOR WALL OUTLET: ADDITIONAL 110V WALL INTERIOR RECEPTACLE ON EXISTING CIRCUIT FOR WALL MOUNTED TV - LOCATE APPROX. 66" A.F.F SEE PLAN FOR LOCATION
72,281 26Apr21		
2459 72,281	1	LIVING ROOM: INTERIOR WALL OUTLET: ADDITIONAL 110V WALL INTERIOR RECEPTACLE ON EXISTING CIRCUIT FOR WALL MOUNTED TV - LOCATE APPROX. 66" A.F.F SEE PLAN FOR LOCATION
26Apr21		
2459	1	BASEMENT: INTERIOR WALL OUTLET: ADDITIONAL 110V WALL INTERIOR RECEPTACLE ON EXISTING CIRCUIT FOR WALL MOUNTED TV - LOCATE APPROX. 66" A.F.F SEE PLAN FOR LOCATION
72,281 26Apr21		TOR WALL MOUNTED IV - LOCATE ATTROX. 00 A.T.T SELF LANTOR LOCATION
2459	6	LIVING ROOM: 4" E/S LED INTERIOR POT LIGHT - GROUND FLOOR - EACH - INCLUDES 1 SWITCH
72,289 26Apr21		INCLUDED IN APS
2459	3	KITCHEN: CEILING OUTLET: ADDITIONAL REINFORCED CEILING OUTLET - LOCATE APPROX CENTERED ABOVE
72,280 26Apr21		ISLAND
2459	1	KITCHEN: ADDITIONAL INTERIOR SWITCH - FOR ISLAND LIGHTS
72,278 26Apr21		
2459	1	KITCHEN: FIXTURE: UNDER CABINET FLUORESCENT LIGHT FIXTURES - DOES NOT INCLUDE (AND REQUIRES) LIGHT VALANCE
72,303 26Apr21		EKIT TABARE

DisciplineMS.rpt 23feb21 Page 5 of 17



Lot: 2

Model: 42.03 A FORESTCREST Project/Phase: Pine Valley Forevergreen / 1

ELECTRICAL

ELECTI Invoice	_	Description
2459 72,298 26Apr21	5	MASTER ENSUITE / ENSUITE 2 / ENSUITE 3 / ENSUITE 4 / ENSUITE 5: BATHROOM FAN DELAY - ONE UNIT -
2459 75,863 26Apr21	1	POWDER ROOM: PANASONIC WHISPER GREEN EXHAUST FAN WITH MOTION/TIMER - PRICE IS EACH
2459 72,665 26Apr21	1	KITCHEN: 240V WALL RECEPTACLE ON SEPARATE CIRCUIT FOR BUILT-INS APPROX. LOCATION AS PER ATTACHED DRAWINGS
2459 72,272 26Apr21	1	KITCHEN: 110V WALL RECEPTACLE ON SEPARATE CIRCUIT - FOR FREEZER - APPLIANCE NOT INCLUDED
2459 72,272 26Apr21	1	SERVERY: 110V WALL RECEPTACLE ON SEPARATE CIRCUIT - FOR WINE FRIDGE - APPLIANCE NOT INCLUDED
2459 75,862 26Apr21	1	KITCHEN ISLAND: USB OUTLET, 20 AMP - PRICE IS EACH -
2459 72,289	8	GREAT ROOM: 4" E/S LED INTERIOR POT LIGHT - GROUND FLOOR - EACH
26Apr21		IN LIEU OF STANDARD LIGHT, USE STANDARD SWITCH
2459 72,281 26Apr21	1	GREAT ROOM: INTERIOR WALL OUTLET: ADDITIONAL 110V WALL INTERIOR RECEPTACLE ON EXISTING CIRCUIT FOR WALL MOUNTED TV - LOCATE APPROX 66" A.F.F.
2459 26Apr21 NoCat	1	**CUSTOM LAYOUT** REDUCE SIZE OF MASTER WIC, TO ALLOW FOR ADDITIONAL 3-PIECE BATHROOM (ENSUITE 2) - COMPLETE WITH TUB AND STANDARD FINISHES - SEE PLAN FOR LOCATION
2459	1	**CUSTOM LAYOUT** RELOCATE EXISTING LAUNDRY ROOM FROM 2ND FLOOR TO MAIN FLOOR MUD ROOM - REMOVE EXISTING LOWER CABINETS TO ALLOW SPACE FOR APPLIANCES - SEE PLAN FOR LOCATION
26Apr21 NoCat		
2459	1	**CUSTOM LAYOUT** ADD LAUNDRY FOR STACKING MACHINES AND LAUNDRY TUB + CREATE LARGER WIC AND ADD WHIRLPOOL TUB - SEE PLAN FOR LOCATION
26Apr21 NoCat		INCLUDED IN APS
2459 26Apr21 NoCat	1	**CUSTOM LAYOUT** ADD LAUNDRY FOR STACKING MACHINES AND LAUNDRY TUB + CREATE LARGER WIC AND ADD WHIRLPOOL TUB - SEE PLAN FOR LOCATION

DisciplineMS.rpt 23feb21 Page 6 of 17



Lot: 2

Model: 42.03 A FORESTCREST Project/Phase: Pine Valley Forevergreen / 1

FIREPLACE

Invoice	Qty.	Description
2459 72,622 26Apr21	_	GREAT ROOM / STUDY: UPGRADE MAIN FLOOR LINEAR 2 SIDED FIREPLACE - HEATILATOR 36" SEE-THROUGH DIRECT VENT GAS LINEAR FIREPLACE IN LIEU OF STANDARD
2459	2	GREAT ROOM/STUDY: ADD PASSIVE HEAT GRILL APPROX 24" FROM CEILING
26Apr21 NoCat		MATTE BLACK GRILL APPROX 2" X 36" - located approx 24" from ceiling above fireplace

FORMING

Invoice	Qty.	Description
2459 72,208 26Apr21		PINE VALLEY MODEL 42.03 FORESTCREST ELEV A - 9 FOOT BASEMENT CEILING HEIGHT IN LIEU OF STANDARD 8 FOOT CEILING. INCLUDED IN APS

FRAMING

Invoice	Qty.	Description
2523 72,631 22Dec20	2	MASTER ENSUITE + ENSUITE 3: SHOWER NICHE [SHAMPOO SHELF] - COMPLETE WITH MATCHING MARBLE JAMBS ON 4 SIDES, STANDARD TILE, APPROX. 12 X 18 INSTALLED VERTICALLY - SEE PLAN FOR LOCATION
2459 26Apr21 NoCat	1	**CUSTOM LAYOUT** REDUCE SIZE OF MASTER WIC, TO ALLOW FOR ADDITIONAL 3-PIECE BATHROOM (ENSUITE 2) - COMPLETE WITH TUB AND STANDARD FINISHES - SEE PLAN FOR LOCATION INCLUDED IN APS
2459 26Apr21 NoCat	1	**CUSTOM LAYOUT** RELOCATE EXISTING LAUNDRY ROOM FROM 2ND FLOOR TO MAIN FLOOR MUD ROOM - REMOVE EXISTING LOWER CABINETS TO ALLOW SPACE FOR APPLIANCES - SEE PLAN FOR LOCATION INCLUDED IN APS
2459 26Apr21 NoCat	1	**CUSTOM LAYOUT** ADD LAUNDRY FOR STACKING MACHINES AND LAUNDRY TUB + CREATE LARGER WIC AND ADD WHIRLPOOL TUB - SEE PLAN FOR LOCATION BASED ON STANDARD FINISHES
2459 72,690 26Apr21	1	DELETE KITCHEN BULKHEAD, IF POSSIBLE, SITE APPROVAL REQUIRED
2459 26Apr21 ** NoCat	1	DELETE KITCHEN BULKHEAD, IF POSSIBLE, SITE APPROVAL REQUIRED

DisciplineMS.rpt 23feb21 Page 7 of 17



Lot: 2

Model: 42.03 A FORESTCREST Project/Phase: Pine Valley Forevergreen / 1

GARAGE DOORS

Invoice	Qty.	Description
2523 72,324 22Dec20	2	GARAGE DOOR OPENER (CHAMBERLAIN BELT DRIVE) - WITH 1 REMOTE - PRICE IS PER DOOR
2523 72,323 22Dec20	2	GARAGE: WIRELESS KEYPAD GARAGE DOOR ENTRY 877LM
2523 72,322 22Dec20	2	GARAGE: EXTRA GARAGE DOOR REMOTE MODEL 891LM

GLASS AND MIRROR

Invoice	Qty.	Description
2573 101,930 19Mar21	1	*THRU OUT: DO NOT INSTALL MIRRORS*
2573	1	ENSUITE 4: UPGRADE SHOWER DOOR HANDLE MT6X6 + HINGES 'MATTE BLACK'
19Mar21 NoCat		
2573	1	MASTER ENSUITE: UPGRADE SHOWER DOOR HARDWARE MT6X6 + HINGES - BRUSHED GOLD
19Mar21 NoCat		
2459	1	**CUSTOM LAYOUT** REDUCE SIZE OF MASTER WIC, TO ALLOW FOR ADDITIONAL 3-PIECE BATHROOM (ENSUITE 2) - COMPLETE WITH TUB AND STANDARD FINISHES - SEE PLAN FOR LOCATION
26Apr21 NoCat		

DisciplineMS.rpt 23feb21 Page 8 of 17



Lot: 2

Model: 42.03 A FORESTCREST Project/Phase: Pine Valley Forevergreen / 1

GRANITE MARBLE QUARTZ

Invoice		TARBLE QUARTZ Description
2523 22Dec20	2	.MASTER ENSUITE + ENSUITE 3: SHOWER NICHE [SHAMPOO SHELF] - COMPLETE WITH MATCHING MARBLE JAMBS ON 4 SIDES, STANDARD TILE, APPROX. 12 X 18 INSTALLED VERTICALLY - SEE PLAN FOR LOCATION
NoCat		
2573 101,930 19Mar21	1	KITCHEN: UPGRADE 6 QUARTZ COUNTER TOP
2573 101,930 19Mar21	1	POWDER ROOM: UPGRADE 6 QUARTZ COUNTERTOP
2573 74,429 19Mar21	2	KITCHEN: QUARTZ WATERFALL LEGS ON ISLAND - LEVEL 6
2573	1	KITCHEN: WATERFALL LEG AT PERIMETER BY DISHWASHER - LEVEL 6 QUARTZ
19Mar21 NoCat		
2573 74,429 19Mar21	1	KITCHEN: QUARTZ FULL HEIGHT BACKSPLASH - LEVEL 6
2573 101,930 19Mar21	1	ENSUITE 2: UPGRADE 1 QUARTZ COUNTERTOP
2573 101,930 19Mar21	1	ENSUITE 3: UPGRADE 6 QUARTZ COUNTERTOP
2573	1	ENSUITE 4: UPGRADE 6 QUARTZ COUNTER TOP
19Mar21 NoCat		
2573	1	ENSUITE 5: UPGRADE 3 QUARTZ COUNTER TOP
19Mar21 NoCat		
2573	1	MASTER ENSUITE: UPGRADE 5 QUARTZ COUNTER TOP
19Mar21 NoCat		
2573	1	KITCHEN: UPGRADE TO 3CM COUNTER TOP THICKNESS
19Mar21 NoCat		
2459	1	**CUSTOM LAYOUT** REDUCE SIZE OF MASTER WIC, TO ALLOW FOR ADDITIONAL 3-PIECE BATHROOM (ENSUITE 2) - COMPLETE WITH TUB AND STANDARD FINISHES - SEE PLAN FOR LOCATION
26Apr21 NoCat		

DisciplineMS.rpt 23feb21 Page 9 of 17



Lot: 2

Model: 42.03 A FORESTCREST Project/Phase: Pine Valley Forevergreen / 1

HARDWOOD

Invoice	Qty.	Description
2573 15 19Mar21	1	THRU OUT, ALL STD AREAS - MAIN HALL/LIVING/ STUDY/ GREAT ROOM/ DINING/ UPPER HALL/ MASTER BEDROOM/ BDRM 2/ BDRM 3/ BDRM 4/ BDRM 5 : MIRAGE, 7 3/4" WHITE OAK, ENGINEERED HARDWOOD, 3/4", FLAIR LIGHT CHARACTER TEXTURE, DURAMATT FINISH - LEVEL 7
2573 101,930 19Mar21	1	KITCHEN/BREAKFAST/SERVERY: MIRAGE, 7 3/4"x3/4", WHITE OAK, FLAIR LIGHT CHARACTER, DURAMATT - LEVEL 7
2573 15 19Mar21	1	BASEMENT FOYER: MIRAGE, 7 3/4" WHITE OAK, ENGINEERED HARDWOOD, 3/4", FLAIR LIGHT CHARACTER TEXTURE, DURAMATT FINISH - OPT. 5 BED, FINISHED BASEMENT FOYER - LEVEL 7
HVAC		

HVAC		
Invoice	Qty.	Description
2573 72,224 19Mar21	1	KITCHEN: GAS LINE ROUGH-IN - MAIN FLOOR FOR GAS RANGE
2459 72,217 26Apr21	1	KITCHEN - UPGRADE TO 8" DUCT (EXTERIOR WALL) IN LIEU OF STANDARD OFFERING
2459 72,690 26Apr21 **	1	DELETE KITCHEN BULKHEAD, IF POSSIBLE, SITE APPROVAL REQUIRED
2459 26Apr21 NoCat	1	KITCHEN - UPGRADE TO 8" DUCT (EXTERIOR WALL) IN LIEU OF STANDARD OFFERING
2459 26Apr21 NoCat	1	**CUSTOM LAYOUT** REDUCE SIZE OF MASTER WIC, TO ALLOW FOR ADDITIONAL 3-PIECE BATHROOM (ENSUITE 2) - COMPLETE WITH TUB AND STANDARD FINISHES - SEE PLAN FOR LOCATION
2459 26Apr21 NoCat	1	**CUSTOM LAYOUT** ADD LAUNDRY FOR STACKING MACHINES AND LAUNDRY TUB + CREATE LARGER WIC AND ADD WHIRLPOOL TUB - SEE PLAN FOR LOCATION
2459 26Apr21 NoCat	1	DELETE KITCHEN BULKHEAD, IF POSSIBLE, SITE APPROVAL REQUIRED
2459 26Apr21 ** NoCat	1	KITCHEN - UPGRADE TO 8" DUCT (EXTERIOR WALL) IN LIEU OF STANDARD OFFERING

DisciplineMS.rpt 23feb21 Page 10 of 17



2459

26Apr21

2459 72,642 26Apr21

CONSTRUCTION SUMMARY

Lot: 2

Model: 42.03 A FORESTCREST Project/Phase: Pine Valley Forevergreen / 1

INTERIOR TRIM / MOULDINGS

Invoice	Qty.	Description
2459	19	2ND FLOOR: ADDITIONAL FOR OVER HEIGHT SINGLE DOOR UP TO 8 FOOT
72,642		
26Apr21		

INTERI Invoice		TRIM AND DOORS Description
2573 153,812 19Mar21	1	THRU OUT: HALIFAX LEVER, IRON BLACK INTERIOR DOOR HARDWARE UPGRADE
2573 155,893 19Mar21	1	ADD FOR HINGES 3X3 SQUARE FLAT TIP THROUGHOUT UPGRADE
2573 153,413 19Mar21	1	UPGRADE 3 1/2" STEP BEVEL CASING, 7 1/4" BASE BOARD, OPTIONAL 5 BED PLAN UPGRADE: BOARD 4

CUSTOM LAYOUT REDUCE SIZE OF MASTER WIC, TO ALLOW FOR ADDITIONAL 3-PIECE BATHROOM (ENSUITE 2) - COMPLETE WITH TUB AND STANDARD FINISHES - SEE PLAN FOR LOCATION

2ND FLOOR: ADDITIONAL FOR OVER HEIGHT SINGLE DOOR UP TO 8 FOOT

DisciplineMS.rpt 23feb21 Page 11 of 17



Lot: 2

Model: 42.03 A FORESTCREST Project/Phase: Pine Valley Forevergreen / 1

KITCHEN AND BATH CABINETRY

Invoice		AND BATH CABINETRY Description
2573 101,930 19Mar21	1	THRU OUT: SEE ATTACHED CABINETRY SCHEDULE
2573	1	FYI-KITCHEN: QUARTZ WATERFALL LEGS ON ISLAND - LEVEL 6
19Mar21 NoCat		
2573	1	FYI-KITCHEN: QUARTZ FULL HEIGHT BACKSPLASH - LEVEL 6
19Mar21 NoCat		
2573	1	FYI-KITCHEN: WATERFALL LEG AT PERIMETER BY DISHWASHER - LEVEL 6 QUARTZ
19Mar21 NoCat		
2459 72,217 26Apr21 **	1	KITCHEN - UPGRADE TO 8" DUCT (EXTERIOR WALL) IN LIEU OF STANDARD OFFERING
2459 72,690 26Apr21 **	1	DELETE KITCHEN BULKHEAD, IF POSSIBLE, SITE APPROVAL REQUIRED
2459	1	KITCHEN - UPGRADE TO 8" DUCT (EXTERIOR WALL) IN LIEU OF STANDARD OFFERING
26Apr21 ** NoCat		
2459	1	**CUSTOM LAYOUT** REDUCE SIZE OF MASTER WIC, TO ALLOW FOR ADDITIONAL 3-PIECE BATHROOM (ENSUITE 2) - COMPLETE WITH TUB AND STANDARD FINISHES - SEE PLAN FOR LOCATION
26Apr21 NoCat		
2459	1	**CUSTOM LAYOUT** RELOCATE EXISTING LAUNDRY ROOM FROM 2ND FLOOR TO MAIN FLOOR MUD ROOM - REMOVE EXISTING LOWER CABINETS TO ALLOW SPACE FOR APPLIANCES - SEE PLAN FOR LOCATION
26Apr21 NoCat		
2459	1	**CUSTOM LAYOUT** ADD LAUNDRY FOR STACKING MACHINES AND LAUNDRY TUB + CREATE LARGER WIC AND ADD WHIRLPOOL TUB - SEE PLAN FOR LOCATION
26Apr21 NoCat		
2459	1	DELETE KITCHEN BULKHEAD, IF POSSIBLE, SITE APPROVAL REQUIRED
26Apr21 ** NoCat		
2459	1	KITCHEN - UPGRADE TO 8" DUCT (EXTERIOR WALL) IN LIEU OF STANDARD OFFERING
26Apr21 NoCat		
2722 101,930	1	***REVISED CABINETRY SCHEDULE - APRIL 21 2021*** ADDITIONAL CABINETRY
26Apr21		SEE ATTACHED

DisciplineMS.rpt 23feb21 Page 12 of 17



Lot: 2

Model: 42.03 A FORESTCREST Project/Phase: Pine Valley Forevergreen / 1

NETWORK AND WIRING

Invoice	Qty.	Description
2459 72,258 26Apr21	1	STUDY: ADDITIONAL CAT6 ETHERNET OUTLET - EACH - LOCATE APPROX. 66" A.F.F SEE PLAN FOR LOCATION
2459 72,256 26Apr21	1	GREAT ROOM: ADDITIONAL RG6 HIGH SPEED TV / INTERNET OUTLETS - LOCATE APPROX. 66" A.F.F SEE PLAN FOR LOCATION
2459 72,256 26Apr21	1	BASEMENT: ADDITIONAL RG6 HIGH SPEED TV / INTERNET OUTLETS - LOCATE APPROX. 66" A.F.F SEE PLAN FOR LOCATION

PAINT

Invoice	Qty.	Description
2573	2	MAIN STAIRS: 2ND FLOOR TO BASEMENT - STAIN STAIRS AND LANDINGS
19Mar21 NoCat		STAIRS AND LANDINGS WILL NOT MATCH HARDWOOD FLOORS IN COLOUR/TEXTURE/SPECIES
2459	1	**CUSTOM LAYOUT** REDUCE SIZE OF MASTER WIC, TO ALLOW FOR ADDITIONAL 3-PIECE BATHROOM (ENSUITE 2) - COMPLETE WITH TUB AND STANDARD FINISHES - SEE PLAN FOR LOCATION
26Apr21 NoCat		

PAINTING

Invoice	Qty.	Description
2459 72,351 26Apr21 **	2	BASEMENT WINDOWS - UPGRADE BASEMENT WINDOW SIZE TO 30 " X 24" - 8" FRAME
2459 72,690 26Apr21 **	1	DELETE KITCHEN BULKHEAD, IF POSSIBLE, SITE APPROVAL REQUIRED
2459	1	DELETE KITCHEN BULKHEAD, IF POSSIBLE, SITE APPROVAL REQUIRED
26Apr21 ** NoCat		

DisciplineMS.rpt 23feb21 Page 13 of 17



Lot: 2

Model: 42.03 A FORESTCREST

Project/Phase: Pine Valley Forevergreen / 1

DisciplineMS.rpt 23feb21 Page 14 of 17 Printed and Sent: 13-May-21



Lot: 2

Model: 42.03 A FORESTCREST Project/Phase: Pine Valley Forevergreen / 1

PLUMBING

Invoice	Qty.	Description
2523	1	**NOTE** ENSUITE 3: WHIRLPOOL TUB MODEL - 30X60" MIROLIN PHOENIX #PAS6030L/R AW - WHITE
22Dec20 NoCat		
2523	1	MASTER ENSUITE: UPGRADE SHOWER SYSTEM TO MOEN 'ALIGN' RAIN SHOWER (from ceiling) + HAND SHOWER - brushed gold
22Dec20 NoCat		
2523 72,346	1	KITCHEN: ADD POT FILLER -MOEN 'MODERN' stainless
22Dec20		ROUGH-IN INCLUDED
2573	1	POWDER ROOM: BLACK RECTANGULAR UNDERMOUNT SINK
19Mar21 NoCat		
2573	1	ENSUITE 2: MOEN 'RIZON' TUB/SHOWER + LAV FAUCET 'MATTE BLACK'
19Mar21 NoCat		
2573	1	**REVISED SELECTION** KITCHEN: CHANGE POT FILLER TO BRUSHED GOLD
19Mar21 NoCat		ORIGINALLY SELECTED STAINLESS FINISH (PE.2523)
2573	1	ENSUITE 4: MOEN 'RIZON' SHOWER + LAV FAUCET 'MATTE BLACK'
19Mar21 NoCat		
2573	1	MASTER ENSUITE: MOEN 'ALIGN' 8"cc LAV FAUCET x2 + TUB FAUCET 'BRUSHED GOLD'
19Mar21 NoCat		
2573	1	KITCHEN: BLANCO QUATRUS R15 U SUPER SINGLE - STAINLESS STEEL SINK
19Mar21 NoCat		BOTTOM GRID NOT INCLUDED
2573	1	KITCHEN: MOEN 'NIO' FAUCET MATTE BLACK + GOLD HANDLE
19Mar21 NoCat		
2573	1	KITCHEN: MOEN 'MODERN' SOAP DISPENSER - MATTE BLACK
19Mar21 NoCat		LOCATE RIGHT OF FAUCET
2573	1	KITCHEN: MOEN 'NIO' BAR FAUCET - MATTE BLACK
19Mar21 NoCat		
2573	1	SERVERY: UPGRADE SINK TO BLANCO R15 U BAR - STAINLESS STEEL
19Mar21 NoCat		

DisciplineMS.rpt 23feb21 Page 15 of 17



Lot: 2

Model: 42.03 A FORESTCREST

Project/Phase: Pine Valley Forevergreen / 1

DΤ	U	N	\mathbf{R}	\mathbf{C}
ri	. []	VI	ы	(T

Invoice	Qty.	Description
2459 72,332 26Apr21	1	KITCHEN: ROUGH-IN 1/4" COLD WATER LINE TO FREEZER
2459 72,335 26Apr21	1	REAR YARD: HOT AND COLD WATER SUPPLY LINES IN REAR YARD IN LIEU OF STANDARD OFFERING
2459 26Apr21 NoCat	1	**CUSTOM LAYOUT** REDUCE SIZE OF MASTER WIC, TO ALLOW FOR ADDITIONAL 3-PIECE BATHROOM (ENSUITE 2) - COMPLETE WITH TUB AND STANDARD FINISHES - SEE PLAN FOR LOCATION
2459 26Apr21 NoCat	1	**CUSTOM LAYOUT** RELOCATE EXISTING LAUNDRY ROOM FROM 2ND FLOOR TO MAIN FLOOR MUD ROOM - REMOVE EXISTING LOWER CABINETS TO ALLOW SPACE FOR APPLIANCES - SEE PLAN FOR LOCATION
2459 26Apr21 NoCat	1	**CUSTOM LAYOUT** ADD LAUNDRY FOR STACKING MACHINES AND LAUNDRY TUB + CREATE LARGER WIC AND ADD WHIRLPOOL TUB - SEE PLAN FOR LOCATION
2722 101,930 26Apr21	1	***NOTE: REVISED FROM PE 2523*** ENSUITE 3: UPGRADE WHIRLPOOL TUB SEE ATTACHED
2758 13May21 NoCat	1	ENSUITE 3: TUB RESELECTION SEE ATTACHED RE-SELECTION - SIGNED COPY

STAIR AND RAILINGS

Invoice	Qty.	Description
2573	1	MAIN STAIRS: ADD FOR GLASS PANEL IN LIEU OF PICKETS, OPT. 5 BED PLAN - UPGRADE - GLASS PANEL
100,264		
19Mar21		

WINDOWS - BASEMENT

WINDO	** 5	- DAGENIENT
Invoice	Qty.	Description
2459	2	BASEMENT WINDOWS - UPGRADE BASEMENT WINDOW SIZE TO 30 " X 24" - 8" FRAME
72,351		
26Apr21 **		

DisciplineMS.rpt 23feb21 Page 16 of 17



Lot: 2

Model: 42.03 A FORESTCREST

 $\label{lem:project/Phase: Pine Valley Forevergreen / 1} Project/Phase: Pine Valley Forevergreen / 1$


WINDOWS AND DOORS


WINDO	** . .	AND DOORS
Invoice	Qty.	Description
2459	1	BREAKFAST ROOM: UPGRADE TO 96" GARDEN DOOR ASSEMBLY
26Apr21 NoCat		

DisciplineMS.rpt 23feb21 Page 17 of 17



MIROLIN – HUDSON DROP IN TUB

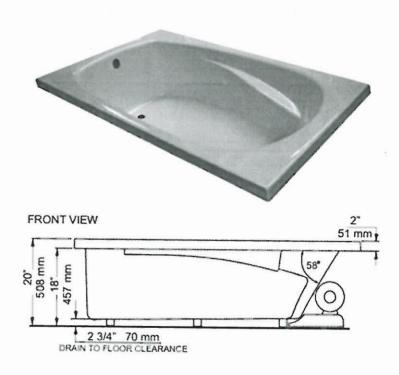


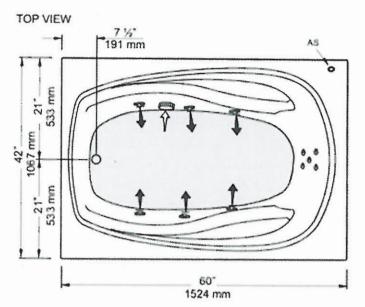


LOT #: PV - 2	DATE: May 12, 2021	LOCATION: Ensuite 3
SIGNATURE:	Anch	
SIGNATURE:	tach	



MIROLIN - HUDSON DROP IN TUB

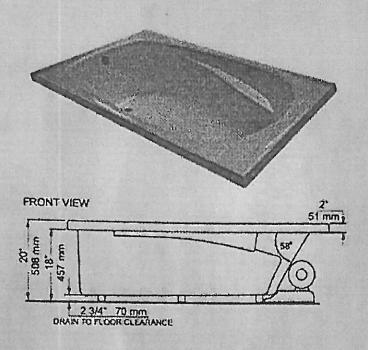

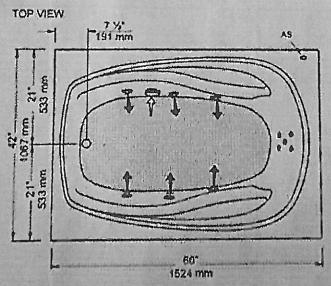

LOT#: PV-2	DATE: May 12, 2021	LOCATION: Ensuite 3
SIGNATURE:	W)	
SIGNATURE:		

GOLDPARK
WORTH MORE" *** NOTE: This is not an approved document. Document must be locked ***

Scheduled Closing Date: May 20, 2021

Purchasers:

Josette Kaye J Holness & Jacqueline Holness Property: 2 of Plan -

ayout Changes: Yes	No Sketch Attached:	Yes No Exterior Colour Scheme	:	
I. Cabinetry———	Style and Colour		• —————	
224	*2-TONE	Counter	Hardwa	
	Modena 'Classic White'	*2-TONE	attche	
Powder Room	*Chelsea pet hi gloss 'White'	P-Lam: Std White	attche	
Ensuite 3	*Chelsea pet hi gloss 'White'	*Quartz: 'Eternal Marquina	attche	
Master Ensuite	Oncisea pet fil gloss White	*Quartz: 'Eternal Marquina	attche	
Bathroom	*Chelsea pet hi gloss 'Black'	*Quartz: Statuario Maximus	attche	
Second Ensuite	*Lennox 'Carbon'	The contract of the contract o	(Y)	
(ppiloubic)		*Quartz: Gris Expo	attche	
	Modena 'Classic White'	*Quartz: Eternal Calacatta	attche	
Comment		en Island + Pantry Wall: *Manhattan Andaman' + CT C	+	
Floor Tile Entrance Vestibule Main Hall	Selection *12x24" Marmorea 'Bianco Cal	acatta' polished		
Kitchen / Breakfast	see harwood			
Laundry Room	+ Mudroom: 13x13" Capri 'White' matte			
Powder Room	*12x24" Marmorea 'Bianco Calacatta' polished			
Ensuite 3	*12x24" Cararra X Matte			
Master Ensuite Bathroom	*12x24" Marmorea-polished 'Pe	ort Laurent' + Grout 'Charace'		
Second Ensuite	12x24" Eterna Nero Ma	radina'		
Bathroom (If Applicable)	*12x24" Reve 'Fumee'			
Lower Landing (If Applicable)	see hardwood			
Ensuite 4	*12x24" Carrara X 'White' polisl	ned		
Comment				
	grout. Charcoal / ENSOI	/ MASTER ENSUITE Shower Floor: *Penny Rounds TE 4 Shower Floor: *2x2" Eterna Calacatta 'Grey' mai Quebcc 2" Hex ' Dark Grey'	'Black Glossy' / tte	
Wall Tile —	Selection	Listello/Inserts Describe		
Ensuite 3	*12x24" Carrara X 'white' poli:	Describe		
Master Ensuite Bathroom				
Tub Deck		○ Yes ● No		
Shower Stal Bathroom Walls		Yes No		
Second Ensuite		Yes No		
Bathroom (If Applicable)	*2x8" CDC 'Dove Grey' glossy	Yes No		
Ensuite 4	*12x24" Carrara X 'white' polis	shed Yes No		
Kitchen Backsplash	Yes No	Backsplash Behind Fridge		
Comment	*FHBS - 'Calacatta Gold'	•		
Comment				

GOLDPARK INTERIOR COLOUR SCHEME *** NOTE: This is not an approved document. Document must be locked *** Scheduled Closing Date: May 20, 2021 Purchasers: Josette Kaye J Holness & Jacqueline Holness Property: 2 of Plan -Telephone Res. / Bus: (647) 448-2780 / Project: Pine Valley Forevergreen - Phase 1 Decor Advisor: Yolande Somerville Model and Elevation: 42.03 A FORESTCREST 4. Plumbing Fixtures Second Ensuite **Powder Room** Master Ensuite Bathroom Other Room - Specify Other Washroom Comment UPGRADED THRU OUT - SEE EXTRAS ORDER 5. Hardwood Flooring Type and Stain Type and Stain Main Hall **Upper Landing** Kitchen / Breakfast *3/4x7-3/4" wht oak 'Eclipse' textur Upper Hall Living Room Master Bedroom **Dining Room** Bedroom #2 **Family Room** Bedroom #3 Den/Library Bedroom #4 **Entrance Vestibule** Bedroom #5 Lower Landing Other Room - Specify *3/4x7-3/4" wht oak 'Eclipse' textur (If Applicable) *3/4x7-3/4" wht oak 'Eclipse' textur Thru-out standard areas No - stained Comment like stairs 6. Carpeting Upgrade Description **Ground Floor** Second Floor Type Upgrade Underpad Capped Runner - *Upgrade Carpet on Stairs Comment 7. Fireplace Living Room **Family Room** Other Room - Specify Purchased As Per Plan N/A Purchased As Per Plan N/A Purchased As Per Plan N/A 0 0 0 0 Fireplace Type *Linear Gas Mantle Type n/a Colour / Stain n/a Surround n/a Hearth none Comment

Page 2 of 4

GOLDPARK WORTH MORE" *** NOTE: This is not an approved document. Document must be locked *** Scheduled Closing Date: May 20, 2021 Purchasers: Josette Kaye J Holness & Jacqueline Holness Property: 2 of Plan -Telephone Res. / Bus: (647) 448-2780 / Project: Pine Valley Forevergreen - Phase 1 Decor Advisor: Yolande Somerville Model and Elevation: 42.03 A FORESTCREST 8. Trim Carpentry Interior Doors Carrara Front Door Glass Inserts Standard Door Handles *Halifax blk + hinge *Board 4 Interior Trim Comment 9. Plaster Mouldings and Medallions Standard Throughout O Yes No N/A **Entrance Vestibule** Kitchen/Breakfast Main Hall Den/Library Living Room Lower Landing **Dining Room** Other Room - Specify **Family Room** Comment 10. Railings and Spindles Railing Package *Glass Package Railing Colour *Glass Package **Spindle Colour** *Glass Stringer / Riser *Vintage 'Graphite' **Treads** *Vintage 'Graphite' Oak Stairs Yes O No O N/A Comment 11. Wall Paint / Ceilings Throughout Finished Areas Warm Grey Trim Paint White

Trim Paint White

Smooth Ceilings
Ground Floor
Second Floor
Note

Comment





GOLDPARK WORTH MORE* *** NOTE: This is not an approved document. Document must be locked *** Josette Kaye J Holness & Jacqueline Holness Purchasers: Property: 2 of Plan -Telephone Res. / Bus: (647) 448-2780 / Project: Pine Valley Forevergreen - Phase 1 Decor Advisor: Yolande Somerville Model and Elevation: 42.03 A FORESTCREST 12. Electrical-Hood Fan White O Stainless N/A Above Kitchen Cabinet Light O Yes No Below Kitchen Cabinet Light Yes No Standard Appliances Over The Range Microwave Chimney Style Fan Comment 13. Heating and Air Conditioning Air Conditioning no **Gas Provisions Stove** ves Gas Provisions Dryer no Gas Provisions Barbecue std Comment 14. Additional Comments 15. Disclaimers and Notes 1) Colours of all materials are as close as possible to builder's selection, but not necessarily identical due to variances in manufacturing. 2) Any extras listed above are null and void unless accompanied by a separate invoice/amendment. Said invoice must be paid in full. 3) The Purchaser acknowledges that after Interior Colour Selection form is signed and dated, no further changes will be permitted other than re-selection due to unavailability. Purchaser's Initials 4) The Purchaser acknowledges reading and accepting the "Gold Park Homes Decor Centre Disclaimers" form. This document contains other miscellaneous disclaimers. This Interior Colour Selection is final and approved by: Signature:

Printed 2021-03-18 18:59:01

attached May 7,202

Kitchen / Breakfast Laundry Room Modena Classic White' Powder Room Former Forme			Jacqueline Holness I				
Layout Changes: Yes No Sketch Attached: Yes No Exterior Colour Scheme: 1. Cabinetry Kitchen / Breakfast Laundry Room			Madel and E				
1. Cabinetry Style and Colour Counter P. Lanut							
Kitchen / Breakfast Laundry Room Modena 'Classic Wale' P_Lam' Sid White Powder Room (Chelsoa pet hi gloss White' P_Lam' Sid White P_Lam' Sid Whi		O NO SKETCH A	Attached: Yes () No	Exterior Colour Scheme			
Laundry Room Powder Room Chelsea pet hi gloss White' Chelsea pet hi gloss Black Fountz Eternal Marquina Ensuite Bathroom Found French F					Hardwar		



Second Ensuite Bathroom (If Applicable) Ensuite 4	Master Ensuite				attched		
Ensuite 4 Modena 'Classic White' Comment KITCHEN Perimeter: Manhattan 'Late' + CT Quartz: Eternal Noire' Kitchen Idland + Panhy Woll: "Manhattan Andaman' + CT Quartz: Calac Servery: "Manhattan 'Andaman' + CT Quartz: Calac Selection	Bathroom	*Chelsea pet hi glo:	ss 'Black' Cuartz:	Statuario Maximus	attched		

Severy: "Manhattan 'Andeman'	Ensuite 4	Modena 'Classic W	hite' Quartz: I	Eternal Calacatta	attched		

Selection Selection	2. Floor Tile		B*		0		
Main Hall Kitchen / Breakfast Laundry Room Powder Room F12x24" Marmorea "Blanco Calacatta" polished F12x24" Reve "Fune" Nur o Marquin p. F12x24" Reve "Fune" Polished F12x24" Carrara X "White" polished F12x24" Land-Grigot Shower Floor "Ponny Rounds Black Glo Ensulte 3 F12x24" Land-Grigot Shower Floor "Ponny Rounds Black Glo Ensulte 3 Shower Floor "Onlario Black HEX + "grout "diacosit / Ensulte 4 Carrara X White Polished Yes No		Selection	the state of the s		and Address of the August Street, and the stre		

Powder Room Ensuite 3 **12x24" Marmorea 'Blanco Calacatta' polished Master Ensuite Bathroom Second Ensuite Bathroom (If Applicable) Lower Landing (If Applicable) Ensuite 4 **12x24" Carrara X 'White' polished Comment ENSUITE 3 Shower Floor 'Onlardo 'Black' HEX. + "grout' charcoal' / ENSUITE 4 Shower Floor 'Penny Rounds 'Black Glo ENSUITE 3 Shower Floor 'Anthracitc' + Shower Floor: Qhabto T Hex. 'Dark. Grey' Wall Tite Ensuite 3 **12x24" Land Son 'Anthracitc' + Shower Floor: Qhabto T Hex. 'Dark. Grey' Wall Tite Selection Listelloftneerts Selection Listelloftneerts Pascribe **12x24" Carrara X 'White' polished Yes No Bathroom Walls Selection **12x24" Carrara X 'White' polished Yes No Bathroom (If Applicable) **12x24" Carrara X 'White' polished Yes No Backsplash Behind Fridge + Mudroom: 13x13" Capri 'White' matte 12x24" Marmorea 'Blanco Calacatta' polished 12x24" Cararra X Matte					
Ensuite 3 Master Ensuite Bathroom Second Ensuite Bathroom (if Applicable) Lower Landling (if Applicable) Ensuite 4 Comment ENSUITE 9. **A2224** Land** Cargot** Shower Floor** Perity Rounds** Black Glos Ensuite 3 **Tex Ensuite Bathroom Tub Deck Shower Stati Bathroom Walls Seecond Ensuite Seecond Ensuite Seecond Ensuite See hardwood Ensuite 4 F12x24** Carrara X 'White' polished Comment Ensuite 3 Carrara X 'White' polished Yes No Sathroom (if Applicable) F12x24** Carrara X '							
Master Ensulte Bathroom Second Ensulte Bathroom (If Applicable) Lower Landing (If Applicable) Lower Landing (If Applicable) Ensulte 4 Comment ENSUITE 5. M2X24* Land-Englot-Shower-Floor-Ontario-Dark-Grey-HEX2/MASTER ENSUITE Shower-Floor: Penny Rounds 'Black Glot' HEX. + "grout' charcoal' Tensulte 4 Selection Tub Deck Shower Stall '2-tone Bathroom Walls Second Ensulte 4 Port Laurent + Grout 'Charcoal' NETO Mar quina' 12x24* Reve 'Fumee' See hardwood Floor: Penny Rounds 'Black Glot' Charcoal' Ensulte Shower-Floor: Penny Rounds 'Black Glot' HEX. + "grout' charcoal' Ensulte 4 Shower-Floor: Dark Grey 'Hex' Dark Grey' National Comment Selection Tub Deck Shower Stall '2-tone Bathroom Walls Second Ensulte Bathroom Walls 2x8* CDC Dove Grey glossy Yes No Backsplash Behind Fridge FHBS - Calacatia Gold' ASTER ENSULTE LONG Wall - "FROM Part of Glot' FHBS - Calacatia Gold'							
Yes No Backsplash Behind Fridge							
Bathroom (if Applicable) Lower Landing (if Applicable) Ensulte 4 Comment ENSUITE 5, 42224*Land-Englot-Shower-Floor-Ontario-Dark Gray-HEX-7 MASTER ENSUITE Shower Floor 'Penny Rounds 'Black Glo ENSUITE 3 Shower Floor 'Ontario 'Black 'HEX. 



Ensuite 3 #12x24" Carrara X 'white' polished Yes No Master Ensuite Bathroom Tub Deck		Selection	Liste	illofinserts Describe			
Tub Deck Shower Stall *2-tone Shower Stall *2-tone Second Ensulte Bethroom (If Applicable) *2x8" CDC Dove Grey glossy *12x24" Carrara X White polished *12x24" Carrara X White polished *Texture 4 *12x24" Carrara X White polished *Texture 4 *Texture 4 *Texture 4 *Texture 4 *Texture 5 No *Texture 4 *Texture 6 No *Texture 6 No *Texture 7 N		*12x24" Carrara >	('white' polished				
Shower Stall *2 - tone			1 m				
Bathroom Walls Second Ensuite Bathroom (If Applicable) *2x8" CDC 'Dove Grey' glossy Yes No *12x24" Carrara X White' pollshed Yes No Sitchen Backsplash Yes No Backsplash Behind Fridge *FHBS - 'Calacatia Gold' ASTER ENSUITE LONG Wall - "Boom Rounds 'Block Classical Cold' **ASTER 
Comment FHBS - 'Calacatta Gold' ,	Citchen Backsplash	TAXABLE AND INC.	Periodical O				
ASTER ENSUITE: LONG Wall - "Ponny Rounds Wilsols Classics" - 10			a Gold	-acropiasii belinu riidg			
SHORT Wall: 1224 Marmores Breccia White pr	ASTER ENSUITE LONG Wall - "	Ponny Rounde Want Class		(4)	5.09		
A STATE OF THE PROPERTY OF THE	SUITE 5: LONG Wall - 112:24-L	and 'Griglo' - SHORT Wal		and the same of th	ccla White polished		
→ Quebec 2" Hex Dark Grey"	- ~~		- De Que	oec 2" Hex "Dark Gray"	12014		

Page 1 c

Printed 2021-03/18 18:59:01

GOLDPARK *** NOTE: This is not an approved document. Document must be locked *** Cabadulad Closing Date: May 20, 2021 Josette Kaye J Holness & Jacqueline Holness Purchasers: Property: 2 of Plan -Telephone Res. / Bus: (647) 448-2780 / Project: Pine Valley Forevergreen - Phase 1 Model and Elevation: 42.03 A FORESTCREST Decor Advisor: Yolande Somerville 4. Plumbing Fixtures Second Ensuite Powder Room Other Room - Specify Master Ensuite Bathroom Other Washroom UPGRADED THRU OUT - SEE EXTRAS ORDER 5. Hardwood Flooring Type and Stain Type and Stain Main Hall **Upper Landing** Kitchen / Breakfast *3/4x7-3/4" wht oak 'Eclipse' textur **Upper Hall Living Room** Master Bedroom **Dining Room** Bedroom #2 **Family Room** Bedroom #3 Den/Library Bedroom #4 **Entrance Vestibule** Bedroom #5 Lower Landing Other Room - Specify 73/4x7-3/4" wht oak 'Eclipse' textur 53/4x7-3/4" whit oak 'Eelipse' textur (If Applicable) No - stained Comment like stoirs -6. Carpeting Upgrade Description Ground Floor Second Floor Type **Upgrade Underpad** Capped Runner - "Upgrade Carpet on Stairs Comment 7. Fireplace Living Room Family Room Other Room - Specify Purchased As Per Plan NJA Purchased As Per Plan N/A Purchased As Per Plan MA "Linear Gas Fireplace Type Mantle Type n/a Colour / Stain n/a Surround rva Hearth none Comment

Printed 2021-03-18 18:59:01

hone Res. / Bus: (647	e Res. / Bus: (647) 448-2780 /				
Trim Carpentry Interior Doors Carrara Interior Trim Board 4 Comment		Glass Inserts Standard Door H	Handles Hallfax blk + hinge		
Plaster Mouldings Standard Throughout Entrance Vestibule Main Hall Living Room Dining Room Family Room Comment		N/A Kitchen/Breakfast Den/Library Lower Landing Other Room - Specify			
	pindles s Package ass Package ntage 'Graphite'	Treads	'Glass 'Vintage 'Graphite' ■ Yes ○ No ○ N/A		
1. Wall Paint / Ce Throughout Finished	Areas wannessy				
Smooth Ceilings Ground Floo Second Floo Note	4179				

Printed 2021-03-18 18:59:01

Page 3 of 4

GOLDPARK		DLOUR SCHEME		
WORTH MORE *** NOT	E: This is not an approved	document. Docume	ent must be locke	ed ***
Purchasers: Josette Kaye J	Holness & Jacqueline Holness	From Date: May 20, 2021 Property: 2 of Plan -		
Telephone Res. / Bus: (647) 448-2780		Project: Pine Valley For	revergreen - Phase 1	
Decor Advisor: Yolande Somer	ville Model and I	Elevation: 42 03 A FORE	STCREST	
_12. Electrical				
Hood Fan White Stain	ess N/A		inet Light O Yes	
Standard Appliances		Below Kitchen Cabi	net Light Yes) No
Over The Range Microwave				
Chimney Style Fan				
Comment				
-13. Heating and Air Condition Air Conditioning no		s Provisions Stove	yes	
Gas Provisions Dryer no		as Provisions Barbecue	std	
Comment				
	and the same and t			
		THE STATE OF		
-14. Additional Comments				
	Barrier Barrier			
15. Disclaimers and Notes—				
1) Colours of all materials are as close as po	salble to builder's selection, but not no	cessarily identical due to varia	must be paid in full.	
2) Any extras listed above are null and void 3) The Purchaser acknowledges that after in	inless accompanied by a separate invi	and dated, no further changes	will be permitted other	
than re-selection due to unavallability	1 8101303			
The Purchaser acknowledges reading en other miscellaneous disclaimers.	d accepting the "Gold Park Homes De	cor Gentre Disclaimers* form.	This document contains	
This interior Colour Selection is final and	approved by:			
a de la constante de la consta		2.1		
Signature: Vita chea	Date: March 14, 20	41		Name of the last
Called actived.	Date: March 18, 20	4		Page 4 of

Printed 2021-03-18 18:59:01



PV - 2 Cabinetry Schedule

Amended April 21, 2021

ROOM	DESCRIPTION	PRICE	QTY	TOTAL
KITCHEN	ADD ITEM: MINI STACKED UPPERS (10' CEILING, NO BULKHEAD)> NOTE: SEE 2-TONE CABINETRY		1	
7764		CABINETRY TOTAL:		

HANDLE PLACEMENT: AT INSTALLERS DISCRETION

SIGNATURE: (C. A.	LOT #: 2	DATE: \(\sigma_1 \(\pa_1 \) \(\pa_2 \)	
GUNATURE. GUNAMU	SIGNATURE:	What,	

GOLDPARK

REVISED: 12/18/2020 15:24



PV - 2 Cabinetry Schedule Amended April 21, 2021

ROCK!	DESCRIPTION	FFIGE	QFY TECH
NTONEN	ACD ITEM: MINI STACKED UPPERS (16" CEILING, NO BULKHEAD)		1
		CABINETRY TOTAL:	


HANGLE PLACEMENT: AT INSTALLERS DISCRETION


LOT# 2	ADVIL 31, 2031	
IGNATURE: (9	And the second s
SIGNATURE:	A	

#EVISED. 11/12/1920 (5.34



Mirolin-BLISS

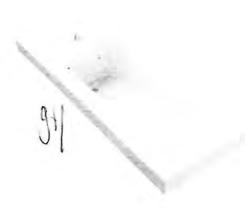

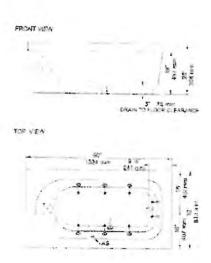

MODEL W0672

101# 3	DATE	April 23	1608	LOCATION: Short worll
SIGNATURE:	tolness	<i>N</i> _	•	
SIGNATURE:	09	1/2/2)	
1	9		23	GOLD




PV - 2 Cabinetry Schedule

ROOM	DESCRIPTION	PRICE CITY	TOTAL
KITCHEN	UPGRADE PART OF PERIMETER FROM SERIES 2 TO SERIES 3 ELITE - MANHATTAN LATTE UPGRADE SERVERY FROM SERIES 2 TO SERIES 6 ELITE - MANHATTAN ANDAMAN	1	
	UPGRADE PANTRY/FRIDGE WALL FROM SERIES 2 TO SERIES 6 ELITE - MANHATTAN ANDAMAN	1	
	UPGRADE HARDWARE - BH-052-09 - LARGE GOLD	1	
	ADJUST CABINETRY FOR 36" RANGE - LEAVE APPROX 3" GAP ON EITHER SIDE (N/C)	1	
	UPPER CABINET ADJACENT TO KITCHEN WINDOW DELETED (N/C)	1	
	ADD 4-BIN RECYCLE CENTRE	1	
	MITRED HOOD CABINET PLANNED WITH 3" GAPS IN ELITE - MANHATTAN ANDAMAN CONVERT STD UPPER AND BASE CABINET TO TALL DEEP BUILT IN OVEN UNIT WITH DRAWER BELOW IN ELITE ANTHRACITE FULL-EXTENSION	1	
	EXTENDED 48"H UPPERS IN LIEU OF STD. 45"H AS A RESULT OF STANDARD CROWN DELETION.		
	FURRING RAIL TO CEILING, ROUGHLY 3"H (N/C)	1	
	FLIP UPS ABOVE FRIDGE/PANTRY (ONE ABOVE FRIDGE, TWO ABOVE PANTRY)	1	
	SUPPLY 2"T X 39"W OPEN SHELVES IN SERVERY IN ELITE - MANHATTAN ANDAMAN	1	
	SUPPLY SERVERY UPPER WINE CUBE STORAGE 48"H x 6"W IN ELITE - MANHATTAN ANDAMAN	1	
	ADJUST SERVERY BASES FOR 18"W BEVERAGE WINE FRIDGE (N/C)	1	
	RETURN TRIP FOR KICKPLATE ADJUSTMENTS	1	
ISLAND:	UPGRADE FROM SERIES 2 TO SERIES 6 ELITE - MANHATTAN ANDAMAN	1	
	STD BANK OF DRAWERS RELOCATED TO ISLAND (N/C)	1	
	ADD FULL-HEIGHT SPICE PULL-OUT ACCESSORY TO ISLAND WITH PLUG ON PANEL ON TOP OF		
	ONE OF THEM	2	
	ADD TOUCH LATCH HARDWARE TO REAR ISLAND BASES	1	
	ADD CAMDEN FLUSH FURNITURE KICK PLATE TO REAR ISLAND		
POWDER ROOM	UPGRADE FROM SERIES 2 TO SERIES 3 - CHELSEA PET HIGH GLOSS WHITE	1	
	ADD TOUCH LATCH HARDWARE	1	
ENSUITE 2	UPGRADE FROM SERIES 2 TO SERIES 3 - LENNOX CARBON	1	
ENSUITE 3	UPGRADE FROM SERIES 2 TO SERIES 3 - CHELSEA PET HIGH GLOSS WHITE	1	
ENSUITE 3	ADD BANK OF FOUR DRAWERS	1	
MASTER ENSUITE	UPGRADE FROM SERIES 2 TO SERIES 3 - CHELSEA PET HIGH GLOSS BLACK	ā	
	UPGRADE HARDWARE - BH-052-09	1	
	CARINIE	RY TOTAL:	

*** HANDLE INSTALLATION: HORIZONTAL ON DRAWERS, VERTICAL ON DOORS UNLESS OTHERWISE NOTED ***

	1021		
OT#: PV-2 DATE: March 18			
SIGNATURE:			

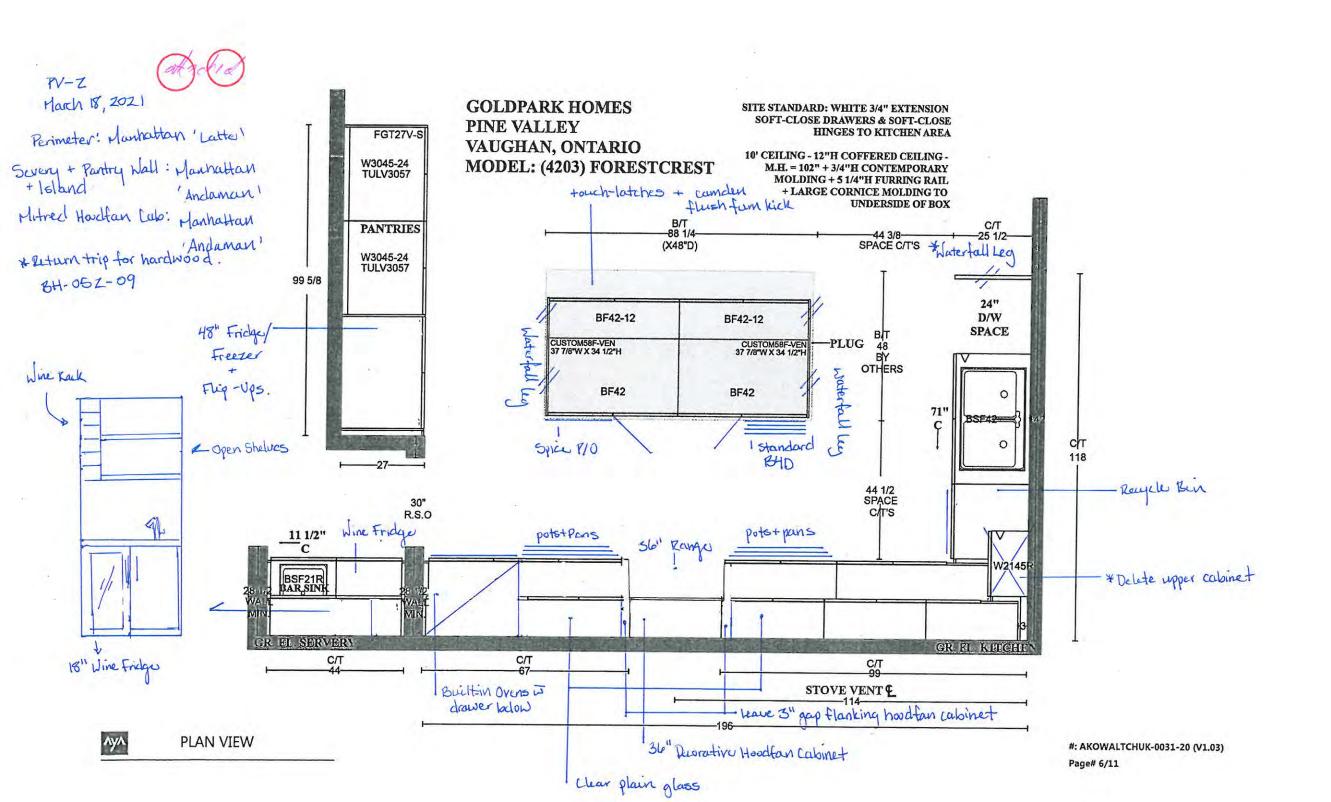



GOLDPARK HOMES PINE VALLEY VAUGHAN, ONTARIO MODEL: (4203 OPT.) FORESTCREST


PV-2 March 18, 2021 (A)


SITE STANDARD: WHITE 3/4" EXTENSION SOFT-CLOSE DRAWERS & STANDARD SLAM DOOR HINGES TO VANITIES

ONE TOP DRAWER WHERE POSSIBLE THROUGHOUT EACH VANITY, ONE BANK OF DRAWERS WHERE POSSIBLE THROUGHOUT EACH MASTER ENSUITE VANITY

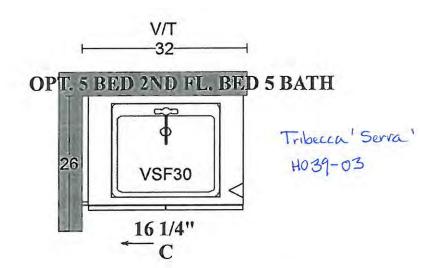


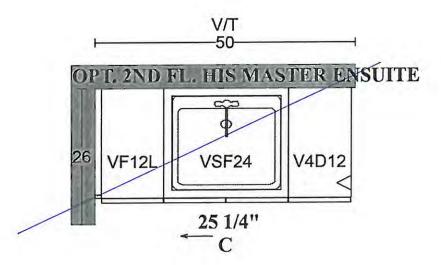


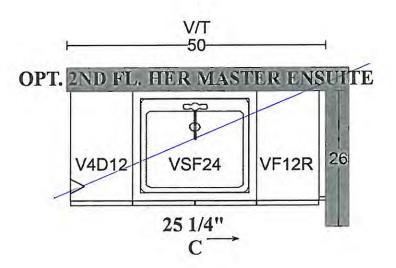

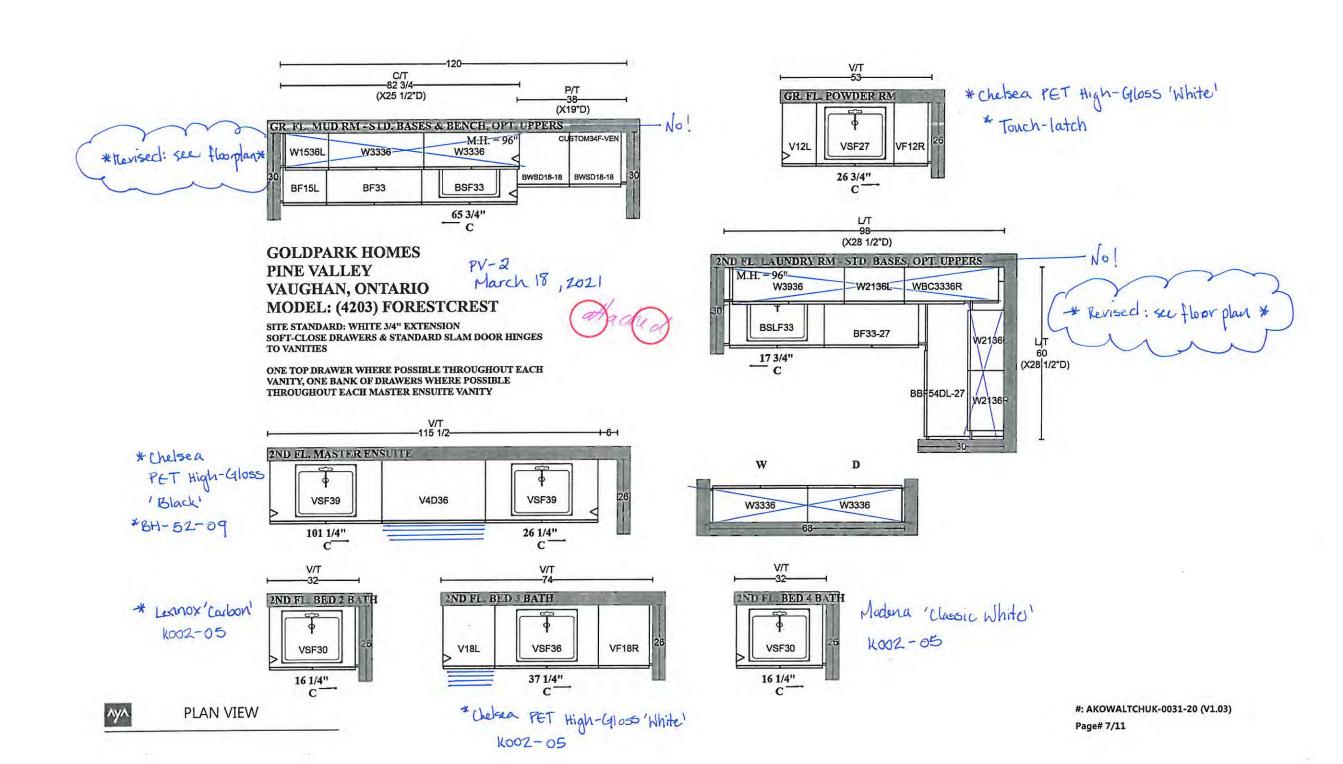

SCHEDULE'F'

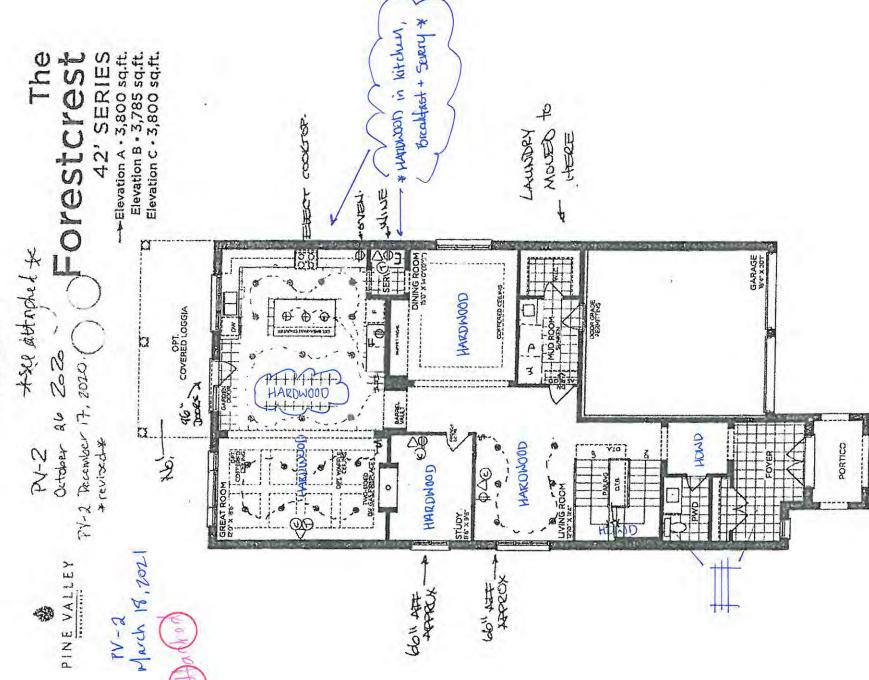


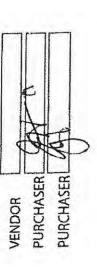


GOLDPARK

GROUND FLOOR | ELEV. A

Prices, figures, flustrations, sizes, festures and finishes are subject to charge without notice. Areas and differencions are upproximate and actual usable ficor space may vary from the stated area. Layout may be reverse of the unit purchasted. E. B. Q.E. 4203

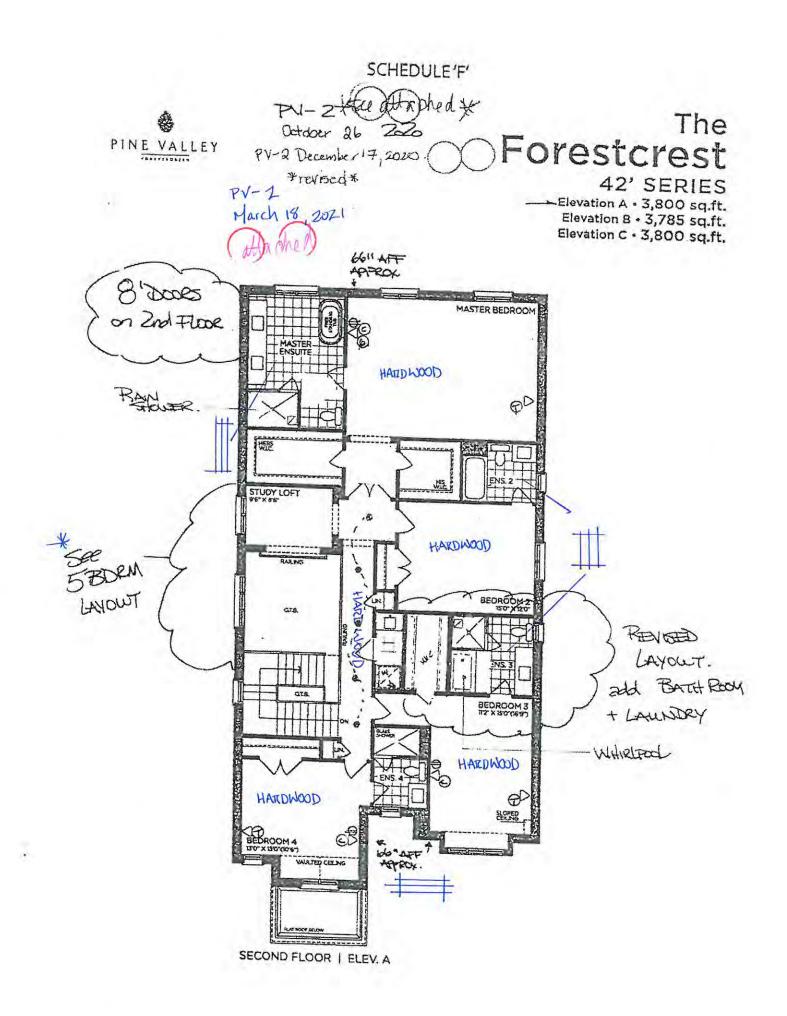

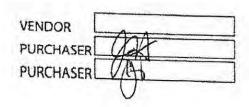



GOLDPARK

WORTH MORE

Prices, figures, illustrations, sizes, features and finishes are subject to change without notice. Areas and dimensions are approximate and actual usable floor space may vary from the stated area. Layout may be reverse of the unit purchased. E. & O.E. 4203

SCHEDULE'F'

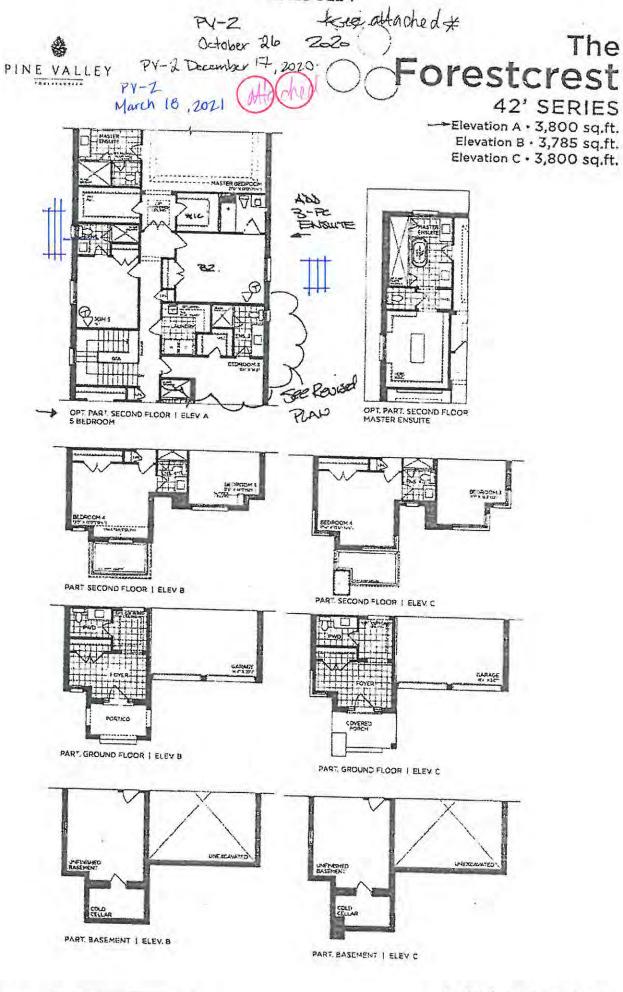


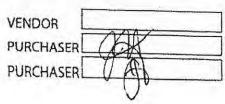


GOLDPARK WORTH MORE

Prices Ingures, illustrations, sizes features and finishes are subject to change without notice. Areas and dimensions are approximate and actual usable floor space may vary from the stated area, Layout may be reverse of the unit purchased. E. & C.E. 4203

SCHEDULE'F'

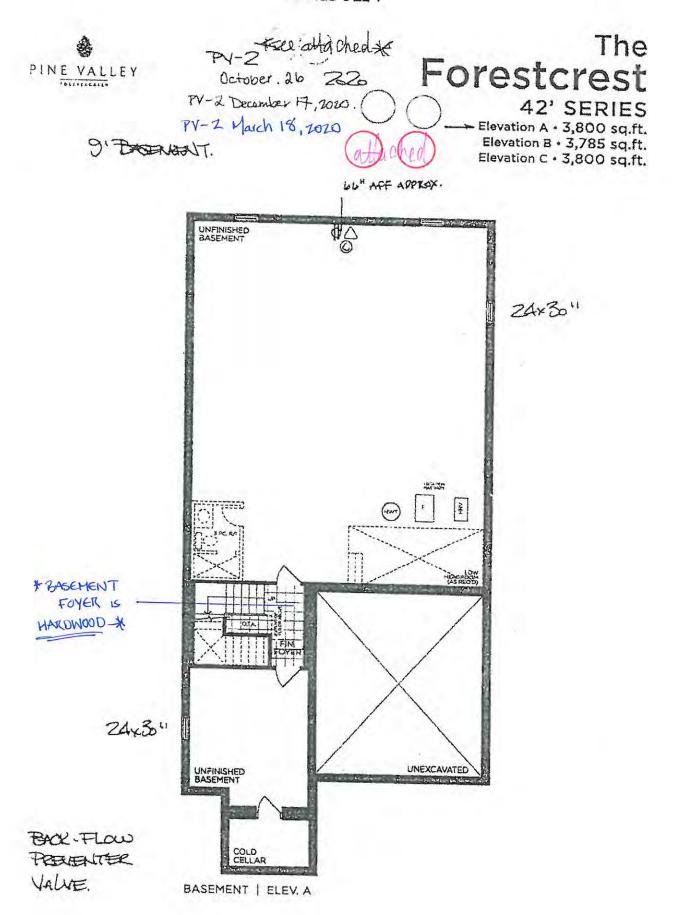

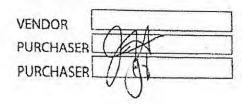

GOLDPARK

Prices, figures, flustrations, sizes features and finishes are subject to change without notice. Areas and dimensions are approximate and actual usable floor space may vary from the stated area. Layout may be reverse of the unit purchased E. & C.E. 4203



PV - 2 Cabinetry Schedule


ROOM	A DESCRIPTION	FRICE	211		IOTAL
FITCHEN	UPGRADE PART OF PERIMETER FROM SERIES 2 TO SERIES 3 ELITE - MANUATTAN LATTE	3,613.28	1		
	UPGRADE SERVERY FACIN SERIES 2 TO SERIES & ELITE - MANHATTAN ANDAMAN	422.40	1	5	3,613 26
	UPGRADE PANTRY/FRIDGE WALL FROM SERIES 2 TO SERIES 6 ELITE - MANHATTAN ANDAMAN	122-10	4	,	422,40
		7 242 40	2	5	7.242.40
	UPGRADE HARDWARE - DH-052-09 - LARGE GOLD	2,854,50	1	5	2,854.50
	ADJUST CABINETRY FOR 36" PANGE - LEAVE APPROX 3" GAP ON EITHER SIDE (N/C)		1	5	4,0.7
	UPPER CABINET ADJACENT TO INTCHEN WINDOW DELETED (1/1/C)	- 2	1	5	
	ADD 1-DIN RECYCLE CENTRE	1,432 20	1	\$	1,432.20
	MITRED HOOD CABINET PLANNED WITH 3" GAPS IN ELITE - MANUATTAN ANDAMAN	6,240.30	1	\$	6,240,30
	CONVERT STD UPPER AND BASE CABINET TO TALL DEEP BIJLT IN OVER UNIT WITH DRAWER				42.10.00
	BELOW IN ELITE ANTHRACITE FULL-EXTENSION	2 910 60	1	5	2,910 60
	EXTENDED 48"H UPPERS IN LIEU OF STO. 45"H AS A RESULT OF STANDARD CROWN DELETION.				4,10 00
	FURRING WAIL TO CEIUNG, ROUGHLY 3"H (N/C)		1	5	
	FLIP UPS ABOVE PRIDGE/PANTRY (DNC ASOVE FRIDGE, TWO ABOVE PANTRY)	1,237 50	1	5	1,237 50
	SUPPLY 7"T X 30" W OPEN SHELVES IN SERVERY IN FLITE - MANUATTAN ANDAMAN	1,095.60	1	5	1,025.60
	Supply Sepvery upper vaine cude sturage 49"H x 6"x" in Eute - Manhattan andaman	2 234 10	1	5	2 434 10
	ADJUST SERVERY BASES FOR 18"W BEVERAGE WINE FRIDGE INACI	3.00	1	5	A 154 10
	return thip for kickflaie adjustments	320 CO	1	\$	320 00
		and.	-	5	23,602.88
SLAND	INCOME PARKA PROME A SALAM AND				0.00
3000	UPGRADE FROM SCRIES 2 TO SERIES & EUTE - MANHATTAN ANDAMAN	2,383 01	1	\$	2,353 04
	STD BANK OF PRAVIERS RELOCATED TO ISLAND IN/C)	4.5	1	5	20000
	ADD FUIL-HEIGHT SPICE PULL-OUT ACCESSORY TO ISLAND WITH PLUG ON PANEL ON TOP OF ONE OF THEM				
		1,250.00	2	5	2,500.00
	ADD TOUCH LATCH HARDWARE TO REAR ISLAND BASES	330 00	1	5	330 00
	ADD CAMDEN FLUSH FURNITURE KICK PLATE TO REAR ISLAND	375.00	1	\$	375,00
				3	5,588.04
POWDER ROOM	UPGRADE FROM SERIES 2 TO SERIES 3 - CHELSEA PET HIGH GLOSS WHITE	704.60		2	25.000
	ADD TOUCH LATCH HARDWARE	201.60	1	\$	201.60
		165.00	1	5	165.00
				5	366.60
NSUITE 2	UPGRADE FROM SERIES 2 TO SERIES 3 - LENNOX CARDON	76 60	1	\$	96 0G
		70.00		3	36.00
INSURE 3	- And Decreption of the Control of t				20,00
Maurie 3	upgrade from Series 2 to Series 3 - Chelsea pet high Gloss white	232.80	1	5	232,60
	add bane of four drawers	60 00	1	\$	660 00
				5	892.80
AASTER ENSUITE	Upgrade from Series 2 to Series 3 . Chelsen pet high gloss black	408.32			*****
	UPGRADE HARDWAKE - 811-052-09	594 00	1	5	405.32
		339 00	1	5	592 00
				2	1,002.32
	CARINET	RYTOTAL		5	37,548.64

*** HANDLE INSTALLATION: HORIZONTAL ON DRAWERS, VERTICAL ON DOORS UNLESS OTHERWISE HOTED ***

LOTN: PV-2	DAYE: March 18, 2021	
SIGNATURE:	Aloness 1	
SIGNATURE:	O (AXI).	
0-	J. Le	GOLD /

17/13/10/20 15 24

.

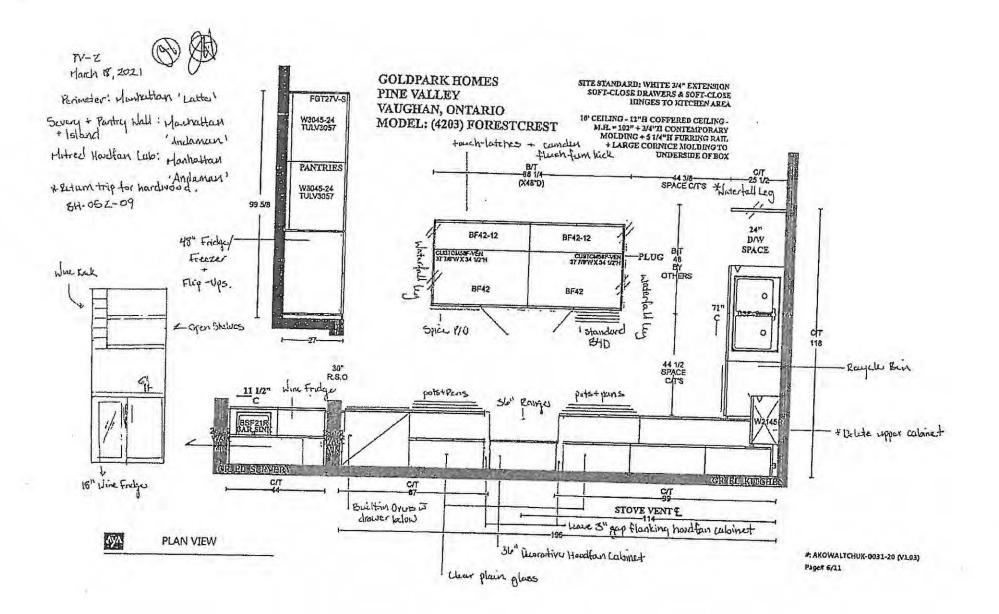

GOLDPARK HOMES PINE VALLEY VAUGHAN, ONTARIO


Harch 18, 2021





MODEL: (4203 OPT.) FORESTCREST

SITE STANDARD: WHITE 3/4" EXTENSION SOFT-CLOSE DRAWERS & STANDARD SLAM DOOR HINGES TO VANITIES

ONE TOP DRAWER WHERE POSSIBLE THROUGHOUT EACH VANITY, ONE BANK OF DRAWERS WHERE POSSIBLE THROUGHOUT EACH MASTER ENSUITE VANITY

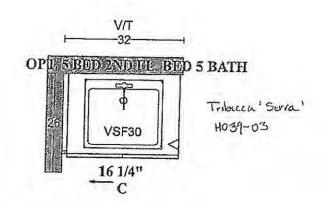

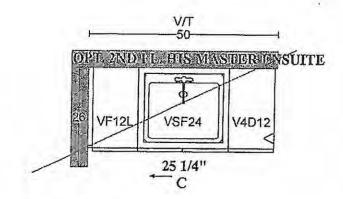


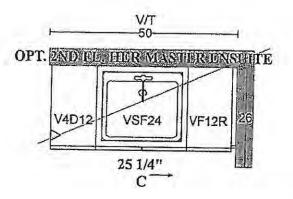


AyA


PLAN VIEW

#: AKOWALTCHUK-0031-20 [V1.03) Page# 8/11

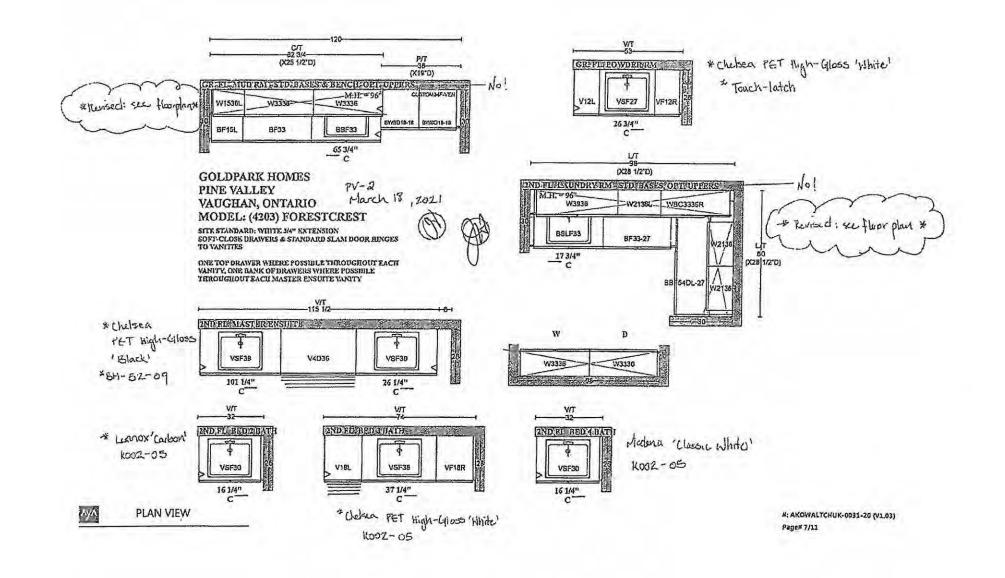


SCHEDULE'F'

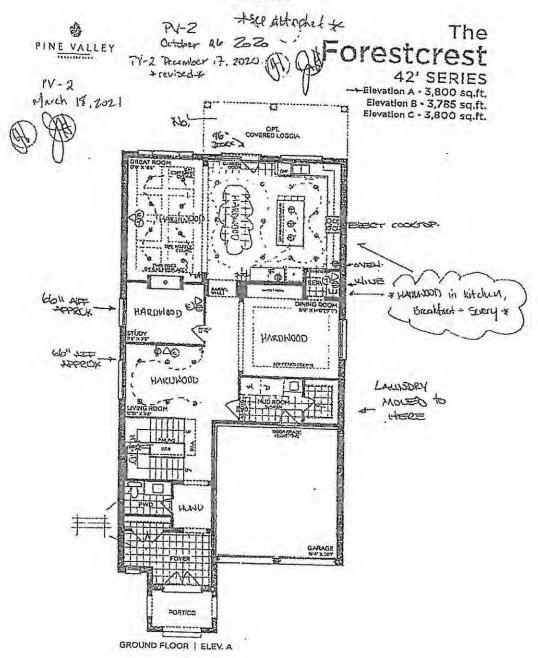


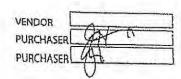

GOLDPARK WOLL WOLL


Prices, Ripurer, il stration, a see Teatures and Rushes are subject to energe without notice, areas and dimensions are approximate and actual vasible from specie may vary from the attendance to the process of the pro

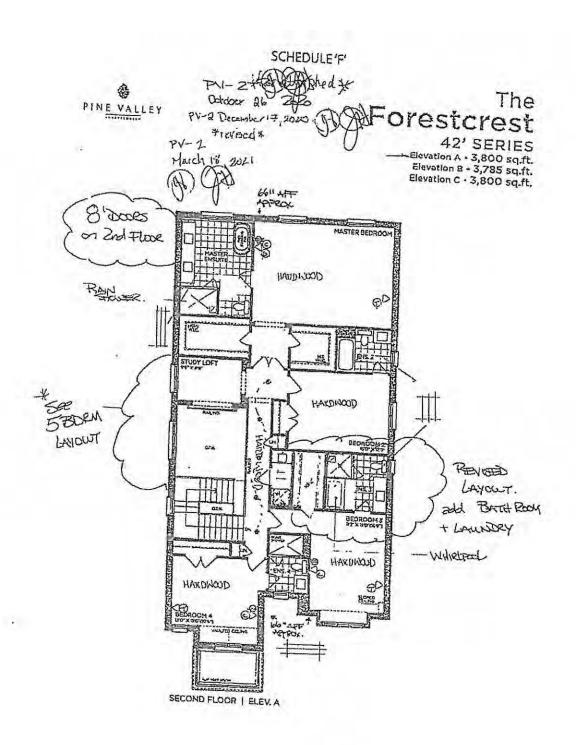

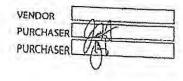


GOLDPARK WORTH HORE

Piece, flower districtions, each, feathers and feather are subject to change self-original and districtions are approximate and actual stable floor space may keep from the stable area. I also a layout may be retained to the unit distriction. I a C.E. 4705

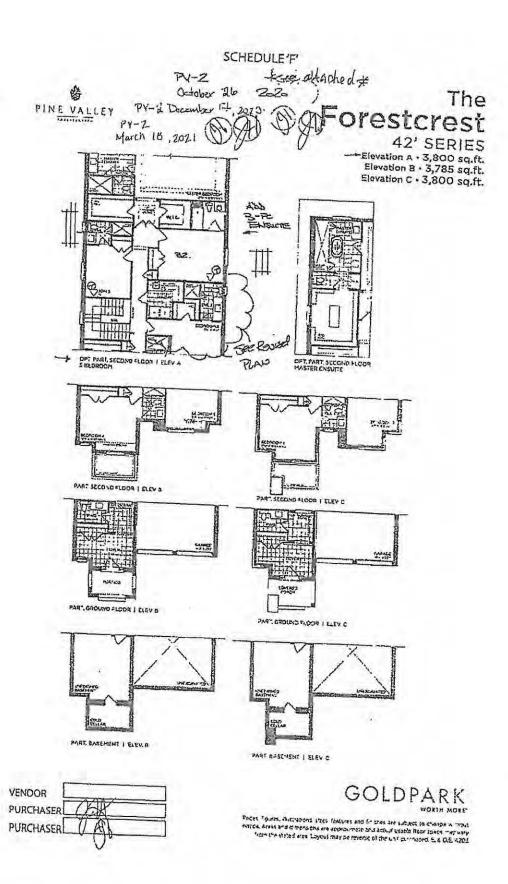

SCHEDULE'F'

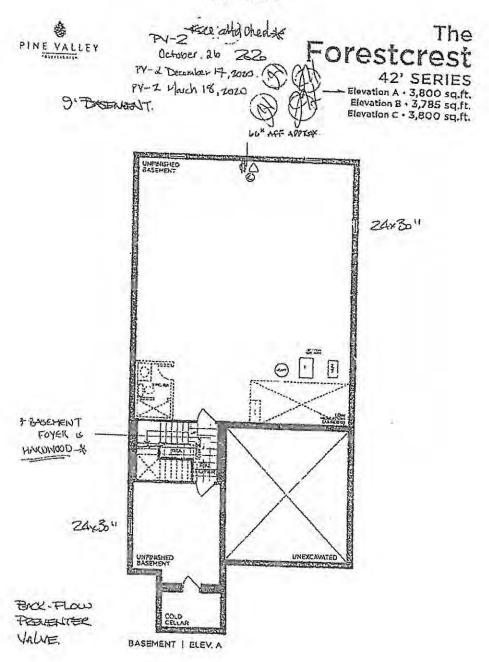

PURCHASER A

GOLDPARK WOLLH MORE

Prices, flames, focuse and lease testines and facilities am automative change a vincial natice disease and different proportionate and actual visible from space may very from the lifetical since Layout may be received all the unit outchased 6. A.O.E. 4203



STONE COUNTERTOP EDGE PROFILES

	STANDARD 2CM EASED EDGE	LOCATION: *THRU-OUT *
	UPGRADE 3CM EASED EDGE	LOCATION: * Kitchen
	UPGRADE 4CM MITRED EDGE	LOCATION:
	UPGRADE 2CM OGEE EDGE	LOCATION:
LOT#: PV-2 SIGNATURE:	DATE: March 18,	202





тот#ру- 2	DATE: March 18, 2021	
SIGNATURE:	ached	
SIGNATURE:	hohed	



H001-02	H001-03	H001-04
	6	
H009-03	H009-09	
H011-03	H011-05	H011-06
		· ·
H033-01	H039-03 > Ensuite 5	*NO HARDWARE
LOT# PV-2 DATE:	n 18,2021	
SIGNATURE: Hached		
SIGNATURE: when when the		



BH-052-09

Pull - 'Brushed Gold'



LOCATION:

+Master Ensuite + Kitchen

LOT# PV-2	DATE: March 18/2021	
SIGNATURE:	hod	
SIGNATURE:	hed	

CHROME



MOEN - MODERN

Pot Filler



STAINLESS (SF	35)—		
BRUSHED GO	LD (BG)		
MATTE BLACK	(BL)		
MODEL: \$665 (\$RS, 8G)	, BL) Pot Filler		
	*REVISED#		
Western Commencer of the Commencer of th	March 18, 2021	The state of the s	
Lot# PV-2	Date: December 17, 2020	Room: Kitchen	
Signature	800		
Signature:	Holness		- 1
0	J		GOLDPARK

CHROME



MOEN - NIO

One-Handle Pulldown Kitchen Faucet




SPOT RESIST STAINLESS (SRS)	
DEL: S75005 Chrome / S75005BL Matte Black / S75005SRS Spot Resist Stainless	
Date: March 18, 2021 Room: Kitchen	
ot# PV-2 Date: March 18, 2021 Room: Kitchen Signature:	



BLANCO - QUATRUS R15 U SUPER SINGLE

Stainless Steel - Undermount 32" x 18" x 9"



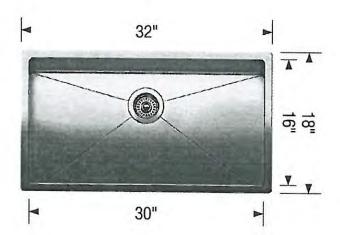

Stainless Steel

MODEL 401518 Stainless Steel

Lot# PV- 2	
Room: Kitchen	Signature:
Date: March 18, 2021	Signature:

CHROME



MOEN - MODERN

Soap/Lotion Dispenser



BRUSHED GOLD		
MATTE BLACK		
EL S3947C Chrome /	S3947SRS Stainless / S3947BG Bru	shed Gold / S3947BL Matte Black
	JA .	
T# 014 2	ROOM: V: I	DATE:
PT# PV-2	ROOM: Kitchen	DATE: Harch 18, 2021
	ROOM: Kitchen	DATE: March 18, 2021
DT# PV-2 GNATURE:	ROOM: Kitchen	DATE: Harch 18, 2021

CHROME



MOEN - NIO

One-Handle Bar Faucet



MATTE BLACK / BRUSHED GOLD (BL) STAINLESS (SRS)	
MODEL: S55005 Chrome / S55005BL Matte Black / S55005SRS	Spot Resist Stainless
Lot# PV-2 Date: March 18, 2021	Room: Servery
Signature:	
Signature.	
Signature:	



BLANCO - QUATRUS R15 U BAR

Stainless Steel - Undermount 17" x 17" x 8"



Stainless Steel

MODEL 401515 Stainless Steel

Lot# PV-2	
Room: Servery	Signature:
Date: March 18, 2021	Signature:





EMERY

RECTANGULAR UNDERMOUNT SINK

□ 4220CGY Undermount Sink, Soft White Undermount Sink, Matte Black Undermount Sink, Slate Grey

PRODUCT SPECS:

- Vitreous china
- Front overflow hole
- 8¼" Bowl depth
- Template and mounting hardware

supplied

DIMENSIONS:

Outer:

545mm W x 355mm D x 210mm H 21½" W x 14" D x 8½" H

Inner:

495mm W x 305mm D x 160mm H 19½" W x 12" D x 6½" H

COMPLIANCE CERTIFICATIONS

Meets or exceeds the following:

- IAPMO cUPC
- ASME A112.19.2 / CSA B45.1


SHIPPING


Cube 1.85 GW 20 lbs






NOTES: Dimensions of fixtures are nominal and may vary within the range of tolerances established by ASME standard Al12.19.2. These measurements are subject to change or cancellation. No responsibility is assumed for use of superseded or voided pages.

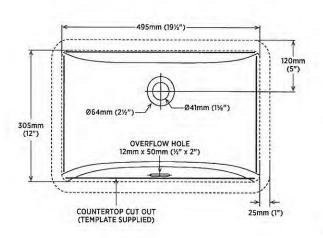

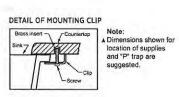

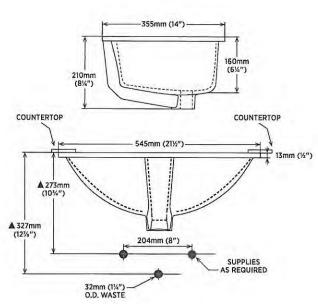

Lot#

74-2

Date:

March 18,2021

Room:

Ponder Room

Signature:

and the of

Signature:



CHROME



MOEN - ALIGN

Two-Handle Adjustable Widespread Lav Faucet with Lift Rod Drain



BRUSHED NICKEL (BN)	
MATTE BLACK (BL)	
BRUSHED GOLD (BG)	
MODEL: T6193 Lav Faucet / 69000 Valve	
Lot# PV-2 Date: March 18, 2021	Room: Master Ensuite x2
Signature: The d	
Signature: The dead	



MOEN - ALIGN

Two-Handle Roman Tub Faucet



CHROME	
BRUSHED NICKEL (BN)	
BRUSHED GOLD (BG)	
MATTE BLACK (BL)	
MODEL: T393 Tub Faucet / 4796 Valve	
Lot# PV - 2 Date: March 18 , 2021	Room: Master Ensuite
Signature: Ahrahed	
Signature: (att) the d	



MOEN - RIZON

Single-Handle Lav Faucet with Lift Rod Drain



CHROME - STANDAR	D	
BRUSHED NICKEL (B	N)	
MATTE BLACK (BL)		
MODEL: 6900 Lav Faucet with	Drain	
Lot# PV-2	ate: March 18, 2021	Room: Ensuite 2, Ensuite 4
Signature:	ed	
Signature:	ne d	



MOEN - RIZON

Eco-Performance Posi-Temp Tub/Shower Faucet



CHROME	From WALL
BRUSHED NICKEL (BN)	from CEILING
MATTE BLACK (BL)	
MODEL: T2813EP Tub/Shower Trim / 62320 1/2" CC Valve /	/ 116651 (BN, WR) Shower Arm (from Ceiling)
Lot# PV-2 Date: Harch 18, 2021	Room: Ensulte 2
Signature: adache d	
Signature: Cathache d	



MOEN - RIZON

Eco-Performance Posi-Temp SHOWER-ONLY*




CHROME - STANDARD	from WALL
BRUSHED NICKEL (BN)	from CEILING
MATTE BLACK (BL)	
MODEL: T2812EP Shower ONLY* Trim / 2520 1/2" CC Valve	e / 116651 (BN, WR) Shower Arm (from Ceiling)
Lot# PV-2 Date: March 18, 2021	Room: Ensure 4
Signature:	
Signature:	



MT6X6

Shower Door Handle + HingeS

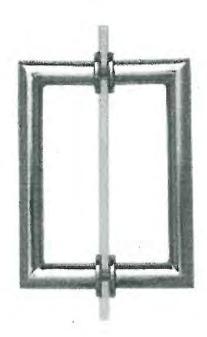

MT6X6 Shower Door Handle


6" x 6" back-to-back 3/4" dia. tube Cut and mitred corners with washers (Also available single sided)

CHROME
MATTE BLACK - Ensuite 4
BRUSHED GOLD - Master Ensuite

Lot# PV-2	Date: March 18 , 2021	Room: Master Ensuite, Ensuite 4
Signature:	hiche d	
Signature:	ached	





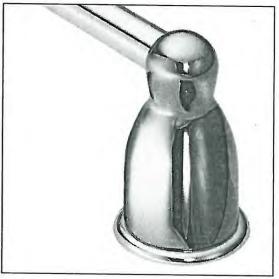

Tissue Holder Mason - Chrome

Towel Bar Mason - Chrome

Please select one of the following:

	INSTALL STANDARD BATHROOM ACCESSORIES THRU OUT (tissue holder + towel bar) *location as per vendors discretion*	
	* DO NOT * INSTALL STANDARD BATHROOM ACCESSORIES THRU OUT *tissue holder + towel bar will not be provided*	ř.
LOT #	PV-2 DATE: March 18., 2021	
SIGNA	ATURE: attached	
SIGNA	ATURE: Wached	



Project: Pine Valley Lot: 2	
Purchaser(s): Josette, Kaye J. Holness & Jacqueline, Holness	
Standard Hood Fan Deletion	
We acknowledge that the builder's standard hood fan will not be installed. Do not supply, install and/or credit. We will install our own hood fan after closir	ng.
Signature:	
Signature: At a de d	
Date: March 18, 2021	



Range Hood - Mitred Square



Lot# PV - 2		1	
Room: Kitchen	Signature: attached		
Date: March 18, 2021	Signature: (a) a ched		1



STONE COUNTERTOP EDGE PROFILES

	STANDARD 2CM EASED FDGE	*THRU-OUT *
	UPGRADE 3CM EASED EDGE	LOCATION: + Kitchen
	UPGRADE 4CM MITRED EDGE	LOCATION:
	UPGRADE 2CM OGEE EDGE	LOCATION:
	DATE: Hoveh 18, 202	
PV-2	Harry W	

K002-02	K002-03	Коо2-04
K002-06	K002-05 Hudroom + Laundry Hensuite 2 Hensuite 3 Hensuite 4	K002-14
К024-03	*NO HARDWARE	
LOT # PV - 2 DATE: L	leach 18, 2021	

GOLDPARK

		TANTAGRIIN
H001-02	H001-03	H001-04
Ноо9-03	Ноо9-09	
H011-03	H011-05	H011-06
H033-01	H039-03 → Ensuite 5	*NO HARDWARE
DATE: Har GIGNATURE: GIGNAT	ch 18,2021	
	 	GOLDPARK



BH-052-09

Pull - 'Brushed Gold'



LOCATION:	
+klaster Ensuite + Kitchen	


LOT# PV-2	DATE: March 18,12021	
SIGNATURE:	latines	****
SIGNATURE:	OAKO)	

GOLDPARK



MOEN - MODERN

Pot Filler

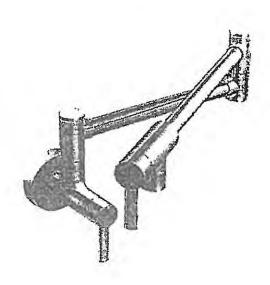

CHROME			
-STAINLESS	(5RS)—		
BRUSHED G	OLD (8G)		
MATTE BLA	CK (Br)		
MODEL: SEES (SRS, E	3G, BL) Pot Filler		
	REVISED		
	March 18, 2011		
Lot# PV-2	Date: Decombor, 7, 2020	Room: Kitcheul	
Signature:	ANO DAR		
Signature:) melmess		
0	J		COLDA


GOLDP . 3K



GOLDPARK

MOEN - NIO


One-Handle Pulldown Kitchen Faucet

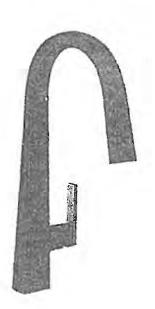


СНКОМ	E		
MATTE !	BLACK / BRUSHED GOLD (BL)		
SPOT RE	SIST STAINLESS (SRS)		
ODEL: \$75005 Chro	me / \$750058L Matte Black / \$750055R.	S Shot Resist Stainless	
		- abov wome profitted?	
ot# PV-2	Date:	Room:	
1 / 2	Date: Worth 18, 2021	Room: Kitchen	:
Signature:	Atol ness		W. 17
ilgnature:	1001/)	
	1 1 1		



BLANCO - QUATRUS R15 U SUPER SINGLE Stainless Steel - Undermount 32" x 18" x 9"

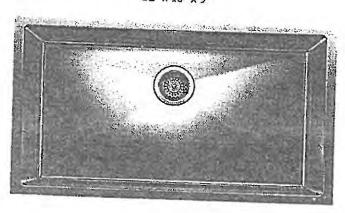

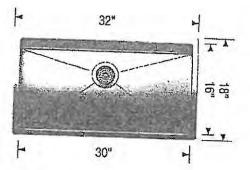

Stainless Steel

MODEL 401518 Stainless Steel


Room: Kitchen	Signature: April 1765
Date: Harch 18, 2021	Signature:



GOLDPARK

MOEN - MODERN

Soap/Lotion Dispenser

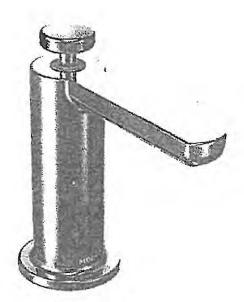


CHROME		
STAINLESS		
BRUSHED GOLD		
MATTE BLACK		
100EL S3947C Chrome /	S3947SRS Stainless / S3947BG B	rushed Gold / S3947BL Matte Black
100EL S3917C Chrome /		
	S3947SRS Stainless / S3947BG B ROOM: Kitchen	DATE: Harch 18, 2021



MOEN - NIO


One-Handle Bar Faucet

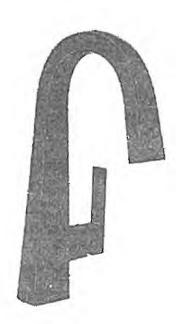

CHROME MATTE BLACK / BRUSHED GOLD (BL)	
STAINLESS (SRS)	
	-
MODEL: 555005 Chrome / S55005BL Matte Black / S55005SRS	Spot Resist Stainless
Lot# PV -) Date:	Room: C
PV- 2 Harch 18, 2021	Servery
Signature: Akolnes	
Signature:	
).
1 /	GOLDPAR



BLANCO - QUATRUS R15 U BAR Stainless Steel - Undermount 17" x 17" x 8"

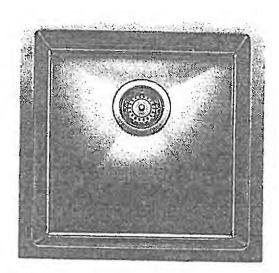

Stainless Steel

MODEL 401515 Stainless Steel

Room: C	Signature:
Room: Servery	Spolnes
Date: Much 18, 2021	Signature:



EMERY RECTANGULAR UNDERMOUNT SINK

ET 4720CGY Undermount Sink, Soft White ED 4720CGY-088 Undermount Sink, Sidte Grey

PRODUCT SPECS:
- Vitreous china

COMPLIANCE CERTIFICATIONS Meets or exceeds the following:
- MFMO CLIPC
- ASME ANZID 2/CSA BASI

- Virseut china
- Front overflow hole
- Bix* Bowl depth
- Template and mounting han
supplied


DIMENSIONS:


SHIPPING Cube 1.85 GW 20 lbs


Outer, 545mm D x 210mm H 210m W x 355mm D x 210mm H 210m W x 34 D x 85 H Imaer; 495mm W x 305mm D x 160mm H 1937 W x 12 D x 65 m h



910

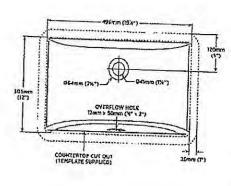

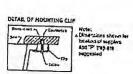

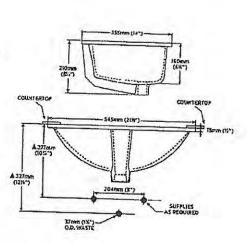


Lot# PY-2	Date: Hach 18,2021	Room: Ponder Room	
Signature;	Halve.		
Signature:	3/1/		

GOLD ...



MOEN - ALIGN

Two-Handle Adjustable Widespread Lav Faucet with Lift Rod Drain

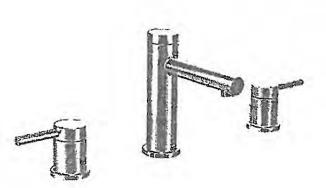


CHROME	
BRUSHED NICKEL (BN)	
MATTE BLACK (BL)	
BRUSHED GOLD (BG)	
MODEL: T6193 Lav Faucet / 69000 Valve	
Lot# YV-2 Date: March 18, 2021	Room: Master Ensuite x2
	J MIGG CHARLE XL
Signature: Atol ness	
Signature:	



MOEN - AUGN

Two-Handle Roman Tub Faucet

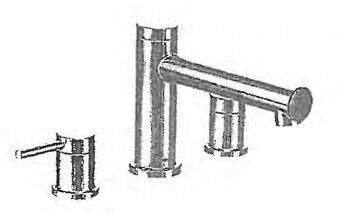


CHROME	
BRUSHED NICKEL (BN)	
ERUSHED GOLD (BG)	
MATTE BLACK (BL)	
MODEL: T393 Tub Faucet / 4796 Valve	
Lot# PV-2 Date: Narch 18, 1021	Room: Master Enswite
Signature: Alphos	
Signature:	
	GOLDPARK



MOEN - RIZON

Single-Handle Lav Faucet with Lift Rod Drain

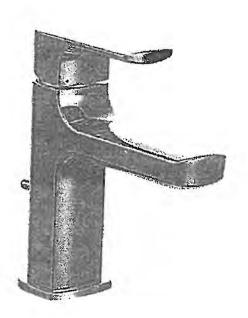

CHROME - STANDARD	
BRUSHED NICKEL (BN)	
MATTE BLACK (BL)	
MODEL: 6900 Lav Faucet with Drain	
Lot# PV-2 Date: Harch 18, 2021	Room: Ensulte 2, Ensuite 4
Signature: Atoliness	
Signature:	
	COLDSYSK



MOEN - RIZON

Eco-Performance Posi-Temp Tub/Shower Faucet



CHROME	From WALL
BRUSHED NICKEL (BN)	from CEILING
MATTE BLACK (BL)	
MODEL: Y2813EP Tub/Shower Trim / 62320 1/2"	CC Valve / 116651 (BN, WR) Shower Arm (from Ceiling)
Lot# PV-2 Date: Harch 18	, 2021 Room: Ensulte 2
Signature: Holnes	
Signature:	
	GOLDPARK



MOEN - RIZON

Eco-Performance Posi-Temp SHOWER-ONLY*




CHROME - STANDARD	from WALL
BRUSHED NICKEL (BN)	from CEILING
MATTE BLACK (BL)	
MODEL: T2812EP Shower ONLY! Trim / 2520	0 1/2" CC Valve / 116651 (BN, WR) Shower Arm (from Celling)
Lot# PV-2 Date: March 1	18,2021 Room: Ensuite 4
Signature: (Alomos	
Signature:	
000	COLDRAD



MT6X6

Shower Door Handle + Hinges

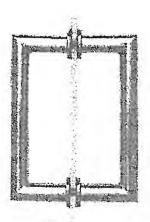

MT6X6 Shower Door Handle

6" x 6" back-to-back 3/4" dia, tube Cut and mitred corners with washers (Also available single sided)

CHROME


MATTEBLACK & Ensuite 4

BRUSHED GOLD - Marter Frishte

Lot# PV-2	Date: Harch 18 , 2021	Room: Haster Ensuite, Ensuite 4
Signature:	Aplness	
Signature:	()	
	7700	

GOLDPARK



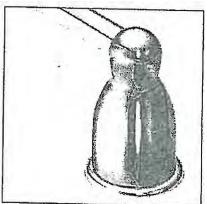

Tissue Holder Mason - Chrome

Towel Bar Mason - Chrome

Please select one of the following:

Ц	(tissue holder	+ towel I	oar) *Iocatio	ACCESSORIES on as per venu	THRU OUT fors discretion*	
,	/					
V	*DO NOT* THRU OUT *b	INSTALL	STANDARD + towel bar	BATHROOM will not be pro	ACCESSORIES	

LOT # PV-2	DATE: plevich 18, 2021	
SIGNATURE:	Hdnos	
SIGNATURE:	AND.	
	7412	

GOLDPARK



Project: Pine Valley

Lot: 2

Purchaser(s): Josette, Kaye J. Holciess & Jacqueline, Holness

Standard Hood Fan Deletion

We acknowledge that the builder's standard hood fan will not be installed. Do not supply, install and/or credit. We will install our own hood fan after closing.


Signature: (A)/

Claundures

Date: March 18 , 2021



Range Hood - Mitred Square

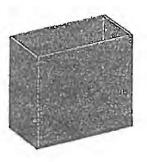


Room: Kitchen	Signature:
Date: March 18, 2021	Signature:



- A. 273/4" (70.5 cm) depth with control panel (See NOTE.)
- B. 36" (91.4 cm) range height when sitting on the wheels
- C. 351/8" (91.1 cm) width
- D. Model/serial/rating plate location/SAID label (located on front side panel)

48" (121.9 cm) models

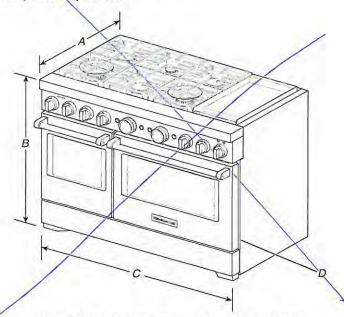


- A. 273/4" (70.5 cm) depth with control panel (See NOTE.)
- B. 36" (91.4 cm) range height when sitting on the wheels
- C. 471/8" (121.6 cm) width
- D. Model/serial/rating plate location/SAID label (located on front side panel)

NOTE: When installed in a 24" (61.0 cm) base cabinet with 25" (63.5 cm) countertop; front of oven door protrudes 3" (7.6 cm) beyond 24" (61.0 cm) base cabinet.

Cabinet Requirements

Cabinet opening dimensions shown are for 25" (64.0 cm) countertop depth, 24" (61.0 cm) base cabinet depth, and 36" (91.4 cm) countertop height. Dimensions must be met in order to ensure a flush fit to back wall.

IMPORTANT: If installing a range hood, hood liner, or microwave hood combination above the cooking surface, follow the range hood or microwave hood combination installation instructions for dimensional clearances above the cooking surface.

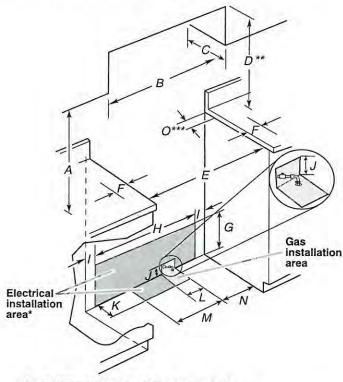

- A. 18" (45.7 cm) upper cabinet to countertop
- B. 30" (76.2 cm) model: 30" (76.2 cm) min. upper cabinet width 36" (91.4 cm) model: 36" (91.4 cm) min. upper cabinet width 48" (121.9 cm) model: 48" (121.9 cm) min. upper cabinet width
- C. 13" (33 cm) max. upper cabinet depth
- D. For minimum clearance to top of range.**
- E. 30" (76.2 cm) on 30" (76.2 cm) models 36" (91.4 cm) on 36" (91.4 cm) models 48" (121.9 cm) on 48" (121.9 cm) models
- F. 12" (30.4 cm) min. clearance from both sides of range to side wall or other combustible material
- G. 15" (38.1 cm)
- H. 22" (55.9 cm) on 30" (76.2 cm) models 28" (71.1 cm) on 36" (91.4 cm) models 40" (101.6 cm) on 48" (121.9 cm) models
- 1. 4" (10.1 cm)
- J. 3" (7.6 cm)
- K. 5" (12.7 cm)
- L. 6" (15.2 cm) on 30" (76.2 cm) models 12" (30.5 cm) on 36" (91.4 cm) models 24" (61.0 cm) on 48" (121.9 cm) models
- M. 101/2" (26.7 cm)
- N. 9" (22.9 cm)
- O. 6" (15.2 cm)***

** If not using ventilation, Minimum Clearances

30" (76.2 cm) models: 42" (106.7 cm) minimum clearance between the top of the cooking platform and the bottom of a combustible surface

36" (91.4 cm) models: 58" (147.3 cm) minimum clearance between the top of the cooking platform and the bottom of a combustible surface

48" (121.9 cm) models: 58" (147.3 cm) minimum clearance between the top of the cooking platform and the bottom of a combustible surface

***If the surface of the back wall is constructed of a combustible material and a backguard is not installed, a 6" (15.2 cm) minimum clearance is required for all models.

Parts Supplied

Check that all parts are included.

Anti-tip bracket kit



A. Anti-tip bracket

B. #8-18 x 1" (2.5 cm) Phillips head screws (4)

NOTE: Anti-tip bracket must be securely mounted to subfloor. Thickness of flooring may require longer screws to anchor bracket to subfloor. Longer screws are available from your local hardware store. See the "Install Anti-Tip Bracket" section.

- Burner grates
- Burner caps
- Griddle drip tray (on griddle models)

Parts Needed

All models must be installed with a backguard if installing at zero clearance to a combustible back wall surface such as drywall. See "Cabinet Dimensions" in the "Location Requirements" section for installation requirements.

Check local codes and consult gas supplier. Check existing gas supply and electrical supply. See the "Electrical Requirements" and "Gas Supply Requirements" sections.

It is recommended that all electrical connections be made by a licensed, qualified electrical installer.

Location Requirements

IMPORTANT: Observe all governing codes and ordinances. Do not obstruct flow of combustion and ventilation air.

- It is the installer's responsibility to comply with installation clearances specified on the model/serial/rating plate. The model/serial/rating plate is located under the console on the right-hand side.
- It is recommended that a 585 CFM (993.9 m³/hr) or larger range hood be installed above the range.
- Follow the range hood or microwave hood combination installation instructions for dimensional clearances above the cooktop surface.
- Recessed installations must provide complete enclosure of the sides and rear of the range.
- All openings in the wall or floor where range is to be installed must be sealed.
- Do not seal the range to the side cabinets.
- Cabinet opening dimensions that are shown must be used.
 Given dimensions are minimum clearances.
- The anti-tip bracket must be installed. To install the anti-tip bracket shipped with the range, see the "Install Anti-Tip Bracket" section.
- Grounded electrical supply is required. See the "Electrical Requirements" section.
- Proper gas supply connection must be available. See the "Gas Supply Requirements" section.
- Contact a qualified floor covering installer to check that the floor covering can withstand at least 200°F (93°C). Use an insulated pad or 1/4" (6.4 mm) plywood over carpet and under range if installing range over carpeting.

IMPORTANT: To avoid damage to your cabinets, check with your builder or cabinet supplier to make sure that the materials used will not discolor, delaminate, or sustain other damage. This oven has been designed in accordance with the requirements of UL and CSA International and complies with the maximum allowable wood cabinet temperatures of 194°F (90°C).

Mobile Home - Additional Installation Requirements

The installation of this range must conform to the Manufactured Home Construction and Safety Standard, Title 24 CFR, Part 3280 (formerly the Federal Standard for Mobile Home Construction and Safety, Title 24, HUD Part 280). When such standard is not applicable, use the Standard for Manufactured Home Installations, ANSI A225.1/NFPA 501A or local codes.

In Canada, the installation of this range must conform with the current standards CAN/CSA-A240-latest edition or with local codes.


Mobile Home Installations Require:

When this range is installed in a mobile home, it must be secured to the floor during transit. Any method of securing the range is adequate as long as it conforms to the standards listed above.


Product Dimensions

NOTE: Cooktop features may differ.

30" (76.2 cm) models

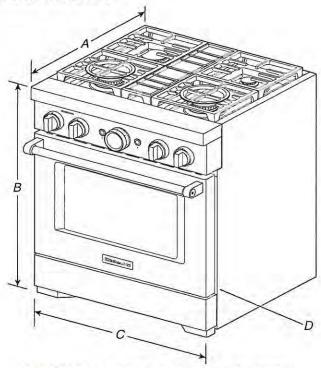

- A. 273/4" (70.5 cm) depth with control panel (See NOTE.)
- B. 36" (91.4 cm) range height when sitting on the wheels
- C. 297/8 " (75.7 cm) width
- D. Model/serial/rating plate location/SAID label (located on front side panel)

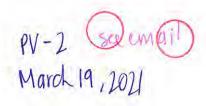

KitchenAid® 27" (68.6 cm) and 30" (76.2 cm) Electric Built-In Microwave/Oven Combination

PRODUCT MODEL NUMBERS

KEMS309E

KOCE500E

KOCE507E

ELECTRICAL CONNECTION

If codes permit and a separate ground wire is used, it is recommended that a qualified electrical installer determine that the ground path and the wire gauge are in accordance with local codes.


Check with a qualified electrical installer if you are not sure the oven is properly grounded.

This oven must be connected to a grounded metal, permanent wiring system.

Be sure that the electrical connection and wire size are adequate and in conformance with the National Electrical Code, ANSI/NFPA 70-latest edition or CSA Standards C22.1-94, Canadian Electrical Code, Part 1 and C22.2 No. O-M91-latest edition, and all local codes and ordinances.

To properly install your oven, you must determine the type of electrical connection you will be using and follow the instructions provided for it here.

 Oven must be connected to the proper electrical voltage and frequency as specified on the model/serial/rating plate. See the following illustration.

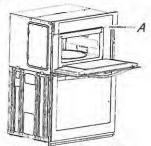

A. Model/serial/rating plate

- Models rated from 7.3 to 9.6 kW at 240 volts (5.4 to 7.4 kW at 208 volts) require a separate 40-amp circuit. Models rated at 4.8 kW and below at 240 volts (3.6 kW and below at 208 volts) require a separate 30-amp circuit.
- · A circuit breaker is recommended.
- Connect directly to the fused disconnect (or circuit breaker box) through flexible, armored or nonmetallic sheathed, copper cable (with grounding wire). See "Make Electrical Connection" section.
- · Flexible conduit from the oven should be connected directly to the junction box.
- . Do not cut the conduit. The length of conduit provided is for serviceability of the oven.
- A UL listed or CSA approved conduit connector must be provided.
- · If the house has aluminum wiring, follow the procedure below:
 - 1. Connect a section of solid copper wire to the pigtail leads.
 - 2. Connect the aluminum wiring to the added section of copper wire using special connectors and/or tools designed and UL listed for joining copper to aluminum.


Follow the electrical connector manufacturer's recommended procedure. Aluminum/copper connection must conform with local codes and industry accepted wiring practices.

For power requirements, refer to the following table.

Model	Voltage	Amperage (L1)*	Amperage (L2)*	Rating (W)
KOCE507E/KOCE500E	120/240	32	30	8000
KOCE507E/KOCE500E	120/208	30	28	6600

*Amperage values noted above are for information purposes only: the units are rated in watts.

PRODUCT DIMENSIONS

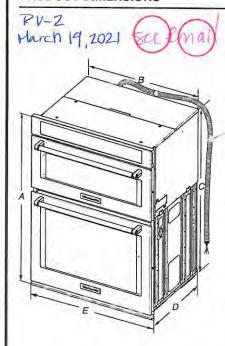


27" (68.6 cm) models

- A. 42% (108.0 cm) overall height
- B. 251/16" (64.6 cm) recessed
- C. 41" (104.1 cm) recessed height
- D. 231/4" (59.1 cm) max. recessed depth
- E. 27" (68.6 cm) overall width
- F. 48" (121.9 cm) flexible conduit length measured from the conduit clamp located at the rear of the oven. Do not remove the conduit clamp.

30" (76.2 cm) models

- A. 429/16" (108.0 cm) overall height
- B. 281/16" (72.3 cm) recessed width
- C. 41" (104.1 cm) recessed height
- D. 231/4" (59.1 cm) max. recessed depth
- E. 30" (76.2 cm) overall width
- F. 48" (121.9 cm) flexible conduit length measured from the conduit clamp located at the rear of the oven. Do not remove the conduit clamp.

Cabinet Dimensions

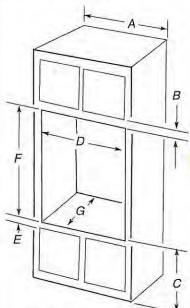

27" (68.6 cm) models

- A. 27" (68.6 cm) min. cabinet width
- B. 1" (2.5 cm) top of cutout to bottom of upper cabinet door
- C. 191/4" (48.9 cm) bottom of cutout to floor is recommended. 4"-191/4" (10.2-48.9 cm) bottom of cutout to floor is acceptable.
- D. 251/2" (64.8 cm) cutout width E. 11/2" (3.8 cm) min. bottom of
- cutout to top of cabinet door 415/16" (105 cm)* recommended
- cutout height
- G. 24" (60.7 cm) cutout depth 30" (76.2 cm) models
- A. 30" (76.2 cm) min. cabinet width
- B. 1" (2.5 cm) top of cutout to bottom
- C. 191/4" (48.9 cm) bottom of cutout to floor is recommended. 4"-191/4" (10.2-48.9 cm) bottom of cutout to floor is acceptable.
- D. 281/2" (72,4 cm) cutout width
- E. 11/2" (3.8 cm) min. bottom of cutout
- F. 415/16" (105 cm)* recommended cutout
- G. 24" (60.7 cm) cutout depth
- NOTE: The cabinet height can be between 41" (104.1 cm) and 411/2" (105.6 cm) for microwave/oven combination.


KBSD606E

KBSD618E

PRODUCT MODEL NUMBERS

To avoid tipping during use, the solid soffit must be within 1" (2.5 cm) maximum above the refrigerator. If the solid soffit is higher than 1" (2.5 cm) or one is not available, then the refrigerator must be braced. If the anti-tip boards are needed, they must be attached to the rear wall studs 80" to 90" (203 cm to 229 cm) above the floor. See "Install Anti-Tip Boards" for more information.

NOTE: A clearance of 1/2" (1.3 cm) above the top grille must be maintained in order for the top grille to be removed.

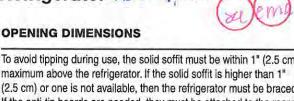

Water Pressure: A cold water supply with water pressure between 30 and 120 psi (207 and 827 kPa) is required to operate the water dispenser and ice maker. If you have questions about your water pressure, call a licensed, qualified plumber.

Electrical: A 115 volt, 60 Hz., AC only, 15- or 20-amp fused, grounded electrical supply

KBSD608E

is required. It is recommended that a separate circuit serving only your refrigerator

be provided. Use an outlet that cannot be turned off by a switch. Do not use an

KBSN602E

KBSN608E

Reverse Osmosis Water Supply:

IMPORTANT: The pressure of the water supply coming out of a reverse osmosis system gwoing to the water inlet valve of the refrigerator needs to be between 30 and 120 psi (207 and 827 kPa).

IMPORTANT:

KBSD602E

KBSD612E


extension cord.


- It is recommended that you do not install the refrigerator near an oven, radiator, or other heat source.
- Do not install in a location where the temperature will fall below 55°F (13°C).
- Floor must support the refrigerator weight, more than 600 lbs (272 kg), door panels and contents of the refrigerator.

PRODUCT DIMENSIONS

- The depth from the front of the top grille to the back of the refrigerator cabinet is 53/8" (64.5 cm).
- The power cord is 84" (213 cm) long.
- Height dimensions are shown with leveling legs extended 1/8" (3 mm) below the rollers.


SIDE VIEW

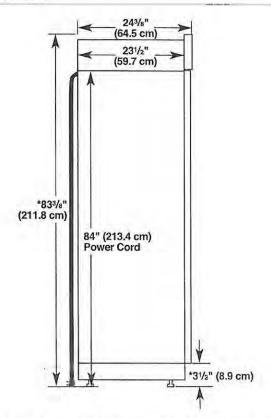

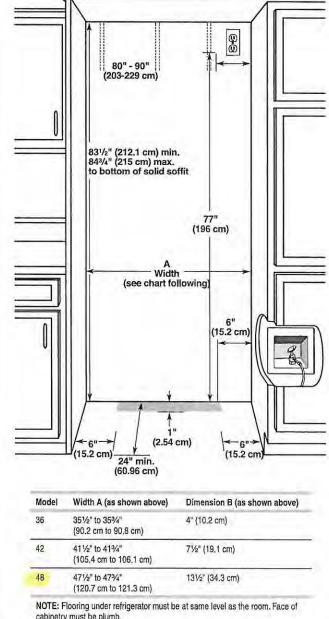

cabinetry must be plumb.

TOP VIEW

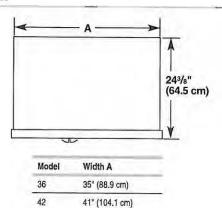


47" (119.4 cm)

FRONT VIEW

- Width dimensions were measured from trim edge to trim edge.
- Height dimensions are shown with leveling legs extended 1/8" (3 mm) below the rollers.

48

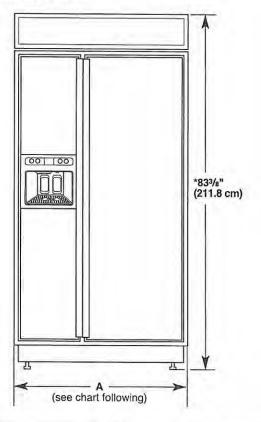

Model	Width A (Trim edge to trim edge)
36	36 ¹¹ / ₃₂ " (92.3 cm)
42	42 ¹ / ₃₂ " (107.5 cm)
48	48 ¹ / ₃₂ " (122.8 cm)

*When leveling legs are fully extended to 11/4" (3.2 cm) below rollers, add 11/6" (2.9 cm) to the height dimensions.

PV-2 March 19, 2021 (Ste) & (Ma)


DOOR SWING DIMENSIONS

The location must permit both doors to open to a minimum of 90°. Allow 5" (12.7 cm) minimum space between the side of the refrigerator and a corner wall.


NOTE: More clearance may be required if you are using overlay panels, custom handles, or extended handles on a Classic model.

To adjust the door swings, see "Adjust Doors."


36" (91.4 cm) Models

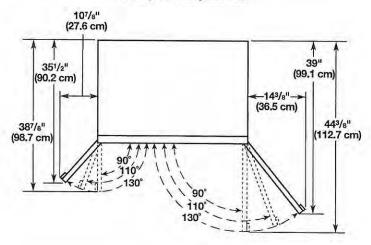

42" (106.7 cm) Models

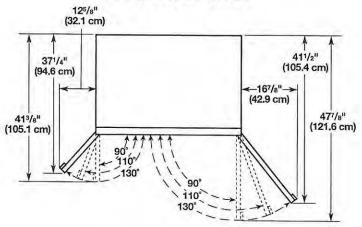

48" (121.9 cm) Models

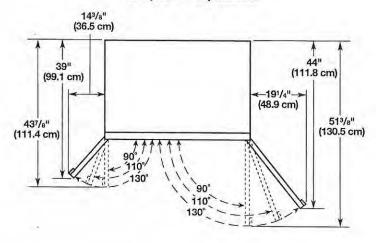

GWS04HAE

PV-2 Harth 19, 2021 (Styleny)

GE® Wine Center

FEATURES AND BENEFITS

Upfront electronic controls

30 bottle capacity

5 wine racks


Glass door with stainless steel trim

Interior lighting

Stainless steel handle

Free-standing or built-in capable

Model GWS04HAE - Stainless steel

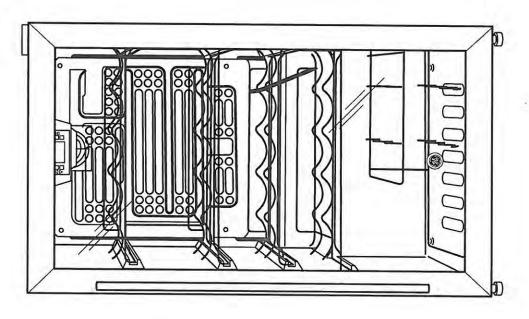



GE® Wine Center


DIMENSIONS AND INSTALLATION INFORMATION (IN INCHES)



7v-2 Hurch 19,2021

Front View

8

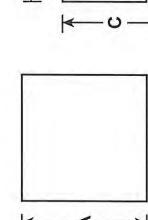

Height (III.) A	00	
Width (in.) B	19	*
Depth with handle (in.) C	22 1/2	
Depth with door open 90° (in.) D	38 5/8	
Each side (in.)	0	
Top (in.)	0	
Back (in.)	0	

Clearances лiА

Height (in.) A Width (in.) B


Overall Dimensions



KitchenAid[®]


* 24" Dishwasher DETAILED PLANNING DIMENSIONS GUIDE

Applies to all model numbers starting with; KDFE104K, KDFE204K, KDTE204K, KDTE204LPA, KDFM404K, KDTM404K, KDPM604K, KDTM604K, KDPM704K, KDTM704K, KDTM704LPA, KDPM804K, KDTM804K

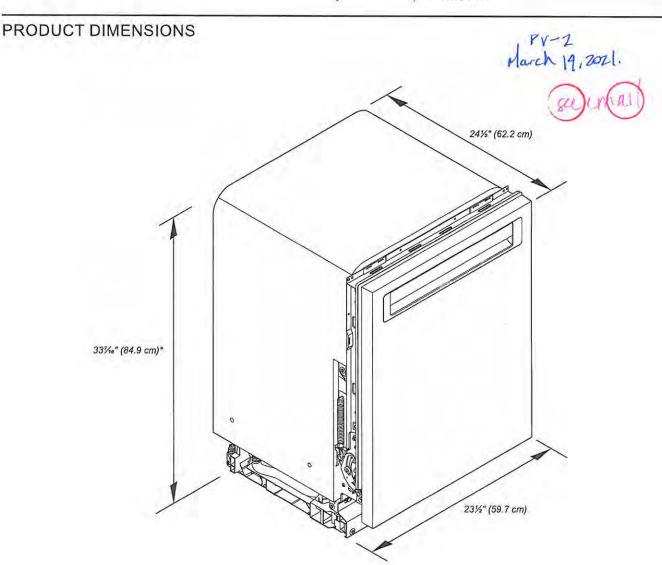


^{*}Dishwasher can be raised 17/16" (3.7 cm) with feet fully extended.



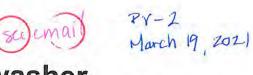

KitchenAid * 24" Dishwasher **DETAILED PLANNING DIMENSIONS GUIDE**

PRODUCT DIMENSIONS (CONTD.)

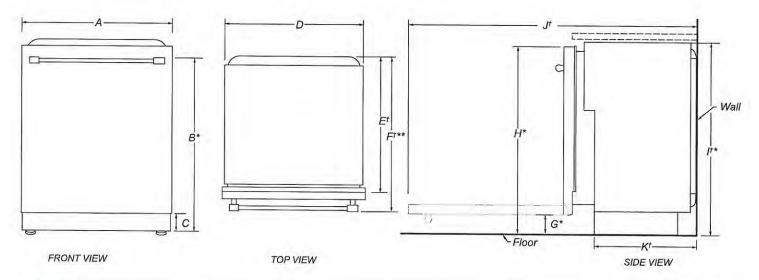

	DESCRIPTION	DIMENSIONS
Α	Width of door	23½" (59.7 cm)
B*	Height to top of handle	30 ¹³ / ₁₆ " (78.3 cm)
С	Height of adjustable toe kick	3⁵⁄₁₅" (8.4 cm) - min. 4¹¹∕₁₅" (11.8 cm) - max.
D	Width of recessed dishwasher	225/s" (57.4 cm)
E [†]	Depth without door	225/4" (57.5 cm)
	Depth with Towel Bar Handle	26½" (68.3 cm)
F1**	Depth with Pocket Handle	24½" (62.6 cm)
	Depth of Panel-Ready Models	24" (61.0 cm)
G*	Height to bottom of door (min.)	35/16" (8.4 cm)
H*	Height to top of door (min.)	33½s" (84.9 cm)
1+*	Height of recessed dishwasher (min.)	33%" (85.4 cm)
Jt	Depth with door fully open (min.)	50%e" (127.4 cm)
K ²	Depth with toe kick (min.)	20 ¹³ / ₁₆ " (52.9 cm)

[†]Insulation blanket thickness adds up to 11/16" (1.8 cm) but can crush up to 1/8" (0.3 cm).

^{*}Dishwasher can be raised 11/16" (3.7 cm) with feet fully extended.

^{**}For panel-ready models, dishwasher depth is 24" (61.0 cm), not including the 3/4" (1.9 cm) custom door panel.




KitchenAid® *24"

DETAILED PLANNING DIMENSIONS GUIDE

OPENING/CLEARANCE DIMENSIONS

IMPORTANT: Check that all surfaces have no protrusions that would prohibit dishwasher installation.

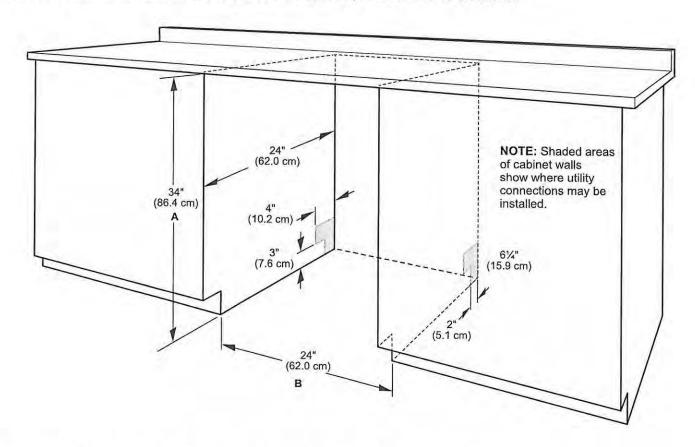

- A. Measured from the lowest point on the underside of the countertop. May be reduced to 33½" (85.1 cm) by removing the wheels and perforated area of insulation (blanket) on dishwasher.
- B. Minimum, measured from narrowest point of opening.

NOTE: Corner locations require a 2" (5.1 cm) minimum clearance between the side of the dishwasher door and the wall or cabinet.

Yolande Somerville

From: Jay Holness < j.holness21@gmail.com>

Sent: March 19, 2021 1:13 PM
To: Yolande Somerville
Cc: Josette Holness

Subject: Re: PV-2 Final Colours Order Revision

Please see below

Microwave and wall oven combo

https://www.canadianappliance.ca/product/KitchenAid KOCE500EBS Microwave Wall Ovens KitchenAid KOCE500EB S.html

Stove

https://www.canadianappliance.ca/product/KitchenAid KFDC506JBK Range KitchenAid KFDC506JBK.html

Fridge

https://www.canadianappliance.ca/product/KitchenAid KBSD618ESS Built In Refrigerators KitchenAid KBSD618ESS.html

Dishwasher

https://www.canadianappliance.ca/product/KitchenAid KDPM604KPS Built-

In Undercounter Dishwashers KitchenAid KDPM604KPS.html

Wine Fridge

https://www.canadianappliance.ca/product/GE GWS04HAESS Under Counter Wine Refrigeration GE GWS04HAESS. html

J.Holness