

Lot: 152

Model: 40.02 A VALLEYVIEW

Project/Phase: Pine Valley Forevergreen / 1

٨	PP	TT	AN	FC
↤		/	\vdash	 '''

Invoice	Qty.	Description
2439	1	KITCHEN - UPGRADE TO 8" DUCT (EXTERIOR WALL) IN LIEU OF STANDARD OFFERING
72,217		
23Oct20 **		
2653	1	APPLIANCE SPECIFICATIONS ATTACHED - SIGNED COPY
07Apr21 NoCat		

BASEMENT WINDOWS

Invoice	Qty.	Description
2439	4	BASEMENT WINDOWS - UPGRADE BASEMENT WINDOW SIZE TO 30 " X 24" - 8" FRAME
72,351		
23Oct20		

CERAM	CERAMIC				
Invoice	Qty.	Description			
2653 37 07Apr21	1	FOYER: TILE, FLOOR - LEVEL 5 - 24X24" LAID IN STRAIGHT, STACKED PATTERN.			
2653 37 07Apr21	1	POWDER ROOM: TILE, FLOOR - LEVEL 5 - 24X24" LAID IN STRAIGHT, STACKED PATTERN			
2653 37 07Apr21	1	MASTER ENSUITE: TILE, FLOOR - LEVEL 5 - 24X24" LAID IN STRAIGHT, STACKED PATTERN			
2653 48 07Apr21	1	MASTER ENSUITE: TILE, WALL, LEVEL 2 - 4X12" LAID IN HORIZONTAL, STACKED PATTERN			
2653 45 07Apr21	1	MASTER ENSUITE: TILE, SHOWER FLOOR, LEVEL 4 - HEX			
2653 35 07Apr21	1	ENSUITE 2: TILE, FLOOR, LEVEL 3 - 12X24" LAID IN STRAIGHT, STACKED PATTERN. SEE PLAN FOR TILE DIRECTION			
2653 36 07Apr21	1	SHARED ENSUITE: TILE, FLOOR, LEVEL 4 - 12X24" LAID IN STRAIGHT, STACKED PATTERN. SEE PLAN FOR TILE DIRECTION			
2653 32 07Apr21	1	BASEMENT FOYER: TILE, FLOOR, LEVEL 1 - 12X24" LAID IN STRAIGHT, STACKED PATTERN. SEE PLAN FOR TILE DIRECTION			
2653 43 07Apr21	1	SHARED ENSUITE: TILE, SHOWER FLOOR, LEVEL 2 - 2x2"			

DisciplineMS.rpt 23feb21 Page 1 of 7



Lot: 152

Model: 40.02 A VALLEYVIEW

Project/Phase: Pine Valley Forevergreen / 1

CERAMIC

Invoice	Qty.	Description
2653	-	KITCHEN: VINTAGE SERIES, 5" RED OAK, NSS ENGINEERED HARDWOOD, 3/4" THK, SCULPTED TEXTURE, UVF FINISH - LEVEL 4
07Apr21 NoCat		DO NOT SUPPLY / INSTALL CERAMIC TILE (CREDIT)

D	D	71	X/	٨	T	1	Γ
.,	ĸ	Y 1	vv	\boldsymbol{A}		,	

DRIWA		
Invoice	Qty.	Description
2439 72,351 23Oct20 **	4	BASEMENT WINDOWS - UPGRADE BASEMENT WINDOW SIZE TO 30 " X 24" - 8" FRAME

DisciplineMS.rpt 23feb21 Page 2 of 7



Lot: 152

Model: 40.02 A VALLEYVIEW

Project/Phase: Pine Valley Forevergreen / 1

ELECTRICAL

ELECT		
Invoice	Qty.	Description
2439 72,351 23Oct20 **	4	BASEMENT WINDOWS - UPGRADE BASEMENT WINDOW SIZE TO 30 " X 24" - 8" FRAME
2439 72,289 23Oct20	6	KITCHEN: 4" E/S LED INTERIOR POT LIGHT - GROUND FLOOR - EACH - INCLUDES 1 SWITCH INCLUDED IN APS
2439 72,289 23Oct20	4	DINING ROOM: 4" E/S LED INTERIOR POT LIGHT - GROUND FLOOR - EACH
2439 72,278 23Oct20	1	DINING ROOM: ADDITIONAL INTERIOR SWITCH FOR POTLIGHTS
2439 72,289 23Oct20	6	GREAT ROOM: 4" E/S LED INTERIOR POT LIGHT - GROUND FLOOR - EACH
2439 72,278 23Oct20	1	GREAT ROOM: ADDITIONAL INTERIOR SWITCH FOR POTLIGHTS
2439 72,303 23Oct20	1	KITCHEN: FIXTURE: UNDER CABINET FLUORESCENT LIGHT FIXTURES - DOES NOT INCLUDE (AND REQUIRES) LIGHT VALANCE
2439 72,272 23Oct20	1	KITCHEN: 110V WALL RECEPTACLE ON SEPARATE CIRCUIT - FOR FREEZER - APPLIANCE NOT INCLUDED
2439 72,275 23Oct20	1	KITCHEN: 240V WALL RECEPTACLE ON SEPARATE CIRCUIT FOR WALL OVEN
2439 72,666 23Oct20	1	KITCHEN: 50AMP FOR INDUCTION RANGE AND/OR COOKTOP
2439 72,272 23Oct20	1	KITCHEN: 110V WALL RECEPTACLE ON SEPARATE CIRCUIT - FOR WINE FRIDGE- APPLIANCE NOT INCLUDED
2439 72,289 23Oct20	3	MAIN HALL: 4" E/S LED INTERIOR POT LIGHT - GROUND FLOOR - EACH IN LIEU OF STANDARD LIGHT
2439 72,291 23Oct20	3	FRONT ELEVATION: EXTERIOR LED SOFFIT POT LIGHT - EACH 1 =- APPROX CENTER OF WINDOW IN UPPER SOFFIT 2 - ABOVE GARAGE DOORS

DisciplineMS.rpt 23feb21 Page 3 of 7



07Apr21

GRADE DOES NOT ALLOW

CONSTRUCTION SUMMARY

Lot: 152

Model: 40.02 A VALLEYVIEW

Project/Phase: Pine Valley Forevergreen / 1

ELECTI	ELECTRICAL			
Invoice	Qty.	Description		
2439 72,278 23Oct20	•	FOYER: ADDITIONAL INTERIOR SWITCH FOR SOFFIT LIGHTS		
FODMI	CODMINC			

FRAMI	FRAMING				
Invoice	Qty.	Description			
2439	-	GREAT ROOM / DINING ROOM: CREATE ARCH WAY BETWEEN DINING ROOM AND GREAT ROOM - AS LARGE AS POSSIBLE - APPROX 8' WIDE			
23Oct20					
NoCat					

GLASS.	GLASS AND MIRROR		
Invoice	Qty.	Description	
2653	2	MASTER ENSUITE + SHARED ENSUITE: UPGRADE SHOWER DOOR HANDLE	
07Apr21 NoCat			

GRANIT	RANITE MARBLE QUARTZ			
Invoice	Qty.	Description		
2653 101,930 07Apr21	1	KITCHEN: UPGRADE QUARTZ COUNTERTOP - UPGRADE 6		
2653	1	MASTER ENSUITE: UPGRADE 4 QUARTZ COUNTER TOP		
07Apr21 NoCat				

DisciplineMS.rpt 23feb21 Page 4 of 7



Lot: 152

Model: 40.02 A VALLEYVIEW

Project/Phase: Pine Valley Forevergreen / 1

HARDWOOD

Invoice	Qty.	Description
2653 7	1	KITCHEN: VINTAGE SERIES, 5" RED OAK, NSS ENGINEERED HARDWOOD, 3/4" THK, SCULPTED TEXTURE, UVF FINISH - LEVEL 4
07Apr21		DIFFERENCE IN PRICE FROM STANDARD INCLUDED IN APS
2653 101,930 07Apr21	1	THRU-OUT STANDARD AREAS: MAIN HALL/ DINING ROOM/ BREAKFAST/ GREAT ROOM/ UPPER HALL/ MASTER BEDROOM/ BEDROOM 2/ BEDROOM 3/ BEDROOM 4 - VINTAGE SERIES, 5" RED OAK, NSS ENGINEERED HARDWOOD, 3/4" THK, SCULPTED TEXTURE, UVF FINISH - LEVEL 4

HVAC

Invoice	Qty.	Description
2439	1	KITCHEN - UPGRADE TO 8" DUCT (EXTERIOR WALL) IN LIEU OF STANDARD OFFERING
72,217		
23Oct20		

INTERIOR DOORS AND TRIM

Invoice	Qty.	Description
2439	1	BASEMENT: ADDITIONAL SINGLE DOOR 800 SERIES COMPLETE WITH BUILDERS STANDARD OFFERINGS
72,638		
23Oct20		AT 3-PIECE R/IN - SEE PLAN FOR LOCATION

INTERIOR TRIM / MOULDINGS

Invoice	Qty.	Description
2439	4	BASEMENT WINDOWS - UPGRADE BASEMENT WINDOW SIZE TO 30 " X 24" - 8" FRAME
72,351		
23Oct20 **		

KITCHEN AND BATH CABINETRY

Invoice	Qty.	Description
2439 72,217 23Oct20 **	1	KITCHEN - UPGRADE TO 8" DUCT (EXTERIOR WALL) IN LIEU OF STANDARD OFFERING
2653 101,930 07Apr21	1	THRU-OUT: SEE ATTACHED CABINETRY SCHEDULE
2768 101,930 28May21	1	***SEE REVISED CABINETRY SCHEDULE*** CREDIT FROM PE 2653 TO BE ADJSUTED UPON CLOSING

DisciplineMS.rpt 23feb21 Page 5 of 7



Lot: 152

Model: 40.02 A VALLEYVIEW

Project/Phase: Pine Valley Forevergreen / 1

NETWORK AND WIRING

Invoice	Qty.	Description
2439	1	*NOTE* DINING ROOM: MOVE STANDARD PHONE + CABLE TO DINING ROOM (NOTHING IN GREAT ROOM)
23Oct20 NoCat		
2439 72,258 23Oct20	2	DINING ROOM / BEDROOM 3: ADDITIONAL CAT6 ETHERNET OUTLET - EACH SEE PLAN FOR LOCATION
2439 72,261 23Oct20	1	KITCHEN: INSTALL VAC PAN UNDER KITCHEN SINK
PAINT		
Invoice	Qty.	Description
2653	2	MAIN STAIRS: STAIN STAIRS AND LANDINGS
101,930 07Apr21		Stairs and landings will not match hardwood in colour/texture/species
PLUMB	ING	
Invoice	Qty.	Description
2439 72,332 23Oct20	1	KITCHEN: ROUGH-IN 1/4" COLD WATER LINE TO FRIDGE

72,332 23Oct20		
2439 72,346 23Oct20	1	KITCHEN: ROUGH-IN FOR KITCHEN POT FILLER (FIXTURE NOT INCLUDED)
2653	1	KITCHEN: UPGRADE SINK - BLANCO SILGRANIT - SUPER SINGLE
07Apr21		

U/Apr21 NoCat		
2653	1	KITCHEN: ADD SOAP DISPENSER - RIGHT OF FAUCET
07Apr21		

DisciplineMS.rpt 23feb21 Page 6 of 7



Lot: 152

Model: 40.02 A VALLEYVIEW

Project/Phase: Pine Valley Forevergreen / 1

PLUMBING

Invoice	Qty.	Description
2653 101,930	1	KITCHEN: MOEN - NIO ONE-HANDLE PULLDOWN KITCHEN FAUCET - MATTE BLACK/GOLD
07Apr21		SEE ATTACHED
2653 101,930	1	KITCHEN: MOEN - MODERN POT FILLER TRIM - GOLD
07Apr21		SEE ATTACHED

STAIR AND RAILINGS

Invoice	Qty.	Description
2653 93,779 07Apr21	_	MAIN STAIRS: 2ND FLOOR TO BASEMENT: UPGRADE - EURONLINE (ALL PLAIN) PICKET, 3" HALF-ROUND W/V-GROOVE HANDRAIL, 3 1/2" ALL SQUARE POST WITH PYRAMID TOP POST CAP - PACKAGE A-2

WINDOWS AND DOORS

WINDOWS AND DOORS							
Invoice	voice Qty. Description						
2439	1	BREAKFAST ROOM: UPGRADE TO 96" GARDEN DOOR ASSEMBLY					
23Oct20 NoCat							
2439	1	*CUSTOM LAYOUT* ADD MAN DOOR AT SIDE OF GARAGE					
23Oct20 NoCat							
2653	1	**CREDIT** DELETE MAN DOOR AT GARAGE					
07Apr21 NoCat		GRADE DOES NOT PERMIT					
2439	4	BASEMENT WINDOWS - UPGRADE BASEMENT WINDOW SIZE TO 30 " X 24" - 8" FRAME					
72,351							
23Oct20 **							

DisciplineMS.rpt 23feb21 Page 7 of 7



PV - 152 Cabinetry Schedule


Amended May 21st, 2021

ROOM	DESCRIPTION	PRICE	QTY		TOTAL
KITCHEN	**DELETE ITEM**: ADD MAGIC CORNER		1	-\$	
		CABINETRY TOTAL:			

HANDLE PLACEMENT: AT INSTALLERS DISCRETION

OT#: PV-152	DATE: May 26, 2021	
IGNATURE:) * see attach. *	
SIGNATURE:	1	

*

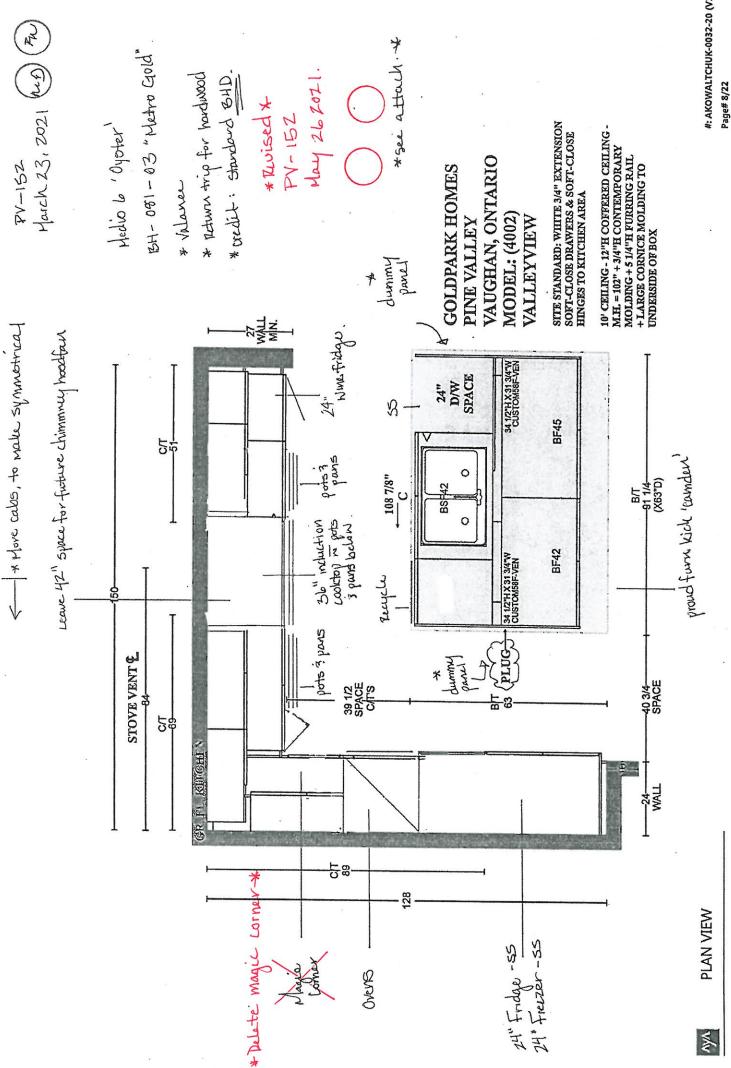




77-152


GOLDPARK HOMES March 23, 2021

MODEL: (4002) VALLEYVIEW VAUGHAN, ONTARIO PINE VALLEY

SITE STANDARD: WHITE 3/4" EXTENSION SOFT-CLOSE DRAWERS & STANDARD SLAM DOOR HINGES TO VANITIES

ONE TOP DRAWER WHERE POSSIBLE THROUGHOUT EACH VANITY, ONE BANK OF DRAWERS WHERE POSSIBLE THROUGHOUT EACH MASTER ENSUITE VANITY

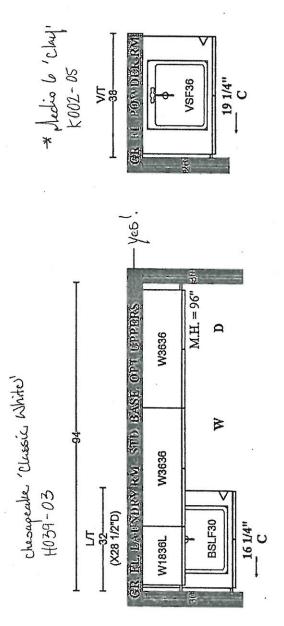

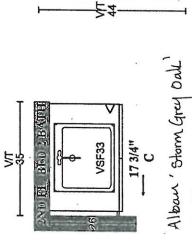


24

22 1/4"

22 1/4"

eVSF42

2ND FL. BED 3 & 4 BATH

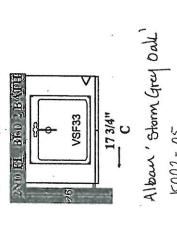










thesapeake 'Classic white' K001-03

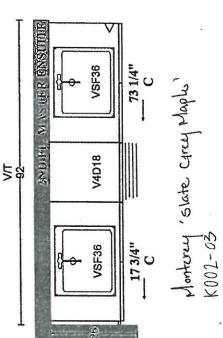



PURCI	IASERS: Maziar Dolatnia and	Pine Valley Fo	EXTRAS QUOTATION Drevergreen - Phase 1		et en	TEL:
	LOT NUMBER 152	PHASE 1	HOUSE TY 40.02 A VALLE		,	
HEM	EXTRA / CHANGE			оту	UNIT PRICE	EXTENDED
*1 101930		TRY SCHEDULE*** CREDIT	FROM PE 2653	1	-\$1,680.00	-\$1,680.00
46826	TO BE ADJSUTED UPO	V CLOSING				
					-\$218.40 H	ub Total IST otal

This is your direction to install the above extras in accordance with the following terms and conditions:

- 1. In the event the work on the house has progressed beyond the point where the items covered by this extra cannot be installed without entailing any unusual expense, then this order is to be cancelled and any deposit paid in connection with the same is to be refunded to the purchaser.
- 2. The Vendor will undertake to incorporate the work covered by the sales extra in the construction of the house but will not be hable to the purchaser in any way, if for any reason the work covered by the extra is not carried out. In that event, any monies paid in connection with the same shall be returned to the purchaser.
- It is understood and agreed that if for any reason whatsoever the transaction of Purchase and Sale is not completed, the total
 cost of extras ordered are not refundable to the Purchaser(s).
- Extrus or changes will not be processed unless signed by the Vendor.
- These extras may not be amended without the written consent of GOLDPARK (PINE VALLEY) INC.
- 6. The purchaser(s) and the builder acknowledge and agree that this "Purchaser's Extra" form shall not be deemed to be part of the agreement of purchase and sale entered into between them, nor an addendum thereto.
- Prices are estimates only and guaranteed for a period of 5 days only.
- 8. No post dated cheques will be accepted.

Payment Summary

Paid By

9. No Estimates or orders will be accepted once construction has commenced.

Amount

- All extras/selections are final with signature. All enquiries to re-open a file and/or request changes to any extras/selections
 is subject to a fee of \$500.00 (five hundred dollars).
- 11. No estimates will be considered official orders until resubmitted on a signed Purchaser Extras Form, accompanied by payment in full.

otal Payment:	Gold Park Homes Décor Centri to this order. Any remaining balance(s) will accordingly to extras purchased	be applied
	Bonus Package Offering Invoice Number Date	\$30,000.00 Amount

Bonus Summary

Bonus Package offering (includes taxes) from

Initials: (F. D)

CONSTRUCTION SCHEDULING APPROVAL

PER:

DATE:

PREPARED BY: Angela Phim
PRINTED: 21-May-21 at 4:09 pm
GollmanceSQL.rpt 07aug20



PV - 152 Cabinetry Schedule Amended May 21st, 2021


RIOOM DESCRIPTION


DELETE ITEM. ADD MAGIC CORNER

HANDLE PLACEMENT: AT INSTALLERS DISCRETION

PV-152	DATE: May 26, 2021	
TURE: (W)	D	
TURE:	T	

GOLDPARK

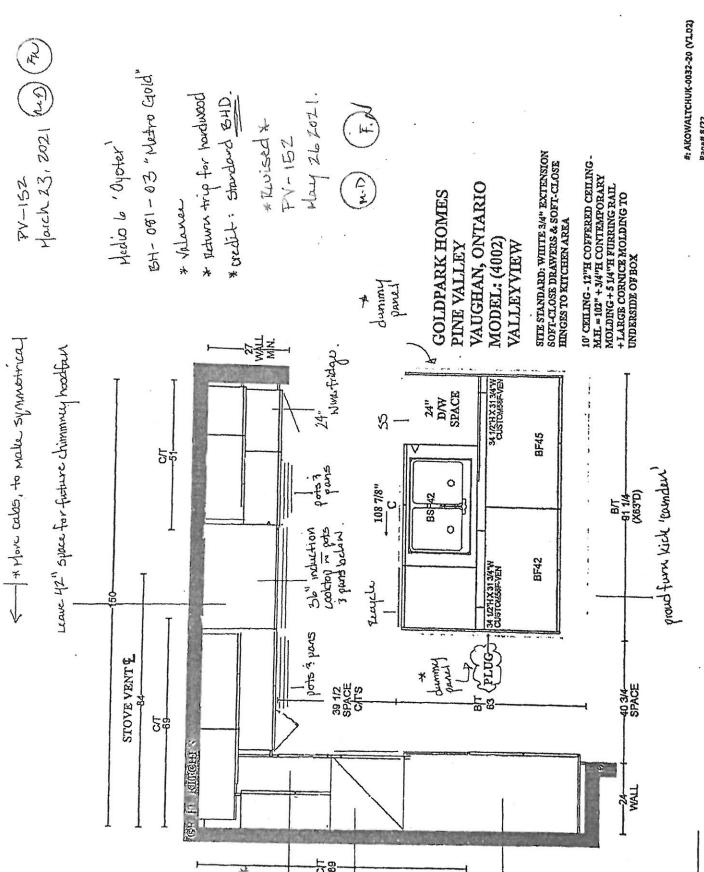

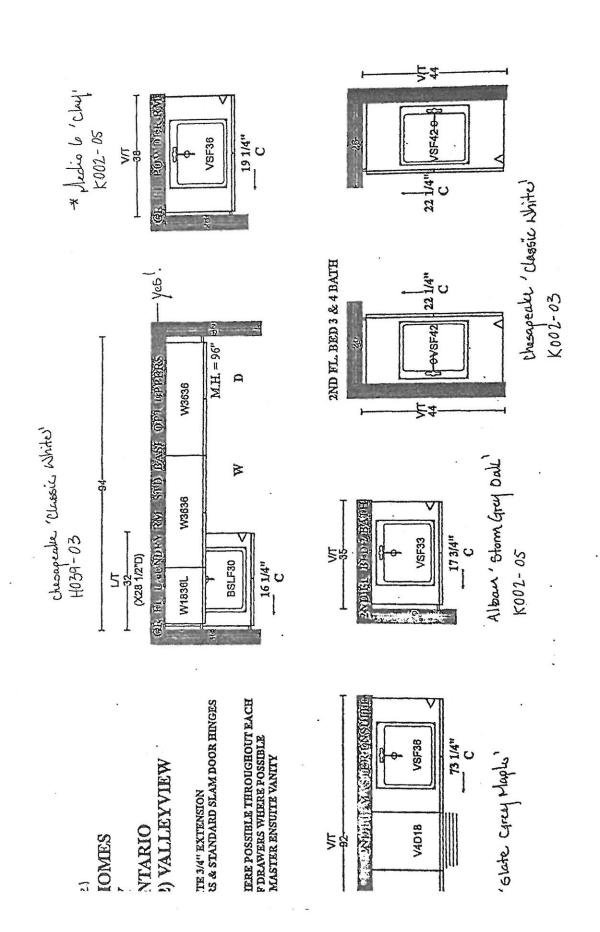



PV - 152 Cabinetry Schedule

ROOM	DESCRIPTION	PRICE QTY TOTAL
CITCHEN	UPGRADE FROM SERIES 2 TO SERIES 5 - MEDIO 6 OYSTER	1
	RETURN TRIP FOR HARDWOOD IN KITCHEN	1
	UPGRADE HARDWARE - BH-081-03 (METRO GOLD)	1
	ADJUST CABINETRY FOR 36" RANGETOP (N/C)	1
	ADD POTS AND PANS IN STOVE LOCATION BELOW COOKTOP	1
	LEAVE 42" SPACE FOR 36" CHIMNEY (N/C)	1
	CONVERT STD BASE CABINETS TO BASE POTS AND PANS	2
	MOVE ALL CABINETRY ALONG COOKTOP WALL OVER TO MAKE SYMMETRICAL (N/C)	1
	ADD CABINETRY VALANCE	1
	PROUD CAMDEN FURNITURE KICK AT BACK OF ISLAND	1
	ADD OVERSIZED DUMMY PANELS TO SIDES OF ISLAND	2
	ADD MAGIC CORNER	1
	ADD TWO-BIN RECYCLE CENTRE TO ISLAND	1
	CONVERT CABINETRY TO TALL, DEEP, BUILT-IN OVEN UNIT WITH DRAWER BELOW	1
	ADJUST CABINETRY FOR 24" FREEZER + 24" FRIDGE (N/C)	1
	ADJUST BASE CABINETS FOR 24" WINE FRIDGE (N/C)	1
	DELETE BANK OF 4 DRAWERS (CREDIT)	· ·
POWDER ROOM	UPGRADE FROM SERIES 2 TO SERIES 5 - MEDIO 6 CLAY	i
AUNDRY	ADD OPTIONAL UPPERS - STD CHESAPEAKE CLASSIC WHITE	1 .
	CABII	NETRY TOTAL:

HANDLE PLACEMENT: AT INSTALLERS DISCRETION

LOT#: PV-152	DATE: March 23, 2021	
SIGNATURE:	9)	
IGNATURE:	2)	

GOLDPARK WORTH HONE

rchasers: Maziar lephone Res. / Bus: / cor Advisor: Angela	Dolatnia & Farsa Niazimashva a Phim		e Valley Forevergre	
ayout Changes: Yes	No Sketch Attached:	Yes No Exterior	Colour Scheme:	
. Cabinetry	Style and Colour	Counter		Hardware
Kitchen / Breakfast	*Medio6 'Oyster'	*Quartz: 'Eternal Noir'		attach
Laundry Room	Chesapeake 'Classic White'	P-Lam: 'White'	1.00	attach
Powder Room	*Medio6 'Clay'	Quartz: 'Ice Snow'		attach
				attach
Master Ensuite Bathroom	Monterey 'Slate Grey Maple'	*Quartz: 'Frosty Carina	a'	attach
Second Ensuite Bathroom (If Applicable)	Alban 'Storm Grey Oak'	Quartz: 'Nordic Loft'		attach
Shared Ensuite	Chesapeake 'Classic White'	Quartz: 'Ice Snow'		attach
2. Floor Tile	Salaction			
	Selection *24x24" Carrara X polished			
Entrance Vestibule Main Hall	*24x24" Carrara X polished			
Entrance Vestibule	*24x24" Carrara X polished			
Entrance Vestibule Main Hall	*24x24" Carrara X polished n/a	nite'		
Entrance Vestibule Main Hall Kitchen / Breakfast	*24x24" Carrara X polished n/a *see hardwood	nite'		
Entrance Vestibule Main Hall Kitchen / Breakfast Laundry Room	*24x24" Carrara X polished n/a *see hardwood 13x13" Serpentine 'Beyaz Wi	nite'		
Entrance Vestibule Main Hall Kitchen / Breakfast Laundry Room Powder Room Master Ensuite	*24x24" Carrara X polished n/a *see hardwood 13x13" Serpentine 'Beyaz Wi *24x24" Carrara X polished			
Entrance Vestibule Main Hall Kitchen / Breakfast Laundry Room Powder Room Master Ensuite Bathroom Second Ensuite	*24x24" Carrara X polished n/a *see hardwood 13x13" Serpentine 'Beyaz Wi *24x24" Carrara X polished *24x24" Eterna 'Dark Grey'	y' polished		
Entrance Vestibule Main Hall Kitchen / Breakfast Laundry Room Powder Room Master Ensuite Bathroom Second Ensuite Bathroom (If Applicable) Lower Landing	*24x24" Carrara X polished n/a *see hardwood 13x13" Serpentine 'Beyaz Wi *24x24" Carrara X polished *24x24" Eterna 'Dark Grey' *12x24" Eterna 'Imperial Grey	y' polished iro Blue' (basement)		
Entrance Vestibule Main Hall Kitchen / Breakfast Laundry Room Powder Room Master Ensuite Bathroom Second Ensuite Bathroom (If Applicable) Lower Landing (If Applicable) Shared Ensuite Comment	*24x24" Carrara X polished n/a *see hardwood 13x13" Serpentine 'Beyaz Wi *24x24" Carrara X polished *24x24" Eterna 'Dark Grey' *12x24" Eterna 'Imperial Grey *12x24" New Byzantine 'Azzu	y' polished iro Blue' (basement) ' polished	natte + grout: 'charcoal'	
Entrance Vestibule Main Hall Kitchen / Breakfast Laundry Room Powder Room Master Ensuite Bathroom Second Ensuite Bathroom (If Applicable) Lower Landing (If Applicable) Shared Ensuite Comment	*24x24" Carrara X polished n/a *see hardwood 13x13" Serpentine 'Beyaz Wi *24x24" Carrara X polished *24x24" Eterna 'Dark Grey' *12x24" Eterna 'Imperial Grey *12x24" New Byzantine 'Azzu *12x24" Timeless 'Dark Grey	y' polished Iro Blue' (basement) ' polished Insuite: 2x2" Ontario 'Dark Grey' r	matte + grout: 'charcoal' Describe	








Scheduled Closing Date: Monday, June 28, 2021							
Purchasers: Maziar Dolatnia & Farsa Niazimashv Telephone Res. / Bus: /				5 (5)	52 of Plan -		
						ne Valley Forevergr	
ecor Advisor:	Angela F	Angela Phim Model and Elevation: 40.02 A VALLEYVIEW				V	
. Plumbing Fixtu	ures						
•			Second Ensu	ite		Powder Room	
Master Ensuite Bath	hroom		Other Room -	- Specify	- 7	Other Machroom	Γ
Comment	_					Other Washroom	
*thru-out see upgrades							
 Hardwood Floor 							
Main Hall	Type and S	Stain		Upper Land	lina	Type and Stain	
	*2/425" -	rod ook soul	Inted 'Hilleide'	Upper Hall	9		
Kitchen / Breakfast	3/4X5 r	eu oak scul	pied miliside	Master Bed	room	L	
Living Room				Bedroom #			
Dining Room							
Family Room				Bedroom #			
Den/Library				Bedroom #			
Entrance Vestibule				Bedroom #	5		
Lower Landing				Other Room		" "JAYS" red dak so	culpted 'Hillside'
(If Applicable)				thru-out star	ndard areas	5	
Comment							
Comment							
Comment							
	-310						
6. Carpeting		Upgrade	Description				
Ground Floor Second Floor Upgrade Underpad Carpet on Stairs Comment		Type		amily Room			Specify Great Ro
Ground Floor Second Floor Upgrade Underpad Carpet on Stairs Comment 7. Fireplace Fireplace Type Mantle Type Colour / Stain	iving Room	Type	Fa		Runner - *L	Other Room - Purchased Standard G Mediterran	As Per Plan N/A Gas Pean

	Maziar Dolatnia & Farsa	
ephone Res. / Bus:	1	Project: Pine Valley Forevergreen - Phase 1
cor Advisor:	Angela Phim	Model and Elevation: 40.02 A VALLEYVIEW
Trim Carpentry	y	
Interior Doors Car	rara Front	Door Glass Inserts std Door Handles std
Interior Trim star	ndard	
Comment		
Plaster Mould	ings and Medallions	s
Standard Through	r	N/A
Entrance Vestibule) [Kitchen/Breakfast Den/Library
Main Hall		Lower Landing
Living Room		Other Room - Specify
Dining Room		Other Room - openly
Family Room Comment	l	
Railing Colour Stringer / Riser	Spindles *A-2 Package *Hopscotch *Hopscotch	Spindle Colour *Black Treads *Hopscotch Oak Stairs Yes \(\) No \(\) N/A
Railing Package Railing Colour Stringer / Riser Comment 1. Wall Paint / C Throughout Finish Trim Paint Smooth Ceilings Ground Flo	*Hopscotch *Hopscotch *Hopscotch Marm Grey White	Treads *Hopscotch
Railing Package Railing Colour Stringer / Riser Comment 1. Wall Paint / C Throughout Finish Trim Paint Smooth Ceilings Ground Flo	*Hopscotch *Hopscotch *Hopscotch Marm Grey White	Treads *Hopscotch
Railing Package Railing Colour Stringer / Riser Comment 1. Wall Paint / C Throughout Finish Trim Paint Smooth Ceilings Ground Flo Second Flo Note	*Hopscotch *Hopscotch *Hopscotch Marm Grey White	Treads *Hopscotch

GOLDPAR	MORE *** NOTE: This is not	t an approved document. Docum Scheduled Closing Date: Monday, June	
Purchasers:	Maziar Dolatnia & Farsa Niazima	ashvari Property: 152 of Plan -	
Telephone Res. / Bus:	I	Project: Pine Valley Fo	prevergreen - Phase 1
Decor Advisor:	Angela Phim	Model and Elevation: 40.02 A VALL	EYVIEW
12. Electrical	otto Ottoialana A NVA	Ahaya Kitahan Cah	inet Light () Yes (No
Hood Fan Wh	nite Stainless N/A		inet Light Yes No
Standard Appliance	· □	Below Ritchell Gab	inet Light 1es 10
Standard Appliance	3S		
Over The Range Mi	crowave		
Chimney Style Fan	\checkmark		
Comment			

	Air Conditioning	Gas Provisions Stove	
Air Conditioning	no	Gas Provisions Stove Gas Provisions Barbecue	no std
Gas Provisions Dry	/er no	Gas Flovisions Barbecue	Stu
Comment			
15. Disclaimers	and Notes		
		ection, but not necessarily identical due to variances	
		by a separate invoice/amendment. Said invoice musi	
than re-selection due	e to unavailability Purcha	n form is signed and dated, no further changes will be ser's Initials Park Homes Decor Centre Disclaimers" form. This of	
other miscellaneous	disclaimers.		
This Interior Colour Sel	ection is final and approved by:		
Signature:	MOMM Date:		

Page 4 of 4

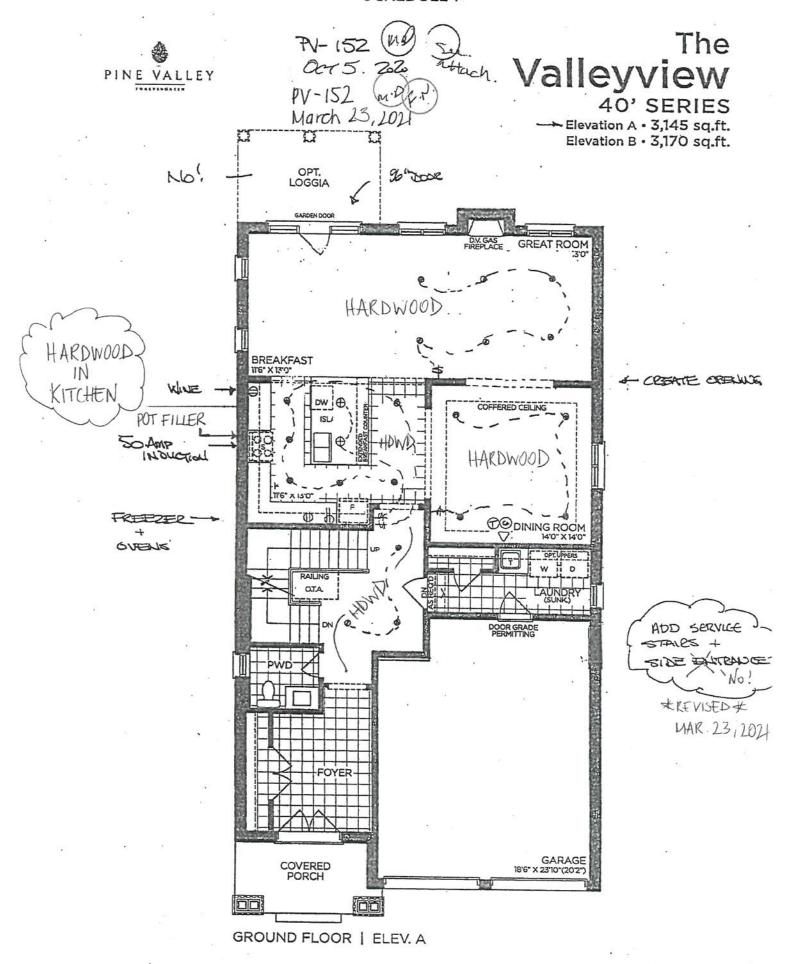


VENDOR		
PURCHASER		
PURCHASER	-	

GOLDPARK

Prices, figures, illustrations, sizes, features and finishes are subject to change without notice. Areas and dimensions are approximate and actual usable floor space may vary, from the stated area. Layout may be reverse of the unit purchased, E. & O.E. 4002




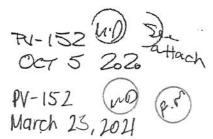

The Valleyview

40' SERIES

→Elevation A • 3,145 sq.ft. Elevation B • 3,170 sq.ft.

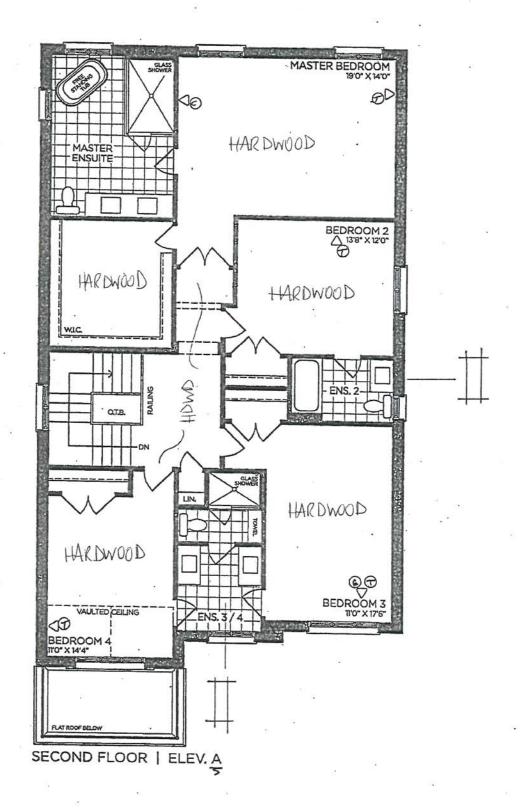


VENDOR
PURCHASER
PURCHASER

GOLDPARK

WORTH MORE

Prices, figures, illustrations, sizes, features and finishes are subject to change without notice. Areas and dimensions are approximate and actual usable floor space may vary from the stated area. Layout may be reverse of the unit purchased. E. & O.E. 4002



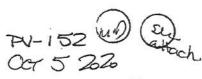


The Valleyview

40' SERIES

Elevation A • 3,145 sq.ft. Elevation B • 3,170 sq.ft.

PV-152 WD F.N. March 23, 2021

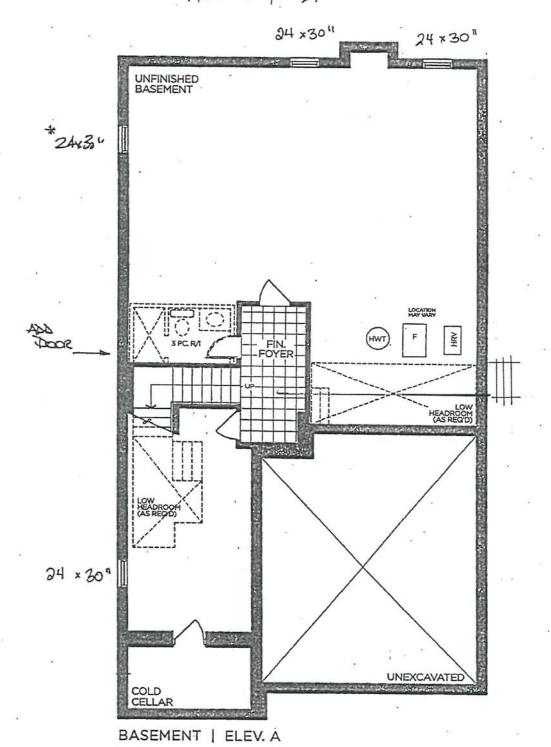

VENDOR
PURCHASER
PURCHASER

GOLDPARK WORTH MORE

Prices, figures, illustrations, sizes, features and finishes are subject to change without notice. Areas and dimensions are approximate and actual usable floor space may vary from the stated area. Layout may be reverse of the unit purchased. E. & O.E. 4002




PN-152 (M) Q Oct 5 2020 attach.

PV-152 (m) E.V March 23, 2021

The Valleyview

40' SERIES

— Elevation A • 3,145 sq.ft. Elevation B • 3,170 sq.ft.

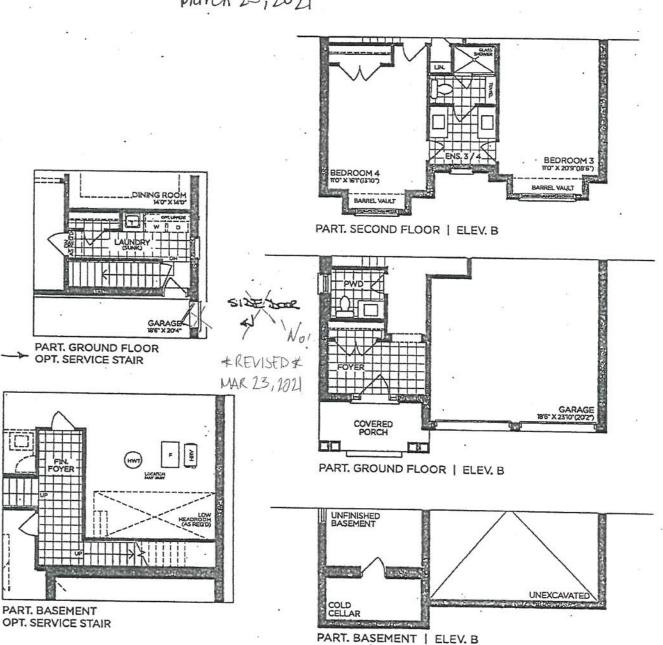

VENDOR	
PURCHASER	
PURCHASER	



Prices, figures, illustrations, sizes, features and finishes are subject to change without notice. Areas and dimensions are approximate and actual usable floor space may vary from the stated area. L'ayout may be reverse of the unit purchased. E. & O.E. 4002



STONE COUNTERTOP EDGE PROFILES

	STANDARD 2CM EASED EDGE	LOCATION: THRU OUT
	UPGRADE 3CM EASED EDGE	LOCATION:
	UPGRADE 4CM MITRED EDGE	LOCATION:
	UPGRADE 2CM OGEE EDGE	LOCATION:
SIGNATURE: (N.D)	DATE: March 2.3	, 2021
SIGNATURE:		2



8	K002-02	V K002-03 → Master Ensuite → Ensuite 3/4	К002-04
	K002-06	Noo2-05 → Powder Room → Ensuite 2	К008-14
		*NO HARDWARE	*TOUCH-LATCH
	K024-03		
		2 A	2
L	OT#PV-152 DATE: Mar	rch 23,2021	
S	IGNATURE: (m10)		
S	IGNATURE:	, 8	



H001-02	H001-03	H001-04
H009-03	Н009-09	
H011-03	H011-05	H011-06
H033-01	HO39-03 Laundry Room	*NO HARDWARE
LOT # PV- 152 DATE: M	larch 23., 2021	
SIGNATURE: (M)		
SIGNATURE: Q 2		



BH-081-03

7" - Pull - 'Brushed Nickel'




LOCATION:			
Kitchen	*		
		12	

LOT# PV-152	DATE: March 23, 2021	
SIGNATURE: (N)		
SIGNATURE:		,



MOEN - NIO

One-Handle Pulldown Kitchen Faucet

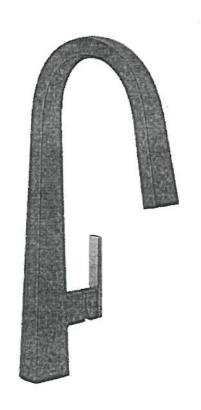


CHROME
MATTE BLACK / BRUSHED GOLD (BL)
SPOT RESIST STAINLESS (SRS)
MODEL: S75005 Chrome / S75005BL Matte Black / S75005SRS Spot Resist Stainless
Lot# PV-152 Date: March 23, 2021 Room: Kitchen
Signature:
Signature:



MOEN - MODERN

Pot Filler

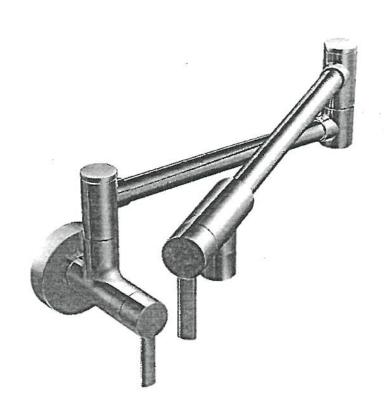



CHROME	
STAINLESS (SRS)	
POLISHED NICKEL (NL)	1
MATTE BLACK (BL)	M _E
BRUSHED GOLD (BG)	
MODEL: S665 Pot Filler	
Lot# PV-152 Date: March 23, 2021 Room: Kitchen	
Signature: who	
Signature:	



BLANCO - PRECIS U SUPER SINGLE


Silgranit - Undermount Sink 32" x 19" x 9 1/2"

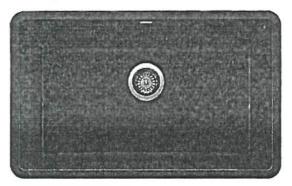

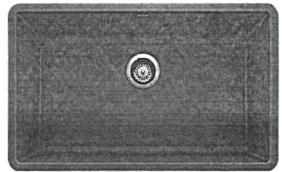

Anthracite

Concrete Grey

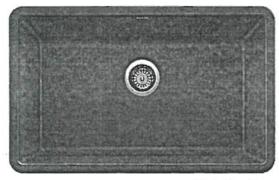



Metallic Grey


White

ANTHRACITE	GRID
CONCRETE GREY	
METALLIC GREY	
WHITE	
MODEL 400890 Anthracite / 402266 Concrete Grey / 401820 White / 406446 Grid	/ 401683 Metallic Grey /
Lot# PV-152	
Room: Kitchen	Signature:
Date: March 23, 2021	Signature:



MOEN - SOAP/LOTION DISPENSER

Soap/Lotion Dispenser

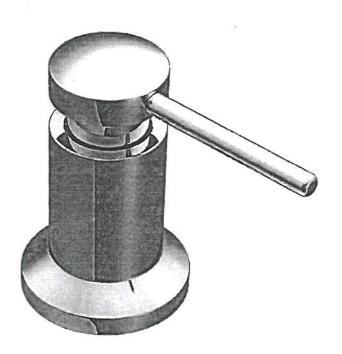


CHROME	* Right of	Suction *
MATTE BLACK (BL)	* KIGHT OT	120-07
GLACIER (W)		
STAINLESS (SRS)		
MODEL: 3942 (BL, W, SRS) Soap Dispenser		
Lot# 52 Date: MARON 26 2621	Room: KITCHEN.	
Signature: NO		
Signature:		




MT6X6


Shower Door Handle

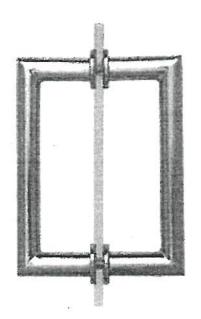

MT6X6	,
Shower Door Handle	[]
6" x 6" back-to-back	CHROME
3/4" dia. tube	MATTE BLACK
Cut and mitred corners with	
washers	BRUSHED GOLD
(Also available single sided)	

Lot#PV-152	Date: March 23, 2021	Room: Master Ensulte, Ensulte 3/4
Signature:)	
Signature: (4)		

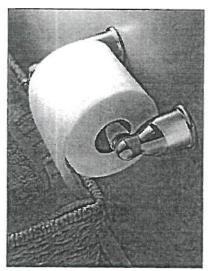

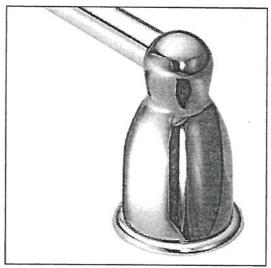

Tissue Holder Mason - Chrome

Towel Bar Mason - Chrome

Please select one of the following:

INSTALL STANDARD BATHROOM ACCESSORIES THRU OUT (tissue holder + towel bar) *location as per vendors discretion*

DO NOT INSTALL STANDARD BATHROOM ACCESSORIES THRU OUT *tissue holder + towel bar will not be provided*

SIGNATURE:

SIGNATURE:

SIGNATURE:

SIGNATURE:



Project: Pine Valley Lot: 15
Purchaser(s): Maziar Dolatnia & Farsa Niazimashvari
Standard Hood Fan Deletion
We acknowledge that the builder's standard hood fan will not be installed. Do not supply, install and/or credit. We will install our own hood fan after closing
Signature:
Signature:
Date: March 23., 2011





March 23, 2021

36" Glass Canopy Chimney Hood

Benchmark® Series - Stainless Steel HCG56651UC





HCG56651UC Stainless Steel

Wall mounted chimney hoods add style and sophistication to the kitchen and gives you greater freedom in your kitchen planning.

Features & Benefits

Touch controls with LCD display.

600 CFM centrifugal integrated blower included.

Four speed touch controls with LCD display.

Dishwasher safe filters with stainless steel covers.

Converts to recirculation mode with accessory kit (separate purchase required).

General Properties	
Operating mode	Convertible: ducted / recirculating
Maximum CFM	600 CFM
Sones	10.13 HS / 2.46 WS
Number of speed settings	4-stage
Motor location	Integrated motor in hood chimney
Number of lights	2
Bulb type	Halogen
Total power of the lamps (W)	80 W
Damper included	Yes
Grease filter material	Washable stainless steel
Grease filter type	Multilayer cassette
Technical Details	
Volts (V)	120 V
Frequency (Hz)	60 Hz
Plug type	No plug





Overall appliance dimensions (width of canopy included) (HxWxD) (in.)	27 7/16" x 42 3/8" / 27 7/16" x 46 5/16" / 35 7/8" x 19 11/16"
Height of the chimney (in.)	25 7/8" x 40 13/16" / 25 7/8" x 44 3/4"
Required distance above cooktop/range cooking surface	24" Electric / 30" Gas
Diameter of air duct (in.)	8"
Net weight (lbs)	54 lbs
Accessories-Optional	





HCIFILTUC



HCREC5UC Recirculation kit




Accessories: To purchase Bosch accessories, cleaners & parts please visit www.bosch-home.com/us/store or call 1-800-944-2904 (Mon to Fri 5 am to 6 pm PST, Sat 6 am to 3 pm PST). Accessories: 10 purchase Bosch accessories, cleaners & parts please visit www.bosch-home.com/us/store or call 1-800-944-2904 (Mon to Fri 5 am to 6 pm PST, Sat 6 am to 3 pm PST).

Notes: All height, width and depth dimensions are shown in inches. BSH reserves the absolute and unrestricted right to change product materials and specifications, at any time, without notice. Consult the product's installation instructions for final dimensional data and other details prior to making cutout.

Warranties: Please see Use & Care manual or Bosch website for statement of limited warranty.

For more information on our entire line of products, go to www.bosch-home.com/us or call 1-800-944-2904

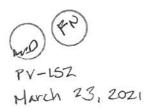



36" Glass Canopy Chimney Hood


Benchmark® Series - Stainless Steel HCG56651UC




Installation Details

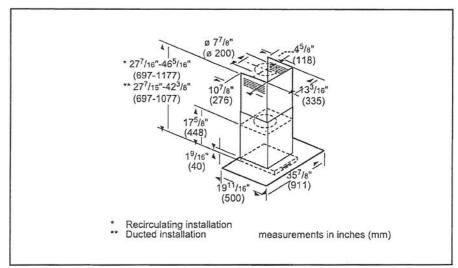

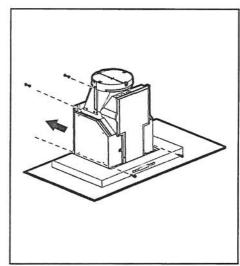

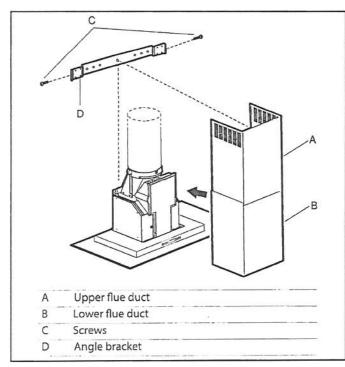

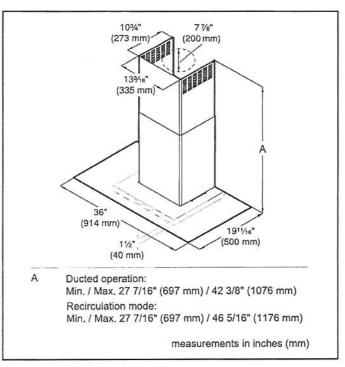

Accessories: To purchase Bosch accessories, cleaners & parts please visit www.bosch-home.com/us/store or call 1-800-944-2904 (Mon to Fri 5 am to 6 pm PST, Sat 6 am to 3 pm PST). Notes: All height, width and depth dimensions are shown in inches. BSH reserves the absolute and unrestricted right to change product materials and specifications, at any time, without notice. Consult the product's installation instructions for final dimensional data and other details prior to making cutout.

Warranties: Please see Use & Care manual or Bosch website for statement of limited warranty.

For more information on our entire line of products, go to www.bosch-home.com/us or call 1-800-944-2904

BSH Home Appliances Corporation. All rights reserved. Bosch is a registered trademark of Robert Bosch GmbH.





36" Induction Cooktop

Benchmark® Series - Black NITP669UC





NITP669UC Black

Also available in:

Black with NITP669SUC Stainless Steel Frame

FlexInduction® cooktop allows you to place your cookware wherever you want on the flexible cooking zone.

Features & Benefits

FlexInduction® – provides even more flexibility by combining two cooking zones into one larger zone

12" dual-ring center cooking zone for large pots and pans

PowerMove[™] – divides FlexInduction® into 3 preset power level zones. Simply move the cookware to change the power level

Home Connect™ – the easy way to connect your smart device with your Bosch cooktop

Element Performance	
Power of Full Zone Left & Right heating element	3,300 W
Power of Full Zone Left & Right heating element (in boost)	3,600 W
Power of Front Left heating element	2,200 W
Power of Front Left heating element (in boost)	3,600 W
Power of Back Left heating element	2,200 W
Power of Back Left heating element (in boost)	3,600 W
Power of Center heating element	3,300 / 2,200 W
Power of Center heating element (in boost)	3,700 / 3,400 W
Power of Back Right heating element	2,200 W
Power of Back Right heating element (in boost)	3,600 W
Power of Front Right heating element	2,200 W
Power of Front Right heating element (in boost)	3,600 W
Burners with booster	All*
Dimension of Front Left heating element	7" x 8"
Dimension of Back Left heating element	7" x 8"
Dimension of Center heating element	12", 9"
Dimension of Back Right heating element	7" x 8"
Dimension of Front Right	7" x 8"

General Properties	
Home Connect™ (Wi-Fi Enabled)	Yes
Controls	PreciseSelect® Touch
Technical Details	No.
Watts	12,000 W
Circuit breaker	50 A
Volts	208-240 V
Frequency	60 Hz
Plug type	No plug
Power cord length	37"
Energy source	Electric
Dimensions & Weight	THE COLD
Overall appliance dimensions (HxWxD)	5/16" +4 1/8" x 37" x 21 1/4"
Required cutout size (HxWxD)	4 1/8" x 34 7/8" x 20"
Minimum distance from counter front	2 1/4"
Minimum distance from rear wall	2"
Net weight	53 lbs
Accessories-Optional	感感 医动脉
(C)	
HEZ390210 8" AutoChef® pan	HEZ390220 9" AutoChef® pan
6	
HEZ390230 10" AutoChef® pan	HEZ390512 Teppanyaki

HEZ9GR37UC





For 36 model Boost function may be used simultaneously in 3 zones only. See User Manual.

Accessories: To purchase Bosch accessories, cleaners & parts please visit www.bosch-home.com/us/store or call 1-800-944-2904 (Mon to Fri 5 am to 6 pm PST, Sat 6 am to 3 pm PST).

Notes: All height, width and depth dimensions are shown in inches. BSH reserves the absolute and unrestricted right to change product materials and specifications, at any time, without notice. Consult the product's installation instructions for final dimensional data and other details prior to making cutout.

Warranties: Please see Use & Care manual or Bosch website for statement of limited warranty.

For more information on our entire line of products, go to www.bosch-home.com/us or call 1-800-944-2904

BSH Home Appliances Corporation. All rights reserved. Bosch is a registered trademark of Robert Bosch GmbH.

heating element





36" Induction Cooktop


Benchmark® Series - Black NITP669UC



Installation Details

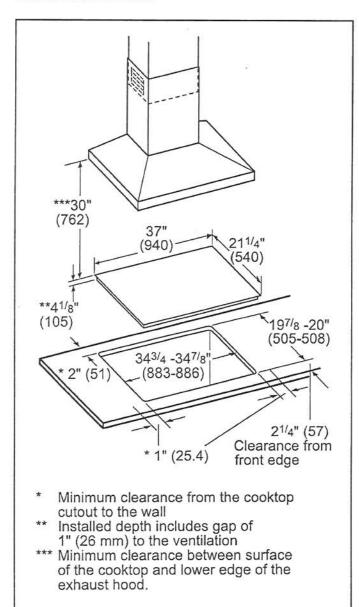

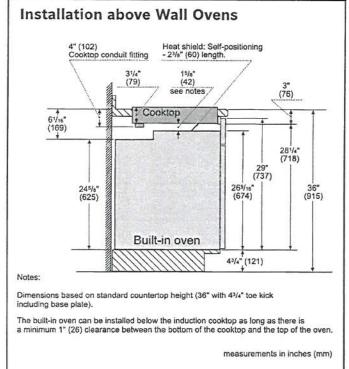

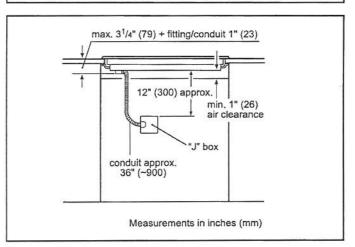

Accessories: To purchase Bosch accessories, cleaners & parts please visit www.bosch-home.com/us/store or call 1-800-944-2904 (Mon to Fri 5 am to 6 pm PST, Sat 6 am to 3 pm PST).

Notes: All height, width and depth dimensions are shown in inches. BSH reserves the absolute and unrestricted right to change product materials and specifications, at any time, without notice. Consult the product's installation instructions for final dimensional data and other details prior to making cutout.

Warranties: Please see Use & Care manual or Bosch website for statement of limited warranty.

For more information on our entire line of products, go to www.bosch-home.com/us or call 1-800-944-2904

BSH Home Appliances Corporation. All rights reserved. Bosch is a registered trademark of Robert Bosch GmbH.


measurements in inches (mm)

WD (2) PV-152 March 23, 2021

PODMC301W 30-INCH DOUBLE COMBINATION BUILT-IN OVEN WITH SPEED OVEN

Thermador.*

PROFESSIONAL SERIES

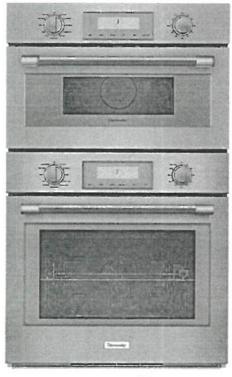







FEATURES & BENEFITS

- Specially crafted gray glass on stainless steel for a luxurious look and finish
- Designed for flexibility—standard or flush installation into kitchen cabinets
- Speed oven with microwave capability can broil and convection bake
- Large commercial style rotisserie with 12 pound capacity
- Multi-point Meat Probe to better capture temperature in roast and poultry

ACCESSORIES (INCLUDED)

Upper Cavity: Metal Turntable, Rack, Ceramic Tray; Lower Cavity: 3 Telescopic Racks, Multi-point Meat Probe, Max Broil Pan, Rotisserie

WARRANTY	
Limited Warranty Parts and Labor	2 Year

GENERAL PROPERTIES

Heating Modes - Upper Cavity

36 CookSmart™ Auto Programs (including True Convection, Speed Convection, Broil, Convection Broil, Heating Programs, Keep Warm) and Microwave Programs


Heating Modes - Lower Cavity

(16) Bake, Broil, Max Broil, Roast, Convection Bake, Convection Broil, Max Convection Broil, Convection Roast, Proof, Warm, Pizza, True Convection, Dehydrate, Speed Convection, Slow Roast, Rotisserie

Sabbath		Yes
Cleaning Type – Lower C	avity	Easy Clean and Self Clean
Telescopic Rack(s)		3
Illumination Type	Upper Cavity Lower Cavity	LED Halogen
Interior Lights	Upper Cavity Lower Cavity	1 2
Home Connect (Wi-Fi Enabled)		Yes, Lower Oven Only
OVEN PERFORMANI	CE	经验证据
Microwave Power		1,000 W
Bake / Broil Element	Upper Cavity Lower Cavity	600 W / 1,750 W 2,400 / 1,000 / 3,800 W
Convection Element	Upper Cavity Lower Cavity	1,700 W 2,000 W

TECHNICAL DETAILS	
Watts	10,200 W
Circuit Breaker	50 A
Volts; Frequency	240 / 208 V; 60 Hz
Plug Type	Fixed Connection, No Plug
Conduit	60" 4-Wire
Energy Source	Electric
DIMENSIONS & WEIGHT	
Overall Appliance Dimensions (HxWxD)	49" x 29 3/4" x 24 1/2"
Trim Overlaps (Top – Sides – Bottom)	1/2" - 9/16" - 0"
Required Cutout Size (HxWxD) - Standard	48 1/2" x 28 1/2" x 23 1/2"
Required Cutout Size (HxWxD) - Flush	49 1/8" x 30" x 24 1/2"

Page 1 of 3 2 / 20

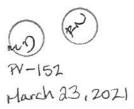



PODMC301W 30-INCH DOUBLE COMBINATION BUILT-IN OVEN WITH SPEED OVEN

Thermador.**

PROFESSIONAL SERIES

30-INCH DOUBLE COMBINATION OVEN WITH SPEED OVEN

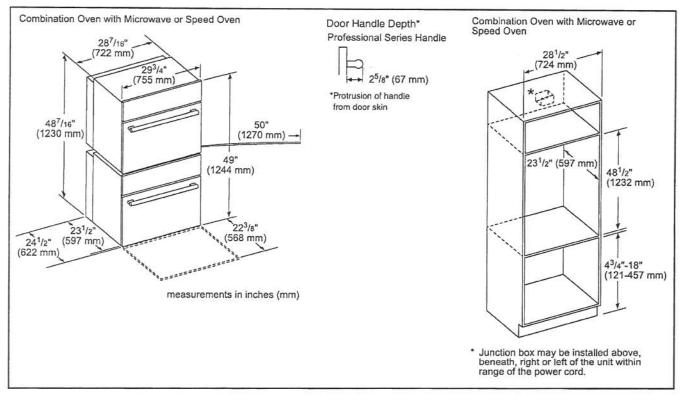

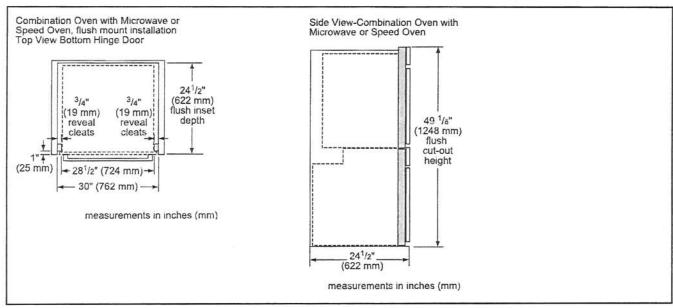







PODMC301W 30-INCH DOUBLE COMBINATION BUILT-IN OVEN WITH SPEED OVEN



PROFESSIONAL SERIES

INSTALLATION DETAILS

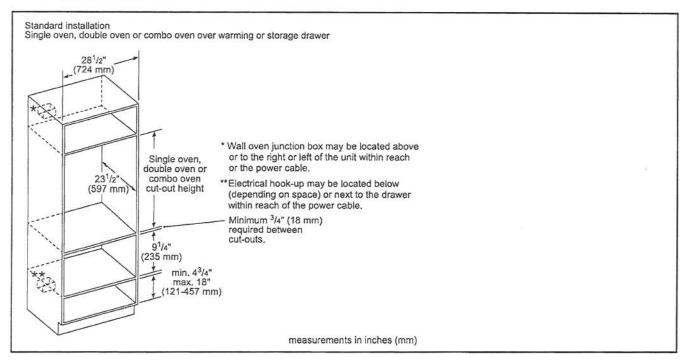

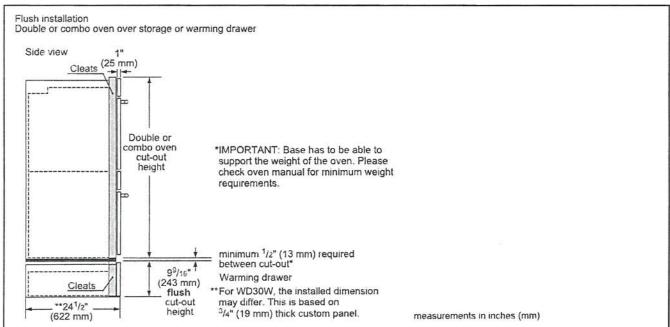

These warranties give you specific legal rights and you may have other rights that vary from state to state. Full warranty and limited warranty from date of installation. For complete warranty details, refer to your Use & Care manual, or ask your dealer.

Specifications are for planning purposes only. Refer to installation instructions and consult your countertop supplier prior to making counter opening. Consult with a heating and ventilation engineer for your specific ventilation requirements. For the most detailed information, refer to installation instructions accompanying product or write to Thermador indicating the model number. Specifications are correct at time of printing. Thermador reserves the right to change product specifications or design without notice. Some models are certified for use in Canada. Thermador is not responsible for products that are transported from the U.S. for use in Canada.

1 800 735 4328 | USA THERMADOR.COM | CANADA THERMADOR.CA | ©2020 BSH HOME APPLIANCES CORPORATION. ALL RIGHTS RESERVED.

Page 3 of 3





T241R900SP 24-INCH BUILT-IN FRESH FOOD COLUMN FREEDOM® COLLECTION, PANEL-READY









- Freedom® Hinge enables true flush design
- Auto Door Opening provides the opening of the door with just a slight push or pull
- Delicate Produce Bins for expanded storage
- ThermaFresh System, Humidity and Temperature controlled drawers
- SoftClose® Drawers and Produce Bins for easy and controlled storage
- Sleek clean design for the perfect symmetry when paired with additional columns
- TFT control panel managing all your columns functions

TEMPERATURE RANGES	Baks a few and a second
Refrigerator	36°F (2°C) to 46°F (8°C)
Temperature Controlled Drawer	30°F (-1°C) to 38°F (3°C)
SuperCool	36°F (2°C) for approximately 6 hours
Energy Saving (Economy) Mode	43°F (6°C)

GENERAL PROPERTIES	Crick List Homes (E)
Panel Ready	Yes
Reversible Door Swing	Yes
SoftClose® Door	Yes*
SoftClose® Drawers	Yes
Carbon Air Filter	Yes
Lighting	LED Sidewall and Theater Lighting
Refrigerator Shelves	4
Adjustable Shelves	3
Shelf Material	Glass w/Aluminum Profile
Full Extension Drawers @ 115° Door Opening Angle	Yes
Full Extension Drawers @ 90° Door Opening Angle	Yes
General Use Drawer	1
Humidity Managed Drawer	1
Temperature Controlled Drawer	1
Door Bins	2
Gallon Door Bins	1
Delicate Produce Bins	2 Small
Door Open Alarm	Yes
Open Door Assist	Yes
Special Modes	Sabbath, Economy Vacation
CAPACITY	THE DESIGNATION OF
Total Capacity (cu. ft.)	13.0 cu. ft.
PERFORMANCE	5 1 27
Dedicated Evaporator & Compressor System	Yes
Freeflow® Cold Air System	Yes
SuperCool	Yes
TECHNICAL DETAILS	
Watts (W)	350 W
Current (A)	15 A
Volts (V)	110-120 V
Frequency (Hz)	60 Hz
Power Cord Length (in.)	118
Plug Type	120V-3 Prong
DIMENSIONS & WEIGHT	
Appliance Dimensions (H x W x D) (in.)	83 3/4"** x 23 3/4" :
Required Cutout Size (H x W x D) (in.)	84" x 24" x 25"
Net / Gross Weight (lbs)	330 / 352 lbs
EFFICIENCY	
ENERGY STAR® Qualified	Yes

^{*}To verify if you have a refrigeration unit with Soft-Close capability please contact our customer team by calling 1-800-735-4328.

**Height adjustable + / -*/2" (+ / -13 mm)

264 kWh

Annual Energy Consumption

Page 1 of 3 3 / 20




T24IR900SP 24-INCH BUILT-IN FRESH FOOD COLUMN FREEDOM® COLLECTION, PANEL-READY




WARRANTY		
Limited, Entire Appliance, Parts and Labor on Any Part of the Refrigerator that Fails Because of a Manufacturing Defect	2 Year	
Limited Warranty for Sealed Refrigeration System*; Parts and Labor	3rd to 6th Year	
Limited Warranty for Sealed Refrigeration System*; Parts Only	7th to 12th Year	
Limited Warranty for Stainless Steel Rust-Through	Lifetime	

^{*}Sealed refrigeration system includes compressor, evaporator, condenser, dryer / strainer and connection tubing


CUTOUT DIMENSIONS

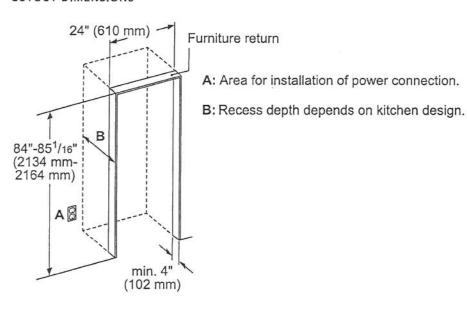

TOP VIEW CLEARANCE

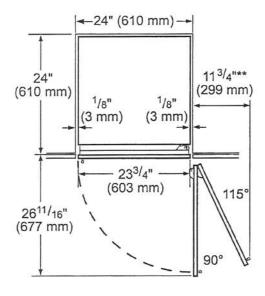

- ** Door handle must be added to this dimension
- * Depends on the thickness of the furniture door. 3/4" (19 mm) is relevant for the stainless steel door. (special Accessory).

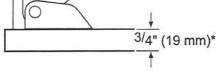




T241R900SP

24-INCH BUILT-IN FRESH FOOD COLUMN

FREEDOM® COLLECTION, PANEL-READY



PRODUCT AND PANEL DIMENSIONS

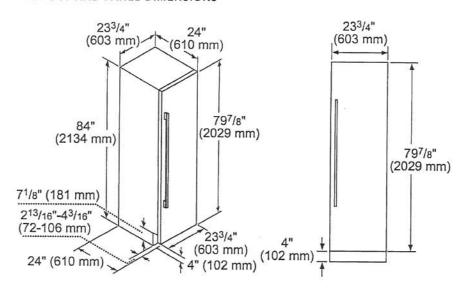

ACCESSORIES (OPTIONAL)

FLAT STAINLESS STEEL DOOR PANELS

24-Inch Flat Stainless Steel Door Panel



TFL24IR800 For use with Handle TFL24IR905* Handleless

*Available Summer 2019

NOTE: Handleless Panels should not be installed on units without the Soft-Close capability. If you are uncertain if you have a refrigeration unit with Soft-Close capability please contact our customer team by calling 1-800-735-4328.

STORAGE



SPRODBIN10 Small Produce Bin



LPRODBIN10 Large Produce Bin



24PRODRAIL 24-Inch Produce Railing



24HFGALBIN 24-Inch Half Gallon Bin



Freedom® Heater Kit

HEATRKIT20 - 13W @ 120V

When two appliances are installed side-by-side a sealing kit must be used. For combinations that involve a freezer column, this kit is included. For all other (non-traditional, i.e. two wine columns, two bottom freezers, etc.) side-by-side combinations or instances where any appliances are

installed less than 6-inches (152 mm) apart from one another but not connected side-by-side, purchase this kit. This kit is recommended for use with any installation in areas that are subject to humidity, or located next to an outside wall.

HANDLES

Choose between two options:

PR36HNDL20 36-Inch Professional Series Handle or

MS36HNDL20 36-Inch Masterpiece® Series Handle

These warranties give you specific legal rights and you may have other rights that vary from state to state. Full warranty and limited warranty from date of installation. For complete warranty details, refer to your Use & Care manual, or ask your dealer.

Specifications are for planning purposes only. Refer to installation instructions and consult your countertop supplier prior to making counter opening. Consult with a heating and ventilation engineer for your specific ventilation requirements. For the most detailed information, refer to installation instructions accompanying product or write to Thermador indicating the model number. Specifications are correct at time of printing. Thermador reserves the right to change product specifications or design without notice. Some models are certified for use in Canada. Thermador is not responsible for products that are transported from the U.S. for use in Canada.


1 800 735 4328 | USA THERMADOR.COM | CANADA THERMADOR.CA | @2020 BSH HOME APPLIANCES CORPORATION. ALL RIGHTS RESERVED.



March 23, 2021

T241D900LP 24-INCH BUILT-IN FREEZER COLUMN WITH ICE & WATER DISPENSER FREEDOM® COLLECTION, PANEL-READY, LEFT-HAND DOOR SWING

Thermador.**

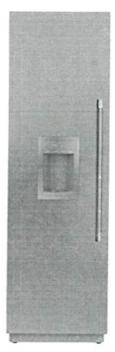



Also Available In: T24ID900RP – Right-Hand Door Swing

FEATURES & BENEFITS

- Freedom® Hinge enables true flush design
- Auto Door Opening provides the opening of the door with just a slight push or pull
- Energy Efficient Diamond Ice made with twist tray technology
- Smooth Filtered Lighting for clear and easy viewing of all
- SoftClose® Drawers for easy and controlled storage
- Sleek clean design for the perfect symmetry when paired with additional columns
- TFT control panel managing all your columns functions

TEMPERATURE RANGES	
Freezer	-11°F (-24°C) to 7°F (-14°C)
SuperFreeze®	-22°F (-30°C) for approximately 52 hours
Energy Saving (Economy) Mode	3°F (-16°C)

GENERAL PROPERTIES	May probably
Panel Ready	Yes
Reversible Door Swing	No
SoftClose® Door	Yes*
SoftClose® Drawers	Yes
Lighting	LED Sidewall and Theater Lighting
Freezer Shelves	4
Adjustable Shelves	2
Shelf Material	Glass w/Aluminum Profile
Full Extension Drawers @ 115° Door Opening Angle	Yes
General Use Drawer	2
Door Bins	0
External LED Proximity Sensor	Yes
Oversized Dispenser Opening	Yes
Chilled Water, Crushed and Cubed Ice	Yes
Rapid Water Replenishment System	Yes
Ice Maker with Diamond Ice System	Yes
Door Open Alarm	Yes
Open Door Assist	Yes
Special Modes	Sabbath, Economy, Vacation
CAPACITY	Transport to the same
Total Capacity (cu. ft.)	11.2 cu. ft.
PERFORMANCE	
Dedicated Evaporator & Compressor System	Yes
SuperFreeze®	Yes
Defrost Process	Frost-Free
TECHNICAL DETAILS	
Watts (W)	350 W
Current (A)	15 A
Volts (V)	110-120 V
Frequency (Hz)	60 Hz
Power Cord Length (in.)	118
Plug Type	120V-3 Prong
DIMENSIONS & WEIGHT	AMUM Salabaya Masa
Appliance Dimensions (H x W x D) (in.)	84"** x 23 3/4" x 24
Required Cutout Size (H x W x D) (in.)	84" x 24" x 25"
Net / Gross Weight (lbs)	342 / 364 lbs
EFFICIENCY	
ENERGY STAR® Qualified	Yes
15 6 :	457 kWh
Annual Energy Consumption	437 KAAII


*To verify if you have a refrigeration unit with Soft-Close capability please contact our customer team by calling 1-800-735-4328.

**Height adjustable + / -1/2* (+ / -13 mm)




T24ID900LP 24-INCH BUILT-IN FREEZER COLUMN WITH ICE & WATER DISPENSER FREEDOM® COLLECTION, PANEL-READY, LEFT-HAND DOOR SWING

Thermador.**

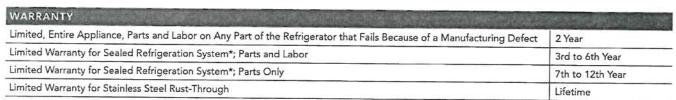

^{*}Sealed refrigeration system includes compressor, evaporator, condenser, dryer / strainer and connection tubing

CUTOUT DIMENSIONS

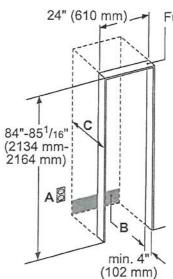


Furniture return

A: Area for installation of power connection.


B: Area for running the water line. It is recommended that the waterbox is placed adjacent to the installation cavity, so that it can be accessed for service without uninstalling the appliance. If this is not possible, place the recessed waterbox adjacent to the water supply socket elevated at the heights as referenced in areas A and B.

C: Recess depth depends on kitchen design.


Note: The cutout for the dispenser unit must be horizontal and vertically aligned (centred).

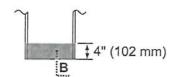

TOP VIEW CLEARANCE

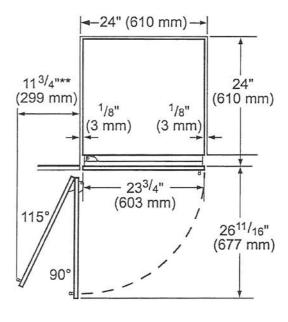

- ** Door handle must be added to this dimension
- * Depends on the thickness of the furniture door. 3/4" (19 mm) is relevant for the stainless steel door. (special Accessory).

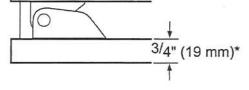

Page 2 of 3





PV-15Z March 23, 202 |


T24ID900LP


24-INCH BUILT-IN FREEZER COLUMN WITH ICE & WATER DISPENSER

FREEDOM® COLLECTION, PANEL-READY, LEFT-HAND DOOR SWING

Thermador.*

PRODUCT AND PANEL DIMENSIONS

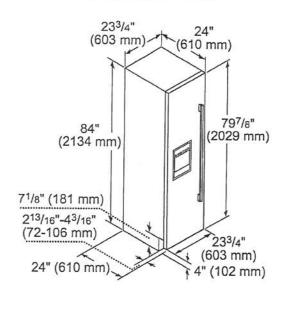

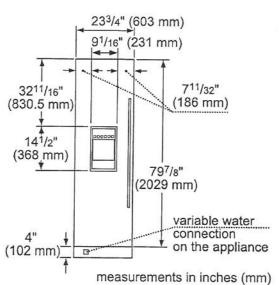

ACCESSORIES (OPTIONAL)

FLAT STAINLESS STEEL DOOR PANELS

24-Inch Flat Stainless Steel Door Panel With Dispenser



TFL24ID800 For use with Handle TFL24ID905* Handleless

*Available Summer 2019

NOTE: Handleless Panels should not be installed on units without the Soft-Close capability. If you are uncertain if you have a refrigeration unit with Soft-Close capability please contact our customer team by calling 1-800-735-4328.

HANDLES

Choose between two options:

PR36HNDL20 36-Inch Professional Series Handle or

FILTERS

REPLFLTR10

Freedom® Water Filter Replacement water filter for use in all freezer and bottom freezer models


SCRNFLTR10

By-Pass Filter for use with existing in-home water filtration systems in all freezers and bottom freezer models

STORAGE



ICEBUCKETL Large Ice Bucket

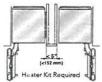

HEATRKIT20 - 13W @ 120V

36-Inch Masterpiece® Series Handle

Freedom® Heater Kit

When two appliances are installed side-by-side a sealing kit must be used. For combinations that involve a freezer column, this kit is included. For all other (non-traditional, i.e. two wine columns, two bottom freezers, etc.) side-by-side combinations or instances where any appliances are installed less than 6-inches (152 mm) apart from one another but not connected side-by-side, purchase this kit. This kit is recommended for use with any installation in areas that are subject to humidity, or located next to an outside wall.

These warranties give you specific legal rights and you may have other rights that vary from state to state. Full warranty and limited warranty from date of installation. For complete warranty details, refer to your Use & Care manual, or ask your dealer.

Specifications are for planning purposes only. Refer to installation instructions and consult your countertop supplier prior to making counter opening. Consult with a heating and ventilation engineer for your specific ventilation requirements. For the most detailed information, refer to installation instructions accompanying product or write to Thermador indicating the model number. Specifications are correct at time of printing. Thermador reserves the right to change product specifications or design without notice. Some models are certified for use in Canada. Thermador is not responsible for products that are transported from the U.S. for use in Canada.


1 800 735 4328 | USA THERMADOR.COM | CANADA THERMADOR.CA | ©2020 BSH HOME APPLIANCES CORPORATION, ALL RIGHTS RESERVED.

Page 3 of 3



T24UW910LS UNDER-COUNTER WINE RESERVE WITH GLASS DOOR MASTERPIECE® SERIES HANDLE - LEFT HINGED



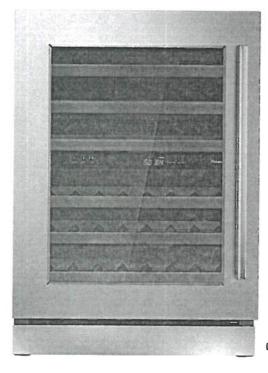



Also Available:

T24UW910RS - Right Hinged with Masterpiece® Series Handle T24UW920LS – Left Hinged with Professional Series Handle T24UW920RS – Right Hinged with Professional Series Handle T24UW900LP – Left Hinged Custom Panel-Ready T24UW900RP – Right Hinged Custom Panel-Ready

FEATURES & BENEFITS

- Dual zone wine storage with adjustable temperature zones
- Full-extension wine racks
- UV resistant tempered glass door
- SoftClose® door hinges for ultra-smooth closing of the door
- LED theater lighting
- Touch electronic controls for precise temperature management

GENERAL PROPERTIES	Renew Sales His
UV Resistant Glass Door	Yes
Reversible Door Swing	Left and Right Available
SoftClose® Door Hinges	Yes
Lighting	Adjustable LED Lighting
Bottle Shelves	6
Shelf Material	Wenge Triangular Hardwood dowels w/ Aluminum Front Caps
Full Extension Wine Racks	Yes
Dual Zone Wine Storage	Yes
Door Open Alarm	Yes
Touch Electronic Controls	Yes
STAR-K Certified Sabbath Mode	Yes
CAPACITY	
Number of Bottles	41
TEMPERATURE RANGES	SAN SOUTH THE SAN
Upper Zone	40°F (3°C) to 52°F (10°C)
Lower Zone	52°F (11°C) to 64°F (18°C)
TECHNICAL DETAILS	
Watts (W)	150 W
Current (A)	15 Amp
Volts (V)	115 V
Frequency (Hz)	60 Hz
Power Cord Length (in.)	60"
Plug Type	120V 3-Wire
DIMENSIONS & WEIGHT	
Appliance Dimensions (H x W x D) (in.)	34 1/4"* x 23 7/8" x 24"
Required Cutout Size (H x W x D) (in.)	34 ³ /4" - 35 ¹ /4" x 24 ³ /16" x 24 ⁹ /16"
Net / Gross Weight (lbs.)	190 / 205 lbs.
EFFICIENCY	
Annual Energy Consumption	426 kWh
WARRANTY	SCREEN SHOW SHOW IN THE STATE OF

Limited Warranty for Sealed Refrigeration System**; Parts and Labor

2 Year

3rd to 6th Year

Limited, Entire Appliance, Parts and Labor on any Part of the Refrigerator that Fails Because of a Manufacturing Defect

Limited Warranty for Sealed Refrigeration System*; Parts Only 7th to 12th Year

Height adjustable \pm 1/2 (13 mm) with legs fully extended **Sealed refrigeration system includes compressor, evaporator, condenser, dryer / strainer and connection tubing






T24UW910LS


UNDER-COUNTER WINE RESERVE WITH GLASS DOOR MASTERPIECE® SERIES HANDLE - LEFT HINGED

Thermador.*

GLASS DOOR WINE RESERVE PRODUCT DIMENSIONS

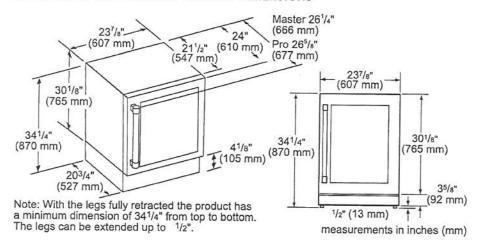


GLASS DOOR WINE RESERVE CUTOUT DIMENSIONS

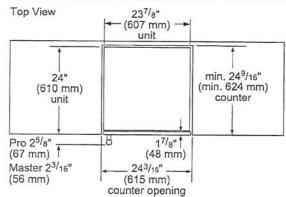


measurements in inches (mm)

Frontal view

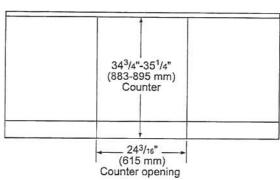

measurements in inches (mm)

GLASS DOOR WINE RESERVE CUTOUT DIMENSIONS & ELECTRICAL LOCATION

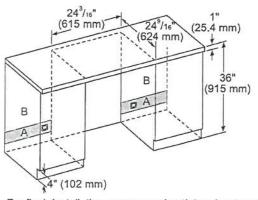

A: Recommended area for installation connection - a 2¹/2" (63 mm) diameter hole is recommended. Location of power cord at base of the appliance.

5¹/₈" (130 mm) † A A A (102 mm) † R:

B: It is recommended that the water connection is placed adjacent to the installation cavity, so that it can be accessed without uninstalling the appliance.

For flush installation, recommend outlet and water connection to be placed to the side of the unit and not directly behind.

measurements in inches (mm)

Page 2 of 3






T24UW910LS


UNDER-COUNTER WINE RESERVE WITH GLASS DOOR MASTERPIECE® SERIES HANDLE - LEFT HINGED



GLASS DOOR WINE RESERVE CUTOUT & DOOR SWING DIMENSIONS

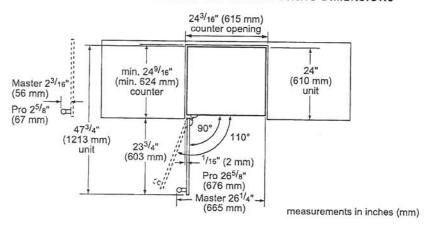

GLASS DOOR WINE RESERVE SIDE-BY-SIDE INSTALLATION

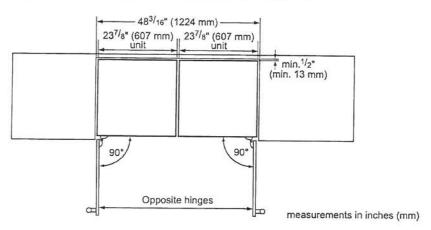

ACCESSORIES (OPTIONAL)

HANDLES

NOTE: Choose one handle for each glass door model, choose 2 handles for each double drawer model.



MS22HNDL20 22-Inch Masterpiece® Series Handle

These warranties give you specific legal rights and you may have other rights that vary from state to state. Full warranty and limited warranty from date of installation. For complete warranty details, refer to your Use & Care manual, or ask your dealer.

Specifications are for planning purposes only. Refer to installation instructions and consult your countertop supplier prior to making counter opening. Consult with a heating and ventilation engineer for your specific ventilation requirements. For the most detailed information, refer to installation instructions accompanying product or write to Thermador indicating the model number. Specifications are correct at time of printing. Thermador reserves the right to change product specifications or design without notice. Some models are certified for use in Canada. Thermador is not responsible for products that are transported from the U.S. for use in Canada.

1 800 735 4328 | USA THERMADOR.COM | CANADA THERMADOR CA | @2019 BSH HOME APPLIANCES CORPORATION. ALL RIGHTS RESERVED.

Page 3 of 3