


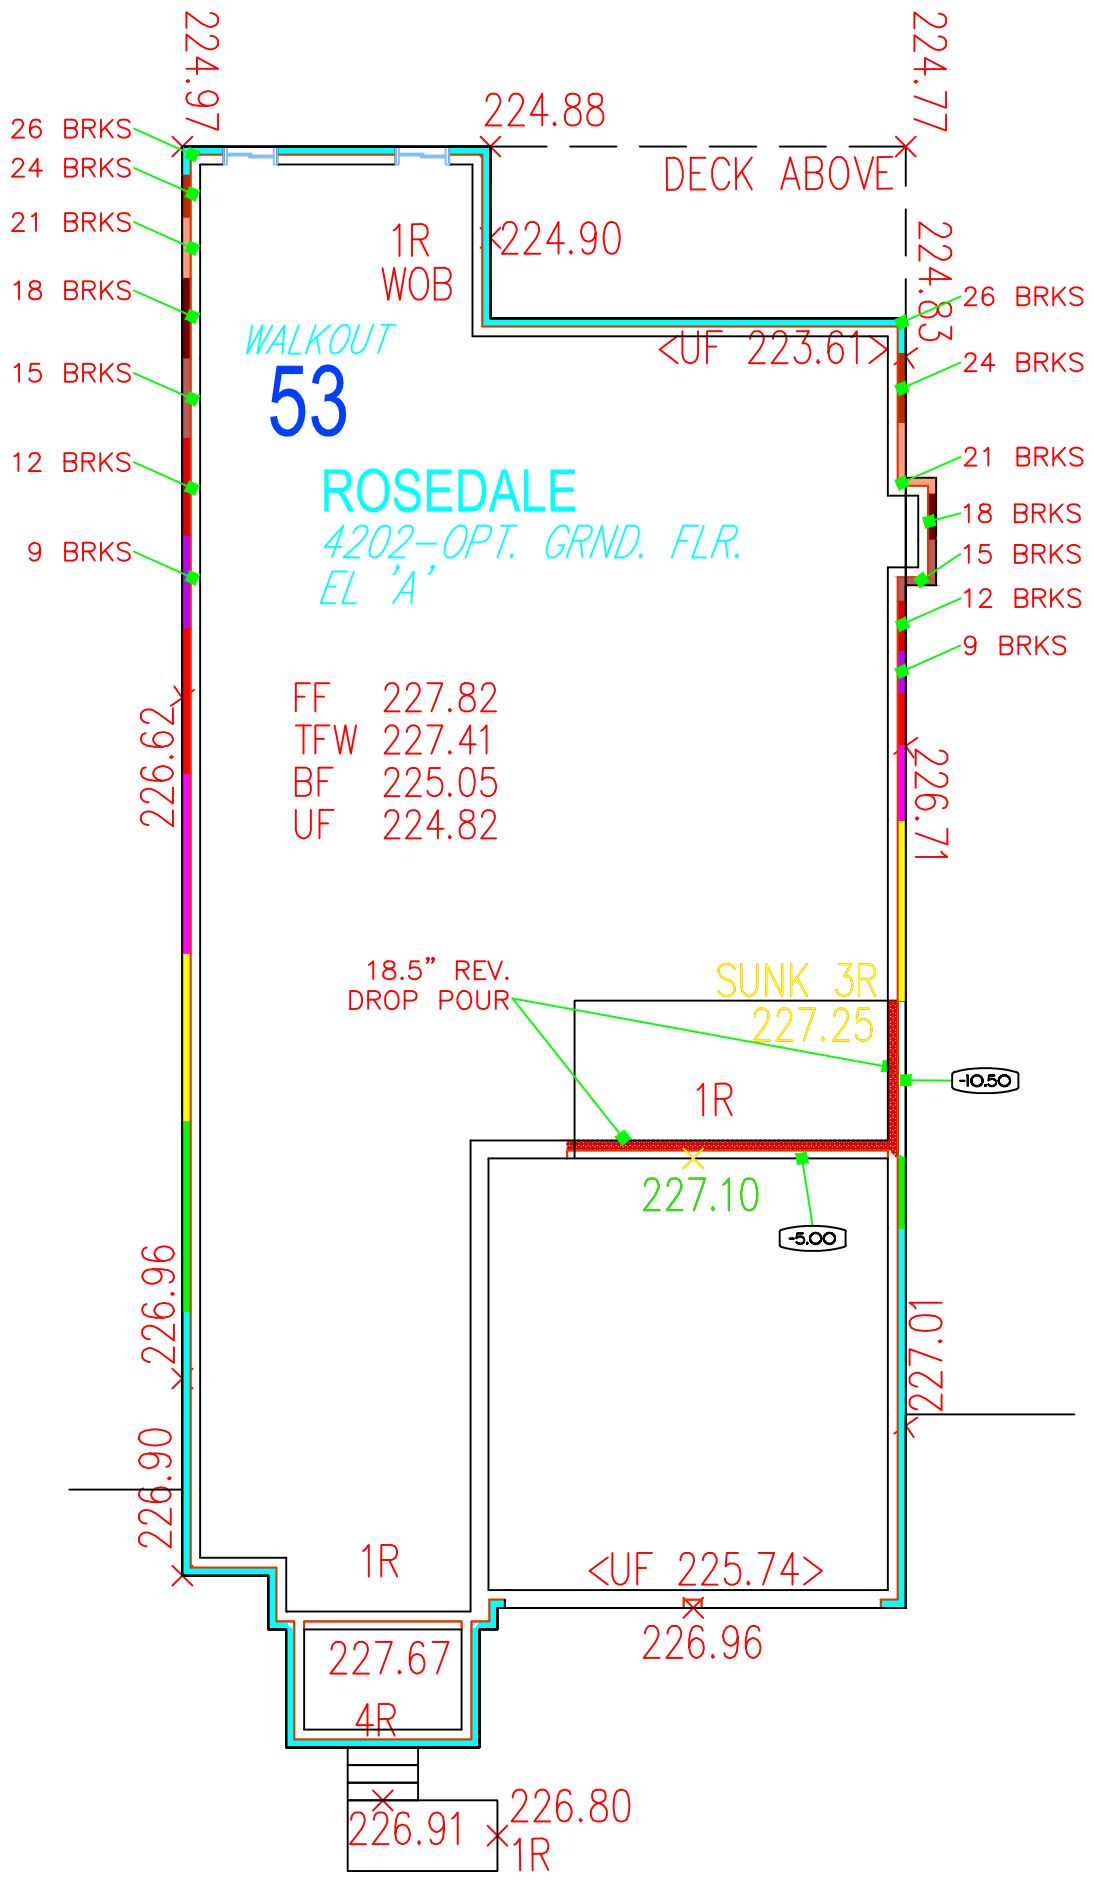

PLAN

Legend			
1 Brick (5")		Standard Wall	
2 Bricks (8.5")		Garage Wall	
3 Bricks (12")		1 Riser reverse	
4 Bricks (15.5")		2 Riser reverse	
5 Bricks (19")		3 Riser reverse	
6 Bricks (22.5")		4 Riser reverse	
7 Bricks (26")		Cut Pour	
8 Bricks (29.5")			

Site Name : Pine Valley		Job No.
Location : Vaughan, Ontario		
Date: 06/04/21		Lot # 53 REVISED
By : jamesp		Scale : n.t.s.

PHASE:		
Total Stone Area Sq. Ft. + 5% Waste = 26 SQFT		
Total Bricks + 4% Waste	1213	