

Lot: 10

Model: 40.03 B BROOKSIDE

Project/Phase: Pine Valley Forevergreen / 1

APPLIANCES

Invoice

2485 72,351

Invoice		Qty.	Description
2804	4	1	KITCHEN: APPLIANCE SPECIFICATIONS - SIGNED COPY ATTACHED
09Juni	21		
N	loCat		

BASEMENT WINDOWS - UPGRADE BASEMENT WINDOW SIZE TO 30 " X 24" - 8" FRAME

BASEMENT WINDOWS

Qty. Description

21Oct20		
CERAM Invoice		Description
2531 13Jan21 NoCat	1	MASTER ENSUITE: SHOWER NICHE [SHAMPOO SHELF] - COMPLETE WITH MATCHING MARBLE JAMBS ON 4 SIDES, STANDARD TILE, APPROX. 12 X 18 INSTALLED VERTICALLY - SEE PLAN FOR LOCATION
2766 37 31May21	1	FOYER: TILE, FLOOR - LEVEL 5 - 24x24" LAID IN STRAIGHT STACKED PATTERN
2766 37 31May21	1	POWDER ROOM: TILE, FLOOR - LEVEL 3 - 12x24" LAID IN STRAIGHT STACKED PATTERN - SEE PLAN FOR DIRECTION
2766 35 31May21	1	MUD ROOM: TILE, FLOOR - LEVEL 3 - 12x24" LAID IN STRAIGHT STACKED PATTERN - SEE PLAN FOR DIRECTION
2766 35 31May21	1	MASTER ENSUITE: TILE, FLOOR , LEVEL 3 - 12X24" LAID IN STRAIGHT, STACKED PATTERN. SEE PLAN FOR TILE DIRECTION.
2766 49 31May21	1	MASTER ENSUITE: TILE, WALL, LEVEL 3 - 12X24" LAID IN HORIZONTAL, STACKED PATTERN
2766 43 31May21	1	MASTER ENSUITE: TILE, SHOWER FLOOR, LEVEL 2 - HEX
2766 32 31May21	1	ENSUITE 2: TILE, FLOOR , LEVEL 1 - 12X24" LAID IN STRAIGHT, STACKED PATTERN. SEE PLAN FOR TILE DIRECTION.
2766 32 31May21	1	SHARED ENSUITE: TILE, FLOOR , LEVEL 1 - 12X24" LAID IN STRAIGHT, STACKED PATTERN. SEE PLAN FOR TILE DIRECTION.
2766 31May21 NoCat	1	KITCHEN/BREAKFAST: VINTAGE SERIES, 5" WHITE OAK, NSS ENGINEERED HARDWOOD, 3/4" THK, SCULPTED TEXTURE, UVF FINISH - LEVEL 4 KITCHEN/BREAKFAST: DO NOT SUPPLY/INSTALL CERAMIC - CREDIT

DisciplineMS.rpt 23feb21 Page 1 of 12



Lot: 10

Model: 40.03 B BROOKSIDE

Project/Phase: Pine Valley Forevergreen / 1

CONCI	PTT	AND	DRAIN
CONCI		AND	DIVAII

Invoice	Qty.	Description
2485	1	BACK-FLOW PREVENTER VALVE
21Oct20		
NoCat		

CRO	WN	MO	ULI	DING
-----	----	----	-----	------

0110 111	SHO WITH MODELD IT TO		
Invoice	Qty.	Description	
2531	1	GREAT ROOM: MODEL OPTIONS 40.03 - GREAT ROOM - OPT. WAFFLE CEILING , BEAM DETAIL AS PER PLAN (6 BOXES) OPTION # 1 CTR-B07	
13Jan21 NoCat			
2531	1	STUDY: MODEL OPTIONS 40.03 - STUDY- OPT. WAFFLE CEILING , BEAM DETAIL AS PER PLAN (4 BOXES) OPTION # 1 CTR-B07	
13Jan21 NoCat			

DisciplineMS.rpt 23feb21 Page 2 of 12



Lot: 10

Model: 40.03 B BROOKSIDE

Project/Phase: Pine Valley Forevergreen / 1

DRYWALL

DKYWA		
Invoice	Qty.	Description
2485 72,351 21Oct20 **	3	BASEMENT WINDOWS - UPGRADE BASEMENT WINDOW SIZE TO 30 " X 24" - 8" FRAME
2531 72,398 13Jan21	1	GREAT ROOM: MODEL OPTIONS 40.03 - GREAT ROOM - OPT. COFFERED CEILING AS PER PLAN
2531 72,397 13Jan21	1	GREAT ROOM: MODEL OPTIONS 40.03 - GREAT ROOM - OPT. WAFFLE CEILING , BEAM DETAIL AS PER PLAN (6 BOXES) OPTION # 1 CTR-B07
2531 72,401 13Jan21	1	STUDY: MODEL OPTIONS 40.03 - STUDY - OPT. COFFERED CEILING AS PER PLAN
2531 72,400 13Jan21	1	STUDY: MODEL OPTIONS 40.03 - STUDY- OPT. WAFFLE CEILING , BEAM DETAIL AS PER PLAN (4 BOXES) OPTION # 1 CTR-B07
2531 72,401 13Jan21	1	MAIN HALL: MODEL OPTIONS 40.03 - OPT. COFFERED CEILING AS PER PLAN
2531 13Jan21 NoCat	1	STUDY: MODEL OPTIONS 40.03 - STUDY - OPT. 8 FOOT HIGH DOUBLE FRENCH DOORS WITH FLAT CLEAR GLASS COMPLETE WITH BUILDERS STANDARD OFFERINGS
2531 13Jan21 NoCat	1	MASTER ENSUITE: SHOWER NICHE [SHAMPOO SHELF] - COMPLETE WITH MATCHING MARBLE JAMBS ON 4 SIDES, STANDARD TILE, APPROX. 12 X 18 INSTALLED VERTICALLY - SEE PLAN FOR LOCATION
2531 13Jan21 NoCat	1	BREAKFAST: UPGRADE TO 96" FRENCH DOOR ASSEMBLY
2531 13Jan21 NoCat	1	THRU OUT 2ND FLOOR: INCREASE HEIGHT OF DOOR TO 8FT SECOND FLOOR - PER DOOR

DisciplineMS.rpt 23feb21 Page 3 of 12

Printed and Sent: 09-Jun-21



Lot: 10

Model: 40.03 B BROOKSIDE

Project/Phase: Pine Valley Forevergreen / 1

ELECTRICAL

ELECTI Invoice	_	AL Description
2485 72,351 21Oct20 **	3	BASEMENT WINDOWS - UPGRADE BASEMENT WINDOW SIZE TO 30 " X 24" - 8" FRAME
2531 72,281 13Jan21	1	GREAT ROOM: INTERIOR WALL OUTLET: ADDITIONAL 110V WALL INTERIOR RECEPTACLE ON EXISTING CIRCUIT FOR WALL MOUNTED TV - LOCATE APPROX 66" A.F.F. ABOVE FIREPLACE
2531 72,289 13Jan21	6	GREAT ROOM: 4" E/S LED INTERIOR POT LIGHT - GROUND FLOOR - EACH, USE STANDARD SWITCH INCLUDED IN APS
2531 72,307 13Jan21	1	KITCHEN: FIXTURE: RELOCATE STANDARD CEILING MOUNT FIXTURE -LOCATE APPROX CENTERED ABOVE ISLAND, SEE PLAN FOR LOCATION
2531 72,280 13Jan21	1	KITCHEN: CEILING OUTLET: ADDITIONAL REINFORCED CEILING OUTLET - LOCATE APPROX CENTERED ABOVE ISLAND - USE SAME SWITCH AS STANDARD, SEE PLAN FOR LOCATION
2531 72,289 13Jan21	7	KITCHEN: 4" E/S LED INTERIOR POT LIGHT - GROUND FLOOR - EACH
2531 72,278 13Jan21	1	KITCHEN: ADDITIONAL INTERIOR SWITCH FOR POTLIGHTS
2531 72,303 13Jan21	1	KITCHEN: FIXTURE: UNDER CABINET FLUORESCENT LIGHT FIXTURES - DOES NOT INCLUDE (AND REQUIRES) LIGHT VALANCE
2531 72,282 13Jan21	1	KITCHEN: ADDITIONAL 220V RECEPTACLE ON A SEPARATE CIRCUIT - FOR BUILT-IN WALL OVEN - APPLIANCE NOT INCLUDED - DOES NOT INCLUDE BREAKER THAT IS TO BE INSTALLED BY LICENSED ELECTRICIAN AND ARRANGED BY HOMEOWNER AFTER CLOSING
2531 72,273 13Jan21	1	KITCHEN: 110V WALL RECEPTACLE ON SEPARATE CIRCUIT - GAS FIRED COOKTOP - FOR AUX. EQUIPMENT - NOT A STOVE PLUG
2531 72,289 13Jan21	4	BREAKFAST: 4" E/S LED INTERIOR POT LIGHT - GROUND FLOOR - EACH SEE PLAN FOR LOCATION
2531 72,278 13Jan21	1	BREAKFAST: ADDITIONAL INTERIOR SWITCH FOR POTLIGHTS
2531 72,289 13Jan21	4	DINING ROOM: 4" E/S LED INTERIOR POT LIGHT - GROUND FLOOR - EACH SEE PLAN FOR LOCATION

DisciplineMS.rpt 23feb21

Page 4 of 12

Printed and Sent: 09-Jun-21



Lot: 10

Model: 40.03 B BROOKSIDE

Project/Phase: Pine Valley Forevergreen / 1

ELECTRICAL

Invoice	Qty.	Description
2531 72,278	1	DINING ROOM: ADDITIONAL INTERIOR SWITCH
13Jan21		FOR POTLIGHTS
2531 72,290	6	UPPER HALL: 4" E/S LED INTERIOR POT LIGHT (INSULATED CEILING) - SECOND FLOOR - EACH
13Jan21		IN LIEU OF STANDARD CEILING LIGHTS, USE STANDARD SWITCHES
2804	1	KITCHEN: APPLIANCE SPECIFICATIONS - SIGNED COPY ATTACHED
09Jun21 NoCat		

DisciplineMS.rpt 23feb21 Page 5 of 12



Lot: 10

Model: 40.03 B BROOKSIDE

Project/Phase: Pine Valley Forevergreen / 1

FRAMING

Invoice	Qty.	Description
2531 72,631 13Jan21	1	MASTER ENSUITE: SHOWER NICHE [SHAMPOO SHELF] - COMPLETE WITH MATCHING MARBLE JAMBS ON 4 SIDES, STANDARD TILE, APPROX. 12 X 18 INSTALLED VERTICALLY - SEE PLAN FOR LOCATION
2531	1	GREAT ROOM: MODEL OPTIONS 40.03 - GREAT ROOM - OPT. COFFERED CEILING AS PER PLAN
13Jan21 NoCat		
2531	1	GREAT ROOM: MODEL OPTIONS 40.03 - GREAT ROOM - OPT. WAFFLE CEILING , BEAM DETAIL AS PER PLAN (6 BOXES) OPTION # 1 CTR-B07
13Jan21 NoCat		
2531	1	MASTER BEDROOM: MODEL OPTIONS 40.03 - MASTER BEDROOM - OPT. 10 FOOT TRAY CEILING
13Jan21 NoCat		
2531	1	STUDY: MODEL OPTIONS 40.03 - STUDY - OPT. COFFERED CEILING AS PER PLAN
13Jan21 NoCat		
2531	1	STUDY: MODEL OPTIONS 40.03 - STUDY- OPT. WAFFLE CEILING , BEAM DETAIL AS PER PLAN (4 BOXES) OPTION # 1 CTR-B07
13Jan21 NoCat		
2531	1	MAIN HALL: MODEL OPTIONS 40.03 - OPT. COFFERED CEILING AS PER PLAN
13Jan21 NoCat		
2531	1	STUDY: MODEL OPTIONS 40.03 - STUDY - OPT. 8 FOOT HIGH DOUBLE FRENCH DOORS WITH FLAT CLEAR GLASS COMPLETE WITH BUILDERS STANDARD OFFERINGS
13Jan21 NoCat		
2531	1	BREAKFAST: UPGRADE TO 96" FRENCH DOOR ASSEMBLY
13Jan21 NoCat		
2531	1	THRU OUT 2ND FLOOR: INCREASE HEIGHT OF DOOR TO 8FT SECOND FLOOR - PER DOOR
13Jan21 NoCat		

GLASS AND MIRROR

GLINDS	TT 11	Militor	
Invoice	Qty.	Description	
2766	2	MASTER ENSUITE + SHARED ENSUITE: UPGRADE SHOWER DOOR HANDLE	
31May21 NoCat			

DisciplineMS.rpt 23feb21 Page 6 of 12

Printed and Sent: 09-Jun-21



Lot: 10

Model: 40.03 B BROOKSIDE

Project/Phase: Pine Valley Forevergreen / 1

GRANITE MARBLE QUARTZ

Invoice		Description
2766	1	KITCHEN: UPGRADE QUARTZ COUNTERTOP - LEVEL 6
31May21 NoCat		
2766	1	KITCHEN: COOKTOP CUT OUT
31May21 NoCat		
2766	1	KITCHEN: UPGRADE TO 3CM COUNTERTOP THICKNESS
31May21 NoCat		
2766	1	POWDER ROOM: UPGRADE QUARTZ COUNTERTOP - LEVEL 4
31May21 NoCat		
2766	1	POWDER ROOM: UPGRADE TO 3CM COUNTERTOP THICKNESS
31May21 NoCat		
2766	1	MASTER ENSUITE: UPGRADE 3 QUARTZ COUNTER
31May21 NoCat		
2766	1	MASTER ENSUITE: UPGRADE QUARTZ THICKNESS TO 3CM
31May21 NoCat		
2766	1	ENSUITE 2: UPGRADE 1 QUARTZ COUNTER
31May21 NoCat		
2766	1	ENSUITE 2: UPGRADE COUNTER TOP THICKNESS TO 3CM
31May21 NoCat		
2766	1	SHARED ENSUITE: UPGRADE 1 QUARTZ COUNTER TOP
31May21 NoCat		
2766	1	SHARED ENSUITE: UPGRADE COUNTER TOP THICKNESS TO 3CM
31May21 NoCat		

DisciplineMS.rpt 23feb21 Page 7 of 12



Lot: 10

Model: 40.03 B BROOKSIDE

Project/Phase: Pine Valley Forevergreen / 1

HΑ	RD	W	0	Ω	D
		, , ,	v	V.	v

Invoice	Qty.	Description
2766 8 31May21	1	KITCHEN/BREAKFAST: VINTAGE SERIES, 5" WHITE OAK, NSS ENGINEERED HARDWOOD, 3/4" THK, SCULPTED TEXTURE, UVF FINISH - LEVEL 4
2766 7 31May21	1	THRU OUT STANDARD AREAS: MAIN HALL, GREAT ROOM, DINING ROOM, STUDY, UPPER HALL, MASTER BEDROOM, BEDROOM 2, BEDROOM 3, BEDROOM 4, LOWER MEDIA ROOM: VINTAGE SERIES, 5" WHITE OAK, NSS ENGINEERED HARDWOOD, 3/4" THK, SCULPTED TEXTURE, UVF FINISH - LEVEL 4

HVAC

Invoice	Qty.	Description
2531	1	KITCHEN: GAS LINE ROUGH-IN - MAIN FLOOR FOR COOKTOP
72,224		
13Jan21		

INTERIOR TRIM /MOULDINGS

Invoice	Qty.	Description
2485	3	BASEMENT WINDOWS - UPGRADE BASEMENT WINDOW SIZE TO 30 " X 24" - 8" FRAME
72,351		
21Oct20		
**		

INTERIOR TRIM AND DOORS

Invoice	Qty.	Description
2531	1	BREAKFAST: UPGRADE TO 96" FRENCH DOOR ASSEMBLY
13Jan21 NoCat		
2784 155,215	1	UPGRADE INTERIOR DOORS TO LOGAN
31May21		UPGRADE
2531 72,402 13Jan21	1	STUDY: MODEL OPTIONS 40.03 - STUDY - OPT. 8 FOOT HIGH DOUBLE FRENCH DOORS WITH FLAT CLEAR GLASS COMPLETE WITH BUILDERS STANDARD OFFERINGS
2531 72,644 13Jan21	16	THRU OUT 2ND FLOOR: INCREASE HEIGHT OF DOOR TO 8FT SECOND FLOOR - PER DOOR

DisciplineMS.rpt 23feb21 Page 8 of 12

Printed and Sent: 09-Jun-21



Lot: 10

Model: 40.03 B BROOKSIDE

Project/Phase: Pine Valley Forevergreen / 1

KITCHEN AND BATH CABINETRY

Invoice	Qty.	Description
2531	1	KITCHEN: FIXTURE: UNDER CABINET FLUORESCENT LIGHT FIXTURES - DOES NOT INCLUDE (AND REQUIRES) LIGHT VALANCE
13Jan21 NoCat		
2531	1	KITCHEN: GAS LINE ROUGH-IN - MAIN FLOOR FOR COOKTOP
13Jan21 NoCat		
2766	1	THRU OUT: SEE ATTACHED CABINETRY SCHEDULE
31May21 NoCat		
2804	1	KITCHEN: APPLIANCE SPECIFICATIONS - SIGNED COPY ATTACHED
09Jun21 NoCat		

MASONRY

MASONIL		
Invoice	Qty.	Description
2531	1	BREAKFAST: UPGRADE TO 96" FRENCH DOOR ASSEMBLY
13Jan21 NoCat		

NETWO	NETWORK AND WIRING		
Invoice	Qty.	Description	
2531 72,259 13Jan21	1	GREAT ROOM: CONDUIT PIPE - FOR WALL MOUNT TV - LOCATE APPROX 66" A.F.F. ABOVE FIREPLACE, TERMINATING AT CABLE LOCATION - SEE PLAN	
2531 72,258 13Jan21	1	GREAT ROOM: ADDITIONAL CAT6 ETHERNET OUTLET - EACH, SEE PLAN FOR LOCATION	

DisciplineMS.rpt 23feb21 Page 9 of 12



Lot: 10

Model: 40.03 B BROOKSIDE

Project/Phase: Pine Valley Forevergreen / 1

P	٨	INT	

PAINT Invoice	Qty.	Description
2531	1	GREAT ROOM: MODEL OPTIONS 40.03 - GREAT ROOM - OPT. COFFERED CEILING AS PER PLAN
13Jan21 NoCat		
2531	1	GREAT ROOM: MODEL OPTIONS 40.03 - GREAT ROOM - OPT. WAFFLE CEILING , BEAM DETAIL AS PER PLAN (6 BOXES) OPTION # 1 CTR-B07
13Jan21 NoCat		
2531	1	MASTER BEDROOM: MODEL OPTIONS 40.03 - MASTER BEDROOM - OPT. 10 FOOT TRAY CEILING
13Jan21 NoCat		
2531	1	STUDY: MODEL OPTIONS 40.03 - STUDY - OPT. COFFERED CEILING AS PER PLAN
13Jan21 NoCat		
2531	1	STUDY: MODEL OPTIONS 40.03 - STUDY- OPT. WAFFLE CEILING , BEAM DETAIL AS PER PLAN (4 BOXES) OPTION # 1 CTR-B07
13Jan21 NoCat		
2531	1	MAIN HALL: MODEL OPTIONS 40.03 - OPT. COFFERED CEILING AS PER PLAN
13Jan21 NoCat		
2531	1	STUDY: MODEL OPTIONS 40.03 - STUDY - OPT. 8 FOOT HIGH DOUBLE FRENCH DOORS WITH FLAT CLEAR GLASS COMPLETE WITH BUILDERS STANDARD OFFERINGS
13Jan21 NoCat		
2531	1	BREAKFAST: UPGRADE TO 96" FRENCH DOOR ASSEMBLY
13Jan21 NoCat		
2531	1	THRU OUT 2ND FLOOR: INCREASE HEIGHT OF DOOR TO 8FT SECOND FLOOR - PER DOOR
13Jan21 NoCat		
2766	2	MAIN STAIRS - 2ND FLOOR TO BASEMENT: STAIN STAIRS AND LANDINGS
31May21 NoCat		STAIRS AND LANDINGS WILL NOT MATCH HARDWOOD FLOORS IN COLOUR/TEXTURE/SPECIES

DisciplineMS.rpt 23feb21 Page 10 of 12

Printed and Sent: 09-Jun-21



Lot: 10

Model: 40.03 B BROOKSIDE

 $\label{lem:project/Phase: Pine Valley Forevergreen / 1} Project/Phase: Pine Valley Forevergreen / 1$

PLUMBING

Invoice	Qty.	Description
2531 72,346	1	KITCHEN: ADD POT FILLER MOEN 'MODERN' CHROME
13Jan21		ROUGH IN INCLUDED
2531	1	KITCHEN: ROUGH-IN 1/4" COLD WATER LINE TO FRIDGE
72,332		
13Jan21		
2531	1	MASTER ENSUITE: MOEN 'ALIGN' RAIN SHOWER (from ceiling) + HAND SHOWER w/ SLIDE BAR - CHROME
13Jan21 NoCat		
2766	1	KITCHEN: UPGRADE SINK TO BLANCO QUATRUS SUPER SINGLE
31May21		

STAIR AND RAILINGS

Invoice	Qty.	Description
2784 93,782 31May21		UPGRADE - EURONLINE (ALL PLAIN) PICKET, 3" HALF-ROUND W/V-GROOVE HANDRAIL, 3 1/2" ALL SQUARE POST WITH PYRAMID TOP POST CAP - PACKAGE A-2

WINDOWS AND DOORS

Invoice	Qty.	Description
2485	3	BASEMENT WINDOWS - UPGRADE BASEMENT WINDOW SIZE TO 30 " X 24" - 8" FRAME
72,351		
21Oct20 **		

DisciplineMS.rpt 23feb21 Page 11 of 12



Lot: 10

Model: 40.03 B BROOKSIDE

Project/Phase: Pine Valley Forevergreen / 1

WINDOWS AND DOORS

Invoice	Qty.	Description
2531	1	THRU OUT: UPGRADE TO BLACK INTERIOR WINDOWS
13Jan21		
NoCat		
2531	1	BREAKFAST: UPGRADE TO 96" FRENCH DOOR ASSEMBLY
13Jan21		
NoCat		

DisciplineMS.rpt 23feb21 Page 12 of 12

36" Induction Cooktop







800 Series - Black NIT8669UC



NIT8669UC Black

Also available in:

Black with NIT8669SUC Stainless Steel Frame

The 800 Series induction cooktop is sleek in design, and features AutoChef® technology which maintains precise cooking temperatures.

Features & Benefits

Induction – faster than gas and electric cooktops. Precise cooking, easy cleaning and more convenience

AutoChef® – regulates temperatures continuously during frying and adjusts them as needed

12" dual-ring center cooking zone for large pots and pans

Home Connect™ – the easy way to connect your smart device with your Bosch cooktop

Hood Control – convenient operation of the Home Connect™ enabled ventilation via your cooktop

Element Performance	STATE OF THE PARTY
Power of Front Left heating element	1,800 W
Power of Front Left heating element (in boost)	3,100 W
Power of Back Left heating element	1,800 W
Power of Back Left heating element (in boost)	3,100 W
Power of Center heating element	3,300 / 2,200 W
Power of Center heating element (in boost)	5,400 / 3,700 W
Power of Back Right heating element	1,400 W
Power of Back Right heating element (in boost)	2,200 W
Power of Front Right heating element	2,200 W
Power of Front Right heating element (in boost)	3,700 W
Burners with booster	All
Element Size	
Dimension of Front Left heating element	7"
Dimension of Back Left heating element	7"
Dimension of Center heating element	12", 9"
Dimension of Back Right heating element	6"
Dimension of Front Right heating element	9"

General Properties	
Home Connect™ (Wi-Fi Enabled)	Yes
Controls	PreciseSelect® Touch
Technical Details	AND REPORT OF
Watts	9,600 W
Circuit breaker	40 A
Volts	208-240 V
Frequency	60 Hz
Plug type	No plug
Power cord length	37"
Energy source	Electric
Dimensions & Weight	No and the same of
Overall appliance dimensions (HxWxD)	5/16" +4 1/8" x 37" x 21 1/4"
Required cutout size (HxWxD)	4 1/8" x 34 7/8" x 20"
Minimum distance from counter front	2 1/4"
Minimum distance from rear wall	2"
Net weight	53 lbs
Accessories-Optional	
(C)	6
HEZ390210 8" AutoChef® pan	HEZ390220 9" AutoChef® pan
HEZ3902	

10" AutoChef® pan





Accessories: To purchase Bosch accessories, cleaners & parts please visit www.bosch-home.com/us/store or call 1-800-944-2904 (Mon to Fri 5 am to 6 pm PST, Sat 6 am to 3 pm PST). Notes: All height, width and depth dimensions are shown in inches. BSH reserves the absolute and unrestricted right to change product materials and specifications, at any time, without notice. Consult the product's installation instructions for final dimensional data and other details prior to making cutout.

Warranties: Please see Use & Care manual or Bosch website for statement of limited warranty.

For more information on our entire line of products, go to www.bosch-home.com/us or call 1-800-944-2904

For more information on our entire line of products, go to www.bosch-home.com/us or call 1-800-944-2904

© BSH Home Appliances Corporation. All rights reserved. Bosch is a registered trademark of Robert Bosch GmbH.


36" Induction Cooktop


800 Series - Black NIT8669UC






Installation Details

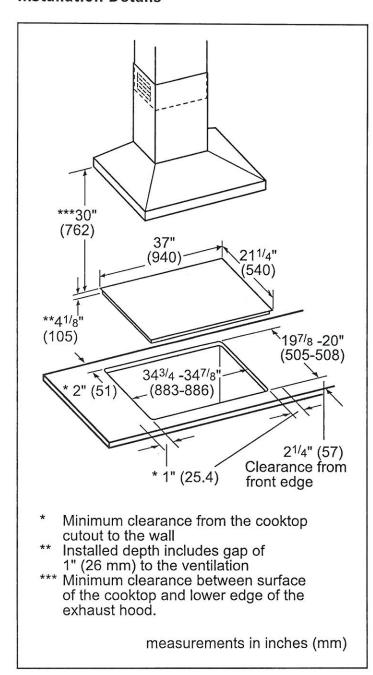

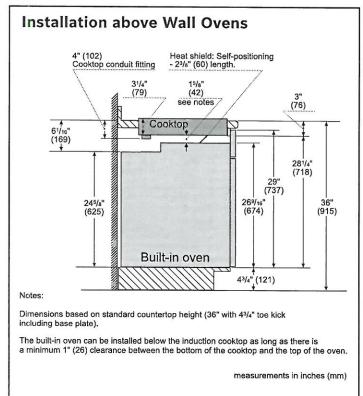

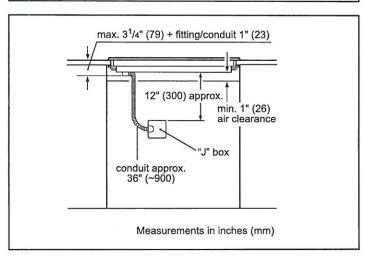

Accessories: To purchase Bosch accessories, cleaners & parts please visit www.bosch-home.com/us/store or call 1-800-944-2904 (Mon to Fri 5 am to 6 pm PST, Sat 6 am to 3 pm PST). Notes: All height, width and depth dimensions are shown in inches. BSH reserves the absolute and unrestricted right to change product materials and specifications, at any time, without notice. Consult the product's installation instructions for final dimensional data and other details prior to making cutout.

Warranties: Please see Use & Care manual or Bosch website for statement of limited warranty.

For more information on our entire line of products, go to www.bosch-home.com/us or call 1-800-944-2904 © BSH Home Appliances Corporation. All rights reserved. Bosch is a registered trademark of Robert Bosch GmbH.

24" Speed Oven











HMC54151UC Stainless Steel

The 24" speed oven pairs the cooking qualities of a conventional oven with the speed of a microwave, designed for smaller spaces.

Features & Benefits

SpeedChef® cooking modes offer faster cooking times for your convenience.

Installs flush with kitchen cabinetry.

2-in-1 microwave and convection oven for a variety of cooking options.

Electrical connection -120 Volt NEMA 5-20 three prong plug.

General Properties	(Dec 10 2 4)
Cavity material	Stainless steel
Max. microwave power (W)	1,000 W
Capacity	型 经营业
Cavity capacity (cu. ft.)	1.6
Turntable diameter (in.)	14 3/16"
Technical Details	
Watts (W)	1,920 W
Circuit breaker (A)	20 A
Volts (V)	120 V
Frequency (Hz)	60 Hz
Power cord length (in)	48"
Plug type	NEMA 5-20 — 3 prong plug

Dimensions & Weight	Per Maria de la companya de la comp
Overall appliance dimensions (HxWxD) (in)	17 7/8" x 23 7/16" x 22 1/16"
Required cutout size (HxWxD) (in)	(Standard) 17 3/4" x 22 5/16" x 22"
	(Flush) 18 7/16" x 24" x 22 3/4"
Oven overall interior dimensions (HxWxD) (in.)	9 7/8" x 16 1/2" x 16 1/2"
Turntable – Metal Max. Cookware	12 3/4" dia.
Turntable – Ceramic Max. Cookware	12 1/2" dia.
Rack – Rectangular Cookware Max.	15" × 12"
Net weight (lbs)	83 lbs.
Accessories-Included	NEWS TRANSPORTER
Included	Metal turntable, cooking rack, ceramic cooking tray





Accessories: To purchase Bosch accessories, cleaners & parts please visit www.bosch-home.com/us/store or call 1-800-944-2904 (Mon to Fri 5 am to 6 pm PST, Sat 6 am to 3 pm PST). Notes: All height, width and depth dimensions are shown in inches. BSH reserves the absolute and unrestricted right to change product materials and specifications, at any time, without notice. Consult the product's installation instructions for final dimensional data and other details prior to making cutout.

Warranties: Please see Use & Care manual or Bosch website for statement of limited warranty.

For more information on our entire line of products, go to www.bosch-home.com/us or call 1-800-944-2904

© BSH Home Appliances Corporation. All rights reserved. Bosch is a registered trademark of Robert Bosch GmbH.


24" Speed Oven




500 Series - Stainless Steel HMC54151UC



Installation Details

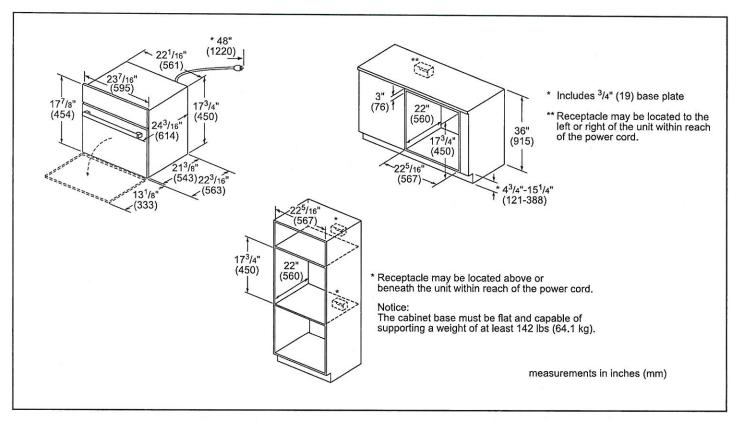

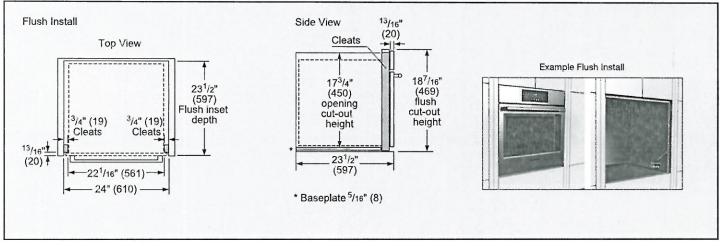

Accessories: To purchase Bosch accessories, cleaners & parts please visit www.bosch-home.com/us/store or call 1-800-944-2904 (Mon to Fri 5 am to 6 pm PST, Sat 6 am to 3 pm PST). Notes: All height, width and depth dimensions are shown in inches. BSH reserves the absolute and unrestricted right to change product materials and specifications, at any time, without notice. Consult the product's installation instructions for final dimensional data and other details prior to making cutout.

Warranties: Please see Use & Care manual or Bosch website for statement of limited warranty.

For more information on our entire line of products, go to www.bosch-home.com/us or call 1-800-944-2904

For more information on our entire line of products, go to www.bosch-home.com/us or call 1-800-944-2904


BSH Home Appliances Corporation. All rights reserved. Bosch is a registered trademark of Robert Bosch GmbH.

RF24R7201SR



SAMSUNG

23 cu. ft. Counter Depth, 4-Door French Door Refrigerator

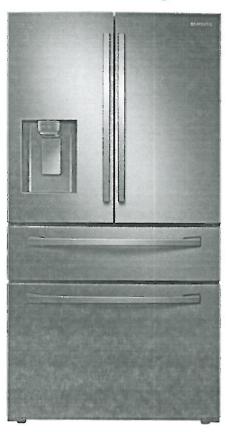

Signature Features

FlexZone™ Drawer

A flexible storage drawer with four different temperature settings and an adjustable Smart Divider to stay organized.

Fingerprint Resistant

A special finish to reduce smudges and minimize cleaning.

Wi-Fi and Bixby Enabled

Use your smartphone to control the temperature and monitor your refrigerator remotely.

Available Colors



Fingerprint Resistant Stainless Steel (shown)



Fingerprint Resistant Black Stainless Steel



Fingerprint Resistant Tuscan Stainless Steel



French Door Design



FlexZone™ Drawer

Convenience

- FlexZone™ Drawer with 4 Temperature Settings and Smart Divider
- Adjustable Shelves for Tall Oversized Items
- Auto Pull-Out Upper Freezer Drawer
- Water Filter Indicator

Design

- Counter Depth
- Modern External Filtered Water and Ice Dispenser
- High Efficiency LED Lighting
- Accessibility (ADA Compliant)
- EZ-Open Handle™ on Freezer Door and FlexZone™ Drawer
- Tempered Glass Spill-Proof Shelves
- Gallon Door Bins
- Dispenser Light

Performance

- Twin Cooling Plus®
- Ice Max Stores up to 2.7 lbs of ice
- Energy Star® Compliant
- Power Freeze and Power Cool Options
- Two Humidity-Controlled Crispers
- CoolTight Door
- Door Alarm

Rating



ENERGY STAR® rated: 690 kWh/yr



SAMSUNG

RF24R7201SR


23 cu. ft. Counter Depth, 4-Door French Door Refrigerator

Installation Specifications


- Measure the height, width and depth of the opening, making sure to include baseboards, molding tile, countertop overhang, etc. Check to be sure there is enough room to open the door (consider walls, islands or other obstacles when measuring).
- 2. Refer to illustration below to determine dimensions.
- 3. Allow 2.5" of clearance on hinge side of refrigerator when installing next to a wall where handle may make contact.
- 4. Allow 1" minimum clearance at rear for proper air circulation and water/electrical connections. Allow a 3/8" minimum clearance at sides and top for ease of installation.
- Ensure each door and entryway in the home is wide enough for the refrigerator to be moved through easily.

For optimal usage and to be able to open refrigerator doors completely, do not install next to a wall.

Please note: The following dimension and cutout information is for planning purposes only. For complete installation details, consult manual packed with product, or download manual online at samsung.com.

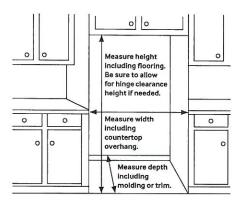

Dimensions

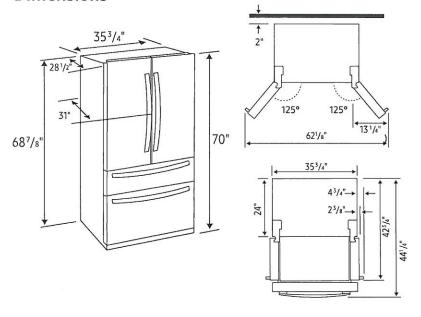

Total Capacity: 22.6 cu. ft.

Refrigerator: 13.0 cu. ft.

- Modern External Filtered Water and Ice Dispenser -Crushed or Cubed Ice
- Ice Max
- High Efficiency LED Lighting
- 2 Humidity-Controlled Crispers
- 5 Tempered Glass Spill-Proof Shelves
 - 1 Slide-In/Flip-Up, 1 Flip-Up, 1 Full Width, 2 Fixed
- 6 Clear Door Bins
- Right Door: 3 Gallon Bins
- Left Door: 3 Regular Bins

FlexZone™ Drawer: 3.1 cu. ft.

- EZ-Open Handle™
- 4 Temperature Zones with Smart Divider:
- Meat/Fish (29°F)
- Cold Drinks (33°F)
- Deli/Snacks (37°F)
- Wine/Party Dishes (42°F)

Freezer: 6.5 cu. ft.

- 1 Large Guard Freezer Bin
- Auto-Out Upper Drawer
- High Efficiency LED Lighting
- EZ-Open Handle™

Warranty

One (1) Year Parts and Labor on Refrigerator Five (5) Years Parts and Labor on Sealed Refrigeration System Only*
Ten (10) Years Parts and Five (5) Years Labor on Digital Inverter Compressor *Compressor, evaporator, condenser, drier and connecting tubing.

Product Dimensions & Weight

Dimensions (WxHxD with hinges, handles and doors): $35^{3}/_{4}$ " x 70" x 31"

Dimensions (WxHxD without hinges and door): $35^3/_4$ " x $68^7/_8$ " x $24^1/_2$ "

Dimensions (WxHxD with hinges and door, no handle): $35^3/_4$ " x 70" x $28^1/_2$ "

Weight: 315 lbs

Shipping Dimensions & Weight (WxHxD)

Dimensions: $38^{1}/_{4}$ " x $75^{3}/_{4}$ " x $30^{5}/_{8}$ "

Weight: 337 lbs

Color

Fingerprint Resistant Stainless Steel	RF24R7201SR	887276304892
Fingerprint Resistant Black Stainless Steel	RF24R7201SG	887276304885
Fingerprint Resistant Tuscan Stainless Steel	RF24R7201DT	887276304878

Model#

UPC Code

Actual color may vary. Design, specifications, and color availability are subject to change without notice. Non-metric weights and measurements are approximate.

©2019 Samsung Electronics America, Inc., 85 Challenger Road, Ridgefield Park, NJ 07660. Tel: 800-SAMSUNG. samsung.com. Samsung is a registered trademark of Samsung Electronics Co., Ltd.

36" Induction Cooktop

800 Series - Black NIT8669UC







BOSCH Invented for life





NITB669UC Black

Also available in:
Black with NIT866S
Stainloss
Steel Frame

The 800 Series inductio cooktop is steek in desting and features AutoChef® technology which maintains precise cooki


Induction – faster than gas and electric cooktops. Precise cooking, easy cleaning and more convenience.

AutoChef* – regulates temperatures continuously during frying and adjusts them as needed.

12* dual-ring conter cooking zone for large pots and pans.

Home Connect** – the easy way to connect your smart device with your Basch cooking.

Hood Control – convenient operation of the Home Connect** enabled ventilation way your cooking.

Pawer of Front Left heating element	T,800 W	Home Connect** (Wi-Fi Enabled)	Yes
Power of Front Left heating cloment	3,100 W	Controls	PrecisaSelect*
Down of Book I of		"Gerboried Derank	THE PERSON NAMED IN
heating element	1,800 W	Watts	9,800 W
Power of Back Left	3,100 W	Circuit breaker	40 A
(in boost)		Volts	208-240 V
Power of Center heating 3 300 / 2 200 w	3 300 / 2 700 W	Frequency	2H 09
element		Plug type	No plug
Power of Center heating 5,400 / 3,700 W	5,400 / 3,700 W	Power cord length	37
greatent (in goost)		Energy source	Elertric
heating element	1,400 W	Metals were	Constant Control
Power of Back Right heating element	2,200 W	Overall appliance dimensions (HxWxD)	5/16" +4 1/8" y 37" x 21 1/4"
(in boost) Power of Front Right	2,200 W	Required cutout size (HxWxD)	4 1/8" × 34 7/8" × 20"
	3,700 W	Minimum distance from counter front	2 1/4"
		Minimum distance from	2,

of pan	10" AutoChefe pan	91	Dimension of Front Right 9" heating cloment	
9		q	Dimension of Back Right 6" heating element	7
9" AutoChef" p	8" Autochef* par	12", 9"	Dimension of Center heating element	
MCCOOLCEN.	HE7390210	7**	Dimension of Back Left heating element	1 6
A		71	Dimension of Front Left heating element	1
	accesseries Optional	Spirite library	artinent's	7/00
53 lbs	Net weight	All	Burners with booster	
7,	Minimum distance from rear wall		(in boost)	1
	Countries trout	3,700 W	Power of Front Right	











36" Induction Cooktop


800 Series - Black NIT8669UC








Installation Details

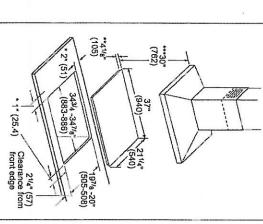




Minimum clearance from the cooktop culout to the wall
 Installed depth includes gap of 1" (26 mm) to the ventilation
 Minimum clearance between surface of the cooktop and lower edge of the exhaust hood.

measurements in inches (mm)

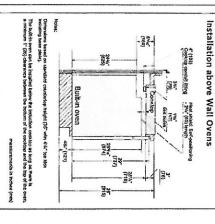

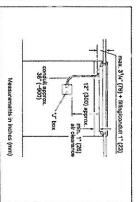




Best Home Appliances Corporation, All rights reserved. Bodo's it segitates of trademark of Booth Gooth.

500 Series - Stainless Steel HMC54151UC

BOSCH invented for life



HMC54151UC Stainless Steel

The 24" speed oven pairs the cooking qualities of a conventional oven with the speed of a microwave, designed for smaller spaces.

Speed Chef* cooking modes offer faster cooking inness for your convenience.

Installs flish with kitchen cabinetry.

2-in-1 microware and convection over for a variety of cooking options.

Electrical connection - 120 Voit NEMA 5-20 three prong plug.

Stainless steel	Cavity canacity (cu. ft.) 1.6	Max. microwave power (W)	Cavity material	विद्यासम्बद्धाः । त्रामाना
Stainless steel 1,000 W		Ğ	ĺ	B
	1.6	1,000 W	Stainless steel	THE REAL PROPERTY.

Cavity ca	Option .	1111
pacity	D	ł
y (cu. ft.)	RESERVE	-
1.6	No.	
		ŀ
		-

Watts (W	UH TOURIE	Turntable
_	Options.	urntable diameter (in.
1,920 W	18.00) 14 3/16"

1,920 W 20 A 120 V	Frequency (Hz)	Volts (V)	Circuit breaker (A)	Watts (W)	Sugar dependent
- 19	SH 09	120 V	20 A	1,920 W	100 Car 1874

Watts (W) 1.920 W Circuit breaker (A) 20 A Voits (V) 120 V Frequency (Hz) 60 Hz Power cord length (In) 48* Plug type Power prong plug

Watts (W) Circuit breaker (A)	1,920 W
Circuit breaker (A)	20 A
Volts (V)	120 V
Frequency (Hz)	60 Hz
Power cord length (in)	48

Diggrisjon: & Weight	
Overall appliance dimensions (HxWxD) (in)	17 7/8" x 23 7/16 x 22 1/16"
Required cutout size (HxWxD) (In)	(Standard) 17 3/4 × 22 5/15" × 22"
	(Flush) 18 7/16" , 24" x 22 3/4"
Oven overall interior dimensions (HxWxD)	9 7/8" x 16 1/2" x 16 1/2"

		1				
Included	here, order-hadeders	Net weight (lbs)	Rack – Rectangular Cookware Max.	Turntable - Ceramic Max. Cookware	Turntable - Metal Max. Cookware	(in.)
Metal turntable, cooking rack, ceramic cooking tray		83 lbs	15" × 12"	12 1/2" dia.	12 3/4" dia	10 2/2






500 Series - Stainless Steel HMC54151UC



BOSCH Invented for life

Installation Details

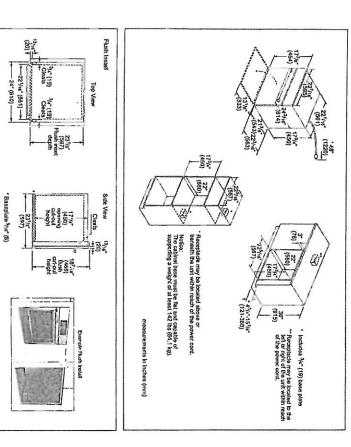




RF24R720ISR



23 cu. ft. Counter Depth, 4-Door

French Door Refrigerator

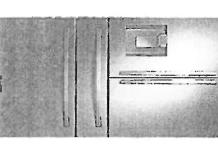

Available Colors

















- Convenience

 FlexZone** Drawer with

 Temperature Settings
 and Smart Divider

 Adjustable Shelves for Tall
 Oversized Items
- Auta Pull-Out Upper Freezer Drawer
- Water Filter Indicator
- Design

 Counter Depth

 Counter Depth

 Modern External Filtered Water
 and Ice Dispenser

 High Efficiency LED Lighting

 Accessibility (ADA Compilant)

 EX-Open Handle* on Freezer Door
 and FlexZone* Drawer

 Iempered Glass Spill-Proof Shelves

 Gallon Door Bins

 Dispenser Light

 Door Alarm CoolTight Door

 Two Humidity-Controlled Crispers Power Freeze and Power Cool Options Energy Star* Compliant ice Max - Stores up to 2.7 lbs of ice Twin Cooling Plus® Performance

690 kWh/yr

SAMSUNG

Signature Features

FlexZone[™] Drawer

A flexible storage drawor with four different temperature settings and an adjustable Smart Divider to stay organized.

Fingerprint Resistant A special finish to reduce smudges and minimize cleaning.

Wi-Fl and Bixby Enabled

Use your smartphone to control the temperature and monitor your refrigerator remotely.





SAMSUNG

23 cu. ft. Counter Depth, 4-Door French Door Refrigerator

Installation Specifications


- 1. Assaure the height, width and depth of the opening, making sure to include baseboards, modified the contemptor perhaps, etc. Check to be sure their is exually room to open the door (consider walls, islands or other obstactes when measuring).
- 2. Refer to Illustration below to determine dimensions.
- Allow 2.5° of clearance on hinge side of reirigerator when installing next to a wall where handle may make contact.
- A. Allow 1" minimum clearance at rear for proper air ctroulation and water/electrical connections. Allow a 3/8" minimum clearance at sides and top for ease of installation.
- Ensure each door and entryway in the home is wide enough for the refrigerator to be moved through easily.

For optimal usage and to be able to open refrigerator doors completely, do not install next to a wall.

se note: The following dimension and cutout information is for planning purposes only, complete installation debaits, consult manual packed with product, or download manual



Dimensions

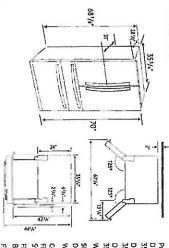

Total Capacity: 22.6 cu. ft.

- Refrigerator: 13.0 cu, ft.

 * Modern External Filtered Water and Ice Dispenser Crushed or Cubed Ice

- Ice Max
 High Efficiency LED Lighting
 2 Humidity-Controlled Crispers
 5 Tempered Glass Spill-Proof Shelves
 1 Side-In/Flip-Up, 1 Flip-Up, 1 Full Width, 2 Fixed
 6 Clear Door Bins
 Right Door: 3 Gallon Bins
 Left Door: 3 Regular Bins
- FlexZone Drawer: 3.1 cu. ft.EZ-Open Handle

- 4 Temperature Zones with Smart Divider:

 Meat/Fish (29°F)

 Cold Orinks (33°F)

 Dell/Snacks (37°F)

 Wine/Party Dishes (42°F)
- Freezer: 6.5 cu. ft.

 1 Large Guard Freezer Bin

 Auto-Out Upper Drawer

 High Efficiency LED Lighting

 EZ-Open Handle

Warranty
One (1) Year Parts and Labor on Refrigerator
Five (5) Years Parts and Labor on
Sealed Refrigeration System Only*
Ten (10) Years Parts and Five (5) Years
Labor on Digital Inverter Compressor
Labor on Digital Inverter Compressor

Product Dimensions & Weight Dimensions (WxHxD with hinges, handles and doors): $35^3 I_n^{\infty} \times 70^{\circ} \times 31^{\circ}$

Dimensions (WxHxD with hinges and door, no handle): $35^3/\iota^* \times 70^* \times 28^3/\imath^*$ Dimensions (WxHxD without hinges and door): $35^3/_* \times 68^7/_* \times 24^7/_*$

Shipping Dimensions & Weight (WxHxD)
Dimensions: 381/4" x 751/4" x 301/4" Weight: 315 lbs

Weight: 337 lbs

Fingerprint Resistant Black Stainless Steel Fingerprint Resistant RF24R7201SR Stainless Steel Fingerprint Resistant RF24R7201DT Tuscan Stainless Steel Model# 887276304878 887276304885 887276304892




PV - 10 Cabinetry Schedule

ROOM	DESCRIPTION	PRICE QTY	TOTAL
KITCHEN	UPGRADE FROM SERIES 2 TO SERIES 5 - MEDIO 6 OYSTER		
NI GITEIT	ADD CABINETRY VALANCE ONLY - ELECTRICAL INCLUDED IN APS	1	
	ADJUST BASE CABINETS FOR 36" COOKTOP (N/C)	1	
	LEAVE 42" SPACE IN UPPER CABINETS FOR FUTURE 36" CHIMNEY (N/C)	1	
	ADD BASE POTS AND PANS BELOW COOKTOP	1	
	ADD SPICE PULL OUT ACCESSORY TO BASE CABINETS FLANKING COOKTOP	2	
	CONVERT BASE CABINETS TO BASE POTS AND PANS DRAWERS	2	
	CONVERT CABINETRY TO TALL, DEEP BUILT IN COMBO OVEN UNIT WITH DRAWER		
	BELOW	1	
	ADD TWO-BIN RECYCLE PULL OUT	1	
SLAND	UPGRADE FROM SERIES 2 TO SERIES 6 - MEDIO 6 MIDNIGHT BLUE	1	
	RELOCATE STANDARD BANK OF 4 DRAWERS TO ISLAND (N/C)	1	
	ADD OVERSIZED DÉCORATIVE PANELS TO SIDES OF ISLAND	2	
	ADD PROUD FURNITURE KICK TO SIDES + REAR ISLAND	1	
MASTER	UPGRADE FROM SERIES 2 TO SERIES 6 - MEDIO 6 MIDNIGHT BLUE	1	
	CARINETI	RY TOTAL:	

***NO HARDWARE OR HOLES THRU OUT: HOMEOWNER IS RESPONSIBLE FOR THE INSTALLATION OF THEIR OWN HARDWARE AFTER CLOSING AT THEIR OWN

EXPENSE AND WARRANTY***

LOT #: PV-10 DATE: May 21, 2021	
SIGNATURE:	
SIGNATURE: O Clear len	

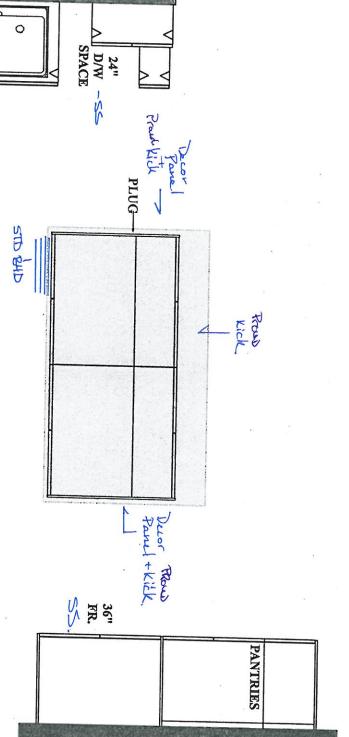

-> Revineter!

-> Island:

* Medio 6 'Oyster!

* Medio 6 'Nidnisht Blue!

I drawer below. Combo Wall Overs 10' CEILING - 12"H COFFERED CEILING - M.H. = 102" + 3/4"H CONTEMPORARY MOLDING + 5 1/4"H FURRING RAIL + LARGE CORNICE MOLDING TO UNDERSIDE OF BOX SITE STANDARD: WHITE 3/4" EXTENSION SOFT-CLOSE DRAWERS & SOFT-CLOSE HINGES TO KITCHEN AREA BROOKSIDE MODEL: (4003) VAUGHAN, ONTARIO PINE VALLEY GOLDPARK HOMES

PotstPans

Pots+Runs

OR BY KINCHES

Ŋ

PLAN VIEW

42" space for ficture 36" chimmen


36" Cooktop


PLAN VIEW


MODEL: (4003) BROOKSIDE VAUGHAN, ONTARIO PINE VALLEY GOLDPARK HOMES


SITE STANDARD: WHITE 3/4" EXTENSION SOFT-CLOSE DRAWERS & STANDARD SLAM DOOR HINGES TO VANITIES


ONE TOP DRAWER WHERE POSSIBLE THROUGHOUT EACH VANITY, ONE BANK OF DRAWERS WHERE POSSIBLE THROUGHOUT EACH MASTER ENSUITE VANITY

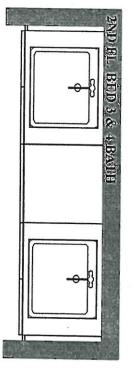

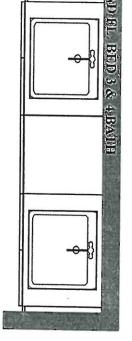

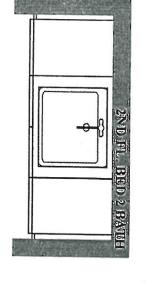

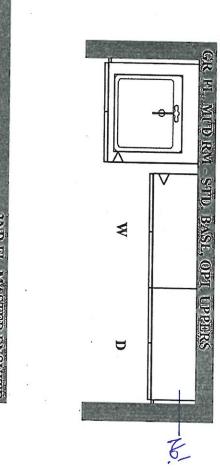


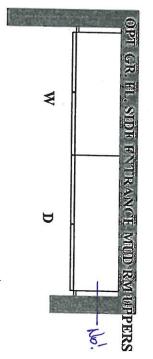





SCHEDULE'F'

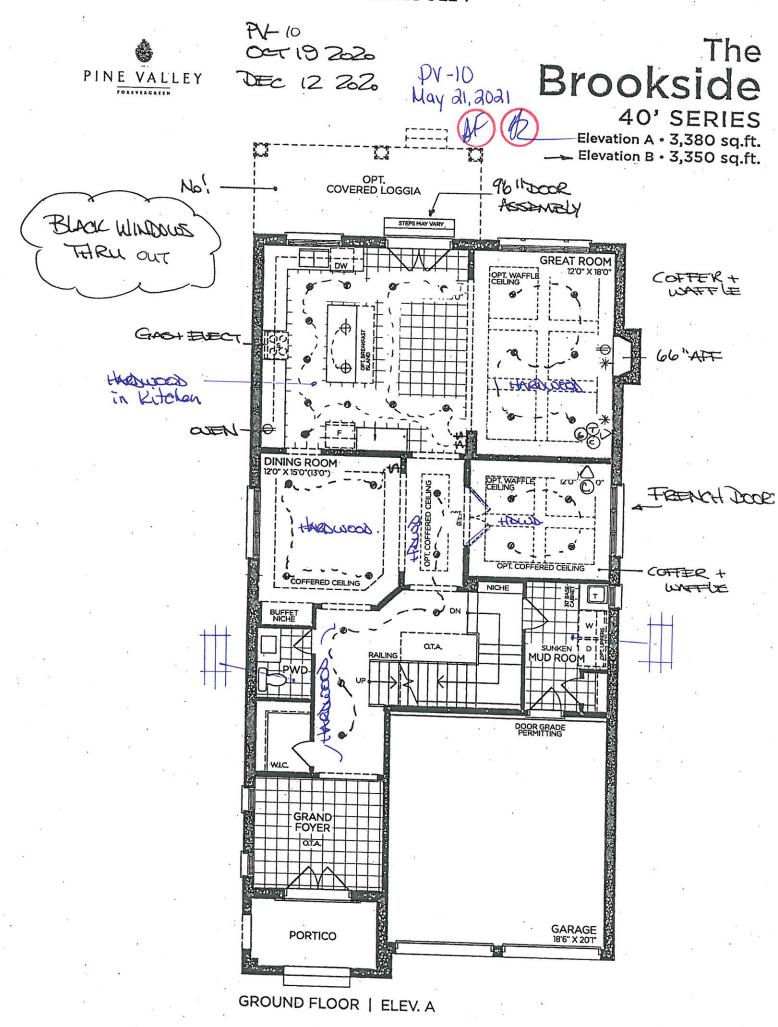

VENDOR PURCHASER PURCHASER

GOLDPARK

WORTH MORE

Prices, figures, illustrations, sizes, features and finishes are subject to change without notice. Areas and dimensions are approximate and actual usable floor space may vary from the stated area. Layout may be reverse of the unit purchased, E. & O.E. 4003




PV-10 OCT 19 202 DEC 11 2020

The Brookside

40' SERIES

Elevation A • 3,380 sq.ft.

PV-10 Elevation B • 3,350 sq.ft.

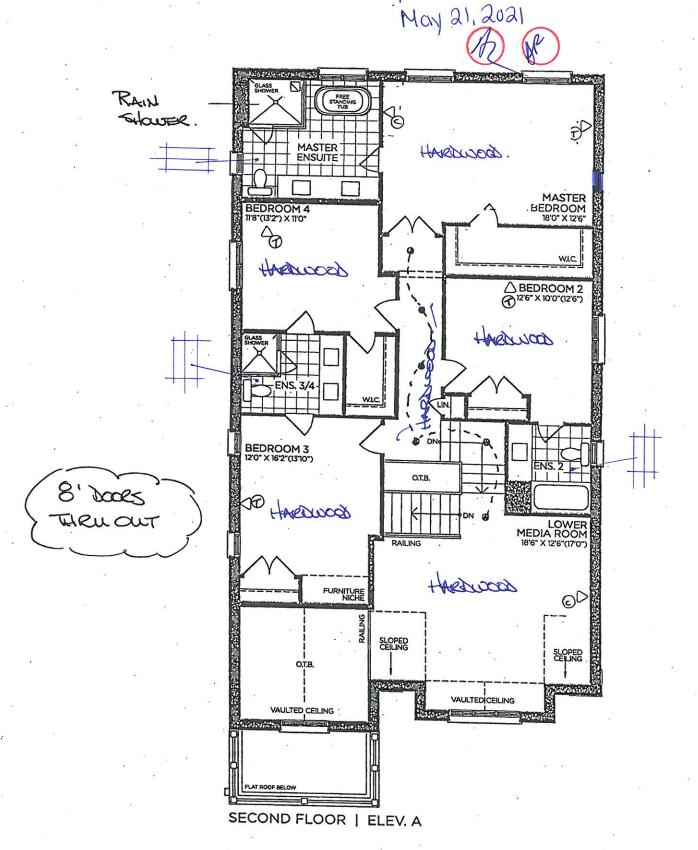

VENDOR PURCHASER PURCHASER GOLDPARK

Prices, figures, illustrations, sizes, features and finishes are subject to change without notice. Areas and dimensions are approximate and actual usable floor space may vary from the stated area, Layout may be reverse of the unit purchased, E. & O.E. 4003

SCHEDULE'F'




PV-10 OCT 19 2020 DEC 11 2020


The **Brookside**

40' SERIES


Elevation A • 3,380 sq.ft.

Elevation B • 3,350 sq.ft.

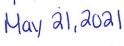


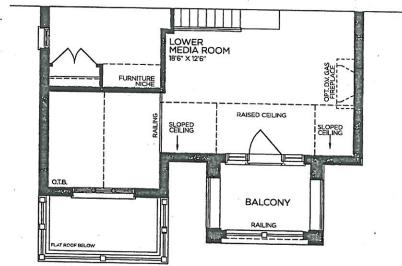


PART. SECOND FLOOR | ELEV. B

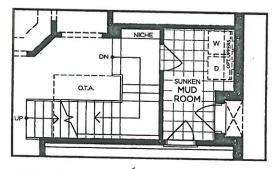

PART. OPT. GROUND FLOOR W/ OPT. SIDE ENTRANCE | ELEV. A (ELEV. B SIMILAR)

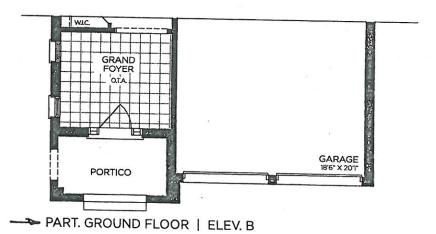

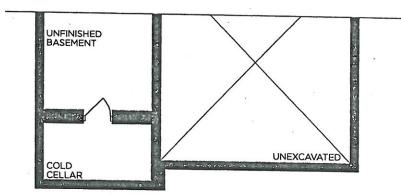

PART. BASEMENT | ELEV. B

VENDOR
PURCHASER
PURCHASER

GOLDPARK

WORTH MORE"

Prices, figures, illustrations, sizes, features and finishes are subject to change without notice. Areas and dimensions are approximate and actual usable floor space may vary from the stated area. Layout may be reverse of the unit purchased, E. & O.E. 4003

SCHEDULE'F'



PV-10 Cot 19 220 JEC 11 7020 DV-10 The Brookside

40' SERIES

Elevation A • 3,380 sq.ft. Elevation B • 3,350 sq.ft.

May 21, 2021

24×30" UNFINISHED BASEMENT FIN. FOYER UNFINISHED BASEMENT UNEXCAVATED COLD CELLAR

BASEMENT | ELEV. A

VENDOR
PURCHASER
PURCHASER

GOLDPARK

WORTH MORE

Prices, figures, illustrations, sizes, features and finishes are subject to change without notice. Areas and dimensions are approximate and actual usable floor space may vary from the stated area. Layout may be reverse of the unit purchased. E. & O.E. 4003



STONE COUNTERTOP EDGE PROFILES

	STANDARD 2CM EASED EDGE	LOCATION:
	UPGRADE 3CM EASED EDGE	LOCATION: * Haru - out *
	UPGRADE 4CM MITRED EDGE	LOCATION:
	UPGRADE 2CM OGEE EDGE	LOCATION:
OT#: PV - VOIGNATURE:	DATE: May 21, 2	021


K002-02	K002-03	K002-04
K002-06	K002-05	K008-14
	*NO HARDWARE	TOUCH-LATCH
K024-03		
*Disclaimer: Holes will not be drilled into cabinetry. Hardware will expense and warranty.	ll not be supplied or installed.Purchaser will dri	ll and install hardware after closing at their own
LOT # PV- LO DATE: May	21,2021	
SIGNATURE:		
SIGNATURE:		



BLANCO - QUATRUS R15 U SUPER SINGLE

Stainless Steel - Undermount 32" x 18" x 9"



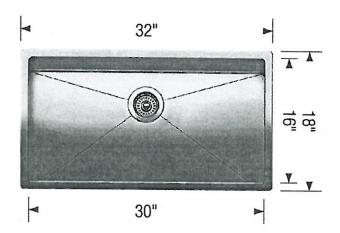


Stainless Steel


MODEL 401518 Stainless Steel

Lot# PV-10	
Room: Kitchen	Signature:
Date: May 21, 2021	Signature:

BATHROOM ACCESSORIES



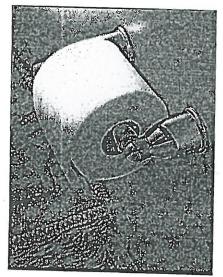

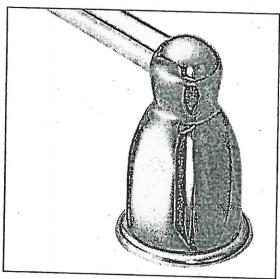

Tissue Holder Mason - Chrome

Towel Bar Mason - Chrome

Please select one of the following:

INSTALL STANDARD BATHROOM ACCESSORIES THRU OUT (tissue holder + towel bar) *location as per vendors discretion*
DO NOT INSTALL STANDARD BATHROOM ACCESSORIES THRU OUT *tissue holder + towel bar will not be provided*

LOT # PV - 10	DATE: May 21, 2021
SIGNATURE:	Deuffen
SIGNATURE:	O Jon



Project: Pine Valley

Lot: ₽V-10

Purchaser(s): Ngan Kim Lieu and Tak. Kuen, Andrew Fan

Standard Hood Fan Deletion

We acknowledge that the builder's standard hood fan will not be installed. Do not supply, install and/or credit. We will install our own hood fan after closing.

Signature:

Signature:

Date: May 21, 2021



UPGRADE PLUMBING

MOEN - ALIGN

3 Function SHOWER ONLY* Rain Shower and Handshower




MODEL: T2192EP Shower Trim Only* / T4191 Transfer Trim + 3372 Transfer Valve / 62320 1/2" CC Valve / 3887EP Handshower + A725 Drop EI / 226651 Shower Arm (from ceiling) / 56360 Showerhead

LOT#: PY-LO	Dec. 11, 2020.	ROOM: Master Ensure
SIGNATURE:		W.
SIGNATURE:		



MOEN - MODERN

Pot Filler

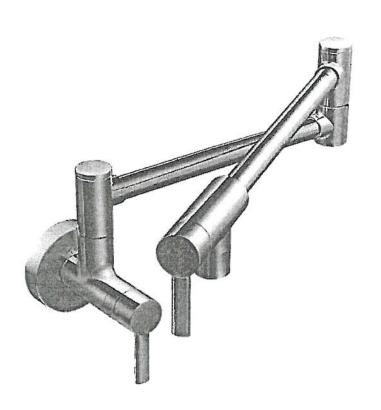

CHROME	
STAINLESS (SRS)	
BRUSHED GOLD (BG)	
MATTE BLACK (BL)	
MODEL: S665 (SRS, BG, BL) Pot Filler	
Lot# PV-LO Dec. 11, 2020. Room: Kitchen	
Signature:	
Signature:	

GOLDPARK

GOLDPARK INTERIOR COLOUR SCHEME

*** NOTE: This is not an approved document. Document must be locked ***

Scheduled Closing Date: February 4, 2021

Purchasers:

NGAN KIM LIFU & TAK KUEN ANDREW FAN Property: 10 of Plan

ayout Changes: O Yes	No Sketch Attached:	Yes No Exterior Colour Scheme:				
. Cabinetry	Style and Colour	Counter	Hardwar			
Kitchen / Breakfast	*2-Tone	*Quartz: 'Calacatta Gold'	attach			
Laundry Room	n/a	n/a	n/a			
Powder Room	*Medio 6 'Anthracite'	*Quartz: 'Blanco Zeus'	attach			
Mud Room	Chesapeake 'Classic White'	P-Lam 'White'	attach			
Master Ensuite Bathroom	*Medio 6 'Midnight Blue'	*Quartz: 'Desert Silver'	attach			
Second Ensuite Bathroom (If Applicable)	Chesapeake 'Classic White'	*Quartz: 'Cement'	attach			
Shared Ensuite	Bowery 'Pewter'	*Quartz: 'Jet Black'	attach			
Comment Kitchen Cabinetry - Perimeter: *Med	dio 6 'Oyster' + Island: *Medio 6 'Midnig	ht Blue'				
Floor Tile						
Entrance Vestibule	Selection 24x24" Cararra X 'White' polis	had				
Main Hall	n/a	nea				
Kitchen / Breakfast	*see hardwood					
Laundry Room	n/a					
Powder Room	*12x24" Cararra X 'White' polished					
Mud Room	*12x24" Cararra X 'White' polis					
Master Ensuite Bathroom	*12x24" Carrara X polished					
Second Ensuite Bathroom (If Applicable)	*12x24" New Byzantine 'Azzur	o Blue'				
Lower Landing (If Applicable)	13x13" Costa 'White' (Basement Foyer)					
Shared Ensuite	*12x24" New Byzantine 'Azzur	o Blue'				
Comment Master Ensuite Shower Floor: *'Onto	ario 'Drark Grey' Matte / Thru-out Showe	er Floor: 2x2" Standard White Listello/Inserts Describe				
Wall Tile		Yes No				
Master Ensuite Bathroom	ck					
Master Ensuite Bathroom Tub De		○ Yes ● No				
Master Ensuite Bathroom Tub De	all *12x24" Carrara X 'White' po	○ Yes ● No				
Master Ensuite Bathroom Tub De Shower St Bathroom Wa Second Ensuite	all *12x24" Carrara X 'White' po	Yes No Dished Yes No				
Master Ensuite Bathroom Tub De Shower St	all *12x24" Carrara X 'White' po	Yes No Dished Yes No Yes No				
Master Ensuite Bathroom Tub De Shower St Bathroom Wa Second Ensuite Bathroom (If Applicable)	all *12x24" Carrara X 'White' polls 8x10" Splendor 'White'	Yes No Olished Yes No Yes No Yes No Yes No				

GOLDPARK INTERIOR COLOUR SCHEME *** NOTE: This is not an approved document. Document must be locked *** Scheduled Closing Date: February 4, 2021 Purchasers: NGAN KIM LIEU & TAK KUEN ANDREW FAN Property: 10 of Plan -Telephone Res. / Bus: / Project: Pine Valley Forevergreen - Phase 1 Decor Advisor: Angela Phim Model and Elevation: 40.03 B BROOKSIDE 4. Plumbing Fixtures Second Ensuite **Powder Room** Master Ensuite Bathroom Other Room - Specify Other Washroom Comment *see attached for upgrade plumbing 5. Hardwood Flooring Type and Stain Type and Stain Main Hall **Upper Landing** Kitchen / Breakfast *5" WhtOak, Sculpted, 'Apollo' **Upper Hall** Living Room Master Bedroom **Dining Room** Bedroom #2 **Family Room** Bedroom #3 Den/Library Bedroom #4 **Entrance Vestibule** Bedroom #5 Lower Landing Other Room - Specify *5" WhtOak, Sculpted,'Apollo' (If Applicable) thru-out standard areas Comment 6. Carpeting Upgrade Description **Ground Floor** Second Floor Type **Upgrade Underpad** Capped Runner - *Upgrade Carpet on Stairs Comment

Fireplace	Living Room			Family Room		300 - 3W	Other Room - Specify	Great Room
	Purchased	As Per Plan	N/A	Purchased	As Per Plan	N/A	Purchased As Per F	Plan N/A
	\bigcirc	\circ	\bigcirc		\bigcirc	\bigcirc	\circ	\bigcirc
Fireplace Type							Standard Gas	
Mantle Type							Mediterranean	
Colour / Stain							Arctic White	
Surround							n/a	
Hearth							n/a	
Comment								
	May	28,202	1					

GOLDPARK	NTERIOR COLOUR SCHEME
WORTH MORE" *** NOTE: This is not a	an approved document. Document must be locked ***
	cheduled Closing Date: February 4, 2021
Purchasers: NGAN KIM LIEU & TAK KUEN AND	
Telephone Res. / Bus: /	Project: Pine Valley Forevergreen - Phase 1
Decor Advisor: Angela Phim	Model and Elevation: 40.03 B BROOKSIDE
8. Trim Carpentry	
Interior Doors - Carrara Logan Front Door Glass	S Inserts Std Door Handles Standard
Interior Trim Standard	
Comment	
9. Plaster Mouldings and Medallions	
Standard Throughout () Yes () No () N/A	
Entrance Vestibule	Kitchen/Breakfast
Main Hall	Den/Library
Living Room	Lower Landing
Dining Room	Other Room - Specify
Family Room	
Comment	
*PLVICEN *	
REVISED	*
May 28, 2021	
attage	
40. 7. 11	
10. Railings and Spindles	
Railing Package Standard 2-Package Package A-L	
Railing Colour *Mirage 'Hopscotch'	Spindle Colour -*Mirage-'Hopscotch'- Black
Stringer / Riser *Mirage 'Hopscotch'	Treads *Mirage 'Hopscotch'
Comment	Oak Stairs Yes No N/A
11. Wall Paint / Ceilings	
Throughout Finished Areas Warm Grey	
meag.reat menou / reae	
Trim Paint White	
Smooth Cailings	
Smooth Ceilings Ground Floor ✓	
Second Floor	
Note	
Hote	
Comment	
Comment	
	I

GOLDPAR	MORE *** NOTE: This	INTERIOR COLOUR SCHEME is not an approved document. Document must b	e locked ***
Purchasers:	NGAN KIM LIEU & TAK K	Scheduled Closing Date: February 4, 2021	
Telephone Res. / Bus:	/	KUEN ANDREW FAN Property: 10 of Plan - Project: Pine Valley Forevergreen - F	Phase 1
Decor Advisor:	Angela Phim	Model and Elevation: 40.03 B BROOKSIDE	11450 1
40 []4-:1			
─12. Electrical ── Hood Fan ○ Wh	ite Stainless N/	/A	· · ·
HOOG Pail Will	ite Stairliess N/	/A Above Kitchen Cabinet Light Below Kitchen Cabinet Light	
Standard Appliance	s \square	below Ritchell Cabillet Light	res O No
Over The Range Mic		,	
Chimney Style Fan			
Comment			
42 1141		*	
13. Heating and A Air Conditioning	no no	Gas Provisions Stove ves	
Gas Provisions Drye		Gas Provisions Stove yes Gas Provisions Barbecue std	
Comment	-		
15. Disclaimers a	nd Notes		
		der's selection, but not necessarily identical due to variances in manufacturing.	
3) The Purchaser acknowl	edges that after Interior Colour S	panied by a separate invoice/amendment. Said invoice must be paid in full. Selection form is signed and dated, no further changes will be permitted other	
than re-selection due to 4) The Purchaser acknow	o unavailability F	Purchaser's Initials e "Gold Park Homes Decor Centre Disclaimers" form. This document contains	
other miscellaneous di	sclaimers. tion is final and approved by:		
Siam of the state	_ =	1 11 100	7
Signature:	Date:	: May 21, 2021	
	(AHA)	May 28,2021	Page 4 of 4

Printed 2021-05-21 13:58:06

WORTH MORE	*** NOTI	E: This is not a	NTERIOR (in approvi	ed do	cume	nt. Docume	nt must be locked
Purchasers: NGA		So J & TAK KUEN ANI	cheduled Cl	osing	Date: I	February 4, 202	1
Telephone Res. / Bus: /		a michochang	JINEW FAIN			10 of Plan -	**************************************
Decor Advisor: Ange	la Phim		Model and	I Flev	ation:	10.03 B BROOK	evergreen - Phase 1
Layout Changes: () Yes	No	Sketch Attached					of the control of the
1. Cabinetry	HAC I III	1 told to the Age and a large to a	165 ()	INO	Exter	or Colour Sch	eme:
Kitchen / Breakfast	Style and C	olour	Counte			The second secon	Hardware
Laundry Room	n/a	W - W - F - F - F - F - F - F - F - F -	entrance of the second	z: 'Ca	lacatta (Gold'	attach
Powder Room	4 (100)	Anthracite'	in/a	-: 'D!-	nco Zei		n/a
Mud Room		ke 'Classic White'	P-Lam			is:	attach
Master Ensuite							altach
Bathroom	injegio e	Midnight Blue'	*Quart	z: 'De	sert Silv	er'	attach
Second Ensuite Bathroom (If Applicable)	Chesapea	ke 'Classic White'	Quart	z' 'Cei	ment'	war aller and the later of the	or the second harmon recovering strongs.
Shared Ensuite	Bowery 'P	ewter'	*Quart	z: 'Jet	Black'	NATIONAL PROPERTY OF THE PROPE	attach
Comment Kitchen Cabinetry - Perimeter: *Mer							The state of the s
. Floor Tile	Selection	THE RESERVE THE PARTY OF THE PARTY.	Company of the Company of the	****	A STATE OF THE STA	The second secon	an other and the separate production of the sepa
Entrance Vestibule		ararra X White' pol	ished	nn we	THE COLUMN	m for more and conservations and appropriate	control per live and management of the day of the little of the little of
Main Hall	n/a	Transfer on Transfer		The same of	Arthur, property of a	professionales season des des communitations and a season designed	
Kitchen / Breakfast	*see hard	wood	e				
Laundry Room	n/a				***************************************	THE RELEASE OF THE RESEARCH OF	
Powder Room		ararra X 'White' po		· Army want		1 1 1 1 1 1 1 1 1 1 1 1 1 1 1 1 1 1 1	
Mud Room Master Ensuite		ararra X 'White' po	lished				The second secon
Bathroom	*12x24" C	arrara X polished			er en er er er er er	regions of the same statements of the same st	
Second Ensuite Bathroom (If Applicable)	*12x24" N	ew Byzantine 'Azzu	ıro Blue'		Promise Same		
Lower Landing (If Applicable)	13x13" Co	sta 'White' (Basem	ent Foyer)			The second of the second section is a second	THE STATE OF THE S
Shared Ensuite	*12x24" Ne	w Byzantine 'Azzu	ro Blue'	***** ** *******	N. N. ath. Co. P. and Co. St. Co.	** ** ** ** * * * * * * * * * * * * *	10 10 00 010 00 00 00 00 00 00 00 00 00
Comment			2000	ALL LANGE & CORN.	****	THE PART OF STREET PARTY OF THE	THE PARTY OF THE STATE OF THE S
Master Ensuite Shower Floor: "Ontain	io 'Drark Grey	Malte / Thru-out Show	wer Floor; 2x2"	Standa	d White	The second second second	The cost of prompt (and of desirable of the statement statement (statement)
							i
							Propulse som
Wall Tile	Selection	****************	11-	tello/in		1 1 2 2 3 2 2 2 2 2 2 2 2 2 2 2 2 2 2 2	
	L	THE STREET STREET	Married St. St. Co. of Co. of Co.		no No	Describe	
Master Ensuite Bathroom						(A)	The control of the co
Tub Dec	Total receipt	N			● No		Committee of the commit
Shower Stal Bathroom Wall		Carrara X 'White' p			No No		
Second Ensuite	***************	lendor 'White'	IO		No No		
Bathroom (If Applicable)	V				No No	THE REAL PROPERTY OF THE PARTY	
Shared Ensuite	-	lendor 'Dark Grey'	O		No		
Kitchen Backsplash	O Yes (D No	Professional and annual and	Back	splash	Behind Fridge	
Comment	L	All for species (state strengths from all pages to the con-		Mark Street	41.00 4.000 4.000	F. J. F. St. Co., Spr. Spr. Sci., Spr. State Spr. Sec.	
May	28,20	U					
							4
M M	1) Alex	•					1

worth Purchasers: Telephone Res. / Bus: Decor Advisor:	NGAN KIM LIEŲ &	This is not an Sch TAK KUEN ANDR	REW FAN Prop	cument, I Date: Febru perty: 10 of pject: Pine	Document mo lary 4, 2021 Plan - Valley Forevergra	ust be locked
1 Plumbing First	B. C. Allert Constant of the constant of the constant program	and the second of the second o	Model allu Lieva	uon: 40.03	B BROOKSIDE	THE STREET SECURIOR STREET, ST
4. Plumbing Fixt Master Ensuite Bate Comment 'see attached for upgrade	hroom [Second Ensul Other Room	L	to come and	wder Room ner Washroom	
	and self-control of the se	The second of the second secon	A.A. Common a company of the common c	antagen deed a configuration of a contract to	THE PARTY AND A STREET	* *************************************
5. Hardwood Floo	oring	A. C	A THE RESIDENCE OF THE PERSON		e districts a separation that the property and property and the separation of the se	Control of the contro
Main Hall	Type and Stain	THE RESERVE OF THE PART AND THE		Тур	e and Stain	
Kitchen / Breakfast	*5" WhtOak Soulote	ed 'Anoflo'	Upper Landing	ļ		The second secon
Living Room	, ocupte	~, ~polit	Upper Hall Master Bedroo		andre of authorities and an incompression of the contraction of	The confidence is
Dining Room	The state of the s	TO SECURE AND ADDRESS OF THE SECURITY OF THE S	Bedroom #2	m L	per el les algoritations de la personal de la compansión	A COURT OF ME AND ADDRESS OF THE ADD
Family Room	Property of the second second second second	A CARLOS OF THE ACT OF THE CONTRACT OF THE CON	Bedroom #3	L	anged change has proper to the respect of	A STATE OF THE PROPERTY OF THE PARTY.
Den/Library	A THE RESERVE OF THE PARTY OF T	AND A STATE OF THE	Bedroom #4		eriget attende de filipie and enteren de les eries e	A
Entrance Vestibule	Personal and A. C. Commission of the Commission		Bedroom #5	ļ		THE STATE OF THE S
Lower Landing					alanin — 32 - eranda ha asan dirigi vadi" enrincari dualentan shqiringga biq	1 1 1 1 1 1 1 1 1 1 1 1 1 1 1 1 1 1 1
(If Applicable)	L	P Bernard Conne	Other Room - S	pecity *5"	WhtOak, Sculpte	ed 'Apollo'
Comment	on the control of the second section of the section of		thru-out standard	d areas	and the same of th	The state of the s
	Upgrade	Description	thru-out standard	d areasi Y		
. Carpeting ————————————————————————————————————	Upgrade	Description	thru-out standard	d areas		

GOLD	*** NOTE: This	INTERIOR COLOUR SO	HEME
		Scheduled Closing Data: D	nt. Document must be locked ** February 4, 2021
Purchasers;	NGAN KIM LIEU & TAK K	UEN ANDREW FAN Property: 1	10 of Plan -
Telephone Res. / Be Decor Advisor:		Project: F	Pine Valley Forevergreen - Phase 1
Decoi Auvisor:	Angela Phim	Model and Elevation: 4	0.03 B BROOKSIDE
8. Trim Carpen	itry		
	Carrara [agan Front Doc		The second secon
Interior Trim S	landard	or Glass insens sig	Door Handles Standard
Comment		comments origing processing of a substance separate and processing or an agencia.	
9. Plaster Moul	dings and Medallions		
Standard Throug	haut Ox Ox	N/A	the control of the co
Entrance Vestibu	le l	. Kind	and the second s
Main Hall		Kitchen/Breakfast	
Living Room	The second secon	Den/Library	Constitution of the second sec
Dining Room		Lower Landing	
Family Room	10 for the control of	Other Room - Specify	
Comment	months are an area and an area and a second	Annual to a state of the state	And A
(E-VIST)	>	the second section of the sect	and the second of the second o
May 28,			
h	AF	The state had been accompanied to the state of the state	The second secon
10. Railings and	Snindles		
Railing Package	Slandard 2-Package - PACK 4P. A-	The second secon	AND THE RESIDENCE OF THE PROPERTY OF THE PROPE
Railing Colour	'Mirage 'Hopscotch'	Spindle Celevre	
1 <u>1 1 1 1 1 1 1 1 1 1 1 1 1 1 1 1 1 1 </u>	Mirage 'Hopscotch'	Treads	*Mirage-'Hopscotch'- Hack
Comment	- A	Oak Stairs	*Mirage 'Hopscotch' Yes No NA
•	The second secon	Professional Contract of the State of the St	Yes () No () N/A
1. Wall Paint / C		The second of th	District times of \$1. Semigroup times and a semigroup time to the semigroup times and the semigroup times are the semigroup times are the semigroup times and the semigroup times are the semigroup ti
i nroughout Finishe	ed Areas Warm Grey	The control of the co	
	La contraction of the contractio		
Trim Paint	White		THE TOTAL SHOP OF A PROPERTY AND A STATE OF
Smooth Ceilings			
Ground Floo	or 🗸		
Second Floo	r 🗸		and the second s
Note		The stranger rate and	The state of the s
Commont			
Comment	The second secon	records to the control of the contro	
W M			

WORTH MORE	. *** NOTE: This is n	INTERIOR COLOU! of an approved docu	ment. Document	must be locked				
urchasers: NG	*** NOTE: This is not an approved document. Document must be locked * Scheduled Closing Date: February 4, 2021 NGAN KIM LIEU & TAK KUEN ANDREW FAN Property: 10 of Plan -							
elephone Res. / Bus: /	TAN LILU & TAN KUEN		rty: 10 of Plan -					
	ela Phim	Proje	ct: Pine Valley Foreve	rgreen - Phase 1				
The state of the s	OIG I HIIII	Model and Elevation	on: 40.03 B BROOKS	DE				
2. Electrical	tion for the first two two terms and the first two two two transfers to the first two two two transfers to the first two two two transfers to the first two two two two two two two two two tw	a comment of Australia Company and Company of the C		The second section is the second section of the section of th				
Hood Fan White	Stainless N/A	Ab	ove Kitchen Cabinet	Light O Yes O No				
Standard Appliances		Be	low Kitchen Cabinet	Light Myes No				
Over The Range Microwa	ve []							
Chimney Style Fan								
Comment	Terrend .							
 Heating and Air Conditioning 	onditioning							
Gas Provisions Dryer	no	Gas Provisi						
Comment	The second secon	oas Provisi	ons Barbecue std	at cartifactor, of englat spatial production of a company of the contract of t				
Addition 10	T							
. Additional Comme	1ts	The state of the s	THE RESIDENCE COMMENTS WHERE IT IS IN A PRODUCT CONTINUES IN A PROPERTY OF	dembres the absorberation and the angular and a set of the con-				
Disclaimers and Not	es	Here we will be and the the confidence of the first product to the con-	and the second second second second second second	M				
Colours of all materials are as clo	se as possible to builder's selecti	ion, but not necessarily identical	dua ta mada a construir					
Any extras listed above are null ar	nd void unless accompanied by a	separate invoice/amendment	Said invoice must be active	cturing.				
The Purchaser acknowledges that	after Interior Colour Selection to	rm is signed and dated at a	oald invoice must be paid in	tuli.				
	1 didilasci	3 initials						
The Purchaser acknowledges rea other miscellaneous disclaimers.		k Homes Decor Centre Disclain	ners" form. This document c	ontains				
s Interior Colbur Selection is fina	al and approved by:							
nature:	Date: May	11,2021						
(1)	Secretary of the secret		· VALOUR STORY OF THE STORY OF					
(41)	N INCY	The second secon						
nled 2021-05-21 13:58:06	Date: May	18,10)4		Page 4 of 4				