



CONSTRUCTION SUMMARY

Lot: 57
Model: 40.00 A BRIARWOOD
Project/Phase: Pine Valley Forevergreen / 1

BASEMENT WINDOWS

Invoice	Qty.	Description
2807 72,351 10Jun21 **	4	BASEMENT WINDOWS - UPGRADE BASEMENT WINDOW SIZE TO 30 " X 24" - 8" FRAME

CONCRETE AND DRAIN

Invoice	Qty.	Description
2807 72,373 10Jun21	1	BACK FLOW PREVENTER VALVE

DRYWALL

Invoice	Qty.	Description
2807 72,373 10Jun21	1	MODEL OPTIONS 40.00 - MASTER BEDROOM - OPT. 11 FOOT TRAY CEILING

FRAMING

Invoice	Qty.	Description
2807 72,373 10Jun21	1	MODEL OPTIONS 40.00 - MASTER BEDROOM - OPT. 11 FOOT TRAY CEILING


PAINT

Invoice	Qty.	Description
2807 72,373 10Jun21	1	MODEL OPTIONS 40.00 - MASTER BEDROOM - OPT. 11 FOOT TRAY CEILING



SCHEDULE 'F'
PV-57
June 10, 2021
attached

The
Briarwood
40' SERIES
Elevation A • 2,870 sq.ft.
Elevation B • 2,860 sq.ft.

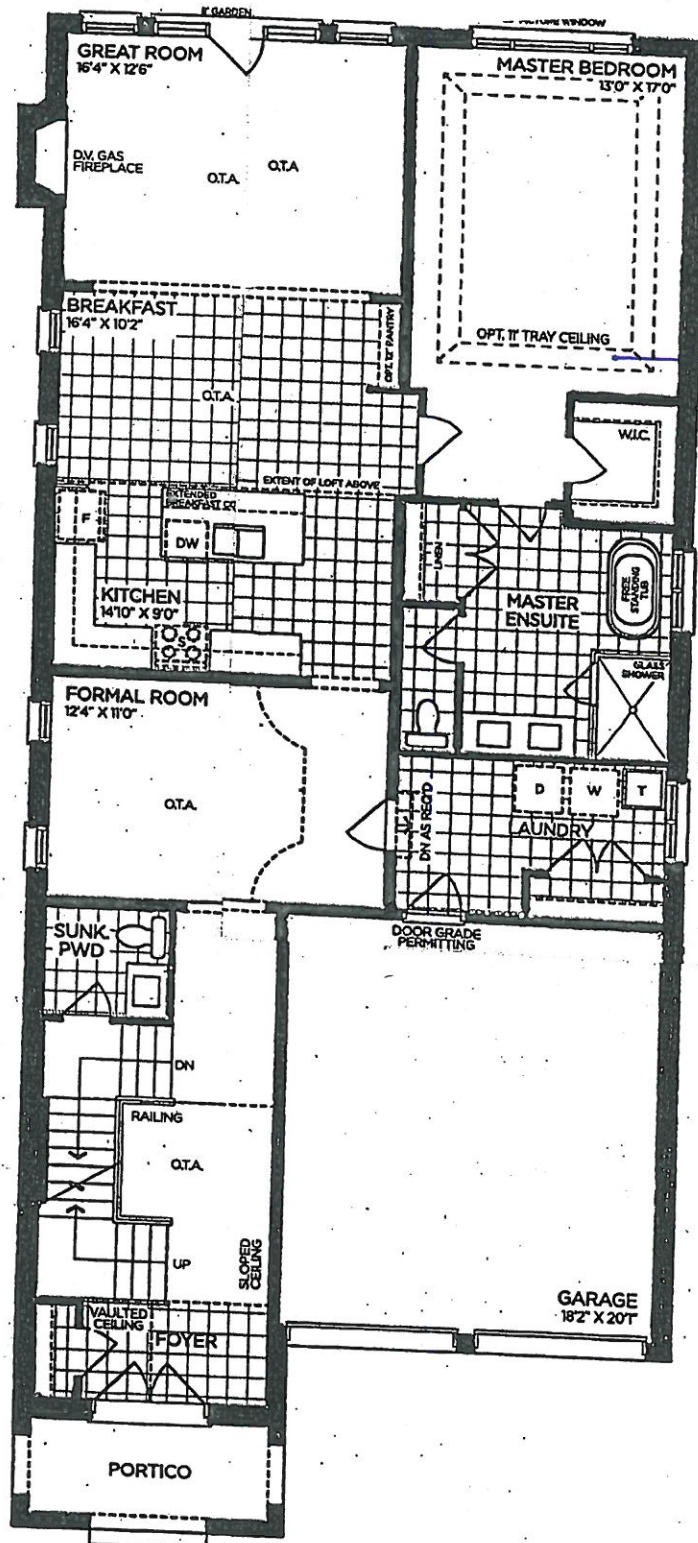

— TRAY - YES!

GROUND FLOOR | ELEV. A

VENDOR

PURCHASER

PURCHASER

GOLDPARK
WORTH MORE™

Prices, figures, illustrations, sizes, features and finishes are subject to change without notice. Areas and dimensions are approximate and actual usable floor space may vary from the stated area. Layout may be reverse of the unit purchased. E. & O.E. 4000




SCHEDULE 'F'

PV-57
June 10, 2021

attached

The
Briarwood
40' SERIES

Elevation A • 2,870 sq.ft.
Elevation B • 2,860 sq.ft.

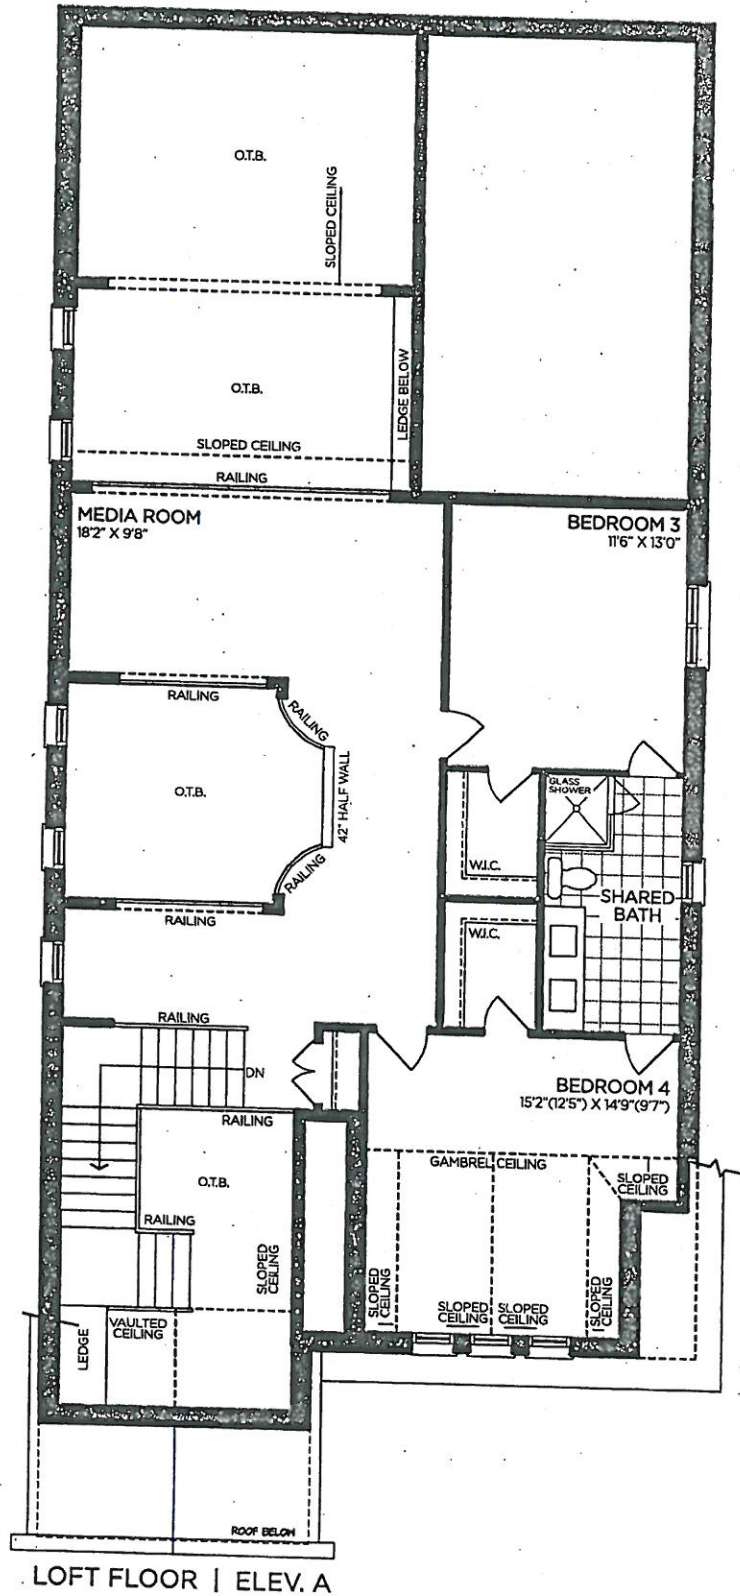

VENDOR

PURCHASER

PURCHASER

GOLDPARK
WORTH MORE™

Prices, figures, illustrations, sizes, features and finishes are subject to change without notice. Areas and dimensions are approximate and actual usable floor space may vary from the stated area. Layout may be reverse of the unit purchased. E. & O.E. 4000



SCHEDULE 'F'


PV-57
June 10, 2021 *attached*

The Briarwood

40' SERIES

Elevation A • 2,870 sq.ft.

Elevation B • 2,860 sq.ft.

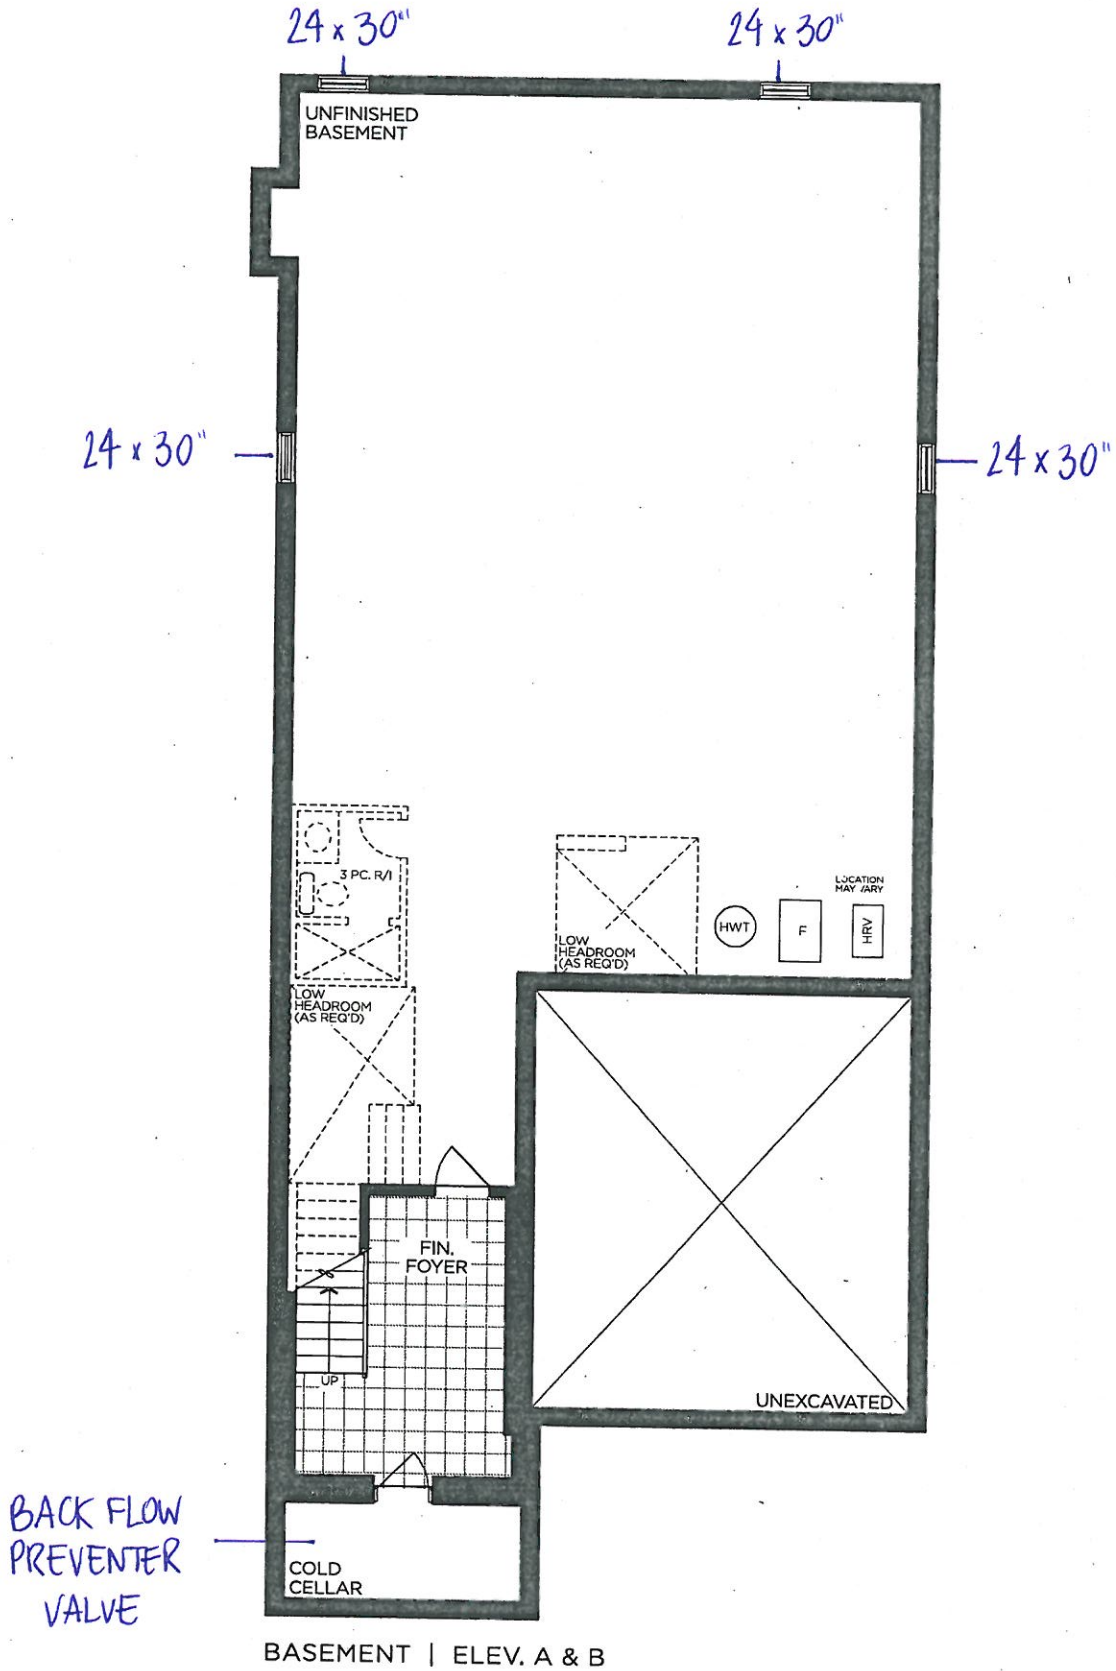

VENDOR

PURCHASER

PURCHASER

GOLDPARK
WORTH MORE™

Prices, figures, illustrations, sizes, features and finishes are subject to change without notice. Areas and dimensions are approximate and actual usable floor space may vary from the stated area. Layout may be reverse of the unit purchased. E. & O.E. 4000




SCHEDULE 'F'
PV-57
June 10, 2021

1.00 MR

The Briarwood

40' SERIES

Elevation A • 2,870 sq.ft.
Elevation B • 2,860 sq.ft.

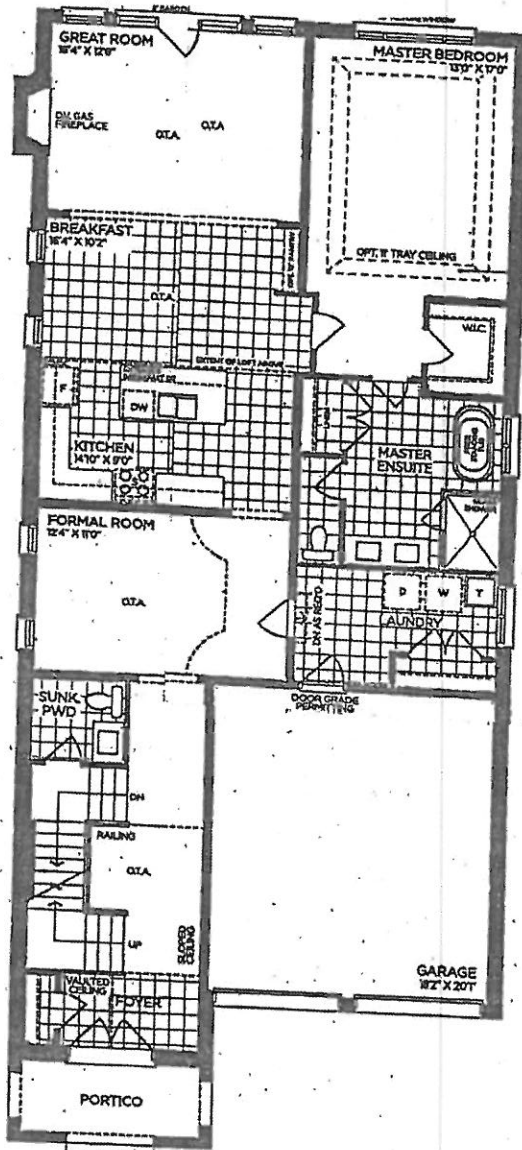

TRAY - YES!

VENDOR	
PURCHASER	
PURCHASER	


GOLDPARK
WORTH MORE™

Prices, figures, illustrations, sizes, features and finishes are subject to change without notice. Areas and dimensions are approximate and actual usable floor space may vary from the stated area. Layout may be reverse of the unit purchased. E & O.E. 4000



SCHEDULE 'F'
PV-57
June 10, 2021

The
Briarwood
40' SERIES
Elevation A • 2,870 sq.ft.
Elevation B • 2,860 sq.ft.

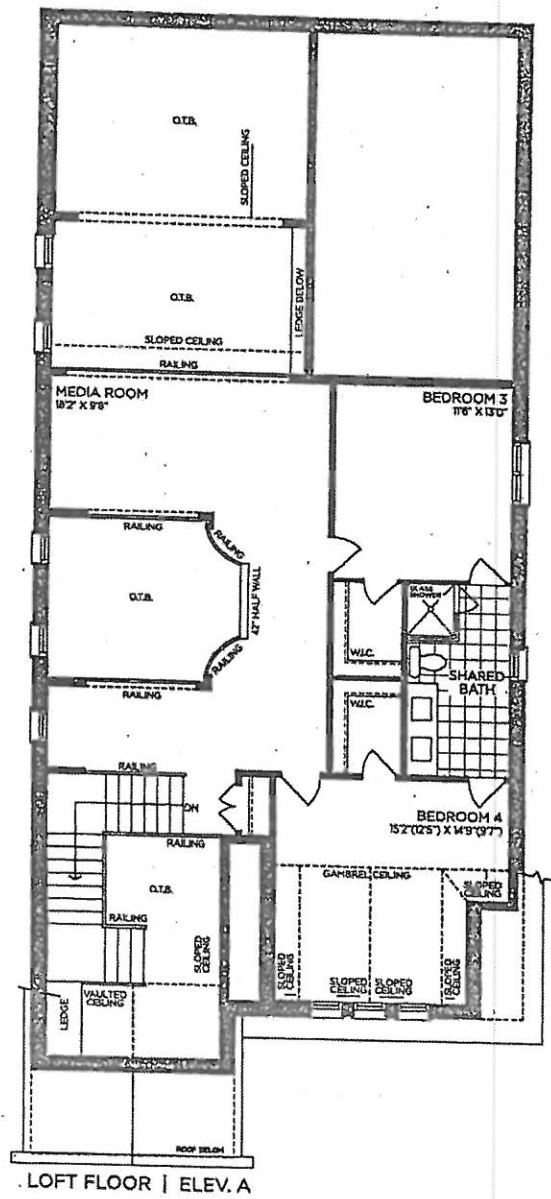

VENDOR	
PURCHASER	
PURCHASER	


GOLDPARK
WORTH MORE™

Prices, figures, illustrations, sizes, features and finishes are subject to change without notice. Areas and dimensions are approximate and actual usable floor space may vary from the stated area. Layout may be reverse of the unit purchased. E. & O.E. 4000



SCHEDULE 'F'
PV-57
June 10, 2021  

The
Briarwood
40' SERIES
Elevation A • 2,870 sq.ft.
Elevation B • 2,860 sq.ft.

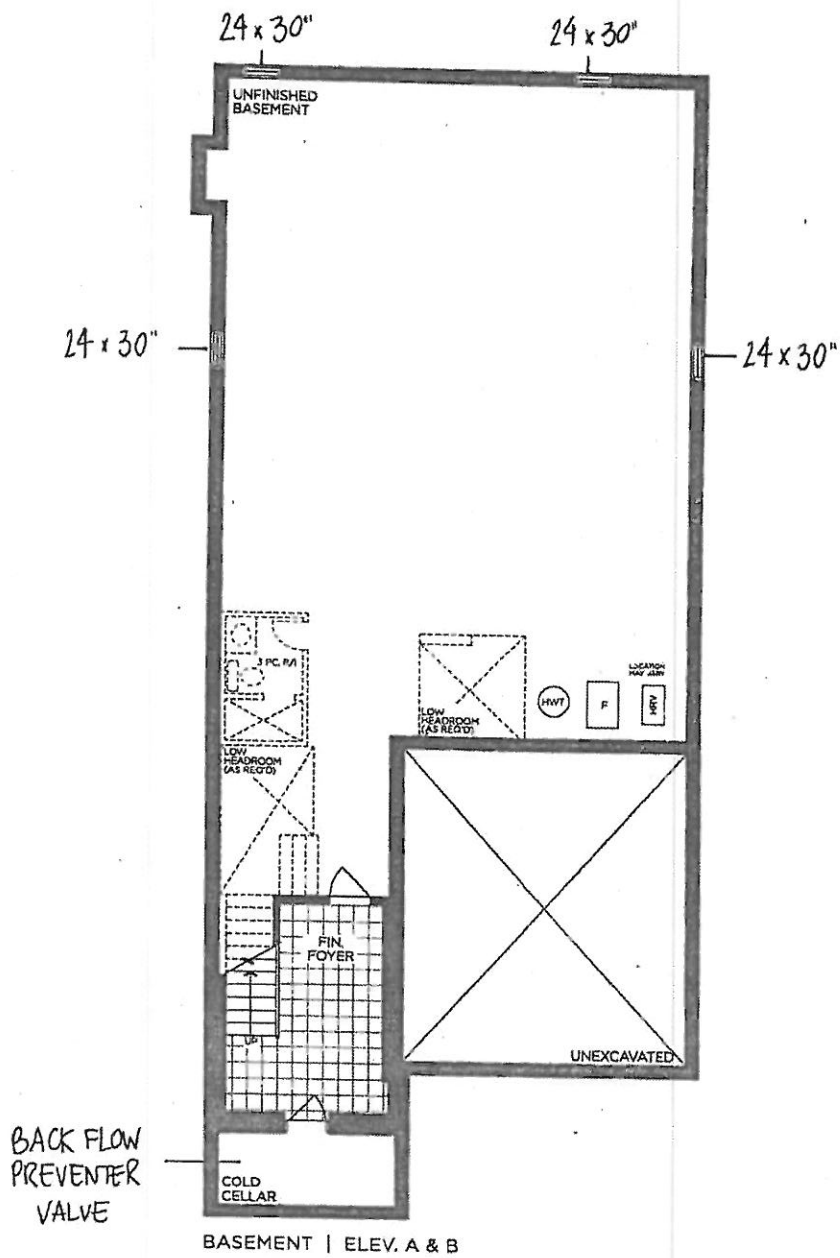

VENDOR
PURCHASER
PURCHASER

GOLDPARK
WORTH MORE™

Prices, figures, illustrations, sizes, features and finishes are subject to change without notice. Areas and dimensions are approximate and actual usable floor space may vary from the stated area. Layout may be reverse of the unit purchased. E & O.E 4000