

Lot: 83

Model: 50.04 A BEAUMONT

Project/Phase: Pine Valley Forevergreen / 1

APPLIANCES

Invoice

2564

72,675

Invoice	Qty.	Description
2672	1	APPLIANCE HOOD FAN INSERT SPEC ATTACHED - SIGNED COPY
30Mar21		
NoCat		

BASEMENT WINDOWS - UPGRADE BASEMENT WINDOW SIZE TO 30 " X 24" - 10" FRAME (PINEVALLEY 50 FOOT

BASEMENT WINDOWS

Qty. Description

LOTS ONLY)

10Mar21		
CERAM Invoice		Description
2564	1	MASTER ENSUITE: DELETE LINEN CLOSET, INSTALL ADDITIONAL SINGLE VANITY AND SINK INSTEAD - BASED ON STANDARD FINISHES
10Mar21 NoCat		SEE PLAN FOR DETAILS INCLUDED IN APS
2564	1	**CUSTOM LAYOUT** SWITCH LOCATION OF TUB AND SHOWER ENSUITE 2 TO HAVE TUB + ENSUITE 3 TO HAVE SHOWER
10Mar21 NoCat		BASED ON STANDARD FINSIHES
2564 10Mar21 NoCat	1	MASTER ENSUITE: DELETE LINEN PANTRY - ADD 2ND VANITY (BASED ON STANDARD FINISHES) - SEE PLAN FOR LOCATION
2672 37 30Mar21	1	FRONT FOYER: TILE, FLOOR , LEVEL 5 - 24X24" LAID IN STRAIGHT, STACKED PATTERN.
2672 37 30Mar21	1	POWDER ROOM: TILE, FLOOR , LEVEL 5 - 24X24" LAID IN STRAIGHT, STACKED PATTERN.
2672	1	FYI - KITCHEN/BREAKFAST: VINTAGE SERIES, 5" RED OAK, NSS ENGINEERED HARDWOOD, 3/4" THK, SCULPTED TEXTURE, UVF FINISH
30Mar21 NoCat		DO NOT SUPPLY / INSTALL CERAMIC IN KITCHEN/BREAKFAST AREA (CREDIT)
2715 32 03Jun21	1	ENSUITE 2: TILE, FLOOR - LEVEL 1 - 12x24" LAID IN STRAIGHT STACKED PATTERN - SEE PLAN FOR DIRECTION
2715 46 03Jun21	1	ENSUITE 2: TILE, WALL - LEVEL 1 - 3x6" LAID IN HORIZONTAL STACKED PATTERN
2715 32 03Jun21	1	ENSUITE 3: TILE, FLOOR - LEVEL 1 - 12x24" LAID IN STRAIGHT STACKED PATTERN - SEE PLAN FOR DIRECTION
2715 46 03Jun21	1	ENSUITE 3: TILE, WALL - LEVEL 1 - 3x6" LAID IN HORIZONTAL STACKED PATTERN

DisciplineMS.rpt 23feb21 Page 1 of 9



Lot: 83

Model: 50.04 A BEAUMONT

Project/Phase: Pine Valley Forevergreen / 1

	\mathbf{F}^{*}	D	٨	N	Л	[C]
•	r,	N	$\overline{}$		/	

Invoice	Qty.	Description
2715 32 03Jun21	1	ENSUITE 4: TILE, FLOOR - LEVEL 1 - 12x24" LAID IN STRAIGHT STACKED PATTERN - SEE PLAN FOR DIRECTION
2715 46 03Jun21	1	ENSUITE 4: TILE, WALL - LEVEL 1 - 3x6" LAID IN HORIZONTAL STACKED PATTERN
2715 43 03Jun21	1	MASTER ENSUITE: TILE, SHOWER FLOOR - LEVEL 2 - 2" HEX
2793 46 03Jun21	1	MASTER ENSUITE: TILE, WALL, LEVEL 1 - 4x16" LAID IN HORIZONTAL, STACKED PATTERN.
2798 26 15Jun21	1	MASTER ENSUITE: TILE INSTALLATION UPGRADE, WALL, HORIZONTAL, BRICK (30/70) PATTERN

CONCRETE AND DRAIN

Invoice	Qty.	Description
2564	1	BACK-FLOW PREVENTER VALVE
10Mar21		
NoCat		

DisciplineMS.rpt 23feb21 Page 2 of 9



Lot: 83

Model: 50.04 A BEAUMONT

Project/Phase: Pine Valley Forevergreen / 1

DRYWALL

Invoice	Qty.	Description
2564	1	**CUSTOM LAYOUT** DELETE ARCH WAYS BETWEEN LIBRARY AND DINING ROOM
10Mar21 NoCat		
2564	1	FYI - KITCHEN: UPGRADE GARDEN DOOR ASSEMBLY TO 96"
10Mar21 NoCat		
2564	1	MASTER ENSUITE: DELETE LINEN CLOSET, MAKE DRESSING ROOM AND BEDROOM 4 CLOSETS LARGER
10Mar21 NoCat		
2564	1	MASTER ENSUITE: DELETE LINEN CLOSET, INSTALL ADDITIONAL SINGLE VANITY AND SINK INSTEAD - BASED ON STANDARD FINISHES
10Mar21 NoCat		SEE PLANS FOR DETAILS INCLUDED IN APS
2564	1	**CUSTOM LAYOUT** SWITCH LOCATION OF TUB AND SHOWER ENSUITE 2 TO HAVE TUB + ENSUITE 3 TO HAVE SHOWER
10Mar21 NoCat		BASED ON STANDARD FINISHES
2564	1	THRU OUT: INCREASE HEIGHT OF DOOR TO 8FT SECOND FLOOR - PER DOOR
10Mar21 NoCat		
2564	1	MASTER ENSUITE: DELETE LINEN PANTRY - ADD 2ND VANITY (BASED ON STANDARD FINISHES) - SEE PLAN FOR LOCATION
10Mar21 NoCat		

DisciplineMS.rpt 23feb21 Page 3 of 9



Lot: 83

Model: 50.04 A BEAUMONT

Project/Phase: Pine Valley Forevergreen / 1

ELECTRICAL

Invoice	Qty.	Description
2564 72,281 10Mar21	1	GREAT ROOM: INTERIOR WALL OUTLET: ADDITIONAL 110V WALL INTERIOR RECEPTACLE ON EXISTING CIRCUIT FOR WALL MOUNTED TV - LOCATE APPROX 66" A.F.F. ABOVE FIREPLACE
2564 72,272 10Mar21	1	KITCHEN: 110V WALL RECEPTACLE ON SEPARATE CIRCUIT - FOR WINE FRIDGE - APPLIANCE NOT INCLUDED SEE PLAN FOR LOCATION
2564 72,306 10Mar21	1	KITCHEN: RELOCATE KITCHEN APPLIANCE FROM STANDARD LOCATION - APPROX. "NEW" LOCATION AS PER ATTACHED DRAWINGS SEE PLAN FOR REVISED FRIDGE LOCATION
2564 72,272 10Mar21	1	KITCHEN: 110V WALL RECEPTACLE ON SEPARATE CIRCUIT - FOR FREEZER - APPLIANCE NOT INCLUDED
2564 72,272 10Mar21	1	SERVERY: 110V WALL RECEPTACLE ON SEPARATE CIRCUIT - FOR MICROWAVE - MICROWAVE NOT INCLUDED
2564 72,289 10Mar21	6	GREAT ROOM: 4" E/S LED INTERIOR POT LIGHT - GROUND FLOOR - EACH - INCLUDED IN APS INCLUDES SWITCH
2564 10Mar21 NoCat	1	MASTER ENSUITE: DELETE LINEN CLOSET, MAKE DRESSING ROOM AND BEDROOM 4 CLOSETS LARGER
2672 30Mar21 NoCat	1	*NOTE* VALANCE LIGHTING NOT PURCHASED - HOME OWNER TO COMPLETE AFTER CLOSING

EXTER	EXTERIOR COLOURS				
Invoice	Qty.	Description			
2564	1	EXTERIOR COLOUR PACKAGE: BR1			
10Mar21					

DisciplineMS.rpt 23feb21 Page 4 of 9



Lot: 83

Model: 50.04 A BEAUMONT

Project/Phase: Pine Valley Forevergreen / 1

FRAMING

Invoice	Qty.	Description
2564	1	**CUSTOM LAYOUT** DELETE ARCH WAYS BETWEEN LIBRARY AND DINING ROOM
10Mar21 NoCat		
2564	1	FYI - KITCHEN: UPGRADE GARDEN DOOR ASSEMBLY TO 96"
10Mar21 NoCat		
2564	1	MASTER ENSUITE: DELETE LINEN CLOSET, MAKE DRESSING ROOM AND BEDROOM 4 CLOSETS LARGER
10Mar21 NoCat		
2564	1	MASTER ENSUITE: DELETE LINEN CLOSET, INSTALL ADDITIONAL SINGLE VANITY AND SINK INSTEAD - BASED ON STANDARD FINISHES
10Mar21 NoCat		SEE PLAN FOR DETAILS INCLUDED IN APS
2564	1	**CUSTOM LAYOUT** SWITCH LOCATION OF TUB AND SHOWER ENSUITE 2 TO HAVE TUB + ENSUITE 3 TO HAVE SHOWER
10Mar21 NoCat		BASED ON STANDARD FINISHES
2564	1	THRU OUT: INCREASE HEIGHT OF DOOR TO 8FT SECOND FLOOR - PER DOOR
10Mar21 NoCat		
2564	1	MASTER ENSUITE: DELETE LINEN PANTRY - ADD 2ND VANITY (BASED ON STANDARD FINISHES) - SEE PLAN FOR LOCATION
10Mar21 NoCat		

GLASS AND MIRROR

021100					
Invoice	Qty.	Description			
2564	1	MASTER ENSUITE: DELETE LINEN CLOSET, INSTALL ADDITIONAL SINGLE VANITY AND SINK INSTEAD - BASED ON STANDARD FINISHES			
10Mar21		SEE PLAN FOR DETAILS			
NoCat		INCLUDED IN APS			
2564	1	**CUSTOM LAYOUT** SWITCH LOCATION OF TUB AND SHOWER ENSUITE 2 TO HAVE TUB + ENSUITE 3 TO HAVE SHOWER			
10Mar21		BASED ON STANDARD FINISHES			
NoCat					
2564	1	MASTER ENSUITE: DELETE LINEN PANTRY - ADD 2ND VANITY (BASED ON STANDARD FINISHES) - SEE PLAN FOR LOCATION			
10Mar21					
NoCat					
2672	1	MASTER ENSUITE: UPGRADE SHOWER DOOR HANDLE AND HINGES - MATTE BLACK			
30Mar21					
NoCat					

DisciplineMS.rpt 23feb21 Page 5 of 9



Lot: 83

Model: 50.04 A BEAUMONT

Project/Phase: Pine Valley Forevergreen / 1

GRANITE MARBLE QUARTZ

Invoice	Qty.	Description
2672 101,930 30Mar21	1	KITCHEN: UPGRADE 2 QUARTA COUNTER TOP
2672 101,930 30Mar21	1	POWDER ROOM: UPGRADE 2 QUARTZ COUNTER TOP
2672	1	MASTER ENSUITE: UPGRADE 2 QUARTZ COUNTER TOP
30Mar21 NoCat		2 VANITIES - PER APS
2672	1	ENSUITE 2 + ENSUITE 3 + ENSUITE 4: UPGRADE 2 QUARTZ COUNTER TOP
30Mar21 NoCat		
2715	1	KITCHEN: UPGRADE TO 3CM COUNTERTOP THICKNESS
03Jun21 NoCat		

HARDWOOD

Invoice	Qty.	Description	
2672 6 30Mar21	•	KITCHEN/BREAKFAST: VINTAGE SERIES, 5" RED OAK, NSS ENGINEERED HARDWOOD, 3/4" THK, SCULPTED TEXTURE, UVF FINISH **DIFFERENCE IN PRICE FROM STANDARD HARDWOOD IN APS**	
2672 6 30Mar21	•	THRU OUT STANDARD AREAS - MAIN HALL/ LIBRARY/ DINING/ GREAT ROOM/ UPPER HALL/ MASTER BEDROOM/ BEDROOM 2/ BEDROOM 3/ BEDROOM 4: VINTAGE SERIES, 5" RED OAK, NSS ENGINEERED HARDWOOD, 3/4" THK, SCULPTED TEXTURE, UVF FINISH - LEVEL 4	

INTERIOR TRIM AND DOORS

Invoice	Qty.	Description
2564 72,644 10Mar21	15	THRU OUT: INCREASE HEIGHT OF DOOR TO 8FT SECOND FLOOR - PER DOOR
2564	1	MASTER ENSUITE: DELETE LINEN CLOSET, MAKE DRESSING ROOM AND BEDROOM 4 CLOSETS LARGER
10Mar21 NoCat		
2564	1	MASTER ENSUITE: DELETE LINEN PANTRY - ADD 2ND VANITY (BASED ON STANDARD FINISHES) - SEE PLAN FOR LOCATION
10Mar21 NoCat		

DisciplineMS.rpt 23feb21 Page 6 of 9



Lot: 83

Model: 50.04 A BEAUMONT

Project/Phase: Pine Valley Forevergreen / 1

KITCHEN AND BATH CABINETRY

Invoice	Qty.	Description
2564	1	MASTER ENSUITE: DELETE LINEN CLOSET, INSTALL ADDITIONAL SINGLE VANITY AND SINK INSTEAD - BASED ON STANDARD FINISHES
10Mar21 NoCat		SEE PLAN FOR DETAILS INCLUDED IN APS
2564	1	KITCHEN: RELOCATE KITCHEN APPLIANCE FROM STANDARD LOCATION - APPROX. "NEW" LOCATION AS PER ATTACHED DRAWINGS
10Mar21 NoCat		SEE PLAN FOR RELOCATION OF FRIDGE
2564	1	MASTER ENSUITE: DELETE LINEN PANTRY - ADD 2ND VANITY (BASED ON STANDARD FINISHES) - SEE PLAN FOR LOCATION
10Mar21 NoCat		
2672 101,930	1	THRU OUT: SEE ATTACHED CABINETRY SCHEDULE
30Mar21		
2672	1	FYI - *NOTE* VALANCE LIGHTING NOT PURCHASED - HOME OWNER TO COMPLETE AFTER CLOSING
30Mar21 NoCat		
2715 101,930	1	***REVISED CABINETRY SCHEDULE - JUNE 1 2021*** SEE ATTACHED REVISED CABINETRY SCHEDULE
03Jun21		

MASONRY

Invoice	Qty.	Description
2564	1	FYI - KITCHEN: UPGRADE GARDEN DOOR ASSEMBLY TO 96"
10Mar21		
NoCat		

NETWORK AND WIRING

Invoice	Qty.	Description
2564 72,259 10Mar21	1	GREAT ROOM: CONDUIT PIPE - FOR WALL MOUNT TV - LOCATE APPROX 66" A.F.F. ABOVE FIREPLACE, THRU BASEMENT, TERMINATE AT CABLE LOCATION - SEE PLAN
2564 72,260 10Mar21	1	CONDUIT PIPE - FROM ATTIC TO BASEMENT - ELECTRICAL PANEL IN BASEMENT TO APPROX CENTER OF ATTIC

DisciplineMS.rpt 23feb21 Page 7 of 9



Lot: 83

Model: 50.04 A BEAUMONT

Project/Phase: Pine Valley Forevergreen / 1

P	٨	т	N	Т
	\rightarrow			•

Invoice	Qty.	Description
2564	1	**CUSTOM LAYOUT** DELETE ARCH WAYS BETWEEN LIBRARY AND DINING ROOM
10Mar21 NoCat		
2564	1	FYI - KITCHEN: UPGRADE GARDEN DOOR ASSEMBLY TO 96"
10Mar21 NoCat		
2564	1	MASTER ENSUITE: DELETE LINEN CLOSET, MAKE DRESSING ROOM AND BEDROOM 4 CLOSETS LARGER
10Mar21 NoCat		
2564	1	MASTER ENSUITE: DELETE LINEN CLOSET, INSTALL ADDITIONAL SINGLE VANITY AND SINK INSTEAD - BASED ON STANDARD FINISHES
10Mar21 NoCat		SEE PLAN FOR DETAILS INCLUDED IN APS
2564	1	**CUSTOM LAYOUT** SWITCH LOCATION OF TUB AND SHOWER ENSUITE 2 TO HAVE TUB + ENSUITE 3 TO HAVE SHOWER
10Mar21 NoCat		BASED ON STANDARD FINISHES
2564	1	THRU OUT: INCREASE HEIGHT OF DOOR TO 8FT SECOND FLOOR - PER DOOR
10Mar21 NoCat		
2564	1	MASTER ENSUITE: DELETE LINEN PANTRY - ADD 2ND VANITY (BASED ON STANDARD FINISHES) - SEE PLAN FOR LOCATION
10Mar21 NoCat		
2672	2	MAIN STAIRS: STAIN STAIRS AND LANDINGS
30Mar21 NoCat		STAIRS AND LANDINGS WILL NOT MATCH HARDWOOD FLOORS IN COLOUR/TEXTURE

DisciplineMS.rpt 23feb21 Page 8 of 9



Lot: 83

Model: 50.04 A BEAUMONT

Project/Phase: Pine Valley Forevergreen / 1

PLUMBING

Invoice	Qty.	Description
2564 72,332 10Mar21	1	KITCHEN: ROUGH-IN 1/4" COLD WATER LINE TO FREEZER
2564	1	MASTER ENSUITE: DELETE LINEN CLOSET, INSTALL ADDITIONAL SINGLE VANITY AND SINK INSTEAD - BASED ON STANDARD FINISHES
10Mar21 NoCat		SEE PLAN FOR LOCATION INCLUDED IN APS
2564	1	**CUSTOM LAYOUT** SWITCH LOCATION OF TUB AND SHOWER ENSUITE 2 TO HAVE TUB + ENSUITE 3 TO HAVE SHOWER
10Mar21 NoCat		BASED ON STANDARD FINISHES
2564	1	MASTER ENSUITE: DELETE LINEN PANTRY - ADD 2ND VANITY (BASED ON STANDARD FINISHES) - SEE PLAN FOR LOCATION
10Mar21 NoCat		INCLUDED IN APS
2564	1	MASTER ENSUITE: DELETE LINEN CLOSET, MAKE DRESSING ROOM AND BEDROOM 4 CLOSETS LARGER
10Mar21 NoCat		
2672	1	KITCHEN SINK: BLANCO QUATRUS R U SUPER SINGLE - SS
30Mar21 NoCat		SERVERY SINK IS STANDARD

STAIR AND RAILINGS

Invoice	Qty.	Description

2672 93,812 30Mar21	2 MAIN STAIRS - BASEMENT TO 2ND FLOOR; UPGRADE - EURONLINE (ALL PLAIN) PICKET, 3" HALF-ROUND W/V-GROOVE HANDRAIL, 3 1/2" ALL SQUARE POST WITH PYRAMID TOP POST CAP - PACKAGE A-2	
---------------------------	--	--

WINDOWS AND DOORS

Invoice	Qty.	Description
2564	1	KITCHEN: UPGRADE GARDEN DOOR ASSEMBLY TO 96"
10Mar21 NoCat		
2564	1	THRU OUT: UPGRADE TO BLACK INTERIOR WINDOWS
10Mar21 NoCat		

Page 9 of 9



PV - 83 Cabinetry Schedule

KITCHEN	LIPGRADE DEPRACTED SPONGER	PRICE	OTY	TOTA
ANGERO TRANSPORT	UPGRADE PERIMETER FROM SERIES 2 TO SERIES 5 - MEDIO 6 OYSTER			ļ.
	NO HARDWARE / HOLES IN KITCHEN RETURN TRIP FOR HARDWOOD		1	
	ADD CABINETRY VALANCE			
			1	
	ADJUST CABINETRY FOR 48"W RANGE (N/C)		0.001	
	ADJUST CABINETRY FOR 30"W FRIDGE AND 30"W FREEZER (N/C)	118	1	
	ADD DÉCOR PANELS FOR FRIDGE/FREEZER		1	
	CONVERT BASE CABINETS TO BASE POTS AND PANS DRAWERS		1	
	RE-LOCATE PANTRY TO COPINER ON FRIDGE WALL (36°W) (N/C) ADD DECORATIVE HOOD CARINET ASSESSMENT ASSE		3 .	
			1	
	CONVERT STD. UPPER INTO HUTCH CABINET WITH 9"/12"H DRAWER COMBINATION IN WHITE 3/4"	1.00	1 :	
	ADD BEVELLED CLEAR GLASS INSERTS TO HUTCH CABINET		1	
	ADJUST BASE CABINETRY FOR 24"W WINE FRIDGE (N/C)		1	
	ADD DÉCOR PANEL FOR WINE FRIDGE (GLASS INSERT)	110		
ISLAND	*NOTE: PLEASE SEE ADJUSTED ISLAND SIZE AND LOCATION*		•	
	UPGRADE FROM SERIES 2 TO SERIES 6 - MEDIO 6 MIDNIGHT BLUE			
_	ADD SPICE PULL OUT ACCESSORY TO ISLAND		1 5	
	ADD 2-BIN RECYCLE CENTRE TO ISLAND		1 6	
	ADD OVERSIZED DUMMY DOORS TO SIDES OF ISLAND		1 \$	
	ADD PROUD KICK PLATE TO SIDES + REAR ISLAND			
	ADD DECOR PANEL FOR DISHWASHER		2 \$	
	THE SECON PARCE FOR DISHWASHER		1 9	
			- 3	
ERVERY	UPGRADE FROM SERIES 2 TO SERIES 6 - MEDIO 6 MIDNIGHT BLUE			
	ADD BUILT IN MICROWAVE CABINET WITH DRAWER BELOW		1 \$	
	S. S		1 \$	
OWDER ROOM	UPGRADE FROM SERIES 2 TO SERIES 6 - MEDIO 6 MIDNIGHT BLUE		\$	
	2 TO SERIES 0 - INIEDIO 6 MIDNIGHT BLUE		1 \$	
			\$	
	CABINETRY TO	7741-		
	CABINETATIO	MAL.	5	

HANDLE PLACEMENT: AT INSTALLERS DISCRETION

LOT #: BB DATE: NIARON 20 2021	
SIGNATURE: A CAPACITICO	
SIGNATURE:	
*Revised * PV-83 PAP	GOLDPARK WOTH MOST
June 1, 2021	REVISED: 12/18/2020 15:24



PV - 83 Cabinetry Schedule


Amended June 1, 2021

ROOM	DESCRIPTION	PRICE	QTY	TOTAL
KITCHEN	REVISED: ADD DECORATIVE HOOD CABINET - ASPEN MODERN - IN MEDIO 6 'MIDNIGHT BLUE'		1	
	DELETE ITEM: SPICE PULL OUT ACCESSORY		1	
	ADD ITEM: DECORATIVE POST + APPLIED MOULDING TO SIDES OF ISLAND		1	
	CABINETRY	TOTAL:		


HANDLE PLACEMENT: AT INSTALLERS DISCRETION

LOT#: PV-83 DATE: June 1, 2021	
SIGNATURE:	
SIGNATURE: (Menual)	e .

GOLDPARK

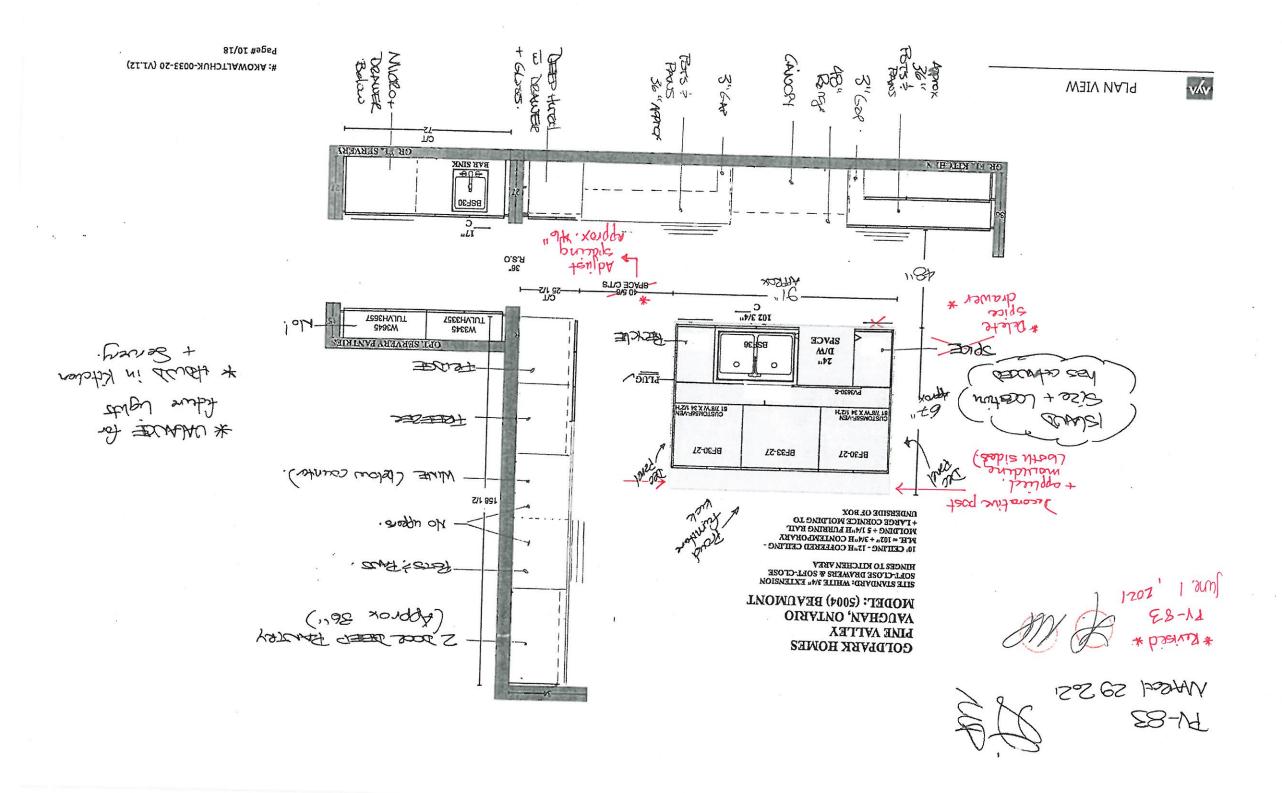




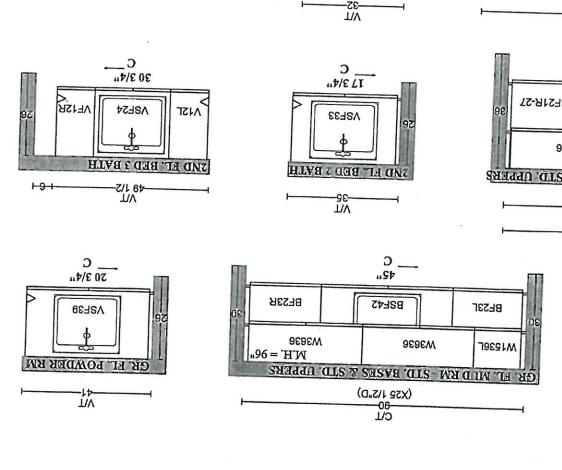

.. t/I 9I


VSF30

SVD FL. BED 4 BATH

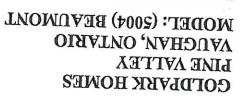




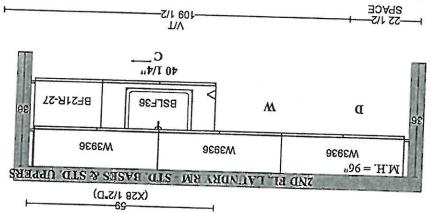

 Π

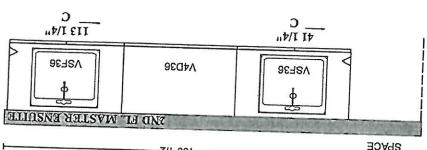

INTERIOR COLOUR SCHEME

*** NOTE: This is not an approved document. Document must be locked ***

Scheduled Closing Date: Wednesday, August 18, 2021

Purchasers:

MICHAEL PAIANO & LAURA, LEE PAIANO

Property: 83 of Plan -

Telephone Res. / Bus: / (416) 459-9282

Project: Pine Valley Forevergreen - Phase 1

Decor Advis	or:

Amanda Ceresino

		Todel and Elevation: 50.04 A BEAUMON		
yout Changes: O Yes	No Sketch Attached:	Yes No Exterior Colour Scheme:		
. Cabinetry	Style and Colour	Counter	Hardware	
Kitchen / Breakfast	2-tone	*Quartz: Organic White	attachd	
Laundry Room	Chesapeake 'Classic White'	Std: P-Lam 'White'	attachd	
Powder Room	*Medio 6 'Midnight Blue'	*Quartz: Organic White	attachd	
Mud Room	Chesapeake 'Classic White'	Std: P-Lam 'White'	attachd	
Master Ensuite Bathroom	Podena Chesapeake 'Classic White'	*Quartz: Organic White	attachd	
Second Ensuite Bathroom (If Applicable)	Modera 'Nassa	*Quartz: Organic White	attachd	
Ensuite 3	Modena Classic White			
	Tribecca Stello	*Quartz: Organic White	attachd	
Comment Kitchen Perimeter: Media 6 'Overte	or / Kitchen loland i Canana Madia C 184	idnight Blue' // Ensuite 4: Tribeeca 'Stello ' + *Quartz: Organi		
	. A Michigan Stand & Gelvery, Wedio C Wil	Modena Classic White)	c white	
Floor Tile				
i loor tile	Selection			
Entrance Vestibule	*24x24" Volkas polished 'White	e'		
Main Hall				
Kitchen / Breakfast	see hardwood			
Laundry Room 13x13" Cambridge matte 'White' Powder Room *24x24" Volkas polished 'White'				
Mud Room	13x13" Cambridge matte 'White'			
Master Ensuite Bathroom	13x13" Cambridge matte 'White' 13 x 13" Capri 'White'			
Second Ensuite Bathroom (If Applicable)	12x12" Construct 'Black' 1/2	1 x 24" Land 'Anthracite'	• .	
Lower Landing (If Applicable)	13x13" Cambridge matte 'Whit	te'		
Ensuite 3	12x12" Construct 'Black' *	2 x 24" Land 'Authracite'		
Comment	1	MAN HINETIO		
Ensuite 4: 13x13" 12x12" Construc *12×24" Lan	ot 'Black'// Shower Floors thru out: std 2x d'Anthracite'	2" white / Master Ensure Shower Floor * Octario HEX. 'Snow	: White Mac	
Wall Tile	Selection Chass Arctic	Spicial Listello/Inserts Describe		
Ensuite 3	8x10" Uniwall 'White' Whi			
Master Ensuite Bathroom				
Tub De	eck 4x16" CDC 'Arctic Brie	No Yes No		
	tall 8x10" Uniwall 'White' White			
		Yes No		
Bathroom Wa		17 101		
Bathroom Wa Second Ensuite	3x6" Chess 'Arctic' 8x10" Uniwall White'	Bright		
Bathroom Wa Second Ensuite Bathroom (If Applicable)	3x6" Chess Arctic 8x10" Uniwall 'White' Wh 3x6" Chess Arctic	Bright Yes No		
Bathroom Wa Second Ensuite Bathroom (If Applicable) Ensuite 4	3x6" Chess 'Arctic' 8x10" Uniwall 'White' Wh	Sricht Yes No		
	3x6"Chrss Arctic 8x10"Uniwall'White' Wh 3x6"Chrss Arctic 8x10"Uniwall'White' White	Sright Yes No No		

GOLDPARK INTERIOR COLOUR SCHEME ** NOTE: This is not an approved document. Document must be locked *** Scheduled Closing Date: Wednesday, August 18, 2021 Purchasers: MICHAEL PAIANO & LAURA, LEE PAIANO Property: 83 of Plan -Telephone Res. / Bus: / (416) 459-9282 Project: Pine Valley Forevergreen - Phase 1 Decor Advisor: Amanda Ceresino Model and Elevation: 50.04 A BEAUMONT 4. Plumbing Fixtures Second Ensuite Powder Room Master Ensuite Bathroom Other Room - Specify Other Washroom Comment See extras 5. Hardwood Flooring Type and Stain Main Hall Type and Stain Upper Landing Kitchen / Breakfast *3/4x5"red oak sculpted 'Hillside Upper Hall Living Room Master Bedroom **Dining Room** Bedroom #2 Family Room Bedroom #3 Den/Library Bedroom #4 **Entrance Vestibule** Bedroom #5 Lower Landing Other Room - Specify (If Applicable) *3/4x5"red oak sculpted 'Hillside' *Thru out std areas Comment Carpeting Upgrade Description Ground Floor Second Floor Type Upgrade Underpad Capped Runner - *Upgrade Carpet on Stairs Comment 7. Fireplace Living Room Family Room Other Room - Specify Purchased As Per Plan N/A Purchased As Per Plan N/A Purchased As Per Plan 0 Fireplace Type Standard Gas Mantle Type Mediterranean Colour / Stain Arctic White Surround n/a Hearth none Comment

GOLDPARK INTERIOR COLOUR SCHEME ** NOTE: This is not an approved document. Document must be locked *** Scheduled Closing Date: Wednesday, August 18, 2021 Purchasers: MICHAEL PAIANO & LAURA, LEE PAIANO Property: 83 of Plan -Telephone Res. / Bus: / (416) 459-9282 Project: Pine Valley Forevergreen - Phase 1 Decor Advisor: Amanda Ceresino Model and Elevation: 50.04 A BEAUMONT 8. Trim Carpentry Interior Doors Carrara Front Door Glass Inserts Standard Door Handles Standard Interior Trim Standard Package Comment 9. Plaster Mouldings and Medallions Standard Throughout O Yes O No Entrance Vestibule Kitchen/Breakfast Main Hall Den/Library Living Room Lower Landing Dining Room Other Room - Specify Family Room Comment 10. Railings and Spindles Railing Package A2 package Railing Colour *Zeus Spindle Colour *Black Stringer / Riser *Zeus Treads *Zeus Oak Stairs Comment Yes O No O N/A 11. Wall Paint / Ceilings

Page 3 of 4

Trim Paint

Comment

Smooth Ceilings

Note


Ground Floor Second Floor

Throughout Finished Areas Warm Grey

White

GOLDPAR	RK	INTERIOR COLOUR SCHEME
WORTH	MORE. *** NOTE: This is n	ot an approved document. Document must be locked ***
Purchasers:	MICHAEL PAIANO & LAURA,	Scheduled Closing Date: Wednesday, August 18, 2021
Telephone Res. / Bus:	/ (416) 450-0282	
Decor Advisor:	Amanda Ceresino	Project: Pine Valley Forevergreen - Phase 1
		Model and Elevation: 50.04 A BEAUMONT
12. Electrical	and the second s	
Hood Fan Wh	ite O Stainless N/A	Above Kitchen Cabinet Light O Yes No
		Below Kitchen Cabinet Light Yes No
Standard Appliance	s	140
Over The Range Mic	rowave	
Chimney Style Fan		
12 11		
Air Conditioning	ir Conditioning	
Gas Provisions Drye	no	Gas Provisions Stove yes
Comment	r no	Gas Provisions Barbecue std
Disclaimers and	d Notes	
1) Colours of all materials are	e as close as possible to builder's selec	ction, but not necessarily identical due to variances in manufacturing.
2) Any extras listed above are	e null and void unless accompanied by	a separate invoice/amendment. Said invoice must be paid in full.
The Purchaser acknowledge	ges that after Interior Colour Selection	form is signed and detail as 6, 4
	1 didiase	a 3 littlats
The Purchaser acknowledgether miscellaneous disclared	ges reading and accepting the "Gold Palmers.	ark Homes Decor Centre Disclaimers" form. This document contains
This Interior Colour Selection	is final and approved by:	
10	V -	
Signature:	Milita Date:	
\mathcal{A}		
7		Page 4 of 4
Printed 3/29/2021 14:57:	35	

SCHEDULE'F'

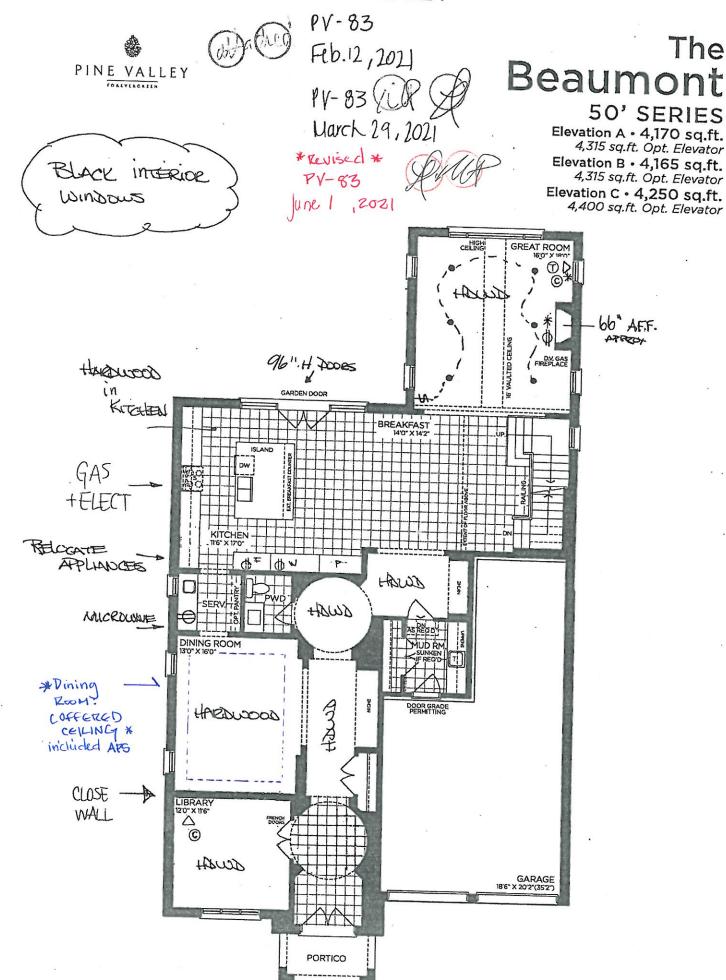

GROUND FLOOR | ELEV. A

VENDOR
PURCHASER
PURCHASER

GOLDPARK

Prices, figures, illustrations, sizes, features and finishes are subject to change without notice. Areas and dimensions are approximate and actual usable floor space may vary from the stated area. Layout may be reverse of the unit purchased. E. & O.E. 5004

PINE VALLEY

8ff DOORS TARU OUT 2nd FLOOR SCHEDULE'F'

PV-83 Feb. 12, 2021

March 29, 202

* REVISED* PV-83 June 1, 202


The Beaumont

50' SERIES

Elevation A • 4,170 sq.ft. 4,315 sq.ft. Opt. Elevator


Elevation B • 4,165 sq.ft. 4,315 sq.ft. Opt. Elevator Elevation C • 4,250 sq.ft.

4,400 sq.ft. Opt. Elevator

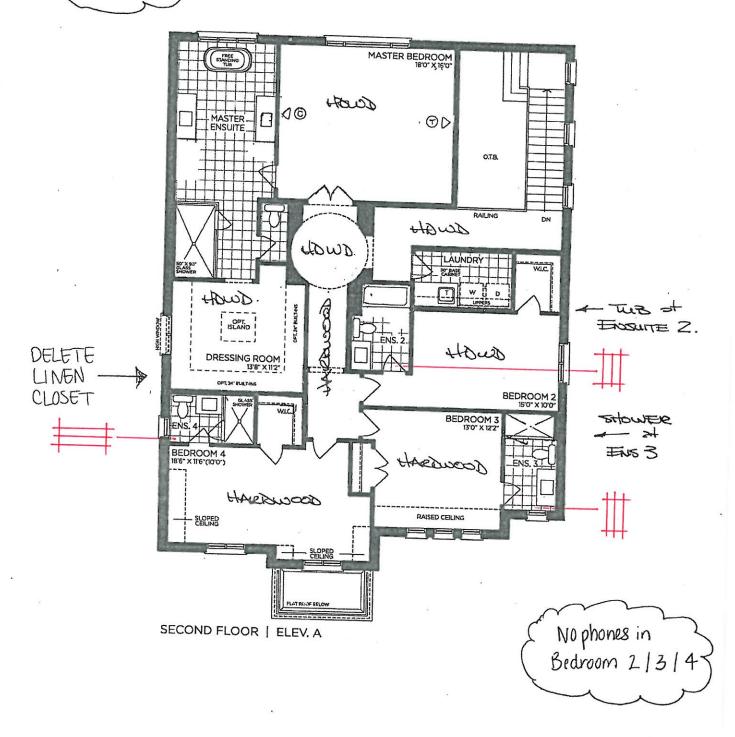

VENDOR PURCHASER PURCHASER GOLDPARK

Prices, figures, illustrations, sizes, features and finishes are subject t notice, Areas and dimensions are approximate and actual usable floor space may vary from the stated area, Layout may be reverse of the unit purchased, E. & O.E. 5004

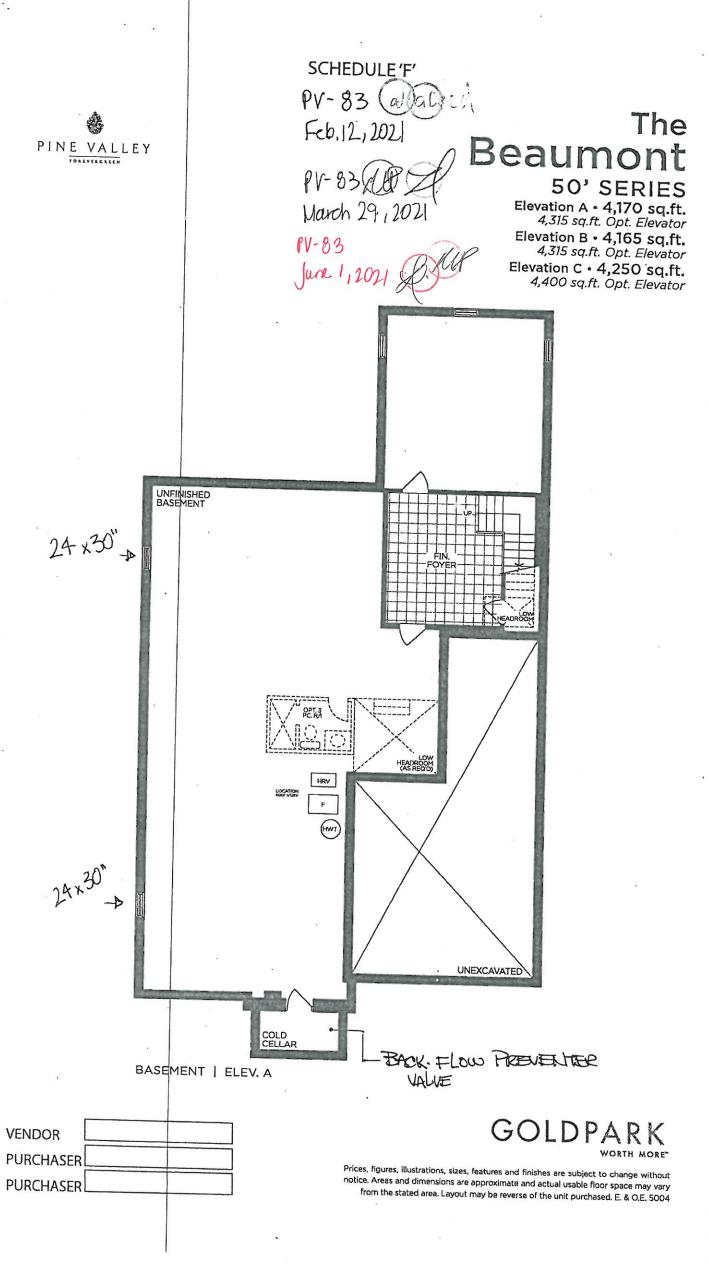



STONE COUNTERTOP EDGE PROFILES

June 2, 2021

	STANDARD 2CM EASED EDGE	LOCATION:
	UPGRADE 3CM EASED EDGE	LOCATION:
	UPGRADE 4CM MITRED EDGE	LOCATION:
	UPGRADE 2CM OGEE EDGE	LOCATION:
SIGNATURE: SIGNATURE: ** Trevised **	DATE: March 29	GOLDPARK WOITH MOST



GOLDPARK

STONE COUNTERTOP EDGE PROFILES

	STANDARD 2CM EASED EDGE	LOCATION: THRU OUT
	UPGRADE 3CM EASED EDGE	LOCATION: 紫以itchen 治
	UPGRADE 4CM MITRED EDGE	LOCATION:
	UPGRADE 2CM OGEE EDGE	LOCATION:
OT#: NV-83 IGNATURE:	DATE: March 29,	2021



STONE COUNTERTOP EDGE PROFILES

	STANDARD 2CM EASED EDGE	LOCATION:
	UPGRADE 3CM EASED EDGE	LOCATION:
	UPGRADE 4CM MITRED EDGE	LOCATION:
	UPGRADE 2CM OGEE EDGE	LOCATION:
OT#: PV - 83	DATE: March 29	2021
IGNATURE:		


K002-02	K002-03	K002-04
K002-06	K002-05 MUD ROOM LAUNTON MASTER Ens 2 Ens 3 Ens 4	K008-14
K024-03	*NO HARDWARE KITCHTOL. POLETIE	*TOUCH-LATCH
LOT# PV-83 DATE: Murch	29,2021	
SIGNATURE:		
SIGNATURE:		



BLANCO - QUATRUS R15 U SUPER SINGLE

Stainless Steel - Undermount 32" x 18" x 9"



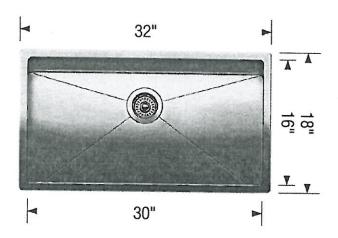

Stainless Steel

GRID - No!


MODEL 401518 Stainless Steel /_406347 Grid-

Lot# 83	
Room:	Signature:
Date: 19 2021	Signature



MT6X6

Shower Door Handle

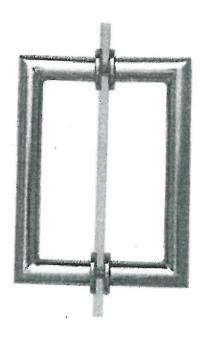


6" x 6" back-to-back 3/4" dia. tube Cut and mitred corners with washers (Also available single sided) CHROME MATTE BLACK + HINGE BRUSHED GOLD	MT6X6 Shower Door Handle	
	3/4" dia. tube Cut and mitred corners with washers	MATTE BLACK + HINGES

Lot# 83	Date: MARCEL 20 202	Room:
Signature:	Mymin	
Signature:		-



SDK106

Shower Door Knob

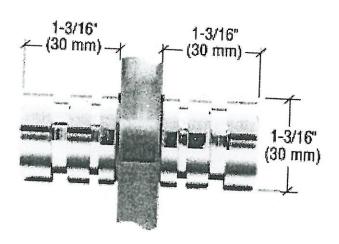


SDK106 Shower Door Knob

1-3/16" dia. Contemporary Style (Also available single sided)

CHROME

Lot# 1V-83 Date: March 29,2021	Room: ENSULTE 3+4.
Signature:	
Signature:	



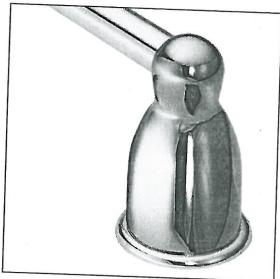

Tissue Holder Mason - Chrome


Towel Bar Mason - Chrome

Please select one of the following:

INSTALL STANDARD BATHROOM ACCESSORIES THRU OUT (tissue holder + towel bar) *location as per vendors discretion*	ě	
DO NOT INSTALL STANDARD BATHROOM ACCESSORIES THRU OUT *tissue holder + towel bar will not be provided*		V -
LOT # PV - 83 DATE: March 29,2021		
SIGNATURE: Marine		
SIGNATURE:		



Range Hood - Aspen Modern

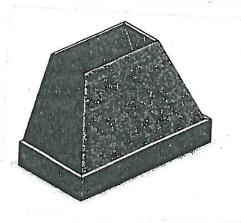

Lot#	
Room: Kitated	Signature:
Date:	Signature



Date: March 29,207


Project: Pine Valley

Purchaser(s): Michael Paiano Laura Lee

Standard Hood Fan Deletion

We acknowledge that the builder's standard hood fan will not be installed. Do not supply, install and/or credit. We will install our own hood fan after closing.


Signature:

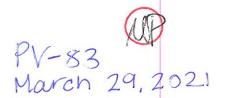



VCIN48GWS 48-INCH CUSTOM INSERT PROFESSIONAL® SERIES



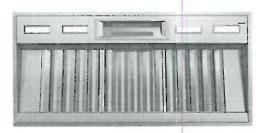







FEATURES & BENEFITS

- Revel in creative freedom with Professional® Series custom inserts that can blend in with cabinetry or make a bold
- ★- Equipped with the Thermador Connected Experience by Home Connect™
 - Powerfully Quiet® system accepts integral, inline, and remote blowers
 - Beautiful illumination with multi-level, vivid LED lights
 - Features automatic mode, delay shut-off, and check filter light

ACCESSORIES (OPTIONAL)

25 ft. Blower Connector Cable - EXTNCB25W

For use with the following inline and remote blowers: VTR630W, VTR1030W, VTR1330W, VTI610W, VTI1010W

Roofplates

RFPLT600P - For use with 600 CFM remote blower VTR630W

RFPLT1000P - For use with 1000 CFM remote blower VTR1030W and 1300 CFM blower VTR1330W

VCIN Trim Notes

NOTE: VCIN_GWS series custom insert models include hood trim pieces to complete the installation.

Remote Control Panel

REMCPW - Ability to vertically install on cabinetry or wall to control hood in a convenient location



GENERAL PROPERTIES


Multi-Level LED Lights with Fading Transitions, Automatic Mode, Check Filter Reminder Light, Delay Shut-Off

Filter Reminder Light, Delay Shut-On	
Operating Mode	Ducted
Maximum CFM	Blower Sold Separately
Number of Speed Settings	4-Stage
Number of Lights	4
Bulb Type	LED
Light Lumens	100 – 150
Light Color (°K)	3500 – 4000
Total Power of the Lamps (W)	4.8 W
Damper Included	Yes
Grease Filter Material	Washable Stainless Steel
Grease Filter Type	Stainless-Steel Commercial Style Baffle Filter
Home Connect™ (Wi-Fi Enabled)	Yes
TECHNICAL DETAILS	
Watts (W)	See Chart on Page 3
Current (A)	See Chart on Page 3
Volts (V)	120 V
Frequency (Hz)	60 Hz
Plug Type	Fixed Connection
Power Cord / Conduit Length (in)	Direct Wire at Junction Box
DIMENSIONS & WEIGHT	THE PARTY NAMED IN STREET
Overall Appliance Dimensions (Width of Canopy Included) (HxWxD) (in)	12 13/16" x 45 3/4" x 22"
Minimum Required Distance Above Gas / Electric Cooking Surface	30" Electric / 30" Gas
Diameter of Air Duct (in.) Top	10"
Net Weight (lbs)	65 lbs
ACCESSORIES (REQUIRED)	4400 K-4 大学 2 10 本

ACCESSORIES (REQUIRED)

Blower (Sold Separately)

BLOWER OPTIONS	
Remote Blowers	VTR630W - 600 CFM
(Mounted to Roof or External Wall)	VTR1030W - 1000 CFM
	VTR1330W - 1300 CFM
Inline Blowers	VTI610W - 600 CFM
(Mounted Between Kitchen and External Wall)	VTI1010W - 1000 CFM
Integrated Blower (Mounted in Hood)	VTN630W - 600 CFM
-	VTN1090R - 1000 CFM
WARRANTY	THE MANAGEMENT OF THE
Limited Warranty Parts and Labor	2 Year

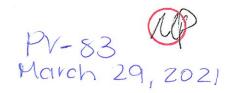




VCIN48GWS 48-INCH CUSTOM INSERT PROFESSIONAL® SERIES

Thermador.**

HOOD DIMENSIONS

NOTE: VCIN Custom Insert models include hood trim pieces.

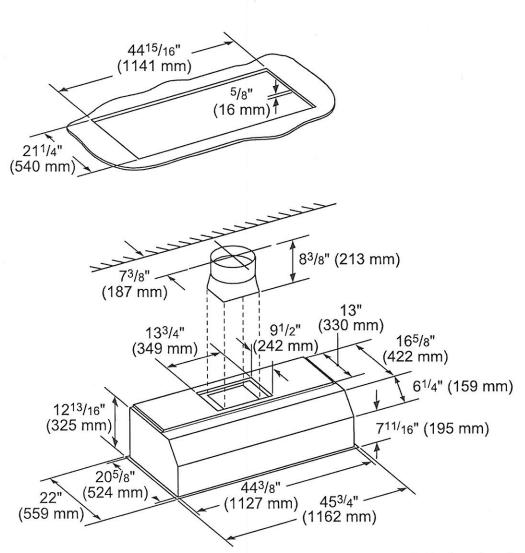

measurements in inches (mm)



Fresh Living Tip

shelving for food and beverages than any other model in the Marvel lineup. Plus each shelf glides most versatility between wine storage and flat enthusiasm, consider this model. It offers the If you love wine and good food with equal out to access contents easily.

FINISH OPTIONS

24" Marvel Professional **Beverage Center**

Performance

- $5.5\,\mathrm{cu}.$ ft. capacity stores 19 wine bottles total (14 flat, 5 cradled) and holds (108) 12-oz cans
- (2) 3-in-1 Slide-Out Split Convertible Shelves feature removable glass pane with wine rack option to store beverages, food or wine
 - Display wine rack glides out for easy access and holds 5 wine bottles, including magnum sizes
- Access contents easily with full-extension shelf, glideout shelving on the smooth-glide ball bearing system
- Cantilevered shelving system adjusts height to your storage needs

Cooling Performance

- Dynamic cooling technology delivers rapid cool down, frost-free operation and precise temperature stability
 - Thermal-efficient cabinet ensures optimum food preservation and energy efficiency while maximizing capacity
- Argon-filled, UV-resistant tinted dual pane glass door protects contents from damaging ultraviolet light and helps conserve energy

Convenient Controls

- Multifunction controls allow you to select a precise cabinet temperature from 33°F to 70° F
 - Audible alarms for door ajar and high/low temperature ensure your contents stay at optimal temperature
 At the touch of a button, change the interior light color to sapphire blue or arctic white
- Theater-style display lighting gently brightens as door is opened and dims to off when closed

Fit & Finish

- Elegant midnight black interior
- Professional styling: robust full-length handle and stainless steel accents
 Reversible soft-close door allows for right or left swing
- Door lock provides added security

Warranty

3-year parts and labor warranty with product registration and 5-year sealed system parts warranty

3-in-1 Convertible Shelf

A dynamic food, beverage and wine storage solution, this adaptable beverage center features two versatile glass shelves that convert to a wine rack option. An additional display wine rack can hold a variety of bottle types, including magnum sizes.

Glass Shelving -


Glass Shelving and Wine Rack





MODEL NUMBER	MPBV424-SG31A	MPBV424-IG31A	MPBV424-IS31A	MPBV424-SS31A
TYLE	Stainless Steel Frame Glass	Panel Ready Frame Glass	il Ready	lless Steel
DOOR STYLE	Stainless S	Panel Read	Solid Panel Ready	Solid Stainless Steel





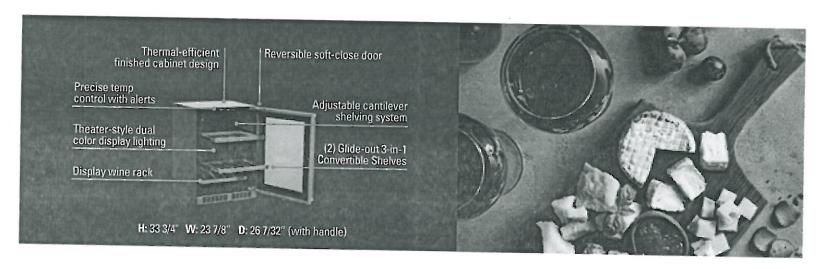

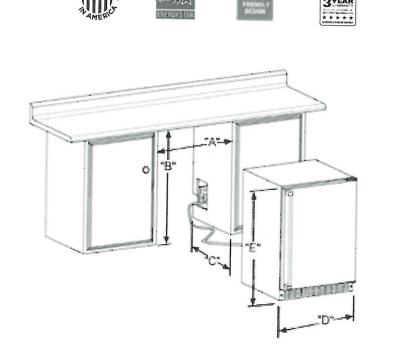

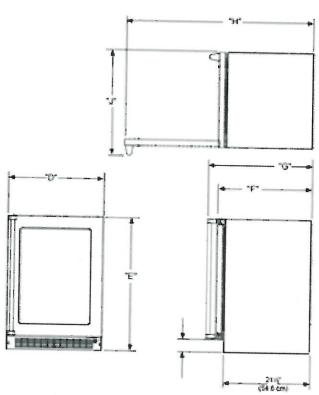

Rough In	Dimensions*		Cabinet Di	mensions*				
"A"	"B"	"C"	"D"	"E"	"F"	"G"	"H"	",]"
24"	34-1/4" to 35-1/4"	24"	23-7/8"	33-5/8" TO 34-5/8"	23-5/8"*	26-1/8"*	47-3/4**	26-1/2"*
(61 CM)	(87 CM to 89.5 CM)	(61 CM)	(60.7 CM)	(85.4 CM TO 87.9 CM)	(60 CM)	(66.3 CM)	(146.6 CM)	(67.3 CM)

^{*}Stainless steel model dimensions only. For panel-ready models, see the owner's guide online at marvelrefrigeration.com.

Capacity Control Type 5.5 CU. FT. Electronic

Sabbath Mode

Yes 33°F to 70°F

Temperature Range Handle Style Hinge Type

Professional (handle not included on panel-ready models) Reversible Soft-Close

Interior Lighting Shelving System

White + Blue LED

Toe Grille Finish

Cantilever Stainless Steel

(Black on Panel-Ready Models)

Lock

Yes

Electrical Requirements

115V / 60 Hz / 15A

Cord Length

6 FT.

Shipping Dimensions

28" W x 31" D x 37" H

Shipping Weight Agency Approval

160 LBS

Agency Approval UL Refrigerant Type R600a

For comprehensive installation instructions, including panel overlay details, please visit marvelrefrigeration.com to access the owner's guide.



marvetrefrigeration com | 616.754.5601



PRD486WIGC

48-INCH DUAL-FUEL PRO GRAND® INDUCTION RANGE PROFESSIONAL SERIES, COMMERCIAL-DEPTH, PORCELAIN COOKTOP SURFACE










FEATURES & BENEFITS

- ★ 4 ExtraLow® burners for simmering, melting, or holding long durations
- ★ ExtraHigh Star® Burner—22,000 BTUs of power for searing or boiling
- \bigstar Hydraulic SoftClose® hinges prevent slamming for ultra smooth closing
 - 3,600W induction: rapid boiling and full surface heating for griddles
 - Superfast 2.5-hour self-clean mode-fastest in the industry

TECHNICAL DETAILS	WE CONTRACTOR
Circuit Breaker	50 A
Volts	240 / 208 V, 60Hz 4 Wire
Energy Source	Gas and Electric
Plug Type	208 / 240V 4 Prong
Power Cord Length	Purchase Separately
Gas Supply	3/4"
WARRANTY	
Limited Warranty, Entire Appliance, Parts and Labor	2 Year

SEE PAGE 2 FOR INCLUDED AND OPTIONAL ACCESSORIES

RANGETOP

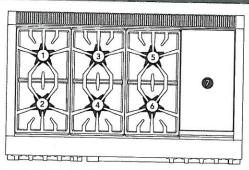

Total Number of Cooktop Burners	6 + Induction
1 – Power of Back Left Burner BTU	15,000 and XLO
2 – Power of Front Left Burner BTU	22,000 and XHI / XLO
3 – Power of Back Center Burner BTU	15,000
4 – Power of Front Center Burner BTU	18,000
5 – Power of Right Back Center Burner BTU	15,000 and XLO
6 – Power of Right Front Center Burner BTU	18,000 and XLO
7 – Power of Far Right 12" Induction	3,600 W
OVEN	THE SECTION
Oven Capacity (Lg / Sm)	5.7 / 2.5 cu. ft.

Cooking Modes - Large Cavity

Bake, Convection Bake, True Convection, Convection Roast, Roast, Convection Broil, Broil

Cooking Modes - Small Cavity

Bake, Convection Bake, Proof, Keep Warm, Convection Roast, Roast, Convection Broil, Broil


Sabbath (Lg / Sm)	Yes / Yes		
Self-Clean (Lg / Sm)	Yes / Yes		
Telescopic Rack(s) (Lg / Sm)	3/2		
Interior Lights (Lg / Sm)	2/1		
Bake Power (Lg / Sm)	2,000 W / 1,400 W		
Broil Power (Lg / Sm)	4,000 W / 2,600 W		
Convection Power (Lg / Sm)	2,750 W / 1,960 W		
Home Connect™ (Wi-Fi Enabled)	Yes, Large Oven Only		
Lg Cavity Interior Dimensions (HxWxD)	16 ¹ / ₄ " x 28" x 21 ¹ / ₂ "		
Lg Cavity Usable Dimensions (HxWxD)	12" x 25 3/8" x 19 1/2"		
Sm Cavity Interior Dimensions (HxWxD)	16 ¹ / ₄ " x 12 ³ / ₈ " x 21 ¹ / ₂ "		
Sm Cavity Usable Dimensions (HxWxD)	12" x 9 3/4" x 19 1/2"		
DIMENSIONS & WEIGHT	ORIGINAL PROPERTY.		
Overall Appliance Dimensions (HxWxD)	35 ³ /4" - 36 ³ /4" x 47 ¹⁵ /16" x 27 ⁷ /8"		
Required Cutout Size (HxWxD)	35 ³ / ₄ " - 36 ³ / ₄ " × 48" × 24" - 25 ¹ / ₈ "		
Net Weight	530 lbs.		

PRD486WIGC


48-INCH DUAL-FUEL PRO GRAND® INDUCTION RANGE PROFESSIONAL SERIES, COMMERCIAL-DEPTH, PORCELAIN COOKTOP SURFACE



48-INCH RANGE DIMENSIONS

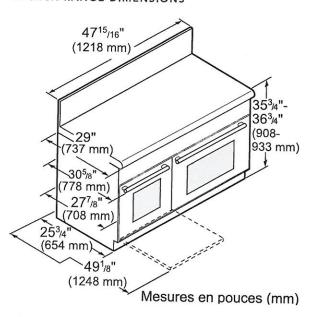

48-INCH RANGE CUTOUT DIMENSIONS

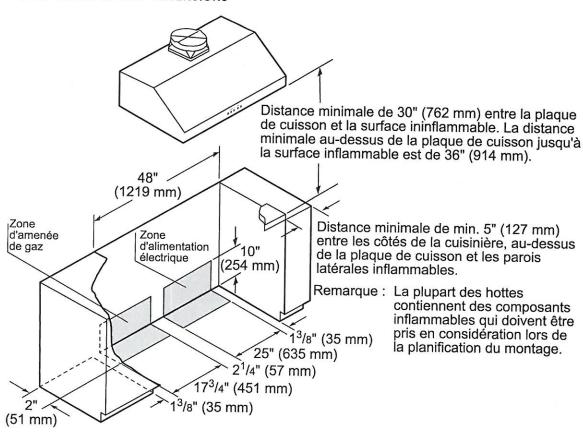



Dimensions en pouces (mm)

48-INCH DUAL-FUEL PRO GRAND® INDUCTION RANGE PROFESSIONAL SERIES, COMMERCIAL-DEPTH, PORCELAIN COOKTOP SURFACE



48-INCH RANGE CUTOUT DIMENSIONS

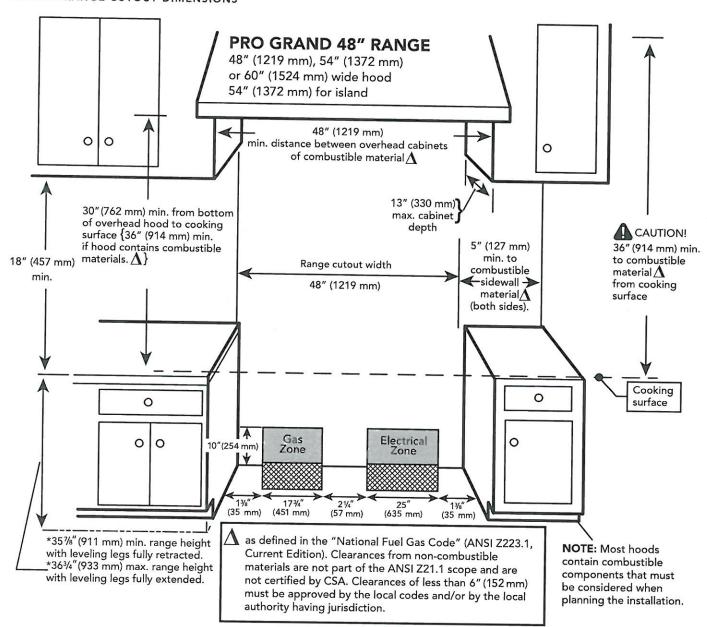

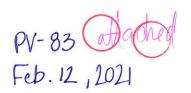


48-INCH DUAL-FUEL PRO GRAND® INDUCTION RANGE

Thermador.


PROFESSIONAL SERIES, COMMERCIAL-DEPTH, PORCELAIN COOKTOP SURFACE

48-INCH RANGE DIMENSIONS AND CLEARANCE REQUIREMENTS WITH "LOW BACK"

NOTE: A 36-inch minimum clearance is required between the top of the cooking surface and the bottom of an unprotected cabinet. A 30-inch clearance can be used when the bottom of the wood or metal cabinet is protected by not less than 1/4 inch of a flame retardant material covered with not less than No. 28 MSG sheet steel, 0.015 inch (0.4 mm) thick stainless steel, 0.024 inch (0.6 mm) aluminum, or 0.020 inch (0.5 mm) thick copper.

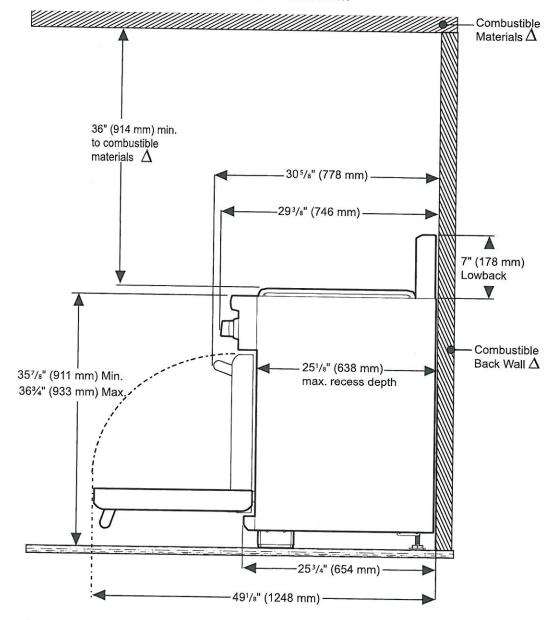

\$\times\$ As defined in the "National Fuel Gas Code" (ANSI Z223.1, Current Edition). Clearances from non-combustible materials are not part of the ANSI Z21.1 scope and are not certified by CSA. Clearances of less than 6" (152 mm) must be approved by the local codes and/or by the local authority having jurisdiction.

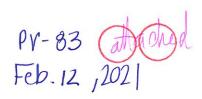


48-INCH DUAL-FUEL PRO GRAND® INDUCTION RANGE

Thermador.**

PROFESSIONAL SERIES, COMMERCIAL-DEPTH, PORCELAIN COOKTOP SURFACE

48-INCH RANGE DIMENSIONS AND CLEARANCE REQUIREMENTS WITH "FLUSH ISLAND TRIM"

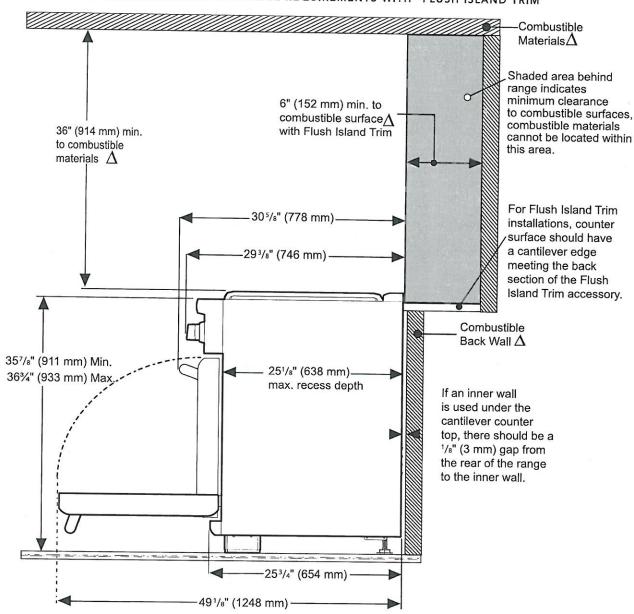


\$\times\$ As defined in the "National Fuel Gas Code" (ANSI Z223.1, Current Edition). Clearances from non-combustible materials are not part of the ANSI Z21.1 scope and are not certified by CSA. Clearances of less than 6" (152 mm) must be approved by the local codes and/or by the local authority having jurisdiction.

These warranties give you specific legal rights and you may have other rights that wary from state to state. Full warranty and limited warranty from date of installation. For complete warranty details, refer to your Use & Care manual, or ask your dealer.

Specifications are for planning purposes only. Refer to installation instructions and consult your countertop supplier prior to making counter opening. Consult with a heating and ventilation engineer for your specific ventilation requirements. For the most detailed information, refer to installation instructions accompanying product or write to Thermador indicating the model number. Specifications are correct at time of printing. Thermador reserves the right to change product specifications or design without notice. Some models are certified for use in Canada. Thermador is not responsible for products that are transported from the U.S. for use in Canada.

1 800 735 4328 | USA THERMADOR COM | CANADA THERMADOR CA | ©2019 BSH HOME APPLIANCES CORPORATION. ALL RIGHTS RESERVED.

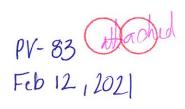

T301F905SP 30-INCH BUILT-IN FREEZER COLUMN WITH INTERNAL ICE MAKER FREEDOM® COLLECTION, PANEL-READY

Thermador.**













FEATURES & BENEFITS


- Full Stainless Steel Inner Liner
- Freedom® Hinge enables true flush design
- Auto Door Opening provides the opening of the door with just a slight push or pull
- SoftClose® Drawers for easy and controlled storage
- Sleek clean design for the perfect symmetry when paired with $\dots \dots$ additional columns
- TFT control panel managing all your columns functions

TEMPERATURE RANGES	PINTED THE PROPERTY OF THE		
Freezer	-11°F (-24°C) to 7°F (-14°C)		
SuperFreeze®	-22°F (-30°C) for approximately 52 ho		
Energy Saving (Economy) Mode	3°F (-16°C)		

Home Connect™ (Wi-Fi Enabled)	Yes		
Panel Ready	Yes		
Reversible Door Swing	Yes		
SoftClose® Door	Yes*		
SoftClose® Drawers	Yes		
Lighting	LED Sidewall and Theater Lighting		
Freezer Shelves	4		
Adjustable Shelves	3		
Shelf Material	Glass w/Aluminum Profile		
Full Extension Drawers @ 115° Door Opening Angle	Yes		
General Use Drawer	2		
Door Bins	4		
External LED Proximity Sensor	No		
Oversized Dispenser Opening	No		
Chilled Water, Crushed and Cubed Ice	No		
Rapid Water Replenishment System	No		
Ice Maker with Diamond Ice System	Yes		
Door Open Alarm	Yes		
Open Door Assist	Yes		
Special Modes	Sabbath, Economy Vacation		
CAPACITY			
Total Capacity (cu. ft.)	15.8 cu. ft.		
PERFORMANCE			
Dedicated Evaporator & Compressor System	Yes		
SuperFreeze®	Yes		
Defrost Process	Frost-Free		
Jenost Process			
FECHNICAL DETAILS	and the state of t		
	350 W		
Vatts (W) Current (A) Volts (V) Frequency (Hz) Power Cord Length (in.) Plug Type DIMENSIONS & WEIGHT Appliance Dimensions (H x W x D) (in.) Required Cutout Size (H x W x D) (in.)	350 W 15 A 110-120 V 60 Hz 118 120V-3 Prong 84"** × 29 3/4" × 24 84" × 30" × 25"		

^{*}To verify if you have a refrigeration unit with Soft-Close capability please contact our customer team by calling 1-800-735-4328.

**Height adjustable + / -1/2* (+ / -13 mm)

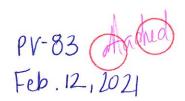

T301F905SP 30-INCH BUILT-IN FREEZER COLUMN WITH INTERNAL ICE MAKER

Thermador*

FREEDOM® COLLECTION, PANEL-READY

WARRANTY	
Limited, Entire Appliance, Parts and Labor on Any Part of the Refrigerator that Fails Because of a Manufacturing Defect	2 Year
Limited Warranty for Sealed Refrigeration System*; Parts and Labor	3rd to 6th Year
Limited Warranty for Sealed Refrigeration System*; Parts Only	
Limited Warranty for Stainless Steel Rust-Through	7th to 12th Year
*Sealed refringration system includes	Lifetime

des compressor, evaporator, condenser, dryer / strainer and connection tubing

CUTOUT DIMENSIONS

30" (762 mm) 84"-85¹/16' (2134 mm-2164 mm) AΘ min. 4' (102 mm)


Furniture return

A: Area for installation of power connection.


B: Area for running the water line. It is recommended that the waterbox is placed adjacent to the installation cavity, so that it can be accessed for service without uninstalling the appliance. If this is not possible, place the recessed waterbox adjacent to the water supply socket elevated at the heights as referred to the water supply socket elevated at the heights as referenced in areas A and B.

C: Niche depth depends on kitchen design. For a flush installation, the depth needs to be at least 24 inches plus the thickness of the door panel.


Stainless steel models contain a panel-ready base unit, ready-to-install stainless steel door(s) with a right or left door swing and handle(s).

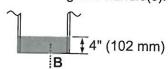

TOP VIEW CLEARANCE

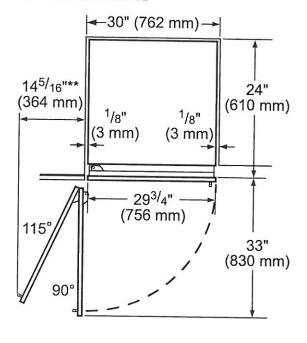

- Door handle must be added to this dimension
- * Depends on the thickness of the unit door. 3/4" (19 mm) refers to the stainless steel door. (special accessory).

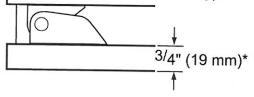


Feb. 12, 2021

T301F905SP 30-INCH BUILT-IN FREEZER COLUMN WITH INTERNAL ICE MAKER FREEDOM® COLLECTION, PANEL-READY

Thermador*

PRODUCT AND PANEL DIMENSIONS

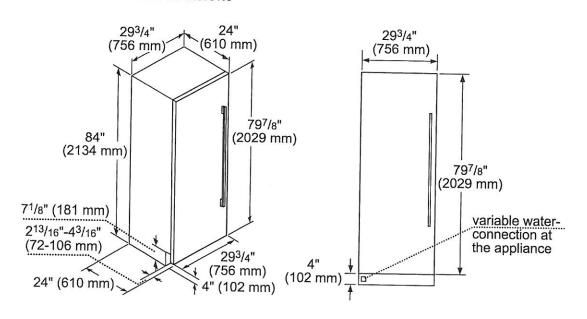

ACCESSORIES (OPTIONAL)

FLAT STAINLESS STEEL DOOR PANELS

30-Inch Flat Stainless Steel Door Panel Without Dispenser



TFL301R800 For use with Handle TFL301R905 Handleless

NOTE: Handleless Panels should not be installed on units without the Soft-Close capability. If you are uncertain if you have a refrigeration unit with Soft-Close capability please contact our customer team by calling 1-800-735-4328.

HANDLES

Choose between two options:

PR36HNDL20 36-Inch Professional Series Handle

MS36HNDL20

36-Inch Masterpiece® Series Handle

REPLFLTR55

STORAGE



ICEBUCKETL Large Ice Bucket

FILTERS



Freedom® Water Filter Replacement water filter for use in all freezer and bottom freezer models



freezers, etc.) side-by-side combinations or instances where any appliances are installed less than 6-inches (152 mm) apart from one another but not connected side-by-side, purchase this kit. This kit is recommended for use with any installation in areas that are subject to humidity, or located next to an outside wall.

FRAMEKIT10

Freedom® Frame Kit


For any custom column installation in 24-inch deep cutouts. With two metal side trims whose placement between the interior cutout wall and the appliance helps overcome the challenge of unfinished cabinet returns.

These warranties give you specific legal rights and you may have other rights that vary from state to state. Limited warranty from date of purchase. For complete warranty details, refer to your Use & Care manual, or ask your dealer.

Specifications are for planning purposes only. Refer to installation instructions and consult your countertop supplier prior to making counter opening. Consult with a heating and ventilation engineer for your specific ventilation requirements. For the most detailed information, refer to installation instructions accompanying product or write to Thermador indicating the model number. Specifications are correct at time of printing. Thermador reserves the right to change product specifications or design without notice. Some models are certified for use in Canada.

Thermador is not responsible for products that are transported from the U.S. for use in Canada.


1 800 735 4328 | USA THERMADOR.COM | CANADA THERMADOR.CA | ©2020 BSH HOME APPLIANCES CORPORATION. ALL RIGHTS RESERVED.

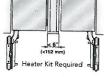

HEATRKIT20 - 13W @ 120V

Freedom® Heater Kit

When two appliances are installed side-by-side a sealing kit must be used. For combinations that involve a freezer column, this sealing kit is included. For all other (non-traditional, i.e. two wine columns, two bottom

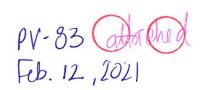

T301R905SP 30-INCH BUILT-IN FRESH FOOD COLUMN FREEDOM® COLLECTION, PANEL-READY















FEATURES & BENEFITS


- Full Stainless Steel Inner Liner
- Freedom® Hinge enables true flush design
- Auto Door Opening provides the opening of the door with just a slight push or pull
- ThermaFresh System, Humidity and Temperature controlled drawers
- SoftClose® Drawers for easy and controlled storage
- Sleek clean design for the perfect symmetry when paired with additional columns
- TFT control panel managing all your columns functions

TEMPERATURE RANGES	AND STATE OF THE REAL PROPERTY.		
Refrigerator	36°F (2°C) to 46°F (8°C)		
Temperature Controlled Drawer	30°F (-1°C) to 38°F (3°C)		
SuperCool	36°F (2°C) for approximately 6 hours		
Energy Saving (Economy) Mode	43°F (6°C)		

CONTRACTOR			
GENERAL PROPERTIES	FIGURE 1 STORY		
Home Connect™ (Wi-Fi Enabled)	Yes		
Panel Ready	Yes		
Reversible Door Swing	Yes		
SoftClose® Door	Yes*		
SoftClose® Drawers	Yes		
Carbon Air Filter	Yes		
Lighting LED Sidewall Theater Light			
Refrigerator Shelves	4		
Adjustable Shelves	3		
Shelf Material	Glass w/Aluminum Profile		
Full Extension Drawers @ 115° Door Opening Angle	Yes		
Full Extension Drawers @ 90° Door Opening Angle	e Yes		
General Use Drawer	1		
Humidity Managed Drawer	1		
Temperature Controlled Drawer	1		
Door Bins	3		
Gallon Door Bins	1		
Door Open Alarm	Yes		
Open Door Assist	Yes		
Special Modes	Sabbath, Economy, Vacation		
CAPACITY	Marie Commission		
Total Capacity (cu. ft.)	16.8 cu. ft.		
PERFORMANCE	A STATE OF THE PARTY OF THE PAR		
Dedicated Evaporator & Compressor System	Yes		
Freeflow® Cold Air System	Yes		
SuperCool	Yes		
TECHNICAL DETAILS	22. Page 552. SAN TANKET		
Watts (W)	350 W		
Current (A)	15 A		
Volts (V)	110-120 V		
Frequency (Hz)	60 Hz		
Power Cord Length (in.)	118		
Plug Type	120V-3 Prong		
DIMENSIONS & WEIGHT	120V-3 Frong		
Appliance Dimensions (H x W x D) (in.)	02.3/-11++ 00.3/-11 04		
Required Cutout Size (H x W x D) (in.)	83 3/4"** x 29 3/4" x 24		
	84" x 30" x 25"		
Net / Gross Weight (lbs)	366 / 403 lbs		
ENERGY STAR® Qualified	Yes		
Annual Energy Consumption	279 kWh		

^{*}To verify if you have a refrigeration unit with Soft-Close capability please contact our customer team by calling 1-800-735-4328.

**Height adjustable + / -1/2" (+ / -13 mm)

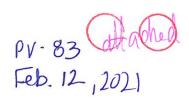


T30IR905SP 30-INCH BUILT-IN FRESH FOOD COLUMN FREEDOM® COLLECTION, PANEL-READY




WARRANTY	
Limited, Entire Appliance, Parts and Labor on Any Part of the Refrigerator that Fails Because of a Manufacturing Defect	2 Year
Limited Warranty for Sealed Refrigeration System*; Parts and Labor	3rd to 6th Year
Limited Warranty for Sealed Refrigeration System*; Parts Only	7th to 12th Year
Limited Warranty for Stainless Steel Rust-Through	Lifetime
*Sealed refrigeration system includes	Liteume

^{*}Sealed refrigeration system includes compressor, evaporator, condenser, dryer / strainer and connection tubing

CUTOUT DIMENSIONS

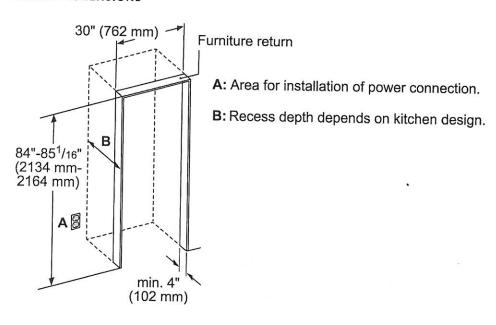

TOP VIEW CLEARANCE

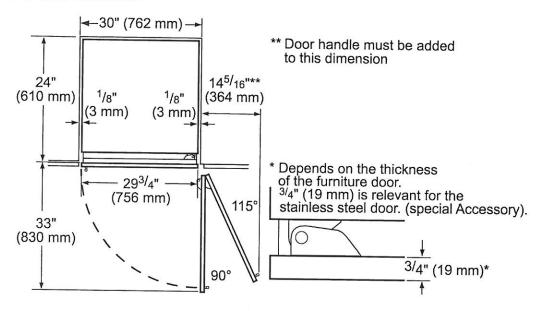


PV-83 allached Feb. 12, 2021

T301R905SP 30-INCH BUILT-IN FRESH FOOD COLUMN FREEDOM® COLLECTION, PANEL-READY

Thermador.**

PRODUCT AND PANEL DIMENSIONS

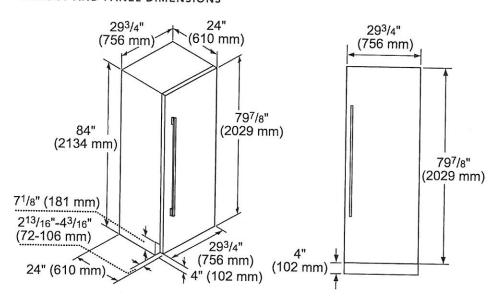

ACCESSORIES (OPTIONAL)

FLAT STAINLESS STEEL DOOR PANELS

30-Inch Flat Stainless Steel Door Panel



TFL30IR800 For use with Handle TFL30IR905 Handleless

NOTE: Handleless Panels should not be installed on units without the Soft-Close capability. If you are uncertain if you have a refrigeration unit with Soft-Close capability please contact our customer team by calling 1-800-735-4328.

HANDLES

Choose between two options:

PR36HNDL20 36-Inch Professional Series Handle

or

MS36HNDL20

36-Inch Masterpiece® Series Handle

STORAGE



SPRODBIN10 Small Produce Bin



LPRODBIN10 Large Produce Bin




30PRODRAIL 30-Inch Produce Railing



30HFGALBIN 30-Inch Half Gallon Bin

FRAMEKIT10

Freedom® Frame Kit
For any custom column installation
in 24-inch deep cutouts. With two
metal side trims whose placement
between the interior cutout wall and
the appliance helps overcome the
challenge of unfinished cabinet returns.

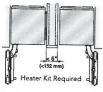

HEATRKIT20 - 13W @ 120V

Freedom® Heater Kit When two appliances are installed side-by-side a sealing kit must be used. For combinations that involve a freezer column, this sealing kit is included. For all other (nontraditional, i.e. two wine columns, two bottom freezers, etc.) sideby-side combinations or instances where any appliances are installed less than 6-inches (152 mm) apart from one another but not connected side-by-side, purchase this kit. This kit is recommended for use with any installation in areas that are subject to humidity, or located next to an outside wall.

These warranties give you specific legal rights and you may have other rights that vary from state to state. Limited warranty from date of purchase. For complete warranty details, refer to your Use & Care manual, or ask your dealer.

Specifications are for planning purposes only. Refer to installation instructions and consult your countertop supplier prior to making counter opening. Consult with a heating and ventilation engineer for your specific ventilation requirements. For the most detailed information, refer to installation instructions accompanying product or write to Thermador indicating the model number. Specifications are correct at time of printing. Thermador reserves the right to change product specifications or design without notice. Some models are certified for use in Canada.

Thermador is not responsible for products that are transported from the U.S. for use in Canada.

1 800 735 4328 | USA THERMADOR.COM | CANADA THERMADOR.CA | Ø2020 BSH HOME APPLIANCES CORPORATION. ALL RIGHTS RESERVED.



DWHD650WPR EMERALD® 6-PROGRAM DISHWASHER CUSTOM PANEL







Also Available In:

DWHD650WFP - Flat Stainless Steel Panel with Professional Series Handle

DWHD650WFM - Flat Stainless Steel Panel with Masterpiece® Series Handle

FEATURES & BENEFITS

- Chef's Tool Drawer (3rd Rack) is designed to make loading and unloading tools and hard to place items extraordinarily easier
- Sens-A-Wash® measures water cleanliness and adjusts wash cycle
- Three stage advanced filtration recirculates water for sparkling results
- 3-Level adjustable upper rack is customizable for all of your needs, designed to be raised for extra large items placed on the bottom rack, or lowered to fit taller wine glasses on the
- Extra Dry Option adds extra heat to the final rinse to enhance drying results
- Impressively Quiet®—48 dBA for peaceful kitchen experience
- Thermador Connected Experience by Home Connect brings exclusive dish features that keep you connected. Always.

ACCESSORIES (OPTIONAL)				
Dishwasher Supply and Drainage Hose Extension 76 3/4"	SGZ1010UC			
Dishwasher Accessory Kit	SMZ5000			
Fine Silverware Carafe	SMZ5002UC			
Junction Box	SMZPCJB1UC			



Small Item Basket






Fine Silverware Carafe

GENERAL PROPERTIES	Basking Agreement in			
Number Of Wash Cycles	6			
Number Of Options	5			
dBA	48			
Third Rack	Chef's Tool Drawer®			
Rack Adjustability	Rackmatic 3-Stage			
Tub Material	Stainless Steel			
Control Type	Touch Control			
Concealed Water Heating Element	Yes			
Leak Protection System	24/7 AquaStop®			
Water Softener	No			
Five-Level Wash	Yes			
Childlock	No			
Home Connect (Wi-Fi Enabled)	Yes			
EFFICIENCY				
Water Usage Per Cycle (g)	3.5 g			
Energy Efficiency Class	Tier 1			
ENERGY STAR® Certified	Yes			
Total Annual Energy Consumption (kWh)	269 kWh			
Total Annual Water Consumption (g)	624 g			
CAPACITY				
Number Of Place Settings	16			
TECHNICAL DETAILS				
Watts (W)	1,440 W			
Current (A)	12 A			
Volts (V)	120 V			
Frequency (Hz)	60 Hz			
Power Cord Length (in)	67"			
Power Cord Install Length from Corner of Unit when Facing the Door (in)*	Left - 45" Right - 56"			
Minimum Water Pressure (lb/sin)	14			
Max. Temperature for Water Intake	140° F			
ength Inlet Hose (in)	N/A			
ength Outlet Hose (in)	79"			
DIMENSIONS & WEIGHT	NOT THE PROPERTY OF THE PARTY.			
Overall Appliance Dimensions (HxWxD) (in)	33 ⁷ /8" x 23 ⁹ /16" x 23 ¹ /16"			
Required Cutout Size (HxWxD) (in)	33 ⁷ /8" Min. x 23 ⁵ /8" Min. x 24"			
Adjustable Feet	Yes			
a de la constante de la consta	100			

^{*}September 2020 running production change to remove adhesive routing clips for power cord. These clips and the edge protector are now included in the dishwasher accessory kit #SMZEPCC1UC.

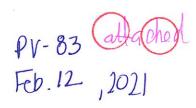


DWHD650WPR EMERALD® 6-PROGRAM DISHWASHER CUSTOM PANEL



WARRANTY	West Education of the Control
Limited Warranty, Entire Appliance, Parts and Labor	2 Year
Limited Warranty for Microprocessor or Printed Circuit Board; Parts Only	3rd to 5th Year
Limited Warranty for Racks (Does Not Include Rack Components); Parts Only	3rd to 5th Year
Limited Warranty for Rust-through On Inner Tub Liner; Parts Only	Lifetime

DISHWASHER & CUTOUT DIMENSIONS

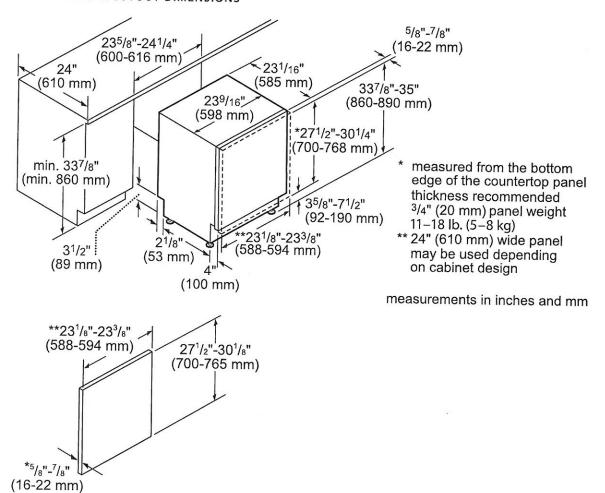

- * thickness recommended ³/₄" (20 mm), panel weight 11–18 lb. (5–8 kg)
- ** 24" (610 mm) wide panel may be used depending on cabinet design


measurements in inches and mm

These warranties give you specific legal rights and you may have other rights that vary from state to state. Full warranty and limited warranty from date of installation. For complete warranty details, refer to your Use & Care manual, or ask your dealer.

Specifications are for planning purposes only. Refer to installation instructions and consult your countertop supplier prior to making counter opening. Consult with a heating and ventilation engineer for your specific ventilation requirements. For the most detailed information, refer to installation instructions accompanying product or write to Thermador indicating the model number. Specifications are correct at time of printing. Thermador reserves the right to change product specifications or design without notice. Some models are certified for use in Canada.

1 800 735 4328 | USA THERMADOR.COM | CANADA THERMADOR.CA | @2020 BSH HOME APPLIANCES CORPORATION. ALL RIGHTS RESERVED.

Page 2 of 2

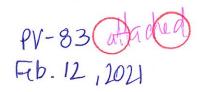



SMD2477ASC

24-INCH MICROWAVE DRAWER® OVEN



TAKE YOUR MICROWAVE TO A BETTER PLACE

It's your kitchen, your design and your lifestyle. Sharp's Microwave Drawer Oven allows you to focus on the design elements you prefer by removing the microwave from sightlines and enabling more design versatility. The Microwave Drawer offers flexible placement options below an island, peninsula, or standard cabinetry, and can also be installed adjacent to your wall oven. The Microwave Drawer allows you to showcase your design savvy and create a kitchen that flows with your lifestyle.

Sharp introduces the next generation of this successful appliance—model SMD2477ASC-a 24" microwave drawer with a simpler and a sleeker design to match more built-in appliances.

Design Flexibility

Sharp's Microwave Drawer product expands the option for microwave placement in almost any kitchen plan— it's a perfect choice for open-plan kitchens, islands, peninsulas, and a great addition to wet bars, family rooms and home theatres.

Location and Counter Space Saving

You may place the drawer under a counter, cooktop or wall oven or above a warming drawer without a built-in kit, additional trim or venting. Sharp microwave drawer provides the best solution for a cleaner, uncluttered counter space.

SHARP's Exclusive AutoTouch™ System

Sharp's exclusive AutoTouch $^{\text{TM}}$ system allows you to open and close the drawer automatically at one-finger operation by pressing a button on the control panel.

New Hidden Control Panel


The new SMD2477ASC model features a hidden control panel which gives a more integrated look and feel within the kitchen. The new tall control panel, angled at 45° degrees, is easy to see, easy to access and easy to use.

Specifications

TECHNICAL SPECIFICATIONS	
Size	24" wide
Microwave Capacity	1.2 cu.ff
Microwave Power	950 watts
Control Panel	Digital LCD Display
Control Type	Hidden Control Panel
Drawer Opening	AutoTouch™ System
Power Level	11
Sensor Cook, Reheat, Popcorn Settings	13
Reheat Auto Settings	2
Defrost Auto Settings	6
Keep Warm Setting	Yes, up to 30 min.
Melt / Soften / Settings	Yes
Beverage Setting	Yes
Programmable Stages	Yes, 4
Digital Clock	Yes
Kitchen Timer	Yes
Child Lock	Yes
+30 sec	Yes
Interior Oven Light	Yes


TECHNICAL SPECIFICATIONS CONTI	NUED
Demonstration Mode	Yes
Built-in Ready	Yes
Available Colour	Stainless Steel
Accessory	SKMD24F0AS
DIMENSIONS/WEIGHT(inches/lbs.)	
Cut-out Dimension	22 1/8" x 15 9/16"
Product Dimension	23 7/8" x 23 1/64" x 15 7/8"
Box Dimension	29.8" w x 27.9" x 21.9"
Net Weight	74 lb.
Gross Weight	85.8 lb.
POWER/SAFETY	
Power / Ratings	120V, 60Hz
Ratings	1.67Kw, 14.5Amps
Safety Compliance	FCC, DHHS, cUL
WARRANTY/UPC	
Warranty	1 year parts & labour with in-home service; 4 additional years for magnetron tube only
UPC	074000619944

5-03-2016

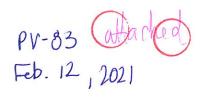

SHARP

SMD2477ASC

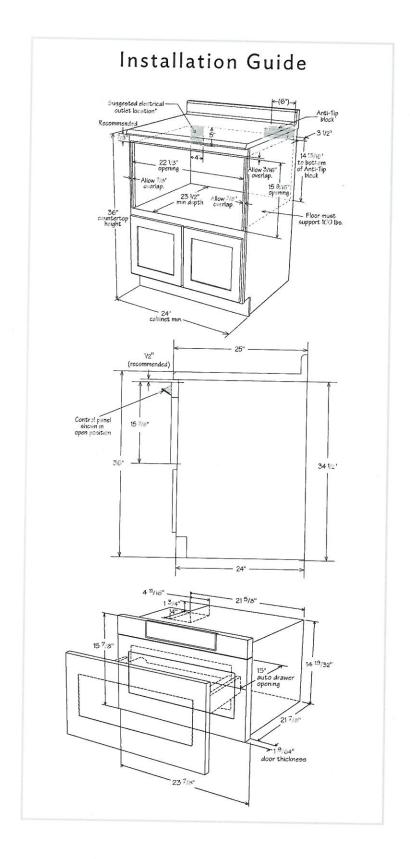

© 2016 Sharp Electronics Corporation. All rights reserved.

Product specification and design are subject to change without notice.

SHARP ELECTRONICS OF CANADA LTD. 335 Britannia Road East, MISSISSAUGA, ONTARIO, L4Z 1W9 www.sharp.ca

Fresh Living Tip

favou, love wine and good food with equal enthusiasm, consider this model. It offers the most versatility between wine storage and flat shelving for food and beverages than anyrother model in the Warverlineup. Plus each shelf glides out to aggess contems easily

FINISH OPTIONS



24" Marvel Professional **Beverage Center**

MPBV424

Performance

- 5.5 cu. ft. capacity stores 19 wine bottles total (14 flat, 5 cradled) and holds (108) 12-oz cans
- and hous (10t) 12-or cans

 (2) 3-in-1 Slide-Out Split Convertible Shelves feature removable glass pane with wine rack option to store beverages, tood or wine

 Display wine rack glides out for easy access and holds 5 wine bottles, including magnum sizes

 Access contents easily with full-extension shell, glideout shalving on the smooth-glide ball bearing system

 Capitiliprend shalving notices of the shalving system

- Cantilovered shelving system adjusts height to your storage needs

Cooling Performance

- Dynamic cooling technology delivers rapid cool down, frost-free operation and precise temperature stability
- and precise temperature stability

 Thermal-efficient cabinet ensures optimum food preservation and energy efficiency while maximizing capacity

 Argon-filled, UV-resistant tinted dual pane glass door protects contents from damaging ultraviolet light and helps conserve energy

Convenient Controls

- Multifunction controls allow you to select a precise cabinet temperature from 33°F to 70° F
- Autible alarms for door ajar and high/low temperature ensure your contents stay at optimal temperature
 At the touch of a button, change the interior light color to sapphire blue or arctic white
- Theater-style display lighting gently brightens as door is opened and dims to off when closed

Fit & Finish

- · Elegant midnight black interior
- Professional styling: robust full-length handle and stainless steel accents
 Reversible soft-close door allows for right or left swing
- Door lock provides added security

Warranty

3-year parts and labor warranty with product registration and 5-year sealed system parts warranty

A dynamic food, beverage and wine storage solution, this adaptable beverage centur leatures two versatile class shelves that convert to a wine rack option. An additional display wine rack can hold a variety of bottle types, including magnum sizes.

3-in-1 Convertible Shelf







DOOR STYLE


Stainless Steel Fremo Glass Panel Ready Frame Glass Solid Pariel Ready Solid Stainless Steel


MODEL NUMBER

MPBV434-SG31A MPE JA 24-1G31A MPBV424-IS31A MP5V424-SS31A



PV-83 DP DE Feb 12, 2021

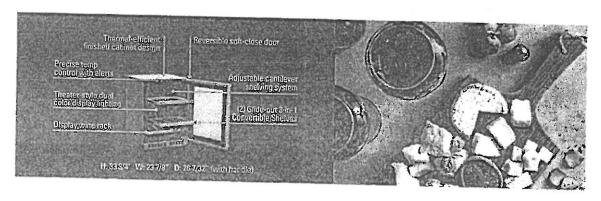

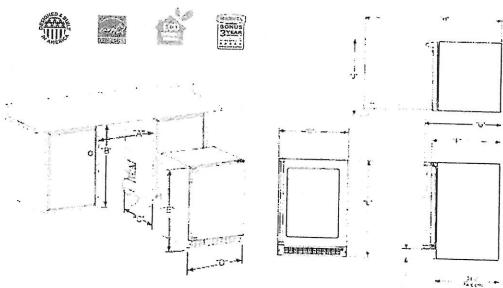

		Cabinet Dimensions*			Dimensions*		
	"C"	"D"	"E"	uE+	11011	One No.	-
4' to 35-1/4"	-A'	22.761			G	"H"	"J"
	.,	23-7/6	33-5/8° TO 34-5/8°	23-5/6**	25-1/8**	47-3/4**	26-1/2**
M to 89 3 CM)	(61 Ctv1)	(60.7 Civa)	ISS A CM TO ST. O Chai		122		20-1/2
			Se Court O DI 3 CIVII	(GI) CIVII	(68.3 CM)	(146 6 CM)	(67 3 CM)
	/4' to 25-1/4" CM to 89 5 CM)	74' to 25-1/4" 24' CM to 89 3 CM) (61 CM)	74' to 35-1/4"	74' to 25-1;4"	/4′ to 25-1/4"	74' to 25-1/4" 24' 23-7/6' 33-5/8' TO 34-5/8' 23-5/6' 25-1/8" - CM to 89 3 CM) (61 CM) (60 7 CM) (85 4 CM TO 87 9 CM) (60 CM) (68 3 CM)	74' to 25-174"

Capacity
Control Type
Sabbath Mode
Temperature Range
Handle Style

Hinge Type
Interior Lighting
Shelving System
Toe Grille Finish

5.5 CU. FT. Electronic 33°F to 70°F

Professional (handle not included on panel-ready m Reversible Soft-Close

White + Blue LED Cantilever Stanless Steel (Black on Panel-Ready Models) Electrical Requirement Cord Length Shipping Dimensions Shipping Weight Agency Approval Refrigerant Type

Lock Electrical Requirements Yes 115V/60 Hz/15A

6 FT. 28" W x 31" D x 37" H 160 LBS

UL R600a


For comprehensive installation instructions, including panel overlay details, please visit marvelrelrigeration.com to access the owner's guide

PV- 83 DD DD Fcb 12,1021

PRD486WIGC

48-INCH DUAL-FUEL PRO GRAND® INDUCTION RANGE PROFESSIONAL SERIES, COMMERCIAL-DEPTH, PORCELAIN COOKTOP SURFACE



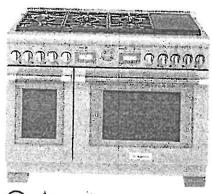




FEATURES & SENERIE

- ★ 4 ExtraLow® burners for simmering, melting, or holding long durations
- 화 ExtraHigh Star® Burner—22,000 BTUs of power for searing or boiling
- ☆ Hydraulic SoftClose® hinges prevent slamming for ultra smooth closing
 - 3,600W induction: rapid boiling and full surface heating for griddles
- Superfast 2.5-hour self-clean mode-fastest in the industry

Circuit Breaker	50 A
Volts	240 / 208 V, 60Hz 4 Wire
Energy Source Plug Type	Gas and Electric
Power Cord Length	Purchase Separately
Gas Supply	3/4*
WARRANTY	建设单户地位
Limited Warranty, Entire Appliance, Parts and Labor	2 Year

SEE PAGE 2 FOR INCLUDED AND OPTIONAL ACCESSORIES

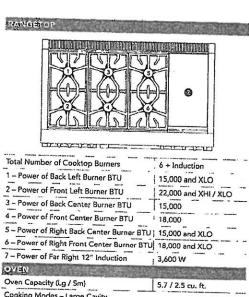

4 - Power of Front Center Burner BTU	18,000
5 - Power of Right Back Center Burner B7	TU 15,000 and XLO
6 - Power of Right Front Center Burner B	TU 18,000 and XLO
7 - Power of Far Right 12" Induction	3,600 W
Oven Capacity (Lg / Sm)	5.7 / 2.5 cu, ft.
Cooking Modes - Large Cavity	
Bake, Convection Bake, True Convection, Convection Broil, Broil	Convection Roast, Roast,
Cooking Modes - Small Cavity	Military Affrica Vinginia
Bake, Convection Bake, Proof, Keep Warn Convection Broil, Broil	n, Convection Roast, Roast,
Sabbath (Lg / Sm)	Yes / Yes
Self-Clean (Lg / Sm)	Yes / Yes
Telescopic Rack(s) (Lg / Sm)	3/2
Interior Lights (Lg / Sm)	12/1
Bake Power (Lg / Sm)	2,000 W / 1,400 W
Broil Power (Lg / Sm)	4,000 W / 2,600 W
Convection Power (Lg / Sm)	2,750 W / 1,960 W
Home Connect™ (Wi-Fi Enabled)	Yes, Large Oven Only
Lg Cavity Interior Dimensions (HxWxD)	16 1/4" x 28" x 21 1/2"
Lg Cavity Usable Dimensions (HxWxD)	1 12" x 25 3/8" x 19 1/2"
Sm Cavity Interior Dimensions (HxWxD)	16 1/4" x 12 3/8" x 21 1/2"
Sm Cavity Usable Dimensions (HxWxD)	12" x 9 3/4" x 19 1/2"
Overall Appliance Dimensions (HxWxD)	35 3/4" - 36 3/4" x 47 15/16" x 27 7/8"
Required Cutout Size (HxWxD)	35 3/4" - 36 3/4" × 48" × 24" - 25 1/8"
Net Weight	F70.0

★ THERMADOR® EXCLUSIVE

Page 1 of 6

Net Weight

2/19 CA


PV-83 (1) (2) Fb . 12,101

PRD486WIGC


48-INCH DUAL-FUEL PRO GRAND® INDUCTION RANGE PROFESSIONAL SERIES, COMMERCIAL-DEPTH, PORCELAIN COOKTOP SURFACE



48-INCH RANGE DIMENSIONS

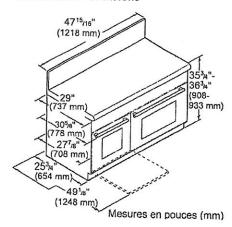

48-INCH RANGE CUTOUT DIMENSIONS

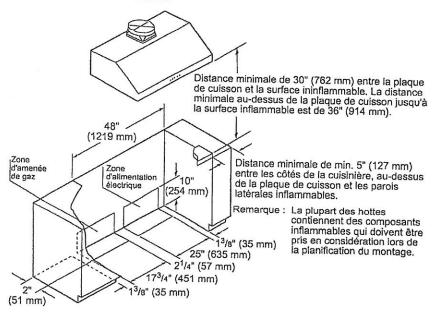

Dimensions en pouces (mm)

tage 3 of 6

2 / 19 CA


PV-83 (40) St Fcb. 12, 2021

PRD486WIGC

48-INCH DUAL-FUEL PRO GRAND® INDUCTION RANGE PROFESSIONAL SERIES, COMMERCIAL-DEPTH, PORCELAIN COOKTOP SURFACE

Thermador.**

48-INCH RANGE CUTOUT DIMENSIONS

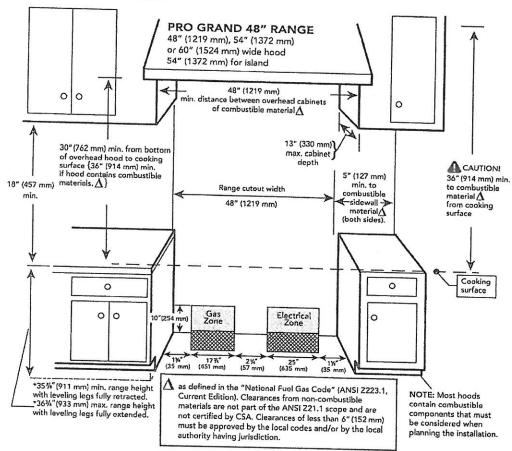

PV-83 (10 (2) Feb. 12, 2021


PRD486WIGC

48-INCH DUAL-FUEL PRO GRAND® INDUCTION RANGE PROFESSIONAL SERIES, COMMERCIAL-DEPTH, PORCELAIN COOKTOP SURFACE

Thermador.*

48-INCH RANGE DIMENSIONS AND CLEARANCE REQUIREMENTS WITH "LOW BACK"

48-INCH RANGE DIMI
NOTE: A 36-inch
minimum clearance is
required between the top
of the cooking surface
and the bottom of an
unprotected cabinet. A
30-inch clearance can be
used when the bottom
of the wood or metal
cabinet is protected by
not less than 1/4 inch of a
flame retardant material
covered with not less
than No. 28 MSG sheet
steel, 0.015 inch (0.4 mm)
thick stainless steel, 0.024
inch (0.6 mm) aluminum,
or 0.020 inch (0.5 mm)
thick copper.

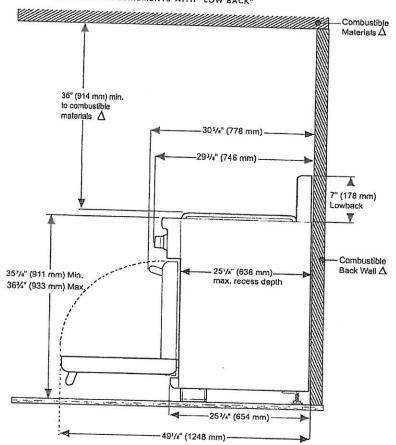

As defined in the "National Fuel Gas Code" (ANSI Z223.1, Current Edition), Clearances from non-combustible materials are not part of the ANSI Z21.1 scope and are not certified by CSA. Clearances of less than 6" (152 mm) must be approved by the local codes and/or by the local authority having jurisdiction.


Fige 5 of 6

2/19 CA

48-INCH DUAL-FUEL PRO GRAND® INDUCTION RANGE PROFESSIONAL SERIES, COMMERCIAL-DEPTH, PORCELAIN COOKTOP SURFACE



48-INCH RANGE DIMENSIONS AND CLEARANCE REQUIREMENTS WITH "FLUSH ISLAND TRIM"

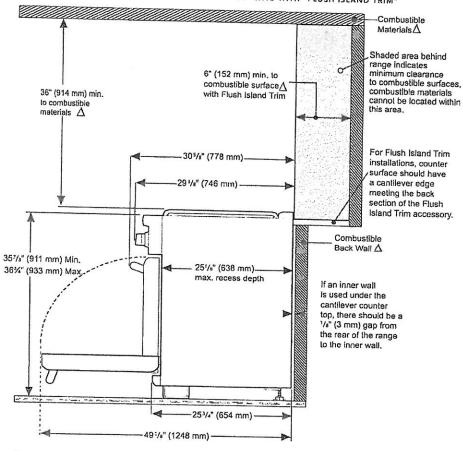

As defined in the "National Fuel Gas Codo" (ANSI 2223.1, Current Edition), Clearances from non-combustible materials are not part of the ANSI 221.1 scope and are not certified by CSA. Clearances of less than 6" (152 mm) must be approved by the local codes and/or by the local authority having jurisdiction.

These warrantes give you specific legal rights and you may have either rights that vary from state to state. Full warranty and limited warranty from date of installation. For complete warranty datalis, refer to your Use & Care manual, or ask your dealer.


Specifications are for planning purposes only. Refer to installation instructions and consult your counterrop supplies prior to making counter opening. Consult with a heating and verification is requirements. For the most detailed information, refer to installation instructions accompanying product or write to Thermador indicating the model number. Specifications are correct at time of princing. Thermador inserves the right to change product specifications or design without notice. Some models are certified for use in Canada. Thermador is not responsible for products that are transported from the U.S. for use in Canada.


1 800 735 4328 USA THERMADOR COM | CANADA THERMADOR CA | 72019 BSH HOME APPLIANCES CORPORATION ALL RIGHTS RESERVED.

PV-83 10 X Feb 12, 2021

T301F905SP 30-INCH BUILT-IN FREEZER COLUMN WITH INTERNAL ICE MAKER FREEDOM® COLLECTION, PANEL-READY



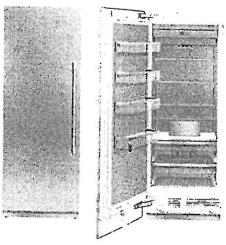

 



नम्भागसङ् ४ व्यक्तनमृद्ध - Full Stainless Steel Inner Liner

- Freedom® Hinge enables true flush design
- Auto Door Opening provides the opening of the door with just a slight push or pull
- SoftClose® Drawers for easy and controlled storage
 Sleck clean design for the perfect symmetry when paired with additional columns
- TFT control panel managing all your columns functions

TEMPERATURE NAMES	
Freezer	-11°F (-24°C) to 7°F (-14°C)
SuperFreeze®	-22°F (-30°C) for approximately 52 hours
Energy Saving (Economy) Mode	3°F (-16°C)

GENERAL PROPERTIES	
Home Connect™ (Wi-Fi Enabled)	Yes
Panel Ready	Yes
Reversible Door Swing	Yes
SoftClase® Door	Yes*
SoftClose® Drawers	Yes
Lighting	LED Sidewall and Theater Lighting
Freezer Shelves	4
Adjustable Shelves	3
Shelf Material	Glass w/Aluminum Profile
Full Extension Drawers @ 115° Door Opening Angle	Yes
General Use Drawer	2
Door Bins	1
External LED Proximity Sensor	No
Oversized Dispenser Opening	No
Chilled Water, Crushed and Cubed Ice	No
Rapid Water Replenishment System	No
Ice Maker with Diamond Ice System	Yes
Door Open Alarm	Yes
Open Door Assist	Yes
Special Modes	Sabbath, Economy, Vacation
CAPACITY	国际产品社会的企业
Total Capacity (cu. ft.)	15.8 cu. ft.
PERFORMANCE	对你是否是否是
Dedicated Evaporator & Compressor System	Yes
SuperFreeze®	Yes
Defrost Process	Frost-Free
TECHNICAL DETAILS	经基础的的现代
Watts (W)	350 W
Current (A)	15 A
Valts (V)	110-120 V
Frequency (Hz)	60 Hz
Power Cord Length (in.)	118
Plug Type	120V-3 Prong
Appliance Dimensions (H x W x D) (in.)	84"^ x 29 3/4" x 24"
Required Cutout Size (H x W x D) (in.)	84" × 30" × 25"
Net / Gross Weight (lbs)	362 / 398 lbs
ENERGY STAR® Qualified	Yes

^{*}To venty if you hale a refingeration unit with Solt-Close capability please contact our customer team by calling 1-300-735-4328
**Height adjustable 47-1/5* (47-13 min)

Page 1 of 3

PV-83 (P) D) Feb. 12, 2021


T301F905SP 30-INCH BUILT-IN FREEZER COLUMN WITH INTERNAL ICE MAKER FREEDOM® COLLECTION, PANEL-READY




WARRANTS	Mark was to be a first
Limited, Entire Appliance, Parts and Labor on Any Part of the Refrigerator that Fails Because of a Manufacturing Defect	2 Year
Limited Warranty for Sealed Refrigeration System*; Parts and Labor	3rd to 6th Year
Limited Warranty for Sealed Refrigeration System*; Parts Only	7th to 12th Year
Limited Warranty for Stainless Steel Rust-Through	Lifetime

"Subted refingeration system includes compressor, e-apprator, condenser, dryer / strainer and connection tubing

CUTOUT DIMENSIONS

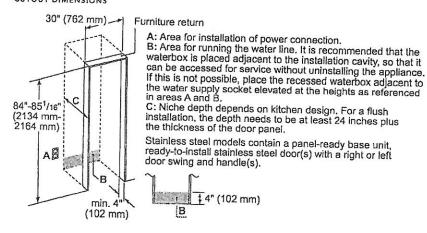

TOP VIEW CLEARANCE

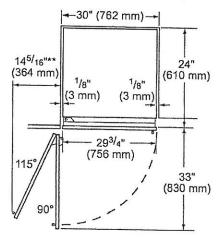

- ** Door handle must be added to this dimension
- Depends on the thickness of the unit door.

 3/4" (19 mm) refers to the stainless steel door. (special accessory).


Page 2 o! 3

PV-83 WPX Feb. 12, 2021

T301F905SP 30-INCH BUILT-IN FREEZER COLUMN WITH INTERNAL ICE MAKER
FREEDOM® COLLECTION, PANEL-READY

Thermador, *

PRODUCT AND PANEL DIMENSIONS

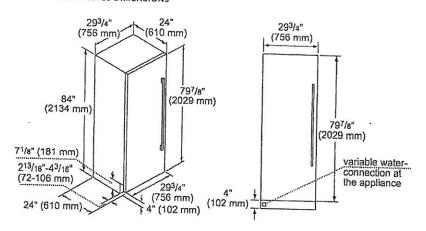


FLAT STAINLESS STEEL DOOR PANELS 30-Inch Flat Stainless Steel Door Panel Without Dispenser



TFL30IR800 For use with Handle
TFL301R905

NOTE: Handleless Panels should not be installed on units without the Soft-Close capability. If you are uncertain if you have a refrigeration unit with Soft-Close capability please contact our customer team by calling 1-800-735-4328.

M536HNDL20 36-Inch Masterpiece® Series Handle

HANDLES

Choose between two options:


36-Inch Professional Series Handle

PR36HNDL20

* ICEBUCKETL Large Ice Bucket

FILTERS

REPLFLTRS5 Freedom[®] Water Filter Replacement water filter for use in all freezer and bottom freezer models

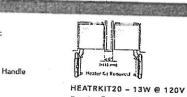

Freedom® Heater Kit

When two appliances are installed side-by-side a sealing kit must be used. For combinations that involve a freezer column, this sealing kit is included. For all other (non-traditional, i.e. two wine columns, two bottom freezers, etc.) side-by-side combinations or instances where any appliances are installed less than 6-inches (152 mm) apart from one another but not connected side-by-side, purchase this kit. This kit is recommended for use with any installation in areas that are subject to humidity, or located next to an outside wall. Freedom® Heater Kit

FRAMEKIT10

STORAGE

Freedom® Frame Kit
For any custom column installation in 24-inch deep cutouts. With two
metal side trims whose placement between the interior cutout wall and the
appliance helps overcome the challenge of unfinished cabinet returns.

These warrantios give you specific legal rights and you may have other rights that vary from state to state. Limited warranty from date of purchase. For complete warranty details, refer to your Use & Care manual, or ask your dualer.


Specifications are for planning purposes only. Rofer to installation instructions and consult your countertop supplier prior to making counter opening. Consult with a heating and vinitalization instructions accompanying product or write to Thermador indicating the model number. Specifications are current at time of printing. Thermador reset is as the right to change product specifications or design without notice. Some models are certified for use in Canada.

Therm. Jot is not responsible for products that are transported from the U.S. for use in Canada.

1 800 735 4328 | USA THERMADOR.COM | CANADA THERMADOR CA | \$2020 BSH HOME APPLIANCES CORPORATION, ALL RIGHTS RESERVED.


Page 3 of 3

9/20

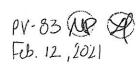

T301R905SP 30-INCH BUILT-IN FRESH FOOD COLUMN FREEDOM® COLLECTION, PANEL-READY



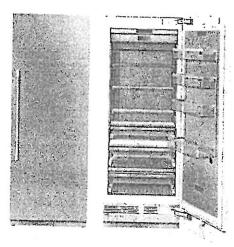







FEATINGS & NEWEFING

- Full Stainless Steel Inner Liner
- Freedom® Hinge enables true flush design
- Auto Door Opening provides the opening of the door with just a slight push or pul!
 ThermaFresh System, Humidity and Temperature controlled drawers
- SoftClose® Drawers for easy and controlled storage
- Sleek clean design for the perfect symmetry when paired with additional columns
- TFT control panel managing all your columns functions

Asmaltanings without	SECTION AND DESCRIPTION
Refrigerator	36°F (2°C) to 46°F (8°C)
Temperature Controlled Drawer	30°F (-1°C) to 38°F (3°C)
SuperCool	36°F (2°C) for approximately 6 hours
Energy Saving (Economy) Mode	43°F (6°C)

GENERAL PROPERTIES Home Connect™ (WI-Fi Enabled)	STATE OF THE STATE OF
Panel Ready	Yes
Reversible Door Swing	Yes
SoftClose® Door	Yes
SoftClose® Drawers	Yes*
Carbon Air Filter	Yes
	Yes
Lighting	LED Sidewall and Theater Lighting
Refrigerator Shelves	4
Adjustable Shelves	3
Sholf Material	Glass w/Aluminum Profile
Full Extension Drawers @ 115° Door Opening Angle	Yes
Full Extension Drawers @ 90° Door Opening Angle	Yes
General Use Drawer	1
Humidity Managed Drawer	1
Temperature Controlled Drawer	1
Door Bins	3
Gallon Door Bins	1
Door Open Alarm	Yes
Open Door Assist	Yes
Special Modes	Sabbath, Economy, Vacation
CAPAGITY	PARTICIPATION OF THE PARTY OF T
Total Capacity (cu. ft.)	16.8 cu. ft.
PERFORMANCE	SCOUNDS OF STREET
Dedicated Evaporator & Compressor System	Yes
Freeflow® Cold Air System	Yes
SuperCool	Yes
TECHNICAL DETAILS	DESCRIPTION OF THE PARTY OF THE
Watts (W)	350 W
Current (A)	15 A
/olts (V)	110-120 V
requency (Hz)	60 Hz
ower Cord Length (in.)	118
Plug Type	
DIMENSIONS & WEIGHT	120V-3 Prong
Appliance Dimensions (H x W x D) (in.)	
Required Cutout Size (H x W x D) (in.)	83 3/4"** x 29 3/4" x 2
Net / Gross Weight (lbs)	84" x 30" x 25"
FF1GIL West	366 / 403 lbs
NEGCH CTARE OF THE L	STATE OF THE PARTY
	Yes
nnual Energy Consumption	279 kWh

^{*}To - arily if you have a refrigeration unit with Soft-Close capability please contact our customer teem by calling 1-800-735-428.

"Height adjustable + /-1/2" [+ /-13 mm]

Page 1 of 3


PV-83 MP 90 Feb. 12,2021

T301R905SP 30-INCH BUILT-IN FRESH FOOD COLUMN FREEDOM® COLLECTION, PANEL-READY




WARRANTY	Control of Androne Control
Limited, Entire Appliance, Parts and Labor on Any Part of the Refrigerator that Fails Because of a Manufacturing Defect	2 Year
Difficed Warranty for Sealed Refrigeration System*; Parts and Labor	3rd to 6th Year
Limited Warranty for Sealed Refrigeration System*; Parts Only	+
Limited Warranty for Stainless Steel Rust-Through	7th to 12th Year

CUTOUT DIMENSIONS

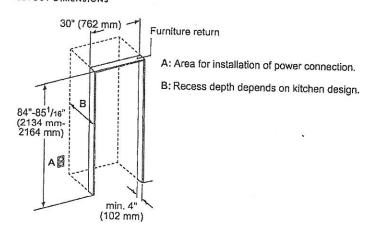


TOP VIEW CLEARANCE

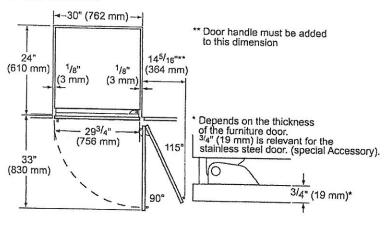

Page 2 of 3

9/20

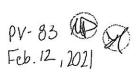


T301R905SP

30-INCH BUILT-IN FRESH FOOD COLUMN FREEDOM® COLLECTION, PANEL-READY

Thermador.*

PRODUCT AND PANEL DIMENSIONS

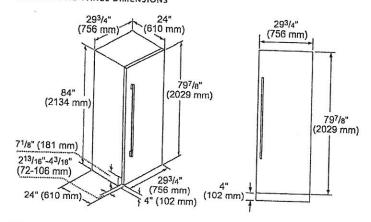

Processories (OLLIONAT)

FLAT STAINLESS STEEL DOOR PANELS 30-Inch Flat Stainless Steel Door Panel



TFL30IR800 For use with Handle TFL301R905 Handleless

NOTE: Handleless Panels should not be installed on units without the Soft-Close capability. If you are uncertain if you have a refrigeration unit with Soft-Close capability please contact our customer team by calling 1-800-735-4328.

HANDLES

Choose between two options:

PR36HNDL20 36-Inch Professional Series Handle

MS36HNDL20 36-Inch Masterpiece® Series Handle

STORAGE



SPRODBIN10 Small Produce Bin



LPRODBIN10 Large Produce Bin



30PRODRAIL 30-Inch Produce Railing



30HFGALBIN 30-Inch Half Gallon Bin

FRAMEKIT10

Freedom® Frame Kit
For any custom column installation
in 24-inch deep cutouts. With two
metal side trims whose placement
between the interior cutout wall and
the appliance helps overcome the
challenge of unfinished cabinet returns.





HEATRKIT20 - 13W @ 120V


HEATRKIT20 – 13W @ 120V Freedom® Heater Kit When two appliances are installed side-by-side a sealing kit must be used. For combinations that involve a freezer column, this sealing kit is included. For all other (non-traditional, i.e. two wine columns, two bottom freezers, etc.) side-by-side combinations or instances where any appliances are installed less than 6-inches (152 mm) apart from one another but not connacted side-by-side, purchase this kit. This kit is recommended for use with any installation in areas that are subject to humidity, or located next to an outside wall.

These warranties give you specific legal rights and you may have other rights that vary from state to state. Limited warranty from date of purchase. For complete warranty details, refer to your. Use & Care manual, or ask your dealar.

1 800 735 4328 | USA THERMADOR.COM | CANADA THERMADOR CA | 02020 BSH HOME APPLIANCES COPPORATION, ALL RIGHTS RESERVED.

DWHD650WPR EMERALD® 6-PROGRAM DISHWASHER



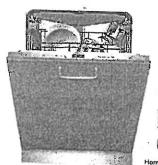



Also Available In: Also Available In:

DWHD650WFP - Flat Stainless Steel Panel with
Professional Series Handle

DWHD650WFM - Flat Stainless Steel Panel with
Masterpiece® Series Handle

- Che's Tool Drawer (3rd Rack) is designed to make loading and unloading tools and hard to place items extraordinarily easier Sens-A-Wash® measures water cloanliness and adjusts wash cycle

 Three stage advanced filtration recirculates water for sparkling results

 3-Level adjustable upper rack is customizable for all of your needs, designed to be raised for extra large items placed on the bottom rack, or lowered to fit taller wine glasses on the upper rack

 Extra Dry Option adds extra heat to the fine large items.
- Extra Dry Option adds extra heat to the final rinse to enhance drying results
- Impressively Quiet 48 dBA for peaceful kitchen experience
- Thermador Connected Experience by Home Connect brings exclusive dish features that keep you connected. Always.

Dishwasher Supply and Drainage Hose Extension 76 3/4"	SGZ1010UC
Dishwasher Accessory Kit	SMZ5000
Fine Silverware Carafe	SMZ5002UC
Junction Box	SMZPCJB1UC





Accessory Kit includes Extra-Tall-Item Sprinkler, Vase / Bottle Holder, 3 Plastic Item Clips and Small Item Basket

Number Of Wash Cycles	CORP AND DESCRIPTION OF THE PARTY OF THE PAR
Number Of Options	6
dBA	5
Third Rack	48
Rack Adjustability	Chef's Tool Drawer®
Tub Material	Rackmatic 3-Stage
Control Type	Stainless Steel
Concealed Water Heating Element	Touch Control
	Yes
Leak Protection System Water Softener	24/7 AquaStop®
Five-Level Wash	No
Childlock	Yes
	No
Home Connect (Wi-Fi Enabled)	Yes
labalentifica	all services
Water Usage Per Cycle (g)	3.5 g
Energy Efficiency Class	Tier 1
ENERGY STAR® Certified	Yes
Total Annual Energy Consumption (kWh)	269 kWh
Total Annual Water Consumption (g)	624 g
en-vigits.	ESTREE OF THE PROPERTY OF
Number Of Place Settings	16
REGULARICAL DEPAILS	Section of the second
Watts (W)	1,440 W
Current (A)	12 A
Volts (V)	120 V
Frequency (Hz)	60 Hz
Power Cord Length (in)	67"
Power Cord Install Length from Corner of Unit when Facing the Door (in)*	Left - 45" Right - 56"
Minimum Water Pressure (lb/sin)	14
Max. Temperature for Water Intake	140° F
ength Inlet Hose (in)	N/A
ength Outlet Hose (in)	79"
PINENSIONS & WEIGHT	STEED STORES OF THE PARTY OF TH
Overall Appliance Dimensions (HxWxD) (in)	33 7/8" x 23 9/16" x 23 1/16"
required Cutout Size (HxWxD) (in)	33 7/8" Min. x 23 5/8" Min. x 24"
Adjustable Feet	Yes
let Weight (lbs)	88 lbs

*September 2020 running production change to remove adhesive routing clips for power cord. These caps and the cope protector are now included in the distinguisher accessory kill in the distinguisher accessory kill.


PV-83 PP P Feb. 12, 2021

DWHD650WPR EMERALD® 6-PROGRAM DISHWASHER



wassan	
Limited Warranty, Entire Appliance, Parts and Labor	MEDICAL PROPERTY.
Limited Warranty for Microprocessor or Printed Circuit Board; Parts Only	2 Year
Limited Warranty for Rocks (Does Not Include Rack Components); Parts Only	3rd to 5th Year
Limited Warranty for Rust-through On Inner Tub Liner; Parts Only	3rd to 5th Year
to Rose Andugh On Inner Tub Liner; Parts Only	Lifetime

DISHWASHER & CUTOUT DIMENSIONS

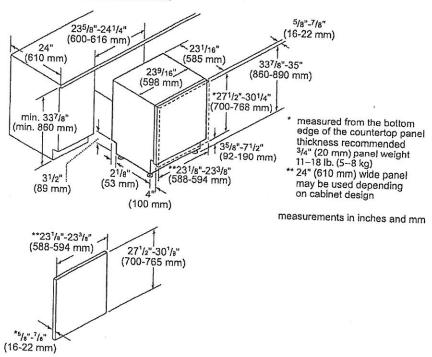

thickness recommended $^{3}/4"$ (20 mm), panel weight 11–18 lb. (5–8 kg) 24" (610 mm) wide panel may be used depending on cabinet design

measurements in inches and mm

These warrantes give you specific legal rights and you may have other rights that vary from state to state. Full warranty and in details, roler to your Use & Care manual, or ask your dealer.


Specifications are for planning purposes only Refer to installation instructions and consult your countertop supplengeness for your specific vanishing requirements. For the most detailed information, refer to installation instruction of princing Thermodor reserves the right to change product specifical for products that are transported from the U.S. for use in Canada.

1 808 735 A328 | USA THERMADOR COM | CANADA THER! IADOR CA | 822026 BSH HOME APPLIANCES CORPORATION. ALL RIGHTS RESERVED

Page 2 of 2

8/20

PV-83(10) (1) Fib. 12, 2021

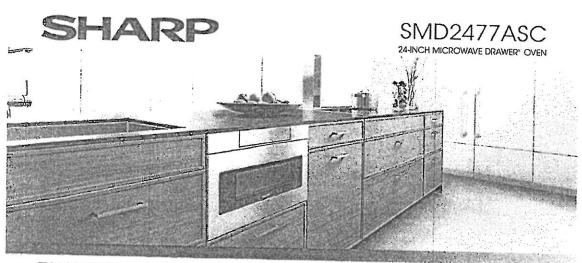

TAKE YOUR MICROWAVE TO A BETTER PLACE

It's your kitchen, your design and your lifestyle. Sharp's Microwave Drawer Oven allows you to focus on the design elements you prefer by removing the microwave from sightlines and enabling more design versalitify. The Microwave Drawer offers tlexible placement options below an island, peninsula, or standard cobinety, and can also be installed adjocent to your wall oven. The Microwave Drawer allows you to showcase your design sawy and create a kitchen that flows with your lifestyle.

Sharp introduces the next generation of this successful appliance—model SMD2477ASC-a 24° microwave drawer with a simpler and a sleeker design to match more built-in appliances.

Design Flexibility

Sharp's Microwave Drawer product expands the option for microwave placement in almost any kilchen plan—it's a perfect choice for open-plan kitchens, islands, peninsulas, and a great addition to wet bars, family rooms and home theatres.

Location and Counter Space Saving

You may place the drawer under a counter, cooklop or wall oven or obove a warming drawer without a built-in kit, additional trim or venting. Sharp microwave drawer provides the best solution for a cleaner, uncluttered counter space.

SHARP's Exclusive AutoTouch™ System

Sharp's exclusive AutoTouchTM system allows you to open and close the drawer automatically at ane-finger operation by pressing a button on the control panel.

New Hidden Control Panel

The new SMD2477ASC model features a hidden control panel which gives a more integrated look and feel within the kitchen. The new tall control panel, angled at 45° degrees, is easy to see, easy to access and easy to use.

Specifications

TECHNICAL SPECIFICATIONS	
Size	24" wide
Microwave Capacity	1.2 cu.ft
Microwave Power	950 walts
Control Panel	Digital LCD Display
Control Type	Hidden Control Panel
Drawer Opening	AutoTouch™ System
Power Level	11
Sensor Cook, Reheat, Popcorn Settings	13
Reheat Auto Settings	2
Defrost Auto Settings	6
Keep Warm Setting	Yes, up to 30 min.
Mell / Solten / Settings	Yes
Beverage Setting	Yes
Programmable Stages	Yes, 4
Digital Clock	Yes
Kilchen Timer	Yes
Child Lock	Yes
+30 sec	Yes
Interior Oven Light	Yes


TECHNICAL SPECIFICATIONS CONTIL	NUED
Demonstration Mode	Yes
Built-in Ready	Yes
Available Colour	Slainless Steet
Accessory	SKMD24FOAS
DIMENSIONS/WEIGHT (inches/ibs.)	
Cut-out Dimension	22 1/8° x 15 9/16°
Product Dimension	23 7/8° x 23 1/64° x 15 7/8°
Box Dimension	29.8" w x 27.9" x 21.9"
Net Weight	74 lb.
Gross Weight	85.8 ib.
POWER/SAFETY	
Power / Ralings	120V, 60Hz
Ratings	1.67Kw, 14.5Amps
Salely Compliance	FCC, DHHS, cUL
WARRANTY/UPC	
Warranty	1 year parts & labour with in-home service; 4 additional years for magnetron tube only
UPC	074000619944

PV-83 PP SP Feb. 12, 2021

SHARP

SMD2477ASC

Installation Guide

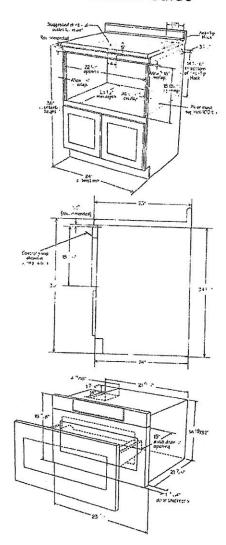

2014 Shorp Bectronics Corp wallon. I nights reserved,
 Product specialising and design our subject to change without police.

SHARP ELECTRONICS OF CANADA LID

335 BABUNNO BINDE EOST, MISSISSAUGA, ONTARIO, LEZ 197