


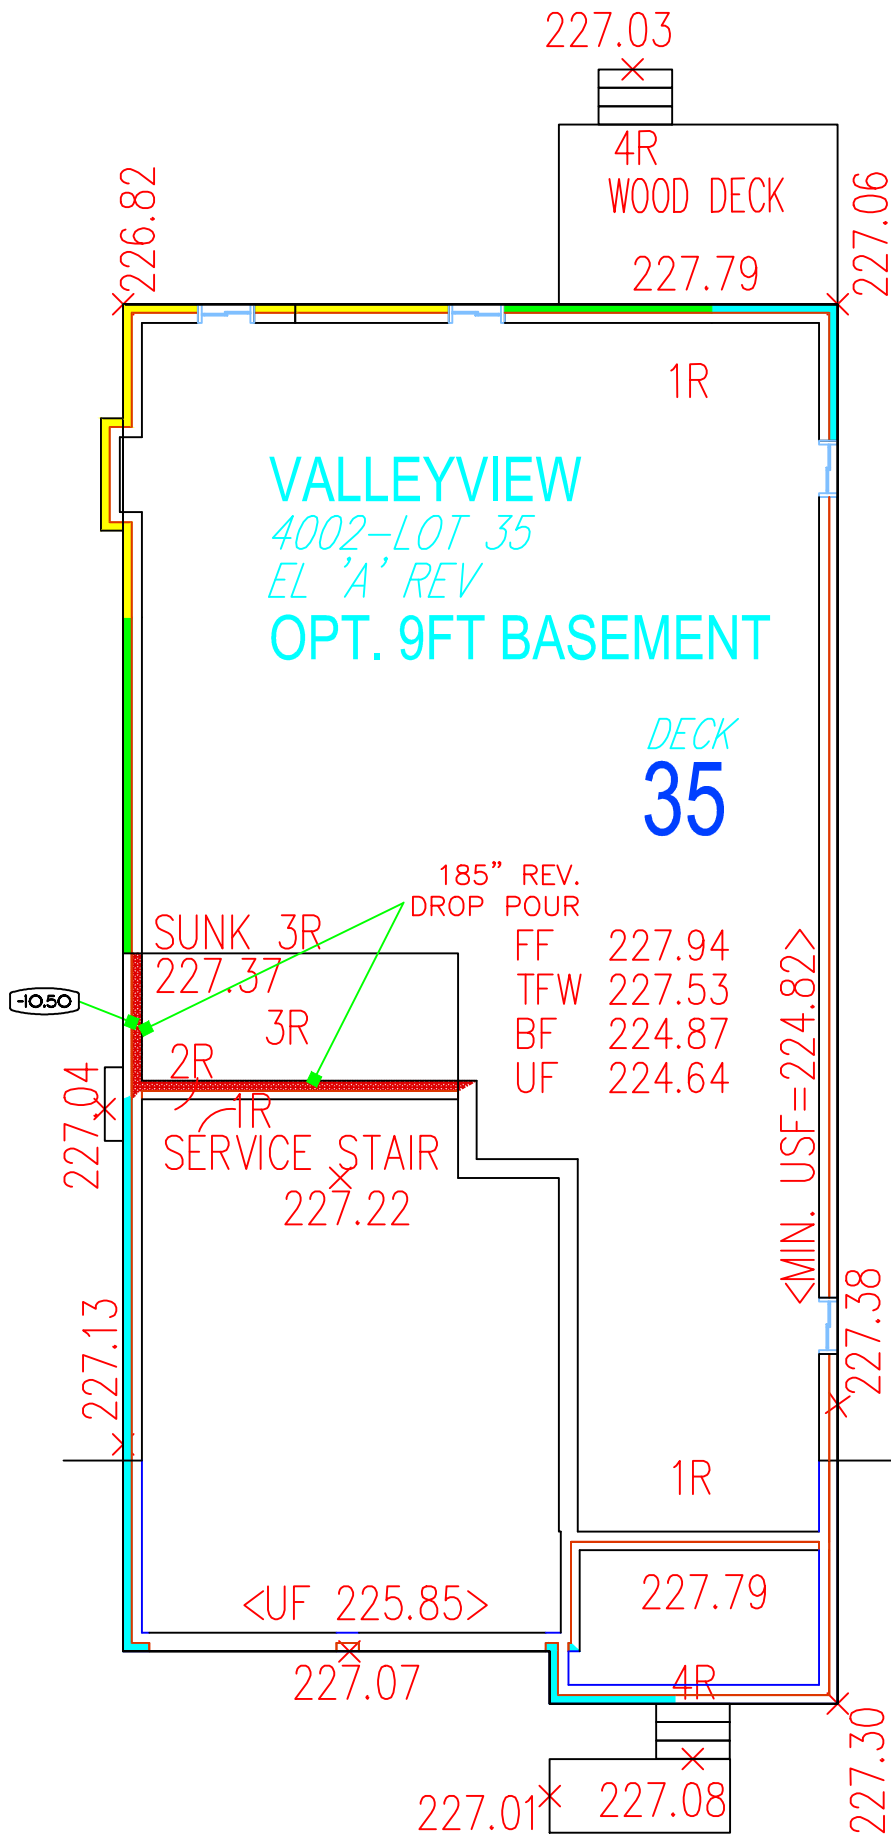

PLAN

Legend			
1 Brick (5")		Standard Wall	
2 Brcks (8.5")		Garage Wall	
3 Brcks (12")		1 Riser reverse	
4 Brcks (15.5")		2 Riser reverse	
5 Brcks (19")		3 Riser reverse	
6 Brcks (22.5")		4 Riser reverse	
7 Brcks (26")		Cut Pour	
8 Brcks (29.5")			

Site Name : Pine Valley	Job No.
Location : Vaughan, Ontario	
Date: 09/28/2021	Lot # 35-REVISION #3
By : jamesp	Scale : n.t.s.

PHASE:
Total Stone Area Sq. Ft. + 5% Waste = 12 SQFT
Total Bricks + 4% Waste 346