

Lot: 47

Model: 50.05 B KNIGHTSWOOD Project/Phase: Pine Valley Forevergreen / 1

APPI	JAN	CES
------	-----	-----

Invoice	Qty.	Description
2646 72,218 14Apr21 **	1	KITCHEN - UPGRADE TO 8" DUCT (INTERIOR WALL) IN LIEU OF STANDARD OFFERING
2646 14Apr21 NoCat	1	FYI - KITCHEN: ADDITIONAL 220V RECEPTACLE ON A SEPARATE CIRCUIT - FOR BUILT-IN WALL OVEN - APPLIANCE NOT INCLUDED - DOES NOT INCLUDE BREAKER THAT IS TO BE INSTALLED BY LICENSED ELECTRICIAN AND ARRANGED BY HOMEOWNER AFTER CLOSING
2646	1	FYI - KITCHEN - UPGRADE TO 8" DUCT (INTERIOR WALL) IN LIEU OF STANDARD OFFERING
14Apr21 NoCat		
2893	1	KITCHEN: ADDITIONAL APPLIANCE SPECIFICATIONS - SIGNED COPY ATTACHED
02Sep21 NoCat		

BASEMENT WINDOWS

Invoice	Qty.	Description
2646	5	BASEMENT WINDOWS - UPGRADE BASEMENT WINDOW SIZE TO 30 " X 24" - 10" FRAME (PINEVALLEY 50 FOOT
72,675		LOTS ONLY)
14Apr21 **		

CERAMIC

CERAM	IC	
Invoice	Qty.	Description
2646	1	ENSUITE 3: SHOWER NICHE [SHAMPOO SHELF] - COMPLETE WITH MATCHING MARBLE JAMBS ON 4 SIDES, STANDARD TILE, APPROX. 12 X 18 INSTALLED VERTICALLY
14Apr21 NoCat		
2646	1	ENSUITE 4; SHOWER NICHE [SHAMPOO SHELF] - COMPLETE WITH MATCHING MARBLE JAMBS ON 4 SIDES, STANDARD TILE, APPROX. 12 X 18 INSTALLED VERTICALLY
14Apr21 NoCat		
2881 37 13Aug21	1	POWDER ROOM: TILE, FLOOR , LEVEL 5 - 12x24" LAID IN STRAIGHT STACKED PATTERN - SEE PLAN FOR TILE DIRECTION
2881 19 13Aug21	1	POWDER ROOM: TILE GROUT UPGRADE, FLOOR , UPG GROUT
2881 35 13Aug21	1	MUD ROOM: TILE, FLOOR , LEVEL 3 - 12x24" LAID IN STRAIGHT STACKED PATTERN - SEE PLAN FOR TILE DIRECTION
2881 37 13Aug21	1	MASTER ENSUITE: TILE, FLOOR , LEVEL 5 - 12x24"

DisciplineMS.rpt 23feb21 Page 1 of 19



Lot: 47

Model: 50.05 B KNIGHTSWOOD Project/Phase: Pine Valley Forevergreen / 1

CERAMIC

CERAM		Description
Invoice	Qty.	Description
2881 25 13Aug21	1	MASTER ENSUITE: TILE INSTALLATION UPGRADE, FLOOR , HERRINGBONE
2881 55 13Aug21	1	MASTER ENSUITE: TILE, WALL, LEVEL 9 - 30x60" LAID IN HORIZONTAL STACKED PATTERN
2881 44 13Aug21	1	MASTER ENSUITE: TILE, SHOWER FLOOR, LEVEL 3 - PENNY ROUNDS
2881 35 13Aug21	1	LAUNDRY ROOM: TILE, FLOOR, LEVEL 3 - 12x24" LAID IN STRAIGHT STACKED PATTERN - SEE PLAN FOR TILE DIRECTION
2881 37 13Aug21	1	ENSUITE 2: TILE, FLOOR , LEVEL 5 - HEX
2881 51 13Aug21	1	ENSUITE 2: TILE, WALL, LEVEL 5 - 12x24" LAID IN VERTICAL STACKED PATTERN
2881 37 13Aug21	1	ENSUITE 3: TILE, FLOOR , LEVEL 5 - HEX
2881 34 13Aug21	1	ENSUITE 3: TILE, WALL , LEVEL 2 - 8x24" LAID IN HORIZONTAL STACKED PATTERN
2881 44 13Aug21	1	ENSUITE 3: TILE, SHOWER FLOOR, LEVEL 3 - PENNY ROUNDS
2881 41 13Aug21	1	FOYER: TILE, FLOOR - LEVEL 9 - 30x60" LAID IN STRAIGHT STACKED PATTERN - SEE PLAN FOR TILE DIRECTION *** 3" INLAY + BORDER ***
2881	1	GREAT ROOM: ADD TILE TO FIREPLACE BUMP OUT - LEVEL 7 - 24x48" LAID IN HORIZONTAL, STACKED PATTERN.
13Aug21 NoCat		
2881	1	KITCHEN/BREAKFAST/SERVERY: VINTAGE SERIES, 6 1/2" WHITE OAK, NSS ENGINEERED HARDWOOD, 3/4" THK, SCULPTED TEXTURE, UVF FINISH - LEVEL 6
13Aug21 NoCat		KITCHEN/BREAKFAST/SERVERY: DO NOT SUPPLY / INSTALL CERAMIC - CREDIT
2881 13Aug21 NoCat	1	POWDER ROOM: RELOCATE TOILET - SEE PLAN FOR APPROX. NEW LOCATION

DisciplineMS.rpt 23feb21



Lot: 47

Model: 50.05 B KNIGHTSWOOD Project/Phase: Pine Valley Forevergreen / 1

CERAMIC

Invoice	Qty.	Description
2881	1	**CUSTOM LAYOUT** DELETE POWDER ROOM @ CABANA
13Aug21 NoCat		
2881	1	POWDER ROOM: ADD FLOATING VANITY SLAB + APRON FRONT - LEVEL 5 **Includes frame from Quartz supplier**
13Aug21 NoCat		Note: Open below, ceramic required wall to wall

CONCRETE AND DRAIN

Invoice	Qty.	Description
2646	1	BACK-FLOW PREVENTER VALVE
14Apr21 NoCat		

CROWN MOULDING

CITO	CNO WIT MODELDING		
Invoice	Qty.	Description	
2646 72,589 14Apr21	1	LIBRARY: MODEL OPTIONS 50.05 - LIBRARY - OPT. WAFFLE CEILING, BEAM DETAIL AS PER PLAN (4 BOXES) OPTION # 1 CTR-B07	
2646 72,581 14Apr21	1	GREAT ROOM: MODEL OPTIONS 50.05 - GREAT ROOM - OPT. WAFFLE CEILING, BEAM DETAIL AS PER PLAN (6 BOXES) OPTION #1 CTR-B07	

DisciplineMS.rpt 23feb21 Page 3 of 19



Lot: 47

Model: 50.05 B KNIGHTSWOOD Project/Phase: Pine Valley Forevergreen / 1

DRYWALL

Invoice		Description
2646 72,565 14Apr21	1	FOYER: MODEL OPTIONS - OPT. FOYER - OPT. COFFERED CEILING
2646 72,546 14Apr21	1	LIBRARY: - OPT. COFFERED CEILING - AS PER PLAN
2646 72,582 14Apr21	1	GREAT ROOM: MODEL OPTIONS 50.05 - GREAT ROOM - OPT. COFFERED CEILING AS PER PLAN
2646 14Apr21 NoCat	1	MASTER ENSUITE: SHOWER NICHE [SHAMPOO SHELF] - COMPLETE WITH MATCHING MARBLE JAMBS ON 4 SIDES, STANDARD TILE, APPROX. 12 X 18 INSTALLED VERTICALLY - SEE PLAN FOR LOCATION
2646 14Apr21	1	2ND FLOOR: INCREASE HEIGHT OF DOOR TO 8FT SECOND FLOOR - PER DOOR
2646 14Apr21 NoCat	1	ENSUITE 3: SHOWER NICHE [SHAMPOO SHELF] - COMPLETE WITH MATCHING MARBLE JAMBS ON 4 SIDES, STANDARD TILE, APPROX. 12 X 18 INSTALLED VERTICALLY
2646 14Apr21 NoCat	1	ENSUITE 4; SHOWER NICHE [SHAMPOO SHELF] - COMPLETE WITH MATCHING MARBLE JAMBS ON 4 SIDES, STANDARD TILE, APPROX. 12 X 18 INSTALLED VERTICALLY
2881 13Aug21 NoCat	1	MASTER BEDROOM: 60" IGNITE SERIES ELECTRIC FIREPLACE (XLF50), FLUSH MOUNT INSTALLATION, INCLUDES ELECTRICAL - SEE PLAN FOR APPROX. LOCATION BOTTOM OF VIEWING AREA APPROX. 24" A.F.F.
2881 13Aug21 NoCat	1	LIBRARY, BEDROOM 2: 42" ELECTRIC FIREPLACE (NEFL42CHD), FLUSH MOUNT INSTALLATION, INCLUDES ELECTRICAL - SEE PLAN FOR APPROX. LOCATION BOTTOM OF VIEWING AREA TO BE APPROX. 24" A.F.F.
2881 13Aug21 NoCat	1	MASTER BEDROOM: INSTALL BUMP-OUT TO CEILING TO ACCOMMODATE FIRPLACE
2881 13Aug21 NoCat	1	**CUSTOM LAYOUT** DELETE POWDER ROOM @ CABANA
2881 13Aug21 NoCat	1	GREAT ROOM: UPGRADE MAIN FLOOR LINEAR FIREPLACE - MAJESTIC ECHELON 2 60" LINEAR DIRECT VENT GAS FIREPLACE, INCLUDES ELECTRICAL NOT INCLUSIVE OF MANTEL SURROUND INCLUDES VENTILATION GRILL APPOX 6" BELOW CEILING TRIM BOTTOM OF VIEWING AREA TO BE APPRO
2893 101,930 02Sep21	1	ENTIRE EXTERIOR WALL FACING PINEVALLEY DRIVE: ADD SOUND INSULATION

DisciplineMS.rpt 23feb21



Lot: 47

Model: 50.05 B KNIGHTSWOOD **Project/Phase: Pine Valley Forevergreen / 1**

DisciplineMS.rpt 23feb21 Page 5 of 19 Printed and Sent: 04-Oct-21



Lot: 47

Model: 50.05 B KNIGHTSWOOD Project/Phase: Pine Valley Forevergreen / 1

ELECTRICAL

Invoice	_	Description Description
2646 72,281 14Apr21	1	GREAT ROOM: INTERIOR WALL OUTLET: ADDITIONAL 110V WALL INTERIOR RECEPTACLE ON EXISTING CIRCUIT FOR WALL MOUNTED TV - LOCATE ABOVE FIREPLACE, APPROX 66" A.F.F.
2646 72,282 14Apr21	1	KITCHEN: ADDITIONAL 220V RECEPTACLE ON A SEPARATE CIRCUIT - FOR BUILT-IN WALL OVEN - APPLIANCE NOT INCLUDED - DOES NOT INCLUDE BREAKER THAT IS TO BE INSTALLED BY LICENSED ELECTRICIAN AND ARRANGED BY HOMEOWNER AFTER CLOSING
2646 72,307 14Apr21	1	KITCHEN: FIXTURE: RELOCATE STANDARD CEILING MOUNT FIXTURE - LOCATE APPROX CENTERED ABOVE ISLAND
2646 72,273 14Apr21	1	KITCHEN: 110V WALL RECEPTACLE ON SEPARATE CIRCUIT - GAS FIRED APPLIANCE - FOR AUX. EQUIPMENT - NOT A STOVE PLUG
2646 72,303 14Apr21	1	KITCHEN: FIXTURE: UNDER CABINET FLUORESCENT LIGHT FIXTURES - INCLUDES REQUIRED CABINETRY LIGHT VALANCE
2646 72,280 14Apr21	1	KITCHEN: CEILING OUTLET: ADDITIONAL REINFORCED CEILING OUTLET - LOCATE APPROX CENTERED ABOVE ISLAND, USE SAME SWITCH AS STANDARD
2646 72,289 14Apr21	6	GREAT ROOM: 4" E/S LED INTERIOR POT LIGHT - GROUND FLOOR - EACH INCLUDED IN APS INCLUDES SWITCH
2646 72,289 14Apr21	5	MAIN HALL: 4" E/S LED INTERIOR POT LIGHT - GROUND FLOOR - EACH USE STANDARD SWITCHES
2646 72,289 14Apr21	4	LIBRARY: 4" E/S LED INTERIOR POT LIGHT - GROUND FLOOR - EACH USE STANDARD SWITCH
2646 72,289 14Apr21	8	KITCHEN + BREAKFAST: 4" E/S LED INTERIOR POT LIGHT - GROUND FLOOR - EACH
2646 72,278 14Apr21	1	KITCHEN: ADDITIONAL INTERIOR SWITCH FOR POTLIGHTS
2646 72,290 14Apr21	6	MASTER BEDROOM: 4" E/S LED INTERIOR POT LIGHT (INSULATED CEILING) - SECOND FLOOR - EACH
2646 72,278 14Apr21	1	MASTER BEDROOM: ADDITIONAL INTERIOR SWITCH FOR POTLIGHTS

DisciplineMS.rpt 23feb21

Page 6 of 19



Lot: 47

Model: 50.05 B KNIGHTSWOOD Project/Phase: Pine Valley Forevergreen / 1

ELECTRICAL

ELECT:		
Invoice	Qty.	Description []
2646 72,278	1	MASTER ENSUITE: ADDITIONAL INTERIOR SWITCH
14Apr21		FOR LIGHT ABOVE TUB
2646 72,290	8	UPPER HALL: 4" E/S LED INTERIOR POT LIGHT (INSULATED CEILING) - SECOND FLOOR - EACH
14Apr21		USE STANDARD SWITCHES
2646 72,280	1	MASTER ENSUITE: CEILING OUTLET: ADDITIONAL REINFORCED CEILING OUTLET - LOCATE APPROX CENTERE ABOVE TUB
14Apr21		
2646 72,289	6	DINING ROOM: 4" E/S LED INTERIOR POT LIGHT - GROUND FLOOR - EACH
14Apr21		
2646 72,278	1	DINING ROOM: ADDITIONAL INTERIOR SWITCH
14Apr21		FOR POTLIGHTS
2881 72,289	3	BREAKFAST: 4" E/S LED INTERIOR POT LIGHT - GROUND FLOOR - EACH
13Aug21		
2881 72,278	1	BREAKFAST: ADDITIONAL INTERIOR SWITCH FOR POT LIGHTS
13Aug21		
2881	6	CABANA: 4" E/S LED INTERIOR POT LIGHT - GROUND FLOOR - EACH
72,289 13Aug21		
2881	1	CABANA: ADDITIONAL INTERIOR SWITCH FOR POT LIGHTS
72,278 13Aug21		
2881	1	KITCHEN: INTERIOR WALL OUTLET: 110V WALL INTERIOR RECEPTACLE ON SEPARATE CIRCUIT - FOR FREEZER
72,269 13Aug21		
2881	1	KITCHEN: 110V WALL RECEPTACLE ON SEPARATE CIRCUIT - FOR MICROWAVE - MICROWAVE NOT INCLUDED
72,272 13Aug21		
2881	2	MASTER ENSUITE: ROUGH-IN FOR ADDITIONAL WALL SCONCE (1) CAPPED OUTLET PLUS (1) SWITCH - FIXTURE
72,288 13Aug21		NOT INCLUDED - SEE PLAN FOR APPROX. LOCATION APPROX. 60" A.F.F. W/ SWITCH DIRECTLY BELOW
2881	1	BEDROOM 2: INSTALL CAPPED CEILING FIXTURE WITH SEPARATE SWITCH - SEE PLAN FOR APPROX. LOCATION
72,280 13Aug21		

DisciplineMS.rpt 23feb21



Lot: 47

Model: 50.05 B KNIGHTSWOOD Project/Phase: Pine Valley Forevergreen / 1

ELECTRICAL

Invoice	Qty.	Description
2881	2	BEDROOM 2: ROUGH-IN FOR ADDITIONAL WALL SCONCE (1) CAPPED OUTLET PLUS (1) SWITCH - FIXTURE NOT INCLUDED - SEE PLAN FOR APPROX. LOCATION
13Aug21 NoCat		APPROX. 18" FROM SIDE WALLS AND APPROX. 60" A.F.F., SWITCH DIRECTLY BELOW EACH SCONCE
2881	1	MASTER BEDROOM: 60" IGNITE SERIES ELECTRIC FIREPLACE (XLF50), FLUSH MOUNT INSTALLATION, INCLUDES ELECTRICAL - SEE PLAN FOR APPROX. LOCATION
13Aug21 NoCat		BOTTOM OF VIEWING AREA APPROX. 24" A.F.F.
2881	1	LIBRARY, BEDROOM 2: 42" ELECTRIC FIREPLACE (NEFL42CHD), FLUSH MOUNT INSTALLATION, INCLUDES ELECTRICAL - SEE PLAN FOR APPROX. LOCATION
13Aug21 NoCat		BOTTOM OF VIEWING AREA TO BE APPROX. 24" A.F.F.
2881	1	**CUSTOM LAYOUT** DELETE POWDER ROOM @ CABANA
13Aug21 NoCat		
2881	1	GREAT ROOM: UPGRADE MAIN FLOOR LINEAR FIREPLACE - MAJESTIC ECHELON 2 60" LINEAR DIRECT VENT GAS FIREPLACE, INCLUDES ELECTRICAL NOT INCLUSIVE OF MANTEL SURROUND INCLUDES VENTILATION GRILL APPOX 6" BELOW CEILING TRIM BOTTOM OF VIEWING AREA TO BE APPRO
13Aug21 NoCat		
2893	1	KITCHEN: ADDITIONAL APPLIANCE SPECIFICATIONS - SIGNED COPY ATTACHED
02Sep21		

FIREPLACE

Invoice	Qty.	Description
2881 72,683 13Aug21	1	MASTER BEDROOM: 60" IGNITE SERIES ELECTRIC FIREPLACE (XLF50), FLUSH MOUNT INSTALLATION, INCLUDES ELECTRICAL - SEE PLAN FOR APPROX. LOCATION BOTTOM OF VIEWING AREA APPROX. 24" A.F.F.
2881 72,684 13Aug21	2	LIBRARY, BEDROOM 2: 42" ELECTRIC FIREPLACE (NEFL42CHD), FLUSH MOUNT INSTALLATION, INCLUDES ELECTRICAL - SEE PLAN FOR APPROX. LOCATION BOTTOM OF VIEWING AREA TO BE APPROX. 24" A.F.F.
2881 72,319 13Aug21	1	GREAT ROOM: UPGRADE MAIN FLOOR LINEAR FIREPLACE - MAJESTIC ECHELON 2 60" LINEAR DIRECT VENT GAS FIREPLACE, INCLUDES ELECTRICAL NOT INCLUSIVE OF MANTEL SURROUND INCLUDES VENTILATION GRILL APPOX 6" BELOW CEILING TRIM BOTTOM OF VIEWING AREA TO BE APPRO

DisciplineMS.rpt 23feb21 Page 8 of 19



Lot: 47

Model: 50.05 B KNIGHTSWOOD Project/Phase: Pine Valley Forevergreen / 1

FRAMING

FKAMIII Invoice	. –	Description
2646 72,631 14Apr21	2	MASTER ENSUITE: SHOWER NICHE [SHAMPOO SHELF] - COMPLETE WITH MATCHING MARBLE JAMBS ON 4 SIDES, STANDARD TILE, APPROX. 12 X 18 INSTALLED VERTICALLY - SEE PLAN FOR LOCATION
2646 72,631 14Apr21	1	ENSUITE 3: SHOWER NICHE [SHAMPOO SHELF] - COMPLETE WITH MATCHING MARBLE JAMBS ON 4 SIDES, STANDARD TILE, APPROX. 12 X 18 INSTALLED VERTICALLY
2646 72,631 14Apr21	1	ENSUITE 4; SHOWER NICHE [SHAMPOO SHELF] - COMPLETE WITH MATCHING MARBLE JAMBS ON 4 SIDES, STANDARD TILE, APPROX. 12 X 18 INSTALLED VERTICALLY
2646 14Apr21 NoCat	1	FOYER: MODEL OPTIONS - OPT. FOYER - OPT. COFFERED CEILING
2646 14Apr21 _{NoCat}	1	2ND FLOOR: INCREASE HEIGHT OF DOOR TO 8FT SECOND FLOOR - PER DOOR
2646 14Apr21 _{NoCat}	1	LIBRARY: - OPT. COFFERED CEILING - AS PER PLAN
2646 14Apr21 _{NoCat}	1	GREAT ROOM: MODEL OPTIONS 50.05 - GREAT ROOM - OPT. COFFERED CEILING AS PER PLAN
2881 13Aug21 NoCat	1	MASTER BEDROOM: INSTALL BUMP-OUT TO CEILING TO ACCOMMODATE FIRPLACE
2881 13Aug21 NoCat	1	**CUSTOM LAYOUT** DELETE POWDER ROOM @ CABANA
2881 13Aug21 NoCat	1	MASTER BEDROOM: 60" IGNITE SERIES ELECTRIC FIREPLACE (XLF50), FLUSH MOUNT INSTALLATION, INCLUDES ELECTRICAL - SEE PLAN FOR APPROX. LOCATION BOTTOM OF VIEWING AREA APPROX. 24" A.F.F.
2881 13Aug21 NoCat	1	LIBRARY, BEDROOM 2: 42" ELECTRIC FIREPLACE (NEFL42CHD), FLUSH MOUNT INSTALLATION, INCLUDES ELECTRICAL - SEE PLAN FOR APPROX. LOCATION BOTTOM OF VIEWING AREA TO BE APPROX. 24" A.F.F.

DisciplineMS.rpt 23feb21 Page 9 of 19



Lot: 47

Model: 50.05 B KNIGHTSWOOD **Project/Phase: Pine Valley Forevergreen / 1**

GLASS AND MIRROR

Invoice	Qty.	Description
2881	1	**THRU OUT: DO NOT SUPPLY OR INSTALL STANDARD MIRRORS**
13Aug21 NoCat		
2881	2	MASTER ENSUITE: UPGRADE SHOWER DOOR HARDWARE + HINGES - BRUSHED GOLD
13Aug21 NoCat		
2881	2	ENSUITE 3 + ENSUITE 4: UPGRADE SHOWER DOOR HANDLE - CHROME
13Aug21 NoCat		
2881	1	**CUSTOM LAYOUT** DELETE POWDER ROOM @ CABANA
13Aug21		

DisciplineMS.rpt 23feb21 Page 10 of 19



Lot: 47

Model: 50.05 B KNIGHTSWOOD **Project/Phase: Pine Valley Forevergreen / 1**

GRANITE MARBLE QUARTZ

Invoice		Description
2881	1	KITCHEN: UPGRADE QUARTZ COUNTERTOP - LEVEL 6
13Aug21 NoCat		
2881	1	KITCHEN: ADD FULL HEIGHT BACKSPLASH - LEVEL 6
13Aug21 NoCat		
2881	1	KITCHEN: UPGRADE COUNTERTOP THICKNESS TO 3CM
13Aug21 NoCat		
2881	1	POWDER ROOM: ADD FLOATING VANITY SLAB + APRON FRONT - LEVEL 5 **Includes frame from Quartz supplier**
13Aug21 NoCat		
2881	1	MASTER ENSUITE: UPGRADE QUARTZ COUNTERTOP - LEVEL 6
13Aug21 NoCat		
2881	1	ENSUITE 2: UPGRADE QUARTZ COUNTERTOP - LEVEL 3
13Aug21 NoCat		
2881	1	ENSUITE 3: UPGRADE MARBLE COUNTERTOP - LEVEL 6
13Aug21 NoCat		
2881	1	ENSUITE 4: UPGRADE QUARTZ COUNTERTOP - LEVEL 2
13Aug21 NoCat		
2881	1	MUD ROOM: ADD QUARTZ COUNTER + FULL HEIGHT SLAB BACKSPLASH UPGRADE 2
13Aug21 NoCat		SAME AS COUNTER
2881 157,739	2	KITCHEN: QUARTZ, 54" WATERFALL LEG (PRICE PER LEG) - LEVEL 6
137,739 13Aug21		
2881	1	**CUSTOM LAYOUT** DELETE POWDER ROOM @ CABANA
13Aug21 NoCat		

DisciplineMS.rpt 23feb21 Page 11 of 19



Lot: 47

Model: 50.05 B KNIGHTSWOOD Project/Phase: Pine Valley Forevergreen / 1

HARDWOOD

13Aug21 NoCat

HARDWOOD		
Invoice	Qty.	Description
2881 8 13Aug21	1	KITCHEN/BREAKFAST/SERVERY: VINTAGE SERIES, 6 1/2" WHITE OAK, NSS ENGINEERED HARDWOOD, 3/4" THK, SCULPTED TEXTURE, UVF FINISH - LEVEL 6
2881 8 13Aug21	1	THRU OUT STANDARD AREAS: MAIN HALL, DINING ROOM, GREAT ROOM, LIBRARY, CABANA, UPPER HALL, MASTER BEDROOM, BEDROOM 2, BEDROOM 3, BEDROOM 4: VINTAGE SERIES, 6 1/2" WHITE OAK, NSS ENGINEERED HARDWOOD, 3/4" THK, SCULPTED TEXTURE, UVF FINISH - LEVEL 6
HVAC Invoice	Qty.	Description
2646 72,224 14Apr21	1	KITCHEN: GAS LINE ROUGH-IN - MAIN FLOOR FOR APPLIANCE - SEE PLAN FOR LOCATION
2646 72,218 14Apr21	1	KITCHEN - UPGRADE TO 8" DUCT (INTERIOR WALL) IN LIEU OF STANDARD OFFERING
2881 13Aug21 NoCat	1	MASTER BEDROOM: 60" IGNITE SERIES ELECTRIC FIREPLACE (XLF50), FLUSH MOUNT INSTALLATION, INCLUDES ELECTRICAL - SEE PLAN FOR APPROX. LOCATION BOTTOM OF VIEWING AREA APPROX. 24" A.F.F.
2881 13Aug21 NoCat	1	LIBRARY, BEDROOM 2: 42" ELECTRIC FIREPLACE (NEFL42CHD), FLUSH MOUNT INSTALLATION, INCLUDES ELECTRICAL - SEE PLAN FOR APPROX. LOCATION BOTTOM OF VIEWING AREA TO BE APPROX. 24" A.F.F.
2881 13Aug21 NoCat	1	**CUSTOM LAYOUT** DELETE POWDER ROOM @ CABANA
2881	1	GREAT ROOM: UPGRADE MAIN FLOOR LINEAR FIREPLACE - MAJESTIC ECHELON 2 60" LINEAR DIRECT VENT GAS FIREPLACE, INCLUDES ELECTRICAL NOT INCLUSIVE OF MANTEL SURROUND

INCLUDES VENTILATION GRILL APPOX 6" BELOW CEILING TRIM

BOTTOM OF VIEWING AREA TO BE APPRO

DisciplineMS.rpt 23feb21 Page 12 of 19



Lot: 47

Model: 50.05 B KNIGHTSWOOD Project/Phase: Pine Valley Forevergreen / 1

INTERIOR TRIM AND DOORS

Invoice		Description
2646 72,644 14Apr21	19	2ND FLOOR: INCREASE HEIGHT OF DOOR TO 8FT SECOND FLOOR - PER DOOR
2881	1	THRU OUT: ADD WINDOW STOOLS AND APRONS
13Aug21 NoCat		
2881 153,841	1	THRU OUT: HALIFAX LEVER, IRON BLACK INTERIOR DOOR HARDWARE
13Aug21		UPGRADE
2881 155,922	1	THRU OUT: ADD FOR HINGES 3X3 SQUARE FLAT TIP THROUGHOUT
13Aug21		UPGRADE
2881 155,415	1	THRU OUT: UPGRADE INTERIOR DOORS TO LOGAN
13Aug21		UPGRADE
2881 100,452 13Aug21	1	THRU OUT: UPGRADE 3 1/2" STEP BEVEL, 7 1/4" BASE BOARD - UPGRADE
2881	1	MASTER BEDROOM: 60" IGNITE SERIES ELECTRIC FIREPLACE (XLF50), FLUSH MOUNT INSTALLATION, INCLUDES ELECTRICAL - SEE PLAN FOR APPROX. LOCATION BOTTOM OF VIEWING AREA APPROX. 24" A.F.F.
13Aug21 NoCat		
2881	1	LIBRARY, BEDROOM 2: 42" ELECTRIC FIREPLACE (NEFL42CHD), FLUSH MOUNT INSTALLATION, INCLUDES ELECTRICAL - SEE PLAN FOR APPROX. LOCATION BOTTOM OF VIEWING AREA TO BE APPROX. 24" A.F.F.
13Aug21 NoCat		
2881	1	MASTER BEDROOM: INSTALL BUMP-OUT TO CEILING TO ACCOMMODATE FIRPLACE
13Aug21 NoCat		
2881	1	**CUSTOM LAYOUT** DELETE POWDER ROOM @ CABANA
13Aug21 NoCat		
2881	1	GREAT ROOM: UPGRADE MAIN FLOOR LINEAR FIREPLACE - MAJESTIC ECHELON 2 60" LINEAR DIRECT VENT GAS FIREPLACE, INCLUDES ELECTRICAL NOT INCLUSIVE OF MANTEL SURROUND INCLUDES VENTILATION GRILL APPOX 6" BELOW CEILING TRIM BOTTOM OF VIEWING AREA TO BE APPRO
13Aug21 NoCat		
2893 101,930 02Sep21	1	THRU-OUT: ADD APPLIED MOULDING - SAME AS KNIGHTSWOOD MODEL HOME, LOT 93

DisciplineMS.rpt 23feb21 Page 13 of 19



Lot: 47

Model: 50.05 B KNIGHTSWOOD **Project/Phase: Pine Valley Forevergreen / 1**

KITCHEN AND BATH CABINETRY

Invoice	Qty.	Description
2646 72,218 14Apr21 **	1	KITCHEN - UPGRADE TO 8" DUCT (INTERIOR WALL) IN LIEU OF STANDARD OFFERING
2646	1	KITCHEN: FIXTURE: UNDER CABINET FLUORESCENT LIGHT FIXTURES - INCLUDES REQUIRED CABINETRY LIGHT VALANCE
14Apr21 NoCat		
2881	1	THRU OUT: SEE ATTACHED CABINETRY SCHEDULE
13Aug21 NoCat		
2881	1	**CUSTOM LAYOUT** DELETE POWDER ROOM @ CABANA
13Aug21 NoCat		
2881	1	KITCHEN: QUARTZ, 54" WATERFALL LEG (PRICE PER LEG) - LEVEL 6
13Aug21 NoCat		

DisciplineMS.rpt 23feb21 Page 14 of 19 Printed and Sent: 04-Oct-21



Lot: 47

Model: 50.05 B KNIGHTSWOOD Project/Phase: Pine Valley Forevergreen / 1

NETWORK AND WIRING

Invoice	Qty.	Description
2646 72,259 14Apr21	1	GREAT ROOM: CONDUIT PIPE - FOR WALL MOUNT TV - LOCATE ABOVE FIREPLACE, APPROX 66" A.F.F. THRU BASEMENT, TERMINATE AT CABLE LOCATION - SEE PLAN
2881 72,258 13Aug21	9	GREAT ROOM, DINING ROOM, LIBRARY, CABANA, MASTER BEDROOM, BEDROOM 2 (x2), BEDROOM 3, BEDROOM 4: ADDITIONAL CAT6 ETHERNET OUTLET - EACH - SEE PLAN
2881 72,265 13Aug21	2	GREAT ROOM: ROUGH - IN WIRING FOR ONE PAIR OF SPEAKERS - SEE PLAN FOR APPROX. LOCATION
2881 13Aug21 NoCat	1	THRU OUT: ADD CENTRAL VAC - CYCLOVAC 215 (includes all accessories) LAUNDRY: ADD WALLY - WHITE KITCHEN: ADD VAC PAN (at sink)
2904 72,258	5	ADDITIONAL CAT6 ETHERNET OUTLET - EACH - FOR FUTURE SECURITY CAMERAS
04Oct21		**LOCATION AS PER DISCUSSION WITH MARTIN**

DisciplineMS.rpt 23feb21 Page 15 of 19



Lot: 47

Model: 50.05 B KNIGHTSWOOD Project/Phase: Pine Valley Forevergreen / 1

PAINT

Invoice	Qty.	Description
2646	1	FOYER: MODEL OPTIONS - OPT. FOYER - OPT. COFFERED CEILING
14Apr21 NoCat		
2646	1	MASTER ENSUITE: SHOWER NICHE [SHAMPOO SHELF] - COMPLETE WITH MATCHING MARBLE JAMBS ON 4 SIDES, STANDARD TILE, APPROX. 12 X 18 INSTALLED VERTICALLY - SEE PLAN FOR LOCATION
14Apr21 NoCat		
2646	1	2ND FLOOR: INCREASE HEIGHT OF DOOR TO 8FT SECOND FLOOR - PER DOOR
14Apr21 NoCat		
2646	1	LIBRARY: - OPT. COFFERED CEILING - AS PER PLAN
14Apr21 NoCat		
2646	1	LIBRARY: MODEL OPTIONS 50.05 - LIBRARY - OPT. WAFFLE CEILING, BEAM DETAIL AS PER PLAN (4 BOXES) OPTION # 1 CTR-B07
14Apr21 NoCat		
2646	1	GREAT ROOM: MODEL OPTIONS 50.05 - GREAT ROOM - OPT. WAFFLE CEILING, BEAM DETAIL AS PER PLAN (6 BOXES) OPTION #1 CTR-B07
14Apr21 NoCat		
2646	1	GREAT ROOM: MODEL OPTIONS 50.05 - GREAT ROOM - OPT. COFFERED CEILING AS PER PLAN
14Apr21 NoCat		
2881	2	MAIN STAIRS - 2ND FLOOR TO BASEMENT: STAIN STAIRS AND LANDINGS
13Aug21 NoCat		WILL NOT MATCH HARDWOOD IN COLOUR, SPECIES, OR TEXTURE
2881	1	MASTER BEDROOM: 60" IGNITE SERIES ELECTRIC FIREPLACE (XLF50), FLUSH MOUNT INSTALLATION, INCLUDES ELECTRICAL - SEE PLAN FOR APPROX. LOCATION
13Aug21 NoCat		BOTTOM OF VIEWING AREA APPROX. 24" A.F.F.
2881	1	LIBRARY, BEDROOM 2: 42" ELECTRIC FIREPLACE (NEFL42CHD), FLUSH MOUNT INSTALLATION, INCLUDES ELECTRICAL - SEE PLAN FOR APPROX. LOCATION
13Aug21 NoCat		BOTTOM OF VIEWING AREA TO BE APPROX. 24" A.F.F.
2881	1	MASTER BEDROOM: INSTALL BUMP-OUT TO CEILING TO ACCOMMODATE FIRPLACE
13Aug21 NoCat		
2881	1	**CUSTOM LAYOUT** DELETE POWDER ROOM @ CABANA
13Aug21 NoCat		
2881	1	GREAT ROOM: UPGRADE MAIN FLOOR LINEAR FIREPLACE - MAJESTIC ECHELON 2 60" LINEAR DIRECT VENT GAS FIREPLACE, INCLUDES ELECTRICAL NOT INCLUSIVE OF MANTEL SURROUND
13Aug21 NoCat		INCLUDES VENTILATION GRILL APPOX 6" BELOW CEILING TRIM BOTTOM OF VIEWING AREA TO BE APPRO

DisciplineMS.rpt 23feb21



Lot: 47

Model: 50.05 B KNIGHTSWOOD

Project/Phase: Pine Valley Forevergreen / 1

DisciplineMS.rpt 23feb21 Page 17 of 19
Printed and Sent: 04-Oct-21



Lot: 47

Model: 50.05 B KNIGHTSWOOD Project/Phase: Pine Valley Forevergreen / 1

PLUMBING

Invoice	Qty.	Description
2646	1	MASTER ENSUITE: UPGRADE TO MOEN 'ALIGN' - LAV FAUCET x2 // FLOOR MOUNTED TUB FILLER // RAIN SHOWER SYSTEM - BRUSHED GOLD
14Apr21 NoCat		
2646	1	KITCHEN: POTFILLER - MOEN MODERN 'BRUSHED GOLD'
14Apr21 NoCat		INCLUDES ROUGH IN
2646 72,332 14Apr21	1	KITCHEN: ROUGH-IN 1/4" COLD WATER LINE TO FRIDGE
2881	1	POWDER ROOM: RELOCATE TOILET - SEE PLAN FOR APPROX. NEW LOCATION
13Aug21 NoCat		
2881	1	POWDER ROOM: UPGRADE TOILET TO CONTRAC MILLER - MATTE BLACK
13Aug21 NoCat		
2881	1	POWDER ROOM: UPGRADE TO CHROME P-TRAP
13Aug21 NoCat		FOR FLOATING VANITY
2881	1	KITCHEN + SERVERY: UPGRADE SINKS (Blanco Quatrus) AND FAUCETS (Nio Black with Gold Faucet)
13Aug21 NoCat		
2881	1	KITCHEN: ADD MODERN SOAP DISPENSER
13Aug21 NoCat		RIGHT OF FAUCET
2881	1	POWDER ROOM: UPGRADE FAUCET TO MOEN 8" 'ALIGN' - GOLD
13Aug21 NoCat		
2881	1	MUD ROOM: UPGRADE SINK (Blanco stainless) AND FAUCET (Moen Sleek)
13Aug21 NoCat		
2881	1	SERVERY: ADD MOEN MODERN SIP FILTERED WATER FAUCET SYSTEM
13Aug21 NoCat		LEFT OF FAUCET
2881	1	**CUSTOM LAYOUT** DELETE POWDER ROOM @ CABANA
13Aug21 NoCat		
2881	1	POWDER ROOM: ADD FLOATING VANITY SLAB + APRON FRONT - LEVEL 5 **Includes frame from Quartz supplier**
13Aug21 NoCat		Note: Extended plumbing required

DisciplineMS.rpt 23feb21 Page 18 of 19



Lot: 47

Model: 50.05 B KNIGHTSWOOD Project/Phase: Pine Valley Forevergreen / 1

PLUMBING

I	nvoice	Qty.	Description
	2893	1	SERVERY: ***DELETE FROM PE#2881 - MOEN MODERN SIP FILTERED WATER FAUCET SYSTEM***
	101,930		
	02Sep21		
- 1			

STAIR AND RAILINGS

Invoice	Qty.	Description
2881 94,044 13Aug21	_	MAIN STAIRS: UPGRADE - EUROLINE S/S, 3" RECTANGULAR HANDRAIL, 3 1/2" ALL SQUARE POST WITH SQUARE STYLE W/BAND POST CAP - PACKAGE E

DisciplineMS.rpt 23feb21 Page 19 of 19



PV - 47 Cabinetry Schedule

ROOM	DESCRIPTION	PRICE QTY	TOTAL
KITCHEN	UPGRADE PERIMETER + SERVERY FROM SERIES 2 TO SERIES 5 - WILLIS FOG		
KITCHEN	RETURN TRIP FOR HARDWOOD IN KITCHEN	1	
	UPGRADE HARDWARE - BH-082-03 GOLD	1	
	UPGRADE HARDWARE - BAH-083-03 GOLD (APPLIANCES + PANTRIES)	1	
	ADJUST CABINETRY FOR 36" RANGETOP (N/C)	1	
	ADD BASE POTS AND PANS BELOW RANGETOP	1	
	ADD DECORATIVE HOOD CANOPY - ASPEN MODERN	1	
	CONVERT STD BASE CABINETS TO BASE POTS AND PANS	1	
	ADD SPICE PULL OUT ACCESSORY TO BASE CABINET	2	
	ADD TWO-BIN RECYCLE CENTRE	1	
	ADD DÉCOR PANELS FOR FRIDGE/FREEZER	1	
		1	
	CONVERT STANDARD CABINETRY INTO TALL DEEP BUILT IN PANTRY UNIT	1	
	ADD ROLL OUT DRAWERS TO PANTRY UNITS (3 DRAWERS PER UNIT) ADD DÉCOR PANEL FOR DISHWASHER	1	
		1	
	CONVERT BASE CABINET IN SERVERY TO BUILT IN MICRO UNIT W/ DRAWER BELOW	1	
	CONVERT STD CABINETRY INTO TALL DEEP BUILT IN OVEN UNIT W/ DRAWER BELOW	1	
ISLAND	UPGRADE ISLAND FROM SERIES 2 TO SERIES 5 - WILLIS FOG	1	
	ADD TOUCH LATCH HARDWARE TO REAR ISLAND	i	
	ADD FLUSH KICK PLATE TO REAR ISLAND	i	
WASTER CHOOLE	UPGRADE FROM SERIES 2 TO SERIES 3 - BROADWAY II HI GLOSS GREY CONVERT STANDARD VANITY TO FLOATING VANITY	1	
		2	
	ADD BUILD UP 2x4 SUPPORT OR SKIRT PANEL TO COVER PLUMBING	2	
ENSUITE 2 + ENSUIT	E 3 CONVERT STANDARD VANITIES TO COMFORT HEIGHT VANITIES		
	CABINE	TRY TOTAL:	

HARDWARE TO BE INSTALLED: VERTICAL ON DOORS, HORIZONTAL ON DRAWERS, AND AT INSTALLERS DISCRETION

DATE: August 11, 2021	
GNATURE:	
IGNATURE:	

GOLD PARK

GOLD INTERIOR COLOUR SCHEME

*** NOTE: This is not an approved document. Document must be locked ***

Scheduled Closing Date:

GHOLAM HOSSIN RIZAI & MAHROKH RIZAI Property: 47 of Plan

Layout Changes: Yes	No Sketch Attached: Ye	es No Exterior Colour Scheme:		
1. Cabinetry	Style and Colour	Counter	Hardware	
Kitchen / Breakfast	'Willis 'Fog'	*Quartz: 'Calacatta Gold'	attachd	
Laundry Room	Monterey 'Slate Grey Maple'	P-Lam 'White'	attachd	
Powder Room	*N/A	*Quartz: 'Statuario Maximus'	None	
Mud Room	Monterey 'Slate Grey Maple'	*Quartz: Organic White + FHBS	attachd	
Master Ensuite Bathroom	Broadwayll Hi Gloss 'Grey'	*Quartz: 'Calacatta Gold'	attachd	
Second Ensuite Bathroom (If Applicable)	Modena 'Classic White'	*Quartz: 'Lagoon'	attachd	
Ensuite 3	Modena 'Classic White'	*Marble: Collomandina	attachd	
Comment Ensuite 4: Modena 'Classic White' +	*Quartz: Organic White			
0 Fl Til				
2. Floor Tile	Selection			
Entrance Vestibule	*See comment			
Main Hall	n/a			
Kitchen / Breakfast	*See hardwood			
Laundry Room	*12x24" Eterna 'Imperial Grey' pol			
Powder Room	*12x24" Marmorea 'Port Laurent'	pol. + grout 'Charcoal'		
Mud Room	*12x24" Eterna 'Imperial Grey' po			
Master Ensuite Bathroom	*12x24" Marmorea 'Grigio Imperia	al' pol.		
Second Ensuite Bathroom (If Applicable)	*Roma Hay (Cratita)			
Ensuite 3	*Merino Hex 'Ivory'			
Comment				
	hite' pol. + 3" Inlay Marmorea 'Port Laurer' e' matte / Ensuite 3 Shower Floor: *Penny	nt' pol. + Border Marmorea 'Breccia White' pol. Rounds 'White/Grey/Taupe' / Ensuite 4 Floor: 13x13"		
3. Wall Tile	Selection	Listello/Inserts Describe		
Ensuite 4	8x10" Uniwall 'Tender Grey'	○ Yes ● No		
Master Ensuite Bathroom				
Tub Dec		○ Yes • No		
	II *30x60" Marmorea 'Imp Grigio'			
Bathroom Wall Second Ensuite Bathroom (If Applicable)	*12x24" Overlay 'Smoke'			
Ensuite 3	*8x24" Laguna Wave 'White'	○ Yes ● No		
Kitchen Backsplash	Yes No	Backsplash Behind Fridge		
	*FHBS same as counter	Daonopiasii Deiiiid i Hage	+.	
Comment	TITLO SAITE AS COUITE			

Page 1 of 4

GOLDPARI INTERIOR COLOUR SCHEME *** NOTE: This is not an approved document. Document must be locked *** Scheduled Closing Date: GHOLAM HOSSIN RIZAI & MAHROKH RIZAI Purchasers: Property: 47 of Plan -Telephone Res. / Bus: / Project: Pine Valley Forevergreen - Phase 1 Decor Advisor: Angela Phim Model and Elevation: 50.05 B KNIGHTSWOOD 4. Plumbing Fixtures Second Ensuite **Powder Room** Master Ensuite Bathroom Other Room - Specify Other Washroom Comment *upgraded thru out - see attached 5. Hardwood Flooring Type and Stain Type and Stain Main Hall **Upper Landing** Kitchen / Breakfast *6-1/2" WhiteOak, Sculpted, Apollo Upper Hall Living Room Master Bedroom **Dining Room** Bedroom #2 **Family Room** Bedroom #3 Den/Library Bedroom #4 **Entrance Vestibule** Bedroom #5 Lower Landing Other Room - Specify *6-1/2" WhiteOak, Sculpted, Apollo (If Applicable) thru-out standard areas Comment 6. Carpeting Upgrade Description **Ground Floor** Second Floor Type Area **Upgrade Underpad** Capped Runner - *Upgrade **Carpet on Stairs** Comment 7. Fireplace Living Room Family Room Other Room - Specify see comment Purchased As Per Plan N/A Purchased As Per Plan N/A Purchased As Per Plan N/A 0 0 0 0 0 Fireplace Type Linear - Gas *see comment Mantle Type n/a n/a Colour / Stain n/a n/a Surround n/a n/a Hearth n/a n/a Comment *Library, Master Bedroom, Bedroom 2: upgraded - see extras GIR

GOLDPARK INTERIOR COLOUR SCHEME *** NOTE: This is not an approved document. Document must be locked *** Scheduled Closing Date: Purchasers: GHOLAM HOSSIN RIZAI & MAHROKH RIZAI Property: 47 of Plan -Telephone Res. / Bus: / Project: Pine Valley Forevergreen - Phase 1 Decor Advisor: Angela Phim Model and Elevation: 50.05 B KNIGHTSWOOD 8. Trim Carpentry Interior Doors *Logan Front Door Glass Inserts Standard Door Handles *Halifax Blk + hinge Interior Trim *Board 4 + Window Stools and Aprons Comment 9. Plaster Mouldings and Medallions Standard Throughout O Yes O No **Entrance Vestibule** Kitchen/Breakfast Main Hall Den/Library Living Room **Lower Landing Dining Room** Other Room - Specify Family Room Comment 10. Railings and Spindles Railing Package *Package E Railing Colour *Mirage 'Hopscotch' Spindle Colour *Black w/ Stainless Steel Stringer / Riser *Mirage 'Hopscotch' **Treads** *Mirage 'Hopscotch' Oak Stairs Yes O No O N/A Comment 11. Wall Paint / Ceilings Throughout Finished Areas Warm Grey





Trim Paint

Comment

Smooth Ceilings


Note

Ground Floor Second Floor

White

GOLDPAR INTERIOR COLOUR SCHEME *** NOTE: This is not an approved document. Document must be locked *** Scheduled Closing Date: Purchasers: GHOLAM HOSSIN RIZAI & MAHROKH RIZAI Property: 47 of Plan -Telephone Res. / Bus: / Project: Pine Valley Forevergreen - Phase 1 Decor Advisor: Angela Phim Model and Elevation: 50.05 B KNIGHTSWOOD 12. Electrical Hood Fan White ○ Stainless ○ N/A Above Kitchen Cabinet Light O Yes No Below Kitchen Cabinet Light Yes No Standard Appliances Over The Range Microwave Chimney Style Fan Comment 13. Heating and Air Conditioning Air Conditioning none **Gas Provisions Stove** ves Gas Provisions Dryer none Gas Provisions Barbecue standard Comment 14. Additional Comments 15. Disclaimers and Notes 1) Colours of all materials are as close as possible to builder's selection, but not necessarily identical due to variances in manufacturing. 2) Any extras listed above are null and void unless accompanied by a separate invoice/amendment. Said invoice must be paid in full. The Purchaser acknowledges that after Interior Colour Selection form is signed and dated, no further changes will be permitted other than re-selection due to unavailability. Purchaser's Initials 4) The Purchaser acknowledges reading and accepting the "Gold Park Homes Decor Centre Disclaimers" form. This document contains other miscellaneous disclaimers. This Interior Colour Selection is final and approved by: Signature: Date: Page 4 of 4

Printed 2021-08-11 20:15:29

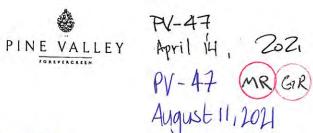

The Knightswood

50' SERIES

Elevation A • 4,445 sq.ft. 4,475 sq.ft. Opt. Elevator / 4,575 sq.ft. Opt. Service Stairs Elevation B • 4,440 sq.ft.


4,475 sq.ft. Opt. Elevator / 4,575 sq.ft. Opt. Service Stairs

Elevation C • 4,525 sq.ft.

4,560 sq.ft. Opt. Elevator / 4,660 sq.ft. Opt. Service Stairs


LEGEND

S = SPEAKER R/I (APPROX 96" A.F.F.)

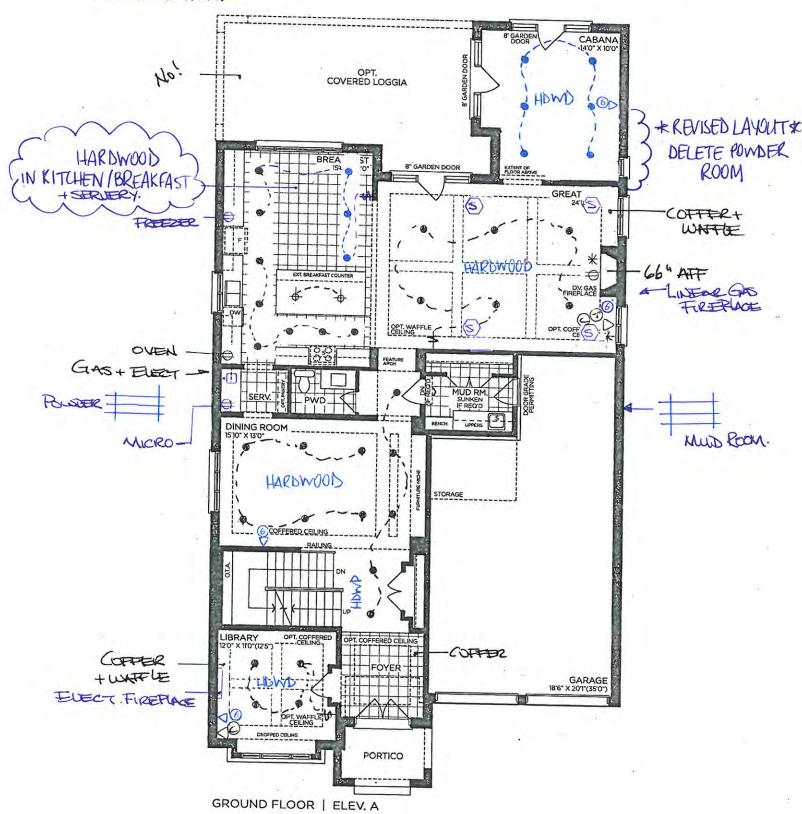

VENDOR PURCHASER PURCHASER GOLDPARK

Prices, figures, illustrations, sizes, features and finishes are subject to change without notice. Areas and dimensions are approximate and actual usable floor space may vary from the stated area. Layout may be reverse of the unit purchased. E. & O.E. 5005

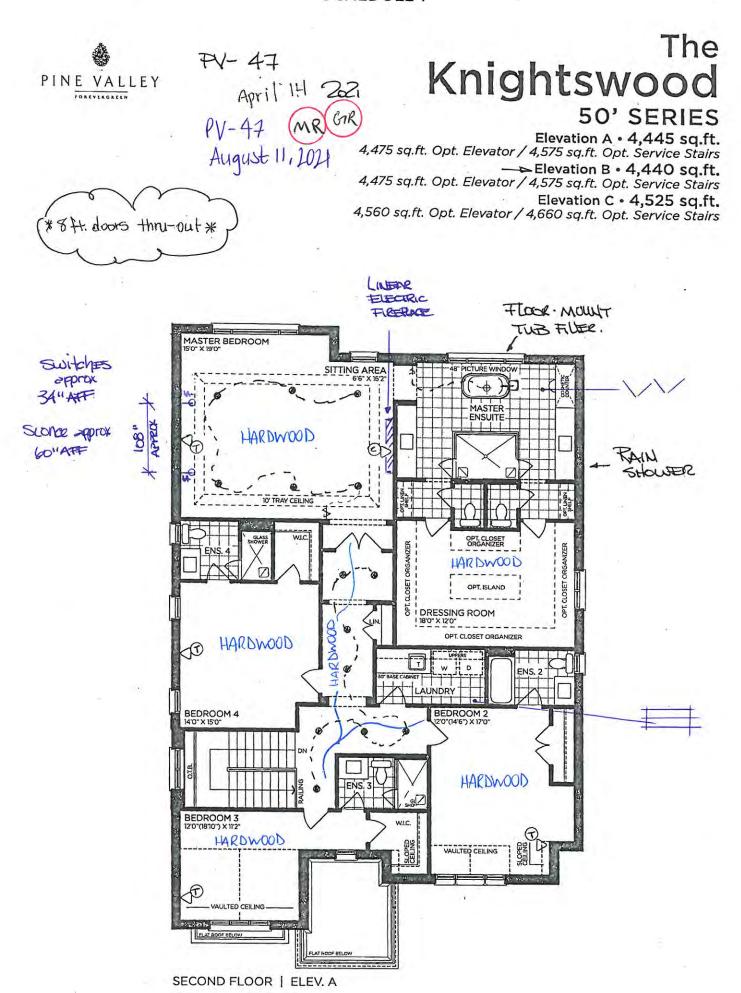

VENDOR
PURCHASER
PURCHASER

GOLDPARK

WORTH MORE

Prices, figures, illustrations, sizes, features and finishes are subject to change without notice. Areas and dimensions are approximate and actual usable floor space may vary from the stated area. Layout may be reverse of the unit purchased. E. & O.E. 5005



PV-47 April 14 22 August 11, 2021


The Knightswood

50' SERIES


Elevation A • 4,445 sq.ft. 4,475 sq.ft. Opt. Elevator / 4,575 sq.ft. Opt. Service Stairs Elevation B • 4,440 sq.ft. 4,475 sq.ft. Opt. Elevator / 4,575 sq.ft. Opt. Service Stairs

Elevation C • 4,525 sq.ft.


4,560 sq.ft. Opt. Elevator / 4,660 sq.ft. Opt. Service Stairs

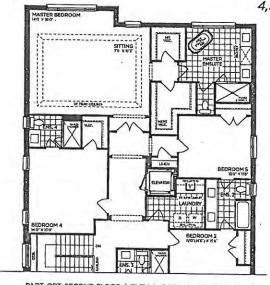


D FLOOR | ELEV. A (5 BEDROOMS - ELEVATOR)

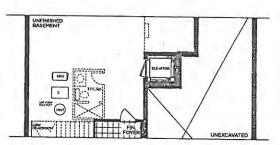


PART, OPT, BASEMENT | ELEV. A (ELEVATOR)

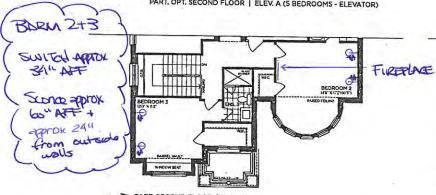


PART, SECOND FLOOR | ELEV. B

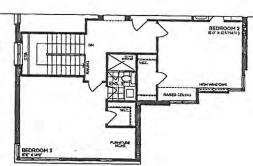

PART, SECOND FLOOR | ELEV. C

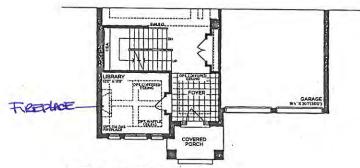


PART. GROUND FLOOR | ELEV. B

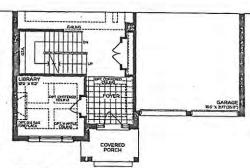

PART, GROUND FLOOR | ELEV. C



PART. BASEMENT | ELEV. B

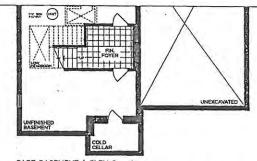

PART. BASEMENT | ELEV. C

VENDOR PURCHASER PURCHASER

GOLDPARK

Prices, figures, illustrations, sizes, features and finishes are subject to change without notice. Areas and dimensions are approximate and actual usable floor space may vary from the stated area. Layout may be reverse of the unit purchased. E, & O.E. 5005



PURCHASER

PURCHASER

PV-47 April 14. 2021 PV-47 MR GR August 11, 2021

The Knightswood

50' SERIES


Elevation A • 4,445 sq.ft. 4,475 sq.ft. Opt. Elevator / 4,575 sq.ft. Opt. Service Stairs


Elevation B • 4,440 sq.ft. 4,475 sq.ft. Opt. Elevator / 4,575 sq.ft. Opt. Service Stairs

Elevation C • 4,525 sq.ft.

4,560 sq.ft. Opt. Elevator / 4,660 sq.ft. Opt. Service Stairs

Prices, figures, illustrations, sizes, features and finishes are subject to change without notice. Areas and dimensions are approximate and actual usable floor space may vary from the stated area. Layout may be reverse of the unit purchased. E. & O.E. 5005

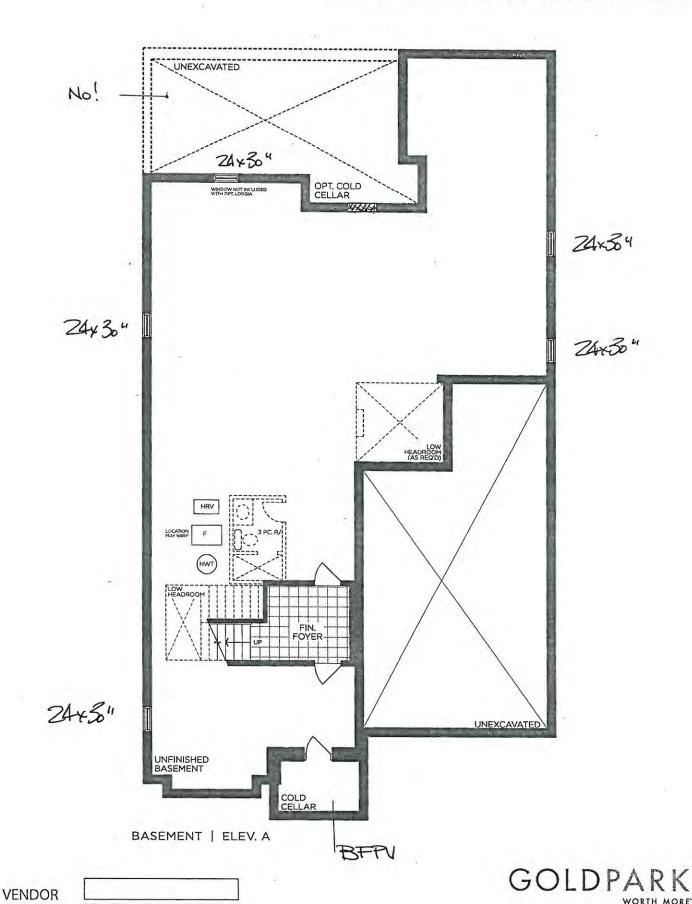

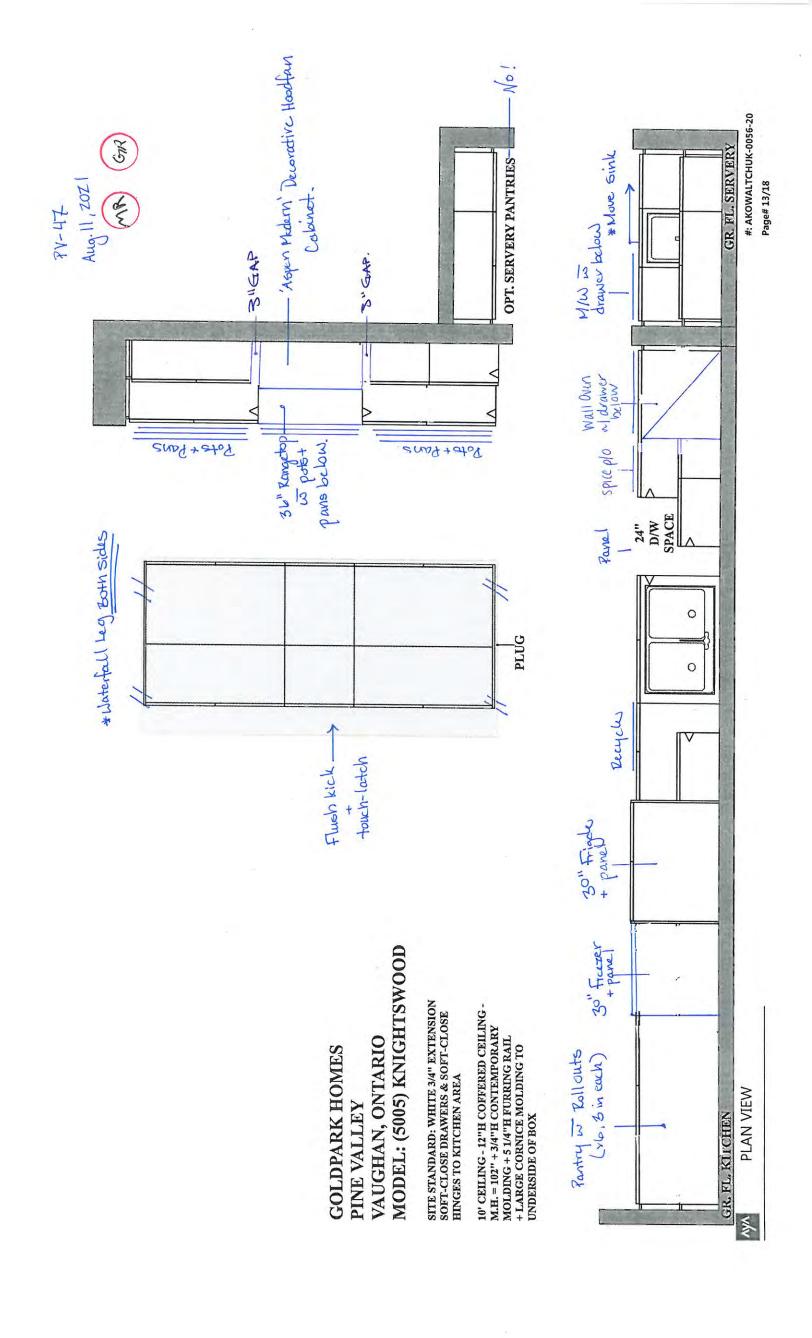





MODEL: (5005) KNIGHTSWOOD VAUGHAN, ONTARIO GOLDPARK HOMES PINE VALLEY

SITE STANDARD: WHITE 3/4" EXTENSION SOFT-CLOSE DRAWERS WITH STANDARD SLAM DOOR HINGES TO VANITIES


ONE TOP DRAWER WHERE POSSIBLE THROUGHOUT EACH VANITY, ONE BANK OF DRAWERS WHERE POSSIBLE THROUGHOUT EACH MASTER ENSUITE VANITY

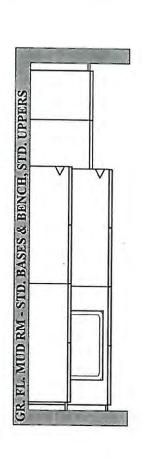


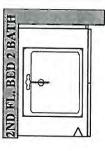






2ND FL. BED 3 BATH

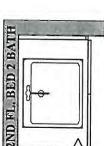


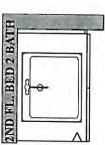


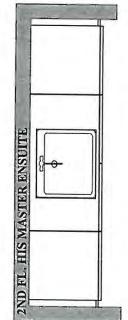


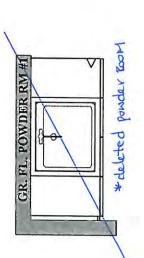

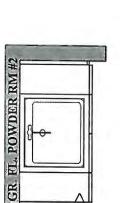

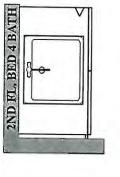

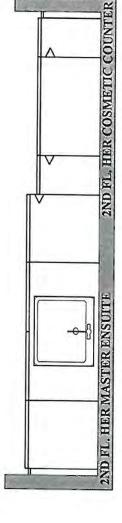

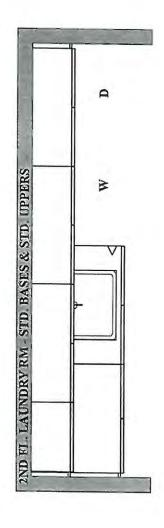





STONE COUNTERTOP EDGE PROFILES

	STANDARD 2CM EASED EDGE	LOCATION: # thru - out *
	UPGRADE 3CM EASED EDGE	LOCATION:
	UPGRADE 4CM MITRED EDGE	LOCATION:
	UPGRADE 2CM OGEE EDGE	LOCATION:
LOT#: PV- 47 SIGNATURE:	DATE: August 11	, 202
SIGNATURE:	arania.	



H001-02	H001-03	H001-04
6		TOUCH-LATCH
H009-03	H009-09	
H011-03	H011-05	H011-06
		*NO HARDWARE
H033-01 LAIMER: NO HARDWARE OR HOLES THRU-OUT: HOME EXPENSE AND WARRANTY.	> Laundry	2, Ensuite 3, Ensuite 4 ; on of their own hardware after closing at the
LOT	August 11, 2021	
SIGNATURE:	Type The second	
SIGNATURE:		



BH-082-03

MATTE	ED NICKEL BLACK EN BRONZE
LOCATION:	
LOT # PV-47 DATE:	Aug. 11,2021
SIGNATURE:	
SIGNATURE:	

SIGNATURE:



BAH-083-03

Appliance Pull

BRUSHED NICKEL MATTE BLACK Modern Bronze	
> kitchen Appliances + Pantries	
DATE: Aug. 11, 2021 SIGNATURE:	



MOEN - SIP MODERN

Single Handle Beverage Faucet



CHROME (C)			
STAINLESS (S	SRS)		
MATTE BLAC	CK (BL)		
BLACK STAIN	ILESS (BLS)		
/IODEL: \$5530 / \$550	00		
-ot# W-47	Date: August 11, 2021	Room: Servery	*left of faucet*
Signature:	J.		
Signature:	Duy.		
			COLDDAR



MOEN - MODERN

Soap/Lotion Dispenser




CHROME (C)	
STAINLESS (SRS)	
BRUSHED GOLD (BG)	
MATTE BLACK (BL)	
MODEL: S3947 (C, SRS, BG, BL) Soap Dispenser	
Lot# PV-47 Date: August 11, 2021 Room: Kitchen	
Signature:	
Signature:	



MOEN - NIO

One-Handle Pulldown Kitchen Faucet

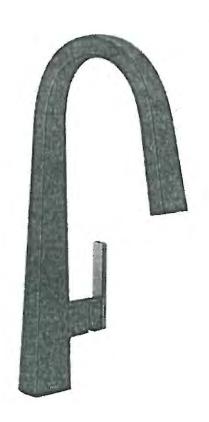

CHROME
MATTE BLACK / BRUSHED GOLD (BL)
SPOT RESIST STAINLESS (SRS)

MODEL: S75005 Chrome / S75005BL Matte Black / S75005SRS Spot Resist Stainless


Lot# PV-47	Date: August 11, 2021	Room: Kitchen	
Signature:			
Signature:) 54		>0



BLANCO - QUATRUS R15 U 2 Stainless Steel - Undermount 32" x 18" x 9"





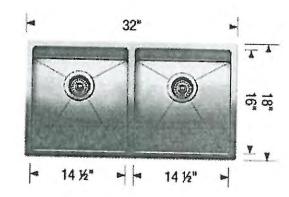

Stainless Steel


MODEL 401519 Stainless Steel

Lot# pV - 47	
Room: Kitchen	Signature:
Date: August 11, 2021	Signature:



MOEN - NIO

One-Handle Bar Faucet

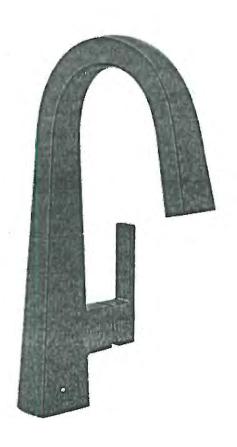

CHROME
MATTE BLACK / BRUSHED GOLD (BL)
STAINLESS (SRS)
MODEL: S55005 Chrome / S55005BL Matte Black / S55005SRS Spot Resist Stainless
Lot# PV-47 Date: August 11, 2021 Room: Servery
Signature:
Signature:



BLANCO - QUATRUS R15 U BAR Stainless Steel - Undermount 17" x 17" x 8"



Stainless Steel

MODEL 401515 Stainless Steel

Lot# PV- 47	
Room: Servery	Signature:
Date: August 11, 2021	Signature:



MOEN - ALIGN

Two-Handle Adjustable Widespread Lav Faucet with Lift Rod Drain



CHROME	
BRUSHED NICKEL (BN)	
BRUSHED GOLD (BG)	
MATTE BLACK (BL)	
MODEL: T6193 / 69000	
Lot# PV-47 Date: August 11, 2021	Room: Ponder Room
Signature:	
Signature:	



MILLER

Contrac Matte Black 1 Piece Elongated Bowl w/ concealed trap-way



DESCRIPTION: Matte Black, Top-Push button, Smooth-Close Seat

DIMENSIONS: 16 3/4" x 28 1/4" x 29 1/2"

MODEL: 4711BEVU-077

Lot# PY-47	Date: Aug. 11, 2021	Room: Powder Room	
Signature:) F		
Signature:) 2.49		



BLANCO - QUATRUS R15 LAUNDRY SINK + MOEN - SLEEK SINGLE HANDLE PULLOUT FAUCET





*CHROME ONLY + STAINLESS STEEL

MODEL: 7864 Faucet / 401802 Stainless Steel Sink


Lot# PV-47	Date: August 11, 2021	Room: Mud Room	
Signature:	<i>I</i>		
Signature:) Sig		



RM6X6

Shower Door Handle

+Hinges

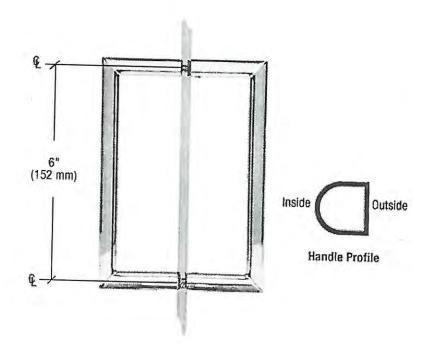

RM6X6 Shower Door Handle	CHROME (CH)
6" RM Series Flat Outside Surface / Round Tubing Inside Back-to- Back Pull Handle	BRASS (BR) + Hinges BRUSHED NICKEL (BN)

Lot# PV- 47	Date: August 11, 2021	Room: Master Ensuite	
Signature:	T. 10		
Signature:	Dug.		



LP6X6

Shower Door Handle





LP6X6 Shower Door Handle

10" Overall back-to-back 6" hole spacing 3/4" dia. tube (Also available single sided)


CHROME			
	MATTE BLACK		

Lot# PV - 47	Date: August 11, 2021	Room: Ensuite 3, Ensuite 4
Signature:) [
Signature:) \$4	

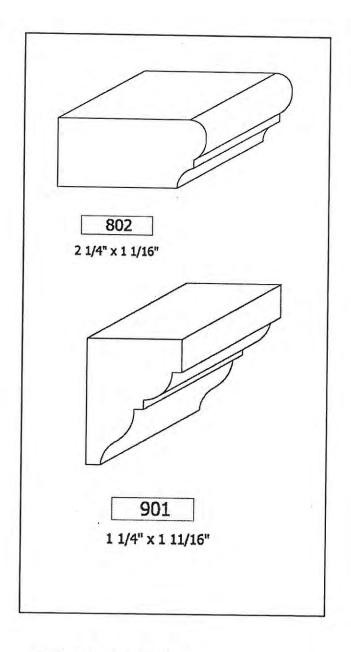

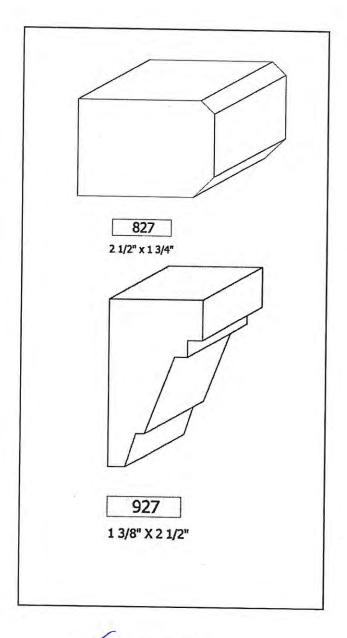


802 + 901 PACKAGE

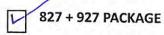


Lot# PV-47	Date: August 11, 2021	ROOM: THRU OUT	
Signature:			
Signature:	They's		

BATHROOM ACCESSORIES



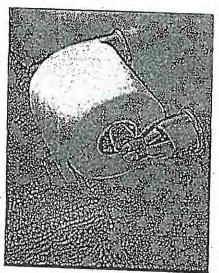

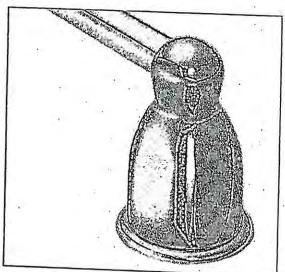

Tissue Holder Mason - Chrome

Towel Bar Mason - Chrome

Please select one of the following:

INSTALL STANDARD BATHROOM ACCESSORIES THRU OUT (tissue holder + towel bar) *location as per vendors discretion*


DO NOT INSTALL STANDARD BATHROOM ACCESSORIES
THRU OUT *tissue holder + towel bar will not be provided*

LOT # PV-47 DATE: Avgust 11, 2021

SIGNATURE: SIGNATURE:



Range Hood - Aspen Modern

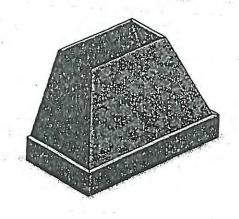

Lot# PV-47	
Room: kitchen	Signature:
Date: Aug. 11, 2021	Signature:



Project: Pine Vally

Lot: 47

Purchaser(s): Gholam Hossin Rizai & Mahrokh Rizai

Standard Hood Fan Deletion

We acknowledge that the builder's standard hood fan will not be installed. Do not supply, install and/or credit. We will install our own hood fan after closing.

Signature:

Signature:

ate: August 11, 2021

(FROUT BOOK) COUT to SOZE)

(MARMOREA POLISHED

(PORT LAWRENT! LEAVE CENTER with(2) 30×40" TILES * MAKE UP SIZE AT BOCKEROR "BETTEZIA WHITE" TV-47 August 11 22 CUSTOM PLACE THE



MOEN - ALIGN

Two-Handle Adjustable Widespread Lav Faucet with Lift Rod Drain



CHROME
BRUSHED NICKEL (BN)
BRUSHED GOLD (BG) x 2.
MATTE BLACK (BL)
MODEL: T6193 / 69000
Lot# Date: Room: MASTER FARMITE
Signature:
Signature:



MOEN - ALIGN

Single Freestanding Tub Filler





MOEN - MODERN

Pot Filler



CHROME	
STAINLESS (SRS)	
POLISHED NICKEL (NL)	y
MATTE BLACK (BL)	4,
BRUSHED GOLD (BG)	
MODEL: S665 Pot Filler	
Lot# 47 Date: Aprill4, 2001 Room: Kitchen	
Signature:	
Signature:	и



MOEN - ALIGN

Posi-Temp SHOWER ONLY* with 3 Function Transfer Valve/Trim and Slide Bar with Hand shower



From CEILING

*BRUSHED GOLD(BG)

MODEL: 6345 / 226651 / 3887EP / U361CI / UT4191

LOT #: 47	DATE:	April 14,20	LOCATION: Master Ensuite
SIGNATURE:			
SIGNATURE:			

SCHEDULE'F'



PV-47 April 14, 2021

PV-47 MR/GR

August 11,2021

The Knightswood 50' SERIES


Elevation A • 4,445 sq.ft. 4,475 sq.ft. Opt. Elevator / 4,575 sq.ft. Opt. Service Stairs

4,475 sq.ft. Opt. Elevator / 4,575 sq.ft. Opt. Service Stairs

Elevation C • 4,525 sq.ft. 4,560 sq.ft. Opt. Elevator / 4,660 sq.ft. Opt. Service Stairs

LEGEND


S=SPEAKER R/I (APPROX.96" A.F.F.)

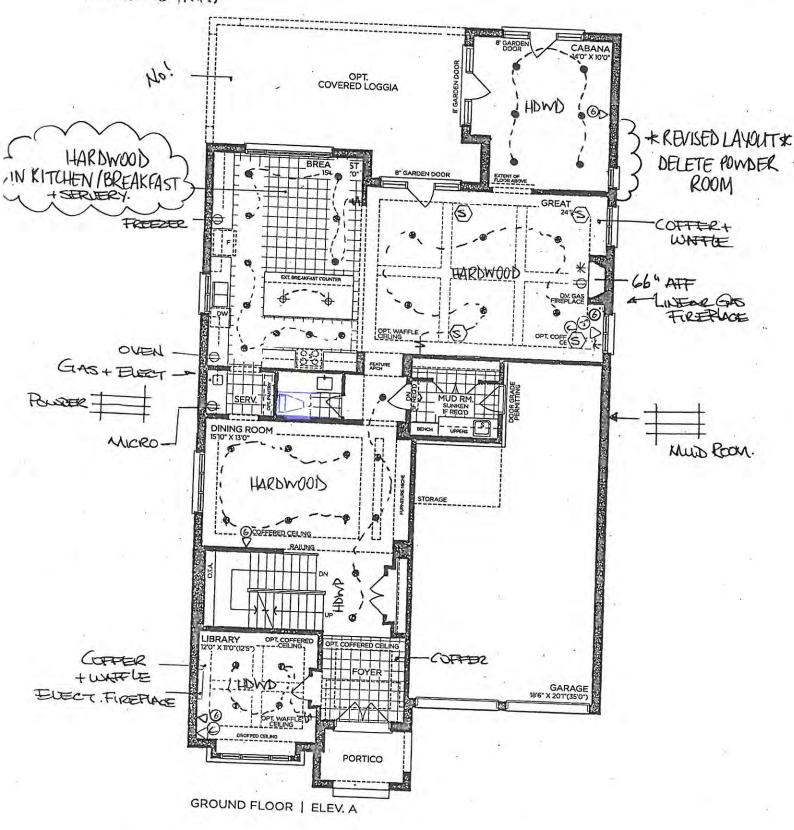

VENDOR PURCHASER PURCHASER

GOLDPARK

Prices, figures, illustrations, sizes, features and finishes are notice. Areas and dimensions are approximate and actual usable floor space may vary from the stated area. Layout may be reverse of the unit purchased. E. & O.E. 5005

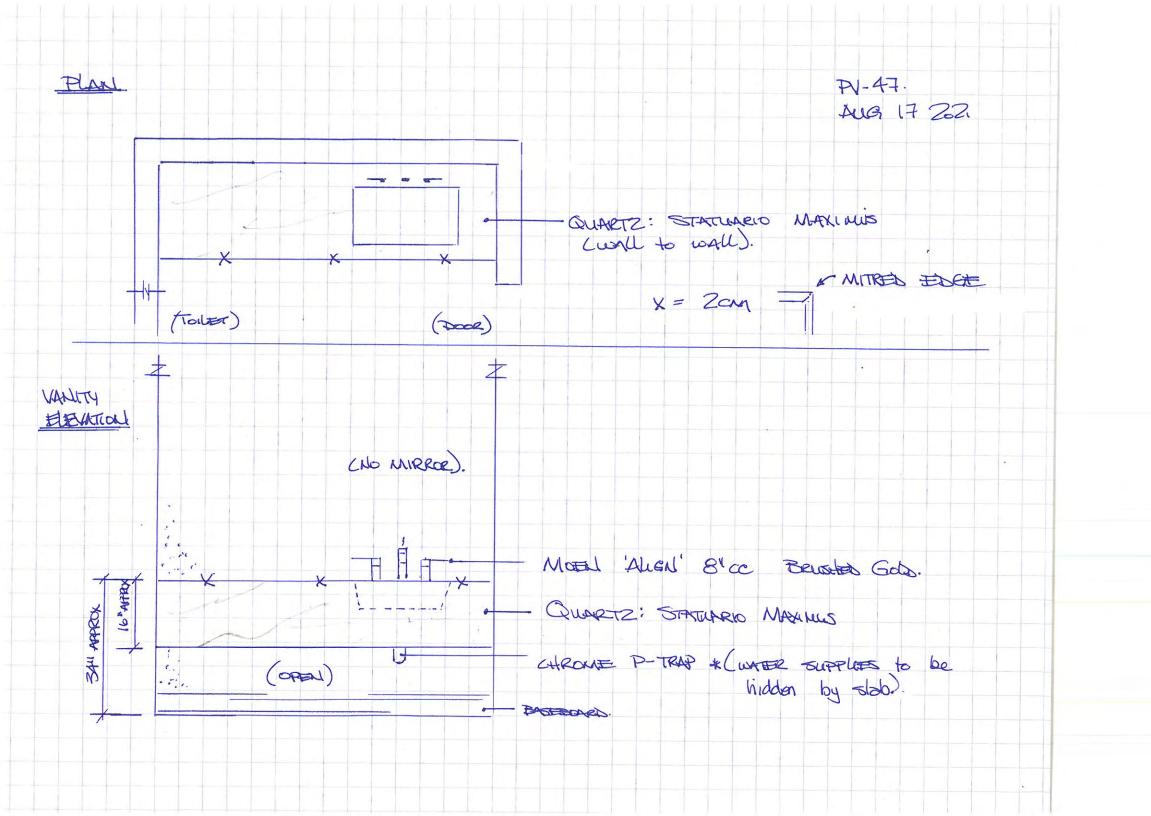

LAUNDRY

WD200CV 29" LG SideKick™ Pedestal Washer 7V-47 Aug 2021



* Redestal for Dryer = Empty Drawer.

KEY FEATURES

1.1 cu. ft. Capacity w/ NeveRust™ Stainless Steel Drum Compatible with select 29" Front Load Washers Direct Drive Motor with 10-Year Limited Warranty Magnetic Remote Control Perfect for Intimates, Hand Wash, Whites, Delicates,



PRODUCT FEATURES

Active Wear and more

	1
APPEARANCE	
Design Look	
Electronic Control Panel with	LED Display
Touch Buttons	and professional and a second a
WASH PROGRAMS	
3 Motion Technology	
No. of Programs	
Wash Programs	Normal, Intimates, Hand Wash, Active Wear, Rinse + Spin, Tub Clean
No. of Options	tions viality active vieal, Rinse + Spin, Iub Clean
Options	We-may 6 a
No. of Wash/Rinse Temps	Warm Water, Extra Rinse 2 (Warm, Cold)
CONVENIENCE FEATURES	2 (warn, Loa)
End of Cycle Signal	
Child Lock	•
Auto Suds Removal	•
Forced Drain System	•
Leveling Legs	4 Adjustable Legs
SmartDiagnosis™	4 volustable regs
Remote Control	
MOTOR AND AGITATOR	
Matar Type	Direct Drive Mator
Motor Speed	Variable
Max RPM	variable

NeveRust™ Stainless Steel Drum	
Cabinet	PC
Control Panel	
Top Plate	Plas
Door Rim	Paint
Door Cover	Glass/Chron
Available Colours	Dark Black Tinted Square Cov
	Graphite Steel (
POWER SOURCE	
Ratings	
Electrical Requirements	UL Liste
Туре	120V, 5 Amp
	Electri
DIMENSIONS	
Product (WxHxD)	29" x 14 1/8" x 30 7/8" (50 9/16 with drawer open
Carton (WxHxD)	30 7/8" x 16 13/16" x 33 1/16
Weight (Product/Carton)	105 lbs / 115 lb
	103 105 / 113 10
LIMITED WARRANTY	
	1 Year Parts and Labour, 10 Years Motor, 5 Years on Drum
UPC CODES	
WD200CV Sidekick™ Pedestal Was	her (Graphite Steel) 772454 064753



LG ELECTRONICS CANADA INC.
20 Norelco Drive, North York, Ontario M9L 2X6
Tel: 647-253-6300 | LG.com
Customer Service & Parts
1-888-542-2623

*Pedestal for

*Pedestal for wisher Aug 25, 2021

*Pedestal for Dryer = Empty Drawer-

8/20/2021

SUMMARY

CAPACITY

1.1 cu.ft.

DIMENSIONS (WXHXD)

29" x 13.6" x 29.4"

STEAM TECHNOLOGY

No

THINQ®

No

SPECIFICATIONS

Dimendions (W x H x D)

29" x 13.6" x 29.4"

Colour

Graphite Steel

Weight (Product/Carton)

56.7 lbs/65.5 lbs

UPC CODE

WDP5V

048231012904

LAUNDRY

WD200CV

29" LG SideKick™ Pedestal Washer

* reclastal for unitar

* Redestal for Dryer = Empty Drawer.

GR

MR

KEY FEATURES

1.1 cu. ft. Capacity w/ NeveRust™ Stainless Steel Drum Compatible with select 29" Front Load Washers Direct Drive Motor with 10-Year Limited Warranty Magnetic Remote Control Perfect for Intimates, Hand Wash, Whites, Delicates,



PRODUCT FEATURES

CAPACITY

Active Wear and more

Capacity	1.1 cu.ft.
APPEARANCE	
Design Look	
Electronic Control Panel with LEC	Front Control
Touch Buttons	o uspay .
WASH PROGRAMS	
3 Motion Technology	
No. of Programs	•
	Moomal Internation Manadally 6
Na. of Options	Normal, Intimates, Hand Wash, Active Wear, Rinse + Spin, Tub Clean
Options	2
No. of Wash/Rimse Temps	Warm Water, Extra Rinse
10.70	2 (Warm, Cold)
CONVENIENCE FEATURES	
End of Cycle Signal	
Child Lock	•
Auto Suás Removal	
Forced Drain System	
eveling Legs	•
SmartDiagnosis**	4 Adjustable Logs
Remote Control	•
MOTOR AND AGITATOR	
dotor Type	Mission 2
Actor Speed	Direct Drive Mater
1. 00.1	Variable

NeveRust™ Stainless Steel Drum	
Cabinet	
Control Panel	PCM
Top Plate	Plastic
Door Rim	Painted
Door Cover	Glats/Chrome
Available Colours	Dark Black Tinted Square Cover
	Graphice Steet (V)
POWER SOURCE	
Ratings	
Electrical Requirements	UL Usted
Туре	120V, 5 Amps
	Electric
DIMENSIONS	
Product (Wid-IxD)	29" x 14 1/8" x 30 7/8" (50 9/16 with drawer open)
Carton (WxHxD)	
Weight (Product/Carton)	30 7/8" x 16 13/16" x 33 1/16"
To act of the contract of	105 lbs / 115 lbs
UMITED WARRANTY	
	1 Year Parts and Labour, 10 Years Motor, 5 Years on Drum
UPC CODES	
WD200CV Sidekick Pedestal Was	ner (Graphite Stret) 772454 064753



LG ELECTRONICS CANADA INC.
20 Noreico Drive, North York, Ontario M9L 2X6
Tek 647-253-6300 | LG.com
Custamer Service & Parts
1-888-542-2623

8/20/2021

* Pedestal for where Aug 25, 2021

* Pedestal for Dryer = Empty Drawer.

SUMMARY

CAPACITY

1.1 cu.ft.

DIMENSIONS (WXHXD)

29" x 13.6" x 29.4"

STEAM TECHNOLOGY

No

THINQ®

No

SPECIFICATIONS

Dimendions (W x H x D)

29" x 13.6" x 29.4"

Colour

Graphite Steel

Weight (Product/Carton)

56.7 lbs/65.5 lbs

UPC CODE

WDP5V

048231012904



NOIR™ 36" GAS RANGETOP



Signature Features

14 RANGETOP CONFIGURATIONS

Bend fire to your will. Grills, griddles, brass burners. Three widths. With 14 unique configurations, it's up to you. Cast off porous, superficially plated options. Go deeper. Infused with chrome, our griddle cleans up well after heavy usage. Underneath, a serpentine element powers our best griddle preheat. Fire up the grill for indoor entertainment on your terms.

CAST IRON GRATES

Robust geometric grates form one graceful surface, crafted to withstand heavy woks and cookware.

9,000 BTU DUAL-STACKED POWERBURNER

A dual-stacked PowerBurner that reaches a maximum power level of 9,000 BTU and fulfills most everyday cooking functions with turndown of 1,000 BTU.

Technical Specifications

HALO-EFFECT KNOBS

A halo of luminary LEDs glows softly when the burner is lit or the oven is on.

20,000 BTU STACKED POWERBURNER

This luxury rangetop's powerful burner delivers exceptionally high heat for cooking methods such as flash frying and wok cooking.

ELECTRONIC IGNITION WITH FLAME-SENSING™ REIGNITION

Burnout banned. If a sudden draft blows out a flame, intelligent Flame-Sensing™ reignition automatically sparks it back to life,

DUAL-STACKED POWERBURNERS

Two stacked, symmetrical flames bloom and retreat at your inclination, offering total control over heat levels. High-heat searing and wok cooking, Low, slow simmer and melt. Infinite intermediate settings satisfy every appetite.

18,000 BTU DUAL-STACKED POWERBURNER

This 18,000 BTU dual-stacked PowerBurner can handle highpowered cooking while still being gentle enough for delicate simmering with turndown of 1,650 BTU.

JGCP436HM



Dimensions

Depth: 27-1/2 in

Height: 7-7/16 in

Maximum Height: 11-15/16 in

Net Weight: 104 lbs

Width: 35-3/4 in

Controls

Knob Color: Stainless Steel

Infinite Heat Controls: No

Knob Type: Metal

Location of Controls: Front

Electrica

Power Cord Included: Yes

208V Compatible: No

Design Type

Design Expression: NOIR™

Configuration and Overview

Size: 36 in

Cooktop Type: Rangetop

Fuel Type: Gas

LP Convertible: Yes - Kit Included

Installs Over Built-In Oven: No

Power Boost: No

Cooktop Details

Automatic Pan Detection: No

Downdraft Vent: No

Heating Element On Indicator Light: No

Cooktop Details

Number of Cooking Element-Burners: 6

Number of Grates: 3

Grate Details:

- Dishwasher Safe
 Matte Finish
- Porcelain Coated Cast Grates
- Porceiain Co
 Continuous

Right Front Element-Burner Type: Dual

Appearance

Digital Display: No

Certifications

Prop 65: Standard

Hot Surface Indicator Light: No
Left Front Element-Burner Power; 20,000 BTU
Cooktop Element Style: Sealed Burner
Cooktop Surface Color: Black
Ignition Type: Flame-Sensing™ Re-ignition

UL: Yes
Features
Power Outage Compatible: Yes (Gas Cooktop Burners Only)


Details

Cooktop Surface Material: Porcelain Coated Steel

 $^{\mbox{\scriptsize (B)}/\mbox{\scriptsize TM}}$ © 2021 JennAir. All rights reserved, Specifications subject to change without notice,

7V-47 Augz5, 2021


36" (91.4 cm) models

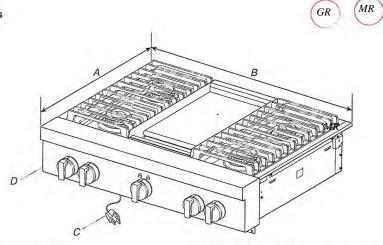

A. 27¹/s" (68.9 cm) B. 35³/₄" (90.8 cm)

- C. 3 prong grounding-type power supply cord D. Model/serial/rating plate (located on the underside of the cooktop burner base)


Side View of Cooktop

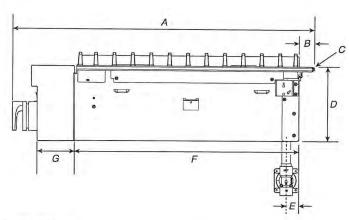

- A. 27⁹/s" (69.5 cm) B. 1¹/s" (3.2 cm) C. Island trim or optional backguard D. 7⁷/1s" (18.8 cm)

- E. Gas inlet is located 1⁷/s* (4.8 cm) from the back of the cooktop burner base and 4⁷/s* (12.4 cm) in from left-hand side of the cooktop burner base. F. 22* (55.9 cm) G. 3⁵/s* (8.4 cm)

Gas and Electric Connection Locations

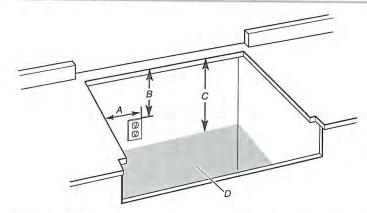


- Grounded 3 prong outlet should be located on left-hand side of the cutout 16" (40.6 cm) max. from enclosure sidewall
- B. 10" (25.4 cm) min. clearance from countertop to top of the outlet
- C. 14" (35.6 cm) countertop to the gas supply line
 G. 35 Supply line should be located in this area on rear or side walls or the supply line can come up through the floor.

NOTE: Solid side and bottom of cutout enclosure

Cabinet Requirements

IMPORTANT: If installing a range hood or microwave hood combination above the cooking surface, follow the range hood or microwave hood combination installation instructions for dimensional clearances above the cooktop surface.

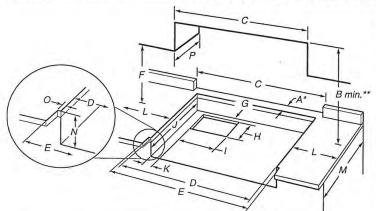

- A. See chart.
- B. See chart.
- C. See chart.
- D. See chart.
- E. See chart.
- 18" (45.7 cm) min. clearance upper cabinet to countertop
- G. 3/4" (19 mm) back of cabinet cutout to gas opening cutout
- H. $6^{7/8}$ " (16.1 cm) gas opening cutout depth I. $12^{1/2}$ " (31.7 cm) gas opening cutout width
- 1. 12¹² (51.7 cm) gas opening cutout warn
 1. 22¹/₁" (56.5 cm) cabinet cutout depth
 K. 2" (5.1 cm) cabinet side to gas cutout
 L. 6" (15.2 cm) min. distance on both sides of the cooktop to the side wall or other combustible material above cooking surface
- M. 24" (61.0 cm) cabinet depth
- N. 71/4" (18.4 cm) cabinet depth to countertop
- O. Notch to be equal on both sides
- P. 13" (33.0 cm) upper cabinet depth

Size	A*	B**	С	D	E
	Cooktop Cutout to Back Wall	Cooktop to Cabinet	Optional Backguard and Upper Cabinet Opening	Cabinet and Countertop	Countertop Only
30" (76.2 cm)	1 ³ / ₄ " (4.4 cm)*	42" (106.7 cm)	30" (76.2 cm)	29 ¹ / ₄ " (74.3 cm)	29 ⁷ / ₈ " (75.9 cm) for zero clearance
36" (91.4 cm)	13/4" (4.4 cm)*	58" (147.3 cm)	36" (91,4 cm)	351/4" (89.5 cm)	35 ³ / ₄ " (90.8 cm) for zero clearance
48" (121.9 cm)	1 ³ / ₄ " (4.4 cm)*	58" (147.3 cm)	48" (121.9 cm)	47 ¹ / ₄ " (120.0 cm)	477/8" (121.6 cm) for zero clearance

^{*}NOTE: If back wall is constructed of a combustible material and a backguard is not installed, a minimum clearance of dimension A + 6" (15.2 cm) is required for all models.

NOTE: Due to manufacturing factory tolerances, these are nominal dimensions. You may need to readjust to meet your clearance.

^{**} NOTES: Dimension "B" can be reduced by 6" (15.2 cm) when bottom of wood or metal cabinet is covered by not less than 0.25" (6.4 mm) flame retardant millboard covered with not less than No. 28 MSG sheet metal, 0.015" (0.4 mm) stainless steel, 0.024" (0.6 mm) aluminum, or 0.020" (0.5 mm) copper.

If installing a range hood above the cooktop, follow the range hood instructions for dimensional clearances above the cooktop surface.





NOIR™ 30" DOUBLE WALL OVEN WITH V2™ VERTICAL **DUAL-FAN CONVECTION SYSTEM**

Signature Features

IRRESISTIBLE INTERIOR

Captivation cloaked in black. Beyond a dark glass expanse, cinematic lighting illuminates smooth racks, flat tines, and an enticing jet black interior.

SEAMLESS TOUCHES

Seamlessly designed. Concealed details melt into their stainless steel surround, as dark interiors and glass expanses pull you in.

SMOOTH CLOSE DOOR

Quiet, soft, secure. Your oven gently pulls the door closed.

7-INCH FULL COLOR LCD DISPLAY

Visually vibrant. This highlyinteractive, full-color display is packed with dynamic features that allow you to navigate effortlessly through settings and the JennAir® Culinary Center

GLIDE RACK

Smooth moves. Glides in and out fluidly and quietly, even when fully loaded.

5.0 CU. FT. CAPACITY

Big on entertaining, Generous capacity to cook multiple dishes at once

CINEMATIC LIGHTING

Lights, camera, cook. Halogen lighting increases to full intensity, minimizing shadows and dramatically showcasing

CHEF'S LIGHT

Food shown in its best light. This third halogen lamp shines above the door, front and center, further reducing shadows for clear illumination.

V2™ VERTICAL DUAL-FAN CONVECTION

Dual counter-rotating vertical fans work in tandem, helping you wield your cooking prowess with everything from mouthwatering fillets to irresistible roasts.

JJW3830IM



Dimensions

Capacity: 10.00

Depth Closed Excluding Handles: 24-5/16 in

Depth Closed Including Handles: 26-3/8 in

Depth Excluding Doors: 23.0 in

Depth With Door Open 90 Degree: 45-7/16 in

Depth: 23-1/4 in

Height: 52-3/8 in

Net Weight: 327 lbs

Width: 30.0 in

Electrical

Power Cord Included: No

Watts: 9200 Controls

Electronic Display Type: Full Color LCD

Design Type

Design Expression: NOIR™

Technical Specifications

Configuration and Overview

Size: 30 in

Fuel Type: Electric

Installable Under Cooktop: No

LP Convertible: No

Oven Type: Double

Oven Details

Door Lock: Yes

Oven Selections:

- · Audible Signal
- Automatic Door Latch
 Bake

Power On Indicator Light: Yes

Language Conversion: English/French

Automatic Shut-Off: Yes

Door Broil Position: Closed

Oven Cooking System: Convection

Oven Details

Upper Oven Interior Width: 25.0 in

Number of Lower Oven Racks: 3

Number of Upper Oven Racks: 3

Number of Lower Rack Guides: 6

Number of Upper Rack Guides: 6

Hidden Bake Element: Yes

Convection Functions: Bake Broil Roast Both

Number of Bake Elements: 1

Number of Broil Elements: 1

Appearance

Handle Material: Stainless Steel

Flush Installation Approved: Yes

Certifications


Prop 65: Standard

Interior Color: Black
Lower Oven Number of Oven Lights: 3
Upper Oven Number of Oven Lights: 3
Interior Coating: Porcelain
Light Control: Oven Light Touch Pad
Light Type: Halogen
Broller Location: Top of Oven
Self-Cleaning Oven Racks: No
Delay Clean: Yes
Lower Oven Interior Depth: 19.0 in
Lower Oven Interior Height: 18.0 in
Upper Oven Interior Depth: 19.0 in
Upper Oven Interior Depth: 19.0 in

Convection Element Type: Dual-Fan

 $^{\mbox{\scriptsize (B)/TM}}$ @ 2021 JennAir. All rights reserved. Specifications subject to change without notice,

DOUBLE WALL OVENS JJW2827I - 27" x 52-3/8" x 25-5/16" JJW2830I, JJW3830I - 30" x 52-3/8" x 25-5/16"

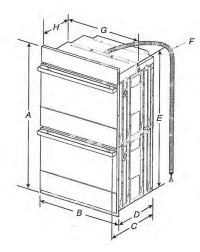


PRODUCT DIMENSIONS - DOUBLE OVENS

27" (68.6 CM) MODELS

- A. 52-3/8" (133 cm) overall height
- B. 27" (68.6 cm) overall width
- C. JJW2827IM 26-3/8" (67 cm) JJW2827IL – 27-3/16" (69 cm)
- D. 23-1/4" (59.1 cm) max. recessed depth
- E. 49-1/4" (125.1cm) recessed height
- F. 66" (167.6 cm) flexible conduit length measured from the conduit clamp located at the rear of the oven. Do not remove the conduit clamp.
- G. 25-7/16" (64.6 cm) recessed width

30" (76.2 CM) MODELS

- A. 52-3/8" (133 cm) overall height
- B. 30" (76.2 cm) overall width
- C. JJW2830IM 26-3/8" (67 cm) JJW2830IL – 27-3/16" (69 cm) JJW3830IM – 26-3/8" (67 cm) JJW3830IL – 27-3/16" (69 cm)
- D. 23-1/4" (59.1 cm) max. recessed depth
- E. 49-1/4" (125.1cm)
- F. 66" (167.6 cm) flexible conduit length measured from the conduit clamp located at the rear of the oven. Do not remove the conduit clamp.
- G. 28-7/16" (72.2 cm) recessed width

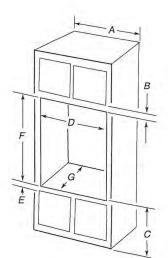

DOUBLE OVENS INSTALLED IN CABINET

27" (68.6 CM) MODELS

- A. 27" (68.6 cm) min. cabinet width
- B. 2-3/16" (5.5 cm) top of cutout to bottom of upper cabinet door
- C. 14-3/4" (37.5 cm) bottom of cutout to floor is recommended. 4"–19'/4" (10.2–48.9 cm) bottom of cutout to floor is acceptable.
- D. 25-1/2" (64.8 cm) cutout width
- E. 1-1/2" (3.8 cm) min. bottom of cutout to top of cabinet door
- F. 50-1/4" (127.6 cm)" recommended cutout height
- G. 24" (60.7 cm) cutout depth

*NOTE: The cutout height can be between 49-1/2 (125.7 cm) and 52-3/16" (132.6 cm) for 27" double ovens.

30" (76.2 CM) MODELS

- A. 30" (76.2 cm) min. cabinet width
- B. 2-3/16" (5.5 cm) top of cutout to bottom of upper cabinet door
- C. 14-3/4" (37.5 cm) bottom of cutout to floor is recommended.
 4"-14-3/4" (10.2-37.5 cm) bottom of cutout to floor is acceptable.
- D. 28-1/2" (72.4 cm) cutout width
- E. 1-1/2" (3.8 cm) min. bottom of cutout to top of cabinet door
- F. 50-1/4" (127.6 cm)* recommended cutout height
- G. 24" (60.7 cm) cutout depth

*NOTE: The cutout height can be between 49-1/2" (125.7 cm) and 52-3/16" (132.6 cm) for 30" double ovens.

IMPORTANT: Dimensional specifications are provided for planning purposes only.

Do not make any cutouts based on this information. Refer to the Installation or Use & Care Guide before selecting cabinetry, verifying electrical/gas connections, making cutouts or beginning installation. All JennAir* appliances are appropriately UL, CUL or CSA approved.



MR

JENNAIR® DETAILED PLANNING DIMENSIONS

DOUBLE WALL OVENS JJW2827I - 27" x 52-3/8" x 25-5/16" JJW28301, JJW38301 - 30" x 52-3/8" x 25-5/16"

ELECTRICAL REQUIREMENTS

If codes permit and a separate ground wire is used, it is recommended that a qualified electrical installer determine that the ground path and the wire gauge are in accordance with local codes.

Check with a qualified electrical installer if you are not sure the oven is properly grounded.

This oven must be connected to a grounded metal, permanent wiring system.

Be sure that the electrical connection and wire size are adequate and in conformance with the National Electrical Code, ANSI/NFPA 70-latest edition or CSA Standards C22.1-94, Canadian Electrical Code, Part 1 and C22.2 No. O-M91-latest edition, and all local codes and ordinances.


A copy of the above code standards can be obtained from:

National Fire Protection Association 1 Batterymarch Park Quincy, MA 02169-7471 CSA International 8501 East Pleasant Valley Road Cleveland, OH 44131-5575

ELECTRICAL CONNECTION

To properly install your oven, you must determine the type of electrical connection you will be using and follow the instructions provided for it here.

Oven must be connected to the proper electrical voltage and frequency as specified on the model/serial/rating plate. The model/serial/rating plate is located under the control panel on the upper oven cavity on double ovens. See the following illustration.

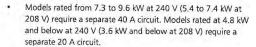

- A circuit breaker is recommended.
- Connect directly to the circuit breaker box (or fused disconnect) through flexible, armored, or nonmetallic sheathed, copper cable (with grounding wire).
- Flexible conduit from the oven should be connected directly to the junction box.
- Fuse both sides of the line.
- Do not cut the conduit. The length of conduit provided is for serviceability of the oven.
- A UL listed or CSA approved conduit connector must be provided.
- If the house has aluminum wiring, follow the procedure below: Connect the aluminum wiring using special connectors and/or tools designed and UL listed for joining copper to aluminum. Follow the electrical connector manufacturer's recommended procedure. Aluminum/copper connection must conform with local codes and industry accepted wiring practices.

For power requirements for models JJW2827I, JJW2830I and JJW3830I, refer to the following table.

	240 VAC	208 VAC	
Model	kW	kW	
JJW28271	8.7	6.5	
JJW28301	8.7	6.5	
JJW3830I	9.2	6.9	



Double Oven A. Model/Serial/Rating Plate

IMPORTANT: Dimensional specifications are provided for planning purposes only. Do not make any cutouts based on this information. Refer to the Installation or Use & Care Guide before selecting cabinetry, verifying electrical/gas connections, making cutouts or beginning installation. All JennAir* appliances are appropriately UL, CUL or CSA approved.







NOIR $^{\text{TM}}$ 30" UNDER COUNTER MICROWAVE OVEN WITH DRAWER DESIGN

Signature Features

1.2 CUBIC FOOT CAPACITY

Explore your options. There's room for whatever you're craving.

MULTI-STAGE PROGRAMMING

Control at will. Combine up to four power levels and keep your meal warm until you're ready to dine.

MENU-DRIVEN LCD DISPLAY

Visceral interactions ahead. An intuitive LCD display responds to your desires with settings and performance catered to your taste.

STEALTH FLUSH INSTALL

Flush-to-cabinet design creates a subtly striking, unbroken line across the kitchen. The microwave drawer merges discreetly into undercounter cabinetry—a bold move for open kitchen designs, islands and creative explorations.

SENSOR REHEAT

Detecting humidity released by food, an intuitive sensor programs the appropriate remaining reheat time.

950-WATT MICROWAVE ELEMENT

This luxury under counter microwave offers 950 watts of power, along with exceptional cooking and heat performance.

ONE TOUCH ACCESS

With zero handles, a flat-front design provides limitless integration and opens at your touch.

DIVERGENT DRAWER DESIGN

Surrender to open and creative configurations with discreet integration that fits anywhere you can dream up.

EMOTIVE CONTROLS

Striking, intuitive and easy to clean. Inviting controls wait expectantly for the lightest touch to unleash performance.

JMDFS30HM



Dimensions

Capacity: 0-14/25
Depth: 26-3/16 in
Height: 15.0 in
Net Weight: 79 lbs
Width: 30.0 in

Technical Specifications

Configuration and Overview	Details		
Size: 23 in	Clock: Yes		
Microwave Type: Drawer	One Touch Cooking: Yes		
Microwave Details	Night Light: No		
Interior Depth: 16-9/16	Features		
Interior Height: 7-313/2500	Number of Sensor Control Keypads: 3		
Interior Width: 17-5/16	Fan Speed Indicator: No		
Sensor Cooking: Yes	Certifications		
Cooking Power: 950 w	Draw CE. Chandrad		
Cavity Finish: Powder Coat	Prop 65: Standard		
Convection: No	UL: Yes		
Grill: No	Compatibility		
Interior Light: Incandescent	Connectivity: No		
Turntable: NA	Works With: No		
Scrolling Electronic Display: Yes	Configuration		

Number of Keypads: 28

Number of Quick Touch/One-Touch Selections: 4

Convenience Cooking Controls: Yes

Number of Convenience Control Pads: 6

Location of Controls: Right

Electrical

Controls

Watts: 400 Design Type

Design Expression: NOIR™

https://www.jennair.com/printpage_JMDFS30HM.html			

®/™ © 2021 JennAir. All rights reserved. Specifications subject to change without notice.

Number of Power Levels: 11


JENNAIR® DIMENSIONS

MICROWAVE DRAWERS

PRODUCT



	24" STAINLESS STEEL JMDFS24GS	24" NOIR™ JMDFS24HM	30" RISE™ JMDFS30HL	30" NOIR™ JMDFS30HM
Overall Width (A)	23-7/8" (60.6 cm)	23-7/8" (60.6 cm)	29-15/16" (76 cm)	29-15/16" (76 cm)
Control Panel Height (B)	3" (7.6 cm)	3" (7.6 cm)	3" (7.6 cm)	3" (7.6 cm)
Drawer Height (C)	12-3/4" (32.4 cm)	12-11/16" (32.3 cm)	12-3/4" (32.4 cm)	12-11/16" (32.3 cm)
Control Panel to Drawer Space (D)	1/4" (0.6 cm)	1/4" (0.6 cm)	1/4" (0.6 cm)	1/4" (0.6 cm)
Overall Height (E)	16" (40.6 cm)	16" (40.6 cm)	16" (40.6 cm)	16" (40.6 cm)

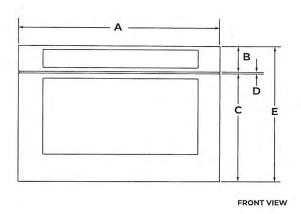

JENNAIR® DIMENSIONS


PV-47 Aug 25,2021





MICROWAVE DRAWERS
PRODUCT

	24" STAINLESS STEEL JMDFS24GS	24" NOIR™ JMDFS24HM	30" RISE™ JMDFS30HL	30" NOIR™ JMDFS30HM
Recessed Width (F)	21-5/8" (54.9 cm)	21-5/8" (54.9 cm)	21-5/8" (54.9 cm)	21-5/8" (54.9 cm)
Conduit Channel Width (G)	4-11/16" (11.9 cm)	4-11/16" (11.9 cm)	4-11/16" (11.9 cm)	4-11/16" (11.9 cm)
Depth without Drawer (H)	21-7/8" (55.6 cm)	21-7/8" (55.6 cm)	21-7/8" (55.6 cm)	21-7/8" (55.6 cm)
Depth with Drawer (I)	23-1/2" (59.7 cm)	23-11/16" (60.1 cm)	23-9/16" (58.9 cm)	23-11/16" (60.1 cm)

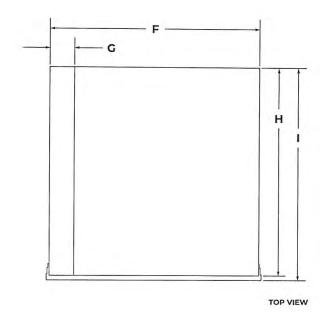

PY-47


JENNAIR® DIMENSIONS

MICROWAVE DRAWERS

PRODUCT



	24" STAINLESS STEEL JMDFS24GS	24" NOIR™ JMDFS24HM	30" RISE™ JMDFS30HL	30" NOIR™ JMDFS30HM
Recessed Height (J)	14-5/8" (37.1 cm)	14-5/8" (37.1 cm)	14-5/8" (37.1 cm)	14-5/8" (37.1 cm)
Drawer Open Depth (K) (Flush Receptacle)	38-5/16" (97.3 cm)	38-1/2" (97.8 cm)	38-3/8" (97.4 cm)	38-1/2" (97.8 cm)
Drawer Open Depth (K) (Non-flush Receptacle)	42-13/16" (108.7 cm)	43" (109.2 cm)	42-13/16" (108.8 cm)	43" (109.2 cm)
Depth with Drawer (L) (Flush Receptacle)	23-5/16" (59.2 cm)	23-1/2" (59.7 cm)	23-3/8" (59.3 cm)	23-1/2" (59.7 cm)
Depth with Drawer (L) (Non-flush Receptacle)	27-13/16" (70.6 cm)	28" (71.1 cm)	27-13/16" (70.7 cm)	28" (71.1 cm)
Depth without Drawer (M) (Flush Receptacle)	21-7/8" (55.6 cm)	21-7/8" (55.6 cm)	21-7/8" (55.6 cm)	21-7/8" (55.6 cm)
Depth without Drawer (M) (Non-flush Receptacle)	26-3/8" (67 cm)	26-3/8" (67 cm)	26-3/8" (67 cm)	26-3/8" (67 cm)
Conduit Channel Length (N)	4" (10.2 cm)	4" (10.2 cm)	4" (10.2 cm)	4" (10.2 cm)
Conduit Channel Height (O)	1-3/4" (4.4 cm)	1-3/4" (4.4 cm)	1-3/4" (4.4 cm)	1-3/4" (4.4 cm)

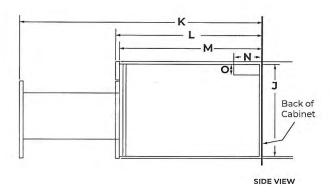


JENNAIR® DIMENSIONS

MICROWAVE DRAWERS

FLUSH OPENING AND CLEARANCE

	30" RISETM JMDFS30HL	30" NOIR™ JMDFS30HM	
Cutout Width (A)	30-1/4"-30-9/16" (76.8-77.6 cm) min.	30-1/4"-30-9/16" (76.8-77.6 cm) min.	
Width Between Side Cleats (B)	28-7/16" (72.2 cm)	28-7/16" (72.2 cm)	
Cutout Height (C)	17" (43.2 cm)	17" (43.2 cm)	
Platform to Top of Cutout Height (D)	16-1/8" (41 cm) min.	16-1/8" (41 cm) min.	
Cutout Top to Oven or Countertop Bottom (E)	2" (5.1 cm)	2" (5.1 cm)	
Cabinet Bottom to Cabinet Door Top (F)	2" (5.1 cm)	2" (5.1 cm)	



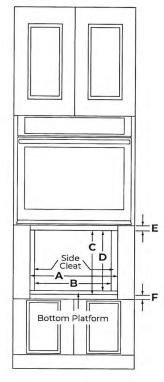

FRONT VIEW


JENNAIR® DIMENSIONS

MICROWAVE DRAWERS

FLUSH OPENING AND CLEARANCE

4	30" RISE™ JMDFS30HL	30" NOIR™ JMDFS30HM
Side Cleat Depth (G)	1/8" (0.39 cm)	1/8" (0.39 cm)
Microwave Back to Cabinet Back Depth (H)	3-1/2" (8.9 cm)	3-1/2" (8.9 cm)
Cabinet Face to Front of Platform Depth (I)	1-15/16" (4.9 cm)	2-1/16" (5.3 cm)
Cutout Depth (3) (Flush Receptacle)	23-9/16" (59.8 cm) min.	23-11/16" (60.2 cm) min.
Cutout Depth (J) (Non-flush Receptacle)	28-1/16" (71.2 cm)	28-3/16" (71.6 cm)



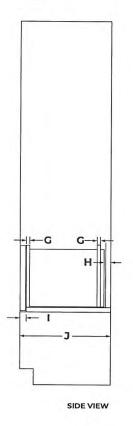

JENNAIR® DIMENSIONS


MICROWAVE DRAWERS

ELECTRICAL REQUIREMENTS




ELECTRIC REQUIREMENTS CHECKLIST 120 volt, 60 Hz, AC only, 15- or 20-amp fused, grounded circuit is required. A time-delay fuse or dedicated circuit is recommended. Do not use an extension cord.

RECOMMENDED ELECTRICAL ZONE

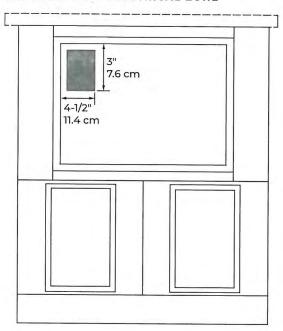

POWER SUPPLY LOCATION

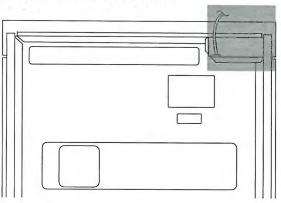

BACK VIEW

FRONT VIEW

? IF YOU HAVE QUESTIONS ABOUT YOUR ELECTRICAL SUPPLY, CALL A LICENSED, QUALIFIED ELECTRICIAN.





30" BUILT-IN REFRIGERATOR COLUMN (RIGHT-HAND DOOR SWING)

Signature Features

OVER 250 CONFIGURATIONS

Freezer or refrigerator, Lefthand or right-hand swing. One, two, three columns in a row. Four different widths, With 12 one-unit options, 75 two-unit combinations and over 250 three-unit combinations, configuration is where bespoke begins.

ECLIPTIC LIGHTING

Live beyond the shadow. Abandoning the dark spots cast by dated puck lighting, over 650 LEDs frame and fill your column, coming alive at a touch of the controls. Each zone awakens and pulses as you mold your column to your desires.

EMOTIVE CONTROLS

At waist-level, this panel invites touch, challenging the idea that controls should be out of sight and out of reach. Control every zone and choose presets to coax out the flavors of your produce, meat, beverages, spirits and beyond—and dominate your domain according to your desires.

TRINITY COOLING

Revel in the trinity of food preservation: three zones, three precision sensors, calibrated every second, Fortified by an exposed air tower, you can conquer humidity levels and customize the temperature of each zone to your deepest desires.

DARING OBSIDIAN INTERIOR

Inspired by the beauty of volcanic glass, this industry-exclusive dark finish rupts with reflective, high-contrast style. Reject the unfeeling, lifeless vessel of harsh steel. Let fine foods and beverages emerge from the interior of your columns like vibrant art, begging to be devoured.

HUSHED ACOUSTICS

Unheard of. We're decibel for decibel one of the quietest leading luxury built-in columns out there. Casting off abrupt start and stop cycles, our columns ditch swings in temperature and humidity, running unobtrusively in the background. Brilliance doesn't have to announce itself, it just is:

REMOTE ACCESS

Open door. Power outages. Filter changes. Connect to WiFi for real-time notifications and control your columns from anywhere. Tap and swipe on both iOS and Android devices. ¹
Appliance must be set to remote enable. WiFi & app required. Features subject to change. For details and privacy statement, visit jennair.com/connect.

SOLID GLASS AND METAL

All-metal bin and shelf frames. Thick, naturally odor-resistant solid glass. A forcefield at the edge that prevents spillovers. To hell with cheap plastic in luxury door bins, shelves and lines.

SHAPESHIFTER DRAWERS (REFRIGERATOR)

From craft beer to the farmer's market. Whether you're marinating a steak or storing a charcuterie tray, every drawer has presets to meet your desires.

JBRFR30IGX



Dimensions

Refrigerator Volume: 17.00 cu. ft.

Capacity: 17.00

Total Volume: 17.0 cu, ft.

Cabinet Width: 30.0 in

Depth Closed Excluding Handles: 24-1/2 in

Depth Closed Including Handles: 27-1/8 in

Depth Excluding Doors: 23-11/16 in

Depth With Door Open 90 Degree: 56-3/8 in

Depth: 24-1/2 in

Height To Top Of Cabinet: 84.0 in

Height: 79-7/8 in

Net Weight: 502 lbs

Technical Specifications

Configuration and Overview Refrigerator Details Advance Foam Insulation: 99.9% lower Global Lighting: Strip and Tower LED Lighting Warming Potential and Better Energy Performance Dispenser Details Counter Depth: Yes Dispenser Type: Interior Water Only Number of Doors: 1 Installation Option: Built-In Dispenser Options: Filtered Water Certifications Appearance Prop 65: Standard Hidden Hinge: Yes Energy Star® Qualified: ENERGY STAR® Certified Handle Material: Metal

Door Style: Flat	UL: Yes	Width: 29-3/4 in
Reversible Door: No	Exterior	Controls
Cabinet Finish: Smooth	Use the Toron Devole Through the state	
Filter Details	Handle Type: Reach Through Handle	Control Lockout: Yes
Maria Pha Lata de Bara A	Compatibility	Door Ajar/Open Alarm: Yes
Water Filter Indicator/Reset: Yes	Connectivity:	Location of Controls: Interior Up Front
Produce Preserver: Yes	ios ios	
Refrigerator Details		Automatic Defrost: Yes
Number of Interior Shelves: 3	Works With: • WiFi	Design Type
Pantry Drawer: No	App Remote Access	Design Expression: Panel-Ready
Deli Drawer: 1 Flexi-Slide Bin	Description	
Supplementary Containers: Herb Tender™ Container	Type of Refrigerator: Column Refrigerator	-

 $^{\mbox{\scriptsize (B)}}{}^{\mbox{\scriptsize TM}}$ © 2021 JennAir. All rights reserved. Specifications subject to change without notice.

JENN-AIR® DETAILED PLANNING DIMENSIONS


GR MR

1 of 3


30" COLUMN REFRIGERATOR

(BASE UNIT REQUIRES SUITE-COORDINATING PANEL KIT OR CUSTOM PANELS AND HANDLES) JBRFR30IGX, JBRFL30IGX – 29%" x 83%6" x 234%6" (without door/handles)

PRODUCT DIMENSIONS

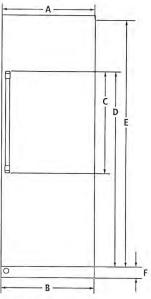

FRONT VIEW

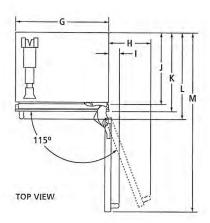

MODEL #			JBRFR30IGX JBRFL30IGX	
		in	cm	
Α	Width of door	293/4	75.6	
В	Overall width	291/8	75.9	
	Height of door handle Pro-Style® Stainless	4535/64	115.7	
C	Euro-Style Stainless	501/64	127.1	
	Custom panel (3/4"/1.9 cm)*	**	**	
D	Height to top of door handle Pro-Style® Stainless	661/64	167.7	
D	Euro-Style Stainless	6817/64	173.4	
	Custom panel (¾"/1.9 cm)*	**	**	
E	Height of door	791/8	202.9	
F	Height of bottom grille	335/64	9.0	
G	Width of recessed refrigerator	29%	75.1	
н	Width from side of refrigerator to handle – door fully open 115° Pro-Style® Stainless	1511/16	39.9	
	Euro-Style Stainless	1515/64	38.7	
	Custom panel (¾"/1.9 cm)*	**	**	
1	Width from side of refrigerator to handle – door open 90° Pro-Style® Stainless	41/32	10.2	
	Custom panel (¾"/1,9 cm)*	**	**	
J	Depth without door panel kit	2343/64	60.1	
ĸ	Depth with door Pro-Style® Stainless	241/2	62.2	
	Euro-Style Stainless	241/2	62.2	
	Custom panel (¾"/1.9 cm)*	241/2	62.2	
L	Depth with handle Pro-Style® Stainless	271/s	68.9	
L	Euro-Style Stainless	2617/32	67.4	
	Custom panel (¾"/1.9 cm)*	**	**	
M	Depth with door open 90°	563/8	143.2	

^{*}Custom panels should not exceed ¾" (1.9 cm) thickness.




^{**}For custom panel models, this depends on handle chosen.

2 of 3

30" COLUMN REFRIGERATOR

(BASE UNIT REQUIRES SUITE-COORDINATING PANEL KIT OR CUSTOM PANELS AND HANDLES) JBRFR30IGX, JBRFL30IGX – 29%" x 83%6" x 234%6" (without door/handles)

DIMENSIONS AS INSTALLED

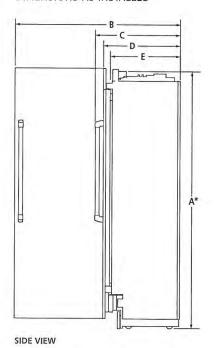

MODEL #		JBRFR30IGX JBRFL30IGX	
		in	cm
A*	Height of recessed refrigerator	8319/64	211.6
В	Depth with door open 90° (min.)	563/8	143.2
	Depth with handle (min.) Pro-Style® Stainless	271/8	68.9
C	Euro-Style Stainless	2617/32	67.4
-	Custom panel (¾"/1.9 cm)**	1	f
	Depth with door (min.) Pro-Style® Stainless	241/2	62.2
D	Euro-Style Stainless	241/2	62.2
	Custom panel (3/4"/1.9 cm)**	241/2	62.2
E	Depth without door panel kit (min.)	2343/64	60.1

^{*}Add 1" (2.5 cm) to the height dimension when leveling legs are fully extended



extended.
**Custom panels should not exceed ¾" (1.9 cm) thickness.

[†]For custom panel models, this depends on handle chosen.


JENN-AIR® DETAILED PLANNING DIMENSIONS

3 of 3


30" COLUMN REFRIGERATOR

(BASE UNIT REQUIRES SUITE-COORDINATING PANEL KIT OR CUSTOM PANELS AND HANDLES)
JBRFR30IGX, JBRFL30IGX – 29%" x 837/6" x 2343/64" (without door/handles)

OPENING/CLEARANCE DIMENSIONS

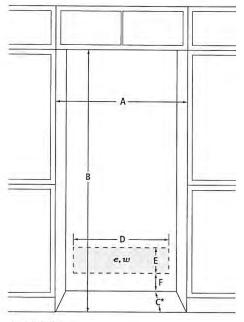

FRONT VIEW

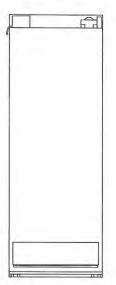

MODEL #			R30IGX L30IGX
		in	cm
A	Width (min.)	30	76.2
В	Height (min.)	84	213.4
C*	Depth (min.)	25	63.5
D	Width of recommended electrical location	26	66.0
E	Height of recommended electrical location	61/2	16.5
F	Height to recommended electrical location	41/2	11.4
e	Recommended electrical connection location		
w	Recommended water connection location		

^{*}A minimum 8" (20.3 cm) furniture return must extend behind the face of the cabinet on all sides.

ELECTRICAL REQUIREMENTS

115 volt, 60 Hz, AC only, 15- or 20-amp fused, grounded circuit is required. A dedicated circuit is recommended. Use an outlet that cannot be turned off by a switch. Do not use an extension cord.

WATER PRESSURE REQUIREMENTS

A cold water supply with water pressure between 40 and 120 psi (207 and 827 kPa) is required to operate the ice maker. Call a licensed, qualified plumber with any questions about the water pressure.

Reverse Osmosis Water Supply

A reverse osmosis system may be used provided that the water pressure from the filtration system meets the required water pressure requirements.

Jenn-Air* Columns feature an auto-bypass water filtration system. To use your product with a reverse osmosis water filtration system, simply remove the water filter from the product.

LOCATION REQUIREMENTS

Floor must be able to support the product's total weight of more than 600 lb (272 kg), including the door panels and contents of the product. Flooring under product must be at the same level as the room, Face of cabinetry must be plumb.

BACK VIEW

IMPORTANT: Dimensional specifications are provided for planning purposes only.

Do not make any cutouts based on this information. Refer to the Installation or Use & Care Guide before selecting cabinetry, verifying electrical/gas connections, making cutouts or beginning installation. All Jenn-Air* appliances are appropriately UL, CUL or CSA approved.



9003AdZw817





30" BUILT-IN FREEZER COLUMN (LEFT-HAND DOOR SWING)

Signature Features

OVER 250 CONFIGURATIONS

Freezer or refrigerator, Lefthand or right-hand swing. One, two, three columns in a row. Four different widths. With 12 one-unit options, 75 two-unit combinations and over 250 three-unit combinations, configuration is where bespoke begins.

ECLIPTIC LIGHTING

Live beyond the shadow. Abandoning the dark spots cast by dated puck lighting, over 650 LEDs frame and fill your column, coming alive at a touch of the controls, Each zone awakens and pulses as you mold your column to your desires.

EMOTIVE CONTROLS

At waist-level, this panel invites touch, challenging the idea that controls should be out of sight and out of reach. Control every zone and choose presets to coax out the flavors of your produce, meat, beverages, spirits and beyond—and dominate your domain according to your desires.

Technical Specifications

DIVINITY FREEZING

One provocative air tower. Two precision sensors. Calibrated every second. United, they keep freezer temperatures from swinging and spirits impeccably chilled.

DARING OBSIDIAN INTERIOR

Inspired by the beauty of volcanic glass, this industry-exclusive dark finish rupts with reflective, high-contrast style. Reject the unfeeling, lifeless vessel of harsh steel. Let fine foods and beverages emerge from the interior of your columns like vibrant art, begging to be devoured.

HUSHED ACOUSTICS

Unheard of. We're decibel for decibel one of the quietest leading luxury built-in columns out there. Casting off abrupt start and stop cycles, our columns ditch swings in temperature and humidity, running unobtrusively in the background. Brilliance doesn't have to announce itself, it just in

REMOTE ACCESS

Open door. Power outages. Filter changes. Connect to WiFi or real-time notifications and control your columns from anywhere. Tap and swipe on both IOS and Android devices. ¹
-sup>1
-sup>1
-sup>1
Appliance must be set to remote enable. WiFi & app required. Features subject to change. For details and privacy statement, visit jennair.com/connect.

SOLID GLASS AND METAL

All-metal bin and shelf frames. Thick, naturally odor-resistant solid glass. A forcefield at the edge that prevents spillovers. To hell with cheap plastic in luxury door bins, shelves and lines.

SHAPESHIFTER DRAWERS (FREEZER)

Devote a drawer to gelato, Or cookie dough. Or vodka, Use all of our presets to customize these drawers to ever-shifting indulgences.

JBZFL30IGX



Dimensions

Freezer Volume: 17.00 cu. ft.

Capacity: 17.00

Total Volume: 17.0 cu. ft.

Cabinet Width: 30.0 in

Depth Closed Excluding Handles: 24-1/2 in

Depth Closed Including Handles: 27-1/8 in

Depth Excluding Doors: 23-11/16 in

Depth With Door Open 90 Degree: 56-3/8 in

Depth: 27-1/8 in

Height To Top Of Cabinet: 84.0 in

Height: 84.0 in

Net Weight: 502 lbs

Configuration and Overview

Advance Foam Insulation: 99.9% lower Global Warming Potential and Better Energy Performance

Counter Depth: Yes

Number of Doors: 1

Installation Option: Built-In

Appearance

Hidden Hinge: Yes

Handle Material: Metal

Door Style: Flat

Certifications

Prop 65: Standard

Energy Star® Qualified: ENERGY STAR® Certified

UL: Yes

Exterior

Handle Type: Reach Through Handle

Freezer Compartment

Shelves: 3 Adjustable Full-Width Glass

Light: LED

Reversible Door: No	Compatibility	Width: 29-3/4 in
Cabinet Finish: Smooth	Connectivity:	Controls
Filter Details	• ios	Control to the Ave
Water Filter Indicator/Reset: Yes	iOS Works With:	Control Lockout: Yes
Produce Preserver: No	• WiFi	Door Ajar/Open Alarm: Yes
Freezer Details	AppRemote Access	Location of Controls: Interior Up Front
Freezer Number of Shelves: 3	Description	Automatic Defrost: Yes
Dispenser Details	Type of Refrigerator: Column Freezer	Design Type
Types of Ice: Cubed	Icemaker	Design Expression: Panel-Ready
Icemaker Details	cemaker: Factory Installed	
Icemaker Location: Freezer		

 $^{\mbox{\scriptsize (B)}/\mbox{\scriptsize TM}}$ © 2021 JennAir. All rights reserved. Specifications subject to change without notice.






1 of 3

JENN-AIR® DETAILED PLANNING DIMENSIONS


30" COLUMN FREEZER

(BASE UNIT REQUIRES SUITE-COORDINATING PANEL KIT OR CUSTOM PANELS AND HANDLES)
JBZFR30IGX, JBZFL30IGX – 297%" x 837/6" x 234%4" (without door/handles)

PRODUCT DIMENSIONS

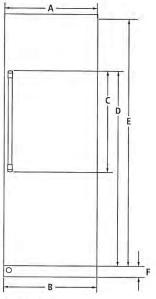

FRONT VIEW

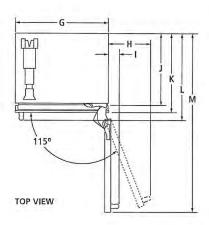

MODEL #		JBZFR30IGX JBZFL30IGX	
		in	cm
Α	Width of door	293/4	75.6
В	Overall width	291/8	75,9
	Height of door handle Pro-Style® Stainless	4535/64	115.7
C	Euro-Style Stainless	501/64	127.1
	Custom panel (3/4"/1.9 cm)*	**	**
	Height to top of door handle Pro-Style® Stainless	661/64	167.7
D	Euro-Style Stainless	6817/64	173.4
	Custom panel (3/4"/1.9 cm)*	**	**
E	Height of door	791/8	202.9
F	Height of bottom grille	335/64	9
G	Width of recessed freezer	29%	75.1
н	Width from side of freezer to handle – door fully open 115° Pro-Style® Stainless	1511/16	39.9
	Euro-Style Stainless	1515/64	38.7
	Custom panel (3/4"/1.9 cm)*	**	**
1	Width from side of freezer to handle – door open 90° Pro-Style* Stainless	41/32	10.2
	Euro-Style Stainless	37/16	8.7
	Custom panel (3/4"/1.9 cm)*	**	**
J	Depth without door panel kit	2343/64	60.1
	Depth with door Pro-Style® Stainless	241/2	62.2
K	Euro-Style Stainless	241/2	62.2
	Custom panel (¾"/1.9 cm)*	241/2	62.2
	Depth with handle Pro-Style® Stainless	271/s	68.9
L	Euro-Style Stainless	2617/32	67.4
	Custom panel (¾"/1.9 cm)*	**	**
M	Depth with door open 90°	563/8	143.2

^{*}Custom panels should not exceed ¾" (1.9 cm) thickness.



^{**}For custom panel models, this depends on handle chosen.


JENN-AIR® DETAILED PLANNING DIMENSIONS

2 of 3

30" COLUMN FREEZER

(BASE UNIT REQUIRES SUITE-COORDINATING PANEL KIT OR CUSTOM PANELS AND HANDLES) JBZFR30IGX, JBZFL30IGX – 29% x 83% x 23% (without door/handles)

DIMENSIONS AS INSTALLED

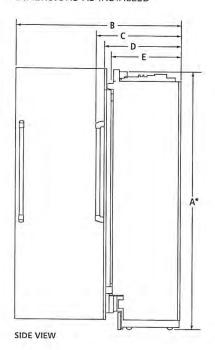

MODEL#		JBZFR30IGX JBZFL30IGX	
		in	cm
Α*	Height of recessed freezer	8319/64	211.6
В	Depth with door open 90° (min.)	56¾	143.2
	Depth with handle (min.) Pro-Style® Stainless	271/8	68.9
С	Euro-Style Stainless	2617/32	67.4
	Custom panel (¾"/1.9 cm)**	+	+
	Depth with door (min.) Pro-Style* Stainless	241/2	62.2
D	Euro-Style Stainless	241/2	62.2
	Custom panel (¾"/1.9 cm)**	241/2	62.2
E	Depth without door panel kit (min.)	2343/64	60.1

^{*}Add 1" (2.5 cm) to the height dimension when leveling legs are fully extended.



^{**}Custom panels should not exceed ¾" (1.9 cm) thickness.

[†]For custom panel models, this depends on handle chosen.





3 of 3


JENN-AIR® DETAILED PLANNING DIMENSIONS

30" COLUMN FREEZER


(BASE UNIT REQUIRES SUITE-COORDINATING PANEL KIT OR CUSTOM PANELS AND HANDLES)

JBZFR30IGX, JBZFL30IGX – 29%" x 837/6" x 234%4" (without door/handles)

OPENING/CLEARANCE DIMENSIONS

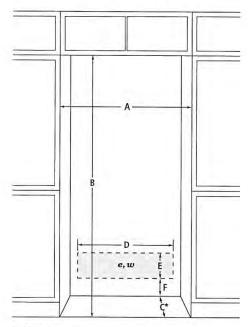

FRONT VIEW

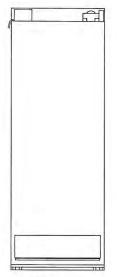

MODEL #		JBZFR30IGX JBZFL30IGX	
	2 - 1	in	cm
Α	Width (min.)	30	76.2
В	Height (min.)	84	213.4
C*	Depth (min.)	25	63.5
D	Width of recommended electrical location	26	66.0
E	Height of recommended electrical location	61/2	16.5
F	Height to recommended electrical location	41/2	11.4
e	Recommended electrical connection location		
w	Recommended water connection location		

^{*}A minimum 8" (20.3 cm) furniture return must extend behind the face of the cabinet on all sides.

ELECTRICAL REQUIREMENTS

115 volt, 60 Hz, AC only, 15- or 20-amp fused, grounded circuit is required. A dedicated circuit is recommended. Use an outlet that cannot be turned off by a switch. Do not use an extension cord.

WATER PRESSURE REQUIREMENTS

A cold water supply with water pressure between 40 and 120 psi (207 and 827 kPa) is required to operate the ice maker. Call a licensed, qualified plumber with any questions about the water pressure.

Reverse Osmosis Water Supply

A reverse osmosis system may be used provided that the water pressure from the filtration system meets the required water pressure requirements.

Jenn-Air* Columns feature an auto-bypass water filtration system. To use your product with a reverse osmosis water filtration system, simply remove the water filter from the product.

LOCATION REQUIREMENTS


Floor must be able to support the product's total weight of more than 600 lb (272 kg), including the door panels and contents of the product. Flooring under product must be at the same level as the room. Face of cabinetry must be plumb.

BACK VIEW

IMPORTANT: Dimensional specifications are provided for planning purposes only.

Do not make any cutouts based on this information. Refer to the Installation or Use & Care Guide before selecting cabinetry, verifying electrical/gas connections, making cutouts or beginning installation. All Jenn-Air* appliances are appropriately UL, CUL or CSA approved.



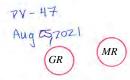



PANEL-READY 24" BUILT-IN TRIFECTA™ DISHWASHER, 38DBA

Signature Features

38 DBA TRANQUILITY¹ SYSTEM

Listen to the hush. At 38 dBA. JennAir is the quietest luxury dishwasher brand²*, all without sacrificing performance.

sup>2 Based on Normal Cycle. </sup>
^{1 Based on normal cycle.}

DARING OBSIDIAN RACKS

A JennAir® signature, this dramatic, industry-exclusive black finish is inspired by the beauty of volcanic glassshowcasing clean dishes in striking contrast.

SUPERIORGLIDE UPPER RACK

Strong and stable. The upper rack glides smoothly and quietly, even when fully loaded. Each rail features 52 ball bearings for quiet operation.

Technical Specifications

ULTRAGLIDE LOWER RACK

Strong and stable. This adjustable lower rack glides smoothly on high-end rails.

CINEMATIC LIGHTING

Shine a spotlight on clean. LED theater lighting ramps up to full intensity to chase away shadows and illuminate the daring Obsidian racks.

FOLD-AWAY™ TINES

Hinged tines allow space reconfiguration to handle uncommon cookware on special occasions or adapt to the every day.

TRIFECTA™ WASH SYSTEM

No need to choose between brilliant cleaning, energy efficiency or quiet operation because our dishwashers deliver all three. Three-stage filtration, pressurized wash arms and alternating wash action in two zones work together to wash dishes with clean water.

REMOVABLE 3RD-LEVEL RACK

This removable, adjustable top-most third rack holds unwieldy spatulas, whisks and ladles, or can be used for overflow silverware.

FLEXIBLE CAPACITY

Lower Rack

Style: Extended

Utility Basket: No

Silverware Basket

Location: Bottom Rack

Culinary Basket: Yes

Covers: Yes

Third Level Rack

Adjustable: Yes

Removable: Yes

Energy Star® Qualified: ENERGY STAR® Certified

Certifications

Intimate affairs. Wild soirees. Enough capacity for a service of 14 means there's always room for one more.

JDTSS245GX



Dimensions

Depth Closed Excluding Handles: 24-1/2 in

Depth With Door Open 90 Degree: 49-1/2 in

Depth: 24-1/2 in

Height: 34-1/2 in

Maximum Height: 34-1/2 in

Minimum Height: 33-1/2 in

Width: 23-7/8 in

Number of Place Settings: 14

Controls

Automatic Temperature Controls: Yes

Last Cycle Recall: Yes

Sensor: Yes

Location of Controls:

Design Type

Design Expression: Panel-Ready

Door Style: Flat

Handle Material: Metal

Window: No

Details

True Hold Door: No

Dispenser: Detergent and Rinse Aid

Number of Wash Levels: 5.0

Rinse Aid Dispenser Level Indicator: Yes


Number of Racks: 3

Built-In Water Softener: No

Interior Light: No

Number of Washarms: 3	NSF® Certified: Yes
Tub Material: Stainless Steel	UL: Yes
Tub Style: Built-in Tall Tub 24**	Prop 65: Standard
Water Filtration: No	Exterior
Rack Material: Nylon Configuration and Overview	Handle Type: Towel Bar Compatibility
Decibel Level dBA: 38 Cycles and Options	Connectivity: No Works With: No
Number of Wash Cycles: 6 Lower Rack	Options Pichurahar Option Salastina
Cushion-Tip Tines: Yes Fold-Down Tines: 1 Row - 3 Position	Dishwasher Option Selections: • Zonal Wash • BottleWash Features
	Sound Package: Yes

®/™ © 2021 JennAir. All rights reserved. Specifications subject to change without notice.

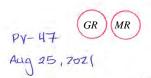


JENN-AIR® DETAILED PLANNING DIMENSIONS

1 of 3


DISHWASHERS

JDTSS246G, JDTSS244G – 231/4" x 331/2" x 2811/32" (including handle) JDTSS245G, JDTSS243G - 231/2" x 331/2" x 24" (not including handle)


PRODUCT DIMENSIONS

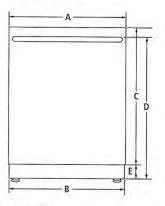

FRONT VIEW

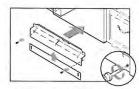

ADJUSTABLE TOE KICK

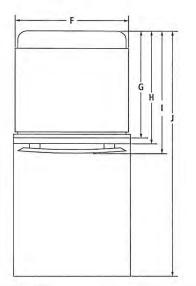

MODEL #		JDTSS246G JDTSS244G		JDTSS245G JDTSS243G	
		in	cm	in	cm
Α	Width of door	231/8	60.6	231/8	60.6
В	Width of toe kick	231/2	59.7	231/2	59.7
c	Height of door Pro-Style® Stainless	30	76.2	-	
	Euro-Style Stainless	30	76.2		_
	Custom panel (¾"/1.9 cm)	-	-120	30	76.2
D	Height to top of handle Pro-Style® Stainless	3117/32	80.1	_	
	Euro-Style Stainless	3117/32	80.1	-	
	Custom panel (¾"/1.9 cm)	6343	- 4	*	*
E	Height of adjustable toe kick (minmax.)	3½- 4¼	8.8- 10.6	3½- 4¼	8.8- 10.6
F	Width of recessed dishwasher	231/8	60.6	231/8	60.6
G	Depth with tub flange	21	53.3	21	53.3
н	Depth with door Pro-Style® Stainless	241/2	62.2	1	-
	Euro-Style Stainless	241/2	62.2	T	-
	Custom panel (¾"/1.9 cm)	-	_	24	60.0
	Depth with handle Pro-Style® Stainless	293/32	73.9	_	12
1	Euro-Style Stainless	2819/32	72.6	-	_
	Custom panel (¾"/1.9 cm)	_	-	*	*
J	Depth with door fully open	491/2	125.7	491/2	125.7

^{*}For custom panel models, this depends on handle chosen.

IMPORTANT: Dimensional specifications are provided for planning purposes only. Do not make any cutouts based on this information. Refer to the Installation or Use & Care Guide before selecting cabinetry, verifying electrical/gas connections, making cutouts or beginning installation. All Jenn-Air* appliances are appropriately UL, CUL or CSA approved.



9009AdZw317

MR


2 of 3

JENN-AIR® DETAILED PLANNING DIMENSIONS

DISHWASHERS

JDTSS246G, JDTSS244G - 23%" x 33½" x 2819/32" (including handle) JDTSS245G, JDTSS243G - 23%" x 33%" x 24" (not including handle)


DIMENSIONS AS INSTALLED

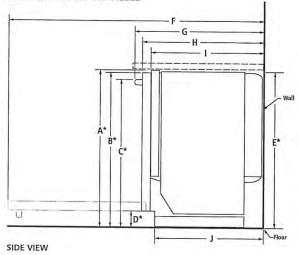

MODEL #		JDTSS246G JDTSS245G JDTSS244G JDTSS243G	
	7	in	cm
A*	Height to top of tub flange (min.)	331/2	85.1
B*	Height to top of door (min.)	33¾	85.7
-4	Height to top of handle (min.) Pro-Style® Stainless	3117/32	80.1
C*	Euro-Style Stainless	3117/32	80.1
	Custom panel (¾"/1.9 cm)	ti	t
D*	Height to bottom of door	35/8	9.4
E*	Height of recessed dishwasher (min.)	33%	85.5
F	Depth with door fully open (min.)	491/2	125.7
5	Depth with handle (min.) Pro-Style® Stainless	293/32	73.9
G	Euro-Style Stainless	2819/32	72.6
	Custom panel (¾"/1.9 cm)	t	T.
	Depth with door (min.) Pro-Style® Stainless	261/2	67.3
н	Euro-Style Stainless	261/2	67.3
	Custom panel (¾"/1.9 cm)	241/2	62.2
1	Depth with tub flange (min.)	225/8	57.4
J	Depth with toe kick (min.)	201/8	52.9

^{*}With wheels removed. Add up to 1" (2.5 cm) to height with wheels and leg levelers fully extended.

[†]For custom panel models, this depends on handle chosen.

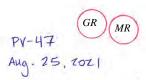


JENN-AIR® DETAILED PLANNING DIMENSIONS

3 of 3


DISHWASHERS


JDTSS246G, JDTSS244G – 23%" x 33½" x 28½" (including handle) JDTSS245G, JDTSS243G – 23%" x 33½" x 24½" (not including handle)

OPENING/CLEARANCE DIMENSIONS

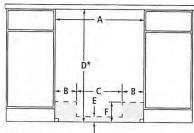

FRONT VIEW

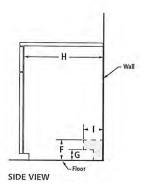

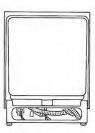

BACK VIEW

MODEL #		JDTSS246G JDTSS245G JDTSS244G JDTSS243G	
		in	cm
Α	Width (min.)	24	61.0
В	Width of possible utility installation area (back wall)	6¾	17.2
C	Width of clear area (back wall)	101/2	26.7
D*	Height with wheels removed (min.)	34	86.4
E	Height of possible utility installation area (back wall)	21/4	6.4
F	Height of possible utility installation area (back/side wall)	61/4	15.9
G	Height of clear area (side wall)	3	7.6
Н	Depth (min.)	24	61.0
1	Depth of utility location (side wall)	4	10.2
	rical, water and drain connections be installed in shaded areas		
Recommended drain connection location – closest to sink		1½ dia.	3.8 dia.
	mmended electrical connection location — -hand side or back wall	1½ dia.	3.8 dia.
Recommended water connection location –		½ dia.	1.3 dia.

^{*}Measured from the lowest point on the underside of countertop.

ELECTRICAL REQUIREMENTS

20-volt, 60 Hz, AC-only, 15- or 20-amp. fused electrical supply. Copper wire only. A time delay fuse or circuit breaker and separate circuit is recommended.

WATER SUPPLY REQUIREMENTS

120°F (49°C) hot water supply with water pressure between 20 and 120 psi (138 and 862 kPa) is required. If you have questions about your water pressure, call a licensed, qualified plumber.

DRAIN REQUIREMENTS

Connect drain hose to waste tee or disposer inlet above drain trap. Maximum drain hose length 12 $^{\circ}$ (3.7 m).

LOCATION REQUIREMENTS

Corner locations require a 2" (5.1 cm) minimum clearance between the side of the dishwasher door and the wall or cabinet.





WM9000HVA

6.0 cu.ft. MEGA Capacity w/ On-Door Control Panel & TurboWash®



MAKE LAUNDRY DAY ANYTHING BUT ROUTINE

Can inspiration be found in the laundry room? Look no further than LG's stunning new front load washer. Huge 6.0 cu. ft. Mega Capacity cleans a king-size comforter and a full set of bedding in one fell swoop. And, with the turbocharged power of LG TurboWash®, a normal load gets done up to 30 minutes faster. And, master multi-taskers take note: This LG washer is TWIN Wash System™ compatible, which means you can add the ingenious LG SideKick $^{\text{\tiny TM}}$ pedestal washer to tackle two loads of laundry—both large and small—all at the same time.

SPECIFICATIONS

- 29" Width
- 6.0 cu. ft. Ultra Capacity with NeveRust™ Stainless Steel Drum
- · Direct Drive Motor with 10-Year Limited Warranty
- 1,300 RPM
- 14 Washing Programs
- 5 Temperature Settings (All Cold Rinses)

STYLISH DESIGN

- On-Door Electronic Control Panel with Delay Wash (Up to 19 Hours) LED Display and Dial-A-Cycle™
 • Large Tinted Glass Door with
- On-Door Controls · Ergonomically Angled Drum & Door
- Extra Wide Door Opening
- Optional Matching Drawer Pedestal
- Optional Sidekick™ Pedestal Washer (WD200CV)

INNOVATIONS

- 2015 ENERGY STAR® Most Efficient
- CEE Tier 3
- CSA Sustainability
- TurboWash® 2.0 Technology
- LG Steam Technology
- ASC Qualified Allergiene™ Smart ThinQ™ (Wi-Fi)
- ColdWash™ Option • 6Motion™ Technology
- SmartDiagnosis™
 TrueBalance™ Anti-Vibration System
- LoDecibel™ Quiet Operation
- SenseClean™
- Easy Loading 10° TilTub™



















TurboWash® Technology
Soccer practice. Groceries. Dinner. Dishes. Shouldn't your laundry move as fast as you? Now it can, with LG's enhanced TurboWash® technology. Powerful high-pressure nozzles save up to 30 minutes per load* - without shortcutting cleaning performance, even on larger loads. Innovation that keeps up with your family calendar? That's not just laundry done fast - it's laundry at the speed of life.

6.0 cu.ft. MEGA CapacityTowers of towels, piles of sweatshirts, and a mountain of jeans? Go for it. The ultra large capacity (6.0 cu.ft.) tub lets you do more laundry in fewer loads. That's time saved and sore backs avoided.

Integrated Electronic Control Panel with Dual LED Display Electronic control panel is integrated into the door for a distict style plus the intuitive functionality you expect from an LG washer.

PRODUCT FEATURES

CAPACITY	MOTOR AND AGITATOR	
Capacity 6.0 cu. ft.	Motor Type	Inverter Direct Drive Motor
	Motor Speed	Variable
APPEARANCE	Max RPM	1,300
Design Look Front Control	Axis	Horizontal
On-Door Electronic Control Panel with LED Display .	MATERIAL CAMP CONTRACTOR	
Touch Buttons ,	MATERIALS AND FINISHES	
Dial-A-Cycle™ .	NeveRust™ Stainless Steel Drum Cabinet	
ENERGY	Control Panel	PCM
2015 ENERGY STAR® Most Efficient	Top Plate	Plastic
CEE Tier 3	Door Rim	Painted
77775	Door Cover	Glass/Chrome
WASH PROGRAMS		Dark Black Tinted Square Cover
No. of Programs 14	Door Opening	42 1/8"
Wash Programs Cotton/Normal, Perm. Press/Casual, Delicates, Speed Wash, TubClean™, Sanitary, Allergiene™, Heavy Duty, BrightWhites™, Towels, Rinse+Spin, Download, Jumbo Wash, Bedding	Available Colours POWER SOURCE	Graphite Steel (V)
No. of Options 12	Ratings	
Options Prewash, Delay Wash, Extra Rinse, Child Lock, ColdWash™, FreshCare™,	Electrical Requirements	UL Listed
Steam, TurboWash™, Custom Program, Drum Light, Smart Grid, Remote Start		120V, 10 Amps
No. of Wash/Rinse Temps 5 Extra Hot, Hot, Warm, Cold, Tap Cold (All Cold Rinses)	Туре	Electric
Spin Speeds Extra High (1,300 max.), High, Medium, Low, No Spin	OPTIONS	
No. of Water Levels Automatically adjusts to the size of load	Pedestal	WDP5V
No. of Soil Levels 5	Pedestal (WxHxD)	29" x 14 1/10" x 30 4/5"
	Sidekick™ Pedestal Washer	WD200CW, WD200CV
FABRIC CARE FEATURES	Sidekick™ Pedestal Washer (WxHxD)	29" x 14 1/10" x 30 4/5"
TurboWash® 2.0 Technology	¥	
Steam Technology .	DIMENSIONS	
Allergiene™ Cycle	Product (WxHxD)	29" x 41 1/4" x 33 3/4"
Sanitary Cycle .	Carton (WxHxD)	(55 15/16" W with door open)
ColdWash™ Option	Weight (Product/Carton)	31 5/16" x 44 19/64" x 35 5/8
SenseClean™ System .	weight (Froduct/Carton)	227.1 lbs / 233.7 lbs
	LIMITED WARRANTY	
CONVENIENCE FEATURES		abour, 10 Years Motor, 5 Year on Drum
TrueBalance™ Anti-Vibration System .		assa, is real structor, s real on brain
4 Tray Dispenser Prewash, Main Wash (with liquid detergent cup), Bleach, Fabric Softener	UPC CODES	
LoDecibel™ Quiet Operation .	WM9000HVA Washer (Graphite Steel)	772454 058837
End of Cycle Signal .	DLEX9000V Electric Dryer (Graphite Steel)	772454 058813
LoadSense .	DLGX9001V Gas Dryer (Graphite Steel)	772454 058820
Child Lock .	WDPSV Pedestal (Graphite Steel)	048231 012904
Auto Suds Removal .	WD200CV Sidekick™ Pedestal Washer (Graphite Steel)	772454 064753
Forced Drain System .	(a spine sally	772434 004733
Leveling Legs 4 Adjustable Legs		
SmartDiagnosis™ • (v 3.0)		
Smart ThinQ™ (Wi-Fi) Smart Adapt, Energy Monitoring, Laundry Starts		
NFC Tag On		



LG ELECTRONICS CANADA INC.

20 Norelco Drive, North York, Ontario M9L 2X6 Tel: 647-253-6300 | LG.com Customer Service & Parts 1-888-542-2623



DLEX9000V/DLGX9001V

9.0 cu.ft. MEGA Capacity TurboSteam™ Dryer w/ On-Door Control Panel

DREAM BIG, STEAM BIG.

When you picture your dream laundry room, this is the dryer that you'll want to be in it. Every contour, every elegant line creates a look like no other, with unexpected touches like an integrated control panel right on the door. The 9.0 cu. ft. Mega Capacity keeps up with even LG's biggest washers, load for load. But no dream is complete without the power of LG TurboSteam $\ensuremath{^{\text{TM}}}$ technology that lets you reduce wrinkles and odors and give favorite clothes new life in only 10 minutes.

SPECIFICATIONS

- 9.0 cu. ft. MEGA Capacity with NeveRust™ Stainless Steel Drum
- 14 Drying Programs
- · 5 Temperature Settings

STYLISH DESIGN

- Upfront Electronic Control Panel with Dual LED Display and Dial-A-Cycle™
- · Large Tinted Glass Door with On-Door Controls
- · Optional Matching Drawer Pedestal
- Reversible Door

INNOVATIONS

- TurboSteam™ Technology
- SteamFresh™ Cycle
- Sensor Dry System
- · Precise Temperature Control with Variable Heat Souce
- LoDecibel™ Quiet Operation
- Smart ThinQ™ (Wi-Fi)
- SmartDiagnosis™
- 3 Minute Installation Check
- FlowSense™ Duct Clogging Indicator
- · Wrinkle Care Option
- · Anti-Bacterial Cycle
- · Damp Dry Signal







PV-47 Aug 25,2021





9.0 cu.ft. MEGA Capacity
When it comes to laundry capacity, big is good, bigger is better, but
biggest is best. With 9.0 cu.ft. of mega capacity, now you can fit a king
size comforter and full set of bedding in a single load! You'll definitely have more room to dry.

TurboSteam™ Technology
LG TurboSteam™ technology to the rescue. Toss the shirt in the dryer, turn on the TurboSteam™ and in just 10 minutes your shirt is back in tip-top shape. Also helps refresh fabrics and reduce wrinkles in half the time of other steam settings.

Integrated Electronic Control Panel with Dual LED Display Electronic control panel is integrated into the door for a distict style plus the intuitive functionality you expect from an LG dryer.

PRODUCT FEATURES

apacity	9.0 cu. ft
PPEARANCE	
Design Look On-Door Front	Control Pane
ntelligent Electronic Controls with Dual LED Display	
ouch Buttons	
ial-A-Cycle™	
PRYER PROGRAMS	
lo. of Programs	14
lo. of Options	13
Options More Time, Less Time, Custom Program, PGM Save, Damp Dry Sign, Child Lock, Wi-Fi Connect, Drum Light, Energy Saver, TurboSteam, Smart Gri	al, Wrinkle Care, id, Remote Start
emperature Settings High, Medium High, Medium, L	ow, Ultra Low
rying Levels Very Dry, More Dry, Normal Dry, Less	Dry, Damp Dry
tanual Dry Times 60 min., 50 min., 40 min., 30 min., 20 min., More Ti	ime/Less Time
ONVENIENCE FEATURES oDecibel™ Quiet Operation nd of Cycle Signal rum Light eversible Door owSense™ Duct Clogging Indicator	
ONVENIENCE FEATURES oDecibel™ Quiet Operation nd of Cycle Signal rum Light eversible Door owSense™ Duct Clogging Indicator enting Option Electric: 4 Way Venting / Gas: 3	3 Way Venting
ONVENIENCE FEATURES oDecibel™ Quiet Operation nd of Cycle Signal rum Light eversible Door lowSense™ Duct Clogging Indicator enting Option Electric: 4 Way Venting / Gas: eveling Legs 4 Ai	
ONVENIENCE FEATURES oDecibel™ Quiet Operation nd of Cycle Signal rum Light eversible Door owSense™ Duct Clogging Indicator enting Option Electric: 4 Way Venting / Gas: 3	3 Way Venting
ONVENIENCE FEATURES oDecibel™ Quiet Operation nd of Cycle Signal rum Light eversible Door lowSense™ Duct Clogging Indicator enting Option Electric: 4 Way Venting / Gas: 3 eveling Legs emaining Time Display/Status Indicator(s)	3 Way Venting djustable Legs
ONVENIENCE FEATURES oDecibel™ Quiet Operation nd of Cycle Signal rum Light eversible Door lowSense™ Duct Clogging Indicator enting Option Electric: 4 Way Venting / Gas: eveling Legs 4 Au emaining Time Display/Status Indicator(s) Minute Installation Check mart Diagnosis™ mart ThinQ™ (Wi-Fi) Smart Grid Ready, Energ	3 Way Venting djustable Legs + (v 3.0) gy Monitoring,
ONVENIENCE FEATURES oDecibel™ Quiet Operation nd of Cycle Signal rum Light eversible Door lowSense™ Duct Clogging Indicator enting Option Electric: 4 Way Venting / Gas: eveling Legs 4 Au maining Time Display/Status Indicator(s) Minute Installation Check martDiagnosis™	3 Way Venting djustable Legs + (v 3.0) gy Monitoring,
ONVENIENCE FEATURES oDecibel™ Quiet Operation nd of Cycle Signal rum Light eversible Door owSense™ Duct Clogging Indicator enting Option Electric: 4 Way Venting / Gas: eveling Legs 4 Avenaining Time Display/Status Indicator(s) Minute Installation Check martDiagnosis™ mart ThinQ™ (Wi-Fi) Smart Grid Ready, Energ- Black Box, Remote Contr	3 Way Venting djustable Legs + (v 3.0) gy Monitoring,
ONVENIENCE FEATURES oDecibel™ Quiet Operation nd of Cycle Signal rum Light eversible Door lowSense™ Duct Clogging Indicator enting Option Electric: 4 Way Venting / Gas: eveling Legs 4 Au maining Time Display/Status Indicator(s) Minute Installation Check mart Diagnosis™ mart Thin(™ (Wi-Fi) Smart Grid Ready, Enere, Black Box, Remote Contr	3 Way Venting djustable Legs + (v 3.0) gy Monitoring,
ONVENIENCE FEATURES oDecibel™ Quiet Operation nd of Cycle Signal rum Light eversible Door lowSense™ Duct Clogging Indicator enting Option Electric: 4 Way Venting / Gas: eveling Legs 4 Au emaining Time Display/Status Indicator(s) Minute Installation Check mart Diagnosis™ mart ThinQ™ (Wi-Fi) Smart Grid Ready, Energ Black Box, Remote Contr IATERIALS AND FINISHES eveRust™ Stainless Steel Drum	3 Way Venting djustable Legs - (v 3.0) 39 Monitoring, ol, Home Chat
ONVENIENCE FEATURES oDecibel™ Quiet Operation nd of Cycle Signal rum Light eversible Door owSense™ Duct Clogging Indicator enting Option Electric: 4 Way Venting / Gas: eveling Legs 4 Av emaining Time Display/Status Indicator(s) Minute Installation Check martDiagnosis™ mart ThinQ™ (Wi-Fi) Smart Grid Ready, Energ Black Box, Remote Contri IATERIALS AND FINISHES eversust™ Stainless Steel Drum abinet	3 Way Venting djustable Legs • (v 3.0) gy Monitoring, gol, Home Chat
ONVENIENCE FEATURES oDecibel™ Quiet Operation nd of Cycle Signal rum Light eversible Door owSense™ Duct Clogging Indicator enting Option Electric: 4 Way Venting / Gas: eveling Legs 4 Au maining Time Display/Status Indicator(s) Minute Installation Check martDiagnosis™ mart ThinQ™ (Wi-Fi) Smart Grid Ready, Enere Black Box, Remote Contr ATERIALS AND FINISHES eveRust™ Stainless Steel Drum abinet ontrol Panel op Cover	3 Way Venting djustable Legs • (v 3.0) gy Monitoring, gol, Home Chat Painted Steel Plastic

POWER SOURCE	
Ratings	CSA Listed
Electrical Requirements	120V, 15 Amps (Gas) / 240V, 30 Amps (Electric)
Туре	Gas/Electric
BTU	20.000

WDP5V
29" x 13 9/10" x 29 2/5"
29" x 40 7/8" x 33 3/8" (56" with door open)
31 5/16" x 44 15/16" x 35 5/8"
157.4lbs / 182.1lbs
160.7lbs / 185.4lbs
1 Year Parts and Labour
772454 058813
772454058820
772454 058837
048231 012904
teel) 772454 064753



LG ELECTRONICS CANADA INC.

20 Norelco Drive, North York, Ontario M9L 2X6 Tel: 647-253-6300 | LG.com Customer Service & Parts 1-888-542-2623

PV-47 2021 Aug GR MR





* reclestal for washer & dryer - *

LAUNDRY

WD200CV

29" LG SideKick™ Pedestal Washer

KEY FEATURES

1.1 cu. ft. Capacity w/ NeveRust™ Stainless Steel Drum Compatible with select 29" Front Load Washers Direct Drive Motor with 10-Year Limited Warranty Magnetic Remote Control Perfect for Intimates, Hand Wash, Whites, Delicates,

Active Wear and more



PRODUCT FEATURES

CAPACITY	
Capacity	1.1 cu. ft.
APPEARANCE	
Design Look	Front Control
Electronic Control Panel with	
Touch Buttons	
WASH PROGRAMS	
3 Motion Technology	
No. of Programs	6
Wash Programs	Normal, Intimates, Hand Wash, Active Wear, Rinse + Spin, Tub Clean
No. of Options	2
Options	Warm Water, Extra Rinse
No. of Wash/Rinse Temps	2 (Warm, Cold)
CONVENIENCE FEATURES	
End of Cycle Signal	
Child Lock	
Auto Suds Removal	
Forced Drain System	
Leveling Legs 4 Adjustal	
SmartDiagnosis™	
Remote Control	
MOTOR AND AGITATOR	
Motor Type	Direct Drive Motor
Motor Speed	Variable

NeveRust™ Stainless Steel Drum	
Cabinet	PCM
Control Panel	Plastic
Top Plate	Painted
Door Rim	Glass/Chrome
Door Cover	Dark Black Tinted Square Cover
Available Colours	Graphite Steel (V)
POWER SOURCE	
Ratings	UL Listed
Electrical Requirements	120V, 5 Amps
Туре	Electric
DIMENSIONS	
Product (WxHxD)	29" x 14 1/8" x 30 7/8" (50 9/16 with drawer open)
Carton (WxHxD)	30 7/8" x 16 13/16" x 33 1/16"
Weight (Product/Carton)	105 lbs / 115 lbs
LIMITED WARRANTY	
	1 Year Parts and Labour, 10 Years Motor, 5 Years on Drum
UPC CODES	



Max RPM

LG ELECTRONICS CANADA INC. 20 Norelco Drive, North York, Ontario M9L 2X6 Tel: 647-253-6300 | LG.com


Customer Service & Parts 1-888-542-2623

Design, features and specifications are subject to change without notice.

Non-metric weights and measurements are approximate.

All trademarks are property of their respective owners.

Printed in October 2015

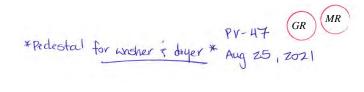

8/20/2021

SUMMARY

CAPACITY

DIMENSIONS (WXHXD)

1.1 cu.ft.

29" x 13.6" x 29.4"

STEAM TECHNOLOGY

No

THINQ®

No

SPECIFICATIONS

Dimendions (W x H x D) 2

29" x 13.6" x 29.4"

Colour

Graphite Steel

Weight (Product/Carton)

56.7 lbs/65.5 lbs

UPC CODE

WDP5V

048231012904







https://www.jennair.com/printpage.JXL6536HSS.html



STAINLESS STEEL 36" CUSTOM HOOD LINER

Signature Features

OPTIONAL 600 CFM OR 1,200 CFM INTERNAL BLOWER

Three-speed blower – ordered separately – rapidly rids the air of smoke, steam and cooking odors so the air is fresh and clean.

DISHWASHER-SAFE STAINLESS STEEL BAFFLE FILTERS

These stainless steel baffle filters, which effectively capture smoke, grease and cooking odors as they're drawn through the hood, can be easily cleaned in the dishwasher.

TWO LIGHTING LEVELS

Two different settings give you the appropriate level of lighting as you cook.

Technical Specifications

OPTIONAL 1,200 CFM IN-LINE BLOWER

Quickly removes smoke, steam and cooking odors from the kitchen and mounts further down the duct run to help reduce the noise of the ventilation system in the kitchen.

CUSTOM HOOD LINER

This hidden ventilation system mounts to the inside of a custom-built vent covering that can blend into the kitchen's design or be highlighted as a visual feature of the kitchen.

THREE FAN SPEED SETTINGS

Provides a range of ventilation power to accommodate your precise cooking needs.

10-INCH ROUND EXTERIOR VENTING

Large-diameter venting that enables quiet airflow and effective performance.

LUSTRE STAINLESS

Blur the lines of temptation with mind-bending curves and hairpin corners of stainless steel that will leave you reeling.

AUTO SENSE OPTION

Automatically turns the ventilation system on and adjusts power as needed.

JXL6536HSS



Dimensions

Depth: 22.0 in

Height: 11-1/2 in

Net Weight: 32 lbs

Width: 35-7/8 in

Electrical

Power Cord Included: Yes

Design Type

Design Expression: Stainless Steel

Certifications Details Energy Star® Qualified: No Night Light: Yes Prop 65: Standard Ventilation System UL: Yes Duct Outlet Size: 10 Configuration and Overview Duct Type: Round Number of Speeds: 3 Hood Type: Custom Hood Liners GDS Details isBaseUnit: true GPC Code: 10005322 Night Light Type: Halogen Number of Night Light Settings: 1 isConsumerUnit: true Number of Task Light Settings: 1 IsInvoiceUnit: true IsOrderableUnit: true Task Light Type: Halogen Task Lighting: Yes Product Type: EA

UDEX: 1100642102