




LOT NUMBER: 59
UNIT NAME: BIRCHWOOD
ELEVATION: A (RIGHT) REV
UNIT NUMBER: 5008-MOD

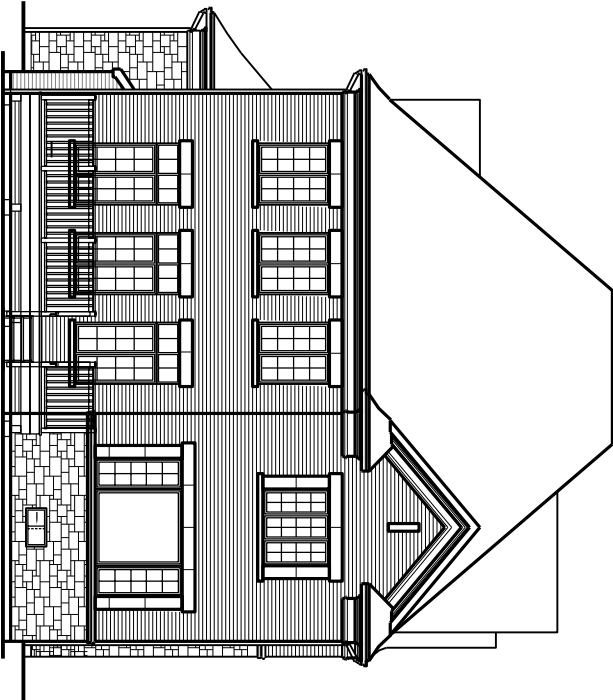

LOT NUMBER: 59
UNIT NAME: BIRCHWOOD
ELEVATION: A (REAR) REV
UNIT NUMBER: 5008-MOD

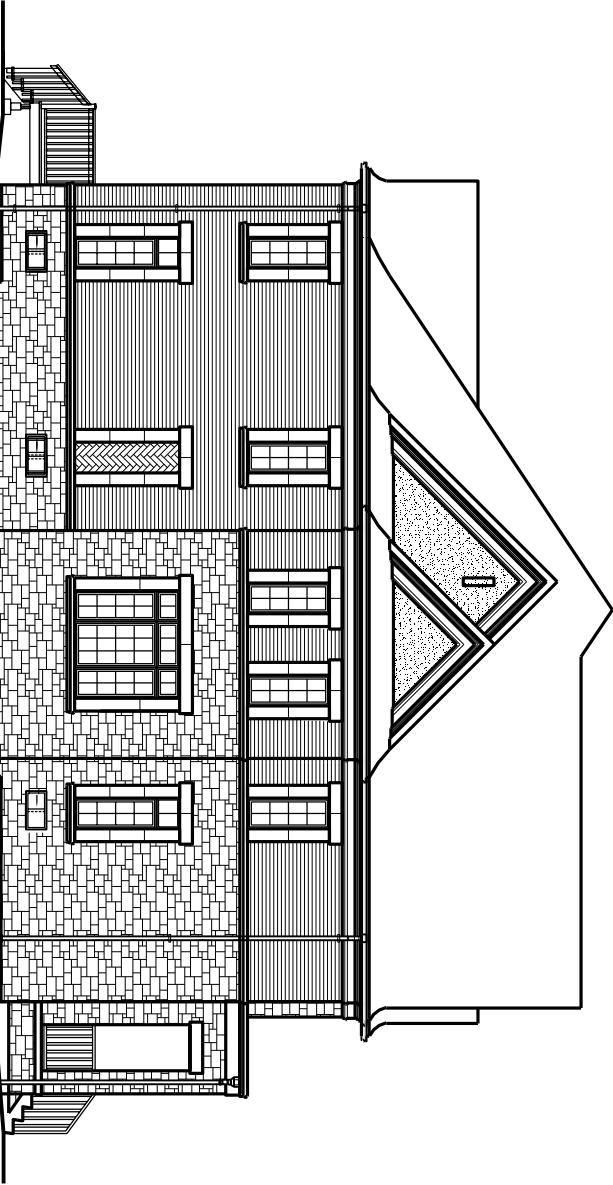

LOT NUMBER: 59
UNIT NAME: BIRCHWOOD
ELEVATION: A (FLANKAGE) REV
UNIT NUMBER: 5008-MOD

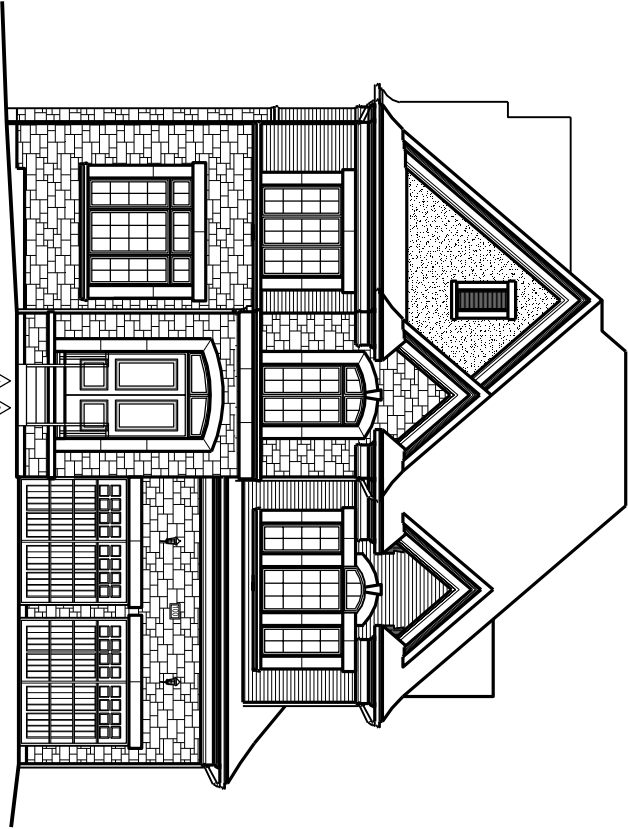

LOT NUMBER: 59
UNIT NAME: BIRCHWOOD
ELEVATION: A (FRONT) REV
UNIT NUMBER: 5008-MOD

LEGEND:

- 1. BRICK/STONE VENER ON SIDES OF STAIRS (POURED OR BRICK LEDGE PRECAST)
- 2. DROP OR RAISE RAINING BY AMOUNT INDICATED.
- 3. ADD BANDING AND/OR TRIM AS INDICATED.
- 4. ADDED CAMBERED HEADERS
- 5. 8'-0" X 8'-0" GARAGE DOORS.
- 6. PROPOSED OR RAISED SOFTT AS INDICATED.
- 7. ADJUSTED ROOF OVERHANG AS INDICATED ON ROOF PLAN.
- 8. PROVIDE GUARD PER CONSTRUCTION NOTE 11.
- 9. FOYER SUNKEN AS INDICATED
- 10. LIGHT FIXTURE RELOCATED AS INDICATED.

It is the builder's complete responsibility to ensure that all plans submitted for approval fully comply with the Architectural Guidelines and all applicable regulations and requirements including zoning provisions and any provisions in the submitted development agreement. The Architect is not responsible in any way for examining or approving site (lotting) plans or working drawings with respect to any zoning or building code or permit matter or that any house can be properly built or located on its lot. This is to certify that these plans comply with the applicable Architectural Design Guidelines approved by the City of VAUGHAN.