


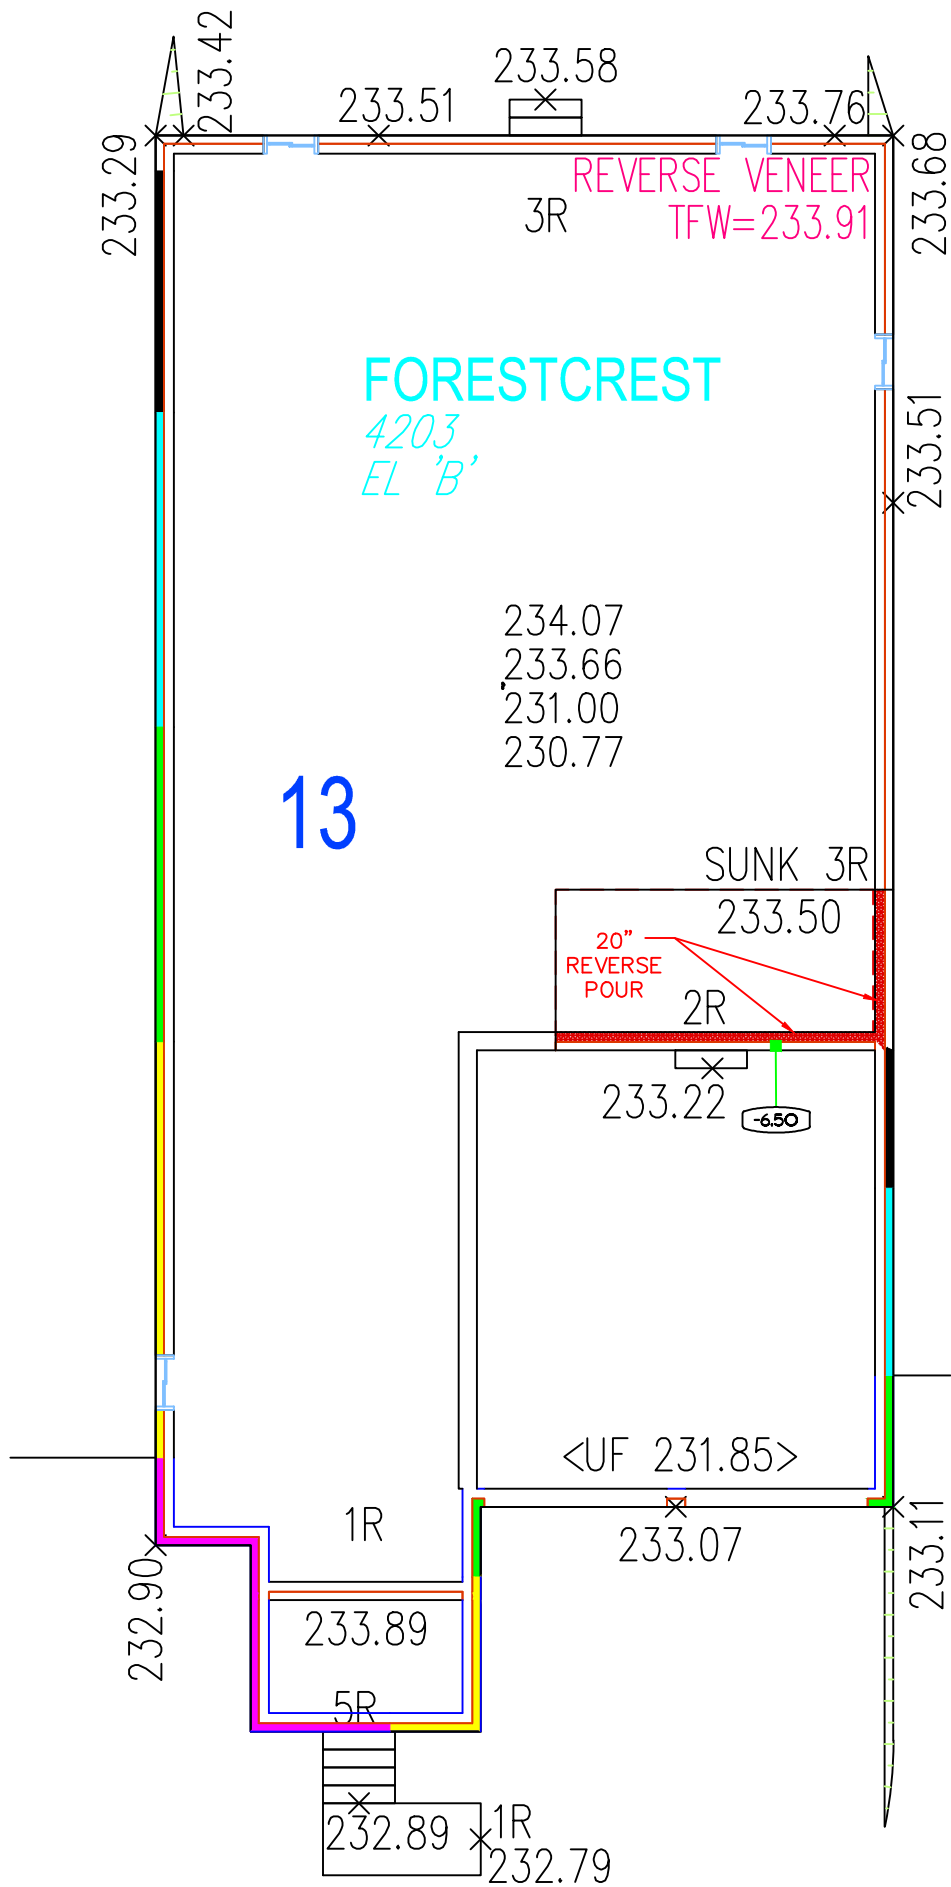

PLAN

Legend			
1 Brick (5")		Standard Wall	
2 Bricks (8.5")		Garage Wall	
3 Bricks (12")		1 Riser reverse	
4 Bricks (15.5")		2 Riser reverse	
5 Bricks (19")		3 Riser reverse	
6 Bricks (22.5")		4 Riser reverse	
7 Bricks (26")		Cut Pour	
8 Bricks (29.5")			

Site Name : Pine Valley		Job No.
Location : Vaughan, Ontario		
Date: 09/30/2023		Lot # 13 - REVISED
By : jamesp		Scale : n.t.s.

PHASE: 2

Total Stone Area Sq. Ft. + 5% Waste = 56 SQFT

Total Bricks + 4% Waste 220