

Strip Footings -
For Singles & Semis up to 2 storey

8" OR 10" FOUNDATION WALLS WITH 2"x8" / 2"x10" FLOOR JOISTS
20"x6" CONCRETE STRIP FOOTINGS BELOW FOUNDATION WALLS.
24"x8" CONCRETE STRIP FOOTINGS BELOW PARTY WALLS.

FOUNDATION WALLS WITH ENGINEERED JOISTS OVER 16' SPANS
24"x8" CONCRETE STRIP FOOTINGS BELOW FOUNDATION WALLS.

FOOTINGS ON ENGINEERED FILL
24"x8" CONCRETE STRIP FOOTINGS WITH REINFORCING
BELOW EXTERIOR WALLS.
30"x8" CONCRETE STRIP FOOTINGS WITH REINFORCING
BELOW PARTY WALLS.

(REFER TO FOOTING DETAILS ON ENGINEERED FILL)

Assume the larger footing size
when two conditions apply

ASSUMED 120 KPa (18 p.s.i.) SOIL BEARING CAPACITY OR 90 KPa
ENGINEERED SOIL FILL, TO BE VERIFIED ON SITE.

Pad Footings

120 KPa NATIVE SOIL 90 KPa ENGINEERED FILL SOIL
F1 = 42"x42"x18" CONCRETE PAD F1 = 48"x48"x20" CONCRETE PAD
F2 = 36"x36"x16" CONCRETE PAD F2 = 40"x40"x16" CONCRETE PAD
F3 = 30"x30"x12" CONCRETE PAD F3 = 34"x34"x14" CONCRETE PAD
F4 = 24"x24"x12" CONCRETE PAD F4 = 28"x28"x12" CONCRETE PAD
F5 = 16"x16"x8" CONCRETE PAD F5 = 18"x18"x8" CONCRETE PAD
(REFER TO FLOOR PLAN FOR UNUSUAL SIZE PADS NOT ON CHART)

WHEN VENEER CUT IS GREATER THAN 26" A 10" POURED CONC.
FDTN. WALL IS REQUIRED.

ALL GARAGE SLABS, PORCH SLABS, STAIRS (EXPOSED CONC.
FLAT WORK) TO BE 32 MPa WITH 5-8% AIR ENTRAINMENT

Brick Veneer Lintels

WL1 = 3-1/2"x3-1/2"x1/4"L (90x90x6.0L) + 2-2"x8" SPR. No.2
WL2 = 4"x3-1/2"x5/16"L (100x90x8.0L) + 2-2"x8" SPR. No.2
WL3 = 5"x3-1/2"x5/16"L (125x90x8.0L) + 2-2"x10" SPR. No.2
WL4 = 6"x3-1/2"x3/8"L (150x90x10.0L) + 2-2"x12" SPR. No.2
WL5 = 6"x4"x3/8"L (150x100x10.0L) + 2-2"x12" SPR. No.2
WL6 = 5"x3-1/2"x5/16"L (125x90x8.0L) + 2-2"x12" SPR. No.2
WL7 = 5"x3-1/2"x5/16"L (125x90x8.0L) + 3-2"x10" SPR. No.2
WL8 = 5"x3-1/2"x5/16"L (125x90x8.0L) + 3-2"x12" SPR. No.2
WL9 = 6"x4"x3/8"L (150x100x10.0L) + 3-2"x12" SPR. No.2

Wood Lintels and Beams

WB1 = 2-2"x8" SPR. No.2 (2-38x184 SPR. No.2)
WB2 = 3-2"x8" SPR. No.2 (3-38x184 SPR. No.2)
WB3 = 2-2"x10" SPR. No.2 (2-38x235 SPR. No.2)
WB4 = 3-2"x10" SPR. No.2 (3-38x235 SPR. No.2)
WB5 = 2-2"x12" SPR. No.2 (2-38x286 SPR. No.2)
WB6 = 3-2"x12" SPR. No.2 (3-38x286 SPR. No.2)
WB7 = 5-2"x12" SPR. No.2 (5-38x286 SPR. No.2)
WB11 = 4-2"x10" SPR. No.2 (4-38x235 SPR. No.2)
WB12 = 4-2"x12" SPR. No.2 (4-38x286 SPR. No.2)

LAMINATED VENEER LUMBER (LVL) BEAMS

LVL1A = 1-1 3/4" x 7 1/4" (1-45x184)
LVL1 = 2-1 3/4" x 7 1/4" (2-45x184)
LVL2 = 3-1 3/4" x 7 1/4" (3-45x184)
LVL3 = 4-1 3/4" x 7 1/4" (4-45x184)
LVL4A = 1-1 3/4" x 9 1/2" (1-45x240)
LVL4 = 2-1 3/4" x 9 1/2" (2-45x240)
LVL5 = 3-1 3/4" x 9 1/2" (3-45x240)
LVL5A = 4-1 3/4" x 9 1/2" (4-45x240)
LVL6A = 1-1 3/4" x 11 7/8" (1-45x300)
LVL6 = 2-1 3/4" x 11 7/8" (2-45x300)
LVL7 = 3-1 3/4" x 11 7/8" (3-45x300)
LVL7A = 4-1 3/4" x 11 7/8" (4-45x300)
LVL8 = 2-1 3/4" x 14" (2-45x356)
LVL9 = 3-1 3/4" x 14" (3-45x356)
LVL10 = 2-1 3/4" x 18" (3-45x456)

Loose Steel Lintels

L1 = 3-1/2"x3-1/2"x1/4"L (90x90x6.0L)
L2 = 4"x3-1/2"x5/16"L (100x90x8.0L)
L3 = 5"x3-1/2"x5/16"L (125x90x8.0L)
L4 = 6"x3-1/2"x3/8"L (150x90x10.0L)
L5 = 6"x4"x3/8"L (150x100x10.0L)
L6 = 7"x4"x3/8"L (175x100x10.0L)

Door Schedule

NOS.	WIDTH	HEIGHT 8'-0" CEILING	HEIGHT 10' OR MORE CEILING	TYPE
1	2'-10"	6'-8"	8'-0"	INSULATED ENTRANCE DOOR
1a	2'-8"	6'-8"	8'-0"	INSULATED FRONT DOORS
2	2'-8"	6'-8"	8'-0"	WOOD & GLASS DOOR
3	2'-8"	6'-8"	8'-0"	EXTERIOR SLAB DOOR
4	2'-8"	6'-8"	8'-0"	INTERIOR SLAB DOOR
5	2'-6"	6'-8"	8'-0"	INTERIOR SLAB DOOR
6	2'-2"	6'-8"	8'-0"	INTERIOR SLAB DOOR
7	1'-6"	6'-8"	8'-0"	INTERIOR SLAB DOOR


SPACE CONVENTIONAL FLOOR JOISTS @ 12"
O.C. BELOW ALL CERAMIC TILE AREAS.
PROVIDE 1 ROW BRIDGING FOR SPANS OF
5'-7', 2 ROWS FOR SPANS GREATER THAN 7'

REFER TO ROOF TRUSS SHOP DRAWINGS FOR
ALL ROOF FRAMING INFORMATION

PLANS NOT DRAWN TO ACTUAL GRADE. REFER
TO FINAL GRADING PLAN.

REFER TO FLOOR FRAMING SHOP DRAWINGS
FOR ENGINEERED FRAMING LAYOUTS


2-2"x6" STUD WALL NAILED TOGETHER AND
SPACED @12" O.C. FULL HT C/M SOLID
BLOCKING 4'-0" O.C. VERTICAL AND 7/16"
EXT. PLYWOOD SHEATHING.

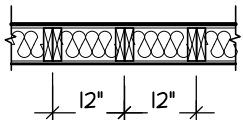

NOTE: MAXIMUM HEIGHT OF WALL
FOR THIS DETAIL IS 18'-0"

TWO STORY HEIGHT WALL DETAIL

2 - 1 1/2" x 5 1/2" TIMBERSTRAND (LSL) 1.5E
STUD WALL. GLUED AND NAILED TOGETHER
AND SPACED MAX. @10" O.C. FULL HT C/M
SOLID BLOCKING MAX. 8'-0" O.C. VERTICAL
AND 7/16" EXT. OSB SHEATHING.

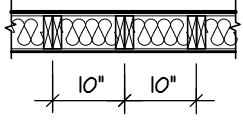

NOTE: MAXIMUM HEIGHT OF WALL FOR THIS
DETAIL IS 20'-2" AND MAXIMUM WIDTH
IS 40'-0"

TWO STORY HEIGHT WALL DETAIL

JUNIPER 7		ELEV.1		ENERGY STAR	
ELEVATION	WALL FT²	WALL MT²	OPENING FT²	OPENING MT²	PERCENTAGE
FRONT	817.41	75.44	158.30	14.71	19.31 %
LEFT SIDE	1039.46	96.51	82.90	7.70	7.98 %
RIGHT SIDE	1039.76	96.60	16.33	1.52	1.57 %
REAR	791.00	73.49	180.67	16.78	22.84 %
TOTAL	3687.63	342.54	438.20	40.71	11.88 %

JUNIPER 7		ELEV.2		ENERGY STAR	
ELEVATION	WALL FT²	WALL MT²	OPENING FT²	OPENING MT²	PERCENTAGE
FRONT	789.42	73.34	123.72	11.49	15.67 %
LEFT SIDE	1039.46	96.51	82.90	7.70	7.98 %
RIGHT SIDE	1039.76	96.60	16.33	1.52	1.57 %
REAR	791.00	73.49	180.67	16.78	22.84 %
TOTAL	3659.64	339.99	403.62	37.50	11.03 %

JUNIPER 7		ELEV.3		ENERGY STAR	
ELEVATION	WALL FT²	WALL MT²	OPENING FT²	OPENING MT²	PERCENTAGE
FRONT	798.42	74.18	123.89	11.51	15.52 %
LEFT SIDE	1039.46	96.51	82.90	7.70	7.98 %
RIGHT SIDE	1039.76	96.60	16.33	1.52	1.57 %
REAR	791.00	73.49	180.68	16.79	22.84 %
TOTAL	3668.64	340.83	403.80	37.51	11.01 %

AREA CALCULATIONS		ELEV. 2	
GROUND FLOOR AREA	=	1408	Sq. Ft.
SECOND FLOOR AREA	=	1698	Sq. Ft.
TOTAL FLOOR AREA	=	3106	Sq. Ft.
	=	288.56	Sq. M.
1ST FLOOR OPEN AREA	=	0	Sq. Ft.
2ND FLOOR OPEN AREA	=	0	Sq. Ft.
ADD TOTAL OPEN AREAS	=	0	Sq. Ft.
ADD FIN. BASEMENT AREA	=	0	Sq. Ft.
GROSS FLOOR AREA	=	3106	Sq. Ft.
	=	288.56	Sq. M.
GROUND FLOOR COVERAGE	=	1408	Sq. Ft.
GARAGE COVERAGE / AREA	=	400	Sq. Ft.
PORCH COVERAGE / AREA	=	78	Sq. Ft.
TOTAL COVERAGE W/ PORCH	=	1886	Sq. Ft.
	=	175.22	Sq. m.
TOTAL COVERAGE W/O PORCH	=	1808	Sq. Ft.
	=	167.97	Sq. m.

AREA CALCULATIONS		ELEV. 3	
GROUND FLOOR AREA	=	1408	Sq. Ft.
SECOND FLOOR AREA	=	1705	Sq. Ft.
TOTAL FLOOR AREA	=	3113	Sq. Ft.
	=	289.21	Sq. M.
1ST FLOOR OPEN AREA	=	0	Sq. Ft.
2ND FLOOR OPEN AREA	=	0	Sq. Ft.
ADD TOTAL OPEN AREAS	=	0	Sq. Ft.
ADD FIN. BASEMENT AREA	=	0	Sq. Ft.
GROSS FLOOR AREA	=	3113	Sq. Ft.
	=	289.21	Sq. M.
GROUND FLOOR COVERAGE	=	1408	Sq. Ft.
GARAGE COVERAGE / AREA	=	400	Sq. Ft.
PORCH COVERAGE / AREA	=	78	Sq. Ft.
TOTAL COVERAGE W/ PORCH	=	1886	Sq. Ft.
	=	175.22	Sq. m.
TOTAL COVERAGE W/O PORCH	=	1808	Sq. Ft.
	=	167.97	Sq. m.

AREA CALCULATIONS		ELEV. 1	
GROUND FLOOR AREA	=	1403	Sq. Ft.
SECOND FLOOR AREA	=	1690	Sq. Ft.
TOTAL FLOOR AREA	=	3093	Sq. Ft.
	=	287.35	Sq. M.
1ST FLOOR OPEN AREA	=	0	Sq. Ft.
2ND FLOOR OPEN AREA	=	0	Sq. Ft.
ADD TOTAL OPEN AREAS	=	0	Sq. Ft.
ADD FIN. BASEMENT AREA	=	0	Sq. Ft.
GROSS FLOOR AREA	=	3093	Sq. Ft.
	=	287.35	Sq. M.
GROUND FLOOR COVERAGE	=	1403	Sq. Ft.
GARAGE COVERAGE / AREA	=	400	Sq. Ft.
PORCH COVERAGE / AREA	=	135	Sq. Ft.
TOTAL COVERAGE W/ PORCH	=	1938	Sq. Ft.
	=	180.05	Sq. m.
TOTAL COVERAGE W/O PORCH	=	1803	Sq. Ft.
	=	167.50	Sq. m.

TOWN OF MILTON
PLANNING AND DEVELOPMENT
JUNIPER 7 MODEL

BUILDING: REVIEWED
SCOTT SHERRIFFS APR 13, 2017
PLANS EXAMINER DATE

Neither the issuance of a permit nor carrying out of
inspections by the Town of Milton relieves the owner from
full responsibility for compliance with the provisions of
the Ontario Building Code Act and the Ontario Building
Code, both as amended, as well as other applicable
statutes and regulations of the Province of Ontario,
By-laws of the Region of Halton and Town of Milton

RECEIVED
TOWN OF MILTON
MAR 29, 2017
JUNIPER 7
BUILDING DIVISION

GENERAL NOTES/CONSTRUCTION DETAILS
Reviewed model drawings to be read in
conjunction with reviewed general notes,
constructions details and specifications

TOWN OF MILTON
PLANNING AND DEVELOPMENT
RMD1*223 ZONE

ZONING: APPROVED
ROBIN CAMPBELL APR 22, 2017
ZONING OFFICER DATE

THE MINIMUM THERMAL PERFORMANCE OF BUILDING ENVELOPE AND EQUIPMENT SHALL CONFORM TO THE FOLLOWING	
2012 ENERGY STAR V-12.7	
COMPONENT	NOTE
CEILING WITH ATTIC SPACE MINIMUM RSI (R) VALUE	8.81 (R50)
CEILING WITHOUT ATTIC SPACE MINIMUM RSI (R) VALUE	5.46 (R31)
EXPOSE FLOOR MINIMUM RSI (R) VALUE	5.46 (R31)
WALLS ABOVE GRADE MINIMUM RSI (R) VALUE	4.4 (R20+R5)
BASEMENT WALLS MINIMUM RSI (R) VALUE	3.52 (R20 BLANKET)
EDGE OF BELOW GRADE SLAB ≤ 600mm BELOW GRADE MINIMUM RSI (R) VALUE	1.16 (R10)
WINDOWS & SLIDING GLASS DOORS MAXIMUM U-VALUE	ENERGY STAR ® ZONE C (ER 29/11/14)
SPACE HEATING EQUIPMENT MINIMUM AFUE	95% ENERGY STAR ® WITH ECM
GAS FIREPLACE	ELECTRONIC SPARK IGNITION
HRV MINIMUM EFFICIENCY	TIER 2 65% GRE ENERGY STAR ® HRV TO BE INTERCONNECTED TO THE FURNACE FAN MUST BE BALANCED INDICATING ON HIGH SPEED FRESH/STALE
HOT WATER TANK	CONDENSING HOT WATER TANK 90% TE ENVIROSENCE
DRAIN WATER HEAT RECOVERY	ONE SHOWER > 42% STEADY R3-42 OR TD342
AIR TIGHTNESS MUST MEET MINIMUM	DETACHED LEVEL 1 (2.5 ACH/0.18 NLR) ATTACHED LEVEL 1 (3.0 ACH/0.26 NLR)
DUCT SEALING	ALL SUPPLY DUCTS 1 m (HORIZONTAL) OF RETURN DUCTS
LIGHTS	75% CFLs OR LEDs



ENERGY STAR - V 12.7



FOR STRUCTURE ONLY

It is the builder's complete responsibility to
ensure that all plans submitted for approval
fully comply with the Architectural Guidelines
and all applicable regulations and requirements
including zoning provisions and any provisions
in the subdivision agreement. The Control
Architect is not responsible in any way for
examining or approving site (lotting) plans or
working drawings with respect to any zoning or
building code or permit matter or that any
house can be properly built or located on its lot.

This is to certify that these plans comply
with the applicable Architectural Design
Guidelines approved by the Town of
MILTON.

JUNIPER 7
ENERGY STAR

5.		
4.		
3.		
2.		
1.	ISSUED FOR REVIEW	SEP 2016
REVISIONS		

The undersigned has reviewed and takes responsibility for this
design, and has the qualifications and meets the requirements set
out in the Ontario Building Code to be a designer.
QUALIFICATION INFORMATION
Required unless design is exempt under Division C, Subsection 3.2.5 of the building code

VIKAS GAJJAR
NAME SIGNATURE
28770
BCIN

REGION DESIGN INC.
8700 DUFFERIN ST.
CONCORD, ONTARIO
L4K 4S6
P (416) 736-4096
F (905) 660-0746


REGION
DESIGN
INC.

SHEET TITLE		CONTRACTOR SHALL CHECK ALL DIMENSIONS AND ELEVATIONS BEFORE COMMENCING WITH WORK AND REPORT ANY DISCREPANCIES TO THE DESIGNER. PRINTS ARE NOT TO BE SCALED.	
AREA CHARTS			
SCALE	3/16"=1'-0"	BY	V.G.
DATE	JUL 2016	TYPE	
AREA	3093	PAGE No.	0
PROJECT	02-10-08		

Greenpark.

PROJECT NAME
LECCO RIDGE

RECEIVED
TOWN OF MILTON
MAR 29, 2017
JUNIPER 7
BUILDING DIVISION

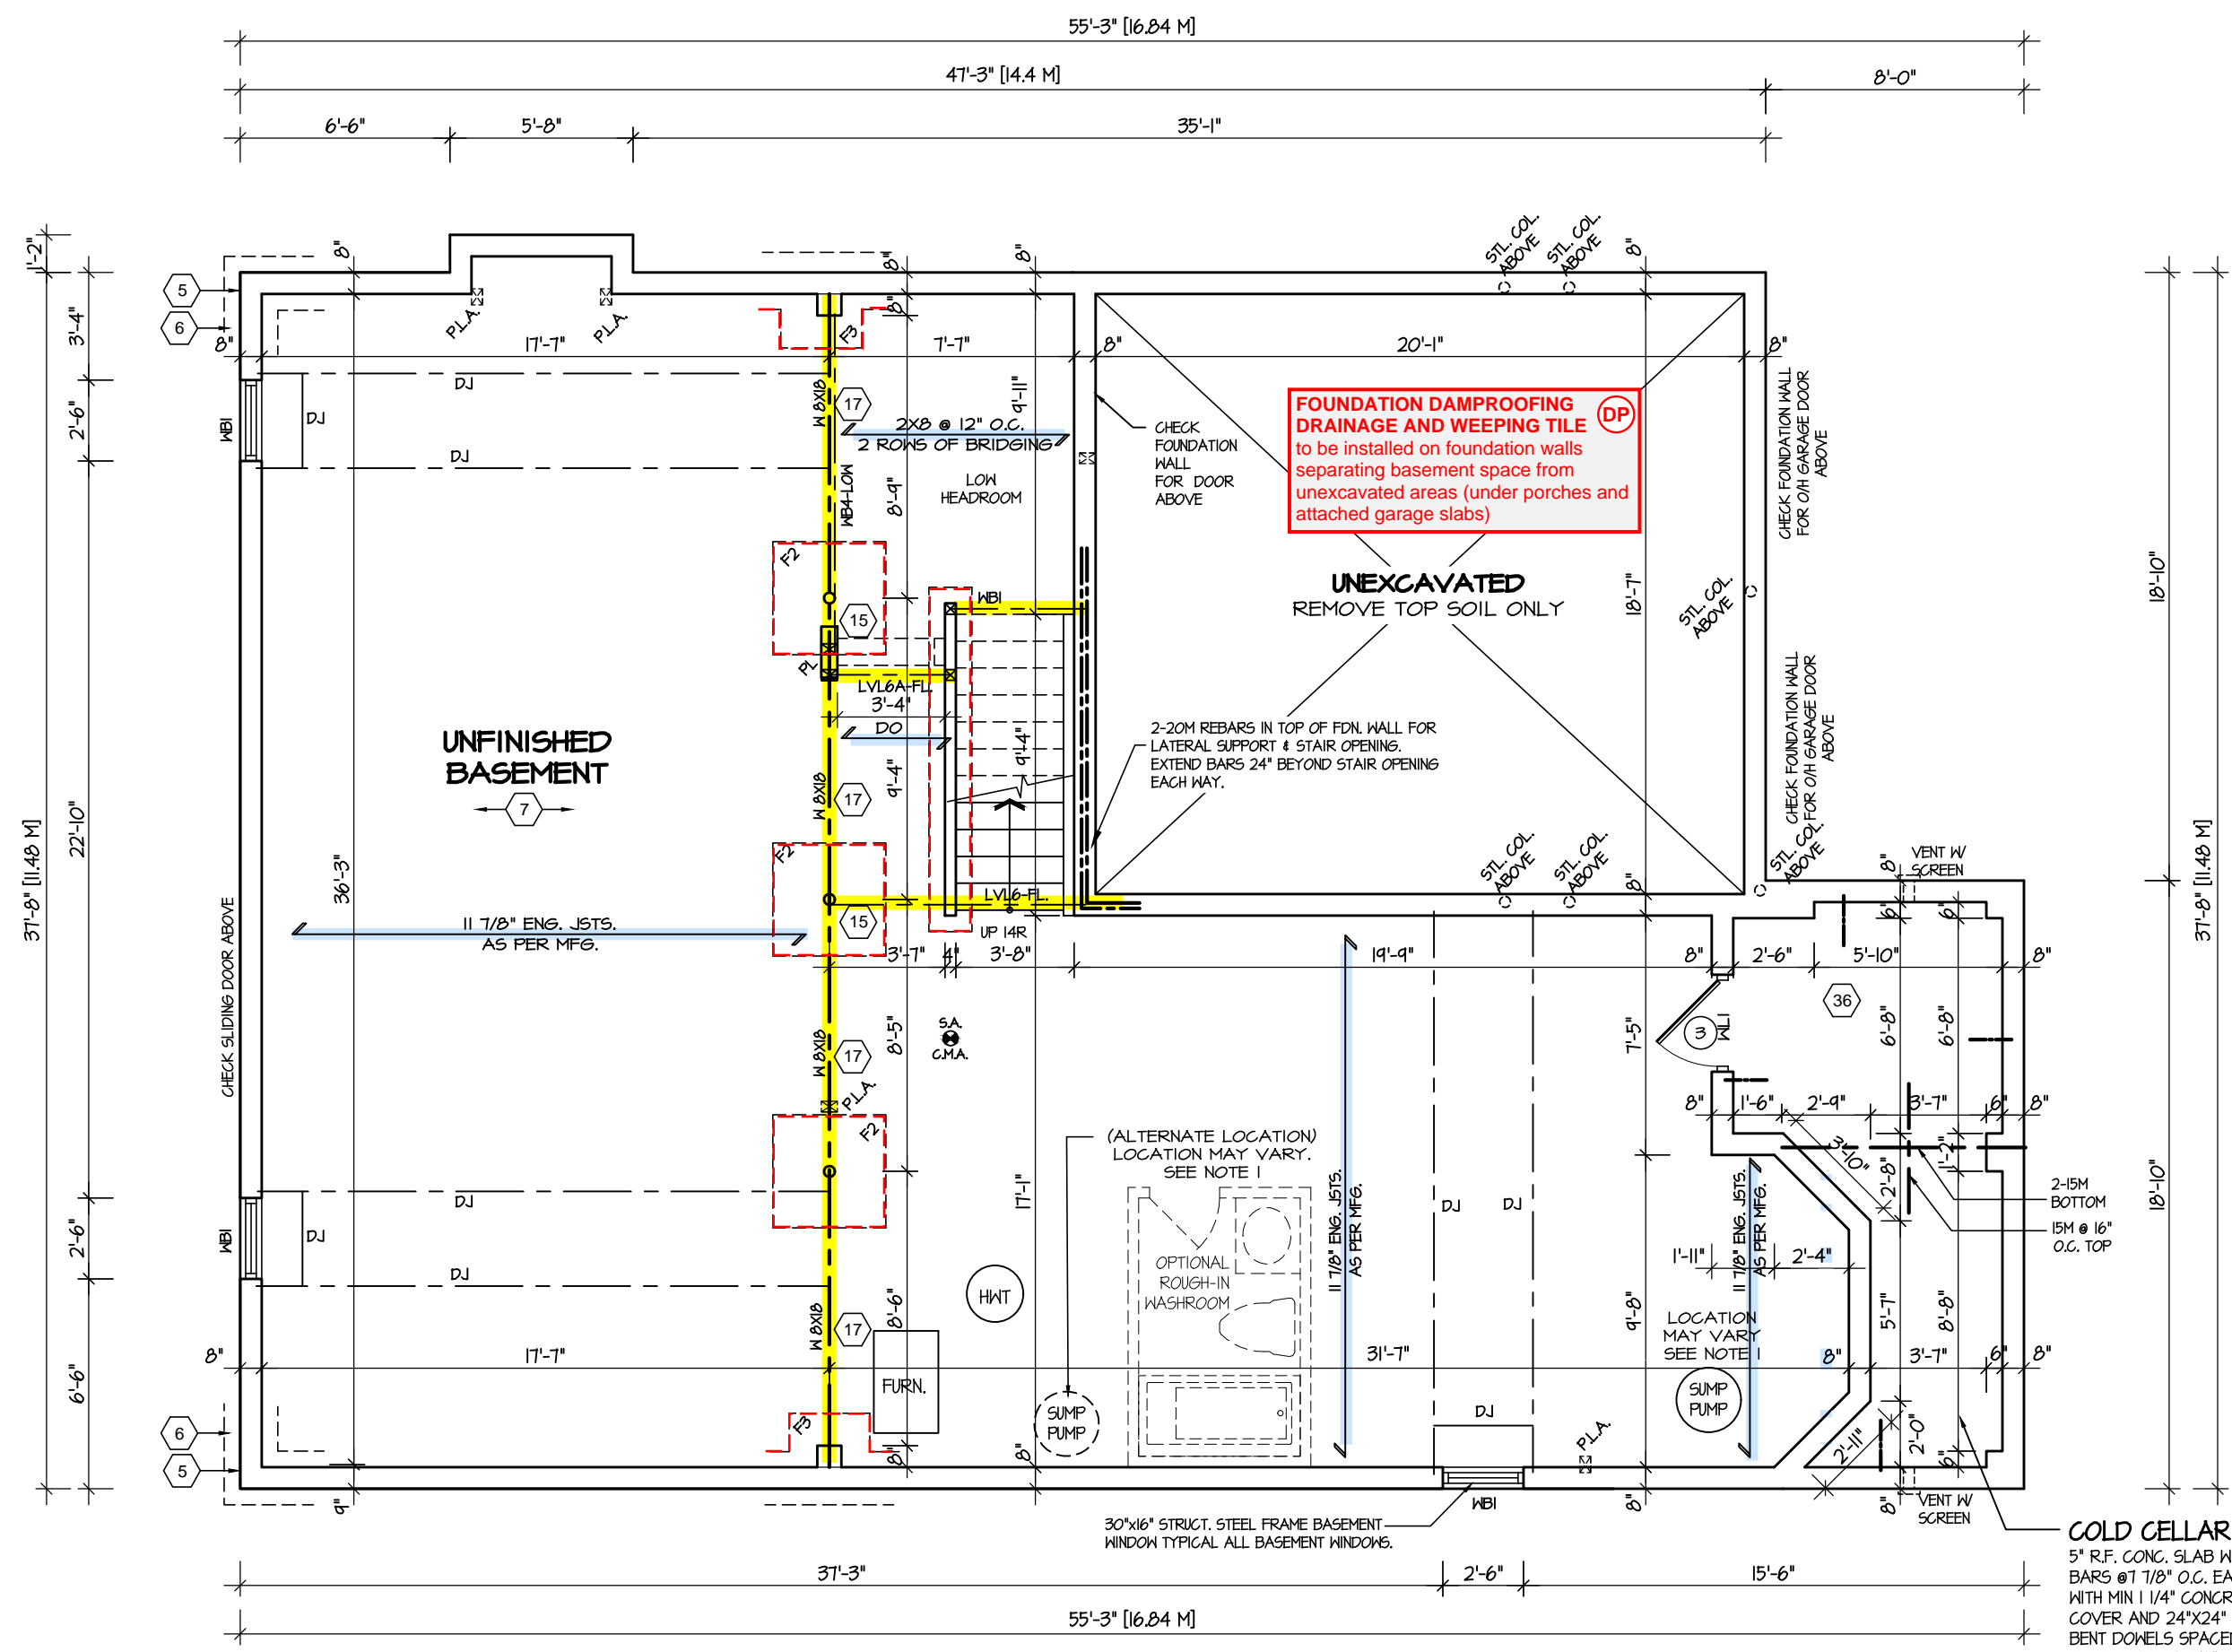

BASEMENT FLOOR PLAN 'I'

REFER TO SHEET NO. 0 FOR LINTEL, BEAMS AND DOOR SIZES

SPACE CONVENTIONAL FLOOR JOISTS @ 12" O.C. BELOW ALL CERAMIC TILE AREAS. PROVIDE 1 ROW BRIDGING FOR SPANS OF 5'-7", 2 ROWS FOR SPANS GREATER THAN 7'


REFER TO FLOOR FRAMING SHOP DRAWINGS FOR ENGINEERED FRAMING LAYOUTS

ALL SUBFLOORS TO BE 3/4" PLYWOOD AND TO BE GLUED AND NAILED ON THIS FLOOR.

ENGINEERED FLOOR SYSTEM
Reviewed model drawings to be read in conjunction with reviewed engineered floor system layout

NOTE 1: FINAL LOCATION OF SUMP PUMP IS BASED ON SITE CONDITION

COLD CELLAR

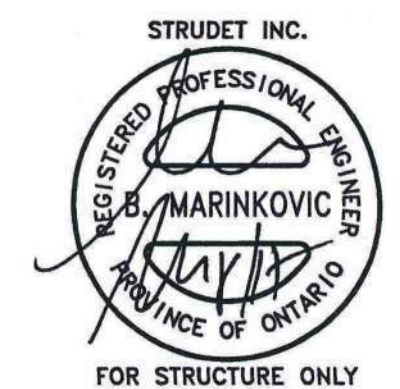

It is the builder's complete responsibility to ensure that all plans submitted for approval fully comply with the Architectural Guidelines and all applicable regulations and requirements including zoning provisions and any provisions in the subdivision agreement. The Control Architect is not responsible in any way for examining or approving site (lotting) plans or working drawings with respect to any zoning or building code or permit matter or that any house can be properly built or located on its lot.


This is to certify that these plans comply with the applicable Architectural Design Guidelines approved by the Town of MILTON.

ARCHITECTURAL REVIEW & APPROVAL
MAR 20 2017
John G. Williams Limited, Architect

JUNIPER 7
ENERGY STAR

5.		<div>The undersigned has reviewed and takes responsibility for this design, and has the qualifications and meets the requirements set out in the Ontario Building Code to be a designer.</div> <div>QUALIFICATION INFORMATION</div> <div>Required unless design is exempt under Division C, Subsection 3.2.5 of the building code</div> <div><div>VIKAS GAJJAR</div><div></div><div>28770</div></div> <div><div>NAME</div><div>SIGNATURE</div><div>BCIN</div></div>	<div>REGION DESIGN INC.</div> <div>8700 DUFFERIN ST.</div> <div>CONCORD, ONTARIO</div> <div>L4K 4S6</div> <div>P (416) 736-4096</div> <div>F (905) 660-0746</div>	<div>REGION DESIGN INC.</div>	SHEET TITLE		CONTRACTOR SHALL CHECK ALL DIMENSIONS AND ELEVATIONS BEFORE COMMENCING WITH WORK AND REPORT ANY DISCREPANCIES TO THE DESIGNER. PRINTS ARE NOT TO BE SCALED.		<div></div> <div>PROJECT NAME</div> <div>LECCO RIDGE</div>
4.					BASEMENT PLAN				
3.					ELEV. 1				
2.					SCALE	BY	AREA	PAGE No.	
1.	ISSUED FOR REVIEW				3/16"=1'-0"	V.G.	3093	1	
REVISIONS		DATE	TYPE	PROJECT					
		JUL 2016		02-10-08					

RECEIVED
TOWN OF MILTON
MAR 29, 2017
JUNIPER 7
BUILDING DIVISION

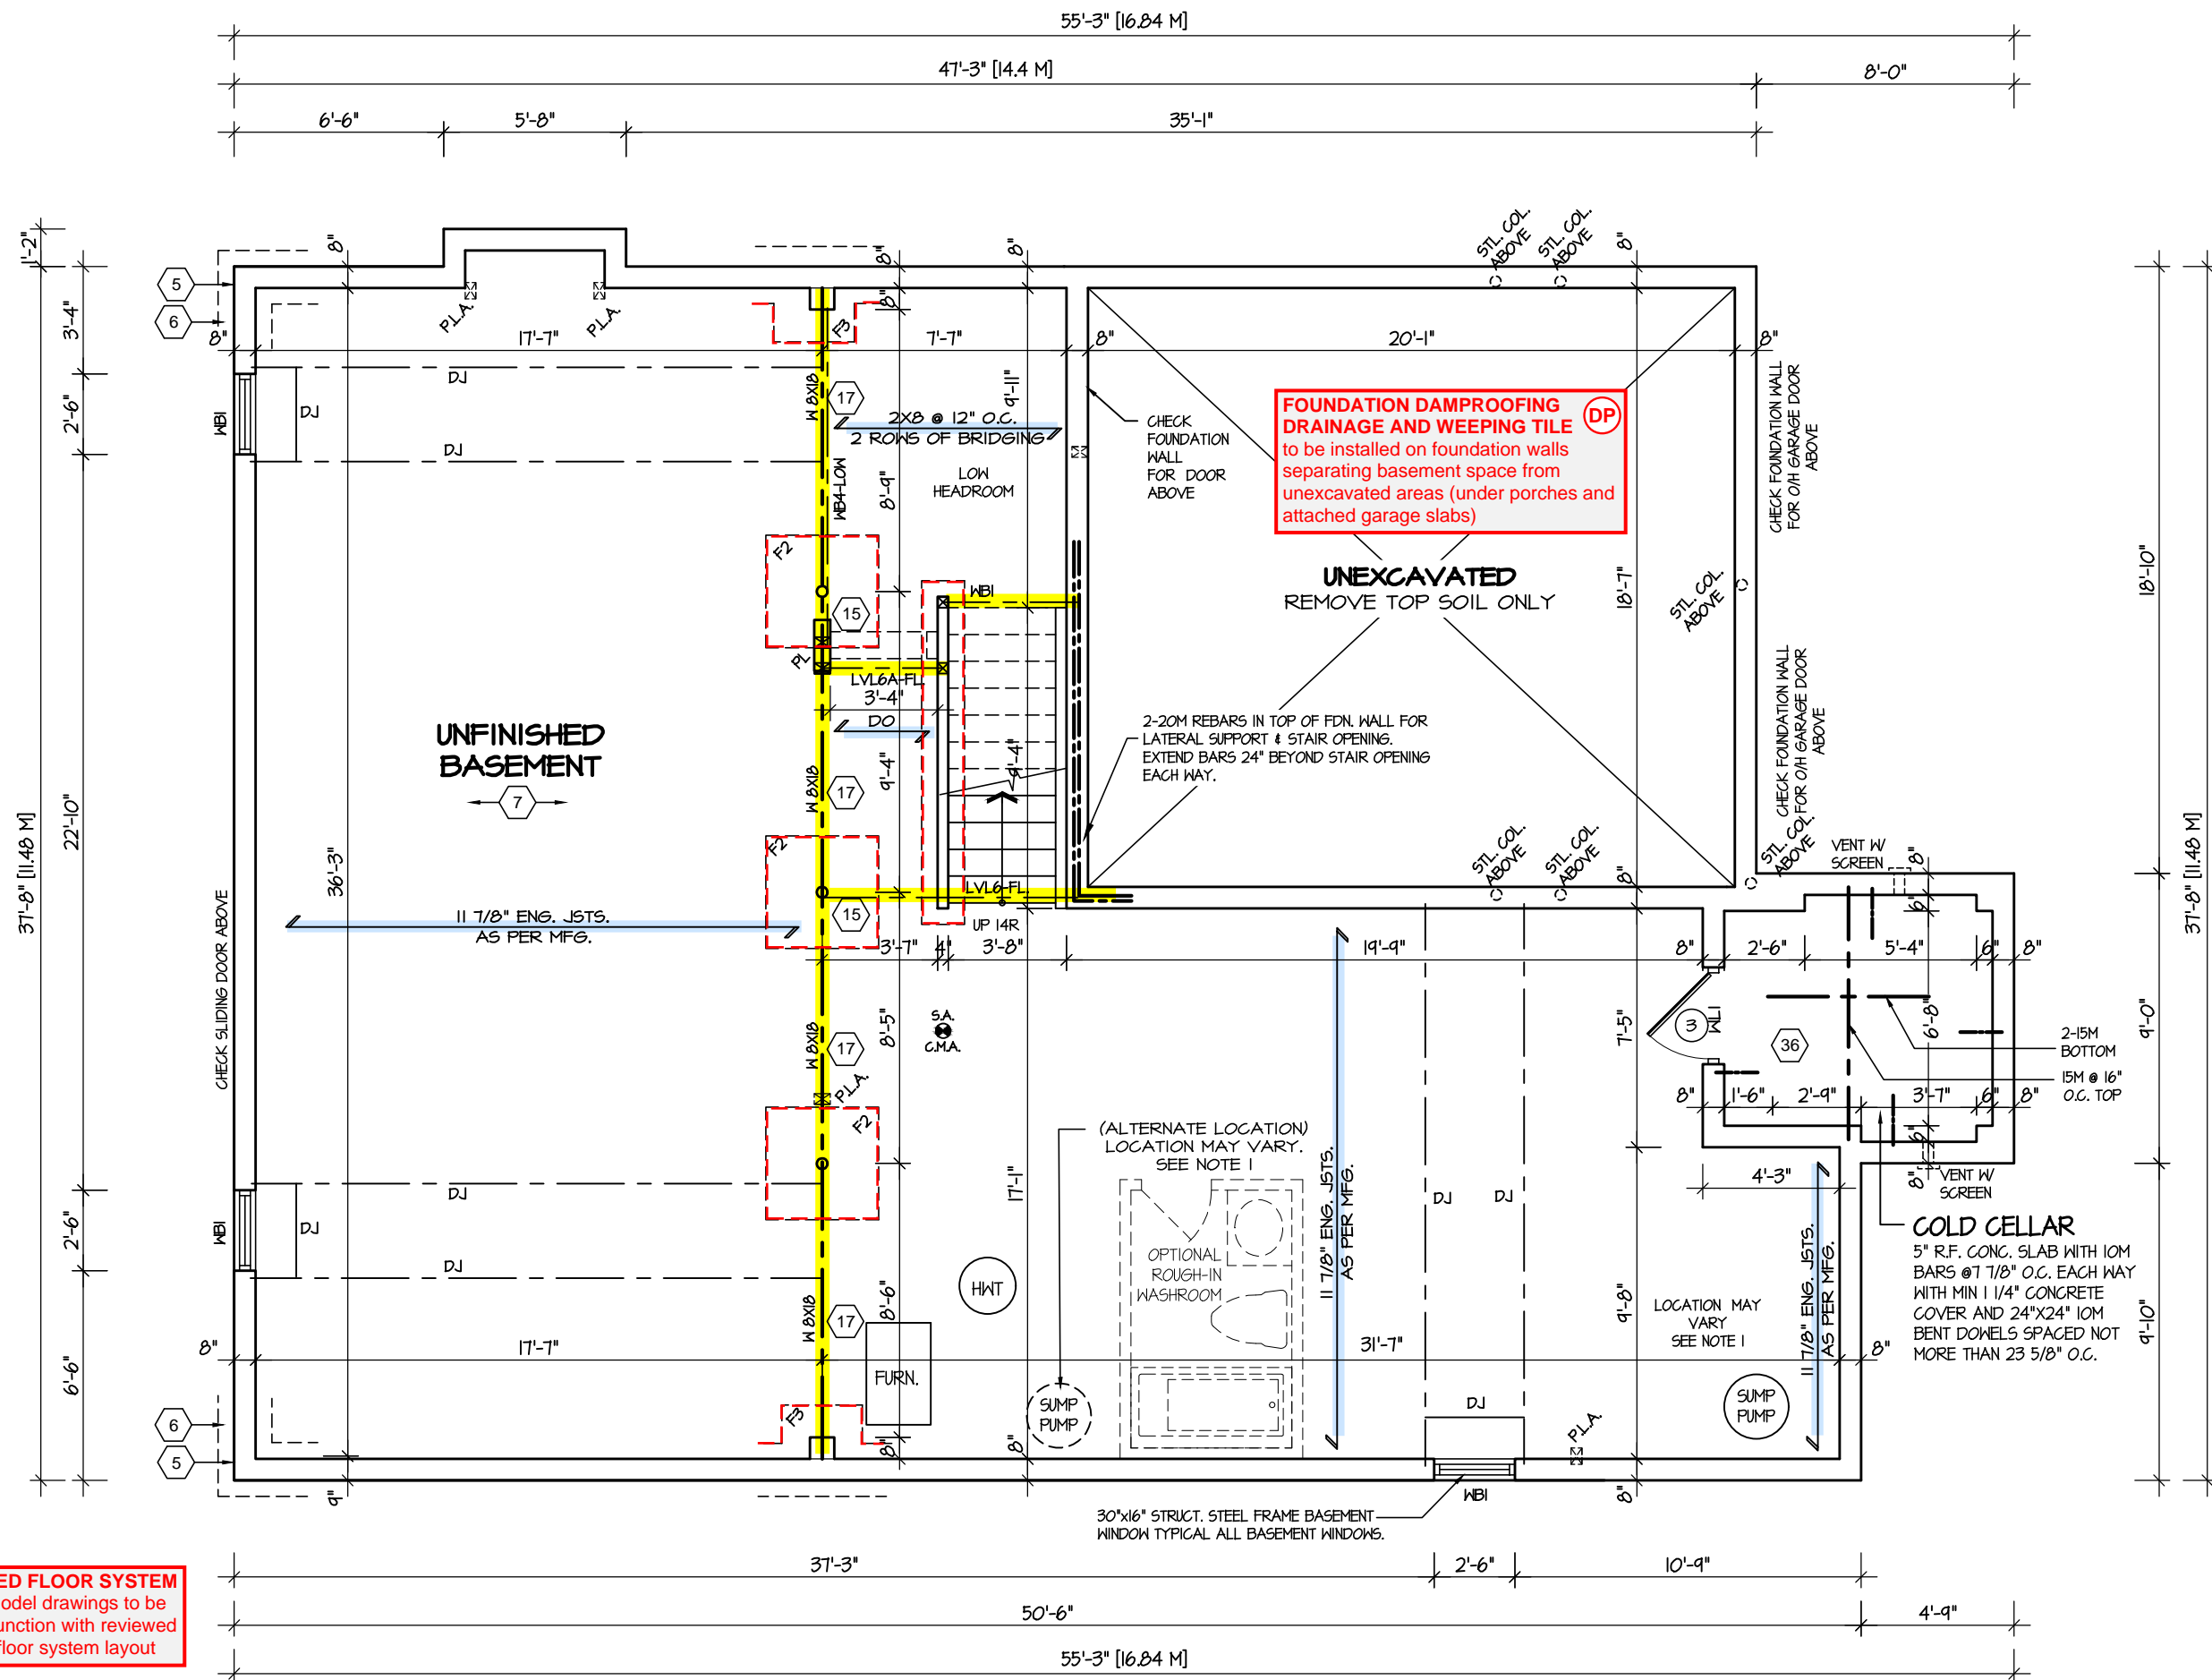

ENGINEERED FLOOR SYSTEM
Reviewed model drawings to be read in conjunction with reviewed engineered floor system layout

BASEMENT FLOOR PLAN '2'


REFER TO SHEET NO. 0 FOR LINTEL, BEAMS AND DOOR SIZES

SPACE CONVENTIONAL FLOOR JOISTS @ 12" O.C. BELOW ALL CERAMIC TILE AREAS. PROVIDE 1 ROW BRIDGING FOR SPANS OF 5'-1", 2 ROWS FOR SPANS GREATER THAN 7'

REFER TO FLOOR FRAMING SHOP DRAWINGS FOR ENGINEERED FRAMING LAYOUTS

ALL SUBFLOORS TO BE 3/4" PLYWOOD AND TO BE GLUED AND NAILED ON THIS FLOOR.

NOTE 1: FINAL LOCATION OF SUMP PUMP IS BASED ON SITE CONDITION

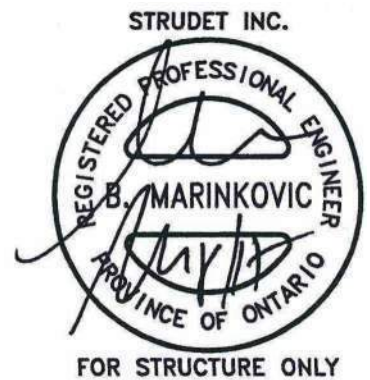

It is the builder's complete responsibility to ensure that all plans submitted for approval fully comply with the Architectural Guidelines and all applicable regulations and requirements including zoning provisions and any provisions in the subdivision agreement. The Control Architect is not responsible in any way for examining or approving site (lotting) plans or working drawings with respect to any zoning or building code or permit matter or that any house can be properly built or located on its lot.


This is to certify that these plans comply with the applicable Architectural Design Guidelines approved by the Town of MILTON.

ARCHITECTURAL REVIEW & APPROVAL
MAR 20 2017
John G. Williams Limited, Architect

JUNIPER 7
ENERGY STAR

5.			<p>The undersigned has reviewed and takes responsibility for this design, and has the qualifications and meets the requirements set out in the Ontario Building Code to be a designer.</p> <p>QUALIFICATION INFORMATION</p> <p>Required unless design is exempt under Division C, Subsection 3.2.5 of the building code</p> <div><div>VIKAS GAJJAR</div><div></div><div>28770</div></div> <div><div>NAME</div><div>SIGNATURE</div><div>BCIN</div></div>	<p>REGION DESIGN INC.</p> <p>8700 DUFFERIN ST.</p> <p>CONCORD, ONTARIO</p> <p>L4K 4S6</p> <p>P (416) 736-4096</p> <p>F (905) 660-0746</p>	<p>REGION DESIGN INC.</p>	SHEET TITLE		CONTRACTOR SHALL CHECK ALL DIMENSIONS AND ELEVATIONS BEFORE COMMENCING WITH WORK AND REPORT ANY DISCREPANCIES TO THE DESIGNER. PRINTS ARE NOT TO BE SCALED.			
4.						BASEMENT PLAN ELEV. 2					PROJECT NAME LECCO RIDGE
3.						SCALE 3/16"=1'-0"	BY V.G.	AREA 3093	PAGE No. 1-2		
2.						DATE JUL 2016	TYPE	PROJECT 02-10-08			
1.	ISSUED FOR REVIEW	SEP 2016									
REVISIONS											

RECEIVED
TOWN OF MILTON
MAR 29, 2017
JUNIPER 7
BUILDING DIVISION

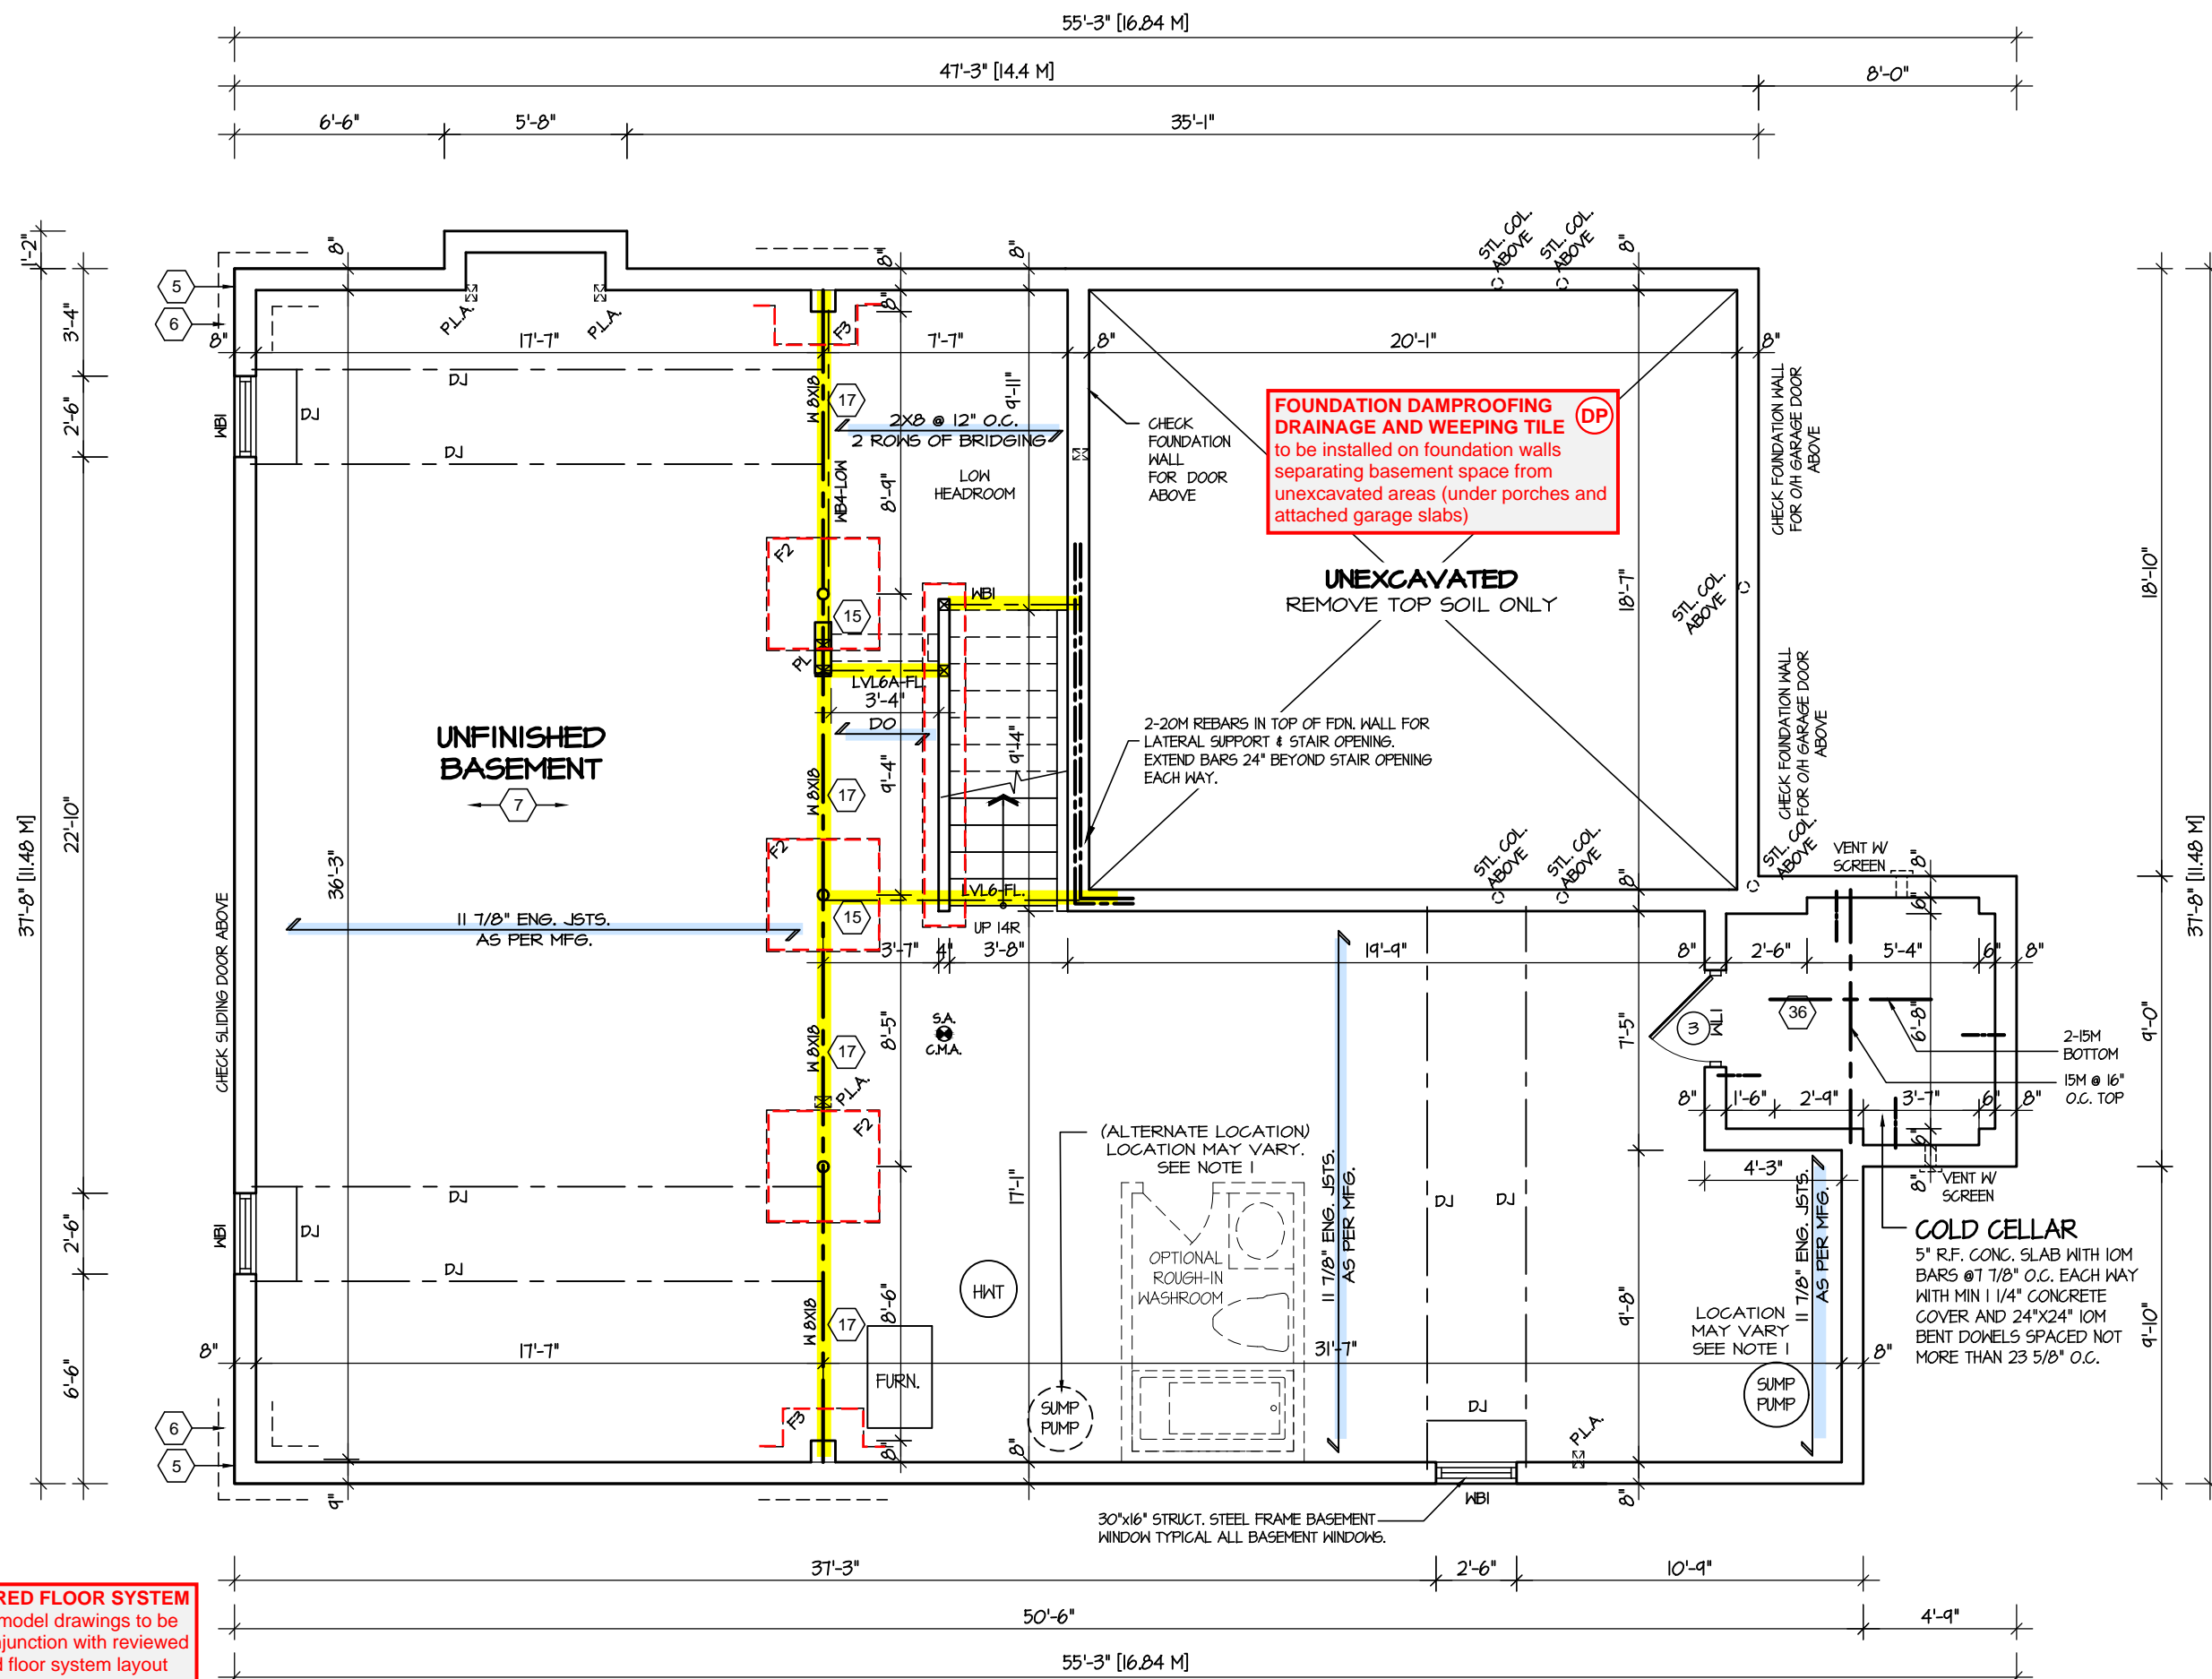

ENGINEERED FLOOR SYSTEM
Reviewed model drawings to be read in conjunction with reviewed engineered floor system layout

BASEMENT FLOOR PLAN '3'

REFER TO SHEET NO. 0 FOR LINTEL, BEAMS AND DOOR SIZES

SPACE CONVENTIONAL FLOOR JOISTS @ 12" O.C. BELOW ALL CERAMIC TILE AREAS.
PROVIDE 1 ROW BRIDGING FOR SPANS OF 5'-7', 2 ROWS FOR SPANS GREATER THAN 7'

REFER TO FLOOR FRAMING SHOP DRAWINGS FOR ENGINEERED FRAMING LAYOUTS

ALL SUBFLOORS TO BE 3/4" PLYWOOD AND TO BE GLUED AND NAILED ON THIS FLOOR.

NOTE 1: FINAL LOCATION OF SUMP PUMP IS BASED ON SITE CONDITION



It is the builder's complete responsibility to ensure that all plans submitted for approval fully comply with the Architectural Guidelines and all applicable regulations and requirements including zoning provisions and any provisions in the subdivision agreement. The Control Architect is not responsible in any way for examining or approving site (lotting) plans or working drawings with respect to any zoning or building code or permit matter or that any house can be properly built or located on its lot.

This is to certify that these plans comply with the applicable Architectural Design Guidelines approved by the Town of MILTON.

ARCHITECTURAL REVIEW & APPROVAL
MAR 20 2017
John G. Williams Limited, Architect

JUNIPER 7
ENERGY STAR

5.		<p>The undersigned has reviewed and takes responsibility for this design, and has the qualifications and meets the requirements set out in the Ontario Building Code to be a designer.</p> <p>QUALIFICATION INFORMATION</p> <p>Required unless design is exempt under Division C, Subsection 3.2.5 of the building code</p> <div><div>VIKAS GAJJAR</div><div></div><div>28770</div></div> <div><div>NAME</div><div>SIGNATURE</div><div>BCIN</div></div>	<p>REGION DESIGN INC.</p> <p>8700 DUFFERIN ST.</p> <p>CONCORD, ONTARIO</p> <p>L4K 4S6</p> <p>P (416) 736-4096</p> <p>F (905) 660-0746</p>	<p>REGION DESIGN INC.</p>	SHEET TITLE		CONTRACTOR SHALL CHECK ALL DIMENSIONS AND ELEVATIONS BEFORE COMMENCING WITH WORK AND REPORT ANY DISCREPANCIES TO THE DESIGNER. PRINTS ARE NOT TO BE SCALED.			PROJECT NAME	
4.					BASEMENT PLAN		ELEV. 3				1-3
3.					SCALE	BY	AREA	PAGE No.			
2.					3/16"=1'-0"	V.G.	3093				
1.	ISSUED FOR REVIEW				SEP 2016	DATE	TYPE	PROJECT			
REVISIONS				JUL 2016		02-10-08	LECCO RIDGE				

45 MIN FRR

LD <1.2 M FOR BUMPOUT
Fireplace bumpout to be constructed with 45 min FRF where the LD is <1.2 m

GARAGE AIR BARRIER
Garage walls/ceiling required to include an air barrier system.
Gypsum board used as an air barrier requires all joints to be sealed with tape and a minimum 1 coat of compound

GARAGE DOOR
Requires weatherstripping
and a self closing device

GUARDS/HANDRAILS
Shall be provided on
porches as required
based on final lot grading

STRUDET INC.



FOR STRUCTURE ONLY

It is the builder's complete responsibility to ensure that all plans submitted for approval fully comply with the Architectural Guidelines and all applicable regulations and requirements including zoning provisions and any provisions in the subdivision agreement. The Control Architect is not responsible in any way for examining or approving site (lotting) plans or working drawings with respect to any zoning or building code or permit matter or that any house can be properly built or located on its lot.

This is to certify that these plans comply with the applicable Architectural Design Guidelines approved by the Town of MILTON.

ARCHITECTURAL REVIEW & APPROVAL

MAR 2/0 2017

John G. Williams Limited, Architect

JUNIPER 7
ENERGY STAR



PROJECT NAME	LECCO RIDGE
--------------	-------------

FIRST FLOOR PLAN "I"

ENGINEERED FLOOR SYSTEM
Reviewed model drawings to be read in conjunction with reviewed engineered floor system layout

5.		<p>The undersigned has reviewed and takes responsibility for this design, and has the qualifications and meets the requirements set out in the Ontario Building Code to be a designer.</p> <p>QUALIFICATION INFORMATION</p> <p>Required unless design is exempt under Division C, Subsection 3.2.5 of the building code</p> <div><div>VIKAS GAJJAR</div><div></div><div>28770</div></div> <div><div>NAME</div><div>SIGNATURE</div><div>BCIN</div></div>	<p>REGION DESIGN INC.</p> <p>8700 DUFFERIN ST.</p> <p>CONCORD, ONTARIO</p> <p>L4K 4S6</p> <p>P (416) 736-4096</p> <p>F (905) 660-0746</p>	<p>REGION DESIGN INC.</p>	SHEET TITLE		CONTRACTOR SHALL CHECK ALL DIMENSIONS AND ELEVATIONS BEFORE COMMENCING WITH WORK AND REPORT ANY DISCREPANCIES TO THE DESIGNER. PRINTS ARE NOT TO BE SCALED.				
4.					FIRST FLOOR PLAN					<p>PAGE No.</p> <p>2</p>	<p>PROJECT NAME</p> <p>LECCO RIDGE</p>
3.					ELEV. 1						
2.					SCALE	BY	AREA				
1.	ISSUED FOR REVIEW				3/16"=1'-0"	V.G.	3093				
REVISIONS				DATE	TYPE	PROJECT					
				JUL 2016		02-10-08					

RECEIVED
TOWN OF MILTON
MAR 29, 2017
JUNIPER 7
BUILDING DIVISION

45 MIN FRR
LD <1.2 M FOR BUMP-OUT
Fireplace bump-out to be constructed with 45 min FRR where the LD is <1.2 m


GARAGE AIR BARRIER
Garage walls/ceiling required to include an air barrier system. Gypsum board used as an air barrier requires all joints to be sealed with tape and a minimum 1 coat of compound

GARAGE DOOR
Requires weatherstripping and a self closing device

GUARDS/HANDRAILS
Shall be provided on porches as required based on final lot grading

ENGINEERED FLOOR SYSTEM
Reviewed model drawings to be read in conjunction with reviewed engineered floor system layout

FIRST FLOOR PLAN '2'

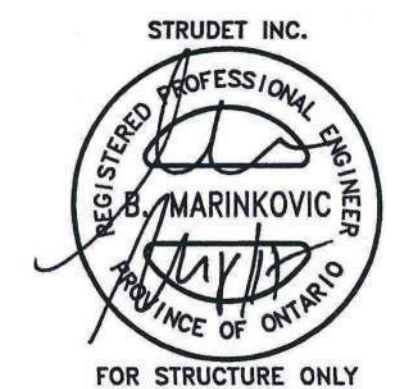


It is the builder's complete responsibility to ensure that all plans submitted for approval fully comply with the Architectural Guidelines and all applicable regulations and requirements including zoning provisions and any provisions in the subdivision agreement. The Control Architect is not responsible in any way for examining or approving site (lotting) plans or working drawings with respect to any zoning or building code or permit matter or that any house can be properly built or located on its lot.

This is to certify that these plans comply with the applicable Architectural Design Guidelines approved by the Town of MILTON.

ARCHITECTURAL REVIEW & APPROVAL
MAR 20 2017
John G. Williams Limited, Architect

JUNIPER 7
ENERGY STAR

5.		<div>The undersigned has reviewed and takes responsibility for this design, and has the qualifications and meets the requirements set out in the Ontario Building Code to be a designer.</div> <div>QUALIFICATION INFORMATION</div> <div>Required unless design is exempt under Division C, Subsection 3.2.5 of the building code</div> <div><div>VIKAS GAJJAR</div><div></div><div>28770</div></div> <div><div>NAME</div><div>SIGNATURE</div><div>BCIN</div></div>	<div>REGION DESIGN INC.</div> <div>8700 DUFFERIN ST.</div> <div>CONCORD, ONTARIO</div> <div>L4K 4S6</div> <div>P (416) 736-4096</div> <div>F (905) 660-0746</div>	<div>REGION DESIGN INC.</div>	SHEET TITLE		CONTRACTOR SHALL CHECK ALL DIMENSIONS AND ELEVATIONS BEFORE COMMENCING WITH WORK AND REPORT ANY DISCREPANCIES TO THE DESIGNER. PRINTS ARE NOT TO BE SCALED.		<div></div> <div>PROJECT NAME</div> <div>LECCO RIDGE</div>
4.					FIRST FLOOR PLAN				
3.					ELEV. 2				
2.					SCALE	BY	AREA	PAGE No.	
1.	ISSUED FOR REVIEW				3/16"=1'-0"	V.G.	3093	2-2	
REVISIONS			DATE	TYPE	PROJECT				
			JUL 2016		02-10-08				

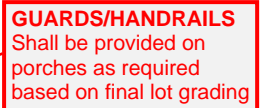

It is the builder's complete responsibility to ensure that all plans submitted for approval fully comply with the Architectural Guidelines and all applicable regulations and requirements including zoning provisions and any provisions in the subdivision agreement. The Control Architect is not responsible in any way for examining or approving site (lotting) plans or working drawings with respect to any zoning or building code or permit matter or that any house can be properly built or located on its lot.

This is to certify that these plans comply with the applicable Architectural Design Guidelines approved by the Town of MILTON.

ARCHITECTURAL REVIEW & APPROVAL



MAR 20 2017

John G. Williams Limited, Architect

JUNIPER 7
ENERGY STAR

5.			<p>The undersigned has reviewed and takes responsibility for this design, and has the qualifications and meets the requirements set out in the Ontario Building Code to be a designer.</p> <p>QUALIFICATION INFORMATION</p> <p>Required unless design is exempt under Division C, Subsection 3.2.5 of the building code</p> <div><div>VIKAS GAJJAR</div><div></div><div>28770</div></div> <div><div>NAME</div><div>SIGNATURE</div><div>BCIN</div></div>	<p>REGION DESIGN INC.</p> <p>8700 DUFFERIN ST.</p> <p>CONCORD, ONTARIO</p> <p>L4K 4S6</p> <p>P (416) 736-4096</p> <p>F (905) 660-0746</p> <p>REGION DESIGN INC.</p>	SHEET TITLE		<p>CONTRACTOR SHALL CHECK ALL DIMENSIONS AND ELEVATIONS BEFORE COMMENCING WITH WORK AND REPORT ANY DISCREPANCIES TO THE DESIGNER. PRINTS ARE NOT TO BE SCALED.</p>		
4.					FIRST FLOOR PLAN				
3.					ELEV. 3				
2.					SCALE	BY	AREA	PAGE No.	
1.	ISSUED FOR REVIEW	SEP 2016			3/16"=1'-0"	V.G.	3093	2-3	
REVISIONS					DATE	TYPE	PROJECT		
					JUL 2016		02-10-08		
								PROJECT NAME	LECCO RIDGE

RECEIVED
TOWN OF MILTON
MAR 29, 2017
JUNIPER 7
BUILDING DIVISION

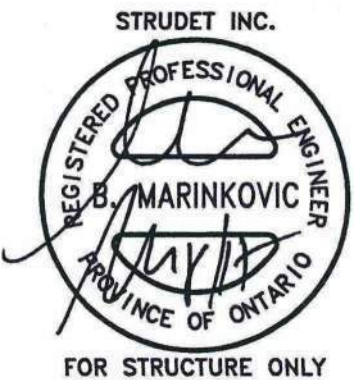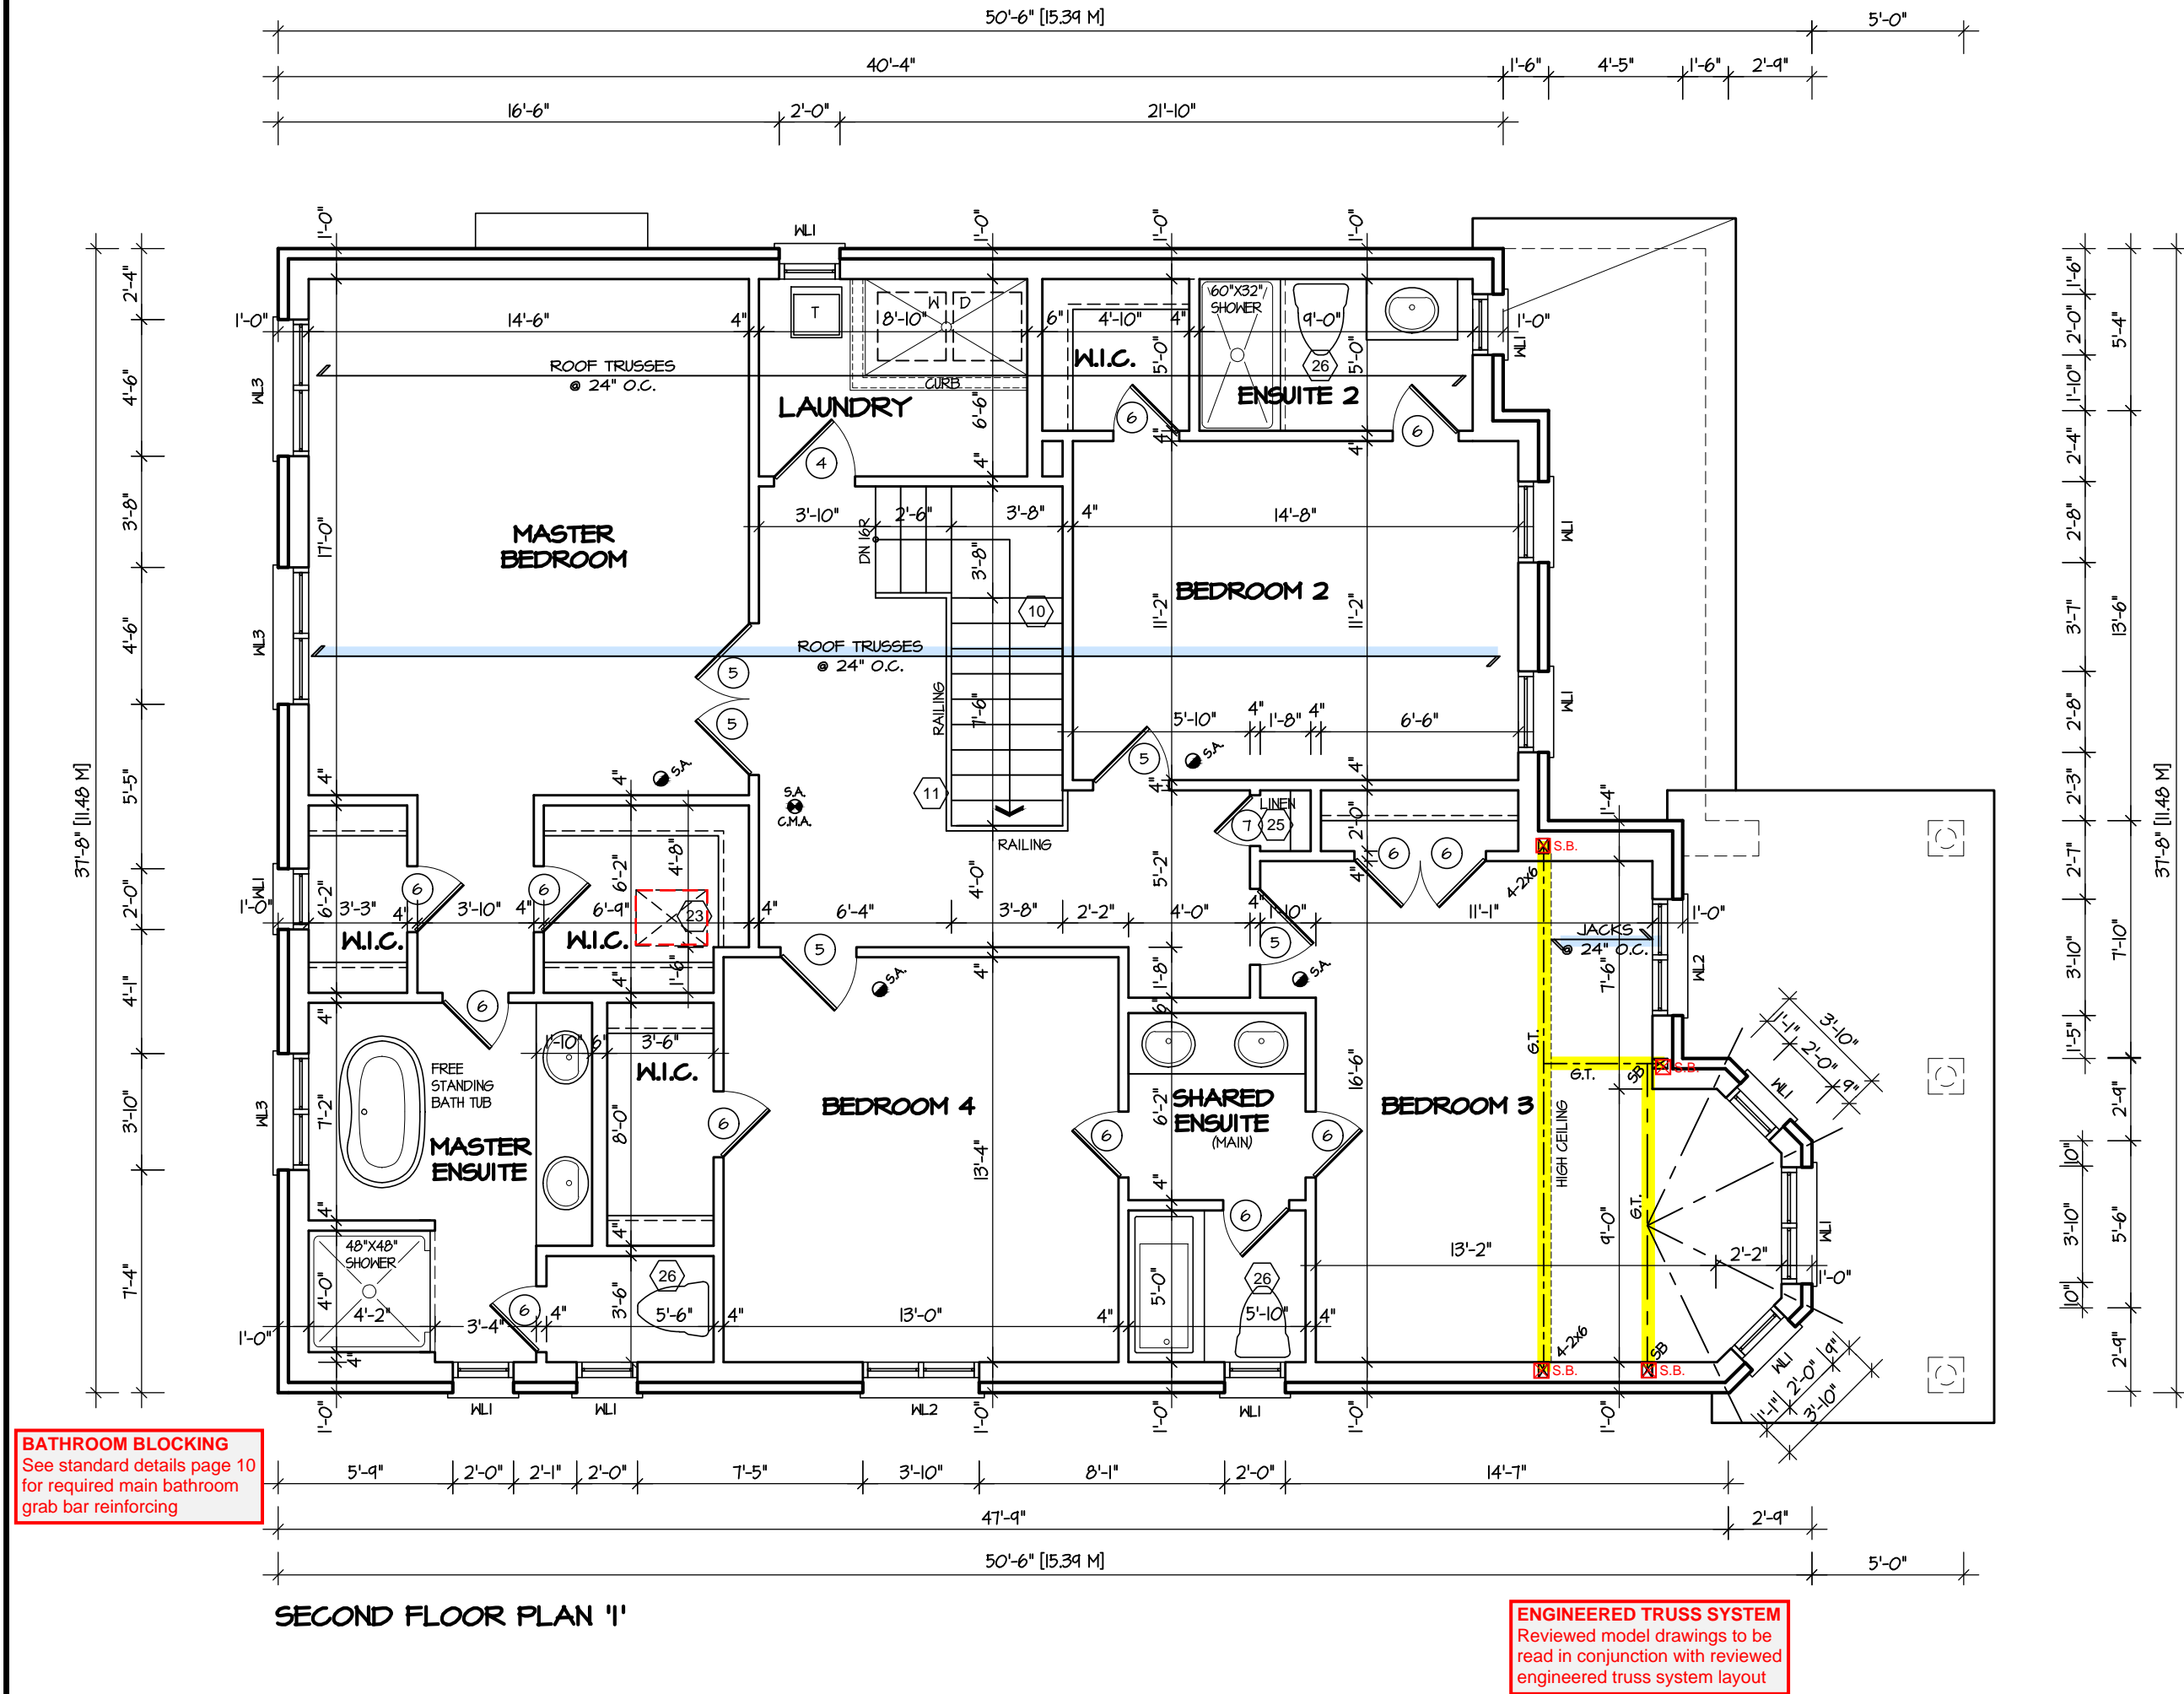


It is the builder's complete responsibility to ensure that all plans submitted for approval fully comply with the Architectural Guidelines and all applicable regulations and requirements including zoning provisions and any provisions in the subdivision agreement. The Control Architect is not responsible in any way for examining or approving site (lotting) plans or working drawings with respect to any zoning or building code or permit matter or that any house can be properly built or located on its lot.

This is to certify that these plans comply with the applicable Architectural Design Guidelines approved by the Town of MILTON.

ARCHITECTURAL REVIEW & APPROVAL
MAR 20 2017
John G. Williams Limited, Architect

JUNIPER 7
ENERGY STAR


5.		<div>The undersigned has reviewed and takes responsibility for this design, and has the qualifications and meets the requirements set out in the Ontario Building Code to be a designer.</div> <div>QUALIFICATION INFORMATION</div> <div>Required unless design is exempt under Division C, Subsection 3.2.5 of the building code</div> <div><div>VIKAS GAJJAR</div><div></div><div>28770</div></div> <div><div>NAME</div><div>SIGNATURE</div><div>BCIN</div></div>	<div>REGION DESIGN INC.</div> <div>8700 DUFFERIN ST.</div> <div>CONCORD, ONTARIO</div> <div>L4K 4S6</div> <div>P (416) 736-4096</div> <div>F (905) 660-0746</div>	<div>REGION DESIGN INC.</div>	SHEET TITLE		CONTRACTOR SHALL CHECK ALL DIMENSIONS AND ELEVATIONS BEFORE COMMENCING WITH WORK AND REPORT ANY DISCREPANCIES TO THE DESIGNER. PRINTS ARE NOT TO BE SCALED.		<div></div>	
4.					SECOND FLOOR PLAN					PROJECT NAME
3.					ELEV. 1					
2.							SCALE	BY	AREA	PAGE No.
1.					ISSUED FOR REVIEW		3/16"=1'-0"	V.G.	3093	3
REVISIONS					DATE	TYPE	PROJECT			
				JUL 2016		02-10-08				

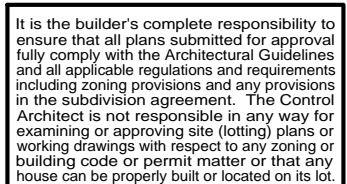

This is to certify that these plans comply with the applicable Architectural Design Guidelines approved by the Town of MILTON.

ARCHITECTURAL REVIEW & APPROVAL
MAR 20 2017
John G. Williams Limited, Architect



JUNIPER 7
ENERGY STAR

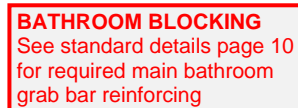

ENGINEERED TRUSS SYSTEM
Reviewed model drawings to be read in conjunction with reviewed engineered truss system layout

5.			<p>The undersigned has reviewed and takes responsibility for this design, and has the qualifications and meets the requirements set out in the Ontario Building Code to be a designer.</p> <p>QUALIFICATION INFORMATION</p> <p>Required unless design is exempt under Division C, Subsection 3.2.5 of the building code</p> <div><div>VIKAS GAJJAR</div><div></div><div>28770</div></div> <div><div>NAME</div><div>SIGNATURE</div><div>BCIN</div></div>	<p>REGION DESIGN INC.</p> <p>8700 DUFFERIN ST.</p> <p>CONCORD, ONTARIO</p> <p>L4K 4S6</p> <p>P (416) 736-4096</p> <p>F (905) 660-0746</p>	<p>REGION DESIGN INC.</p>	SHEET TITLE		<p>CONTRACTOR SHALL CHECK ALL DIMENSIONS AND ELEVATIONS BEFORE COMMENCING WITH WORK AND REPORT ANY DISCREPANCIES TO THE DESIGNER. PRINTS ARE NOT TO BE SCALED.</p>		
4.						SECOND FLOOR PLAN				
3.						SCALE	BY	AREA	PAGE No.	
2.						3/16"=1'-0"	V.G.	3093	3-2	
1.	ISSUED FOR REVIEW	SEP 2016				DATE	TYPE	PROJECT		
REVISIONS									PROJECT NAME	
									LECCO RIDGE	

RECEIVED
TOWN OF MILTON
MAR 29, 2017
JUNIPER 7
BUILDING DIVISION

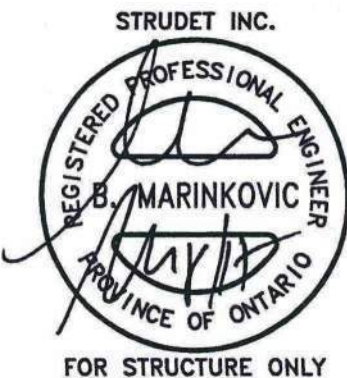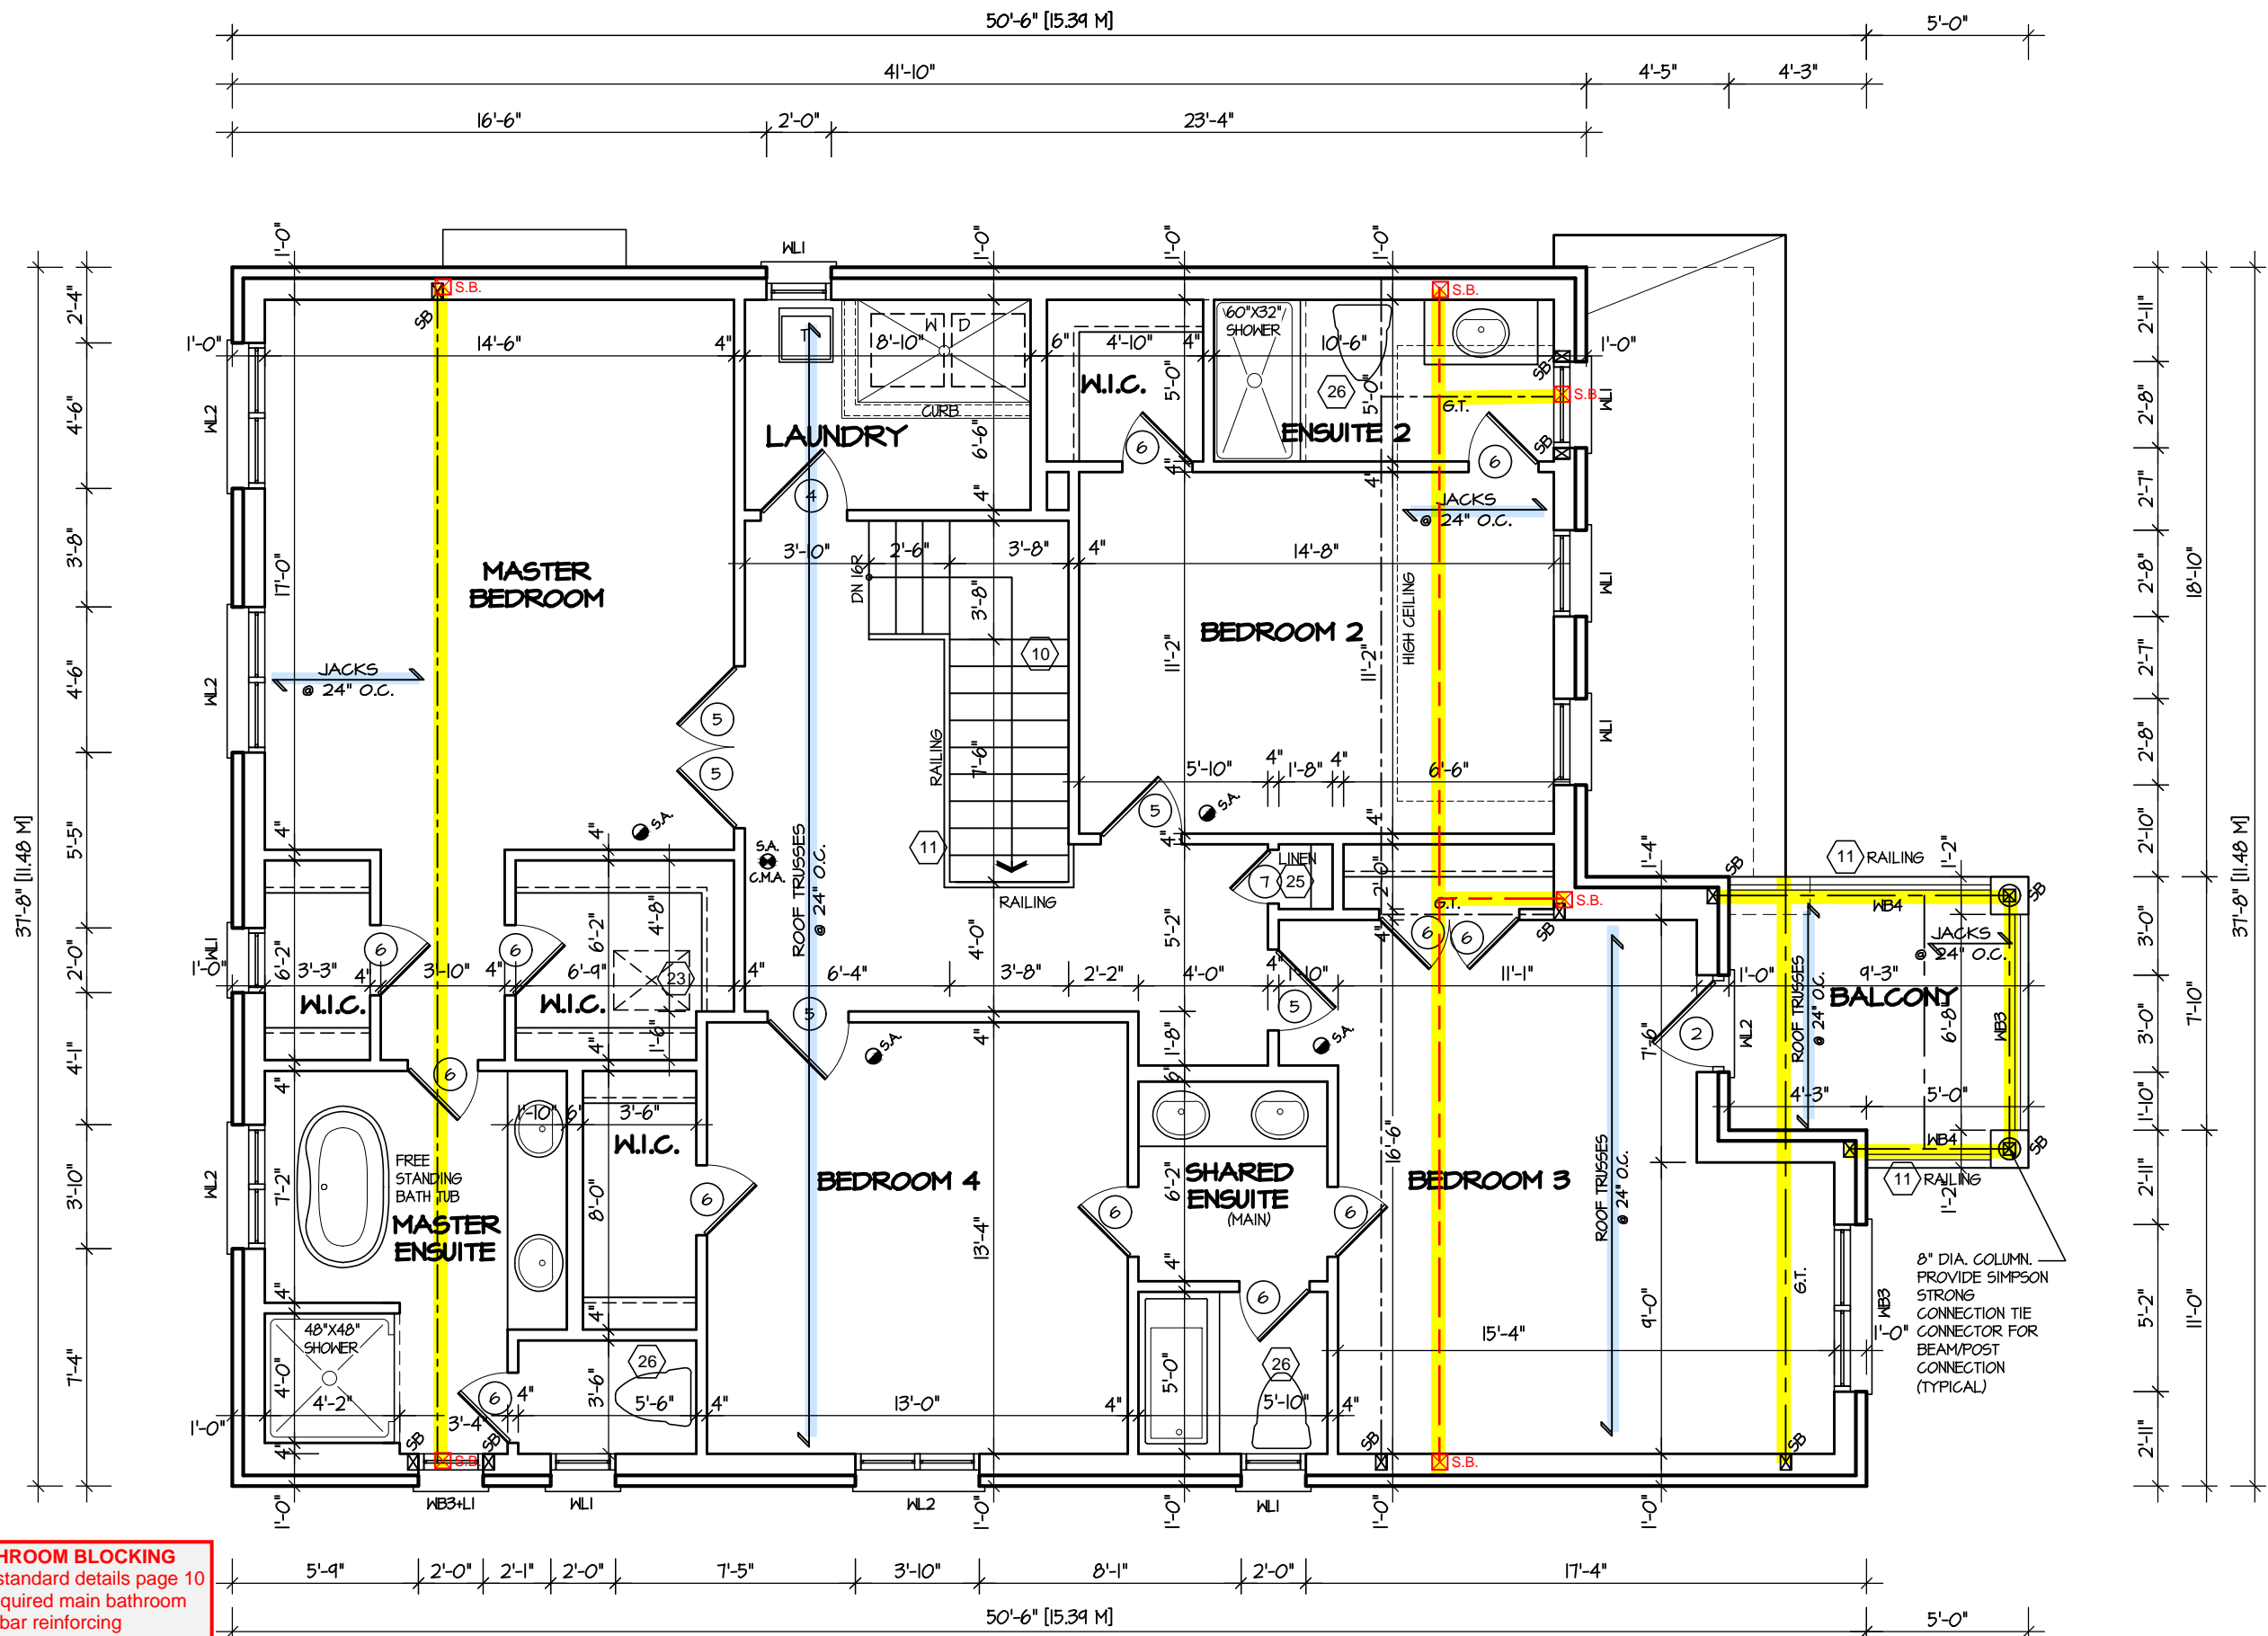

It is the builder's complete responsibility to ensure that all plans submitted for approval fully comply with the Architectural Guidelines and all applicable regulations and requirements including zoning provisions and any provisions in the subdivision agreement. The Control Architect is not responsible in any way for examining or approving site (lotting) plans or working drawings with respect to any zoning or building code or permit matter or that any house can be properly built or located on its lot.

This is to certify that these plans comply with the applicable Architectural Design Guidelines approved by the Town of MILTON.

ARCHITECTURAL REVIEW & APPROVAL
MAR 20 2017
John G. Williams Limited, Architect

JUNIPER 7
ENERGY STAR

5.			The undersigned has reviewed and takes responsibility for this design, and has the qualifications and meets the requirements set out in the Ontario Building Code to be a designer.	REGION DESIGN INC.	REGION DESIGN INC.	SECOND FLOOR PLAN ELEV. 3	CONTRACTOR SHALL CHECK ALL DIMENSIONS AND ELEVATIONS BEFORE COMMENCING WITH WORK AND REPORT ANY DISCREPANCIES TO THE DESIGNER. PRINTS ARE NOT TO BE SCALED.		
4.			QUALIFICATION INFORMATION	8700 DUFFERIN ST.	CONCORD, ONTARIO	SCALE 3/16"=1'-0"	BY V.G.	AREA 3093	PAGE No. 3-3
3.			Required unless design is exempt under Division C, Subsection 3.2.5 of the building code	L4K 456	P (416) 736-4096	DATE JUL 2016	TYPE	PROJECT 02-10-08	
2.				F (905) 660-0746					
1.	ISSUED FOR REVIEW	SEP 2016	VIKAS GAJJAR NAME	28770 SIGNATURE	BCIN				PROJECT NAME LECCO RIDGE
REVISIONS									




RECEIVED
TOWN OF MILTON
MAR 29, 2017
JUNIPER 7
BUILDING DIVISION

TOWN OF MILTON
PLANNING AND DEVELOPMENT
JUNIPER 7 MODEL

BUILDING: REVIEWED
SCOTT SHERRIFFS
PLANS EXAMINER
DATE
APR 13, 2017

Neither the issuance of a permit nor carrying out of inspections by the Town of Milton relieves the owner from full responsibility for compliance with the provisions of the Ontario Building Code Act and the Ontario Building Code, both as amended, as well as other applicable statutes and regulations of the Province of Ontario, By-laws of the Region of Halton and Town of Milton

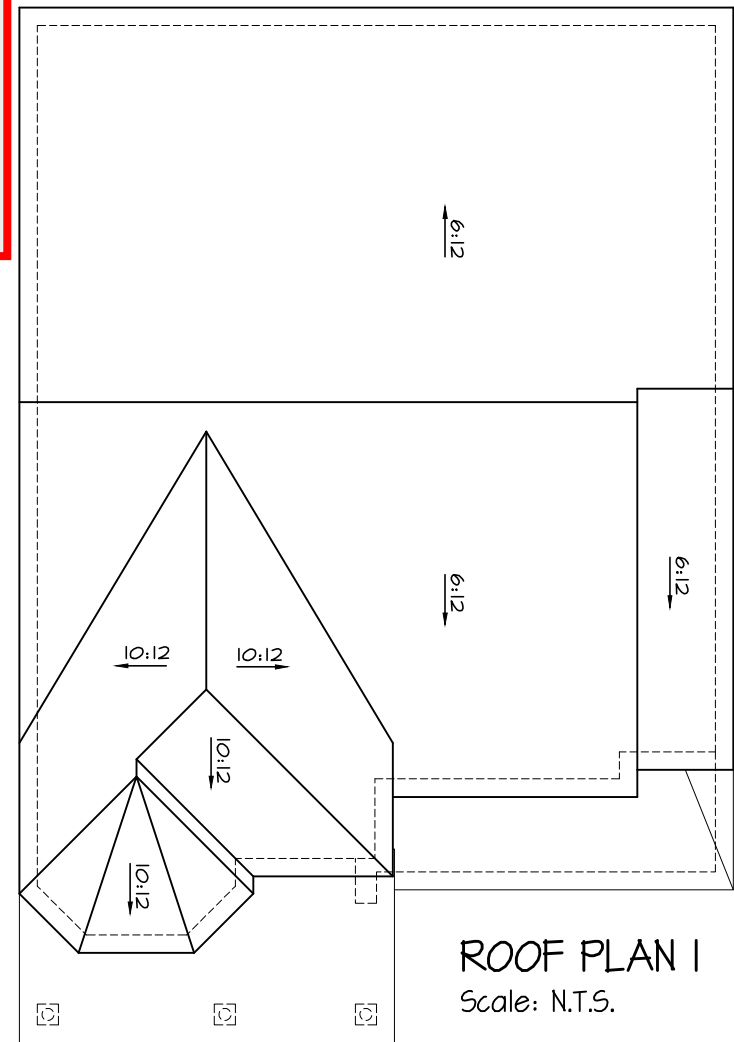

FRONT ELEVATION I

It is the builder's complete responsibility to ensure that all plans submitted for approval fully comply with the Architectural Guidelines and all applicable regulations and requirements including zoning provisions and any provisions in the subdivision agreement. The Control Architect is not responsible in any way for examining or approving site (lotting) plans or working drawings with respect to any zoning or building code or permit matter or that any house can be properly built or located on its lot.

This is to certify that these plans comply with the applicable Architectural Design Guidelines approved by the Town of MILTON.

ARCHITECTURAL REVIEW & APPROVAL
MAR 20 2017
John G. Williams Limited, Architect

JUNIPER 7
ENERGY STAR

5.		<p>The undersigned has reviewed and takes responsibility for this design, and has the qualifications and meets the requirements set out in the Ontario Building Code to be a designer.</p> <p>QUALIFICATION INFORMATION</p> <p>Required unless design is exempt under Division C, Subsection 3.2.5 of the building code</p> <p>VIKAS GAJJAR  28770</p> <p>NAME SIGNATURE BCIN</p>	<p>REGION DESIGN INC.</p> <p>8700 DUFFERIN ST.</p> <p>CONCORD, ONTARIO</p> <p>L4K 4S6</p> <p>P (416) 736-4096</p> <p>F (905) 660-0746</p>	<p>REGION DESIGN INC.</p>	SHEET TITLE		CONTRACTOR SHALL CHECK ALL DIMENSIONS AND ELEVATIONS BEFORE COMMENCING WITH WORK AND REPORT ANY DISCREPANCIES TO THE DESIGNER. PRINTS ARE NOT TO BE SCALED.				
4.					FRONT ELEVATION						
3.					ELEV. 1						
2.					SCALE	BY	AREA	PAGE No.			
1.	ISSUED FOR REVIEW				3/16"=1'-0"	V.G.	3093	4		PROJECT NAME	
REVISIONS		DATE		TYPE		PROJECT		LECCO RIDGE			
		JUL 2016				02-10-08					



March 30, 2017 9:57:34

RECEIVED
TOWN OF MILTON
MAR 29, 2017
JUNIPER 7
BUILDING DIVISION

TOWN OF MILTON
PLANNING AND DEVELOPMENT
JUNIPER 7 MODEL

BUILDING: REVIEWED
SCOTT SHERRIFFS
PLANS EXAMINER
DATE
APR 13, 2017

Neither the issuance of a permit nor carrying out of inspections by the Town of Milton relieves the owner from full responsibility for compliance with the provisions of the Ontario Building Code Act and the Ontario Building Code, both as amended, as well as other applicable statutes and regulations of the Province of Ontario, By-laws of the Region of Halton and Town of Milton

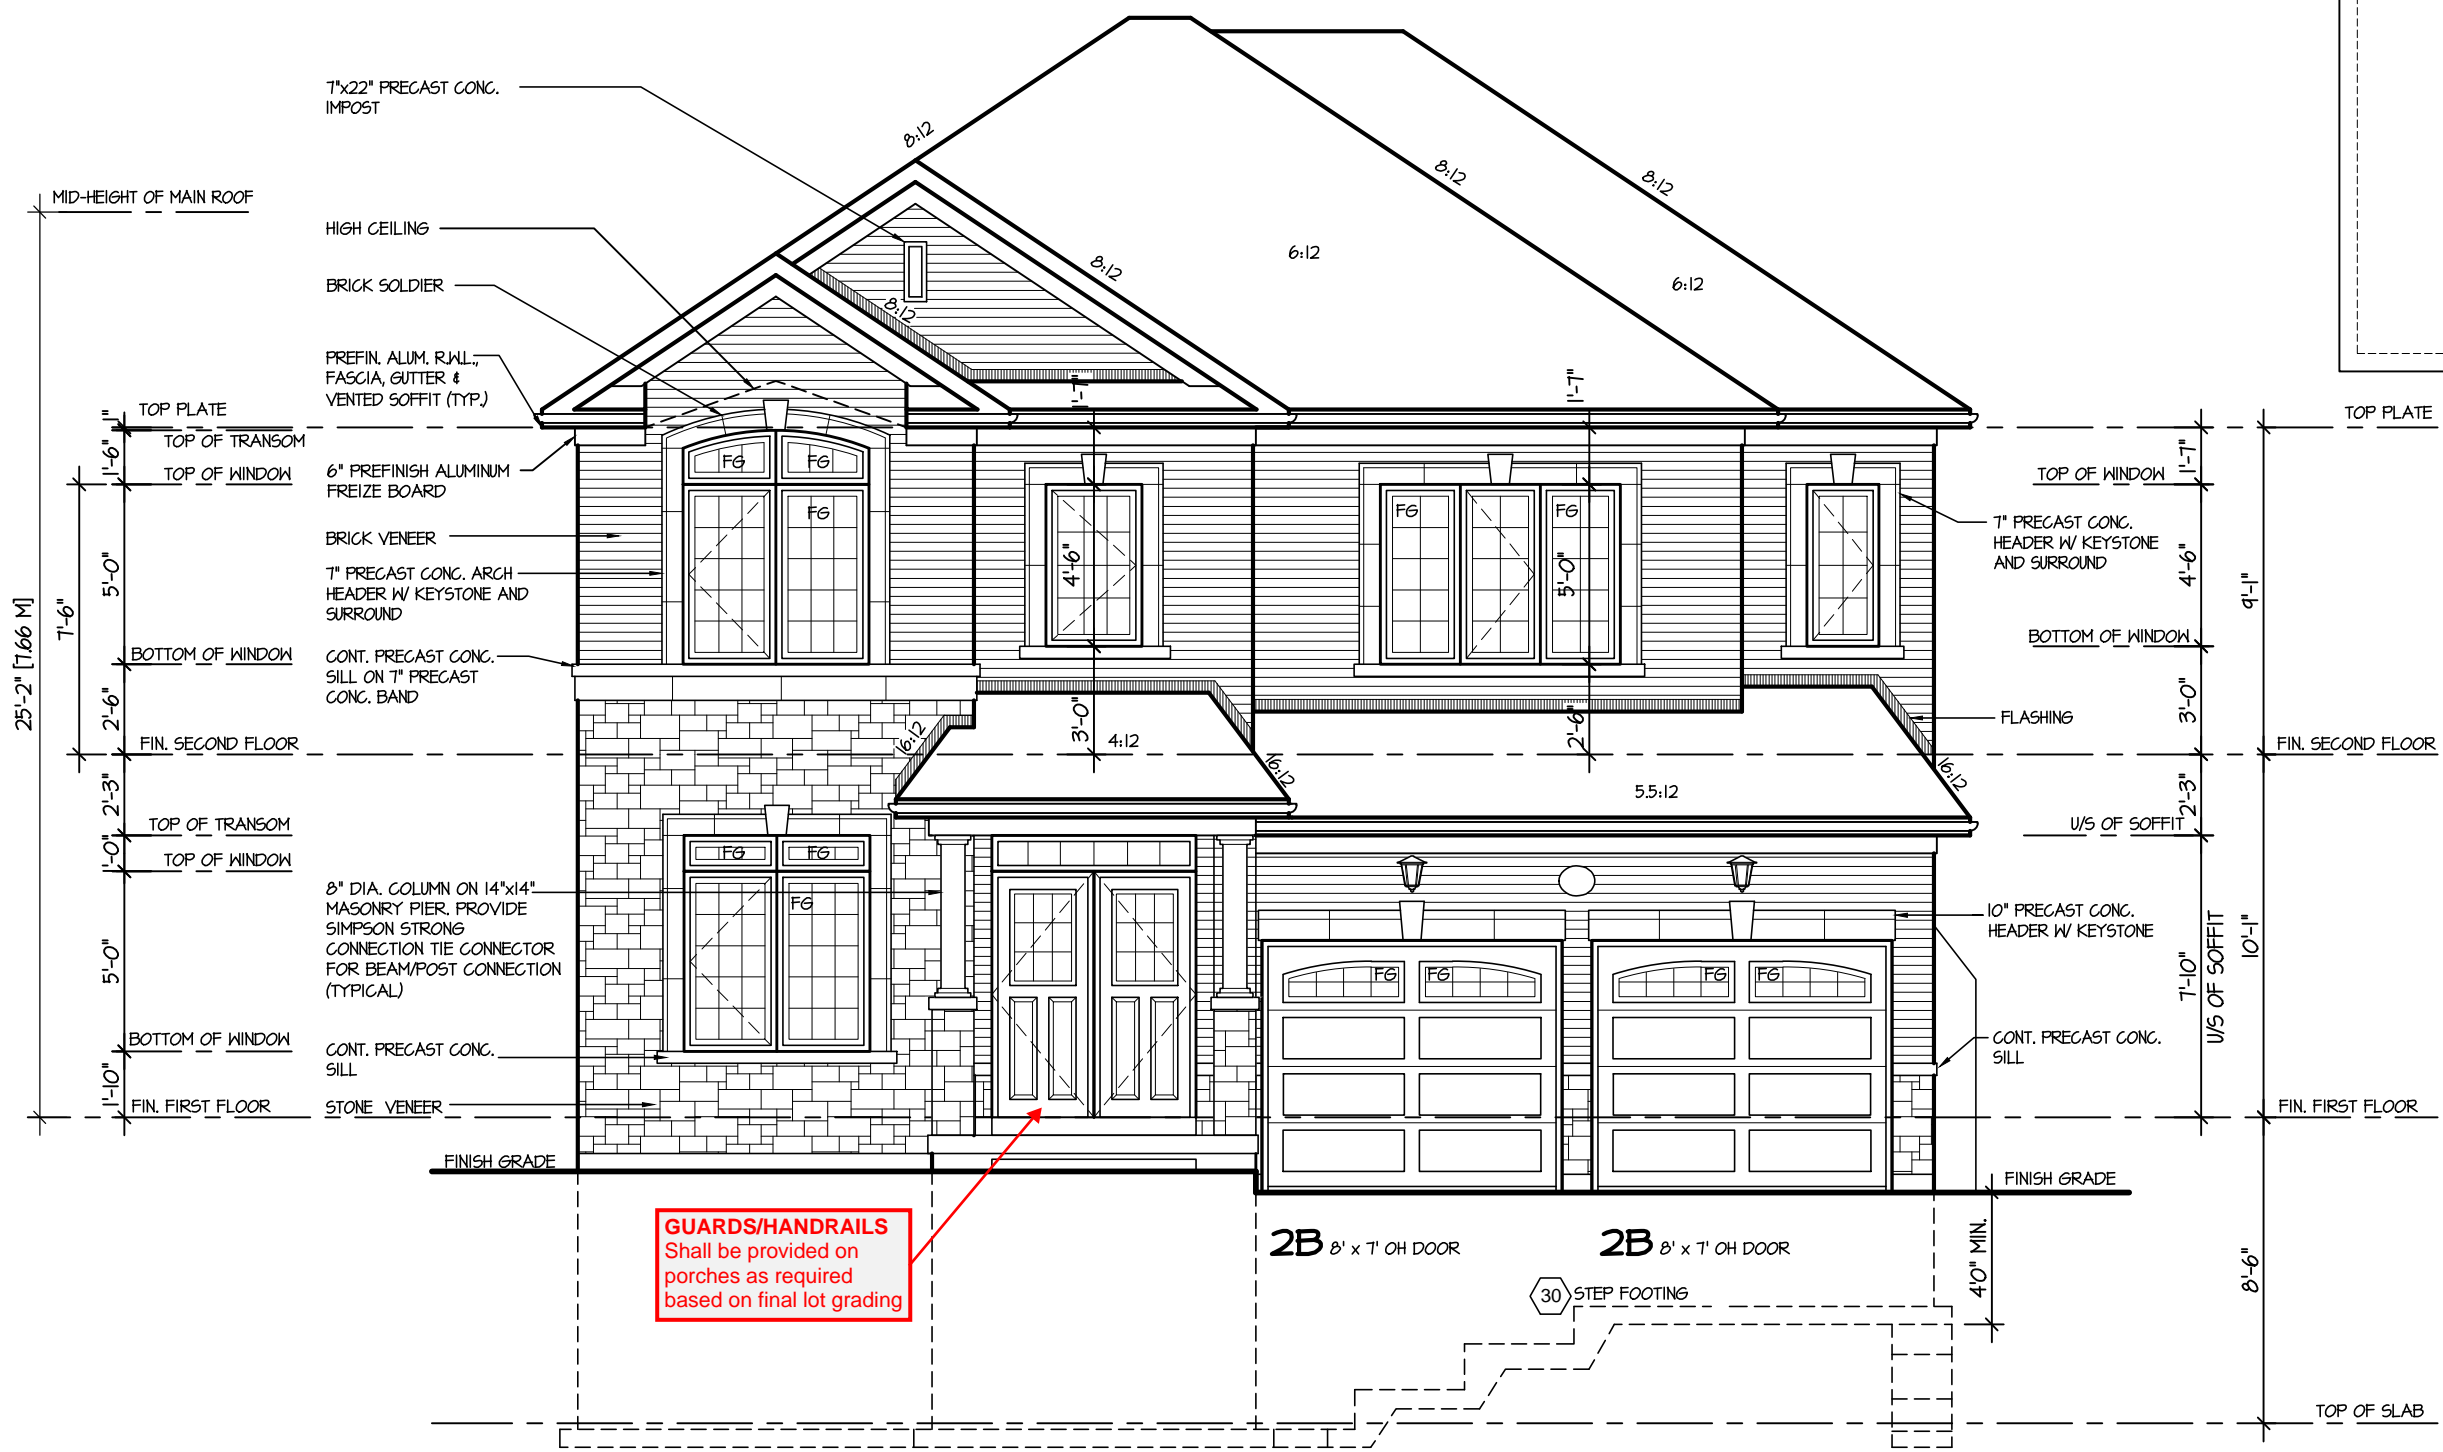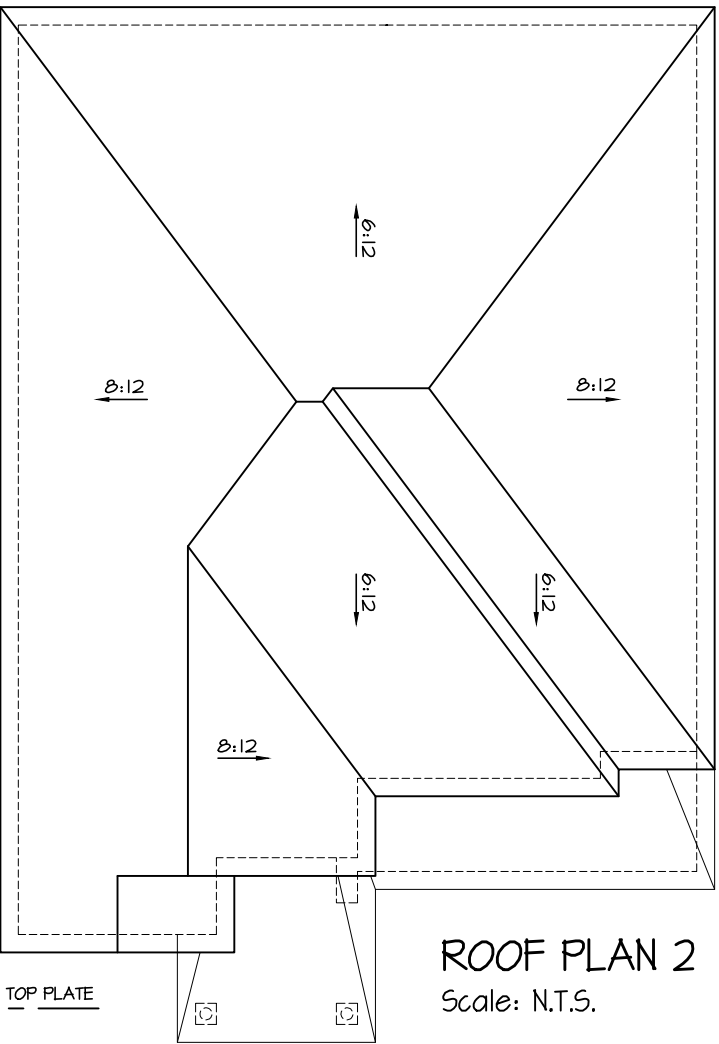

It is the builder's complete responsibility to ensure that all plans submitted for approval fully comply with the Architectural Guidelines and all applicable regulations and requirements including zoning provisions and any provisions in the subdivision agreement. The Control Architect is not responsible in any way for examining or approving site (lotting) plans or working drawings with respect to any zoning or building code or permit matter or that any house can be properly built or located on its lot.

This is to certify that these plans comply with the applicable Architectural Design Guidelines approved by the Town of MILTON.

ARCHITECTURAL REVIEW & APPROVAL
MAR 20 2017
John G. Williams Limited, Architect

JUNIPER 7
ENERGY STAR

5.		
4.		
3.		
2.		
1.	ISSUED FOR REVIEW	SEP 2016
REVISIONS		

The undersigned has reviewed and takes responsibility for this design, and has the qualifications and meets the requirements set out in the Ontario Building Code to be a designer.

QUALIFICATION INFORMATION
Required unless design is exempt under Division C, Subsection 3.2.5 of the building code

VIKAS GAJJAR
NAME
SIGNATURE
28770
BCIN

REGION DESIGN INC.
8700 DUFFERIN ST.
CONCORD, ONTARIO
L4K 4S6
P (416) 736-4096
F (905) 660-0746

**REGION
DESIGN
INC.**

SHEET TITLE
**FRONT
ELEVATION 2**

SCALE
3/16"=1'-0"

DATE
JUL 2016

BY
V.G.

TYPE

CONTRACTOR SHALL CHECK ALL DIMENSIONS AND ELEVATIONS BEFORE COMMENCING WITH WORK AND REPORT ANY DISCREPANCIES TO THE DESIGNER. PRINTS ARE NOT TO BE SCALED.

AREA
3093

PAGE No.
4-2



PROJECT
02-10-08

Greenpark.

PROJECT NAME
LECCO RIDGE

RECEIVED
TOWN OF MILTON
MAR 29, 2017
JUNIPER 7
BUILDING DIVISION

TOWN OF MILTON
PLANNING AND DEVELOPMENT
JUNIPER 7 MODEL
BUILDING: REVIEWED
SCOTT SHERRIFFS
APR 13, 2017
PLANS EXAMINER
DATE
Neither the issuance of a permit nor carrying out of inspections by the Town of Milton relieves the owner from full responsibility for compliance with the provisions of the Ontario Building Code Act and the Ontario Building Code, both as amended, as well as other applicable statutes and regulations of the Province of Ontario, By-laws of the Region of Halton and Town of Milton

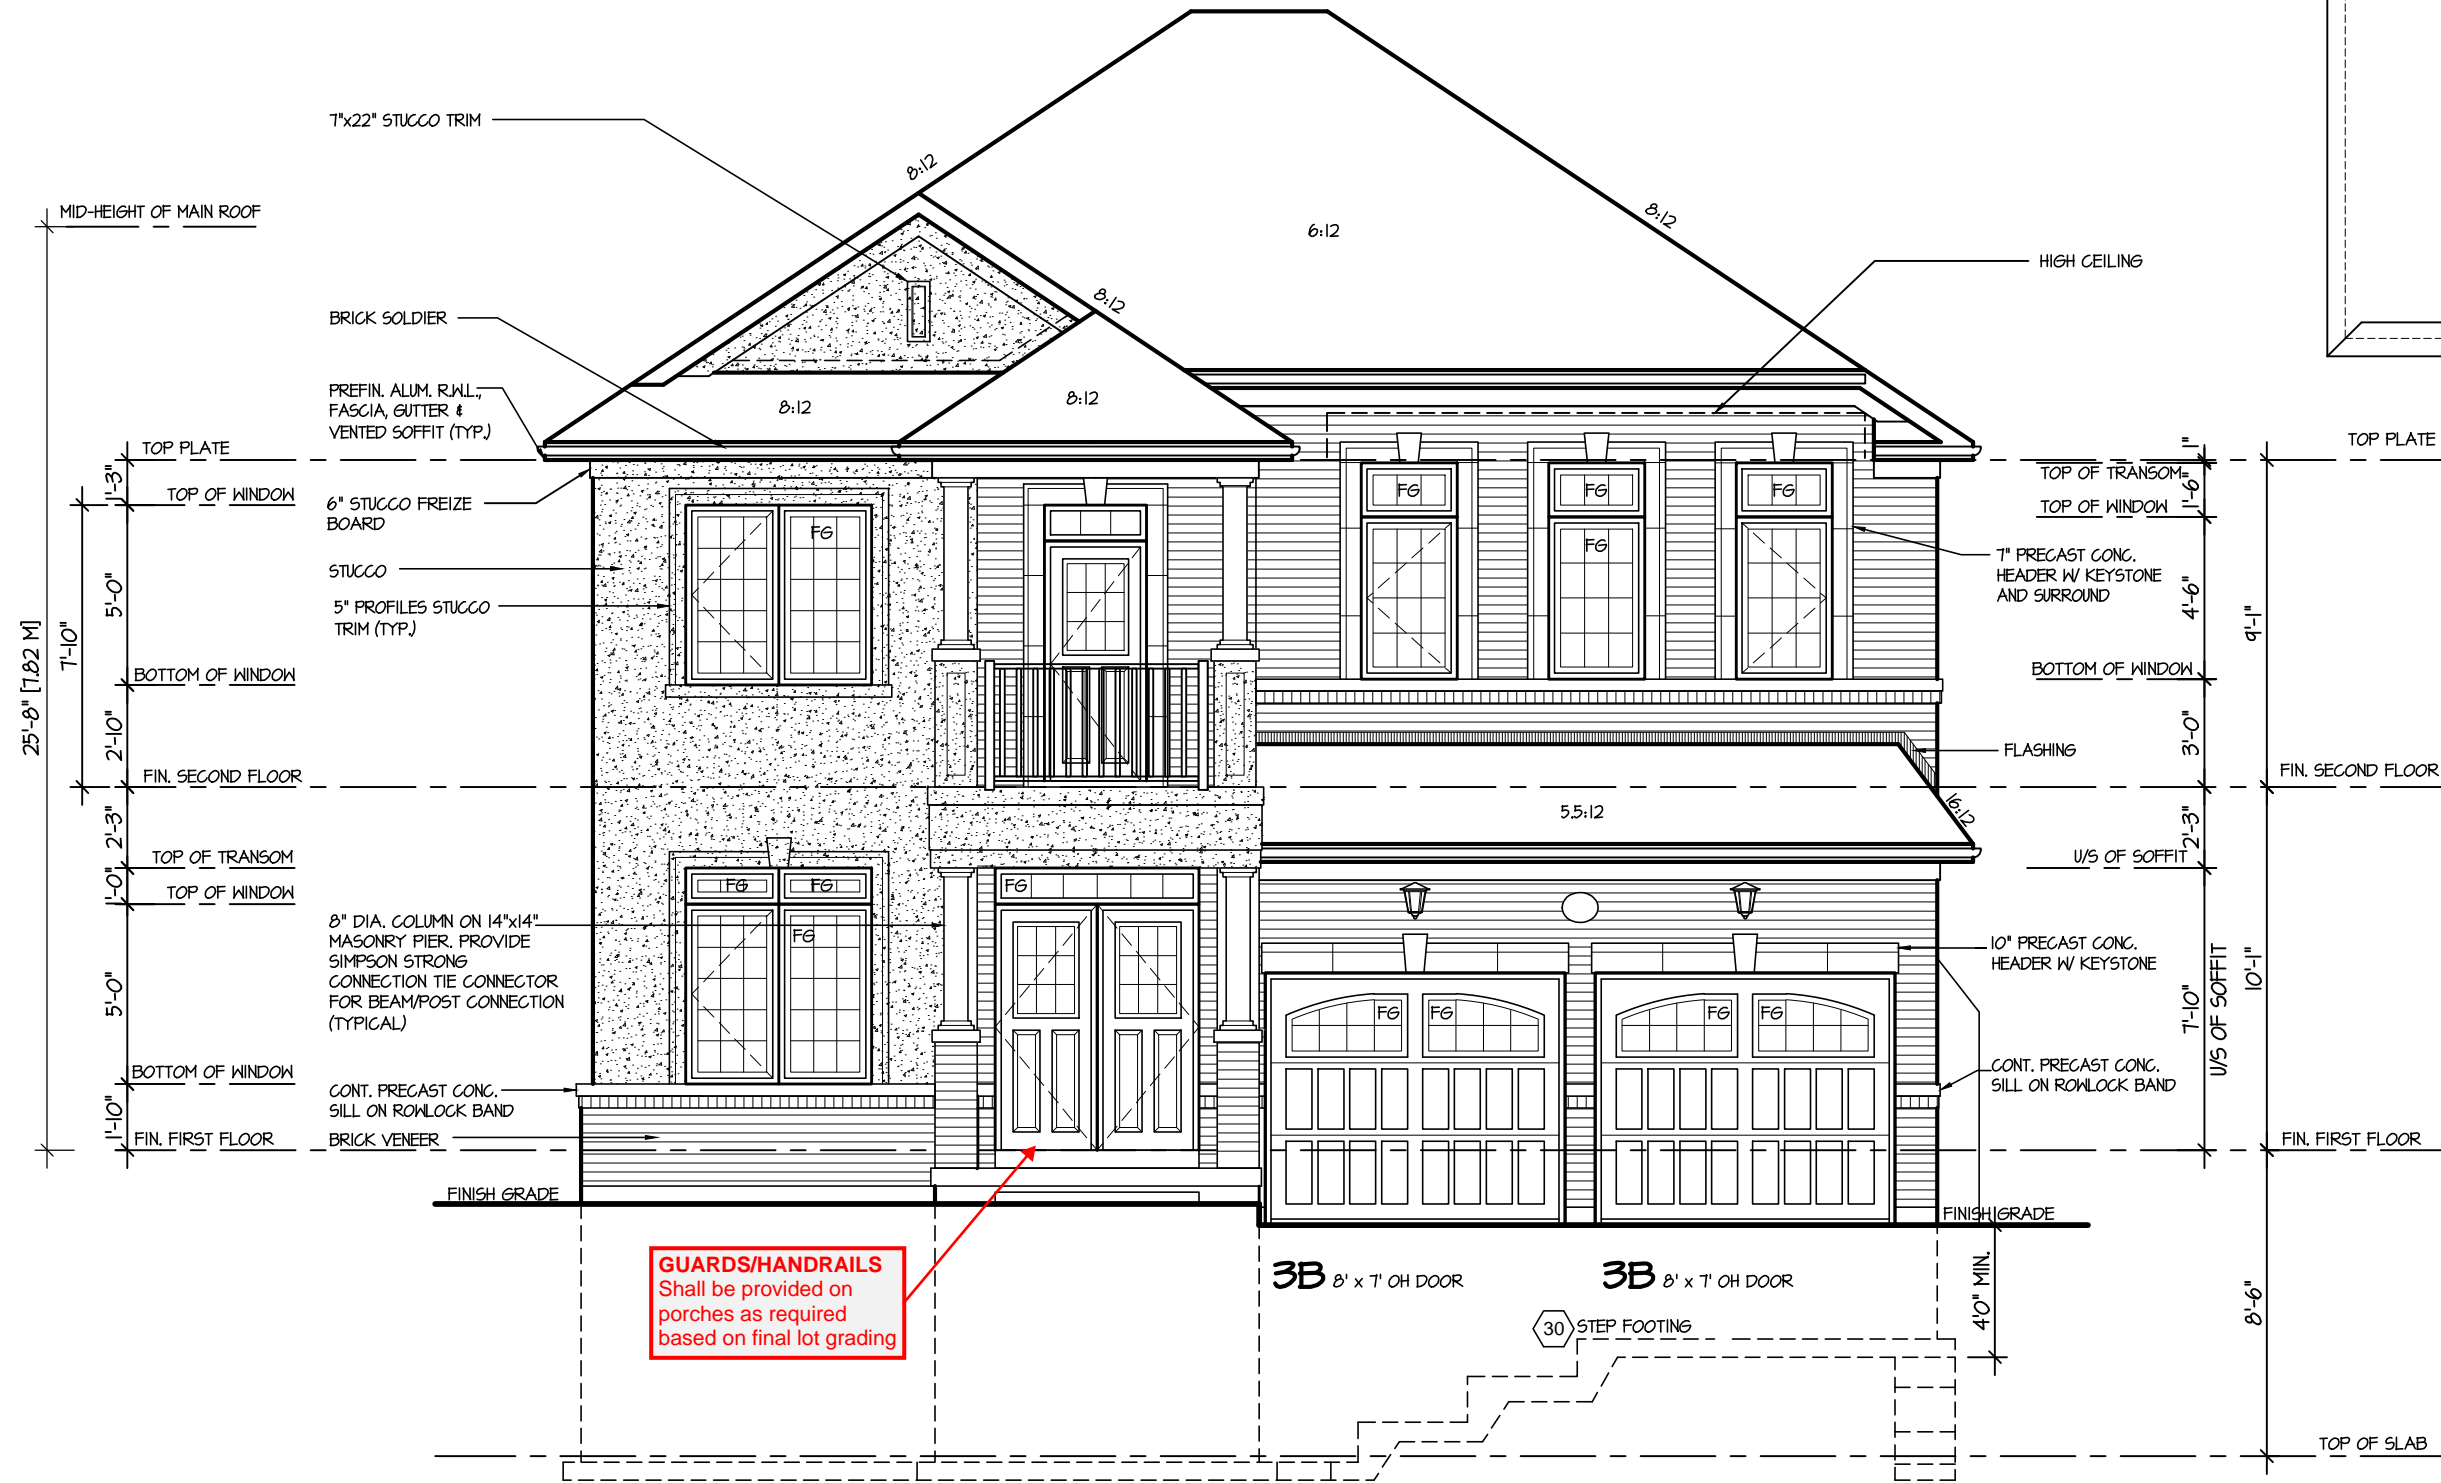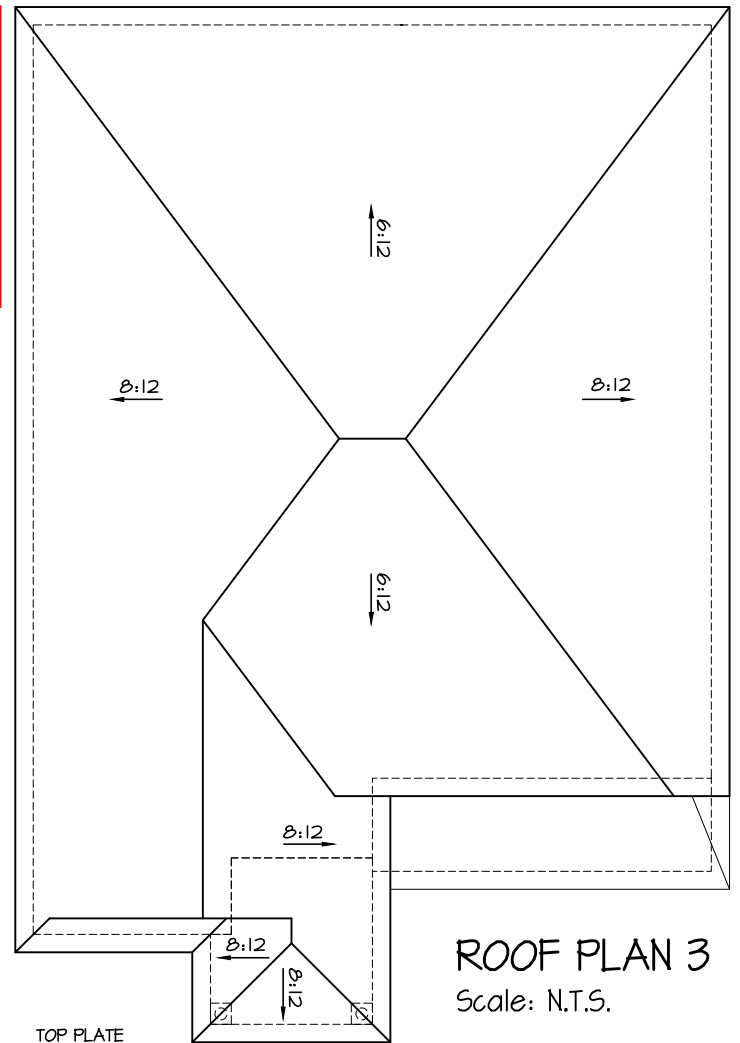

FRONT ELEVATION 3

It is the builder's complete responsibility to ensure that all plans submitted for approval fully comply with the Architectural Guidelines and all applicable regulations and requirements including zoning provisions and any provisions in the subdivision agreement. The Control Architect is not responsible in any way for examining or approving site (lotting) plans or working drawings with respect to any zoning or building code or permit matter or that any house can be properly built or located on its lot.

This is to certify that these plans comply with the applicable Architectural Design Guidelines approved by the Town of MILTON.

ARCHITECTURAL REVIEW & APPROVAL
MAR 20 2017
John G. Williams Limited, Architect

JUNIPER 7
ENERGY STAR

5.		
4.		
3.		
2.		
1.	ISSUED FOR REVIEW	SEP 2016
REVISIONS		

The undersigned has reviewed and takes responsibility for this design, and has the qualifications and meets the requirements set out in the Ontario Building Code to be a designer.		
QUALIFICATION INFORMATION		
Required unless design is exempt under Division C, Subsection 3.2.5 of the building code		
VIKAS GAJJAR	28770	
NAME	SIGNATURE	BCIN

REGION DESIGN INC.
8700 DUFFERIN ST.
CONCORD, ONTARIO
L4K 4S6
P (416) 736-4096
F (905) 660-0746


REGION
DESIGN
INC.

SHEET TITLE FRONT ELEVATION 3	
SCALE 3/16"=1'-0"	BY V.G.
DATE JUL 2016	TYPE

CONTRACTOR SHALL CHECK ALL DIMENSIONS AND ELEVATIONS BEFORE COMMENCING WITH WORK AND REPORT ANY DISCREPANCIES TO THE DESIGNER. PRINTS ARE NOT TO BE SCALED.	
AREA 3093	PAGE No. 4-3
PROJECT 02-10-08	

PROJECT NAME LECCO RIDGE	

RECEIVED
TOWN OF MILTON
MAR 29, 2017
JUNIPER 7
BUILDING DIVISION

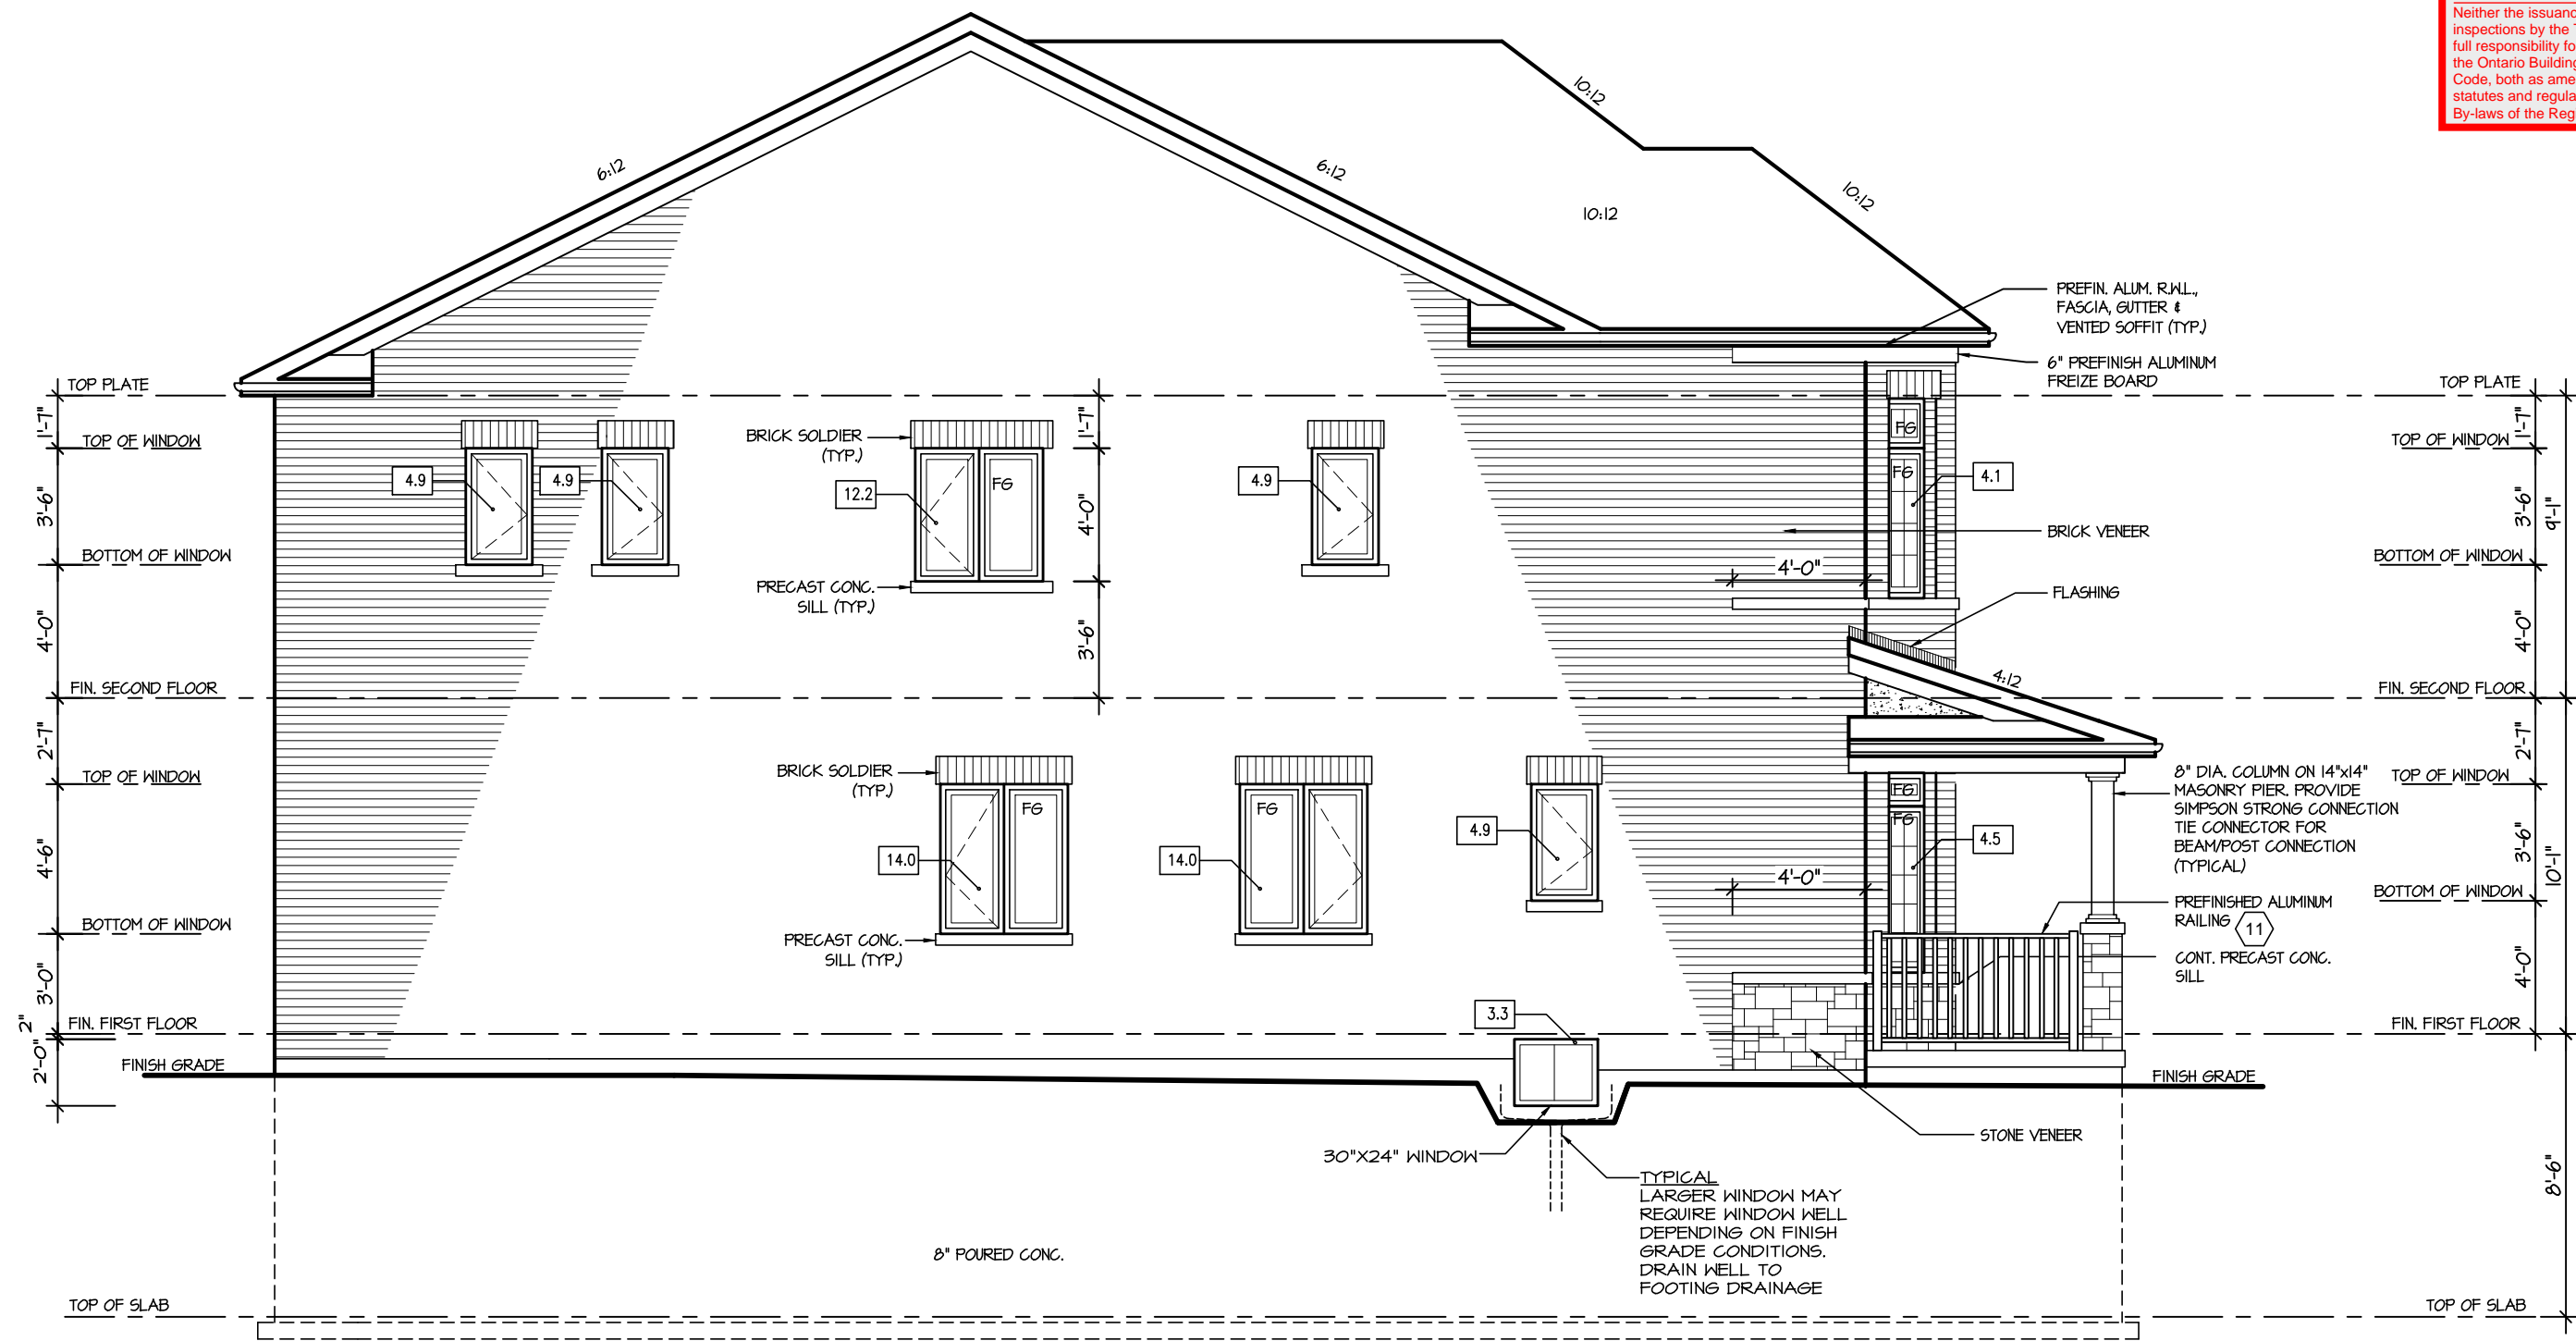

LEFT ELEVATION 1

ALLOWABLE GLAZING (STANDARD PLAN)			
WALL AREA	=	1039	Sq. Ft.
ALLOWABLE GLAZED AREA @ 7% 1.2 M SIDE YARD	=	72.73	Sq. Ft.
ACTUAL GLAZED AREA	=	71.7	Sq. Ft.

It is the builder's complete responsibility to ensure that all plans submitted for approval fully comply with the Architectural Guidelines and all applicable regulations and requirements including zoning provisions and any provisions in the subdivision agreement. The Control Architect is not responsible in any way for examining or approving site (lotting) plans or working drawings with respect to any zoning or building code or permit matter or that any house can be properly built or located on its lot.


This is to certify that these plans comply with the applicable Architectural Design Guidelines approved by the Town of MILTON.

ARCHITECTURAL REVIEW & APPROVAL
MAR 20 2017
John G. Williams Limited, Architect

JUNIPER 7
ENERGY STAR

5.		<p>The undersigned has reviewed and takes responsibility for this design, and has the qualifications and meets the requirements set out in the Ontario Building Code to be a designer.</p> <p>QUALIFICATION INFORMATION</p> <p>Required unless design is exempt under Division C, Subsection 3.2.5 of the building code</p> <p>VIKAS GAJJAR NAME SIGNATURE 28770 BCIN</p>	<p>REGION DESIGN INC. 8700 DUFFERIN ST. CONCORD, ONTARIO L4K 4S6 P (416) 736-4096 F (905) 660-0746</p>	<p>REGION DESIGN INC.</p>	SHEET TITLE LEFT SIDE ELEVATION ELEV. 1		CONTRACTOR SHALL CHECK ALL DIMENSIONS AND ELEVATIONS BEFORE COMMENCING WITH WORK AND REPORT ANY DISCREPANCIES TO THE DESIGNER. PRINTS ARE NOT TO BE SCALED.		<p>Greenpark.</p> <p>PROJECT NAME LECCO RIDGE</p>
4.					SCALE 3/16"=1'-0"	BY V.G.	AREA 3093	PAGE No. 5	
3.					DATE JUL 2016	TYPE	PROJECT 02-10-08		
2.									
1.	ISSUED FOR REVIEW	SEP 2016							
REVISIONS									

RECEIVED
TOWN OF MILTON
MAR 29, 2017
JUNIPER 7
BUILDING DIVISION

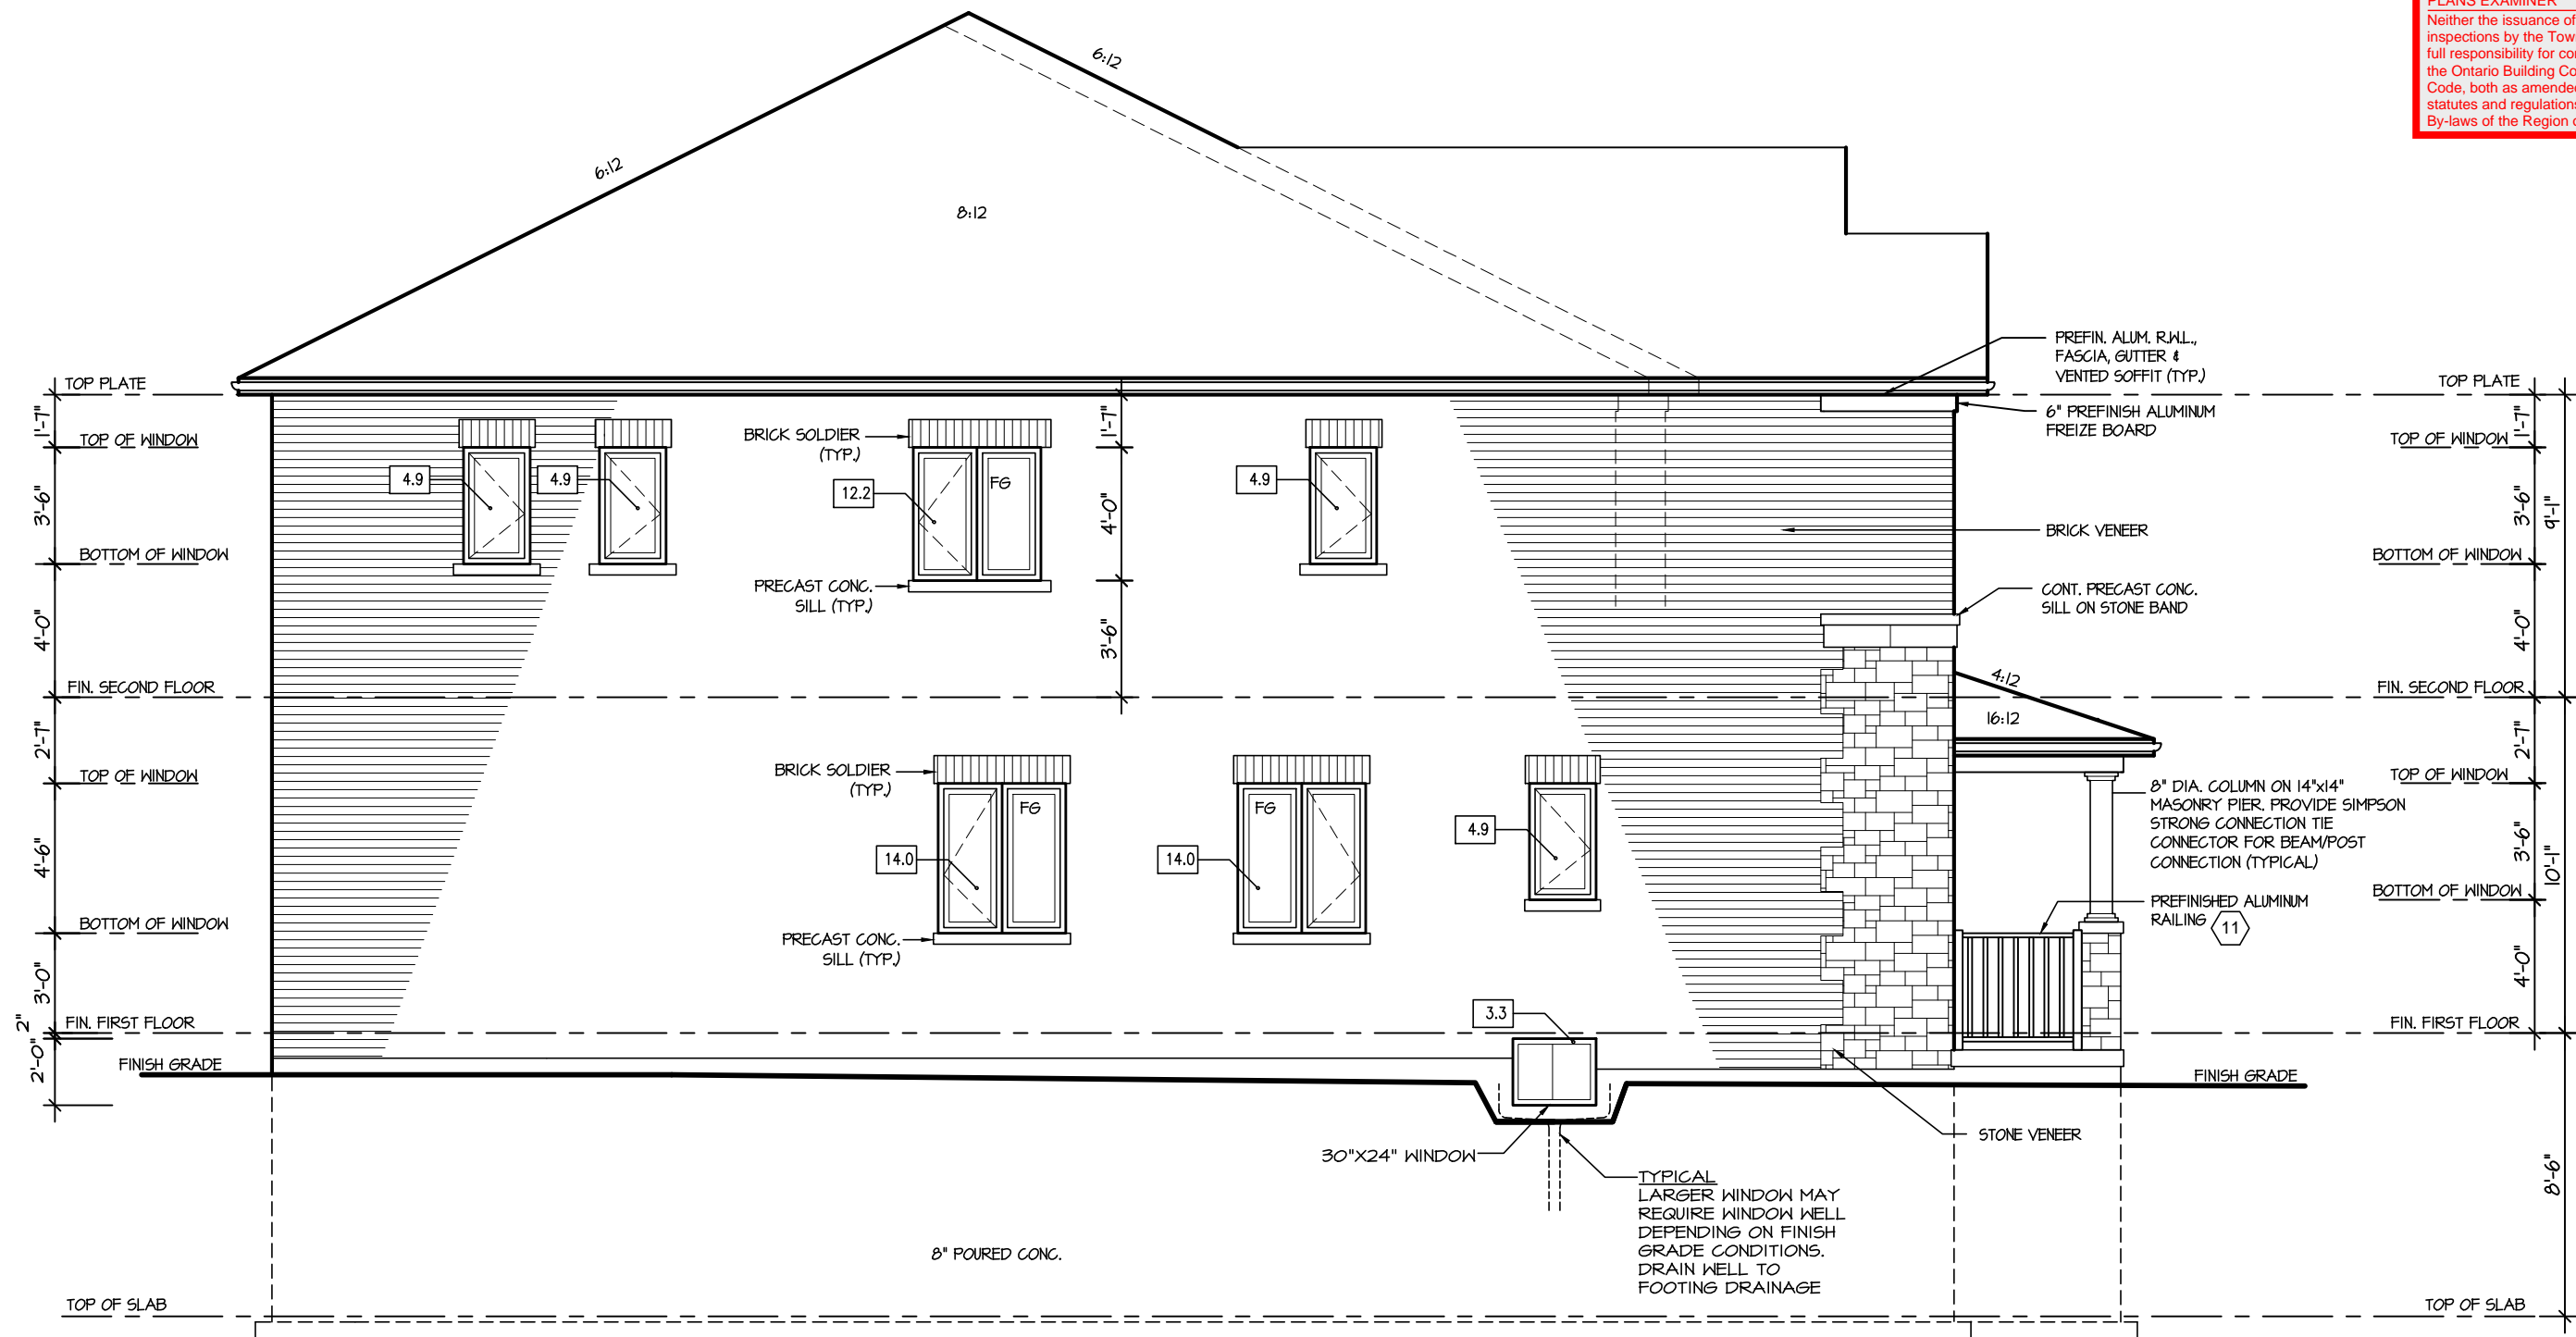

LEFT ELEVATION 2

ALLOWABLE GLAZING (STANDARD PLAN)			
WALL AREA	=	1039	Sq. Ft.
ALLOWABLE GLAZED AREA @ 1 % 1.2 M SIDE YARD	=	12.73	Sq. Ft.
ACTUAL GLAZED AREA	=	63.1	Sq. Ft.

It is the builder's complete responsibility to ensure that all plans submitted for approval fully comply with the Architectural Guidelines and all applicable regulations and requirements including zoning provisions and any provisions in the subdivision agreement. The Control Architect is not responsible in any way for examining or approving site (lotting) plans or working drawings with respect to any zoning or building code or permit matter or that any house can be properly built or located on its lot.


This is to certify that these plans comply with the applicable Architectural Design Guidelines approved by the Town of MILTON.

ARCHITECTURAL REVIEW & APPROVAL
MAR 20 2017
John G. Williams Limited, Architect

JUNIPER 7
ENERGY STAR

5.			The undersigned has reviewed and takes responsibility for this design, and has the qualifications and meets the requirements set out in the Ontario Building Code to be a designer. QUALIFICATION INFORMATION Required unless design is exempt under Division C, Subsection 3.2.5 of the building code	REGION DESIGN INC. 8700 DUFFERIN ST. CONCORD, ONTARIO L4K 4S6 P (416) 736-4096 F (905) 660-0746		SHEET TITLE		LEFT SIDE ELEVATION 2		CONTRACTOR SHALL CHECK ALL DIMENSIONS AND ELEVATIONS BEFORE COMMENCING WITH WORK AND REPORT ANY DISCREPANCIES TO THE DESIGNER. PRINTS ARE NOT TO BE SCALED.					
4.							SCALE	3/16"=1'-0"	BY	V.G.	AREA		3093	PAGE No.	PROJECT NAME LECCO RIDGE
3.							DATE	JUL 2016	TYPE		PROJECT		02-10-08	5-2	
2.															
1.	ISSUED FOR REVIEW	SEP 2016	VIKAS GAJJAR  NAME SIGNATURE BCIN			28770									
REVISIONS															

RECEIVED
TOWN OF MILTON
MAR 29, 2017
JUNIPER 7
BUILDING DIVISION

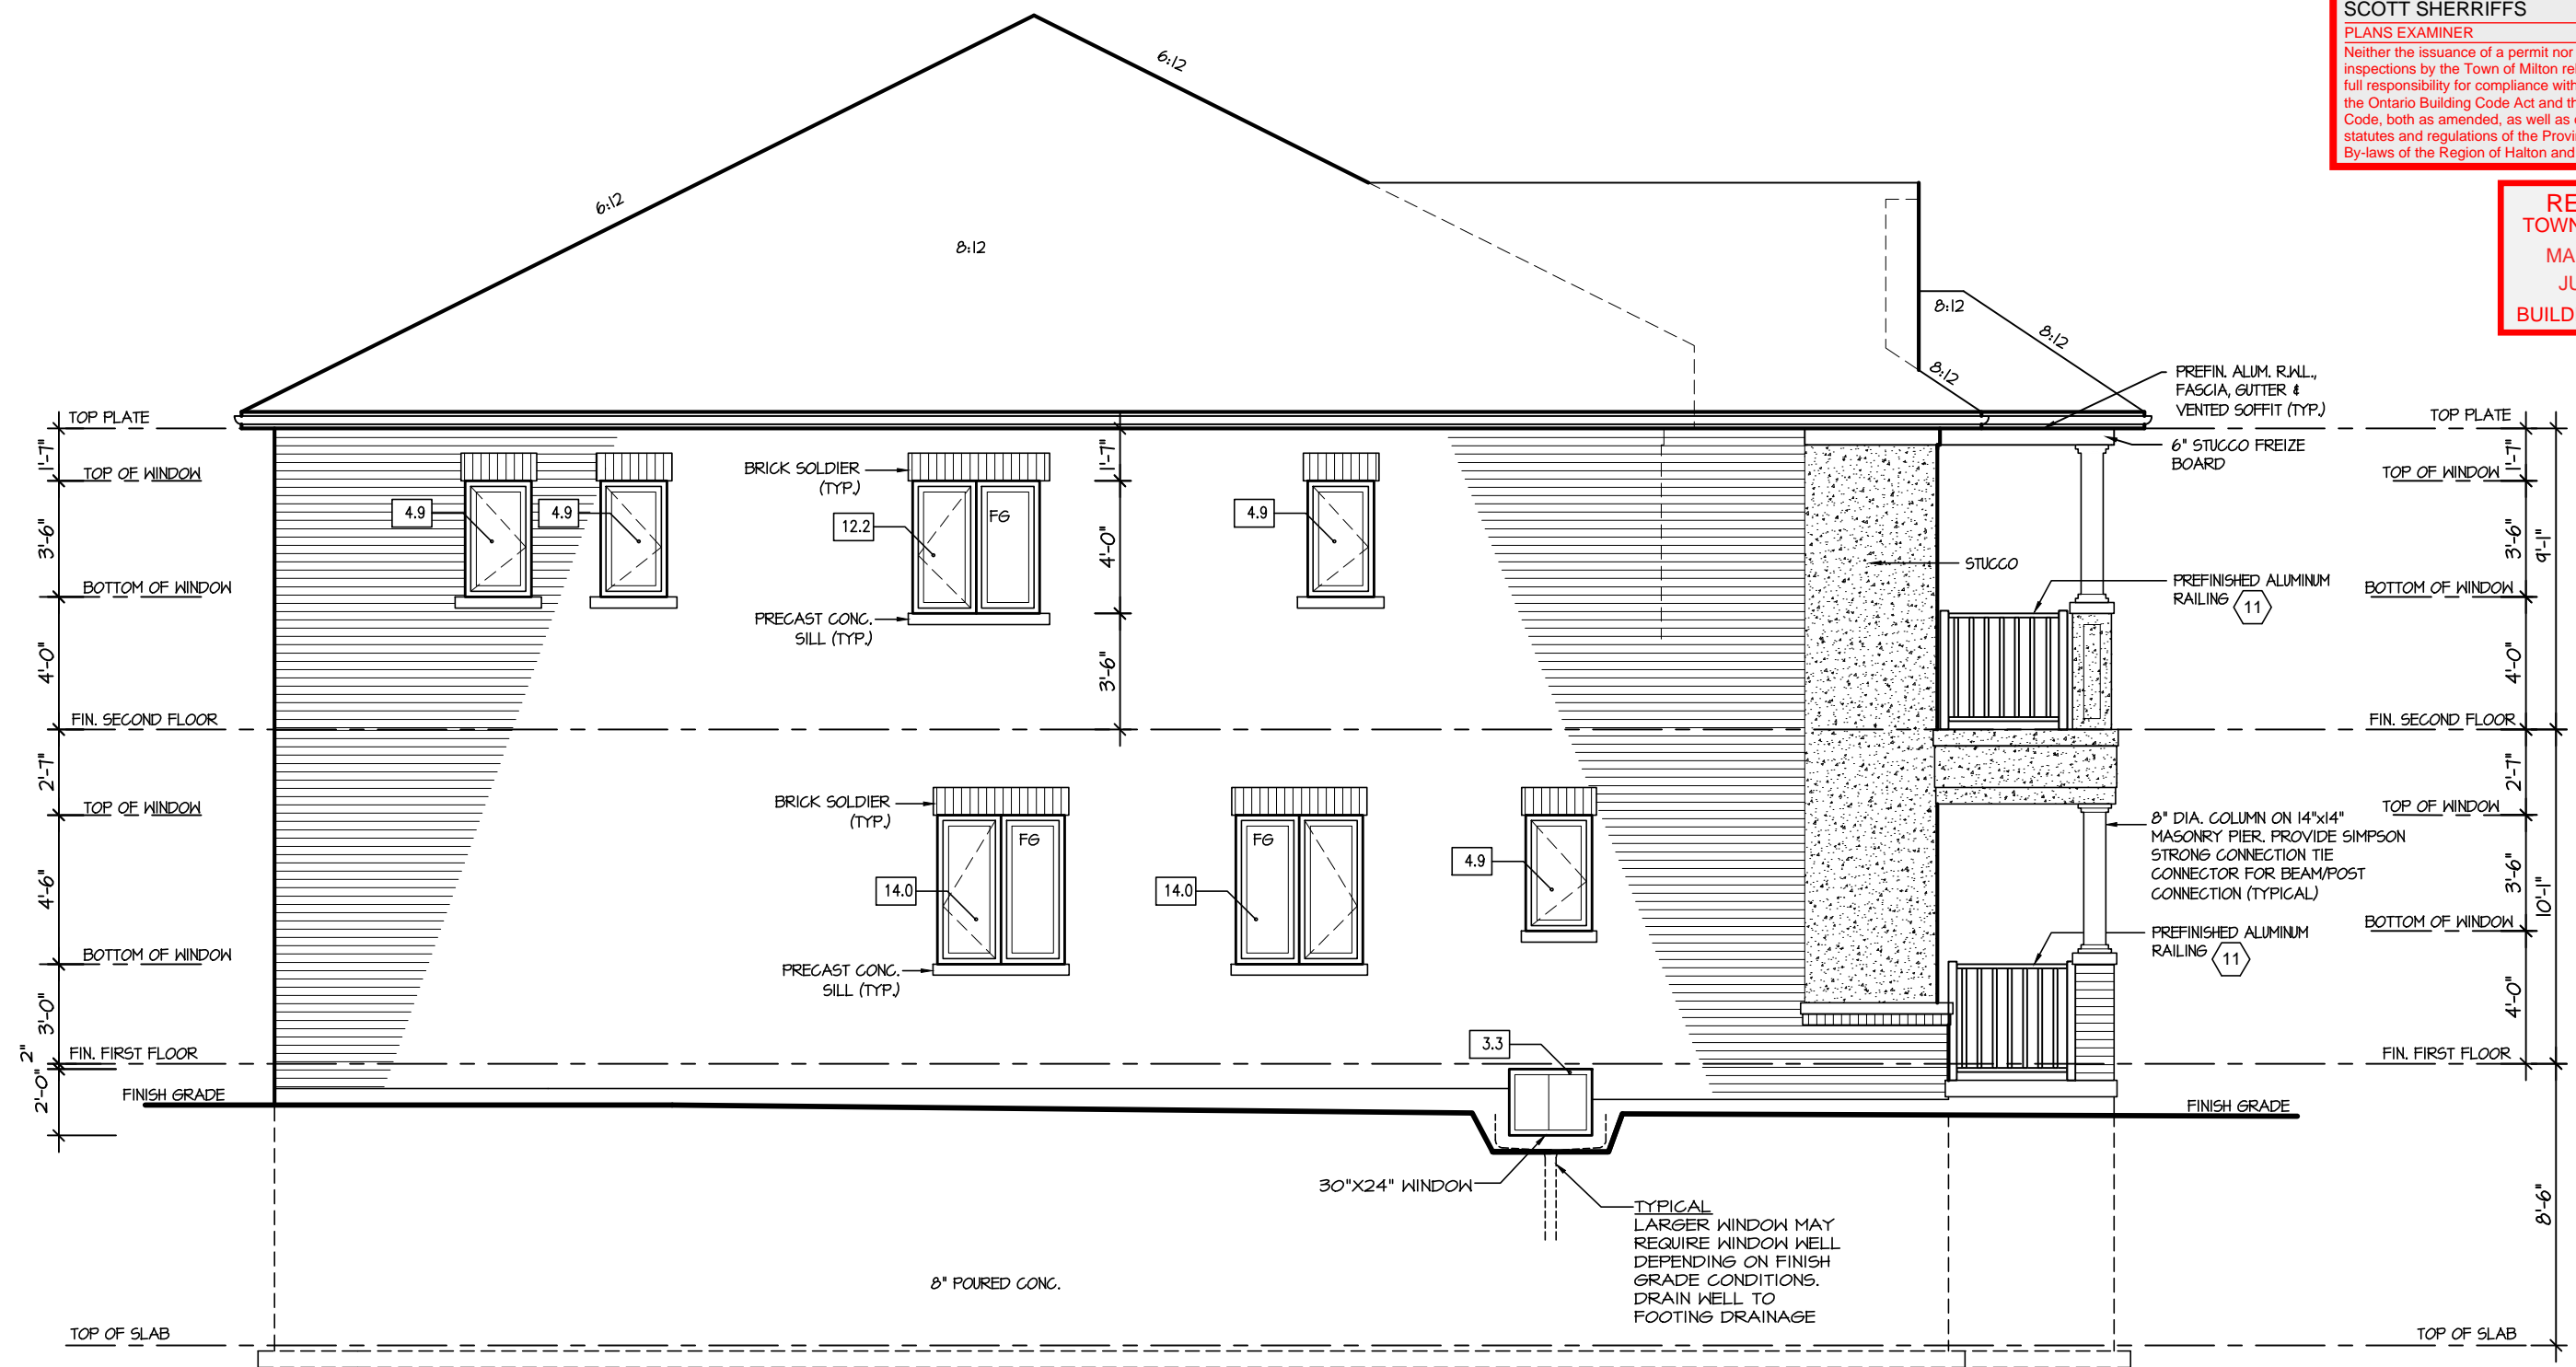

LEFT ELEVATION 3

ALLOWABLE GLAZING (STANDARD PLAN)			
WALL AREA	=	1034	Sq. Ft.
ALLOWABLE GLAZED AREA @ 1 % 1.2 M SIDE YARD	=	12.73	Sq. Ft.
ACTUAL GLAZED AREA	=	63.1	Sq. Ft.

It is the builder's complete responsibility to ensure that all plans submitted for approval fully comply with the Architectural Guidelines and all applicable regulations and requirements including zoning provisions and any provisions in the subdivision agreement. The Control Architect is not responsible in any way for examining or approving site (lotting) plans or working drawings with respect to any zoning or building code or permit matter or that any house can be properly built or located on its lot.

This is to certify that these plans comply with the applicable Architectural Design Guidelines approved by the Town of MILTON.

ARCHITECTURAL REVIEW & APPROVAL
MAR 20 2017
John G. Williams Limited, Architect

JUNIPER 7
ENERGY STAR

5.		
4.		
3.		
2.		
1.	ISSUED FOR REVIEW	SEP 2016
REVISIONS		

The undersigned has reviewed and takes responsibility for this design, and has the qualifications and meets the requirements set out in the Ontario Building Code to be a designer.

QUALIFICATION INFORMATION
Required unless design is exempt under Division C, Subsection 3.2.5 of the building code

VIKAS GAJJAR
NAME
SIGNATURE
28770
BCIN

REGION DESIGN INC.
8700 DUFFERIN ST.
CONCORD, ONTARIO
L4K 4S6
P (416) 736-4096
F (905) 660-0746

REGION DESIGN INC.

SHEET TITLE
LEFT SIDE ELEVATION 3

SCALE
3/16"=1'-0"

DATE
JUL 2016

BY
V.G.

TYPE

CONTRACTOR SHALL CHECK ALL DIMENSIONS AND ELEVATIONS BEFORE COMMENCING WITH WORK AND REPORT ANY DISCREPANCIES TO THE DESIGNER. PRINTS ARE NOT TO BE SCALED.

AREA
3093


PAGE No.
5-3

PROJECT
02-10-08

Greenpark.

PROJECT NAME
LECCO RIDGE

RECEIVED
TOWN OF MILTON
MAR 29, 2017
JUNIPER 7
BUILDING DIVISION

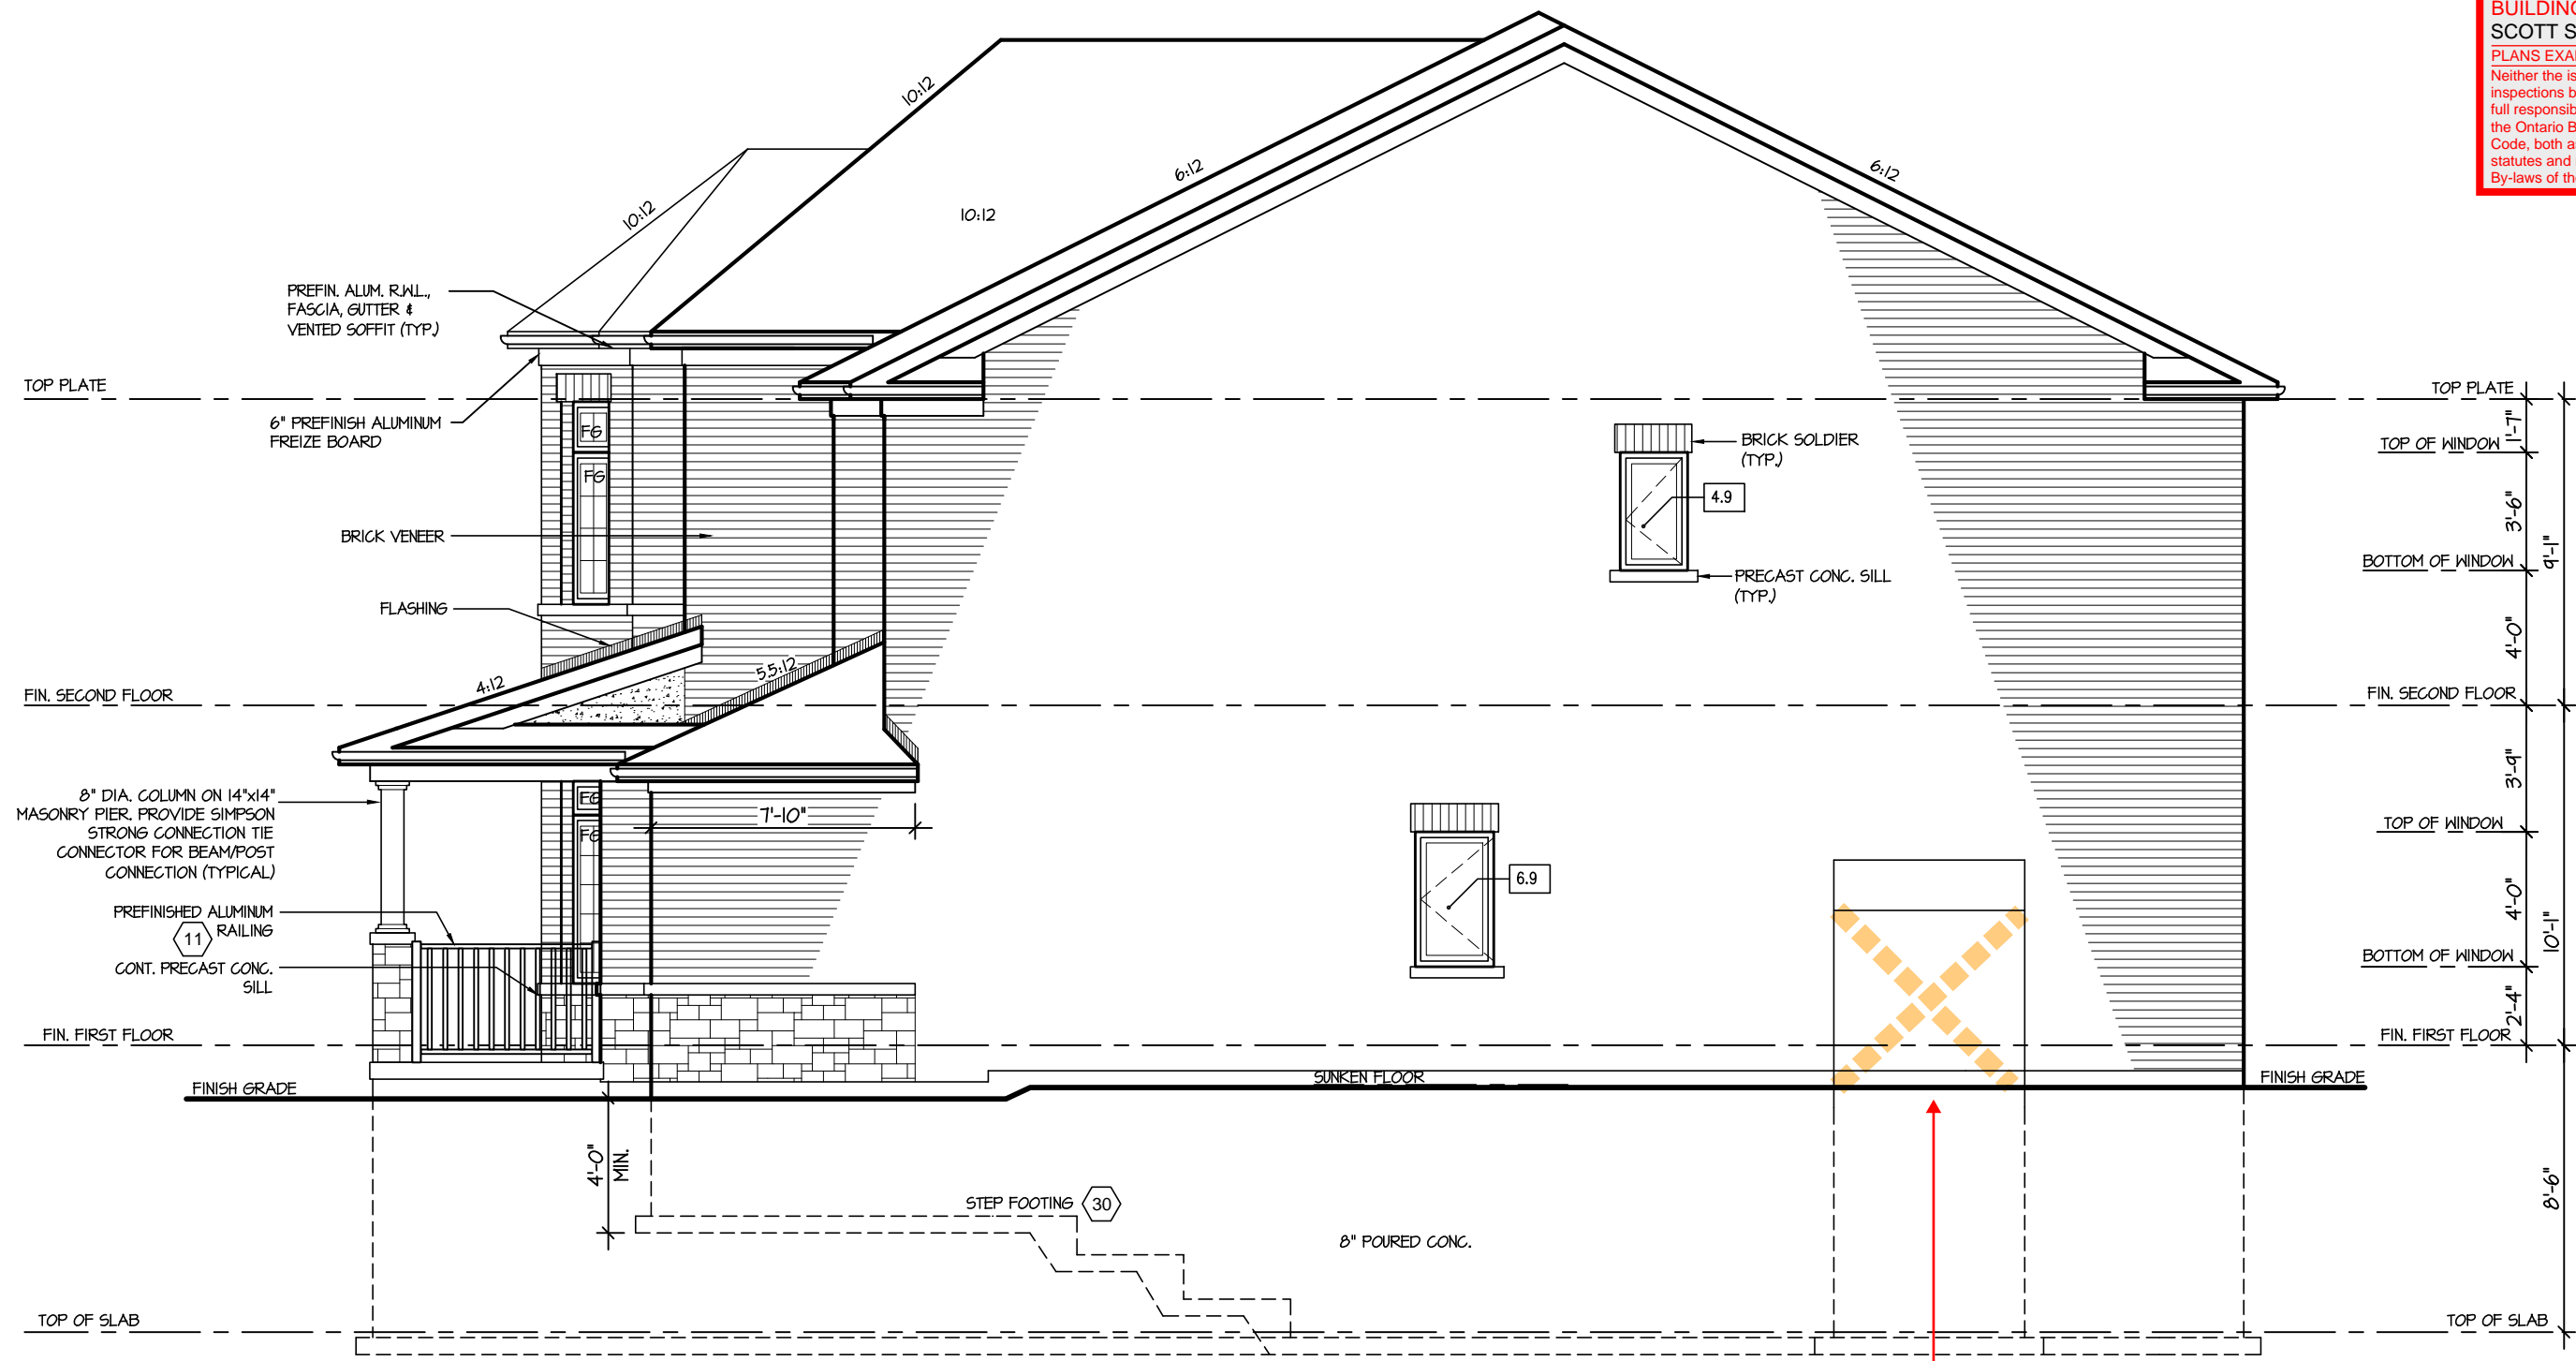

RIGHT ELEVATION I

ALLOWABLE GLAZING (STANDARD PLAN)			
WALL AREA	=	845	Sq. Ft.
ALLOWABLE GLAZED AREA @ 1 % 1.2 M SIDE YARD	=	62.65	Sq. Ft.
ACTUAL GLAZED AREA	=	11.8	Sq. Ft.

LD <1.2 M FOR BUMPOUT
Fireplace bumpout to be constructed with 45 min FRR where the LD is <1.2 m

45 MIN FRR

It is the builder's complete responsibility to ensure that all plans submitted for approval fully comply with the Architectural Guidelines and all applicable regulations and requirements including zoning provisions and any provisions in the subdivision agreement. The Control Architect is not responsible in any way for examining or approving site (lotting) plans or working drawings with respect to any zoning or building code or permit matter or that any house can be properly built or located on its lot.

This is to certify that these plans comply with the applicable Architectural Design Guidelines approved by the Town of MILTON.

ARCHITECTURAL REVIEW & APPROVAL
MAR 20 2017
John G. Williams Limited, Architect

JUNIPER 7
ENERGY STAR

5.		
4.		
3.		
2.		
1.	ISSUED FOR REVIEW	SEP 2016
REVISIONS		

The undersigned has reviewed and takes responsibility for this design, and has the qualifications and meets the requirements set out in the Ontario Building Code to be a designer.
QUALIFICATION INFORMATION
Required unless design is exempt under Division C, Subsection 3.2.5 of the building code
VIKAS GAJJAR
NAME
SIGNATURE
28770
BCIN

REGION DESIGN INC.
8700 DUFFERIN ST.
CONCORD, ONTARIO
L4K 4S6
P (416) 736-4096
F (905) 660-0746


REGION
DESIGN
INC.

SHEET TITLE	
RIGHT SIDE ELEVATION 1	
SCALE 3/16"=1'-0"	BY V.G.
DATE JUL 2016	TYPE

CONTRACTOR SHALL CHECK ALL DIMENSIONS AND ELEVATIONS BEFORE COMMENCING WITH WORK AND REPORT ANY DISCREPANCIES TO THE DESIGNER. PRINTS ARE NOT TO BE SCALED.	
AREA 3093	PAGE No. 6
PROJECT 02-10-08	

Greenpark
PROJECT NAME
LECCO RIDGE

RECEIVED
TOWN OF MILTON
MAR 29, 2017
JUNIPER 7
BUILDING DIVISION

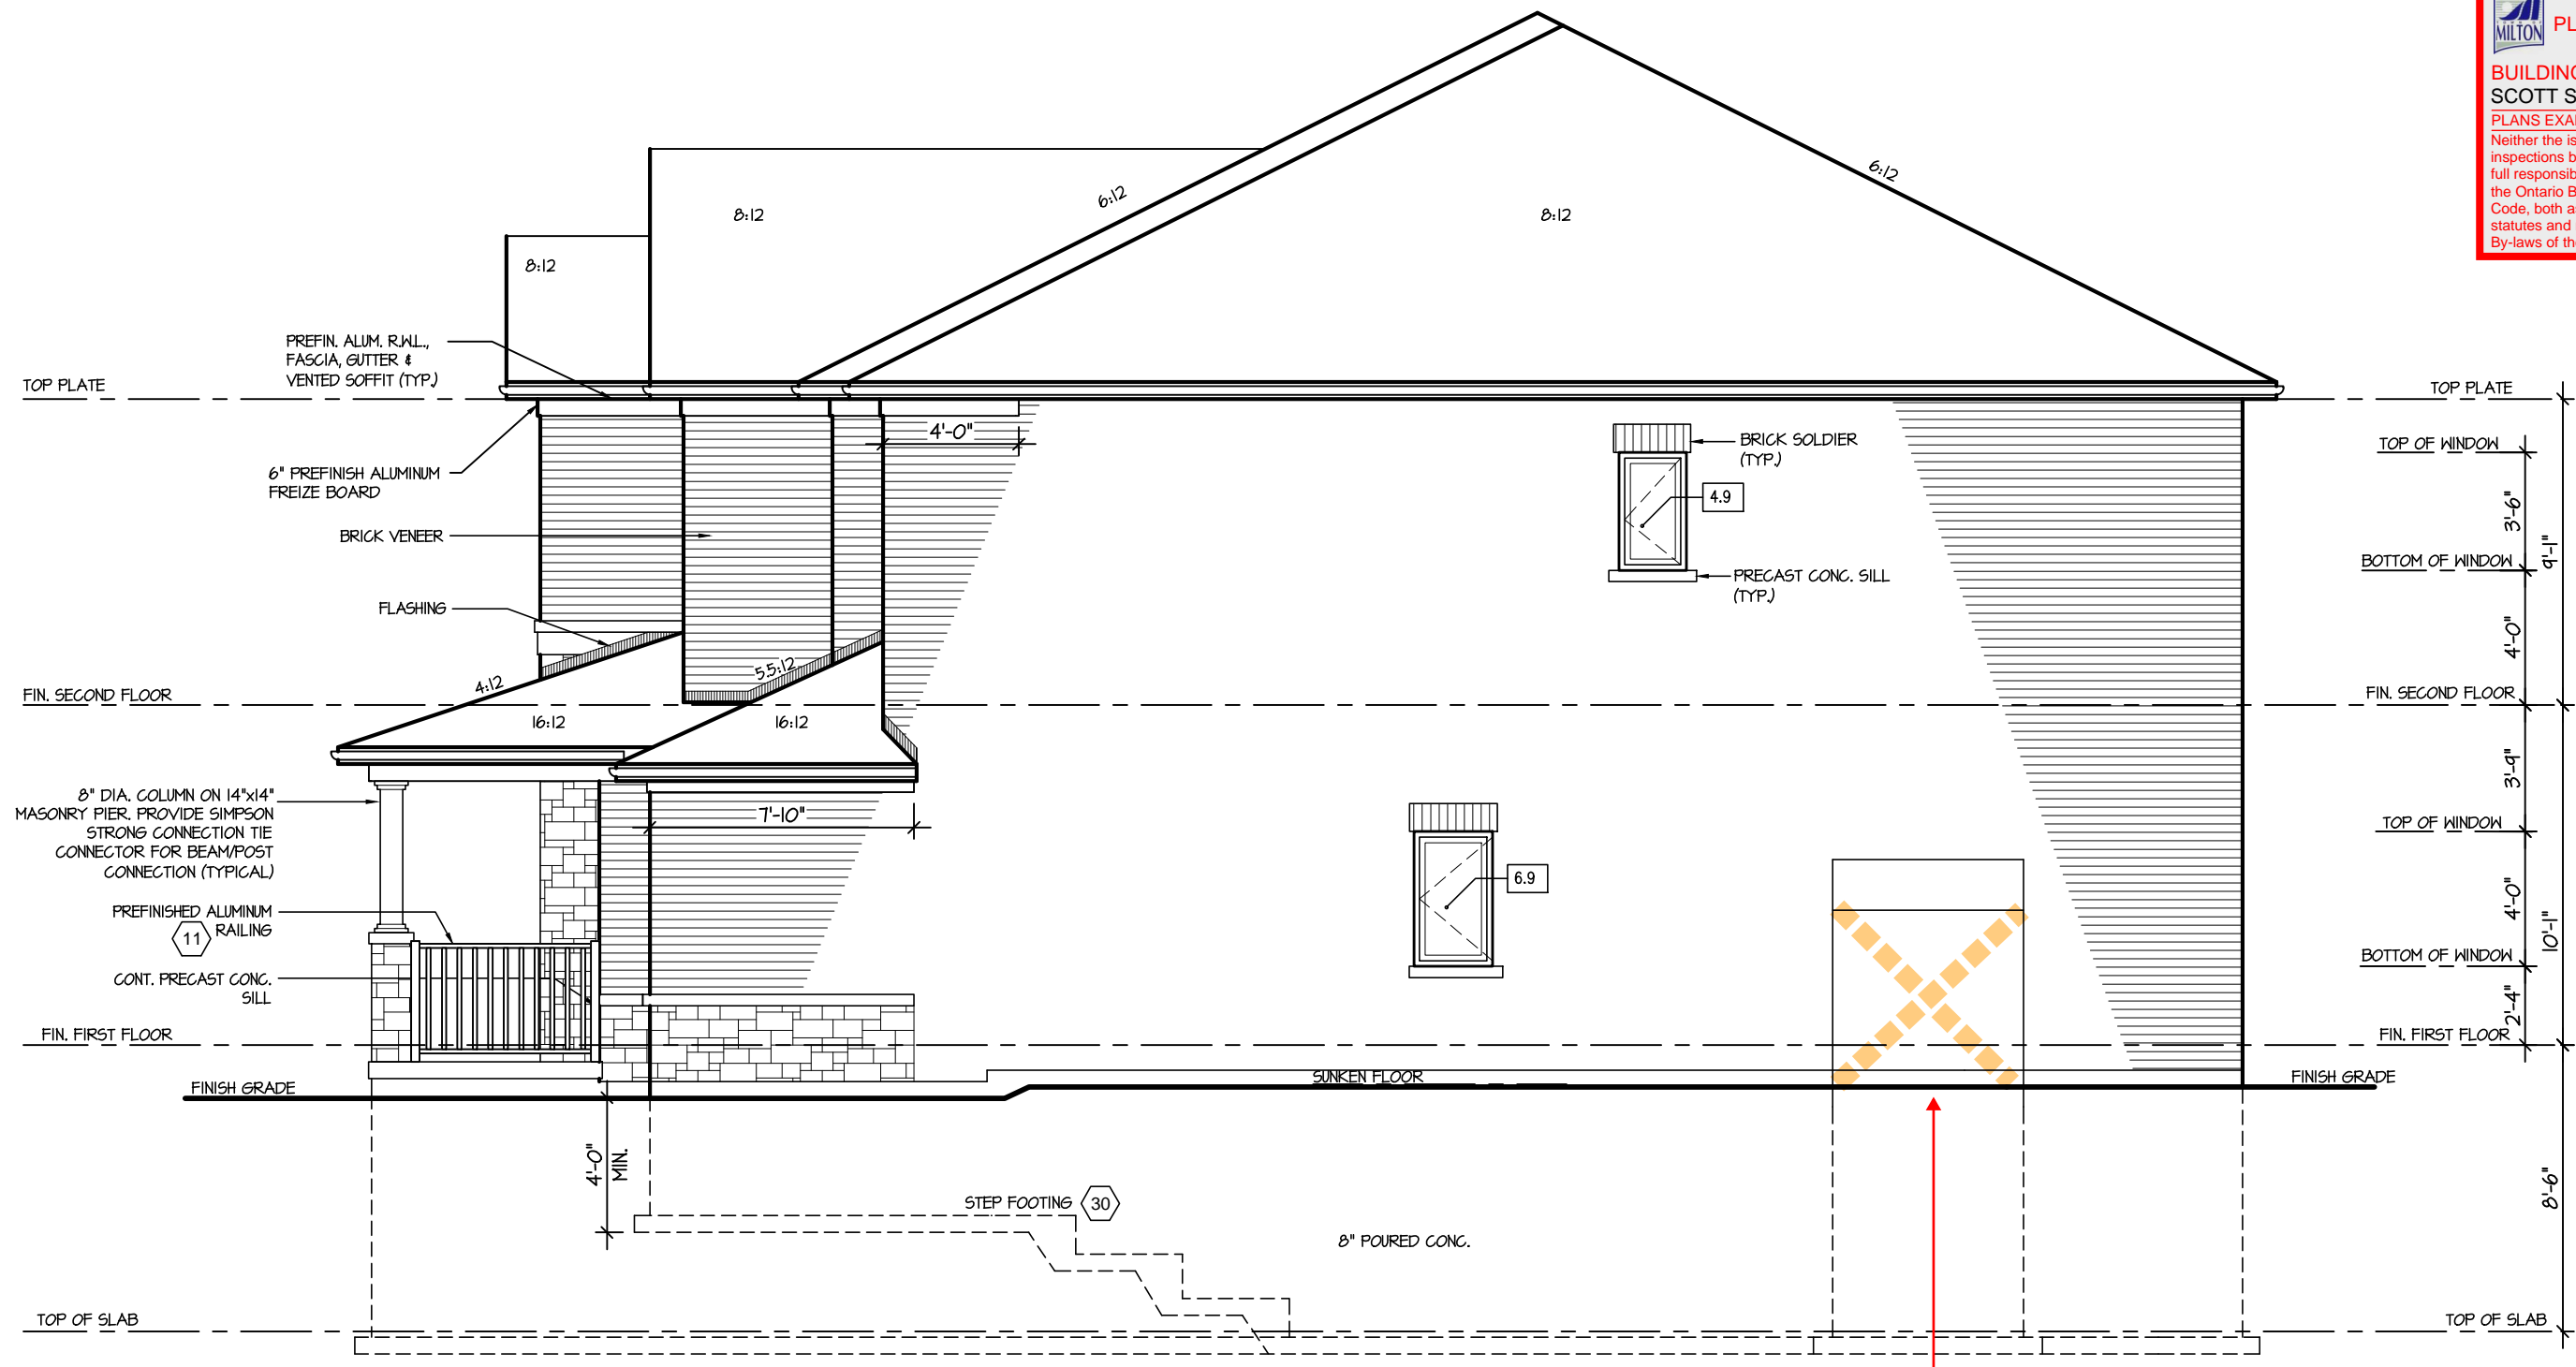

RIGHT ELEVATION 2

ALLOWABLE GLAZING (STANDARD PLAN)			
WALL AREA	=	845	Sq. Ft.
ALLOWABLE GLAZED AREA @ 1 % 1.2 M SIDE YARD	=	62.65	Sq. Ft.
ACTUAL GLAZED AREA	=	11.8	Sq. Ft.

LD <1.2 M FOR BUMPOUT
Fireplace bumpout to be
constructed with 45 min FRR
where the LD is <1.2 m

45 MIN FRR

It is the builder's complete responsibility to ensure that all plans submitted for approval fully comply with the Architectural Guidelines and all applicable regulations and requirements including zoning provisions and any provisions in the subdivision agreement. The Control Architect is not responsible in any way for examining or approving site (lotting) plans or working drawings with respect to any zoning or building code or permit matter or that any house can be properly built or located on its lot.

This is to certify that these plans comply with the applicable Architectural Design Guidelines approved by the Town of MILTON.

ARCHITECTURAL REVIEW & APPROVAL
MAR 20 2017
John G. Williams Limited, Architect

JUNIPER 7
ENERGY STAR

5.		
4.		
3.		
2.		
1.	ISSUED FOR REVIEW	SEP 2016
REVISIONS		

The undersigned has reviewed and takes responsibility for this design, and has the qualifications and meets the requirements set out in the Ontario Building Code to be a designer.

QUALIFICATION INFORMATION
Required unless design is exempt under Division C, Subsection 3.2.5 of the building code

VIKAS GAJJAR
NAME
SIGNATURE
28770
BCIN

REGION DESIGN INC.
8700 DUFFERIN ST.
CONCORD, ONTARIO
L4K 4S6
P (416) 736-4096
F (905) 660-0746

REGION
DESIGN
INC.


SHEET TITLE	
RIGHT SIDE ELEVATION 2	
SCALE 3/16"=1'-0"	BY V.G.
DATE JUL 2016	TYPE

CONTRACTOR SHALL CHECK ALL DIMENSIONS AND ELEVATIONS BEFORE COMMENCING WITH WORK AND REPORT ANY DISCREPANCIES TO THE DESIGNER. PRINTS ARE NOT TO BE SCALED.	
AREA 3093	PAGE No. 6-2
PROJECT 02-10-08	

PROJECT NAME
LECCO RIDGE

Greenpark

RECEIVED
TOWN OF MILTON
MAR 29, 2017
JUNIPER 7
BUILDING DIVISION

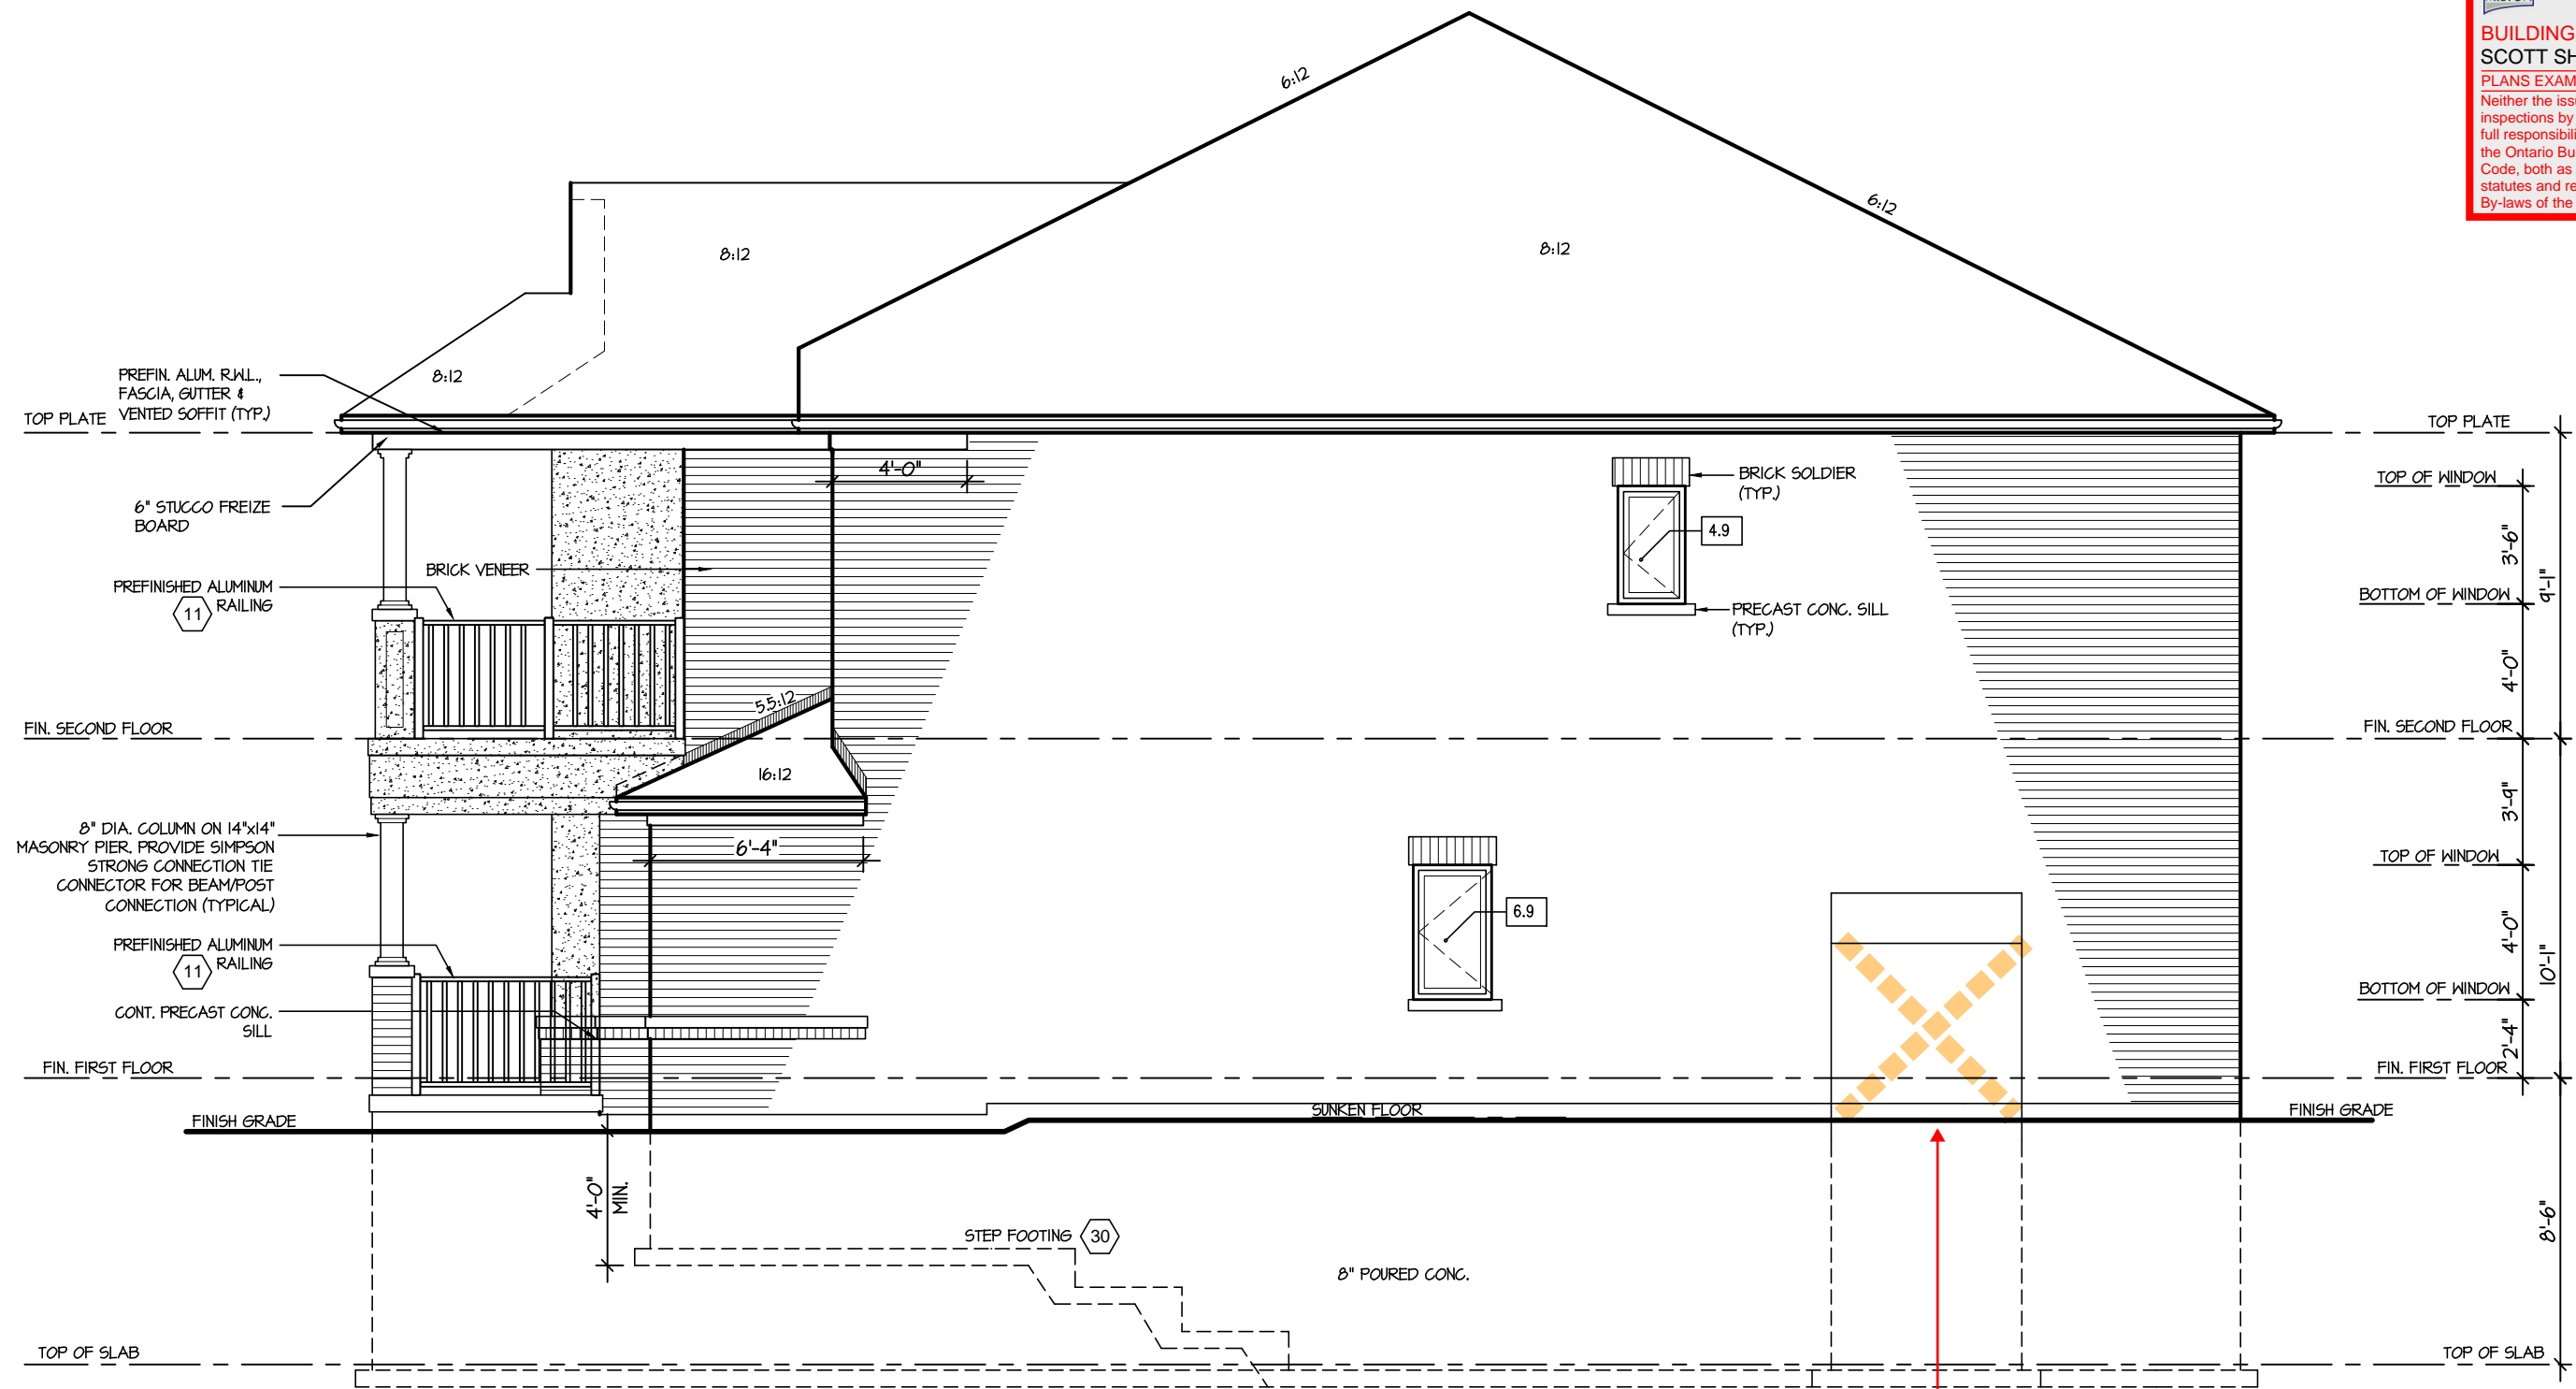

RIGHT ELEVATION 3

ALLOWABLE GLAZING (STANDARD PLAN)			
WALL AREA	=	845	Sq. Ft.
ALLOWABLE GLAZED AREA @ 1 % 1.2 M SIDE YARD	=	62.65	Sq. Ft.
ACTUAL GLAZED AREA	=	11.8	Sq. Ft.

LD <1.2 M FOR BUMPOUT
Fireplace bumpout to be
constructed with 45 min FRR
where the LD is <1.2 m

45 MIN FRR

It is the builder's complete responsibility to ensure that all plans submitted for approval fully comply with the Architectural Guidelines and all applicable regulations and requirements including zoning provisions and any provisions in the subdivision agreement. The Control Architect is not responsible in any way for examining or approving site (lotting) plans or working drawings with respect to any zoning or building code or permit matter or that any house can be properly built or located on its lot.

This is to certify that these plans comply with the applicable Architectural Design Guidelines approved by the Town of MILTON.

ARCHITECTURAL REVIEW & APPROVAL
MAR 20 2017
John G. Williams Limited, Architect

JUNIPER 7
ENERGY STAR

5.		
4.		
3.		
2.		
1.	ISSUED FOR REVIEW	SEP 2016
REVISIONS		

The undersigned has reviewed and takes responsibility for this design, and has the qualifications and meets the requirements set out in the Ontario Building Code to be a designer.

QUALIFICATION INFORMATION
Required unless design is exempt under Division C, Subsection 3.2.5 of the building code

VIKAS GAJJAR
NAME
SIGNATURE
28770
BCIN

REGION DESIGN INC.
8700 DUFFERIN ST.
CONCORD, ONTARIO
L4K 4S6
P (416) 736-4096
F (905) 660-0746

**REGION
DESIGN
INC.**

SHEET TITLE
**RIGHT SIDE
ELEVATION 3**

SCALE
3/16"=1'-0"

DATE
JUL 2016

BY
V.G.

TYPE

CONTRACTOR SHALL CHECK ALL DIMENSIONS AND ELEVATIONS BEFORE COMMENCING WITH WORK AND REPORT ANY DISCREPANCIES TO THE DESIGNER. PRINTS ARE NOT TO BE SCALED.

AREA
3093


PROJECT
02-10-08

PAGE No.
6-3

Greenpark.

PROJECT NAME
LECCO RIDGE

RECEIVED
TOWN OF MILTON
MAR 29, 2017
JUNIPER 7
BUILDING DIVISION

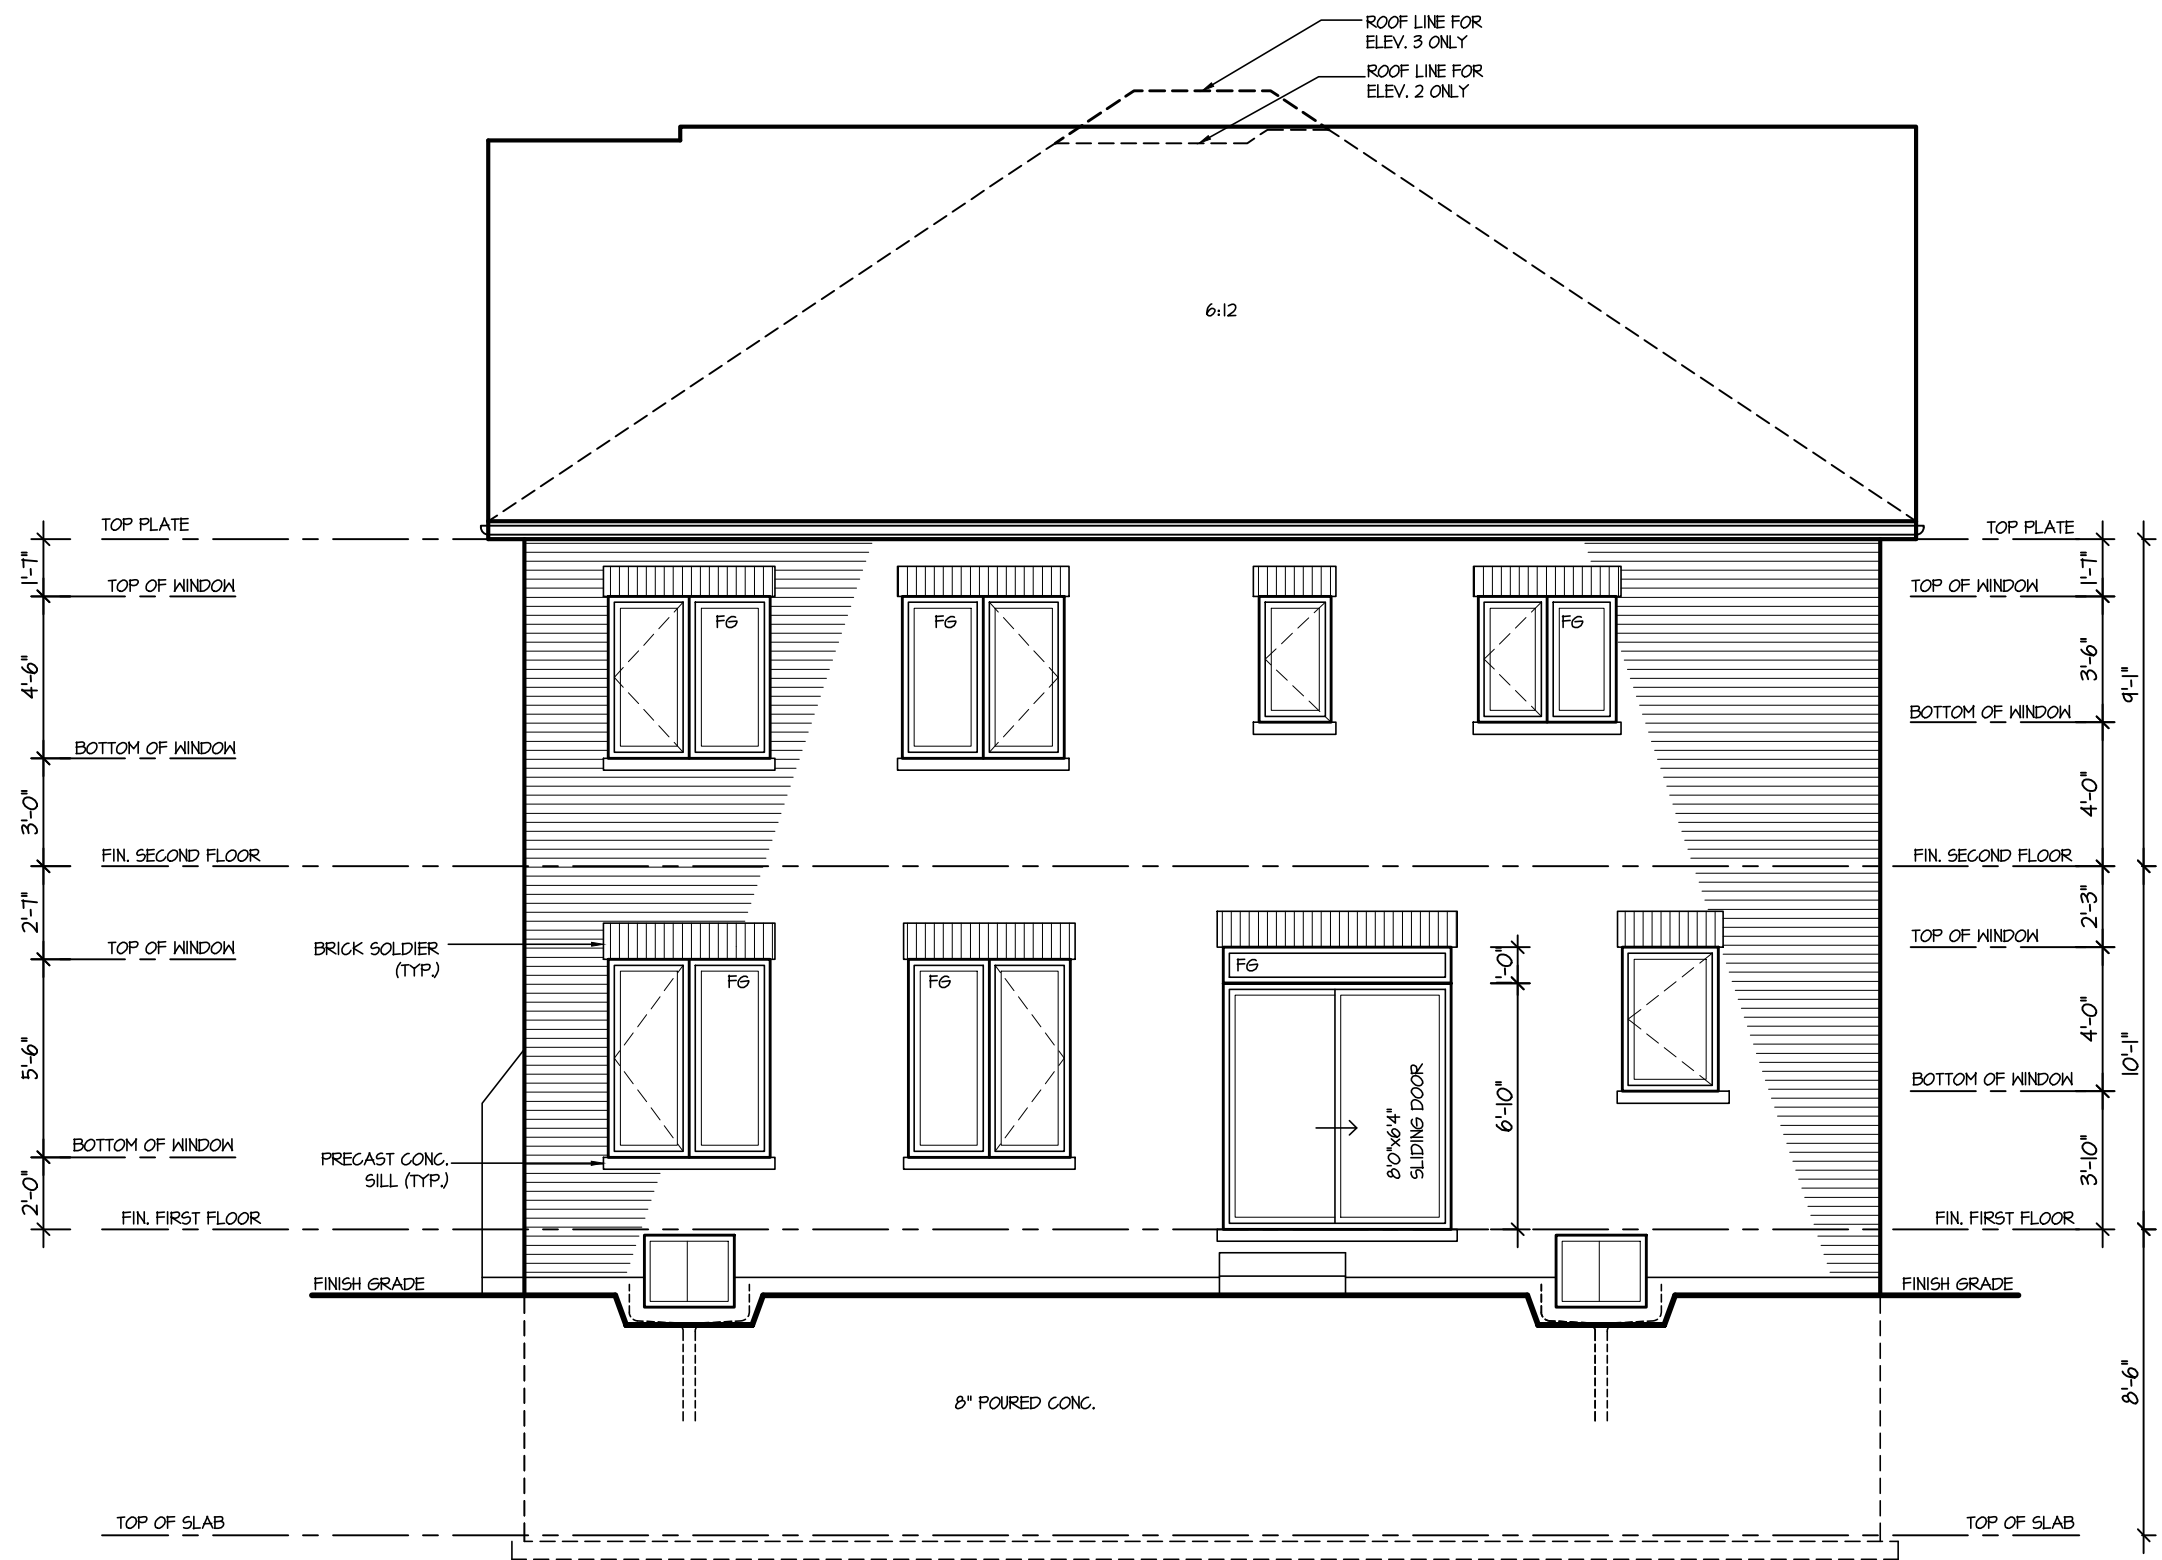

REAR ELEVATION 1, 2 & 3

It is the builder's complete responsibility to ensure that all plans submitted for approval fully comply with the Architectural Guidelines and all applicable regulations and requirements including zoning provisions and any provisions in the subdivision agreement. The Control Architect is not responsible in any way for examining or approving site (lotting) plans or working drawings with respect to any zoning or building code or permit matter or that any house can be properly built or located on its lot.

This is to certify that these plans comply with the applicable Architectural Design Guidelines approved by the Town of MILTON.

ARCHITECTURAL REVIEW & APPROVAL
MAR 20 2017
John G. Williams Limited, Architect

JUNIPER 7
ENERGY STAR

5.		<div>The undersigned has reviewed and takes responsibility for this design, and has the qualifications and meets the requirements set out in the Ontario Building Code to be a designer.</div> <div>QUALIFICATION INFORMATION</div> <div>Required unless design is exempt under Division C, Subsection 3.2.5 of the building code</div> <div><div>VIKAS GAJJAR</div><div></div><div>28770</div></div> <div><div>NAME</div><div>SIGNATURE</div><div>BCIN</div></div>	<div>REGION DESIGN INC.</div> <div>8700 DUFFERIN ST.</div> <div>CONCORD, ONTARIO</div> <div>L4K 4S6</div> <div>P (416) 736-4096</div> <div>F (905) 660-0746</div>	<div>REGION DESIGN INC.</div>	SHEET TITLE		REAR ELEVATION 1		CONTRACTOR SHALL CHECK ALL DIMENSIONS AND ELEVATIONS BEFORE COMMENCING WITH WORK AND REPORT ANY DISCREPANCIES TO THE DESIGNER. PRINTS ARE NOT TO BE SCALED.		<div></div> <div>PROJECT NAME</div> <div>LECCO RIDGE</div>		
4.					SCALE	3/16"=1'-0"	BY	V.G.	AREA	3093		PAGE No.	7
3.					DATE	JUL 2016	TYPE		PROJECT	02-10-08			
2.													
1.		ISSUED FOR REVIEW	SEP 2016										
REVISIONS													



TOWN OF MILTON

PLANNING AND DEVELOPMENT



JUNIPER 7 MODEL

BUILDING: REVIEWED

SCOTT SHERRIFFS

APR 13, 2017

PLANS EXAMINER	DATE
<p>Neither the issuance of a permit nor carrying out of inspections by the Town of Milton relieves the owner from full responsibility for compliance with the provisions of the Ontario Building Code Act and the Ontario Building Code, both as amended, as well as other applicable statutes and regulations of the Province on Ontario, By-laws of the Region of Halton and Town of Milton</p>	

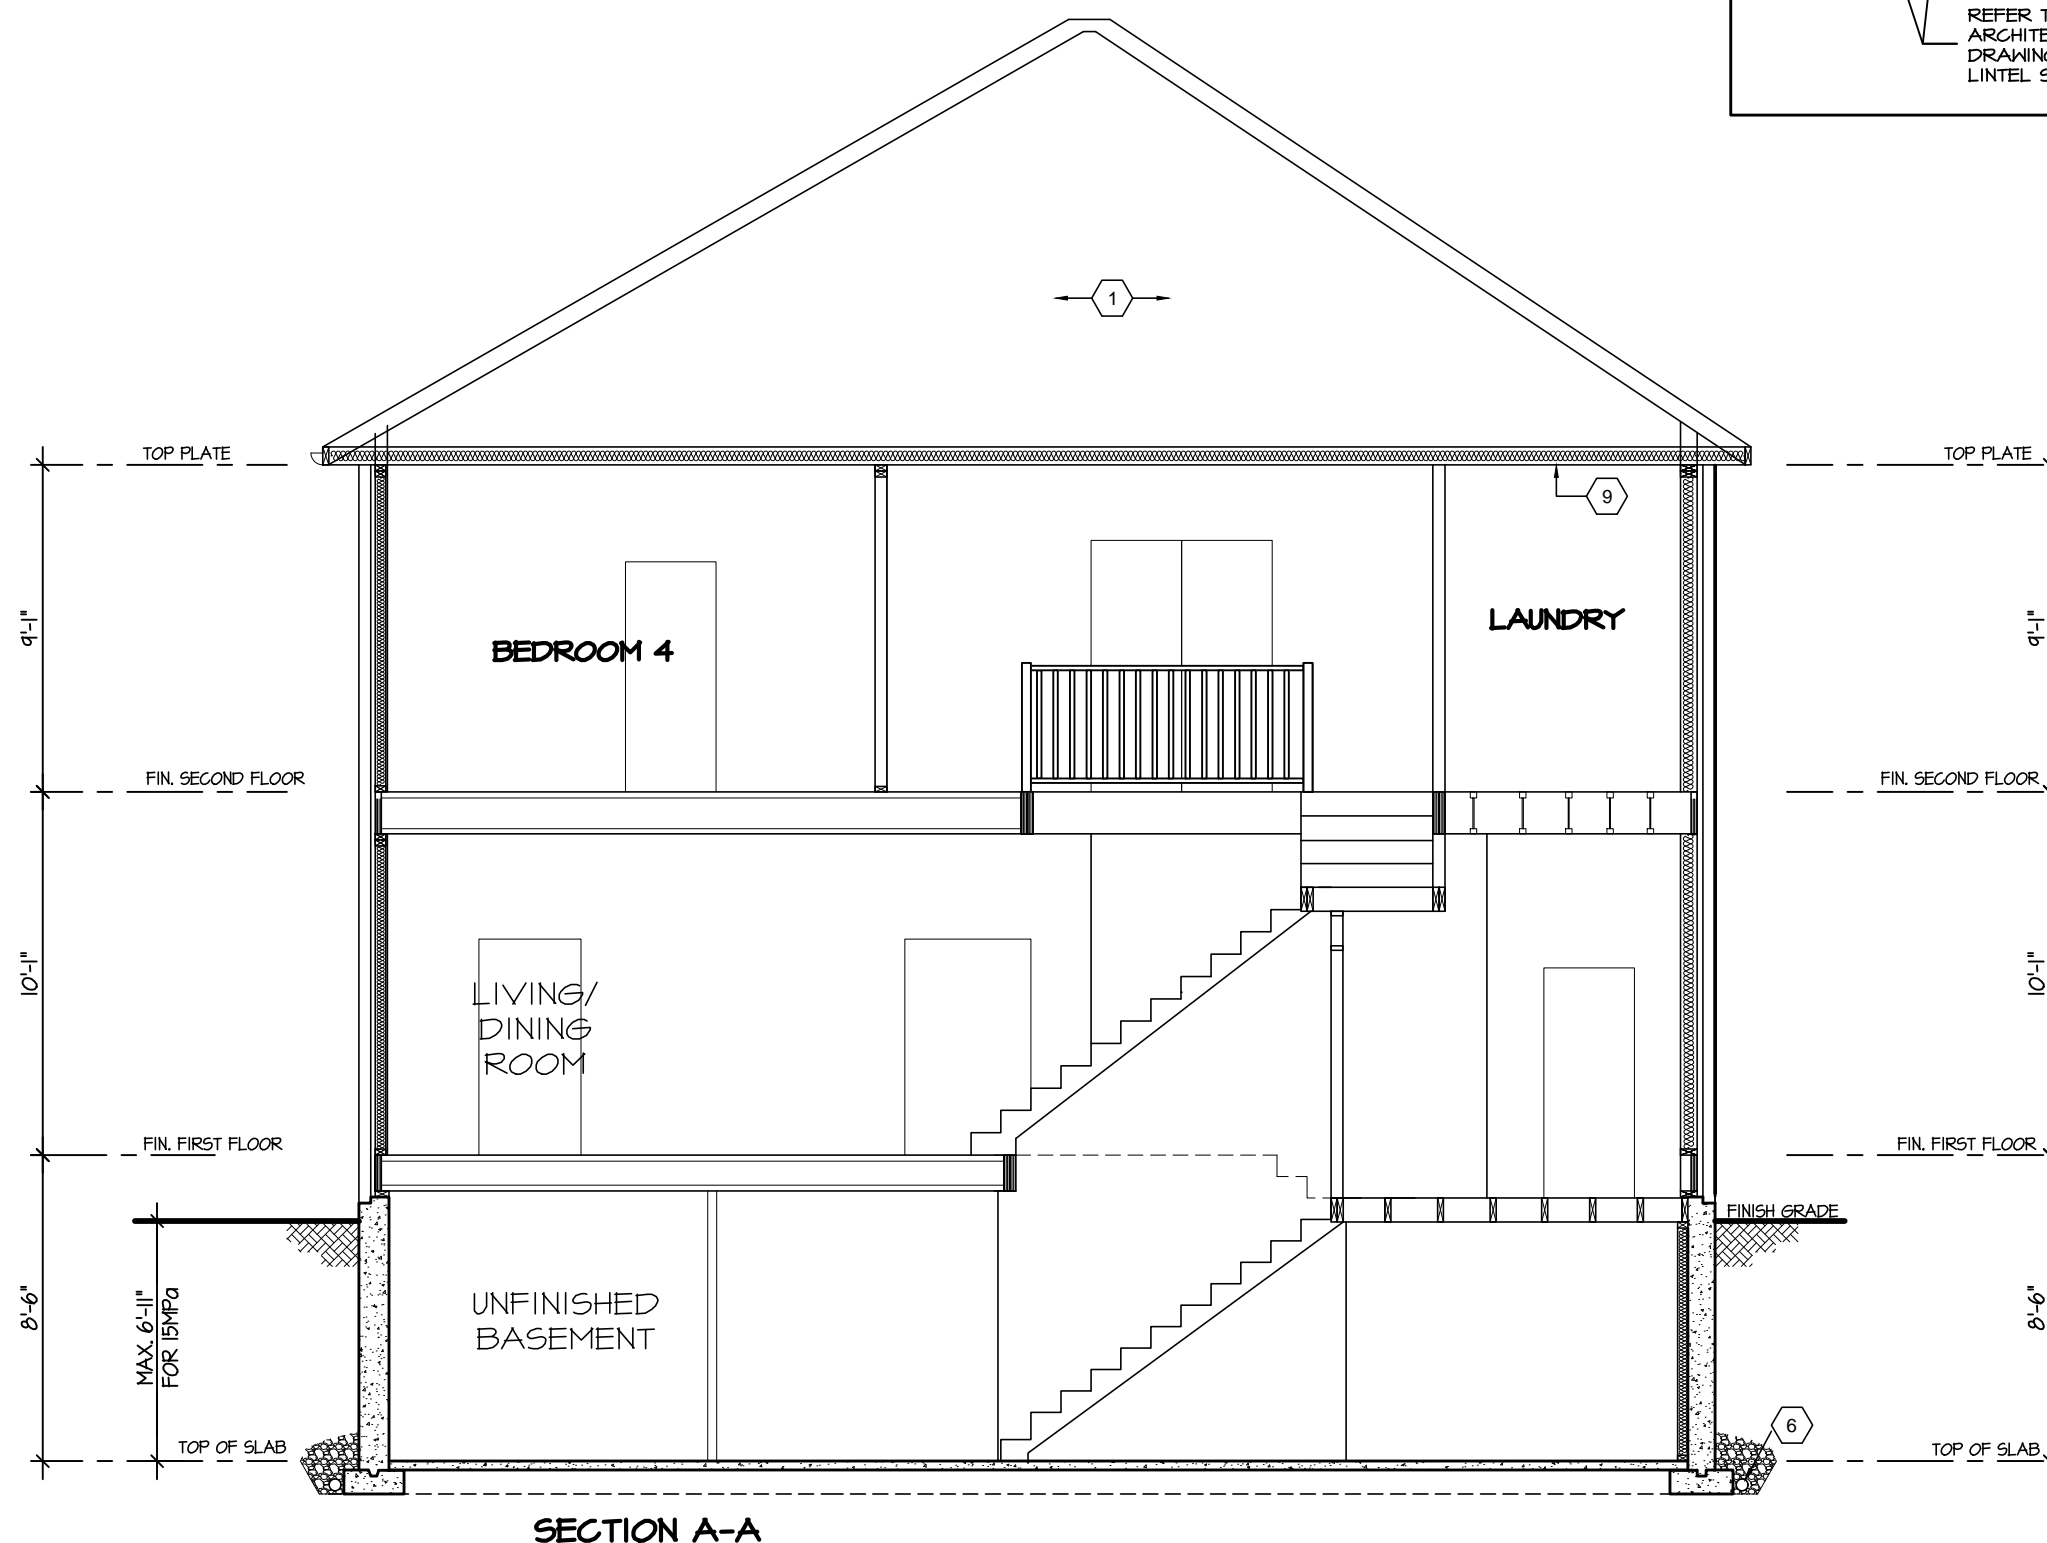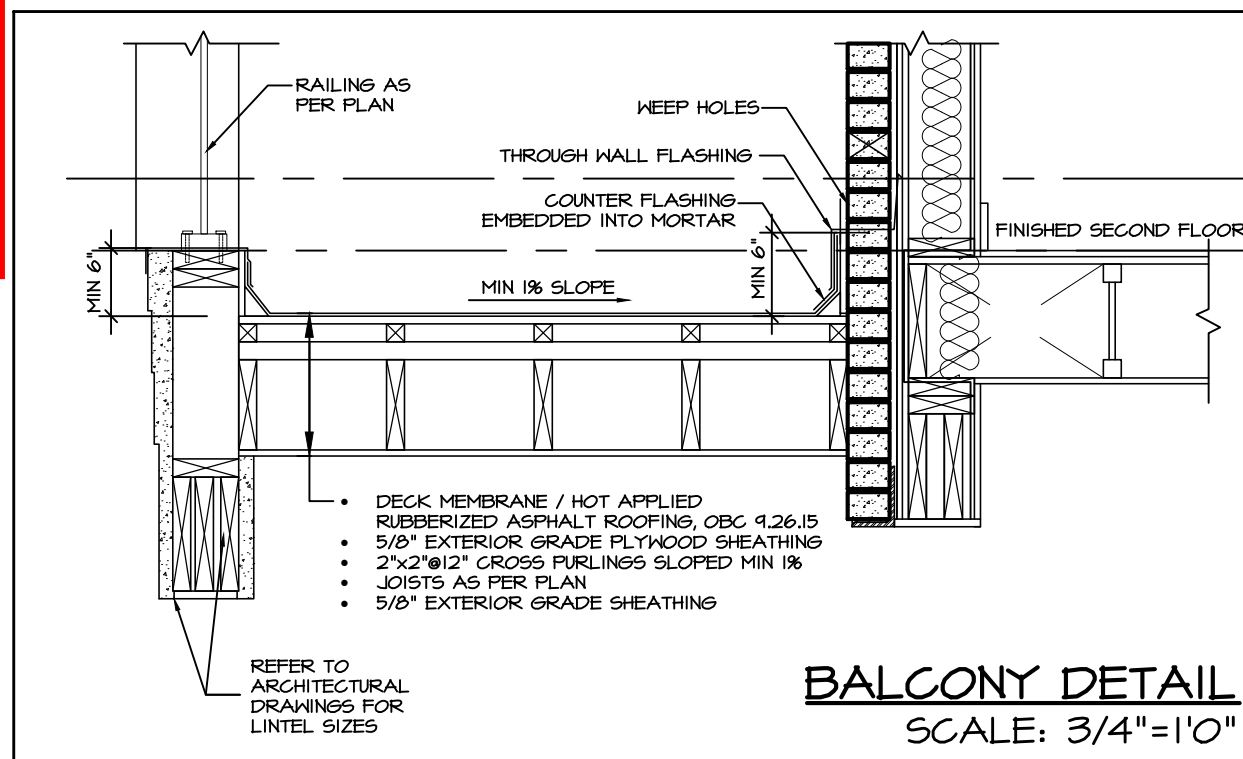

STRUDET INC.

REGISTERED PROFESSIONAL ENGINEER
B. MARINKOVIC
PROVINCE OF ONTARIO

FOR STRUCTURE ONLY


It is the builder's complete responsibility to ensure that all plans submitted for approval fully comply with the Architectural Guidelines and all applicable regulations and requirements, including zoning provisions and any provisions in the subdivision agreement. The Controller/Architect is not responsible in any way for examining or approving site (lotting) plans or working drawings with respect to any zoning or building code or permit matter or that any house can be properly built or located on its lot.

This is to certify that these plans comply with the applicable Architectural Design Guidelines approved by the Town of MILTON.

JUNIPER 7
ENERGY STAR

5.			<div>The undersigned has reviewed and takes responsibility for this design, and has the qualifications and meets the requirements set out in the Ontario Building Code to be a designer.</div> <div>QUALIFICATION INFORMATION</div> <div>Required unless design is exempt under Division C, Subsection 3.2.5 of the building code</div> <div><div>VIKAS GAJJAR</div><div></div><div>28770</div></div> <div><div>NAME</div><div>SIGNATURE</div><div>BCIN</div></div>	<div>REGION DESIGN INC.</div> <div>8700 DUFFERIN ST.</div> <div>CONCORD, ONTARIO</div> <div>L4K 4S6</div> <div>P (416) 736-4096</div> <div>F (905) 660-0746</div> <div><div>R</div><div>D</div><div>I</div><div>REGION DESIGN INC.</div></div>	SHEET TITLE		CONTRACTOR SHALL CHECK ALL DIMENSIONS AND ELEVATIONS BEFORE COMMENCING WITH WORK AND REPORT ANY DISCREPANCIES TO THE DESIGNER. PRINTS ARE NOT TO BE SCALED.		<div></div> <div>PROJECT NAME</div> <div>LECCO RIDGE</div>
4.					CROSS SECTION				
3.					SCALE	BY	AREA	PAGE No.	
2.					3/16"=1'-0"	V.G.	3093	8	
1.	ISSUED FOR REVIEW	SEP 2016			DATE	TYPE	PROJECT		
REVISIONS			JUL 2016		02-10-08				

RECEIVED
TOWN OF MILTON
MAR 29, 2017
JUNIPER 7
BUILDING DIVISION

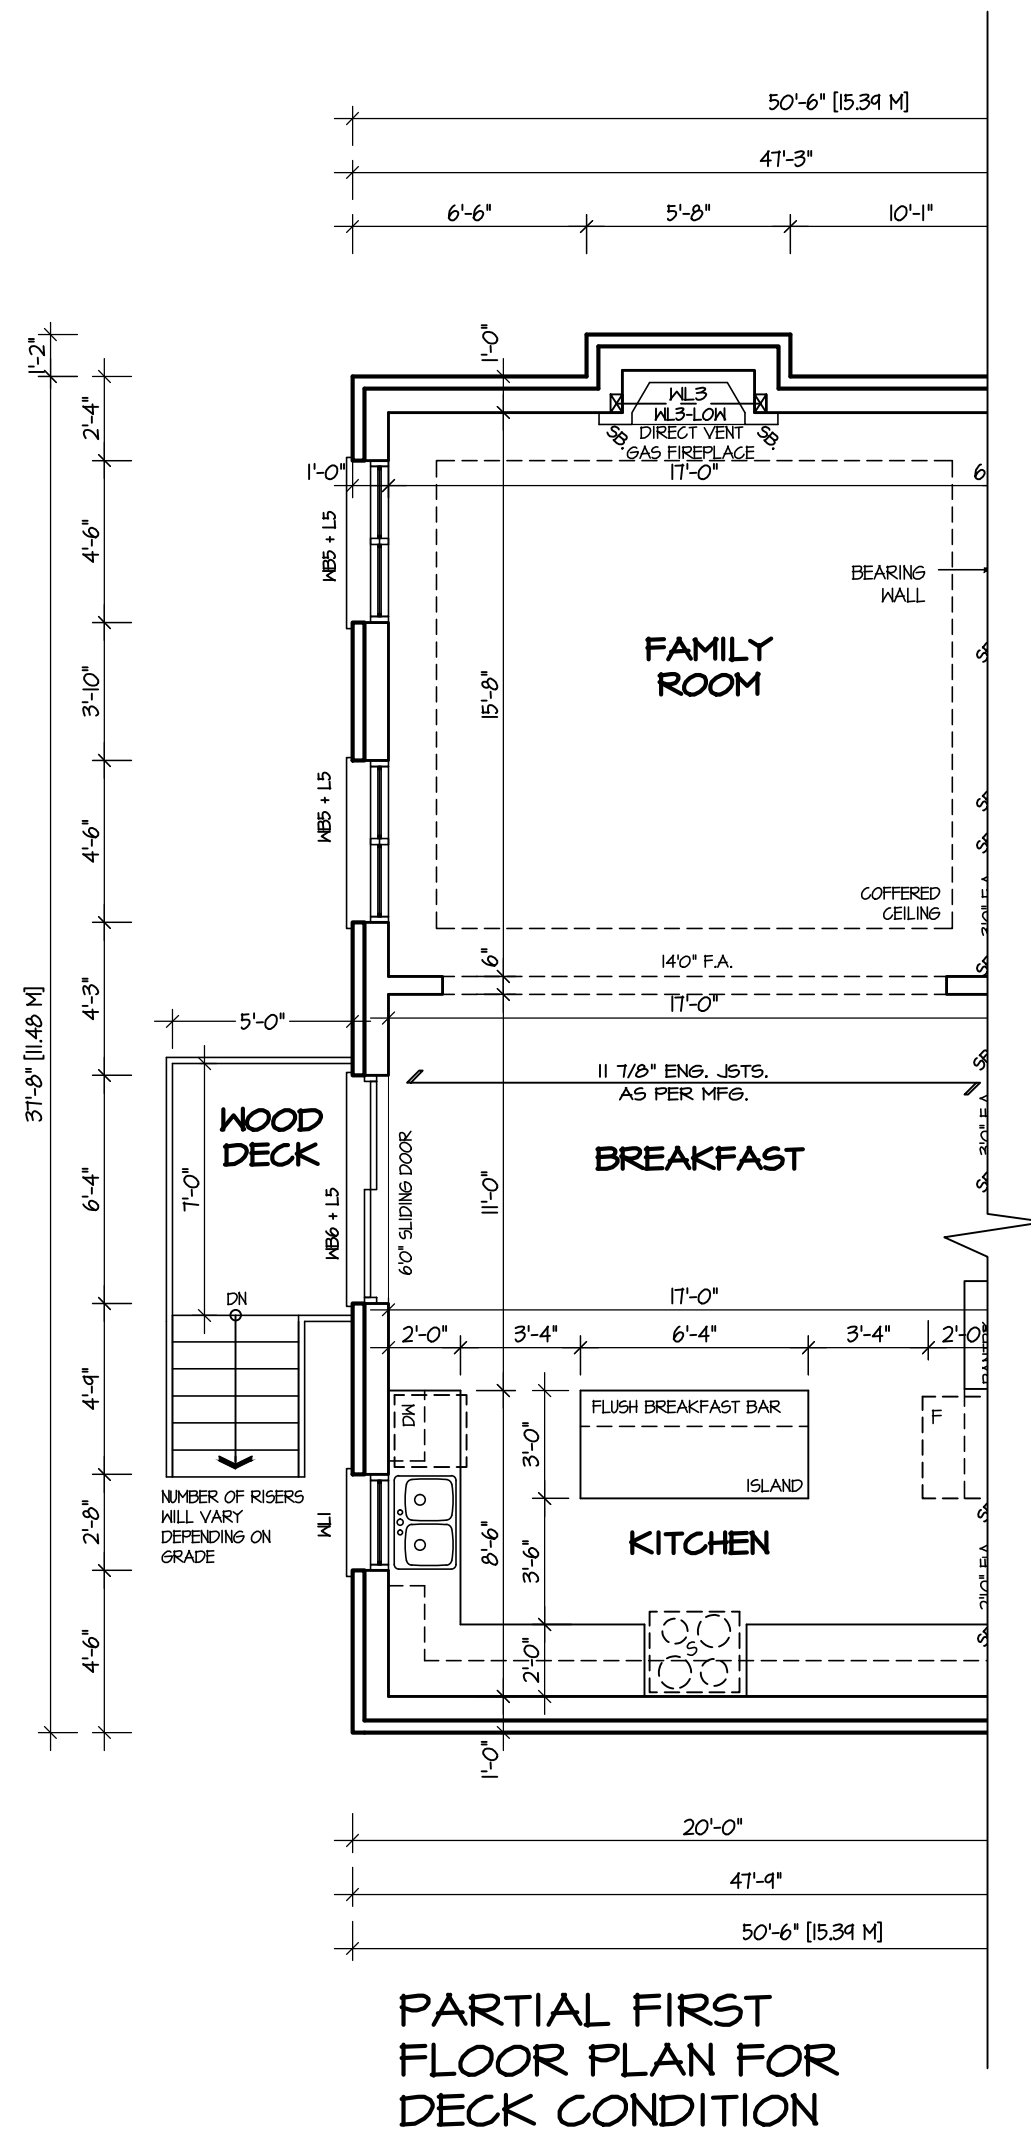

It is the builder's complete responsibility to ensure that all plans submitted for approval fully comply with the Architectural Guidelines and all applicable regulations and requirements including zoning provisions and any provisions in the subdivision agreement. The Control Architect is not responsible in any way for examining or approving site (lotting) plans or working drawings with respect to any zoning or building code or permit matter or that any house can be properly built or located on its lot.

This is to certify that these plans comply with the applicable Architectural Design Guidelines approved by the Town of MILTON.

ARCHITECTURAL REVIEW & APPROVAL
MAR 20 2017
John G. Williams Limited, Architect

JUNIPER 7
ENERGY STAR

5.			<p>The undersigned has reviewed and takes responsibility for this design, and has the qualifications and meets the requirements set out in the Ontario Building Code to be a designer.</p> <p>QUALIFICATION INFORMATION</p> <p>Required unless design is exempt under Division C, Subsection 3.2.5 of the building code</p> <div><div>VIKAS GAJJAR</div><div></div><div>28770</div></div> <div><div>NAME</div><div>SIGNATURE</div><div>BCIN</div></div>	<p>REGION DESIGN INC.</p> <p>8700 DUFFERIN ST.</p> <p>CONCORD, ONTARIO</p> <p>L4K 4S6</p> <p>P (416) 736-4096</p> <p>F (905) 660-0746</p> <div><div>R</div><div>REGION</div><div>D</div><div>DESIGN</div><div>I</div><div>NC.</div></div>	SHEET TITLE		CONTRACTOR SHALL CHECK ALL DIMENSIONS AND ELEVATIONS BEFORE COMMENCING WITH WORK AND REPORT ANY DISCREPANCIES TO THE DESIGNER. PRINTS ARE NOT TO BE SCALED.		
4.					DECK PLANS				
3.					SCALE	BY	AREA	PAGE No.	
2.					3/16"=1'-0"	V.G.	3093	9	
1.	ISSUED FOR REVIEW	SEP 2016			DATE	TYPE	PROJECT		
REVISIONS			JUL 2016		02-10-08		PROJECT NAME	LECCO RIDGE	

RECEIVED
TOWN OF MILTON
MAR 29, 2017
JUNIPER 7
BUILDING DIVISION



REAR ELEVATION 1, 2 & 3

DECK DETAILS
See standard details pages 8
and 8-2 for additional deck
construction details

It is the builder's complete responsibility to ensure that all plans submitted for approval fully comply with the Architectural Guidelines and all applicable regulations and requirements including zoning provisions and any provisions in the subdivision agreement. The Control Architect is not responsible in any way for examining or approving site (lotting) plans or working drawings with respect to any zoning or building code or permit matter or that any house can be properly built or located on its lot.

This is to certify that these plans comply with the applicable Architectural Design Guidelines approved by the Town of MILTON.

ARCHITECTURAL REVIEW & APPROVAL
MAR 20 2017
John G. Williams Limited, Architect




JUNIPER 7
ENERGY STAR

5.			The undersigned has reviewed and takes responsibility for this design, and has the qualifications and meets the requirements set out in the Ontario Building Code to be a designer.	REGION DESIGN INC. 8700 DUFFERIN ST. CONCORD, ONTARIO L4K 4S6 P (416) 736-4096 F (905) 660-0746	REGION DESIGN INC.	SHEET TITLE DECK ELEVATION		CONTRACTOR SHALL CHECK ALL DIMENSIONS AND ELEVATIONS BEFORE COMMENCING WITH WORK AND REPORT ANY DISCREPANCIES TO THE DESIGNER. PRINTS ARE NOT TO BE SCALED.	
4.			QUALIFICATION INFORMATION Required unless design is exempt under Division C, Subsection 3.2.5 of the building code			SCALE 3/16"=1'-0"	BY V.G.	AREA 3093	PAGE No. 9-2
3.						DATE JUL 2016	TYPE	PROJECT 02-10-08	
2.									
1.	ISSUED FOR REVIEW	SEP 2016	VIKAS GAJJAR NAME SIGNATURE 28770 BCIN						PROJECT NAME LECCO RIDGE
REVISIONS									



WALKOUT AREA DRAIN
Uncovered walkout landing to have an area drain with sediment trap/bucket connected to Storm drainage system

WALKOUT BSMT. INSULATION
See standard details page 12 for required perimeter slab insulation for walkout basement condition

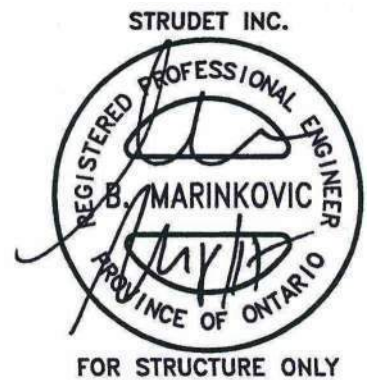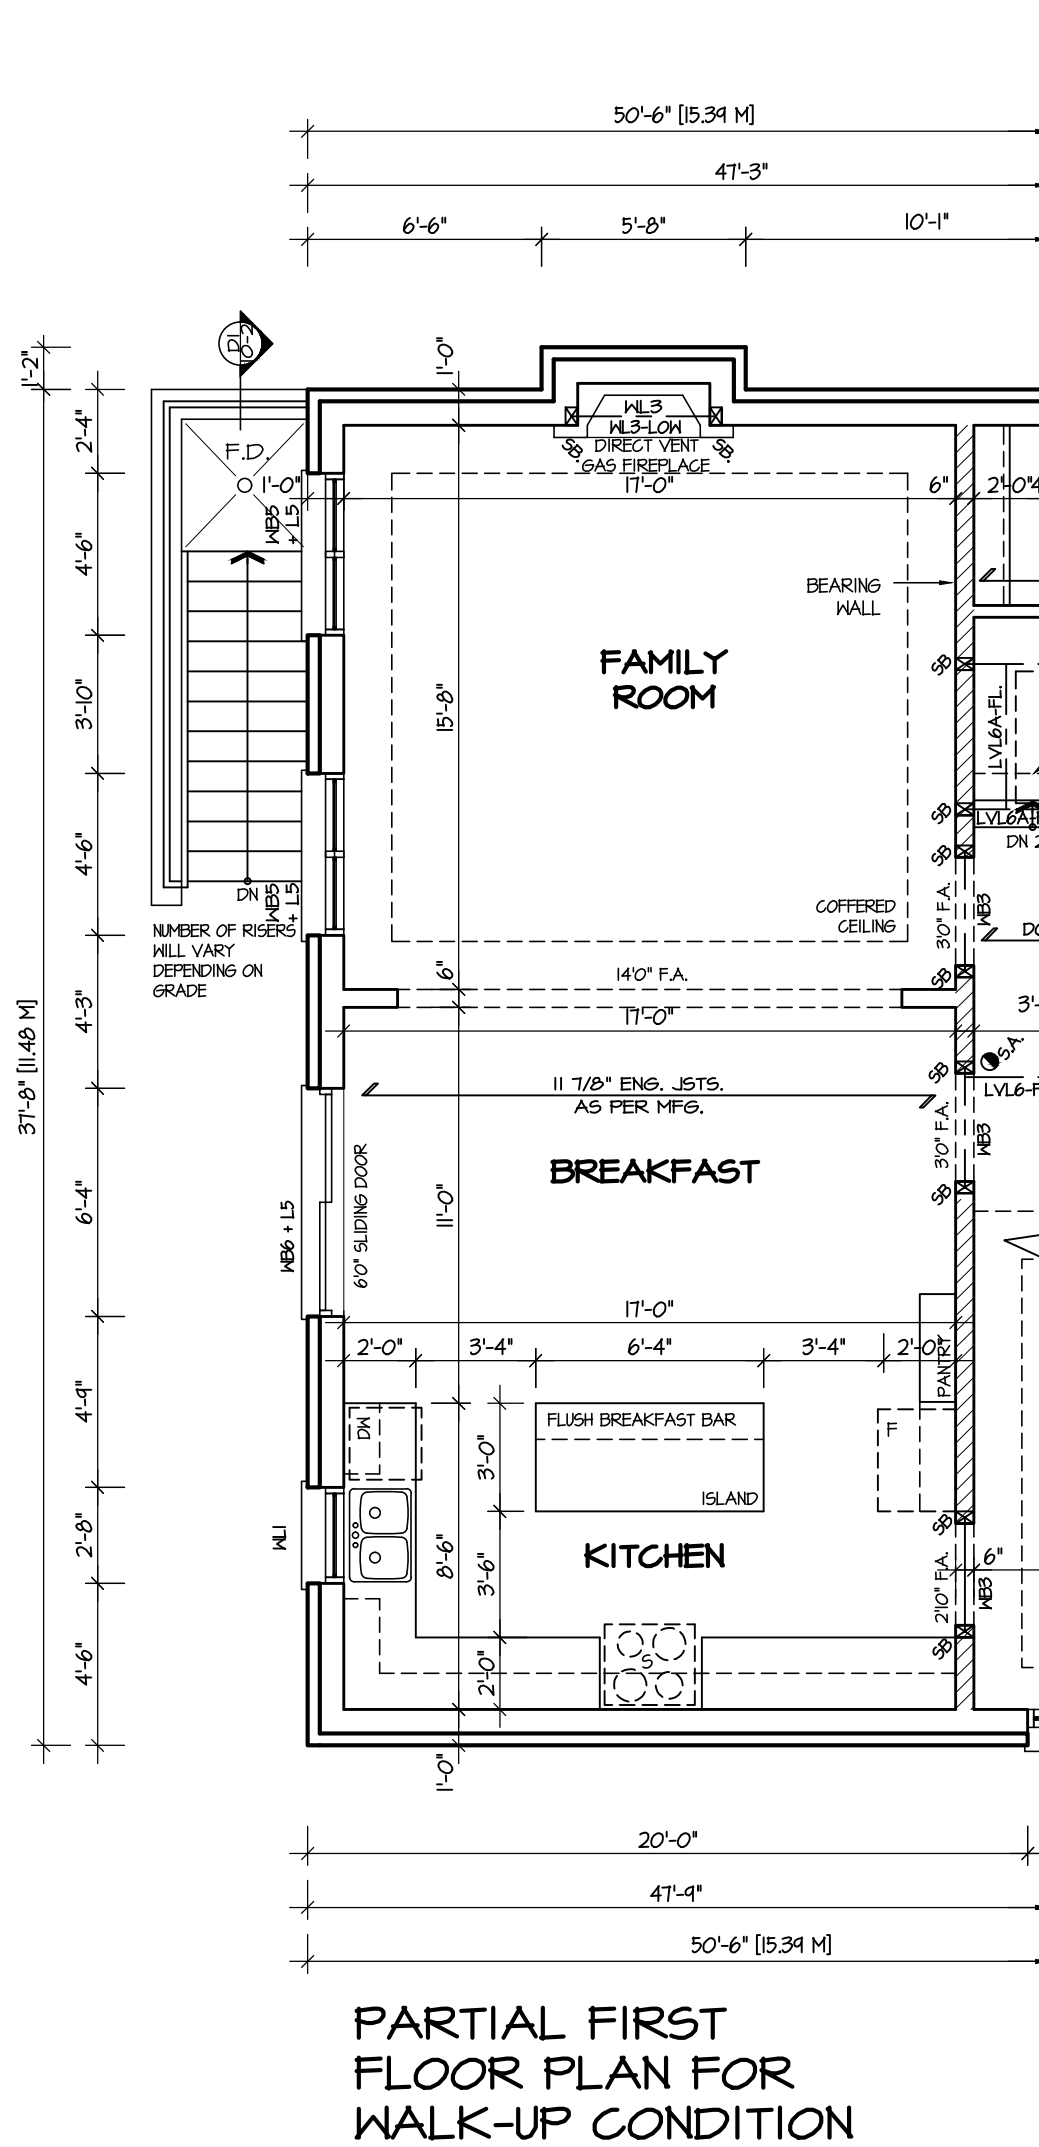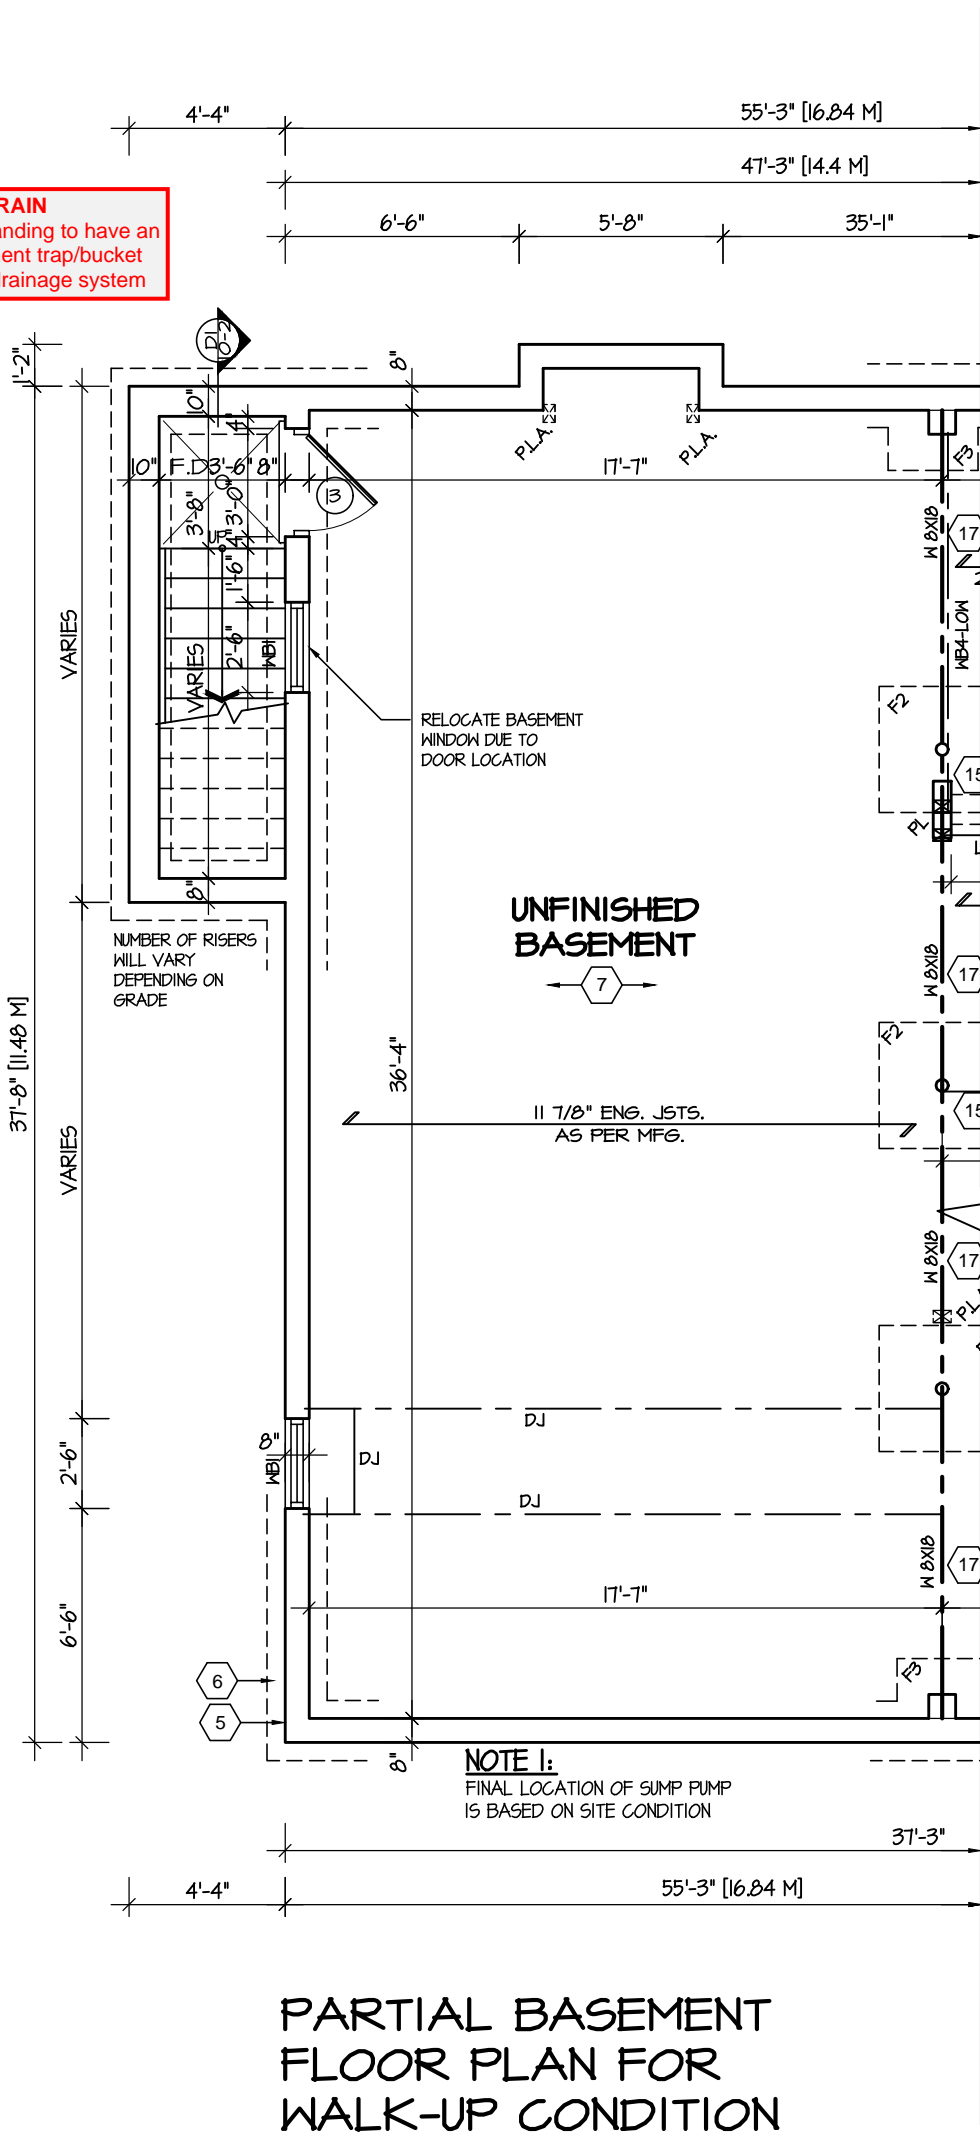

It is the builder's complete responsibility to ensure that all plans submitted for approval fully comply with the Architectural Guidelines and all applicable regulations and requirements including zoning provisions and any provisions in the subdivision agreement. The Control Architect is not responsible in any way for examining or approving site (lotting) plans or working drawings with respect to any zoning or building code or permit matter or that any house can be properly built or located on its lot.

This is to certify that these plans comply with the applicable Architectural Design Guidelines approved by the Town of MILTON.

ARCHITECTURAL REVIEW & APPROVAL
MAR 20 2017
John G. Williams Limited, Architect

JUNIPER 7
ENERGY STAR

5.		
4.		
3.		
2.		
1.	ISSUED FOR REVIEW	SEP 2016
REVISIONS		

The undersigned has reviewed and takes responsibility for this design, and has the qualifications and meets the requirements set out in the Ontario Building Code to be a designer.
QUALIFICATION INFORMATION
Required unless design is exempt under Division C, Subsection 3.2.5 of the building code
VIKAS GAJJAR
NAME
SIGNATURE
28770
BCIN


REGION DESIGN INC.
8700 DUFFERIN ST.
CONCORD, ONTARIO
L4K 4S6
P (416) 736-4096
F (905) 660-0746

REGION
DESIGN
INC.


SHEET TITLE WALK-UP PLANS	
SCALE 3/16"=1'-0"	BY ZMP
DATE JAN 2017	TYPE

CONTRACTOR SHALL CHECK ALL DIMENSIONS AND ELEVATIONS BEFORE COMMENCING WITH WORK AND REPORT ANY DISCREPANCIES TO THE DESIGNER. PRINTS ARE NOT TO BE SCALED.	
AREA 3093	PAGE No. 10
PROJECT 02-10-08	

Greenpark.
PROJECT NAME
LECCO RIDGE

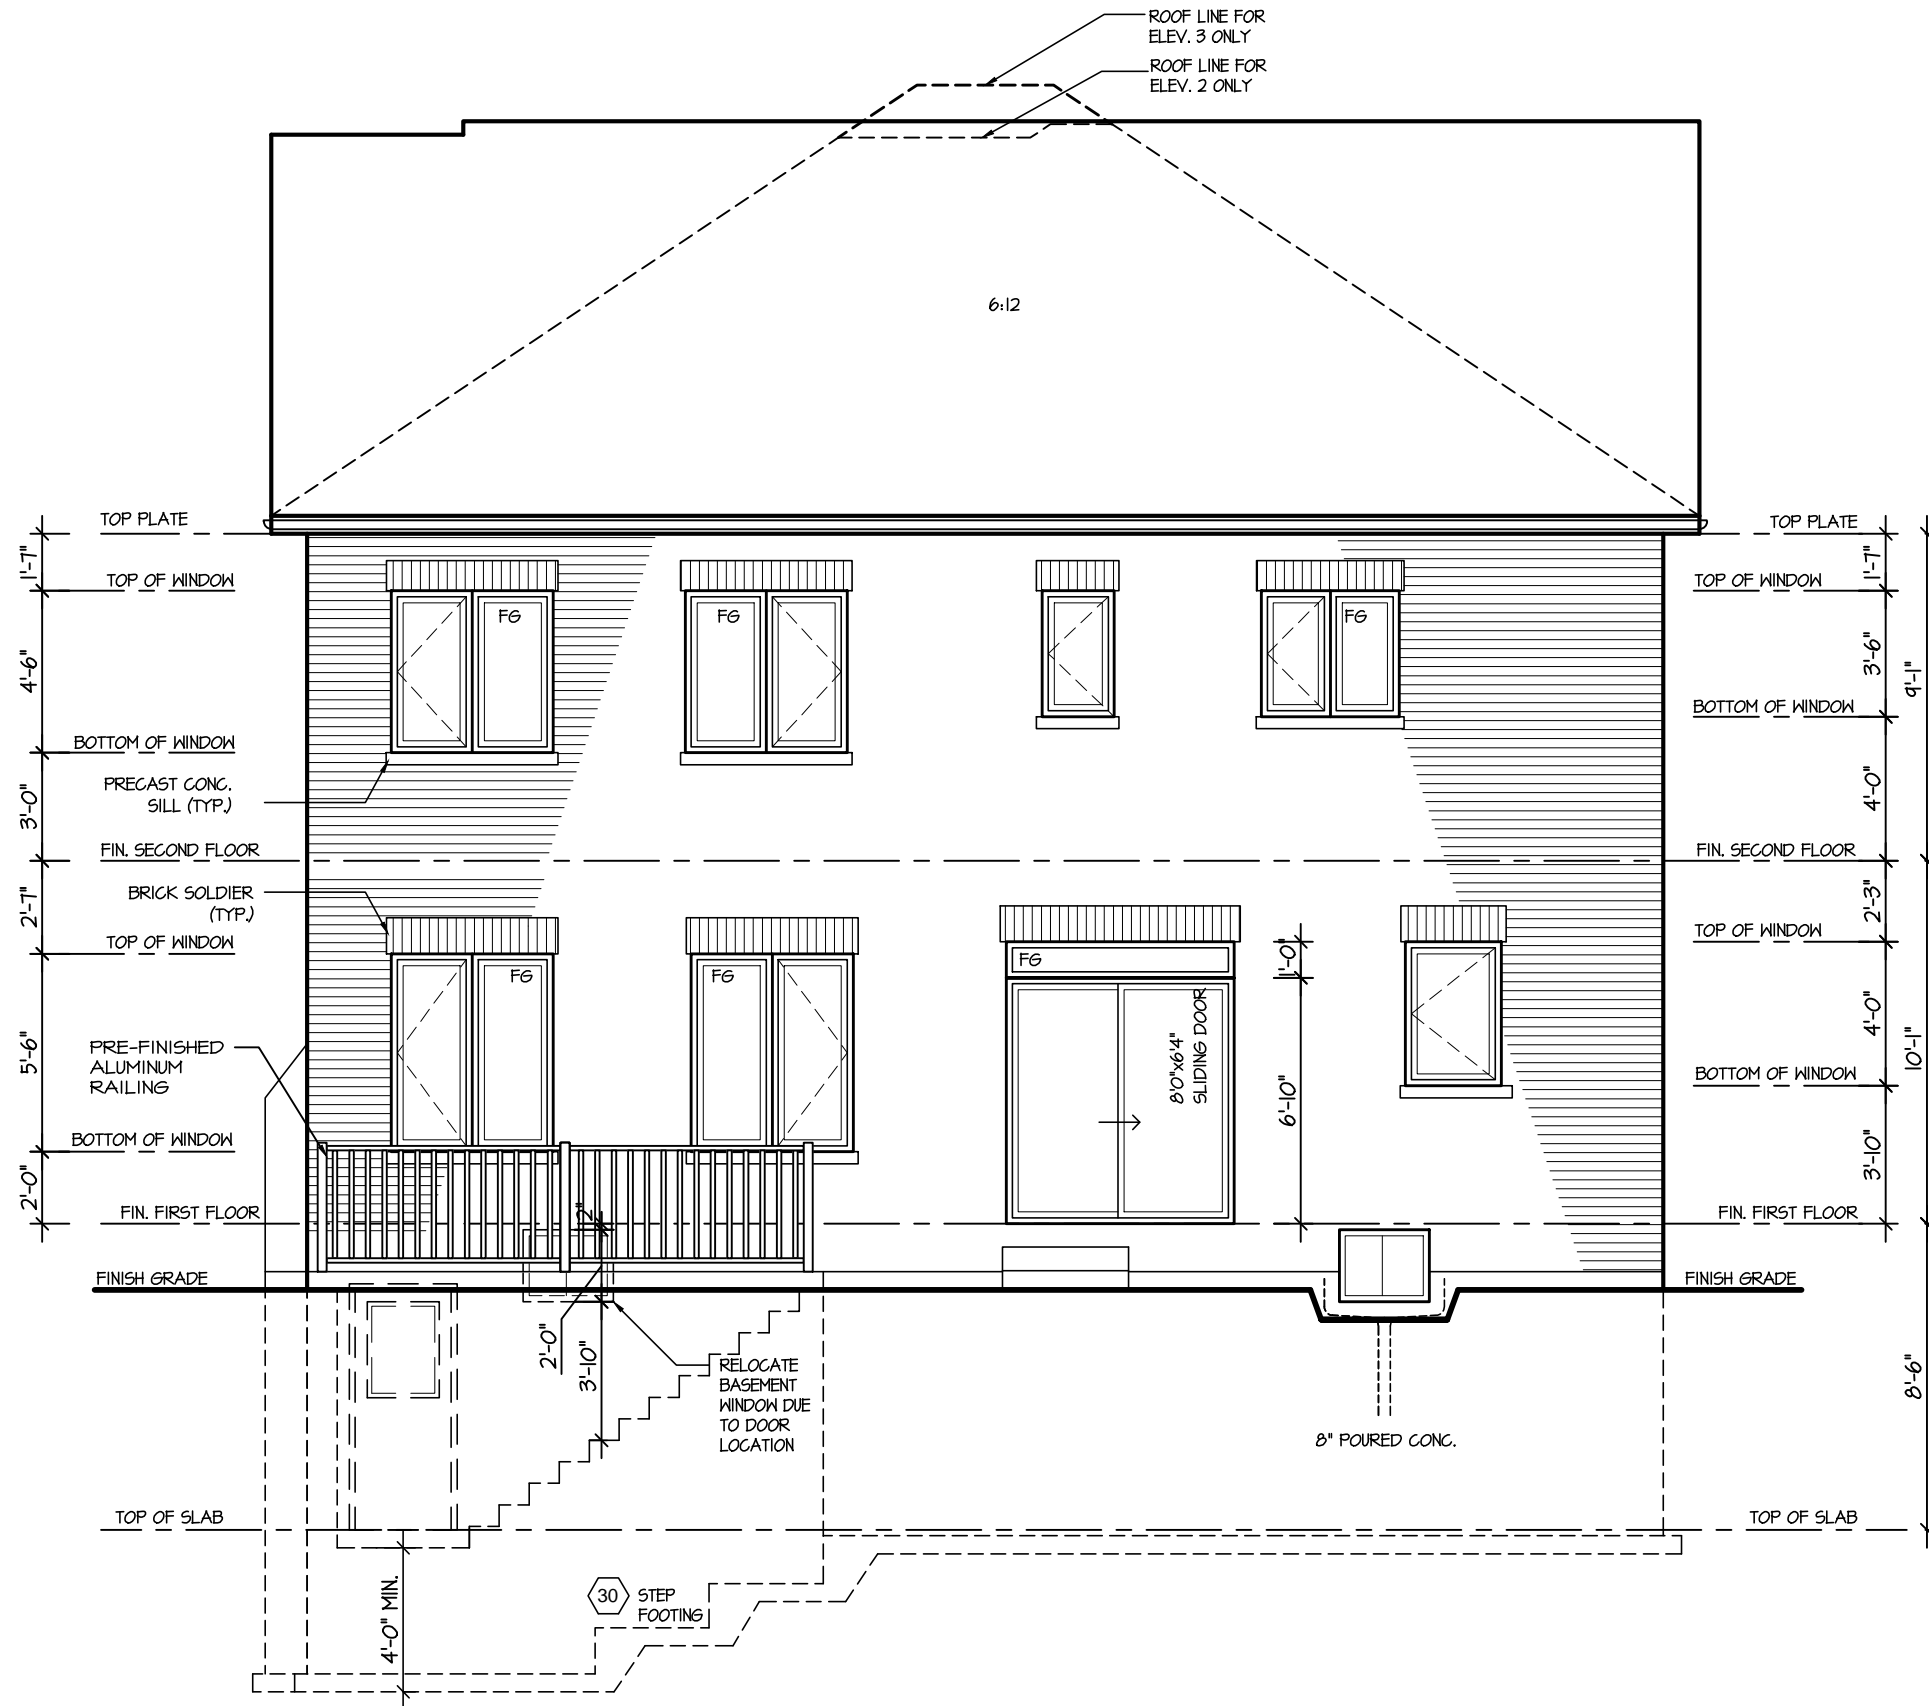

REAR ELEVATION FOR
WALK-UP CONDITION

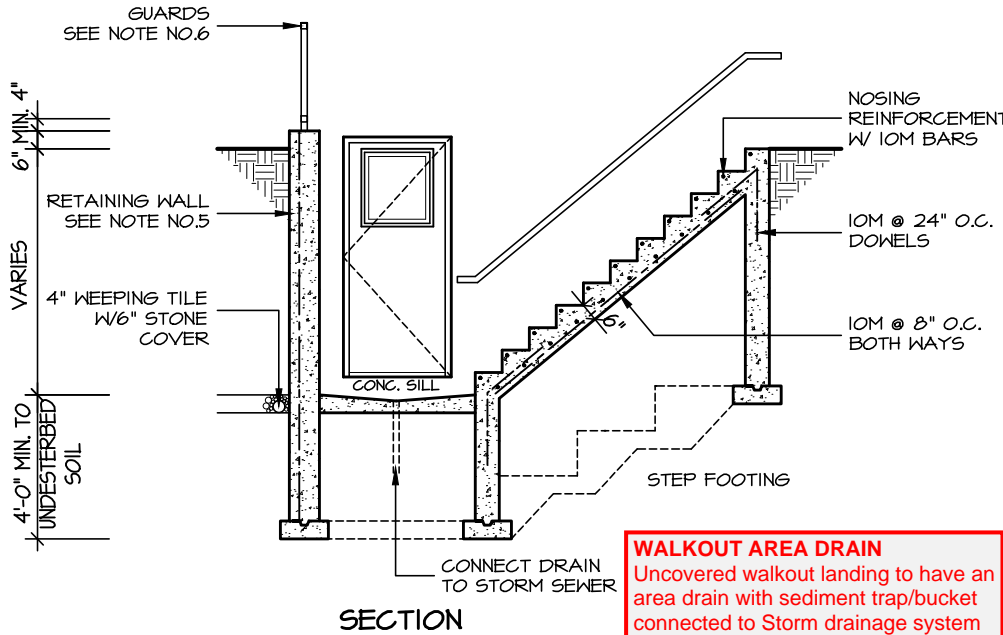

SECTION

GENERAL NOTES:

1. FOOTING
24"x8" POURED CONC. FOOTING. ALL FOOTINGS SHALL REST ON NATURAL UNDISTURBED SOIL OR COMPACTED GRANULAR FILL.
2. CONCRETE
MINIMUM COMPRESSIVE STRENGTH OF 32 MPa (4650 psi) @ 28 DAYS W/ 5% TO 8% AIR ENTRAINMENT.
3. EXTERIOR STAIRS
7 7/8" RISE MAXIMUM
8 1/4" RUN MINIMUM
9 1/4" TREAD MINIMUM
4. INSULATION
FOR INSULATION VALUE & VAPOUR BARRIER LOCATION REFER TO NOTE 13 OF STANDARD NOTES.
5. RETAINING WALL
10" POURED CONCRETE W/ NO REINFORCING REQUIRED FOR WALL HEIGHTS TO A MAX. OF 4'-7". PROVIDE 15M VERTICAL REINFORCEMENT @ 16" O.C. AND 15M HORIZONTAL REINFORCEMENT @ 24" O.C. FOR WALL HEIGHTS FROM 4'-8" TO 7'-0". 15M HORIZONTAL & VERTICAL REINFORCEMENT @ 12" O.C. EACH FACE FOR WALL HEIGHTS FROM 7'-0" TO 9'-0". RETAINING WALL TO RESIST LATERAL DESIGN LOADS AS PER OBC DIVISION B SECTION 4.1.5.16.
6. GUARDS
3'-6" HIGH WHERE DISTANCE FROM GRADE TO BOTTOM OF WALKOUT EXCEEDS 5'-11"; 2'-11" FOR LESSER HEIGHTS. MAXIMUM 4" BETWEEN VERTICAL PICKETS.

DI - EXTERIOR WALKUP STAIRS DETAILS

WALKOUT BSMT. INSULATION
See standard details page 12 for required perimeter slab insulation for walkout basement condition

RECEIVED
TOWN OF MILTON
MAR 29, 2017
JUNIPER 7
BUILDING DIVISION

TOWN OF MILTON
PLANNING AND DEVELOPMENT
JUNIPER 7 MODEL
BUILDING: REVIEWED
SCOTT SHERRIFFS
PLANS EXAMINER
DATE
APR 13, 2017
Neither the issuance of a permit nor carrying out of inspections by the Town of Milton relieves the owner from full responsibility for compliance with the provisions of the Ontario Building Code Act and the Ontario Building Code, both as amended, as well as other applicable statutes and regulations of the Province of Ontario, By-laws of the Region of Halton and Town of Milton



It is the builder's complete responsibility to ensure that all plans submitted for approval fully comply with the Architectural Guidelines and all applicable regulations and requirements including zoning provisions and any provisions in the subdivision agreement. The Control Architect is not responsible in any way for examining or approving site (lotting) plans or working drawings with respect to any zoning or building code or permit matter or that any house can be properly built or located on its lot.

This is to certify that these plans comply with the applicable Architectural Design Guidelines approved by the Town of MILTON.
ARCHITECTURAL REVIEW & APPROVAL
MAR 20 2017
John G. Williams Limited, Architect

JUNIPER 7
ENERGY STAR

5.		
4.		
3.		
2.		
1.	ISSUED FOR REVIEW	SEP 2016
REVISIONS		

The undersigned has reviewed and takes responsibility for this design, and has the qualifications and meets the requirements set out in the Ontario Building Code to be a designer.
QUALIFICATION INFORMATION
Required unless design is exempt under Division C, Subsection 3.2.5 of the building code
VIKAS GAJJAR
NAME
SIGNATURE
28770
BCIN

REGION DESIGN INC.
8700 DUFFERIN ST.
CONCORD, ONTARIO
L4K 4S6
P (416) 736-4096
F (905) 660-0746



SHEET TITLE WALK-UP ELEVATION	
SCALE 3/16"=1'-0"	BY ZMP
DATE JAN 2017	TYPE

CONTRACTOR SHALL CHECK ALL DIMENSIONS AND ELEVATIONS BEFORE COMMENCING WITH WORK AND REPORT ANY DISCREPANCIES TO THE DESIGNER. PRINTS ARE NOT TO BE SCALED.	
AREA 3093	PAGE No. 10-2
PROJECT 02-10-08	

Greenpark
PROJECT NAME
LECCO RIDGE