


PARTY WALL AT GARAGE SIDE CONSTRUCTION

- REFER TO BLOCK PLANS TO CONFIRM WHETHER SK2 OR SK3 PARTY WALL IS TO BE BUILT.
- REFER TO DETAIL PAGES 4A OR 4B TO VERIFY PARTY WALL THICKNESS/CONSTRUCTION.

changed to full height wall

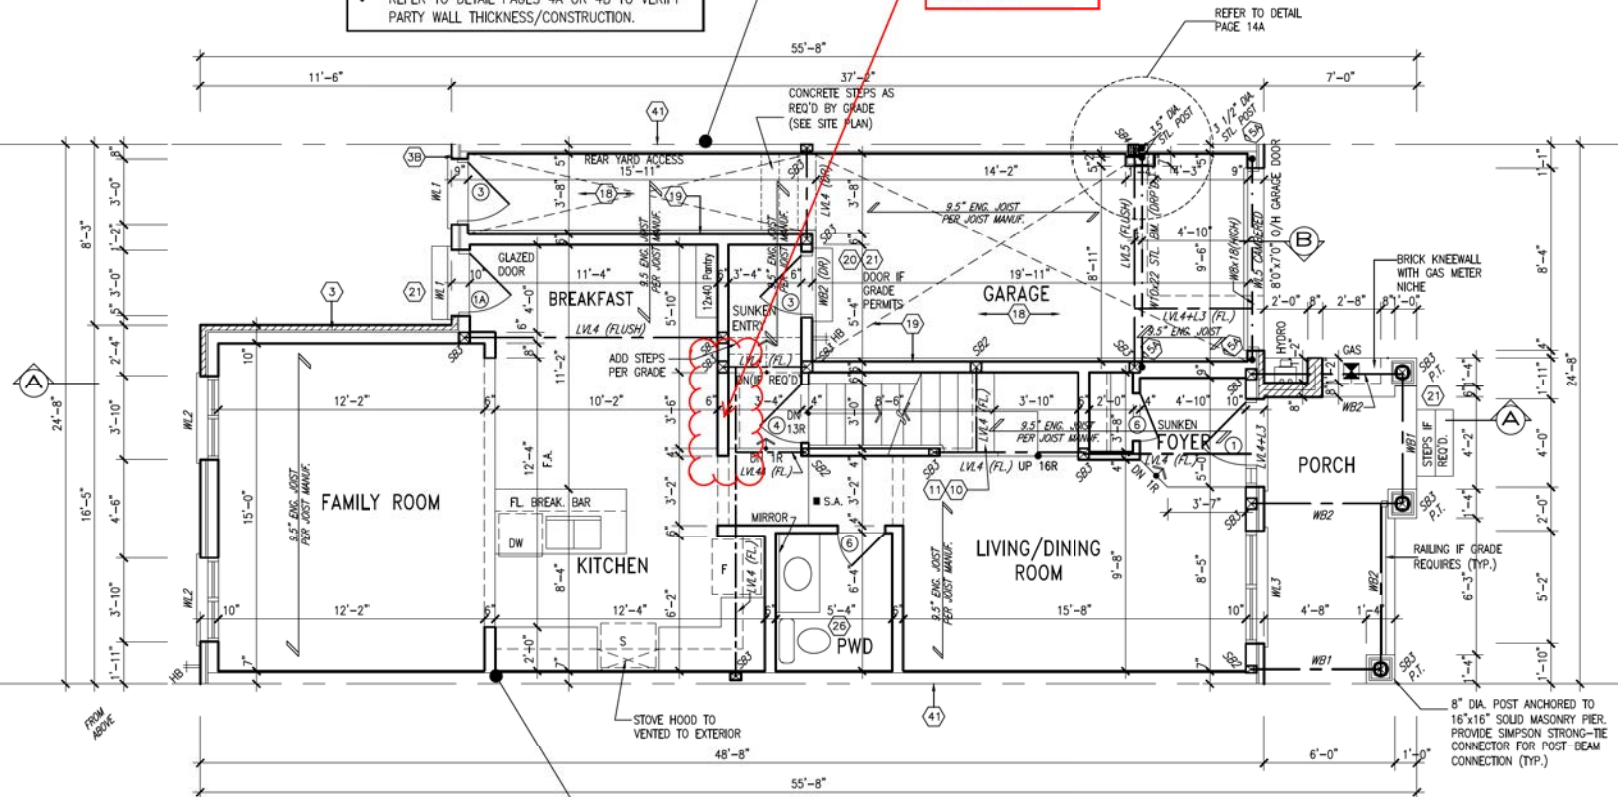

PARTY WALL AT HOUSE SIDE CONSTRUCTION

- REFER TO BLOCK PLANS TO CONFIRM WHETHER SK1 OR SK3 PARTY WALL IS TO BE BUILT.
- REFER TO DETAIL PAGES 4 OR 4B TO VERIFY PARTY WALL THICKNESS/CONSTRUCTION.

GROUND FLOOR PLAN ELEV. '1'

NOTE: ROOF FRAMING
REFER TO ROOF TRUSS SHOP DRAWINGS AND TOWNHOUSE BLOCK PLANS FOR ALL ROOF FRAMING INFORMATION UNLESS OTHERWISE NOTED.

ENGINEERED FLOOR FRAMING INFO
REFER TO ENGINEERED FLOOR LAYOUTS FOR ALL FLOOR FRAMING INFORMATION AND DETAILS UNLESS OTHERWISE NOTED.



STRUDET INC.
FOR STRUCTURE ONLY

It is the builder's complete responsibility to ensure that all plans submitted for approval fully comply with the Architectural Guidelines and all applicable regulations and requirements including zoning provisions and any provisions in the subdivision agreement. The Control Architect is not responsible in any way for examining or approving site (plotting) plans or working drawings with respect to any zoning or building code or permit matter or that any house can be properly built or located on its lot.

This is to certify that these plans comply with the applicable Architectural Design Guidelines approved by the City of HAMILTON.

HIGHGROVE 3
COMPLIANCE PACKAGE 'A1'


15.	16.	17.	
15.	16.	17.	

1902 SF.

PARTY WALL AT GARAGE SIDE CONSTRUCTION
 • REFER TO BLOCK PLANS TO CONFIRM WHETHER SK2 OR SK3 PARTY WALL IS TO BE BUILT.
 • REFER TO DETAIL PAGES 4A OR 4B TO VERIFY PARTY WALL THICKNESS/CONSTRUCTION.

changed to full height wall

REFER TO DETAIL PAGE 14A

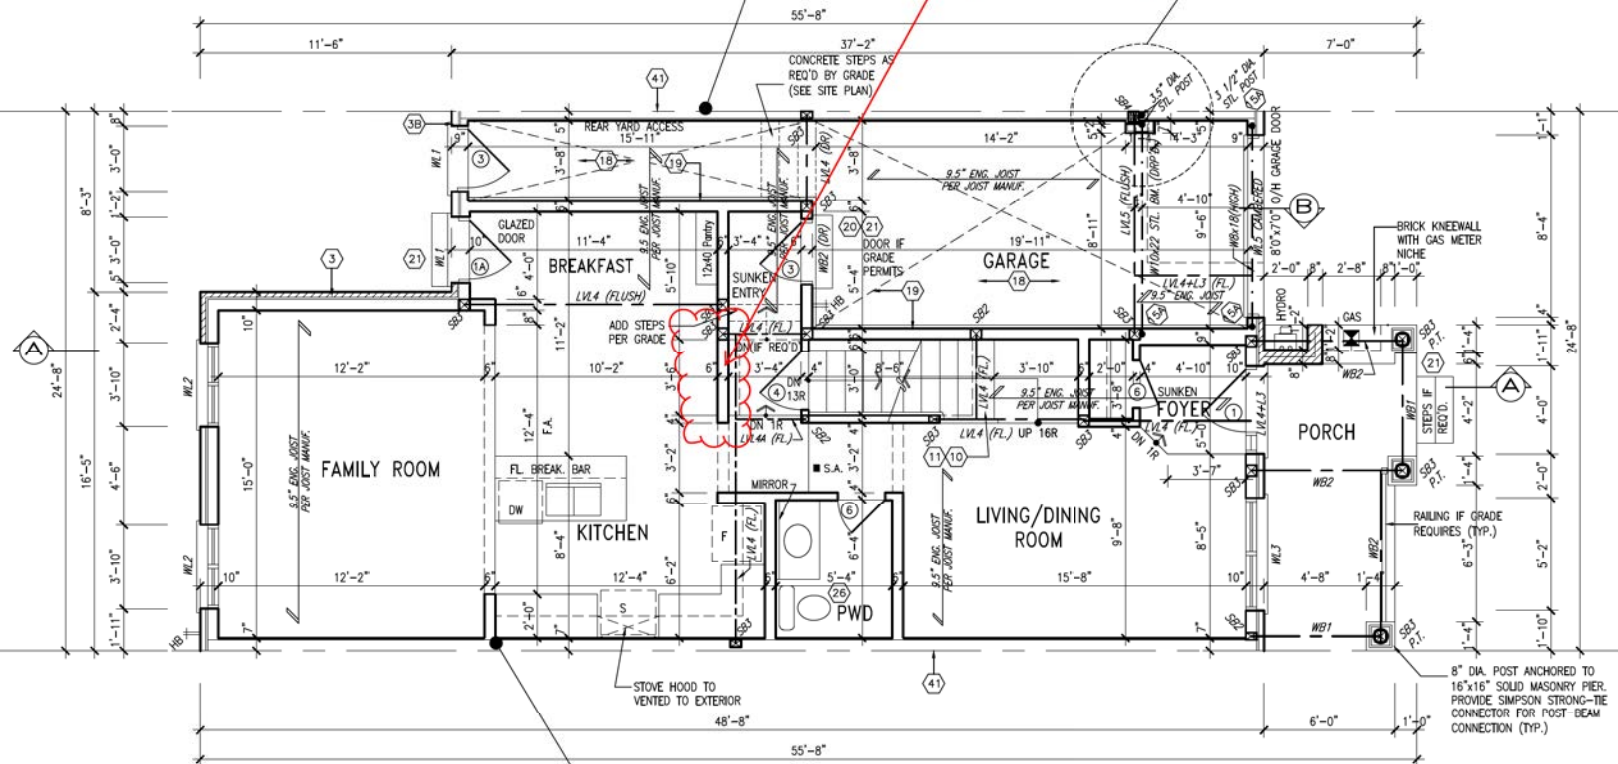

GROUND FLOOR PLAN ELEV. '1A'

PARTY WALL AT HOUSE SIDE CONSTRUCTION
 • REFER TO BLOCK PLANS TO CONFIRM WHETHER SK1 OR SK3 PARTY WALL IS TO BE BUILT.
 • REFER TO DETAIL PAGES 4 OR 4B TO VERIFY PARTY WALL THICKNESS/CONSTRUCTION.

NOTE: ROOF FRAMING
 REFER TO ROOF TRUSS SHOP DRAWINGS AND TOWNHOUSE BLOCK PLANS FOR ALL ROOF FRAMING INFORMATION UNLESS OTHERWISE NOTED.

ENGINEERED FLOOR FRAMING INFO
 REFER TO ENGINEERED FLOOR LAYOUTS FOR ALL FLOOR FRAMING INFORMATION AND DETAILS, UNLESS OTHERWISE NOTED.



STRUDET INC.
 FOR STRUCTURE ONLY

It is the builder's complete responsibility to ensure that all plans submitted for approval fully comply with the Architectural Guidelines and all applicable regulations and requirements including zoning provisions and any provisions in the subdivision agreement. The Control Architect is not responsible in any way for examining or approving site (lotting) plans or working drawings with respect to any zoning or building code or permit matter or that any house can be properly built or located on its lot.

This is to certify that these plans comply with the applicable Architectural Design Guidelines approved by the City of HAMILTON.


HIGHGROVE 3
 COMPLIANCE PACKAGE 'A1'

15.	16.	17.	
15.	16.	17.	

- PARTY WALL AT GARAGE SIDE CONSTRUCTION**
- REFER TO BLOCK PLANS TO CONFIRM WHETHER SK2 OR SK3 PARTY WALL IS TO BE BUILT.
 - REFER TO DETAIL PAGES 4A OR 4B TO VERIFY PARTY WALL THICKNESS/CONSTRUCTION.

changed to full height wall

REFER TO DETAIL PAGE 14A

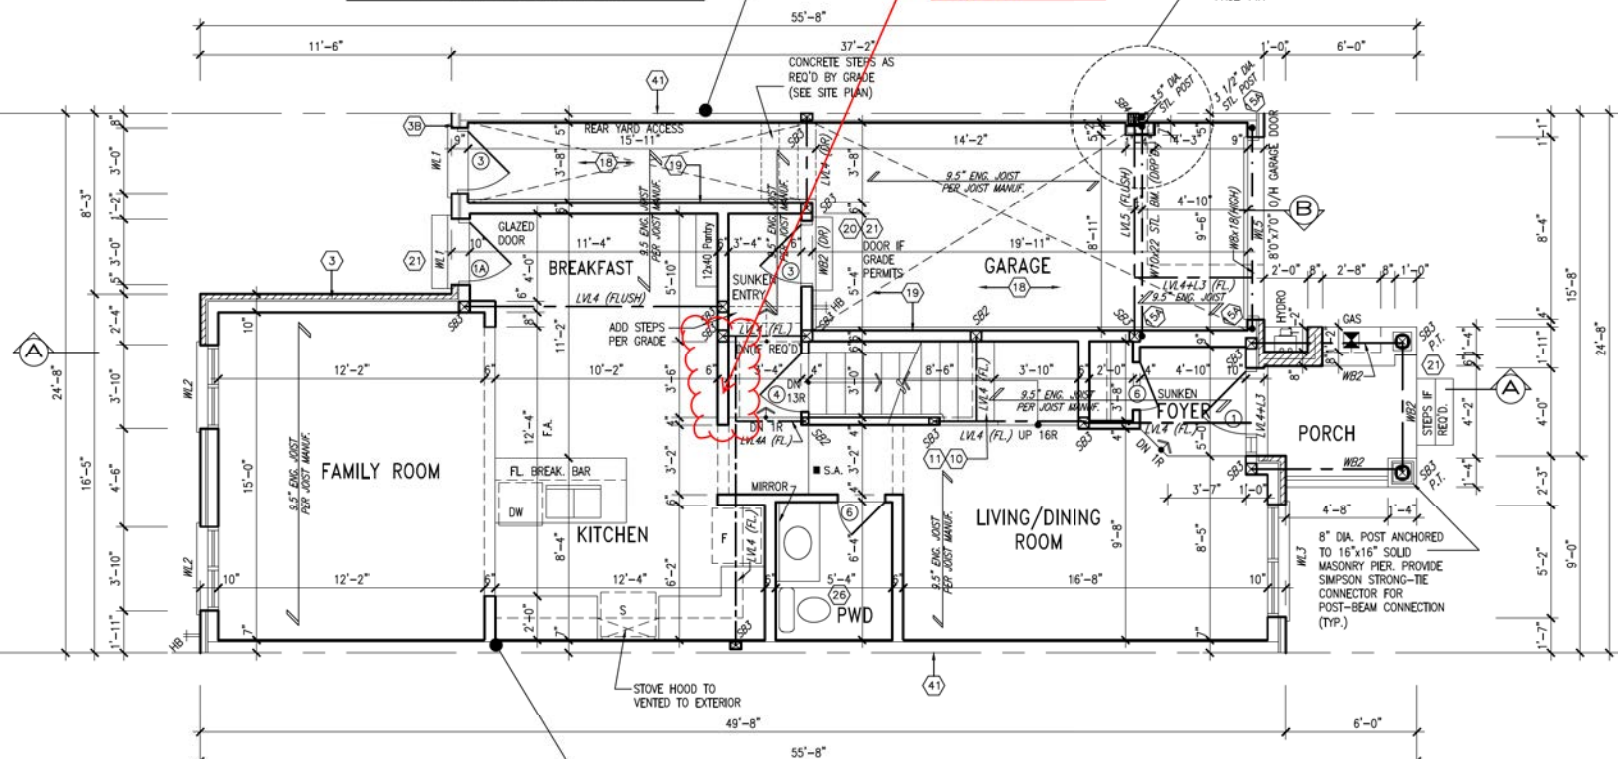

- PARTY WALL AT HOUSE SIDE CONSTRUCTION**
- REFER TO BLOCK PLANS TO CONFIRM WHETHER SK1 OR SK3 PARTY WALL IS TO BE BUILT.
 - REFER TO DETAIL PAGES 4 OR 4B TO VERIFY PARTY WALL THICKNESS/CONSTRUCTION.

GROUND FLOOR PLAN ELEV. '2'

NOTE: ROOF FRAMING
REFER TO ROOF TRUSS SHOP DRAWINGS AND TOWNHOUSE BLOCK PLANS FOR ALL ROOF FRAMING INFORMATION UNLESS OTHERWISE NOTED.

ENGINEERED FLOOR FRAMING INFO
REFER TO ENGINEERED FLOOR LAYOUTS FOR ALL FLOOR FRAMING INFORMATION AND DETAILS, UNLESS OTHERWISE NOTED.



STRUDET INC.
FOR STRUCTURE ONLY

It is the builder's complete responsibility to ensure that all plans submitted for approval fully comply with the Architectural Guidelines and all applicable regulations and requirements including zoning provisions and any provisions in the subdivision agreement. The Control Architect is not responsible in any way for examining or approving site (lotting) plans or working drawings with respect to any zoning or building code or permit matter or that any house can be properly built or located on its lot.

This is to certify that these plans comply with the applicable Architectural Design Guidelines approved by the City of HAMILTON.

HIGHGROVE 3
COMPLIANCE PACKAGE 'A1'


15.	
-----	--	--	

1902 SF.

PARTY WALL AT GARAGE SIDE CONSTRUCTION
 • REFER TO BLOCK PLANS TO CONFIRM WHETHER SK2 OR SK3 PARTY WALL IS TO BE BUILT.
 • REFER TO DETAIL PAGES 4A OR 4B TO VERIFY PARTY WALL THICKNESS/CONSTRUCTION.

changed to full height wall

REFER TO DETAIL PAGE 14A

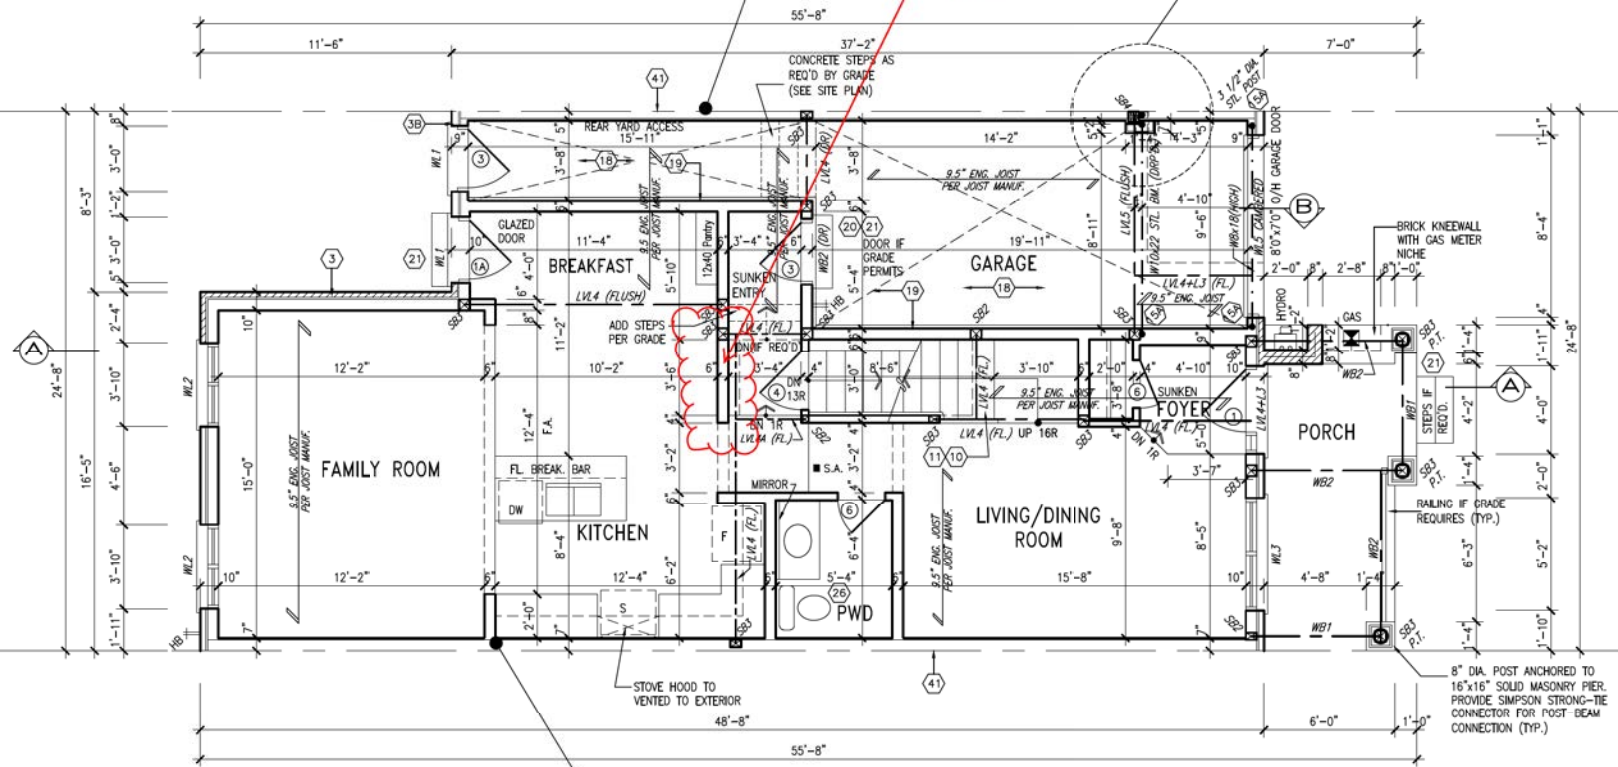

PARTY WALL AT HOUSE SIDE CONSTRUCTION
 • REFER TO BLOCK PLANS TO CONFIRM WHETHER SK1 OR SK3 PARTY WALL IS TO BE BUILT.
 • REFER TO DETAIL PAGES 4 OR 4B TO VERIFY PARTY WALL THICKNESS/CONSTRUCTION.

GROUND FLOOR PLAN ELEV. '3'

NOTE: ROOF FRAMING
 REFER TO ROOF TRUSS SHOP DRAWINGS AND TOWNHOUSE BLOCK PLANS FOR ALL ROOF FRAMING INFORMATION UNLESS OTHERWISE NOTED.

ENGINEERED FLOOR FRAMING INFO
 REFER TO ENGINEERED FLOOR LAYOUTS FOR ALL FLOOR FRAMING INFORMATION AND DETAILS, UNLESS OTHERWISE NOTED.



STRUDET INC.
 FOR STRUCTURE ONLY

It is the builder's complete responsibility to ensure that all plans submitted for approval fully comply with the Architectural Guidelines and all applicable regulations and requirements including zoning provisions and any provisions in the subdivision agreement. The Control Architect is not responsible in any way for examining or approving site (plotting) plans or working drawings with respect to any zoning or building code or permit matter or that any house can be properly built or located on its lot.

This is to certify that these plans comply with the applicable Architectural Design Guidelines approved by the City of HAMILTON.

HIGHGROVE 3
 COMPLIANCE PACKAGE 'A1'

16.	
-----	--	--	