


F) 3.1.10



ARCHITECTURAL REVIEW & APPROVAL
MAY 28 2018
John G. Williams Limited, Architect

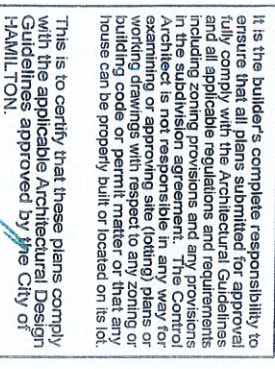

Permit No. 18-118748-00-29

These drawings and/or specifications have been reviewed by _____

DATE _____


Finished grade in
any particular lot.

These drawings are

	(6.0m)
77	13.74

INSTALLATION.

no.	description
-----	-------------

☒ CABLE TELEVISION
☐ BELL PEDESTAL.

—

FOR INFO ON MZD IR®
t 416.630.2255 f 416.630.4781
www3design.com

GM

