THIS LOT GRADING PLAN HAS BEEN REVIEWED BY METROPOLITAN CONSULTING INC. FOR CONFORMANCE WITH THE APPROVED SUBDIVISION GRADING DESIGN. THE PROPOSED GRADES ON THIS PLAN ARE IN GENERAL CONFORMITY WITH THE APPROVED GRADING PLAN AS IT RELATES TO THIS LOT AND ADJACENT LOTS. WHERE THE BASEMENT FLOOR OR OTHER FOUNDATION ELEVATIONS ARE PROPOSED AT A DIFFERENT ELEVATION THAN THAT SHOWN ON THE APPROVED SUBDIVISION PLANS THE SEWER LATERALS HAVE BEEN REVIEWED AND WE ARE SATISFIED THAT THE MINIMUM GRADES FOR THESE LATERALS CAN BE MAINTAINED IN ACCORDANCE WITH THE REQUIREMENTS OF THE O.B.C. AND CITY DESIGN CRITERIA. NOTE: THIS CERTIFICATION DOES NOT REPLACE THE BUILDER'S RESPONSIBILITY TO EXPOSE THE SEWER LATERALS AND CONFIRM ELEVATIONS PRIOR TO EXCAVATING FOR THE FOUNDATION, BY USE OF THIS PLAN THE BUILDER AGREES THAT THEY SHALL BE RESPONSIBLE FOR IMMEDIATELY REPORTING TO METROPOLITAN CONSULTING ANY DISCREPANCY OR VARIATION BETWEEN THE LATERAL INFORMATION AND GRADES DEPICTED ON THIS PLAN AND THE CONDITIONS FOUND IN THE FIELD.

LICENSED PROFESSIONAL ENGINEER
10/10/2018
K.D. HOLLINGSWORTH
100152747
PROVINCE OF ONTARIO

It is the builder's complete responsibility to ensure that all plans submitted for approval fully comply with the Architectural Guidelines and all applicable regulations and requirements including zoning provisions and any provisions in the subdivision agreement. The Control Architect is not responsible in any way for examining or approving site (lotting) plans or working drawings with respect to any zoning or building code or permit matter or that any house can be properly built or located on its lot.

This is to certify that these plans comply with the applicable Architectural Design Guidelines approved by the City of HAMILTON.

ARCHITECTURAL REVIEW & APPROVAL
OCT 19 2018
John G. Williams Limited, Architect

CITY OF HAMILTON
BUILDING DIVISION
Planning & Development Department
OCT 26 2018
REC. BY _____ DATE _____
REF'D TO _____ DATE _____

CITY OF HAMILTON
Building Division
Permit No. 18-141520-00-RS
THESE STAMPED DRAWINGS SHALL BE AVAILABLE ON SITE
THE OWNER AND/OR CONTRACTOR SHALL COMPLY WITH THE ONTARIO BUILDING CODE AND ALL OTHER APPLICABLE LAW
These drawings and/or specifications have been reviewed by
FOR CHIEF BUILDING OFFICIAL — NOV. 9/18 — DATE

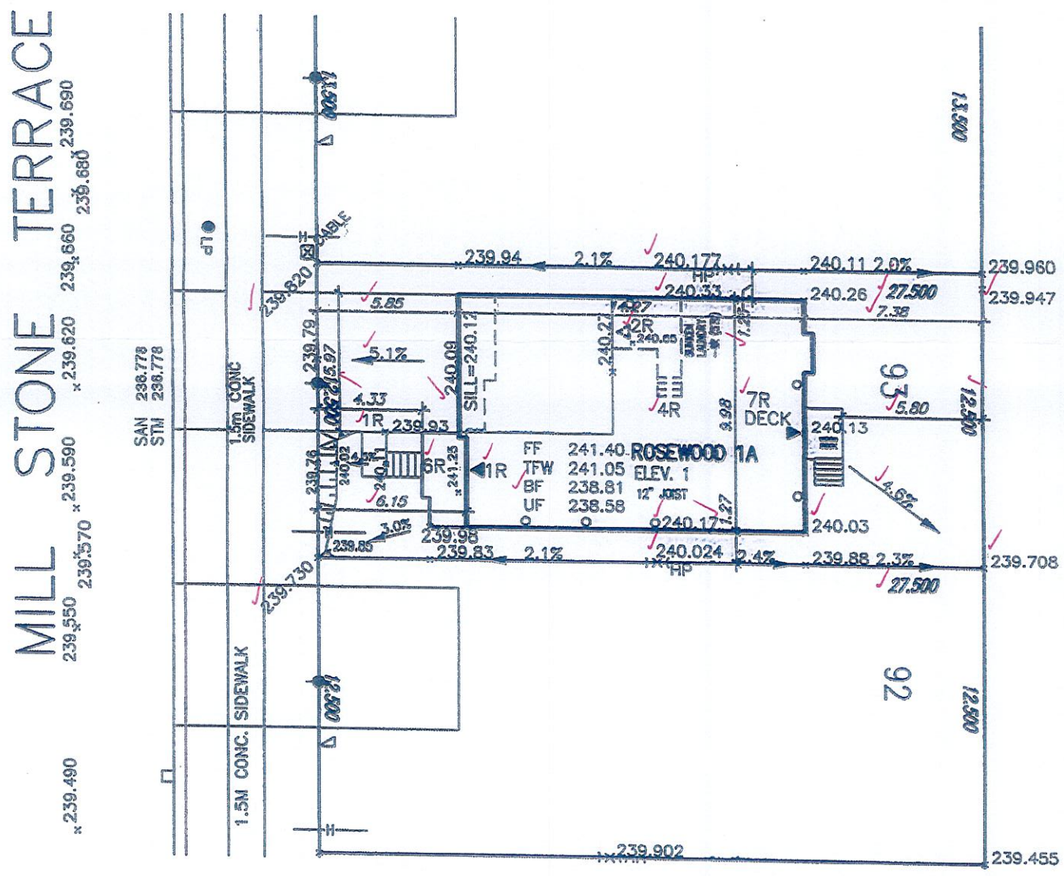

The undersigned has reviewed and takes responsibility for the design and has the qualifications and meets the requirements set out in the Ontario Building Code to be a Designer.

Qualification information
Richard Vink — R Vink — 24488
name — signature — BCIN
registration information
VA3 Design Inc. — 42658

LOT 93		
LOT No.	LOT WIDTH (M) (@ 6.0m)	LOT AREA (M²)
93	12.50	344

Grading Notes:
It shall be the responsibility of the builder to have all grades and services verified and checked before construction by an approved grading engineer. These grades and the placement of storm and sanitary services off the street are to meet the requirements of the municipality having jurisdiction.

VA3 Design Inc. is to be notified promptly of any discrepancies at least 1 (one) week prior to excavation commences in order that the building can be re-sited. Failure to observe these conditions may require expensive remedial action that will not be the responsibility of or cost to VA3 Design Inc. Foundation wall shall be poured to a minimum of 6" above approved grades.

Finished grade lines as indicated on the house prototype are for reference only and do not necessarily depict finish grading conditions of any particular lot.

These drawings are to be read in conjunction with municipal approved site engineering drawings prepared by Metropolitan Consulting Inc.

NOTE: REFER TO LANDSCAPE DRAWINGS FOR ALL FENCING TYPES, HEIGHTS AND LOCATIONS. CONTRACTOR TO VERIFY PRIOR TO INSTALLATION.

PROPOSED WAVE
LP LIGHT POLE
HYDRANT
TRANSFORMER
WATER SERVICE
DOUBLE STM./SAN. CONNECTION
SINGLE STM./SAN. CONNECTION
CB CATCH BASIN
CABLE TELEVISION PEDESTAL
BELL PEDESTAL
R NO. OF RISERS
FF FINISHED FLOOR ELEVATION
US UNDERSIDE FOOTING ELEVATION
BF TOP OF FOUNDATION WALL
TFW TOP OF FOUNDATION WALL
UFR UNDERSIDE FOOTING AT REAR
UFF UNDERSIDE FOOTING AT FRONT
UFS UNDERSIDE FOOTING AT SIDE
W.O.D. WALK OUT DECK
W.O.B. WALK OUT BASEMENT
REF REFERENCE PLAN
STREET SIGN
SUPER MAIL BOX
RETAINING WALL
CHAIN LINK FENCE
ACOUSTICAL FENCE (SEE LANDSCAPE PLAN)
WOOD SCREEN FENCE (SEE LANDSCAPE PLAN)
HYDRO SERVICE LATERAL
SWALE DIRECTION
EMBANKMENT
PROVIDE 3/4" DIA. CLEAN STONE IN THIS AREA
THIS LOT CONTAINS ENGINEERED FILL
AC AIR CONDITIONER REQUIRED
RAIN WATER DOWNSPOUT LOCATION (DISCHARGE ONTO SPLASHPAD)
SIDE WINDOW LOCATION
EXTERIOR DOOR LOCATION
REDUCE SIDE YARD
north arrow

no.	description	date	by
9			
8			
7			
6			
5			
4			
3			
2			
1	ISSUED FOR ENG. REVIEW.	OCT 05/18	GW

Builder to verify location of all hydrants, street lights, transformers and other services. If minimum clearances are not maintained, builder is to relocate at his own expense.
Builder to verify service connection elevations prior to constructing foundations.

VA3 DESIGN
255 Consumers Rd Suite 120
Toronto ON M2J 1R4
t 416.630.2255 f 416.630.4782
va3design.com

Greenpark
project name: RUSSELL GARDENS PHASE 2
municipality: HAMILTON
title: OCT. 2018
LOT SITING/GRADING
drawn by: GW
checked by: --
scale: 1:250
CREO: -- H:\ARCHIVE\WORKING\2016\16036.GRE\SITE\16036-RG2-SP.dwg -- Fri -- Oct 5 2018 -- 2:42 PM
file name: 16036-RG2-SP
lot/block no.: 93
registered plan no.: --
project no.: 16036
drawing no.: 1

All drawings specifications, related documents and designs are the copyright property of VA3 DESIGN. Reproduction of this property in whole or in part is strictly prohibited without VA3 DESIGN's written permission.